


FED. ROAD DIST. NO.	STATE	FED. AID PROJ. NO.	FISCAL YEAR	SHEET NO.	TOTAL SHEETS
HAWAII	HAW	WPH-8F	1935	19	19

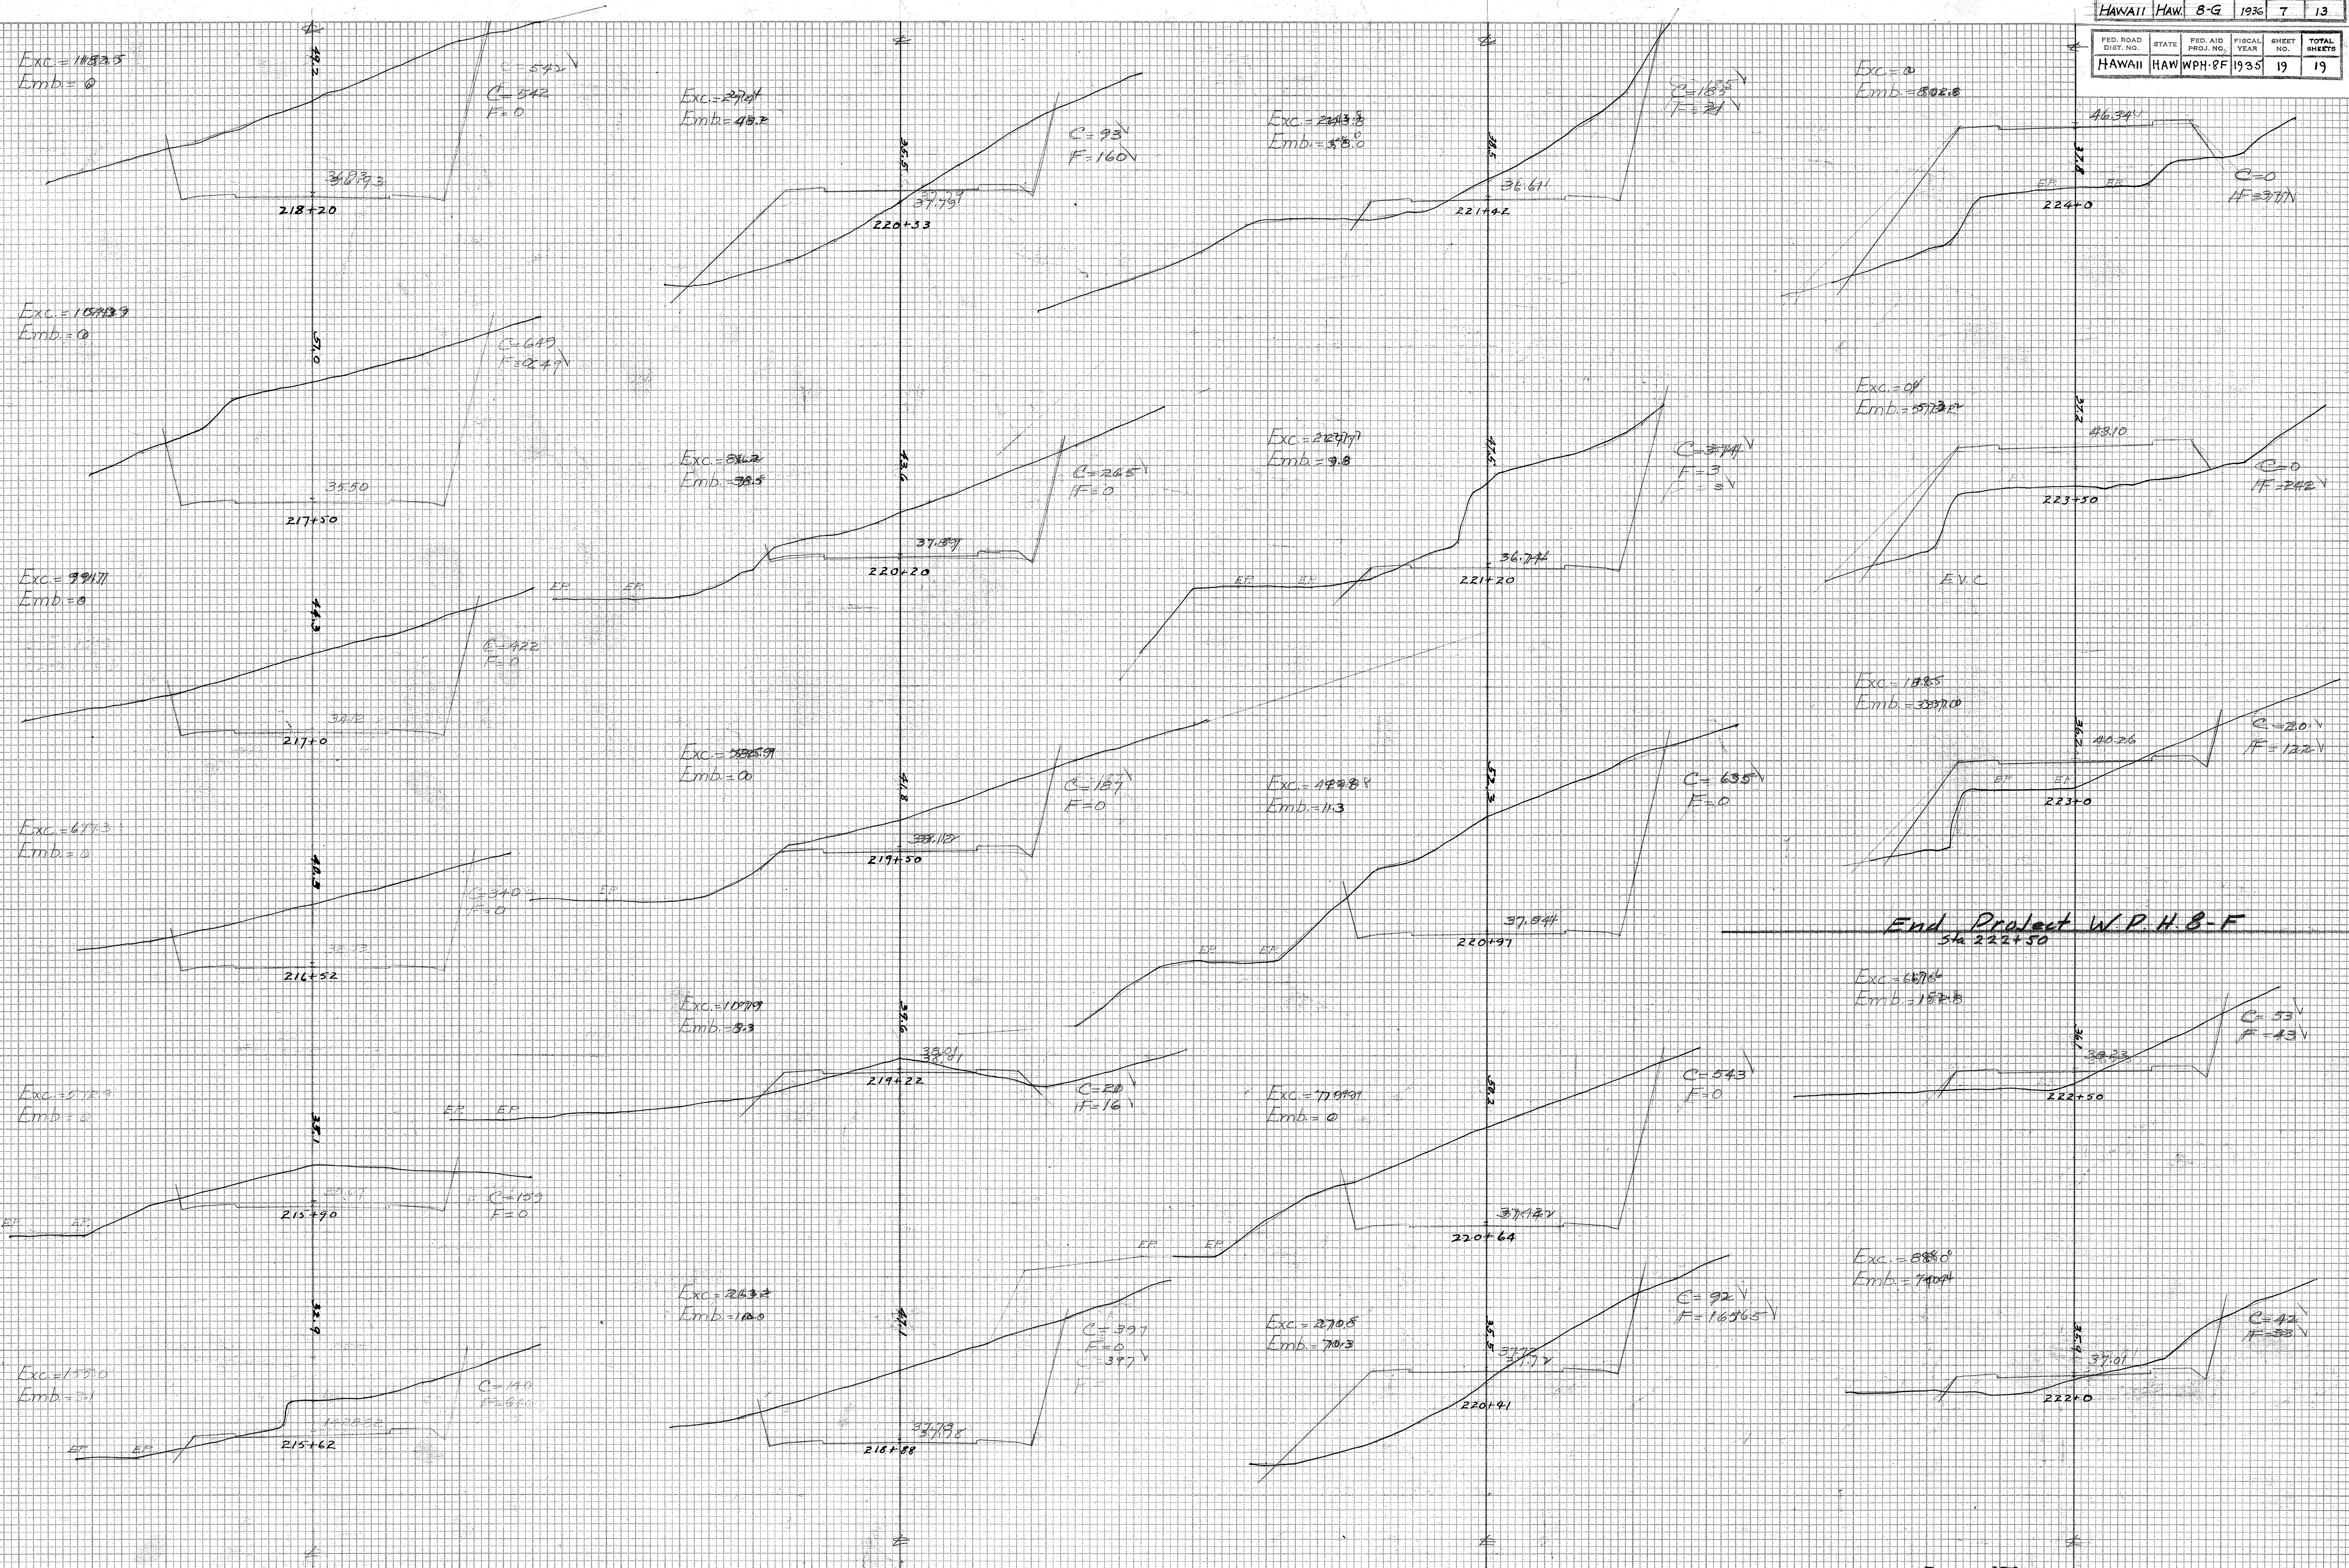


4384.7 4352.19

8F-8G 43840 7

FINAL SURVEY	SURVEYED	BY	DATE
NOTED	PLOTTED		
BOOK	TEMPLATE		
NO.	AREAS CHECKED		

ORIGINAL SURVEY	BY	DATE
SURVEYED	G.C.	10-32
PLOTTED	W.T.	11-33
TEMPLATE	G.C.	11-33
AREAS	W.T. & P.L.	11-33
AREAS CHECKED	W.T. & P.L.	11-35




















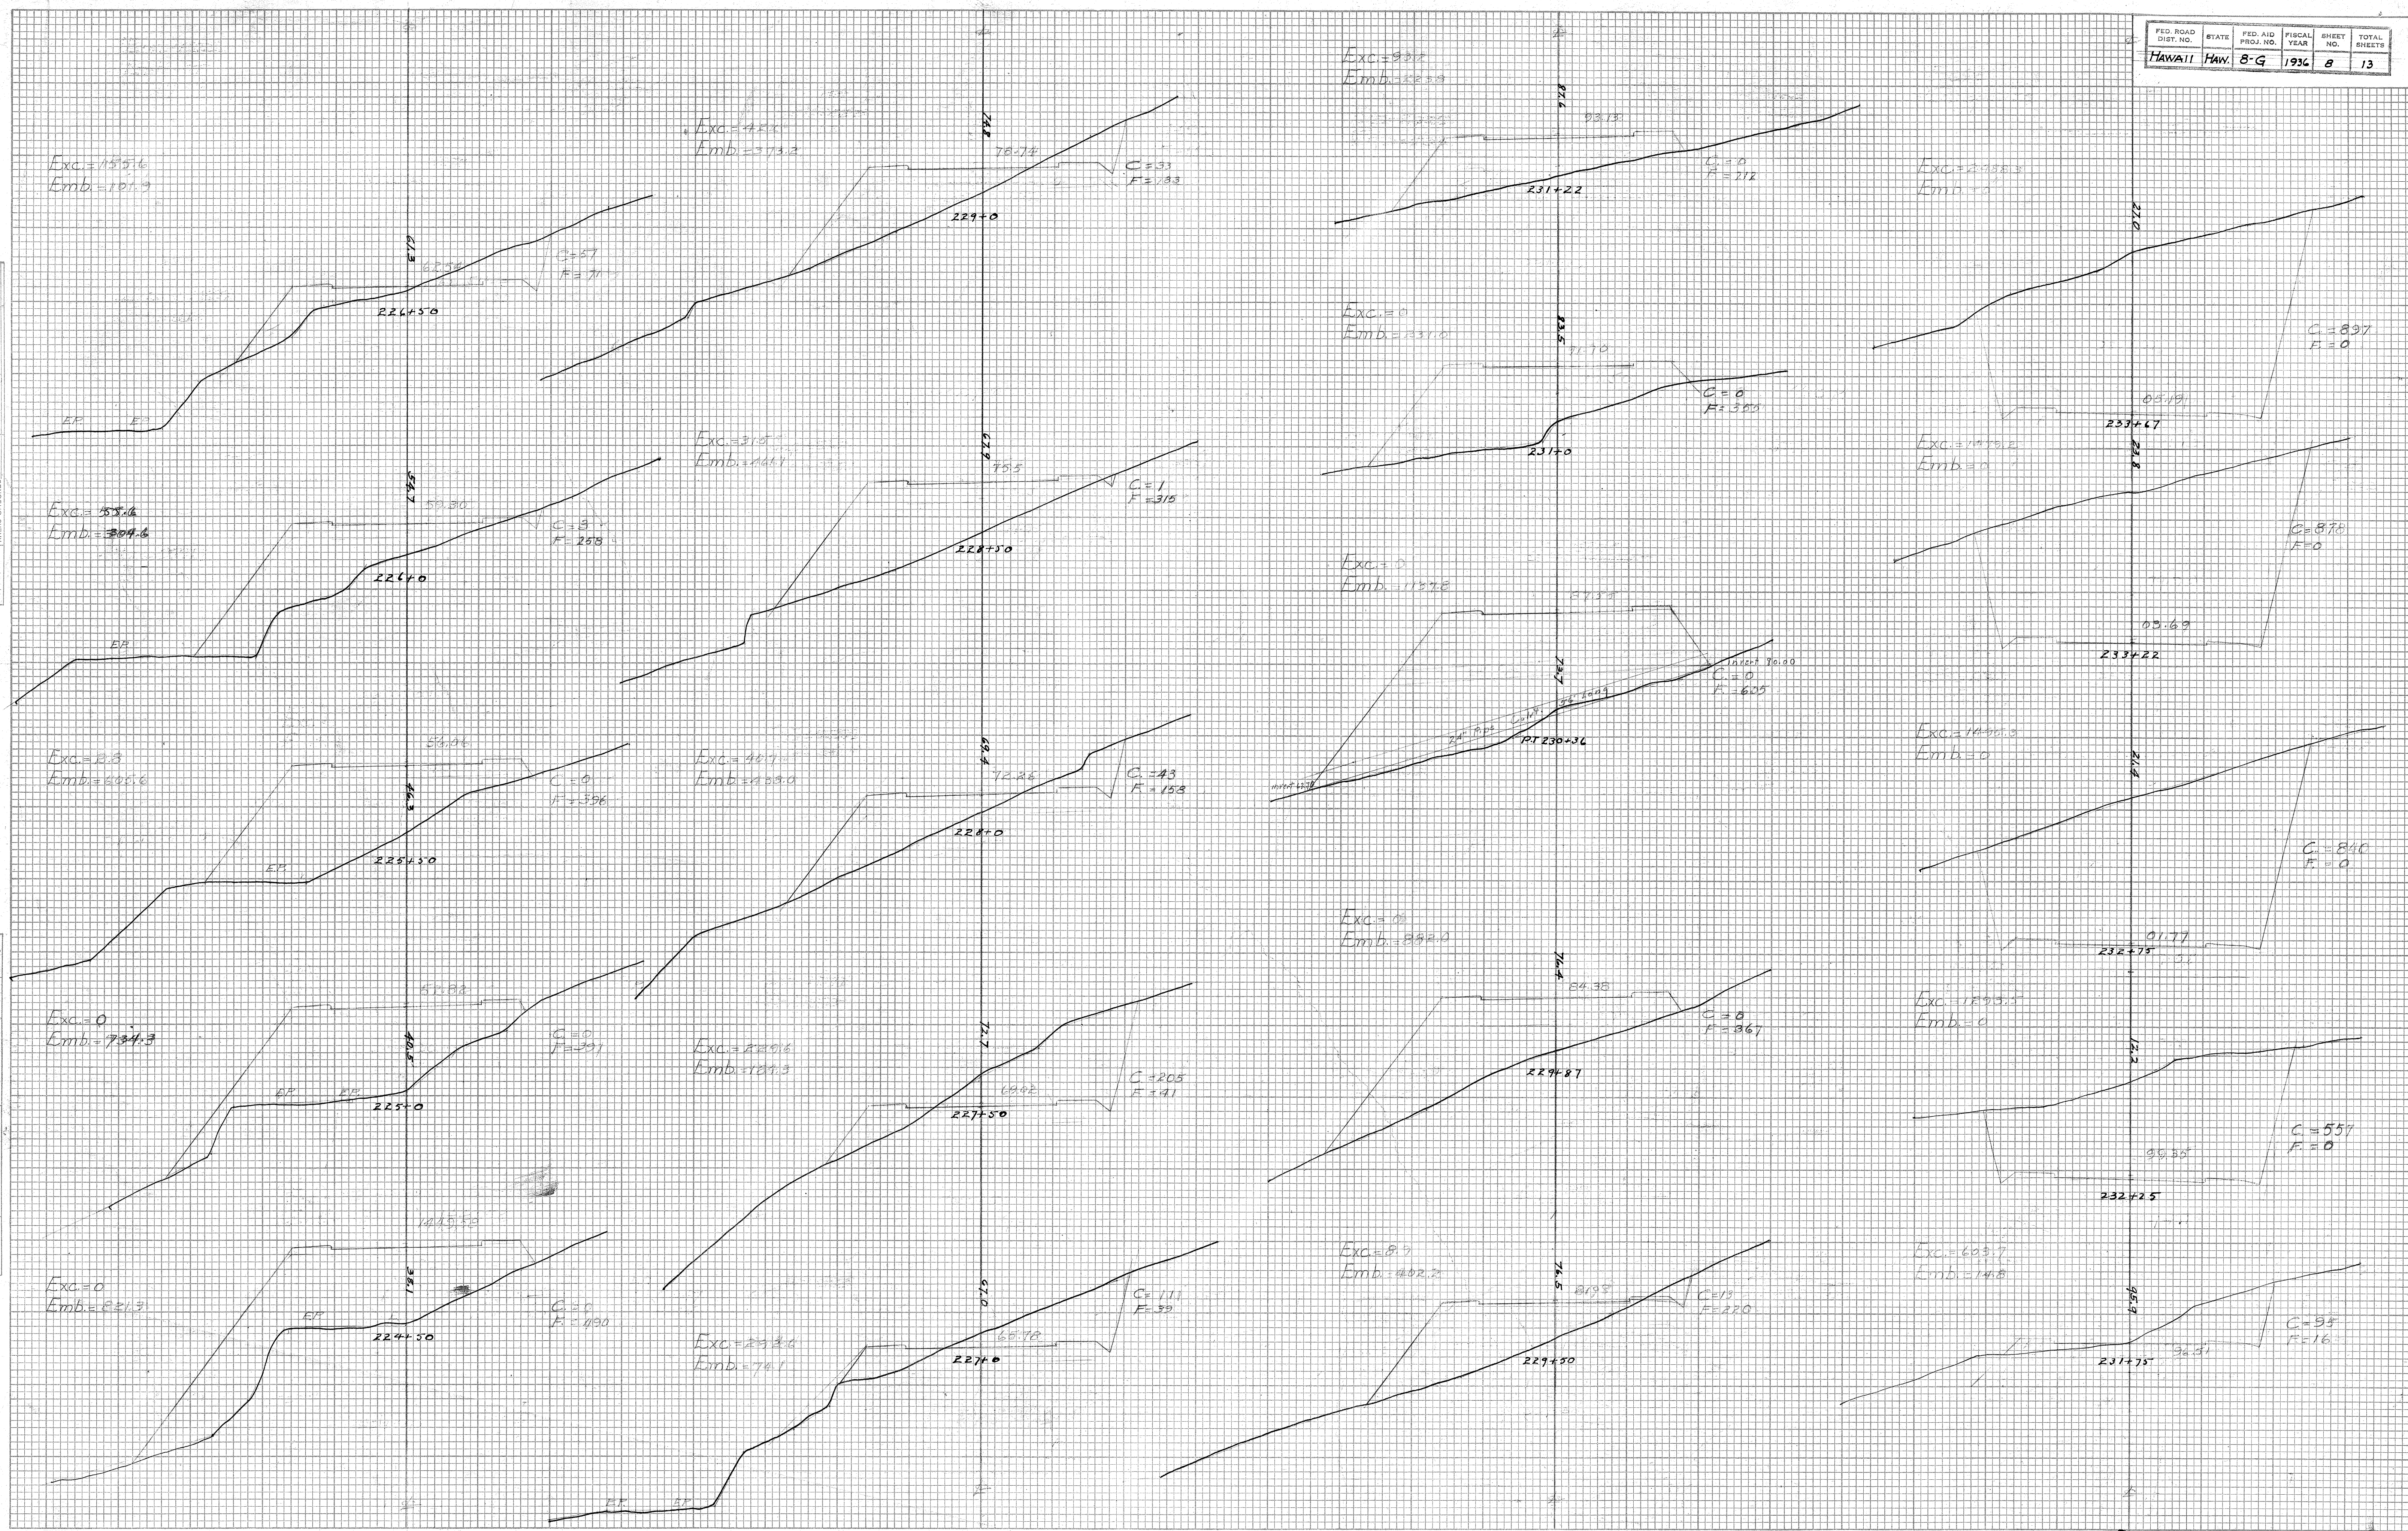


Slope 3/4 to 1

FED. ROAD DIST. NO.	STATE	FED. AID PROJ. NO.	FISCAL YEAR	SHEET NO.	TOTAL SHEETS
HAWAII	HAW	8-G	1936	9	13






















DATE	BY	NO.
11-2-36	W.C. & E.C.	11-2-36
11-3-36		11-3-36
11-4-36		11-4-36
11-5-36		11-5-36
11-6-36		11-6-36
11-7-36		11-7-36
11-8-36		11-8-36
11-9-36		11-9-36
11-10-36		11-10-36
11-11-36		11-11-36
11-12-36		11-12-36

DATE	BY	NO.
11-2-36	W.C. & E.C.	11-2-36
11-3-36		11-3-36
11-4-36		11-4-36
11-5-36		11-5-36
11-6-36		11-6-36
11-7-36		11-7-36
11-8-36		11-8-36
11-9-36		11-9-36
11-10-36		11-10-36
11-11-36		11-11-36
11-12-36		11-12-36

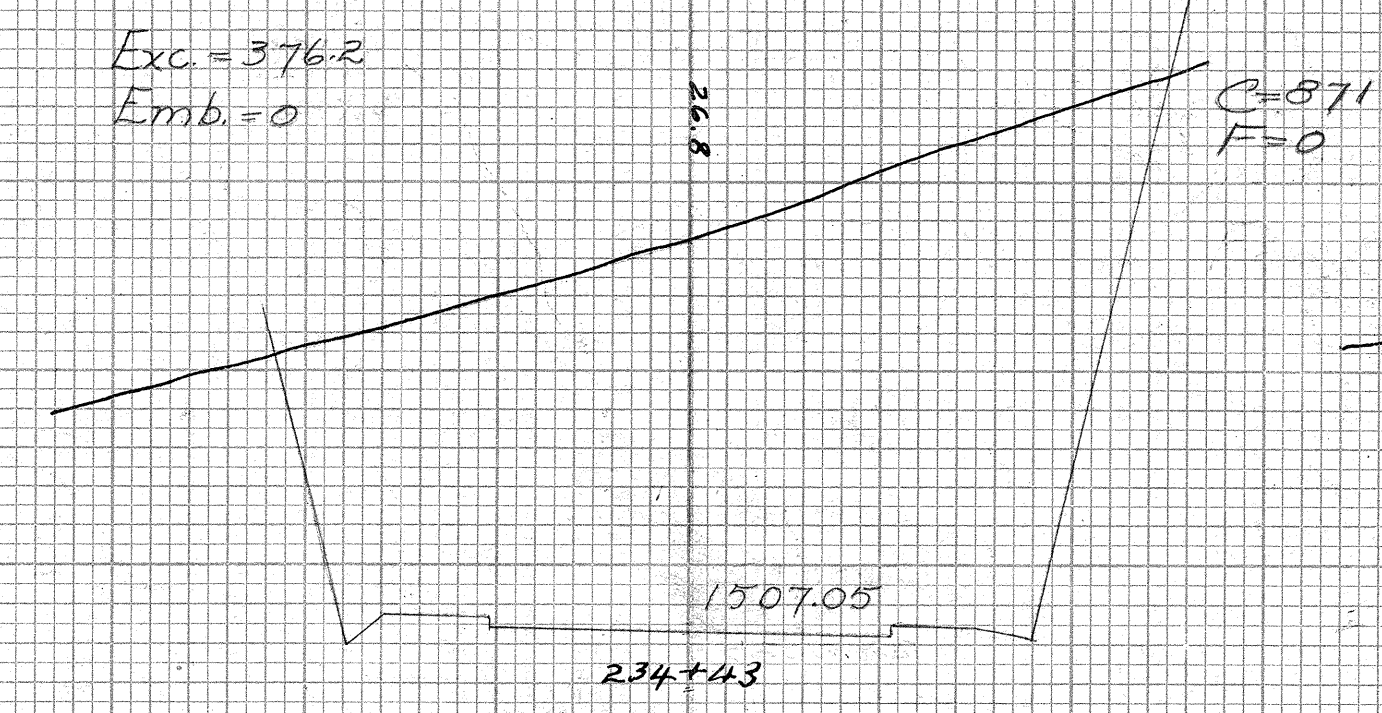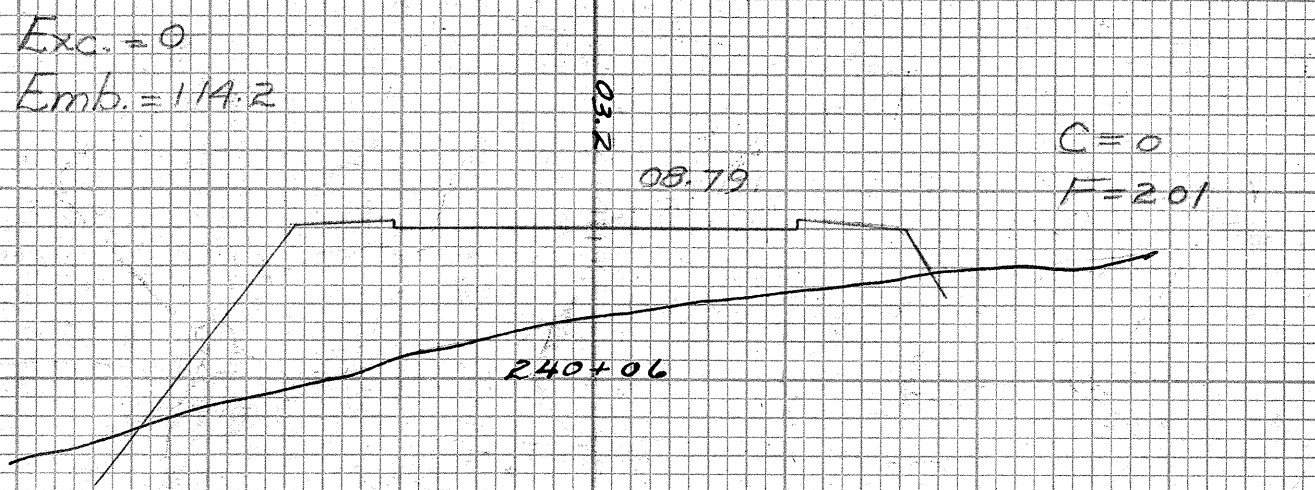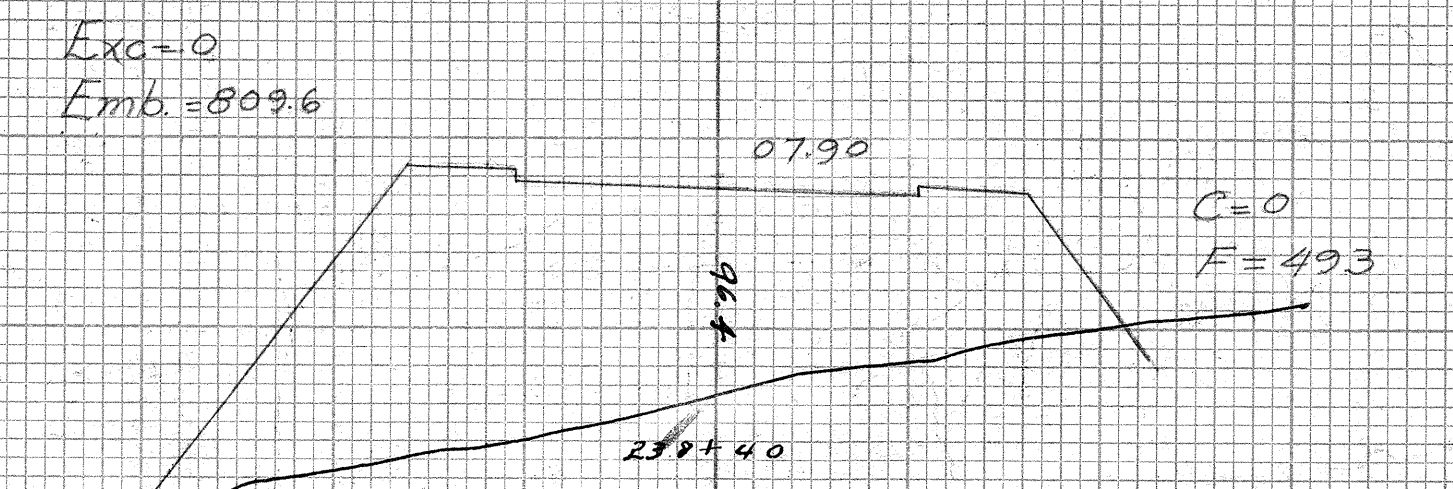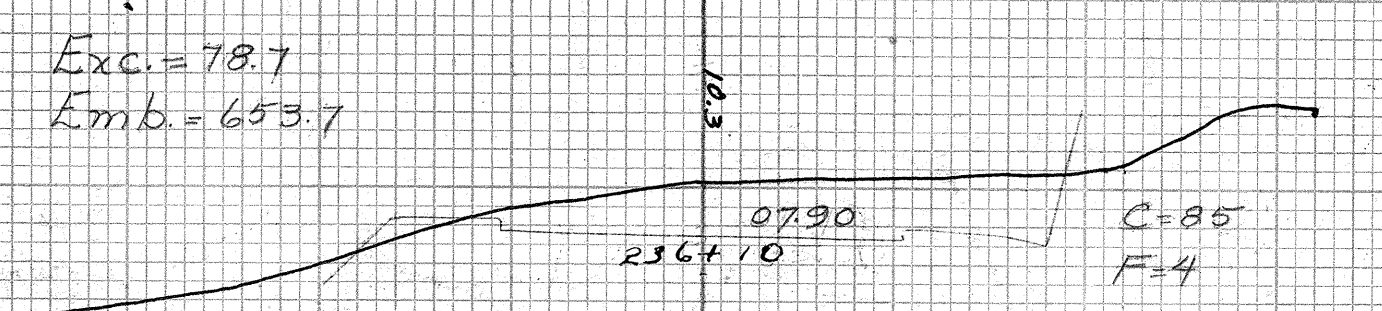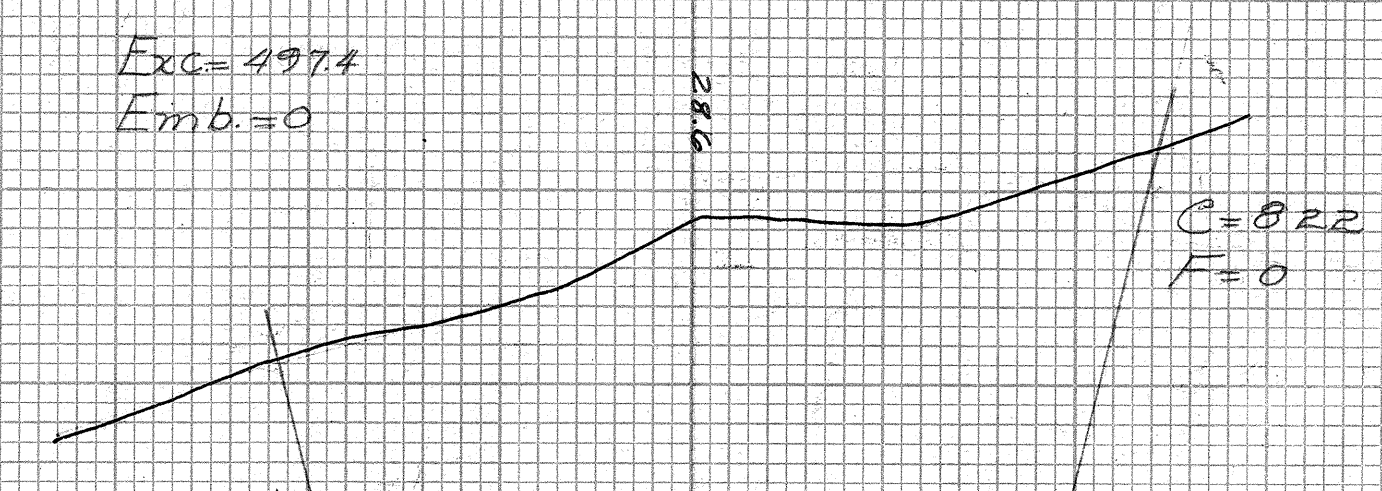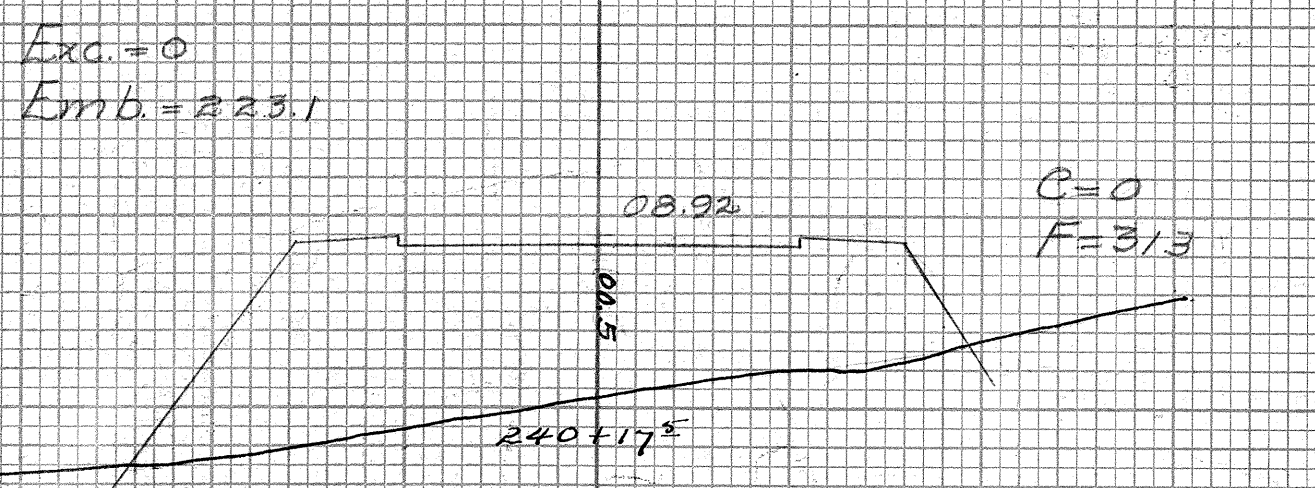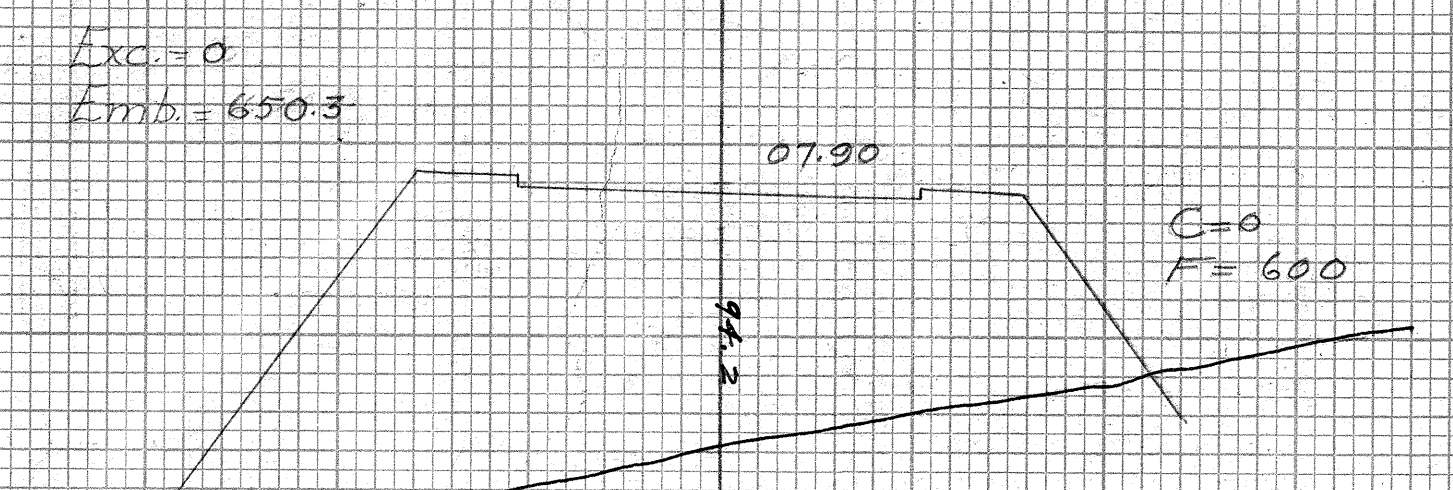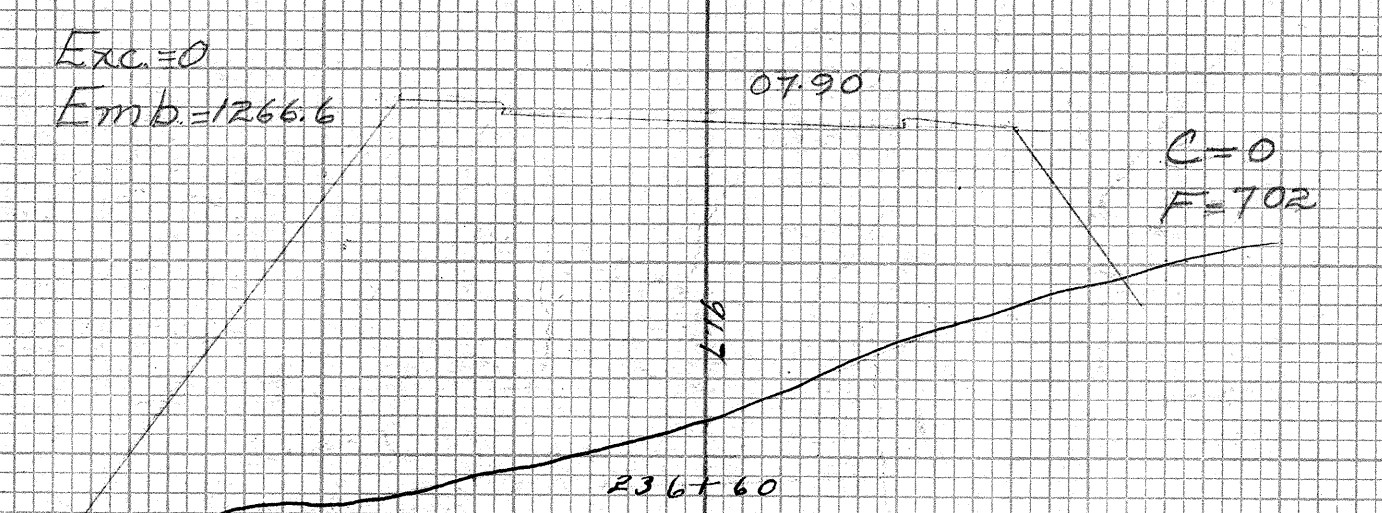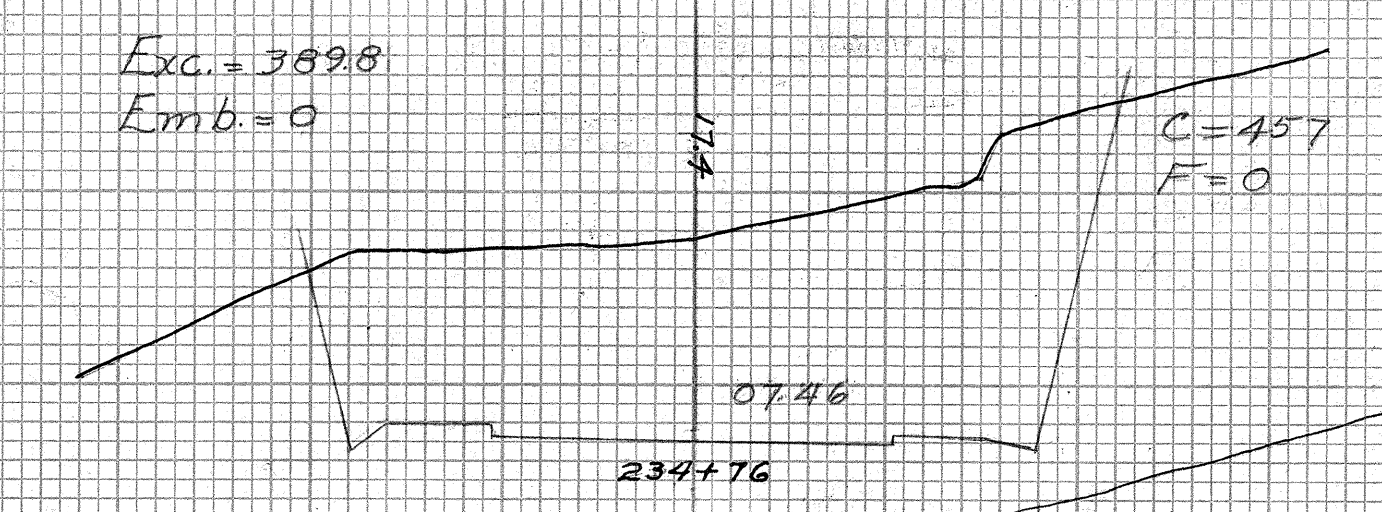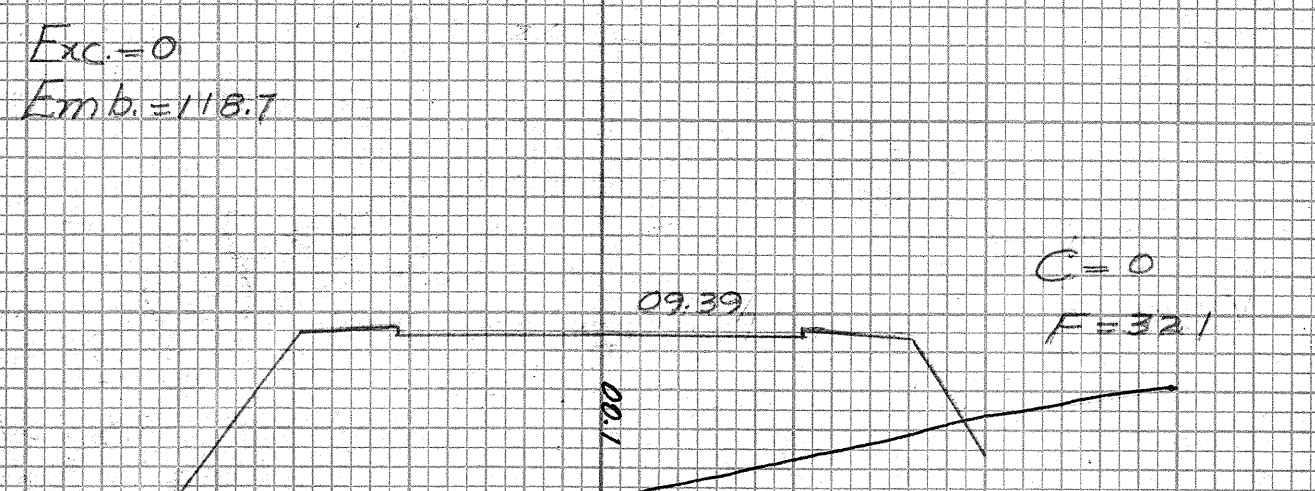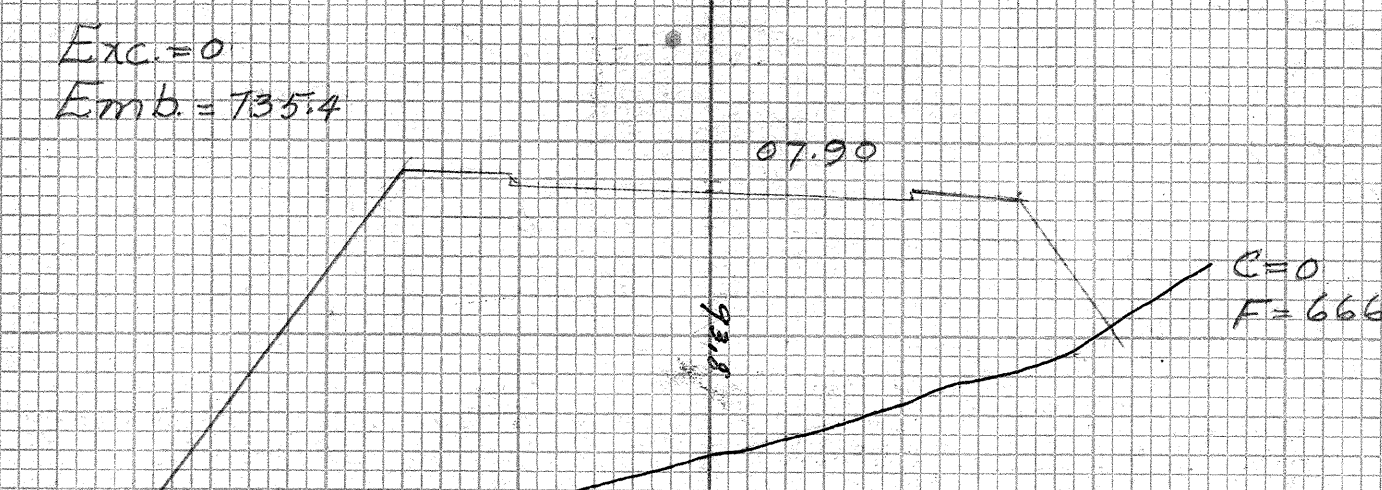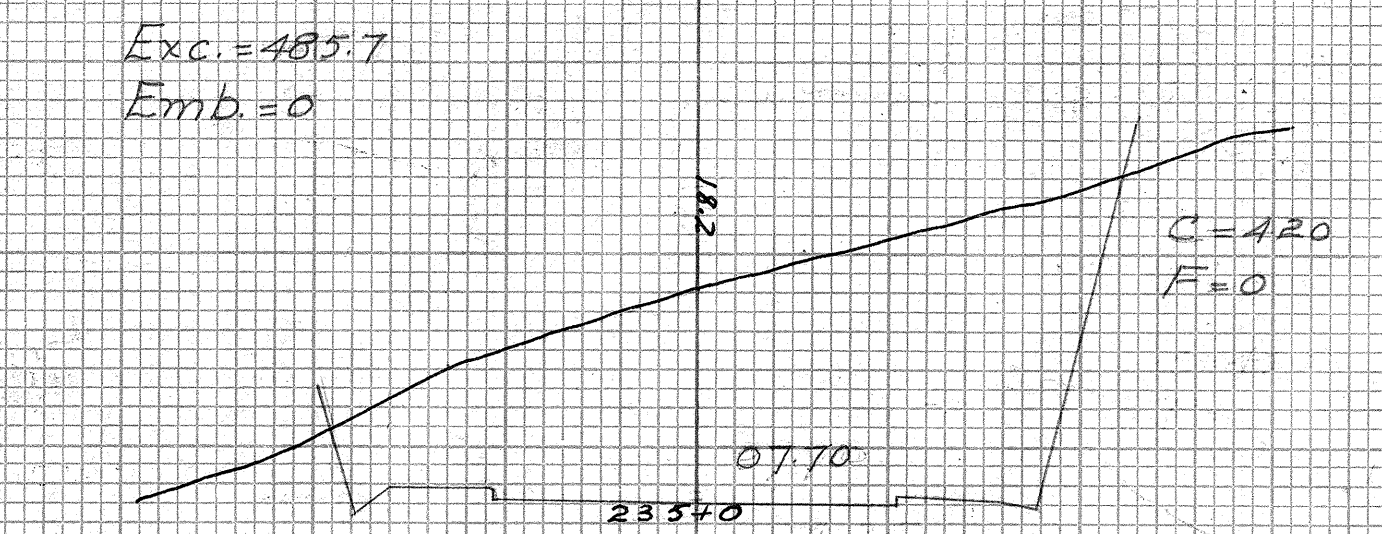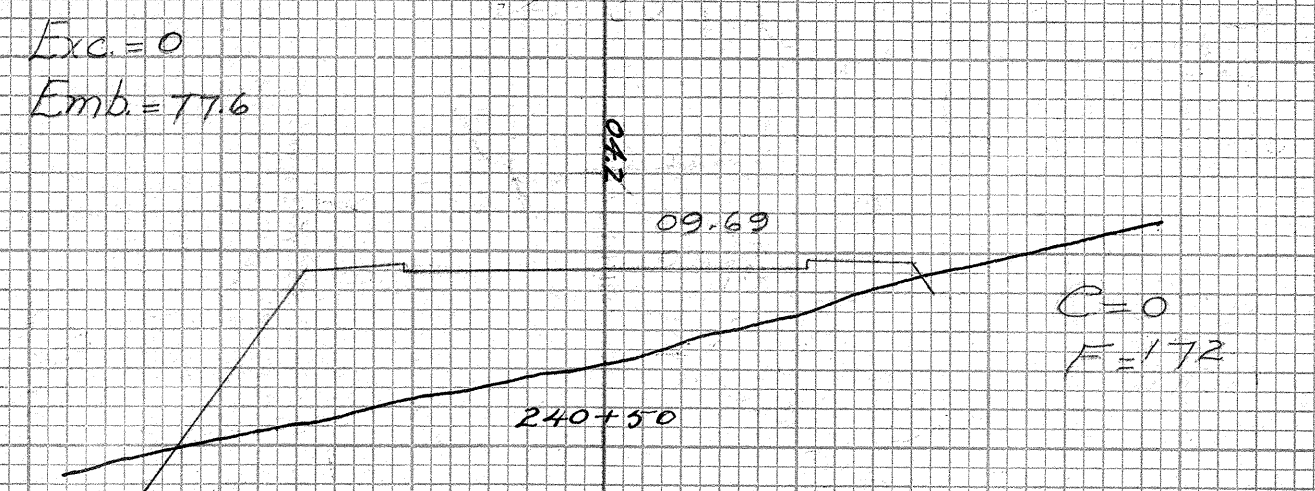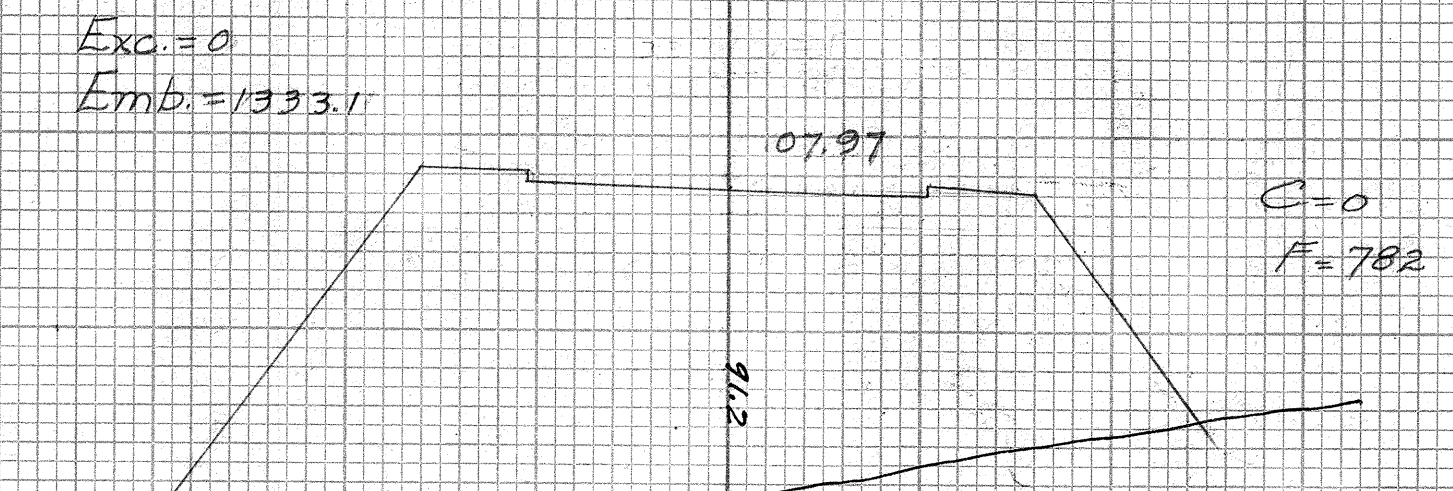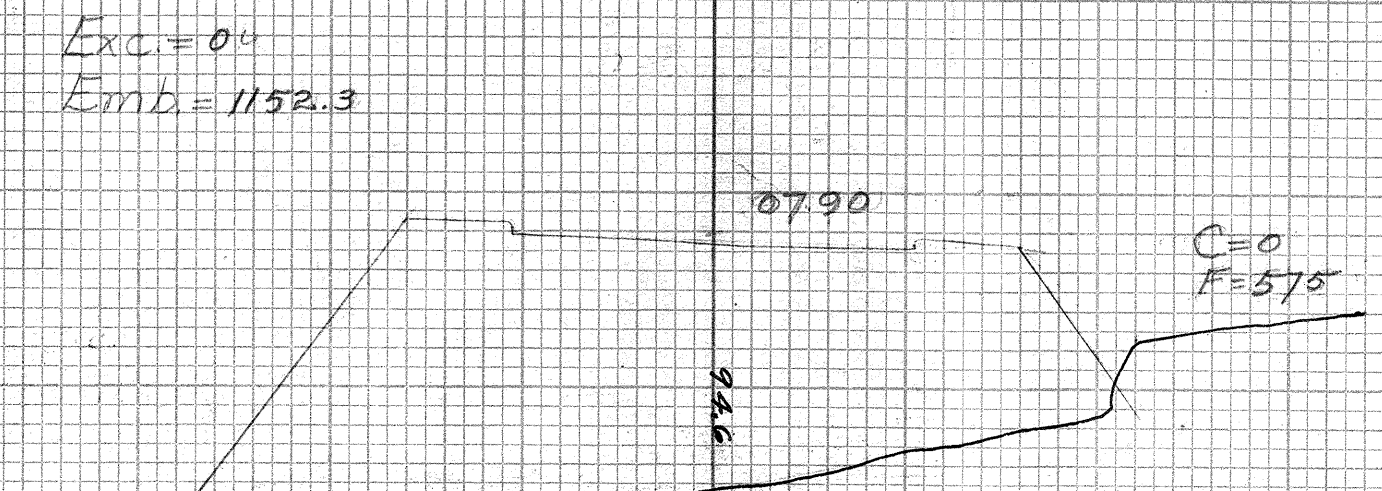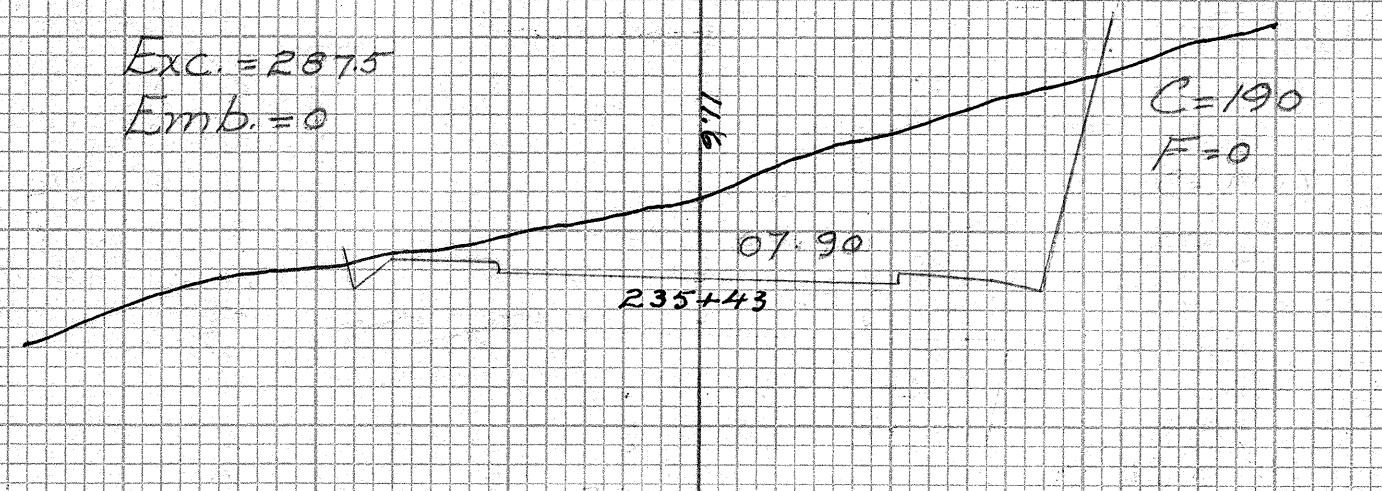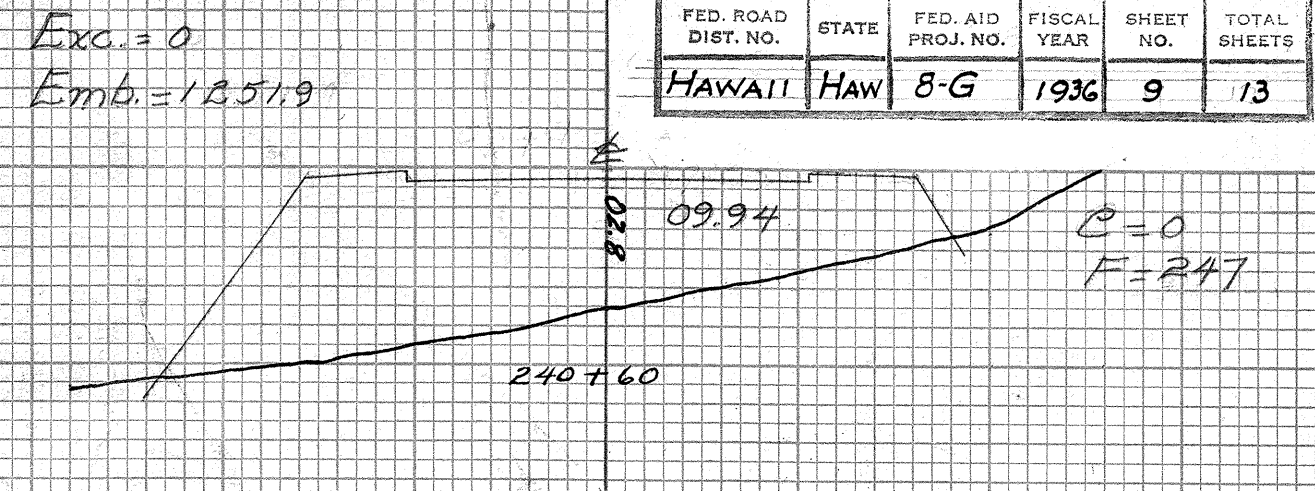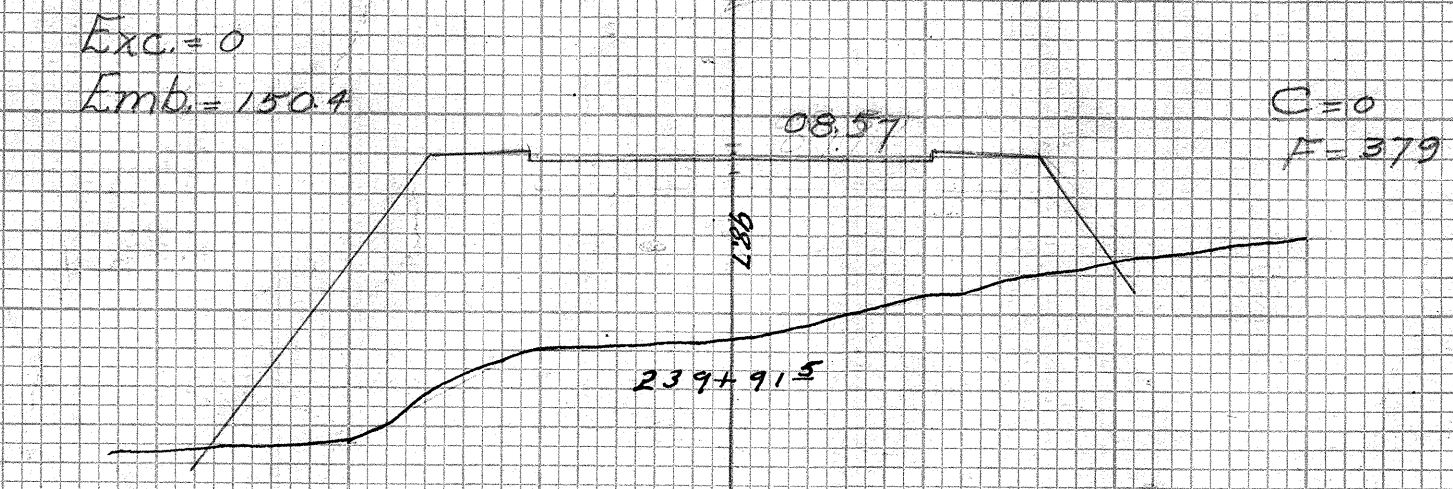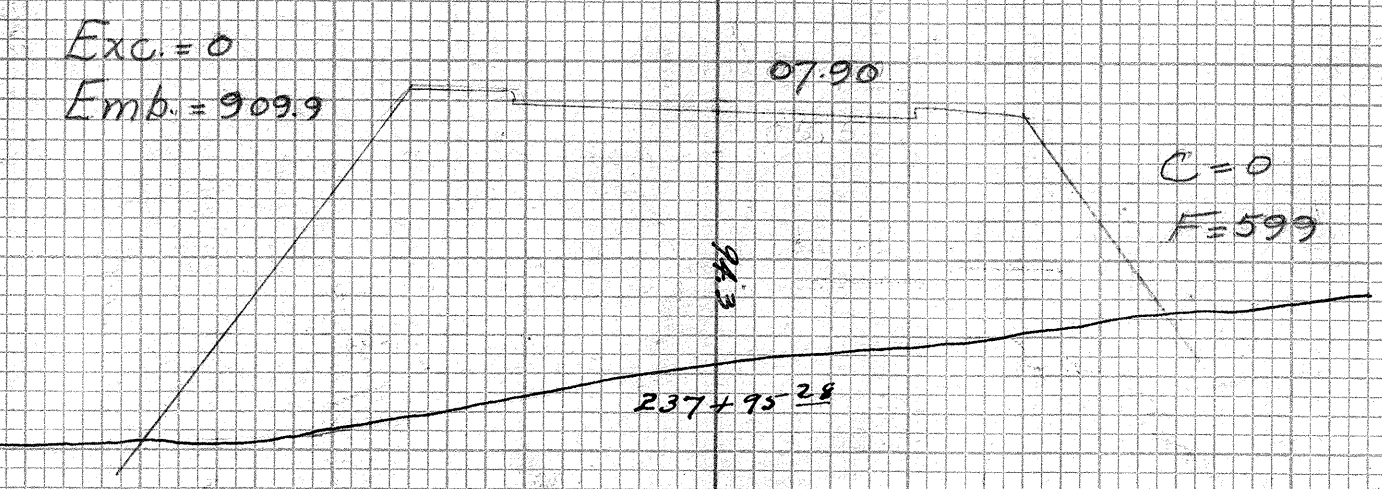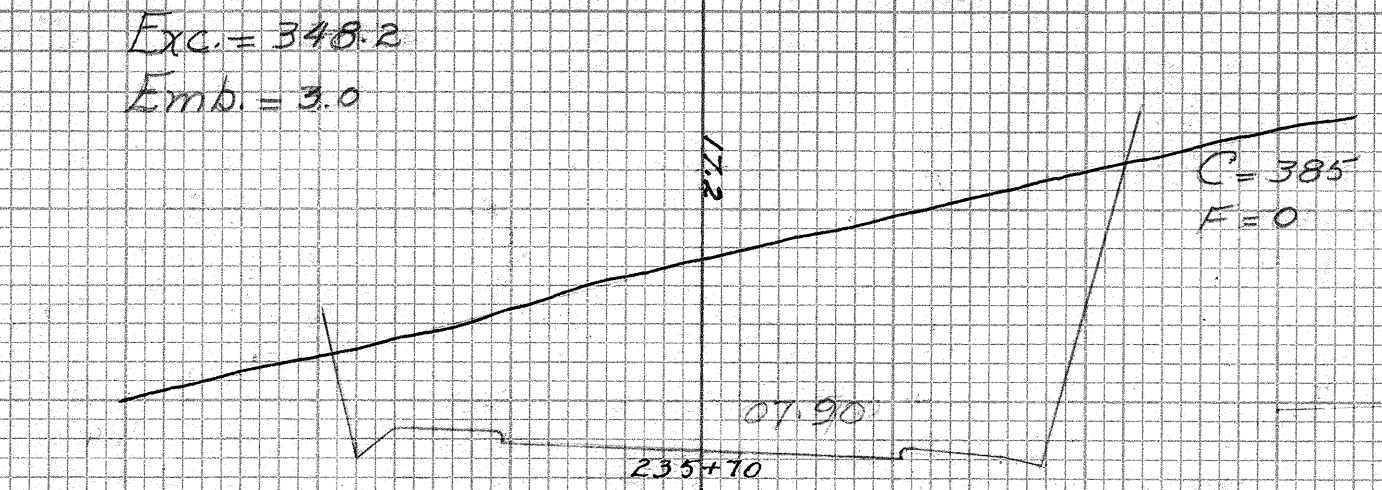

DATE _____ BY _____
 SURVEYED _____
 FINAL SURVEY _____
 NOTE BOOK _____
 NO. _____

DATE _____ BY _____
 SURVEYED _____
 ORIGINAL SURVEY _____
 NOTE BOOK _____
 NO. _____

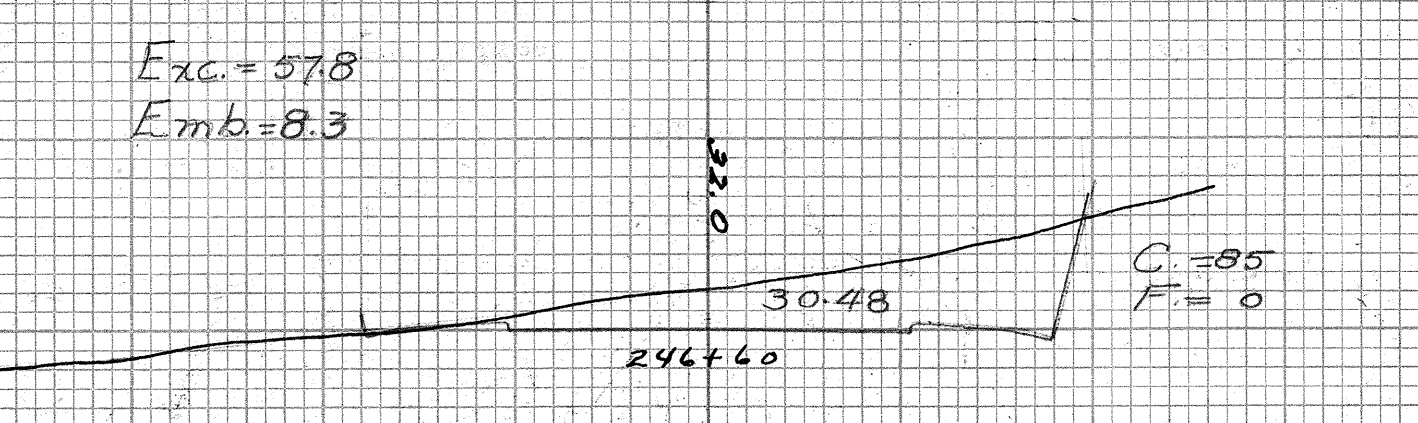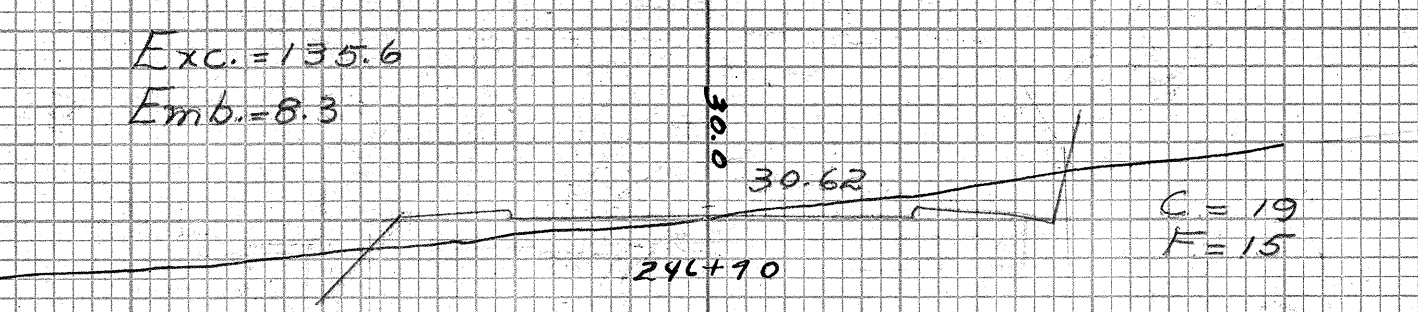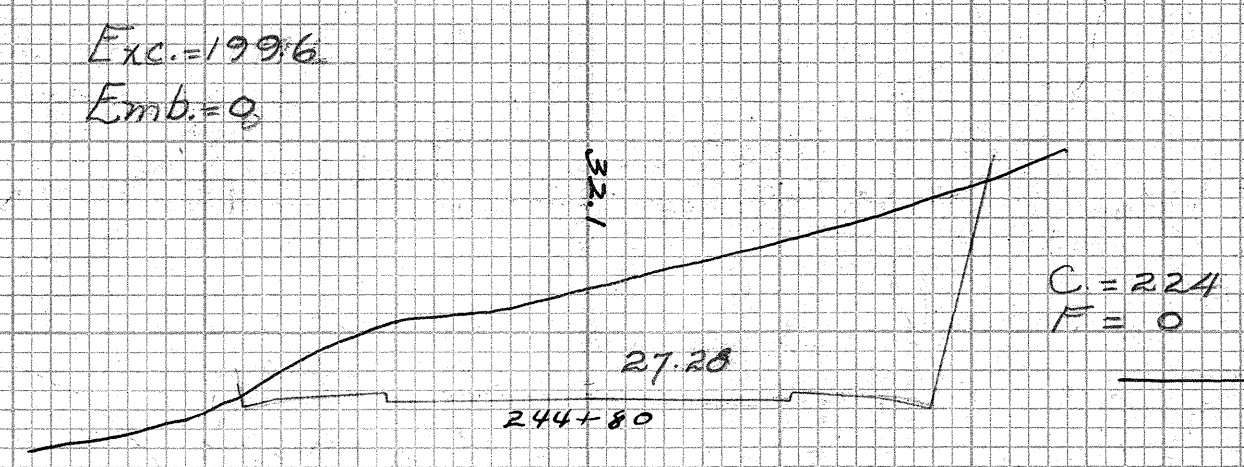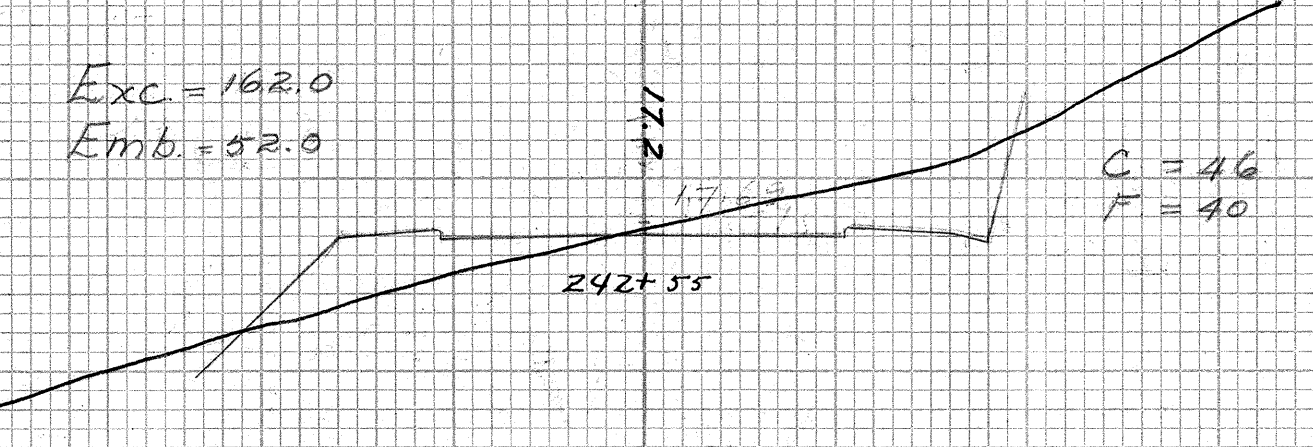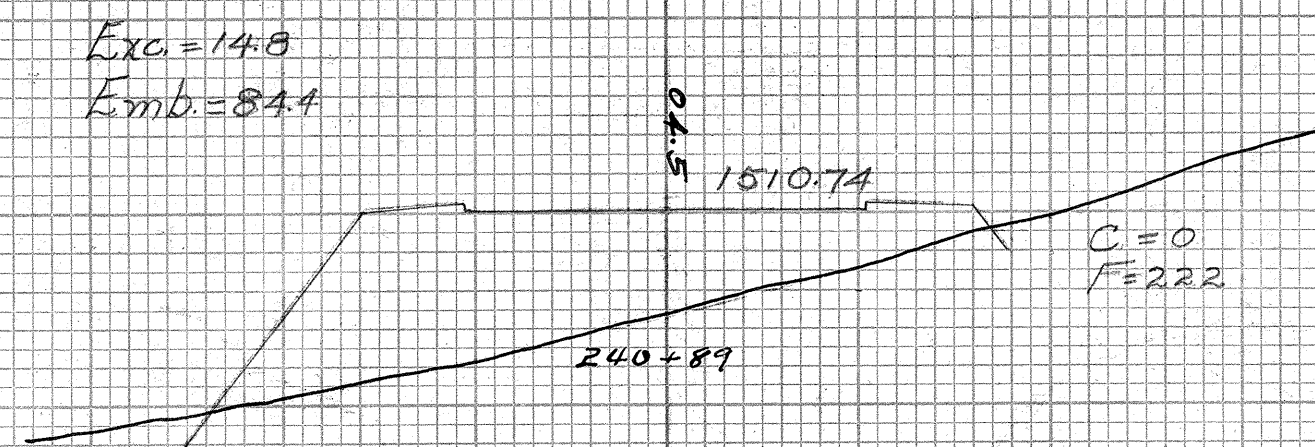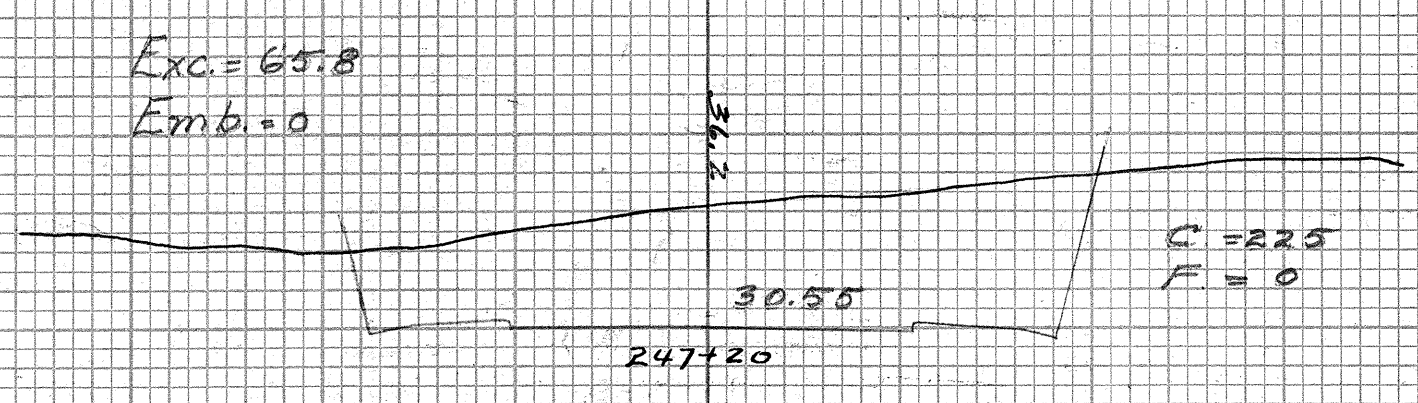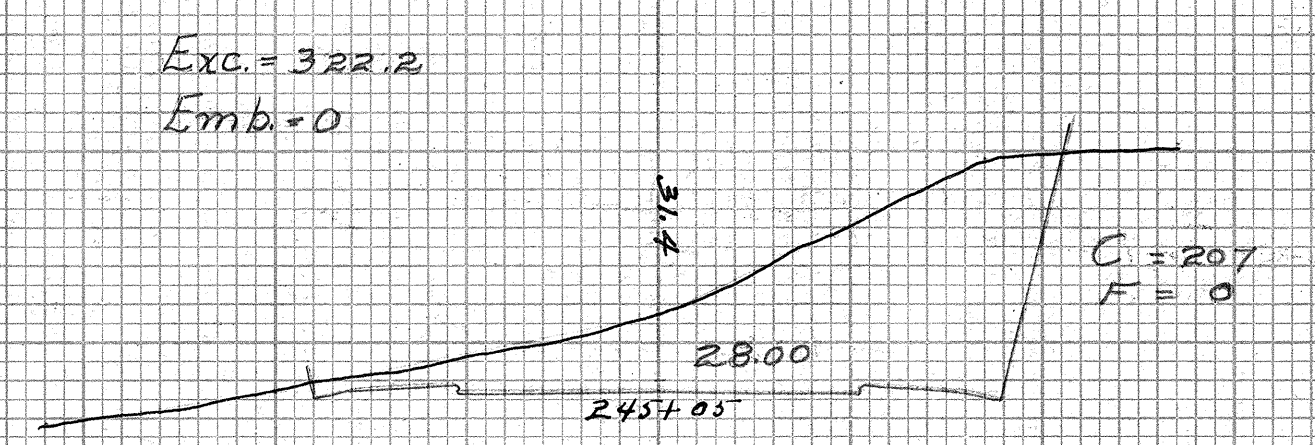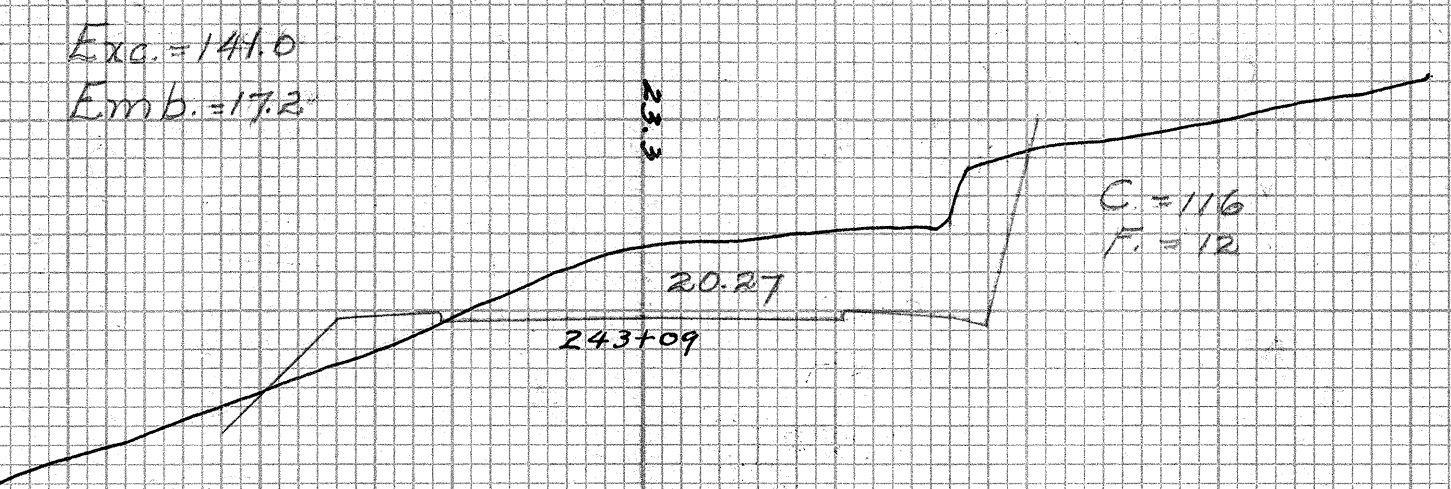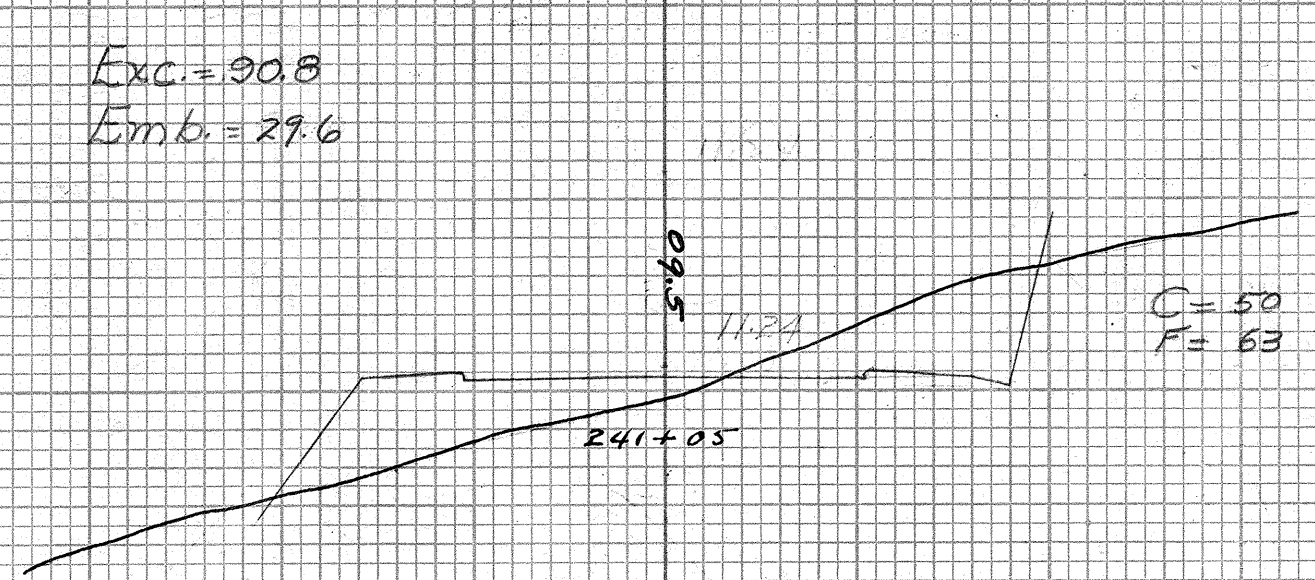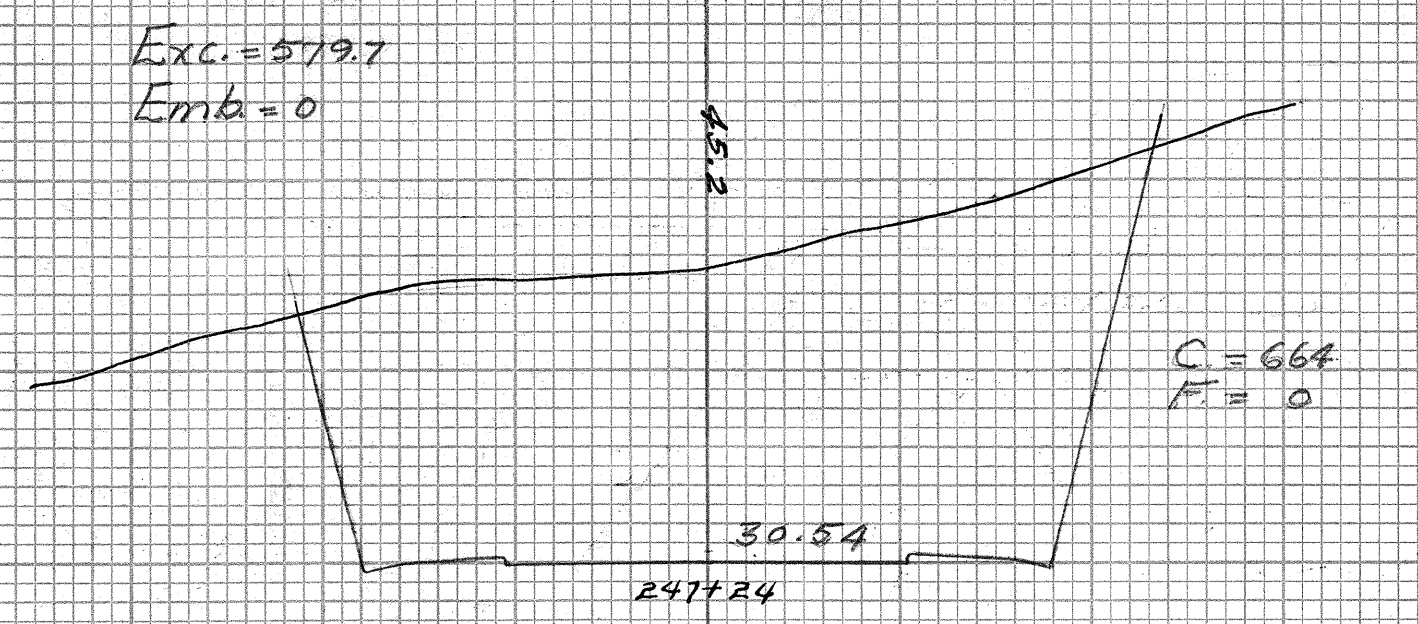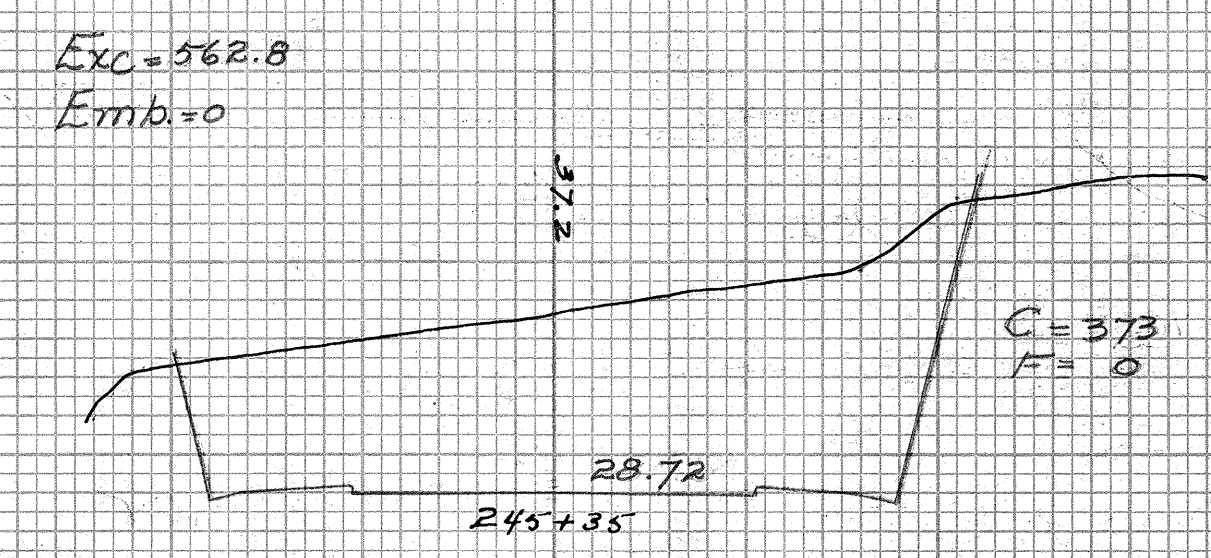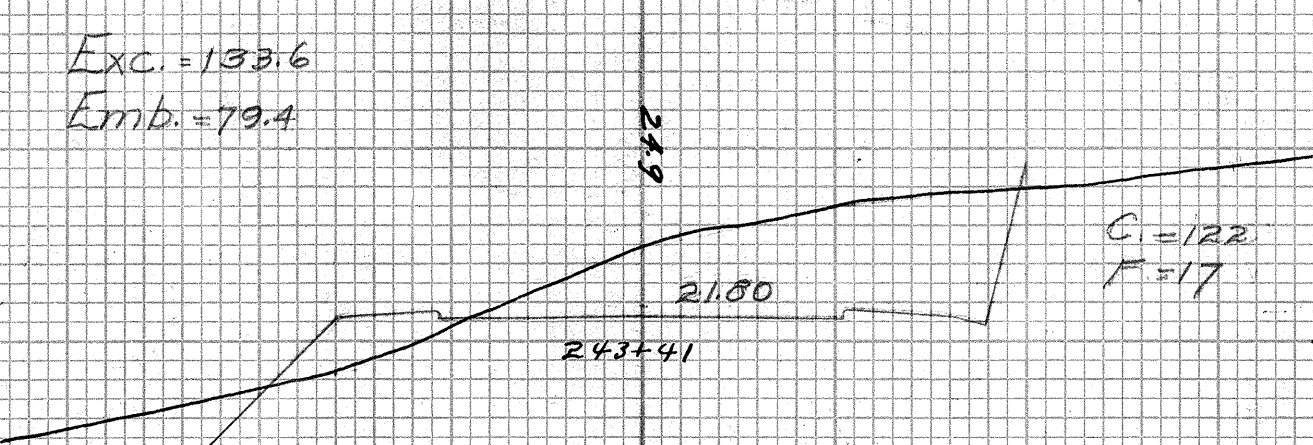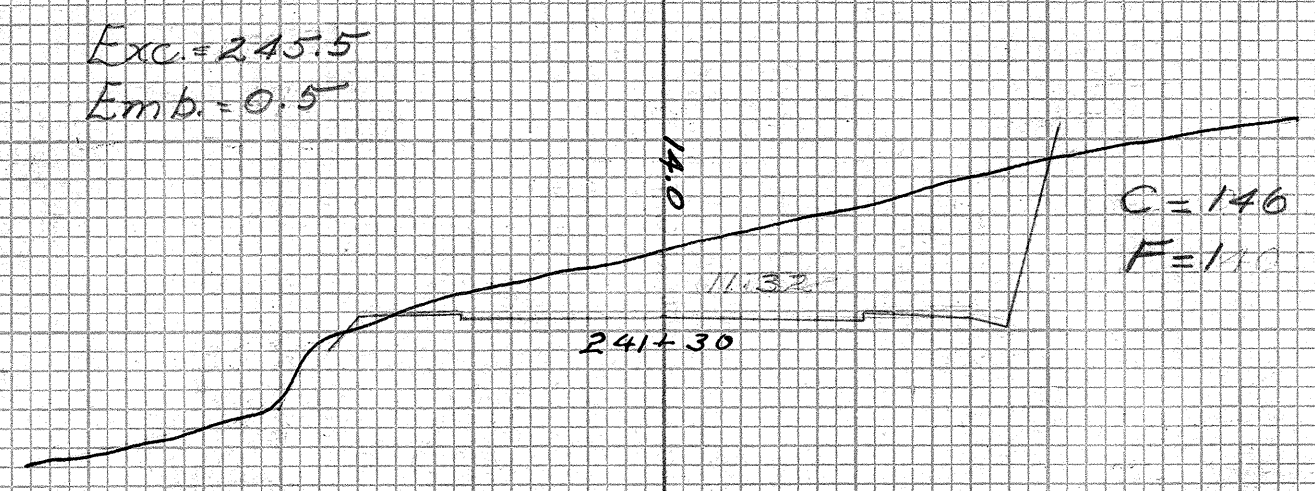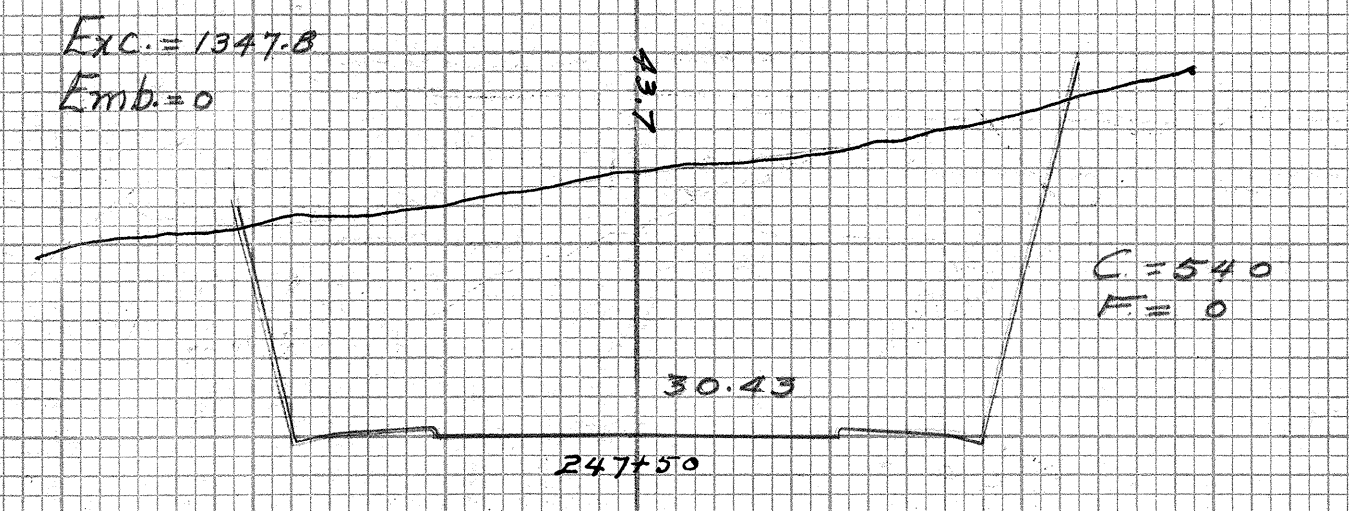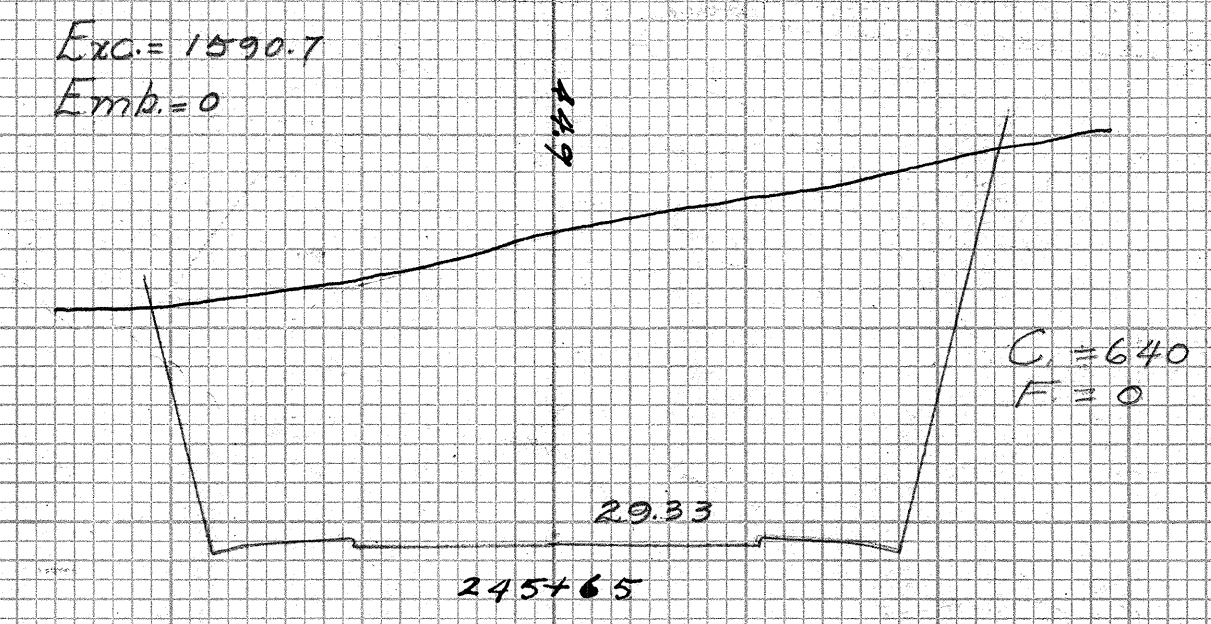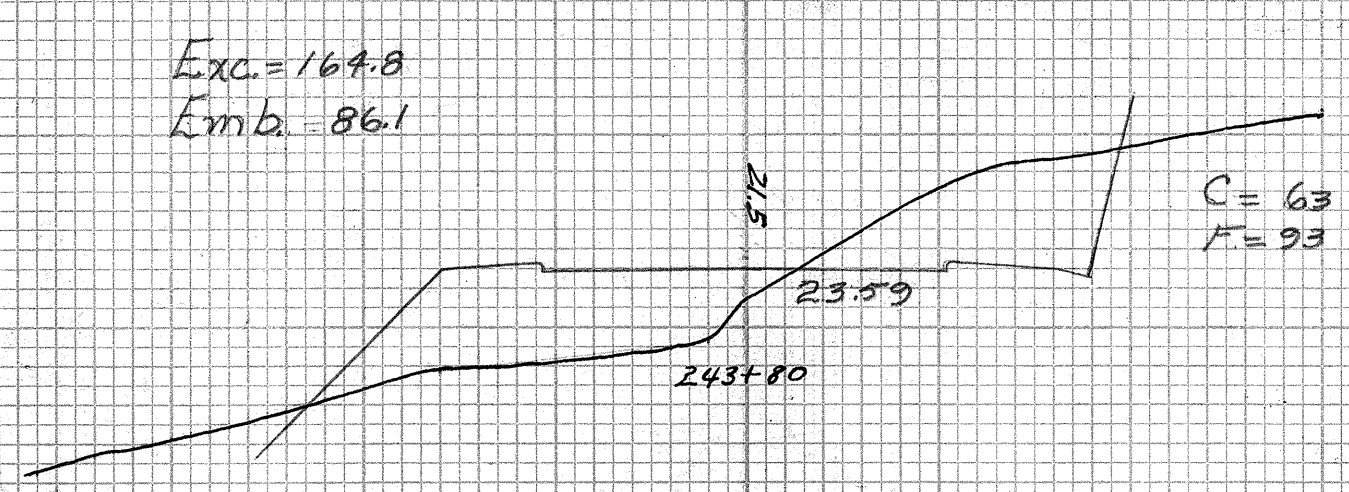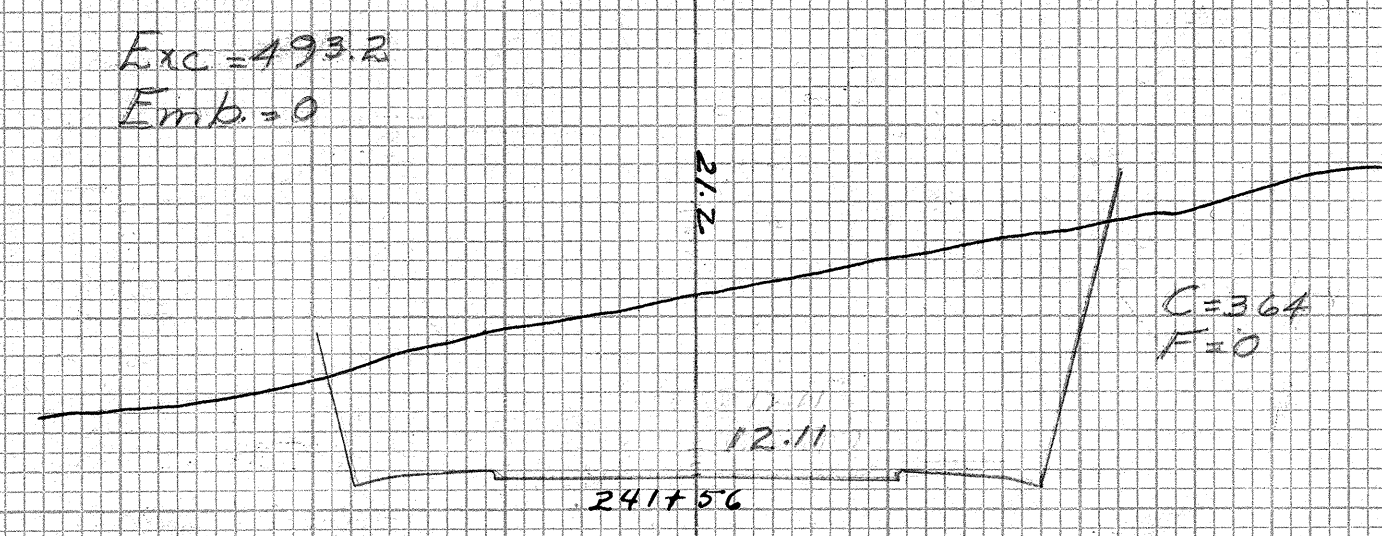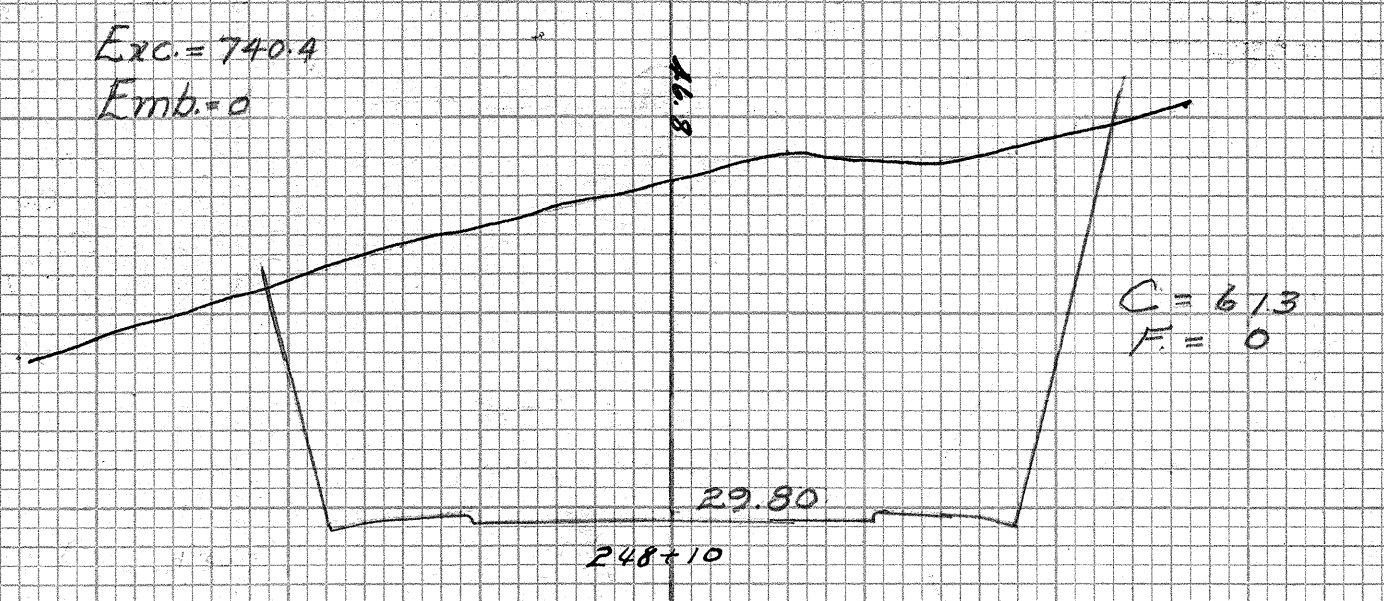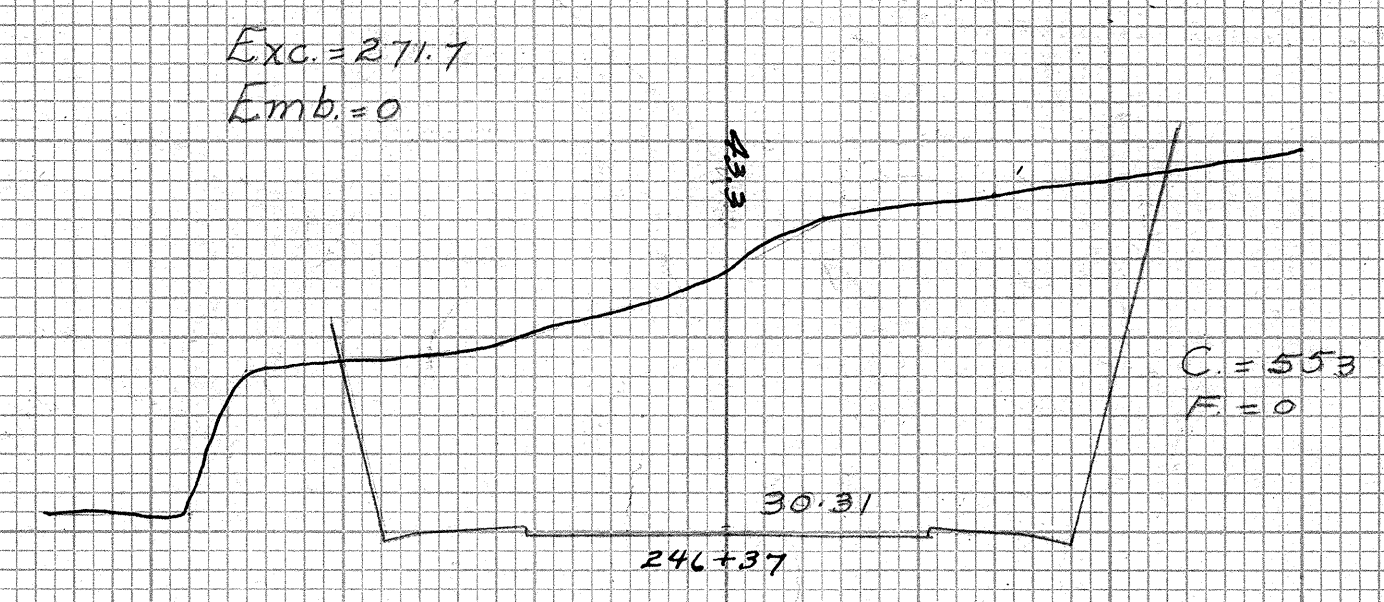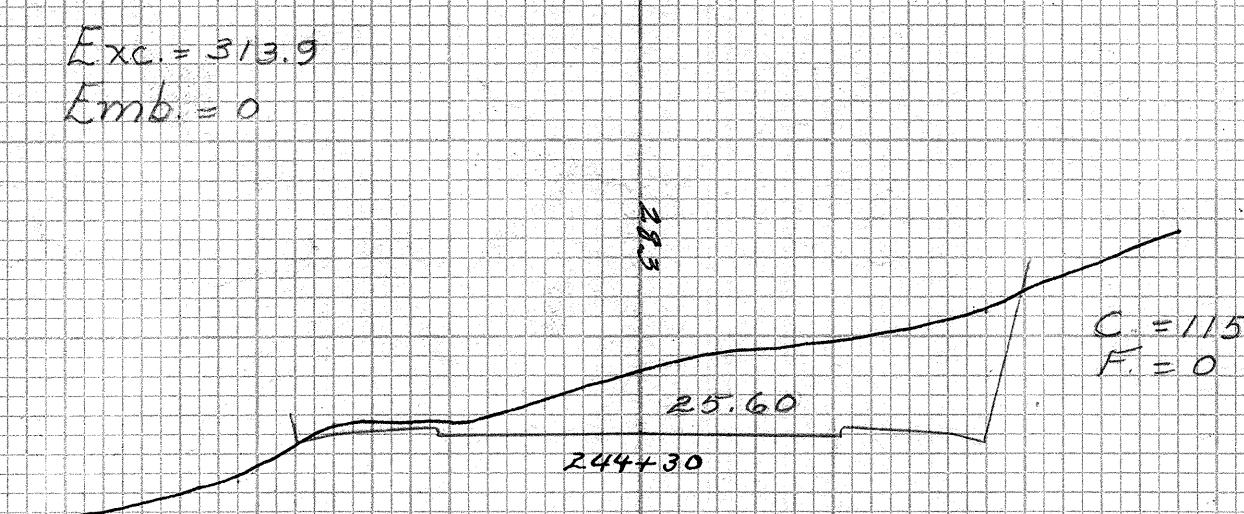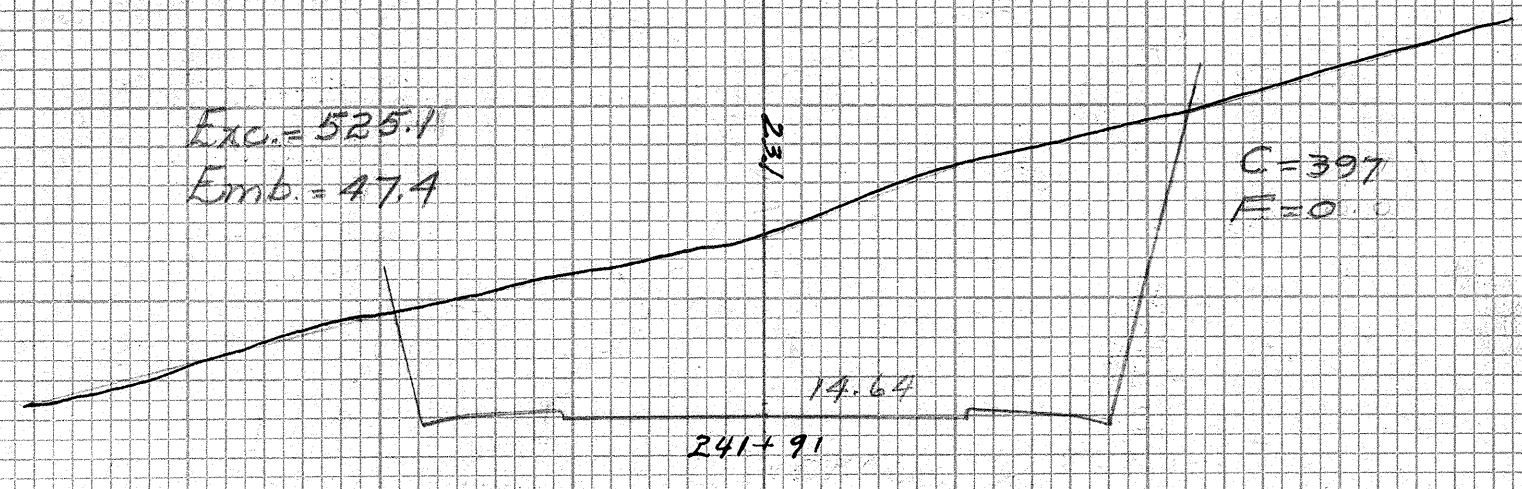


Roller by V.K.K.

FINAL SURVEY	DATE	BY
NOTE BOOK	11/19/55	C.H.X.
NO.		


ORIGINAL SURVEY	DATE	BY
NOTE BOOK	11/19/55	C.H.X.
NO.		

FED. ROAD DIST. NO.	STATE	FED. AID PROJ. NO.	FISCAL YEAR	SHEET NO.	TOTAL SHEETS
HAWAII	HAW	8-G	1956	11	13


Exc.=0
Emb.=1177.0

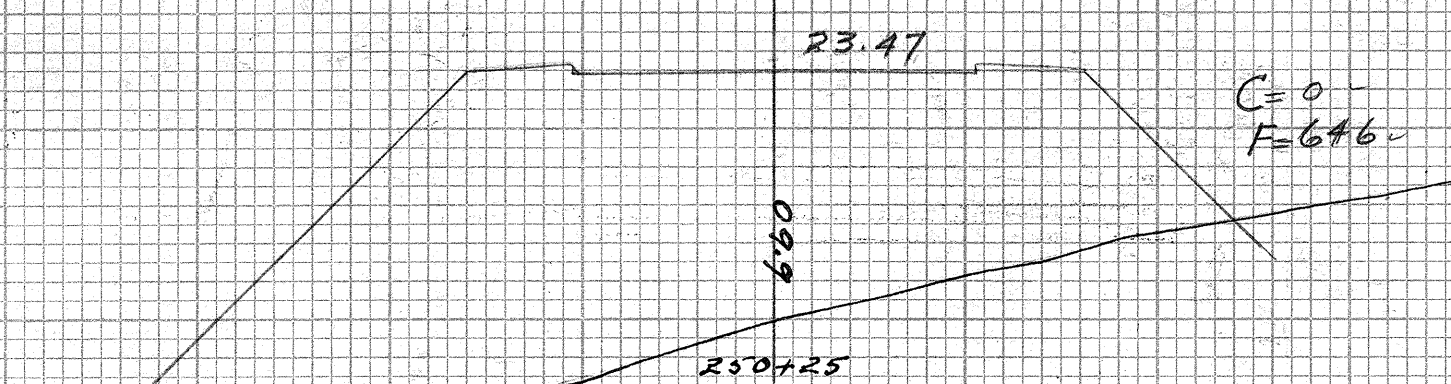


Exc.=563.5
Emb.=0

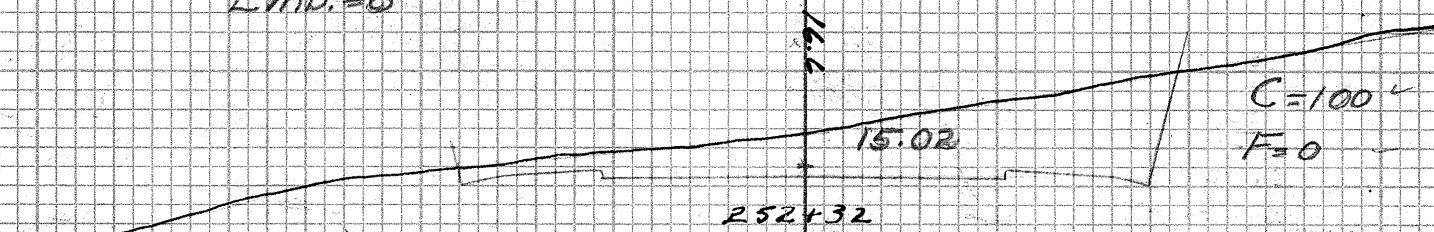


Exc.=126.0
Emb.=0

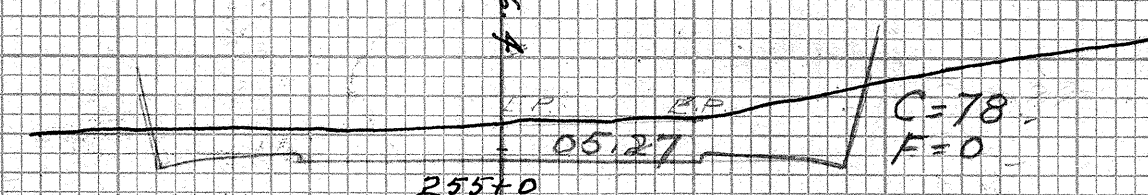


Exc.=116.7
Emb.=18.7

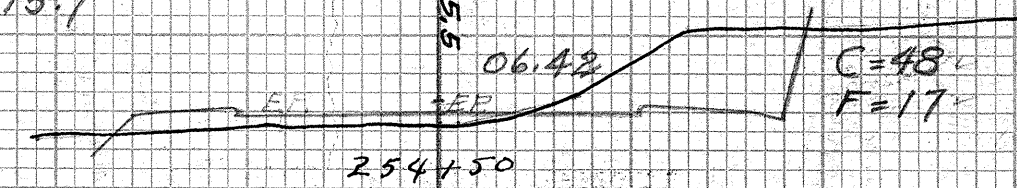


Exc.=51.3
Emb.=419.5

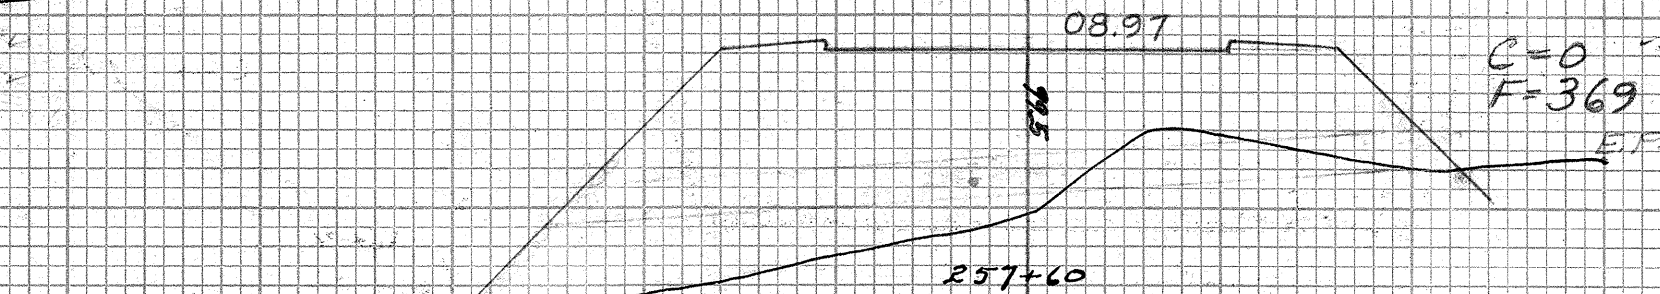


Exc.=0
Emb.=1020.7

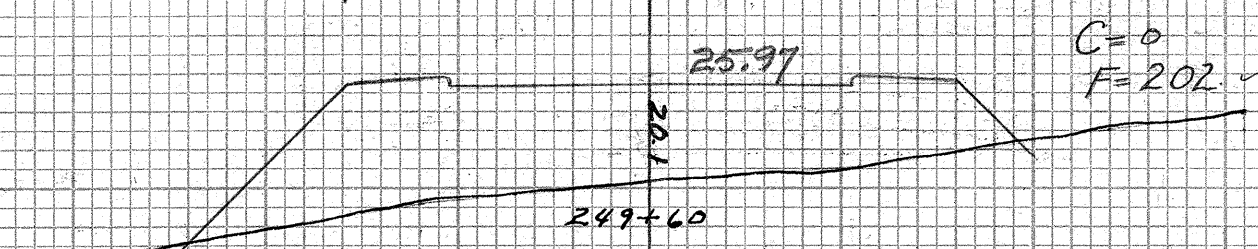


Exc.=68.5
Emb.=80.2

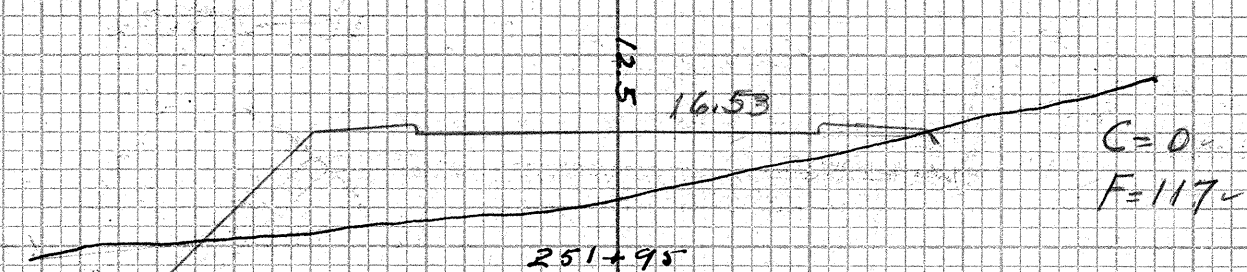


Exc.=78.7
Emb.=56.5

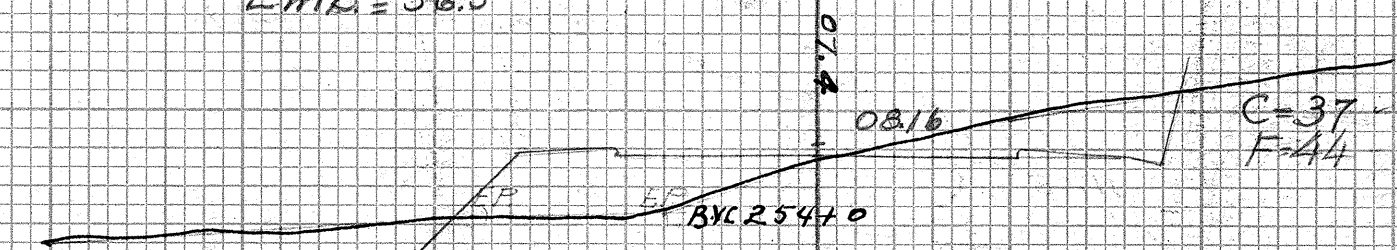


Exc.=20.0
Emb.=513.4

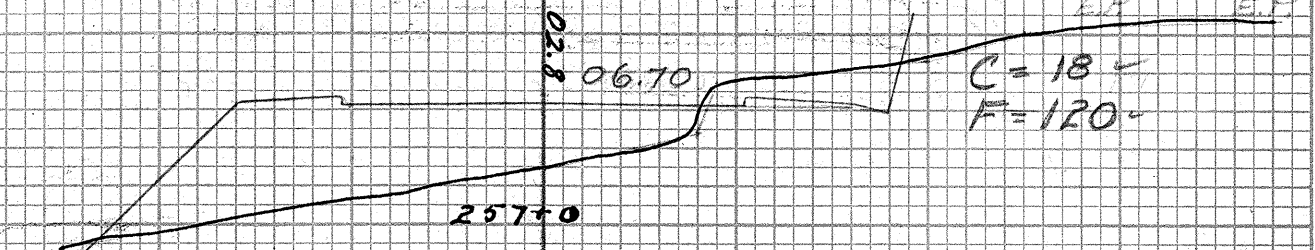


Exc.=0
Emb.=369.5

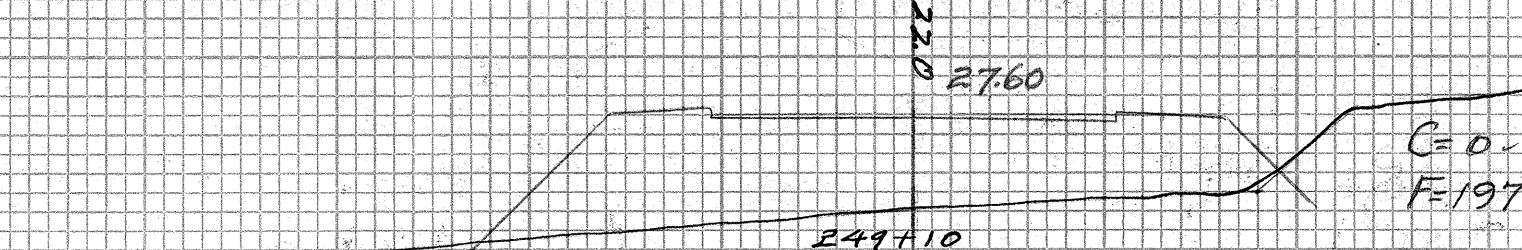


Exc.=0
Emb.=233.3

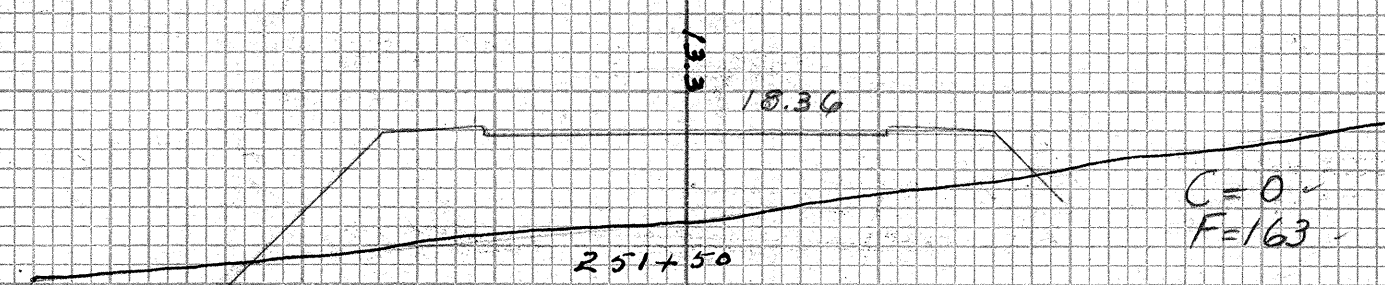


Exc.=36.1
Emb.=131.5

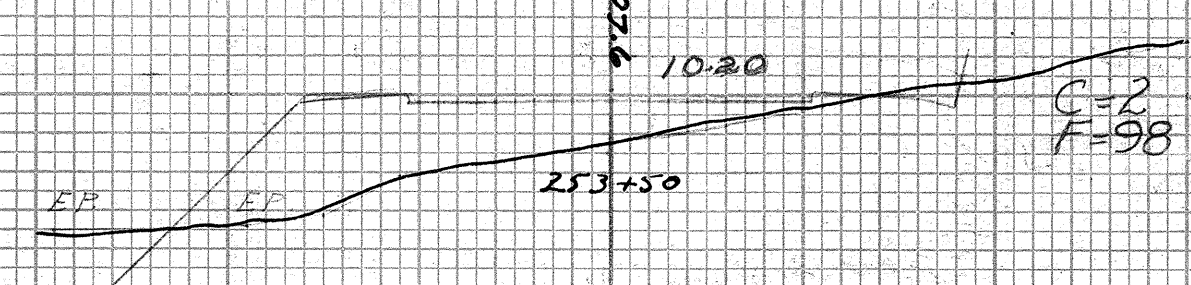


Exc.=16.7
Emb.=315.7

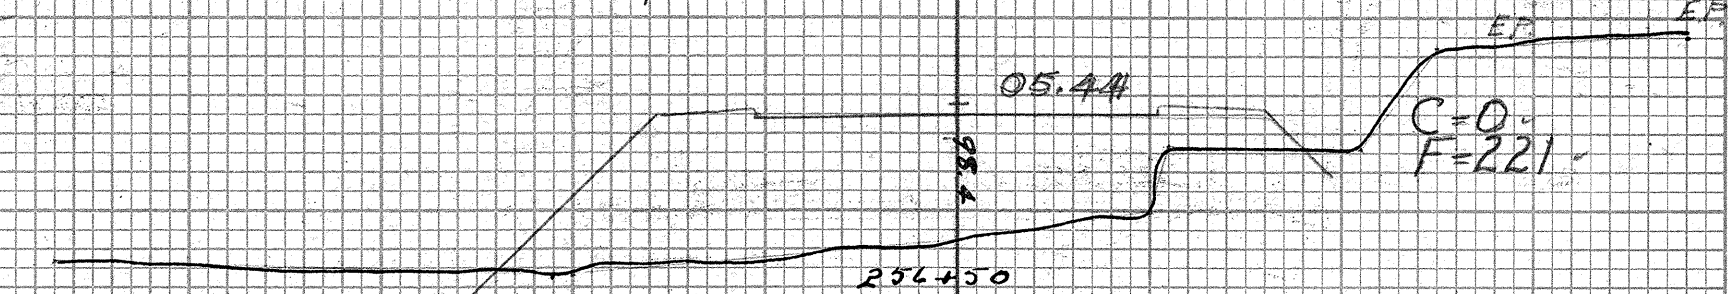


Exc.=13.3
Emb.=155.0

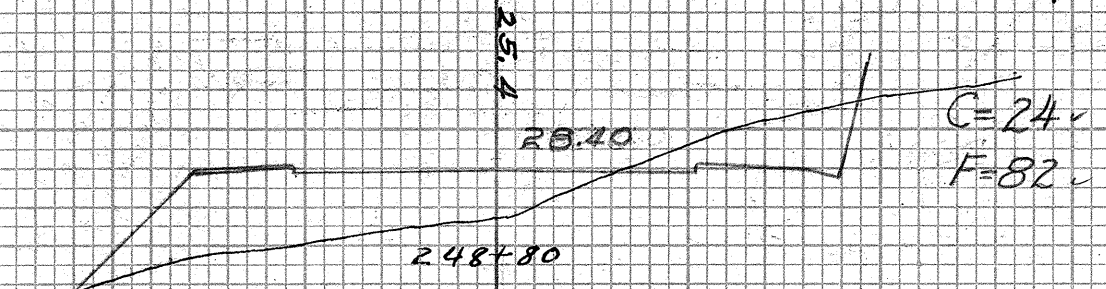


Exc.=0
Emb.=224.3

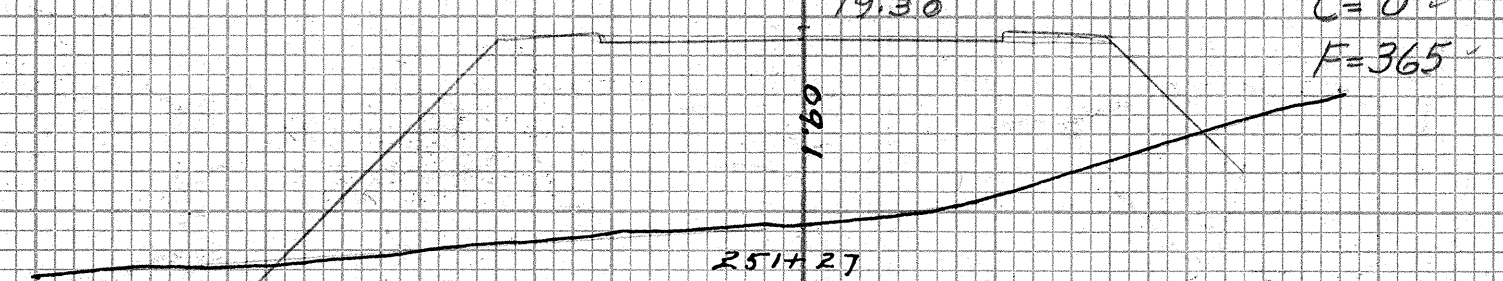


Exc.=31.1
Emb.=83.3

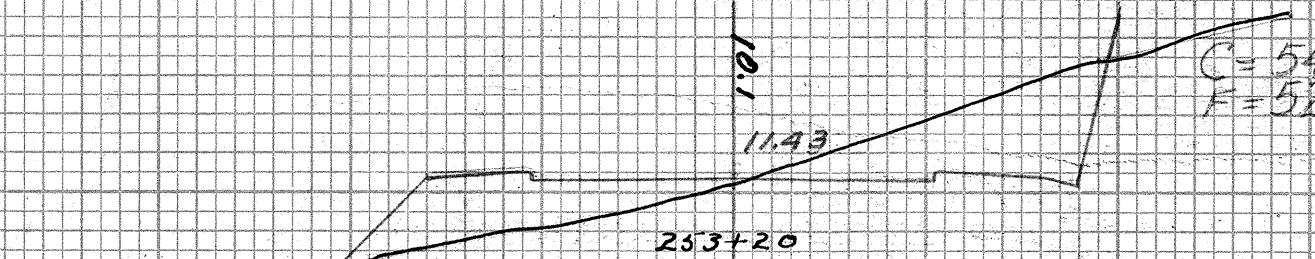


Exc.=15.3
Emb.=326.7

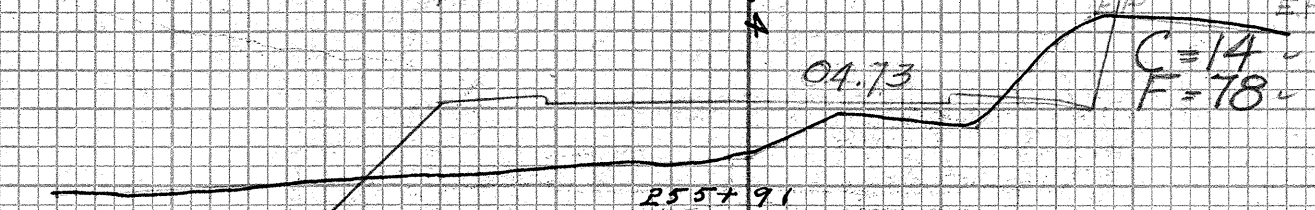


Exc.=75.0
Emb.=33.4

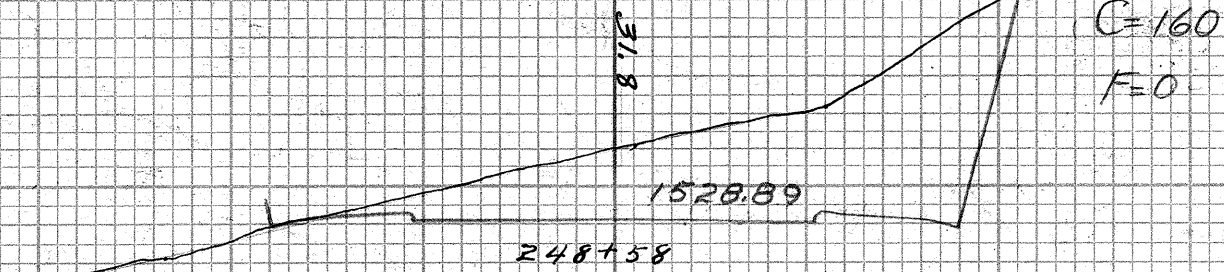


Exc.=0
Emb.=953.3

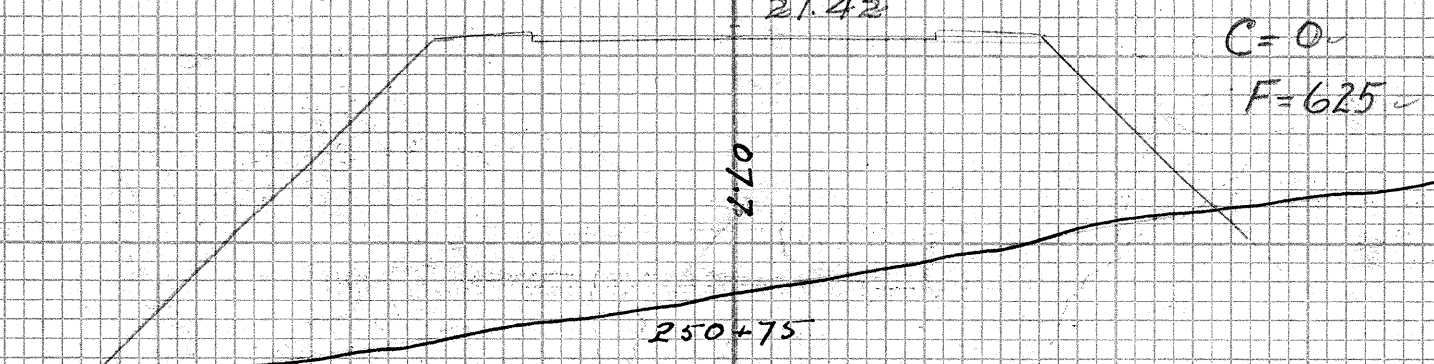

Exc.=202.3
Emb.=24.1

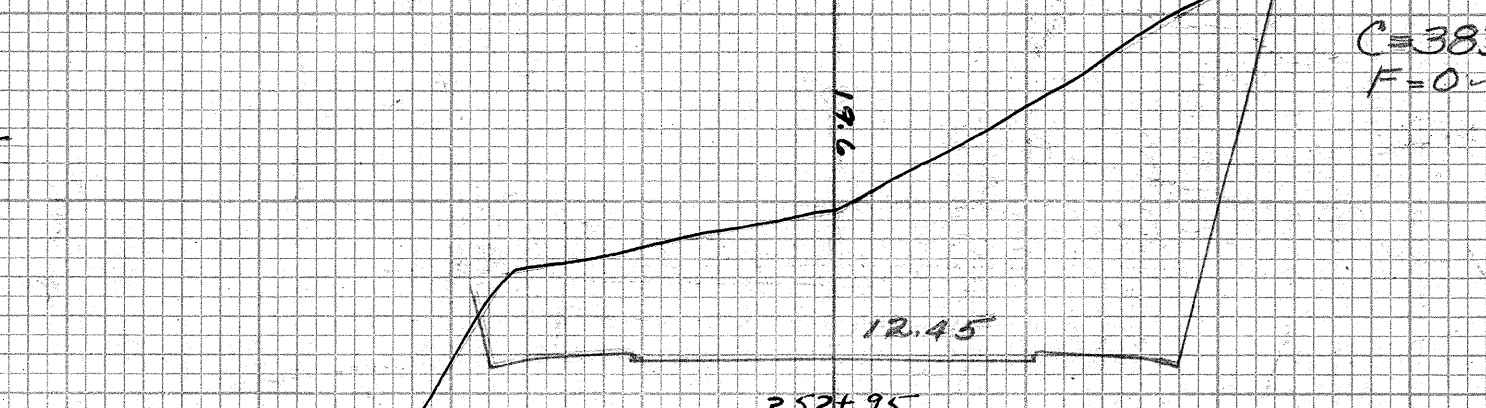























Exc.=94.5
Emb.=72.2

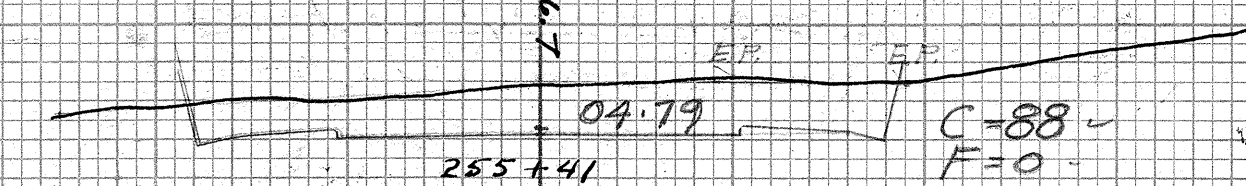

DATE	BY	SURVEYED	PLOTTED	NOTE BOOK	AREAS CHECKED

DATE	BY	SURVEYED	PLOTTED	NOTE BOOK	AREAS CHECKED
11-31					

FED. ROAD DIST. NO.	STATE	FED. AID PROJ. NO.	FISCAL YEAR	SHEET NO.	TOTAL SHEETS
HAWAII HAW.		8-G	1936	12	13

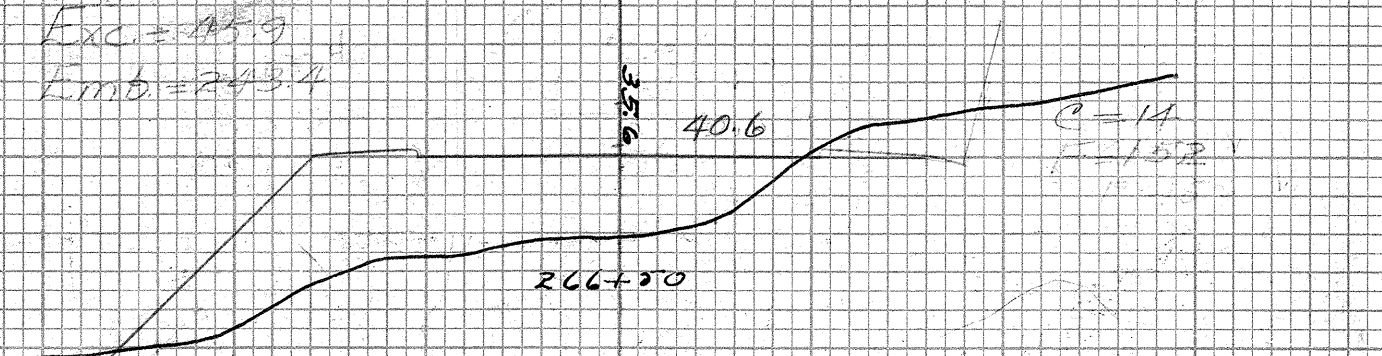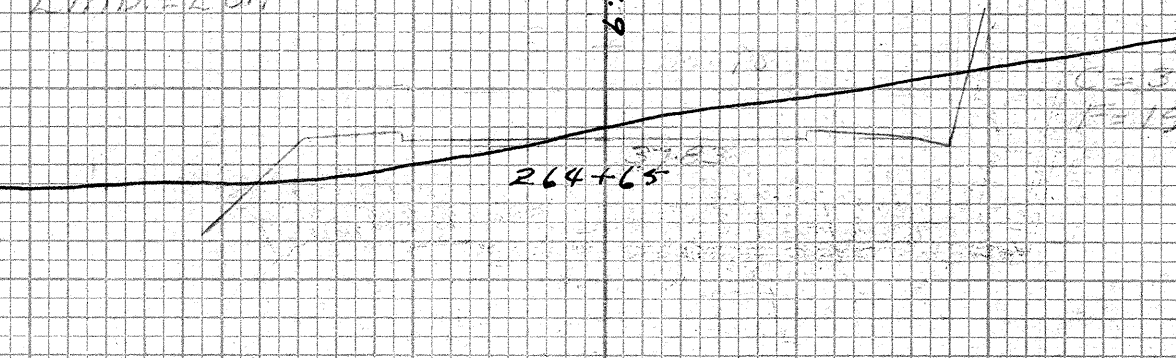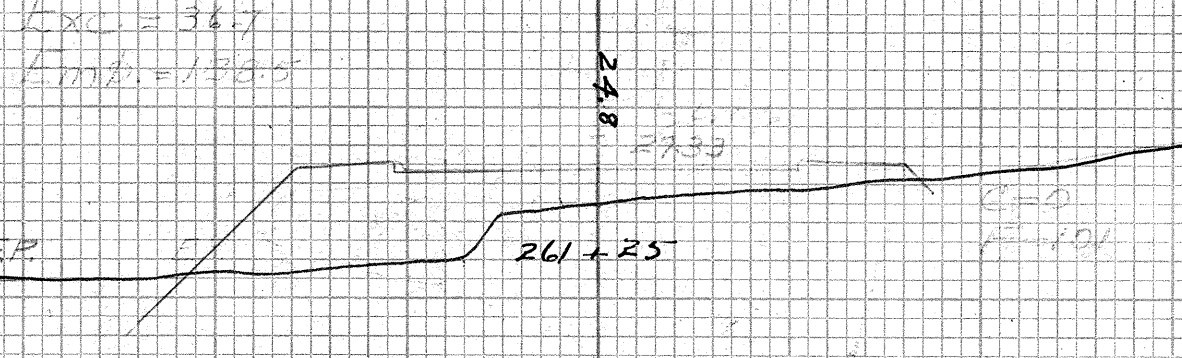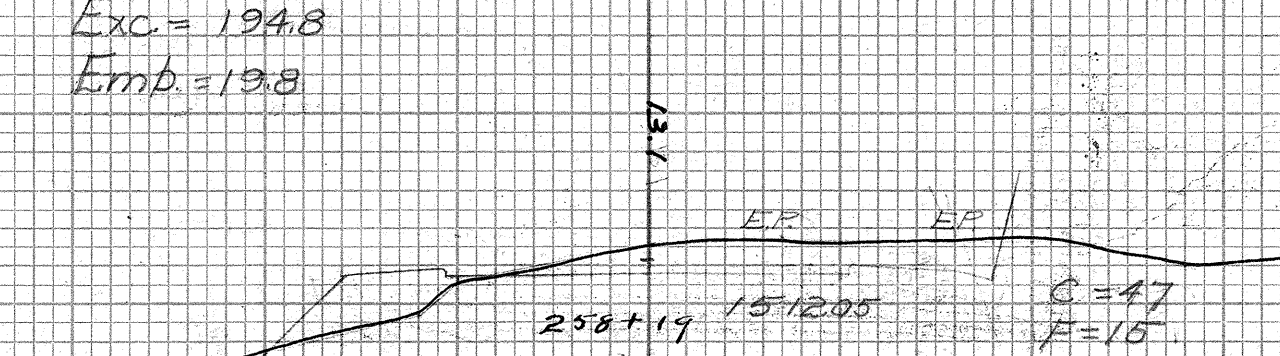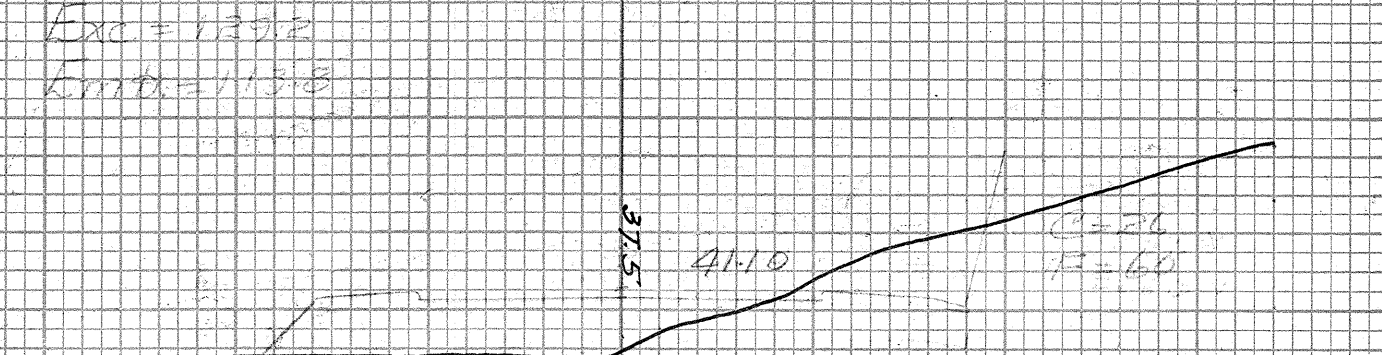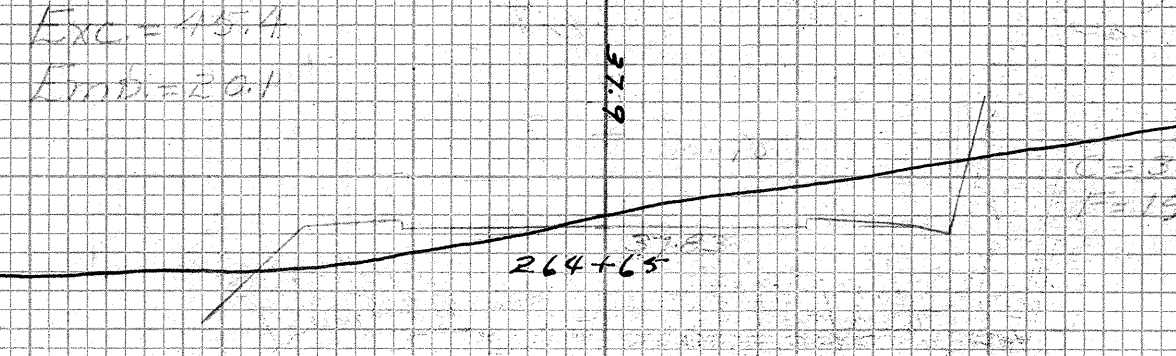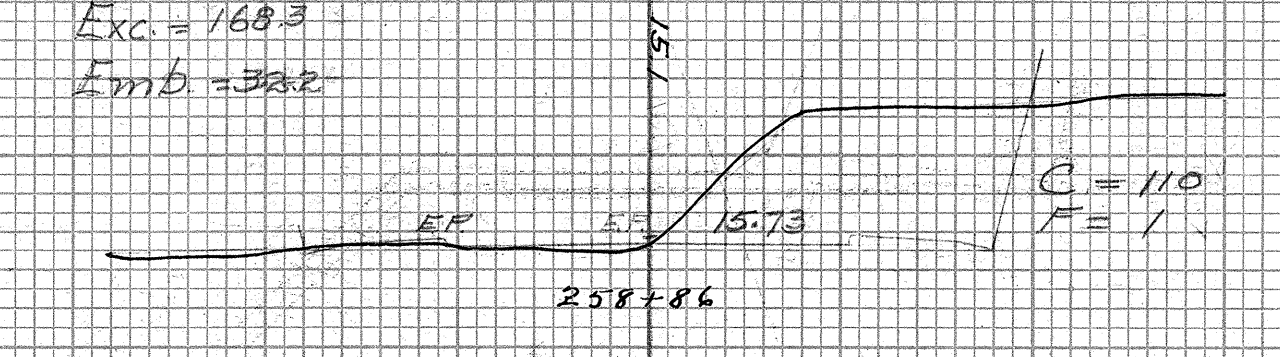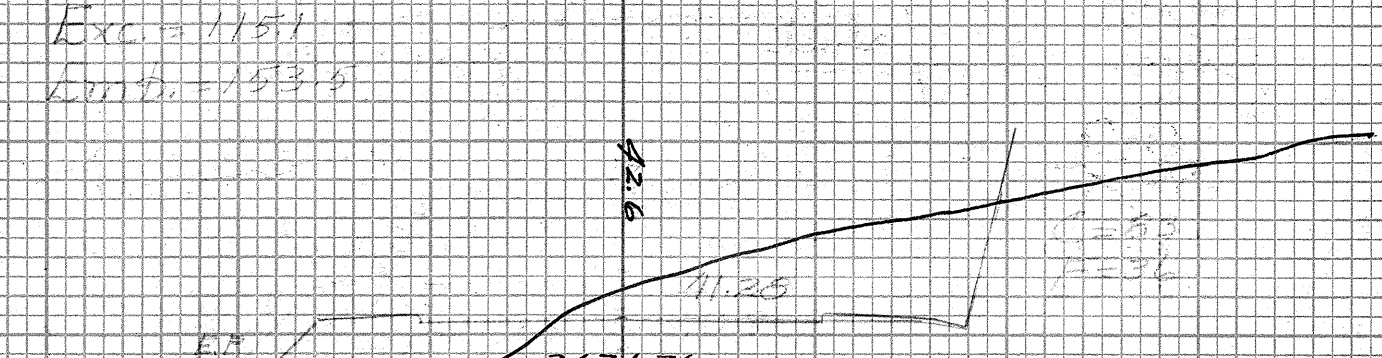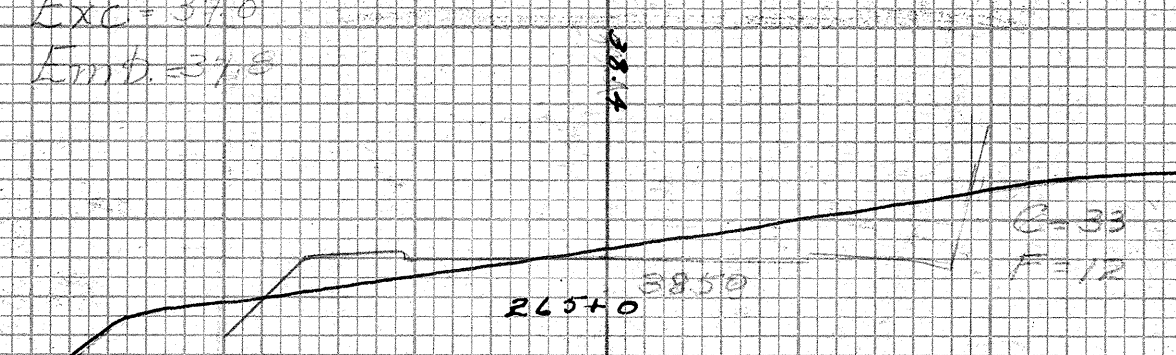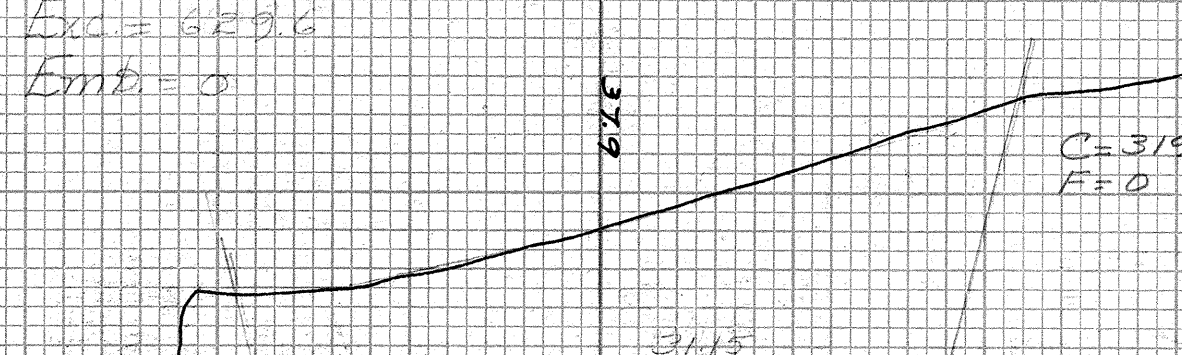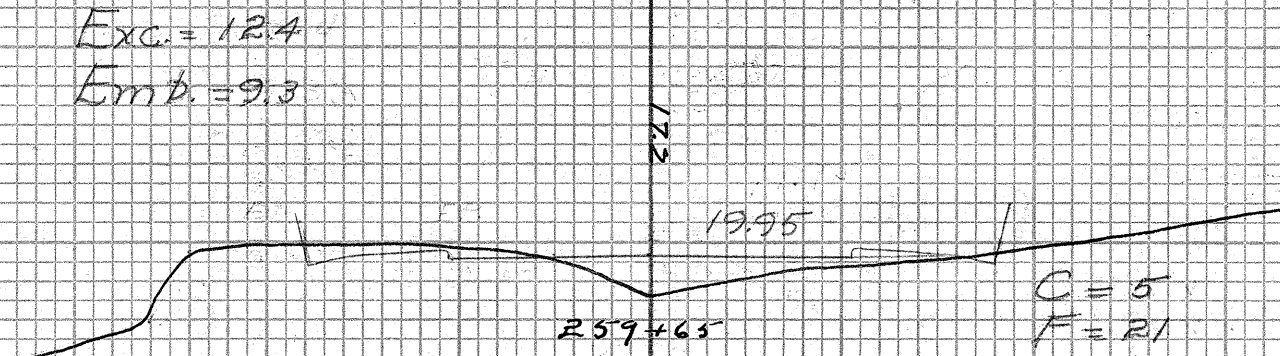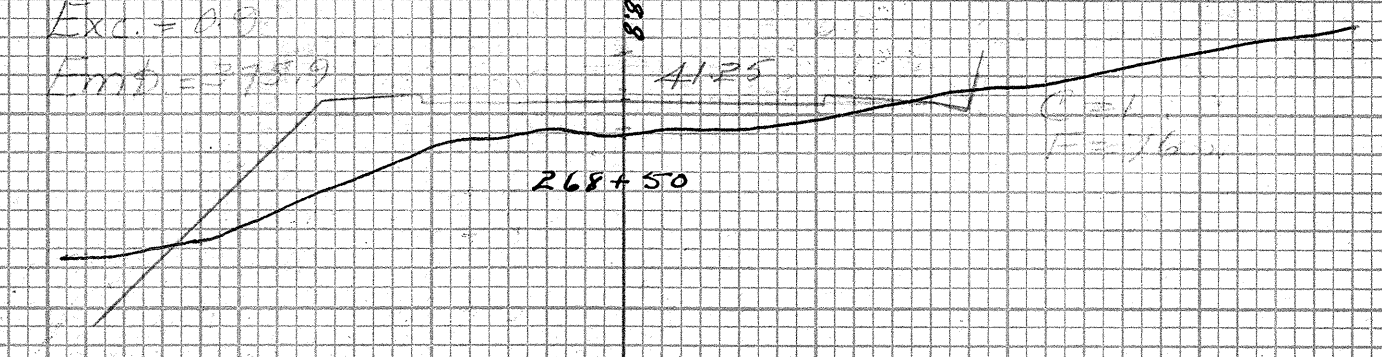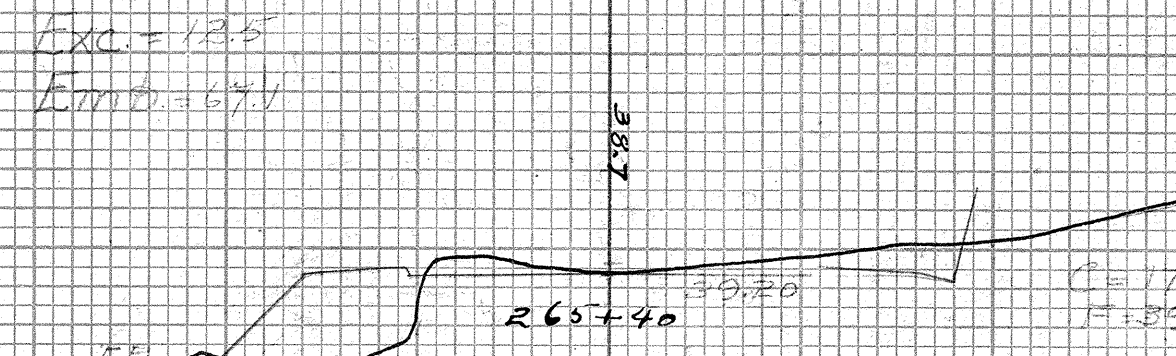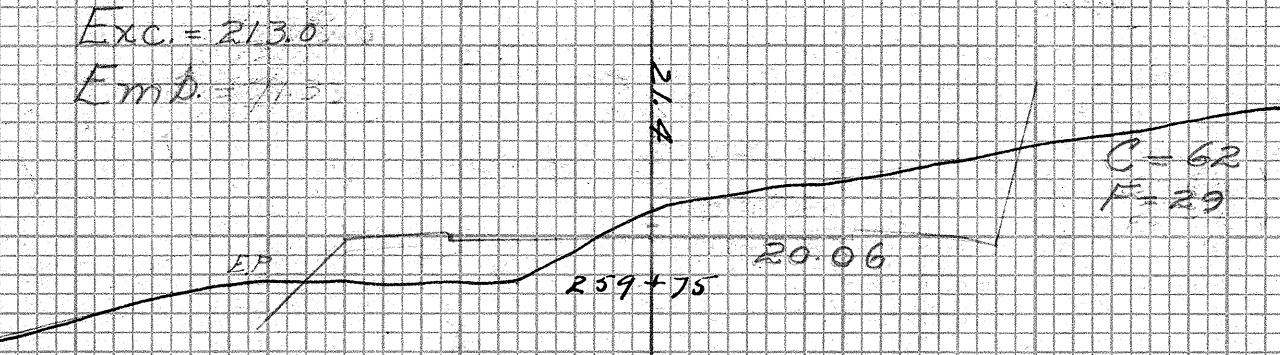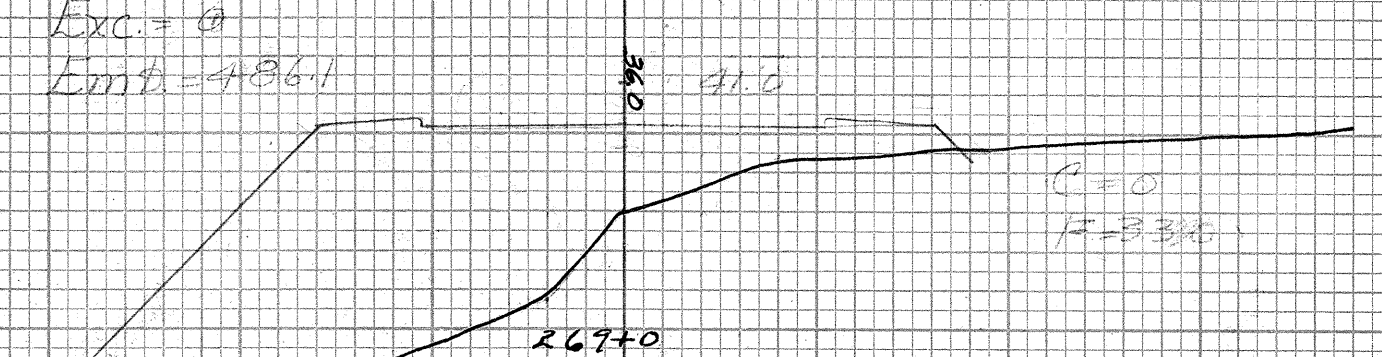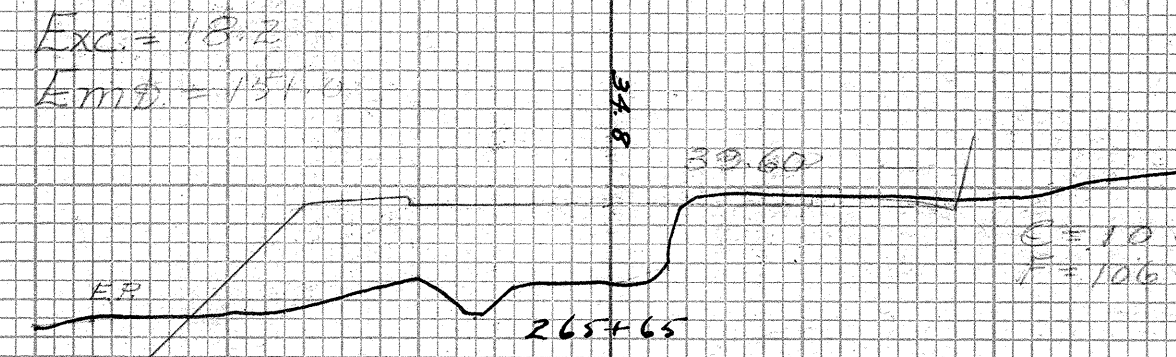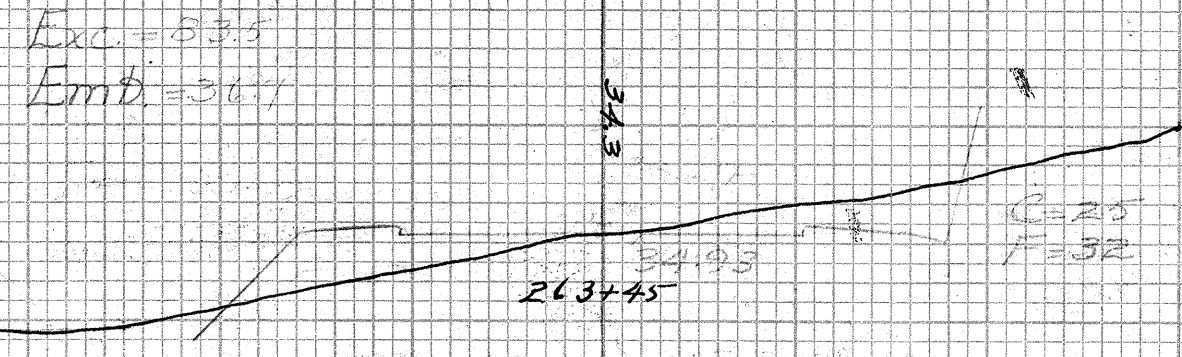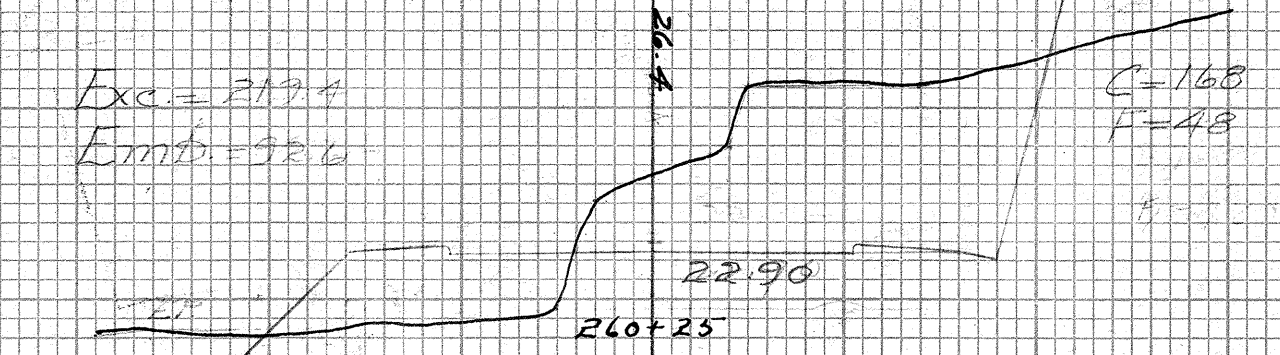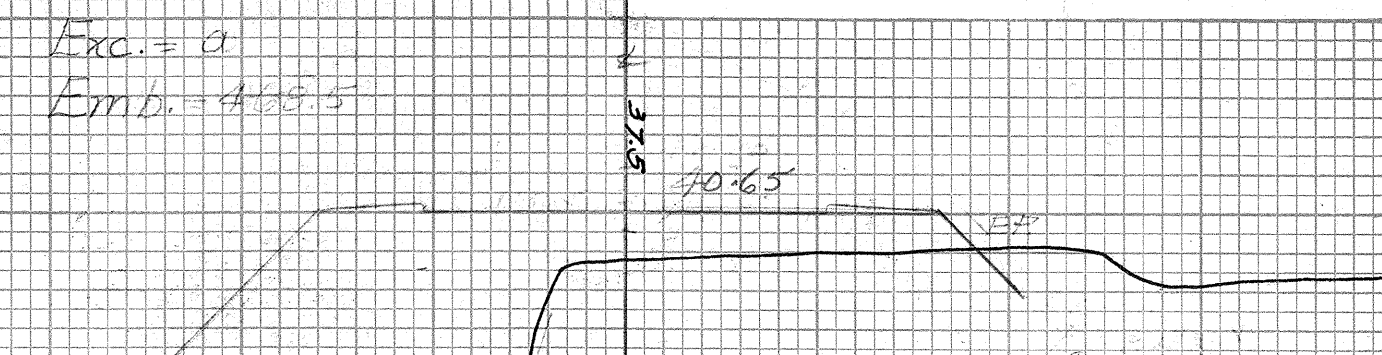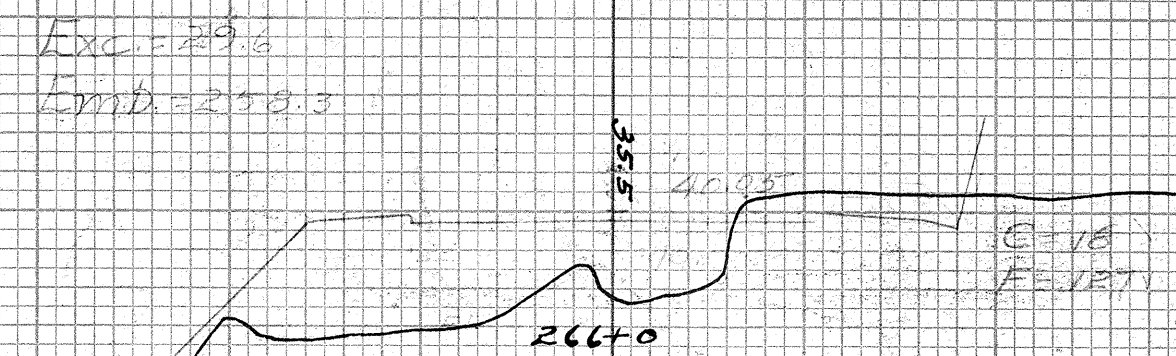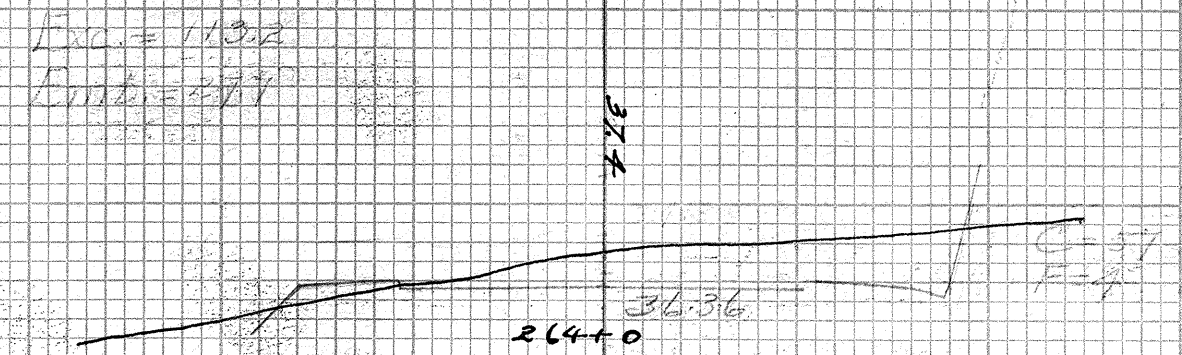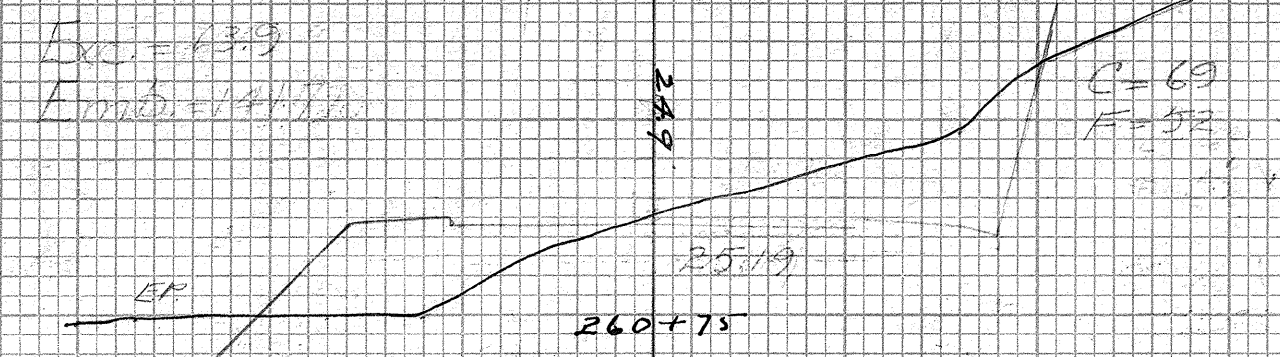

FED. ROAD DIST. NO.	STATE	FED. AID PROJ. NO.	FISCAL YEAR	SHEET NO.	TOTAL SHEETS
HAWAII	HAW.	8-G.	1936	13	13

FINAL SURVEY	DATE	BY
SURVEYED		
PLOTTED		
NOTE BOOK		
NO.		

ORIGINAL SURVEY	DATE	BY
SURVEYED		
PLOTTED		
NOTE BOOK		
NO.		

