

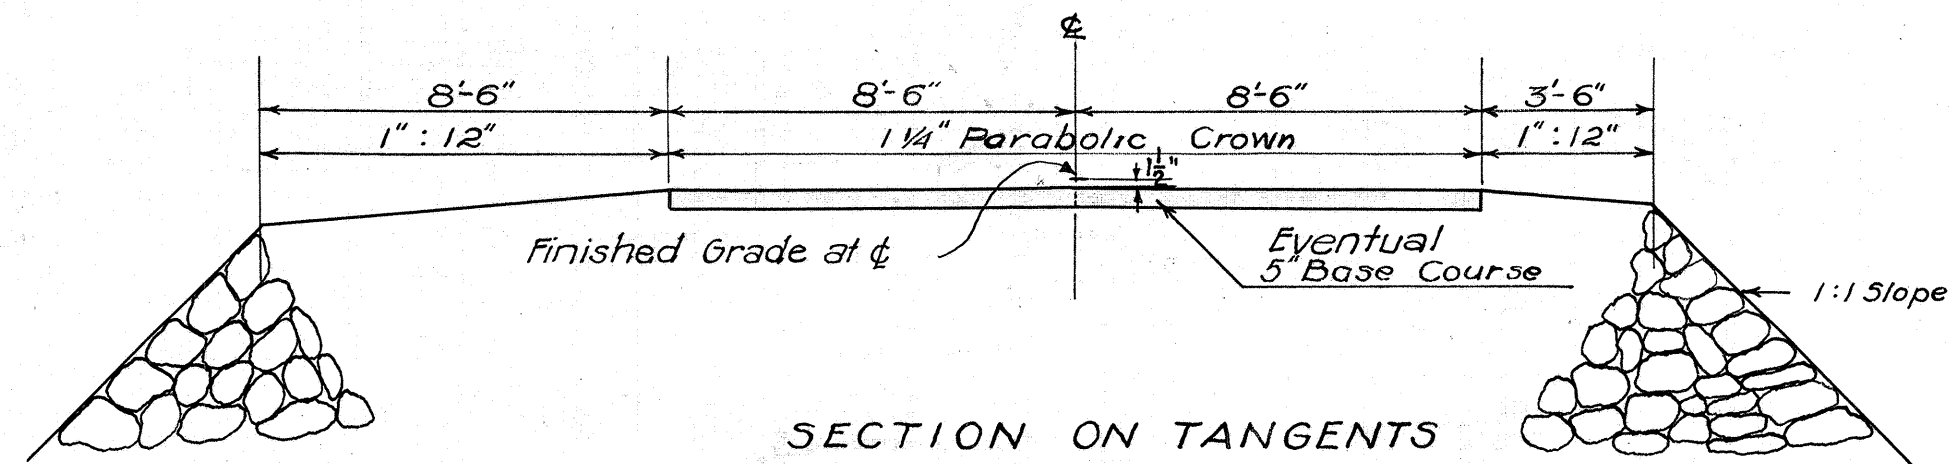




**SECTION OF
NEW STONEWALL FENCE
§
RECONSTRUCTED STONEWALL FENCE**
Scale: 1/2" = 1'-0"

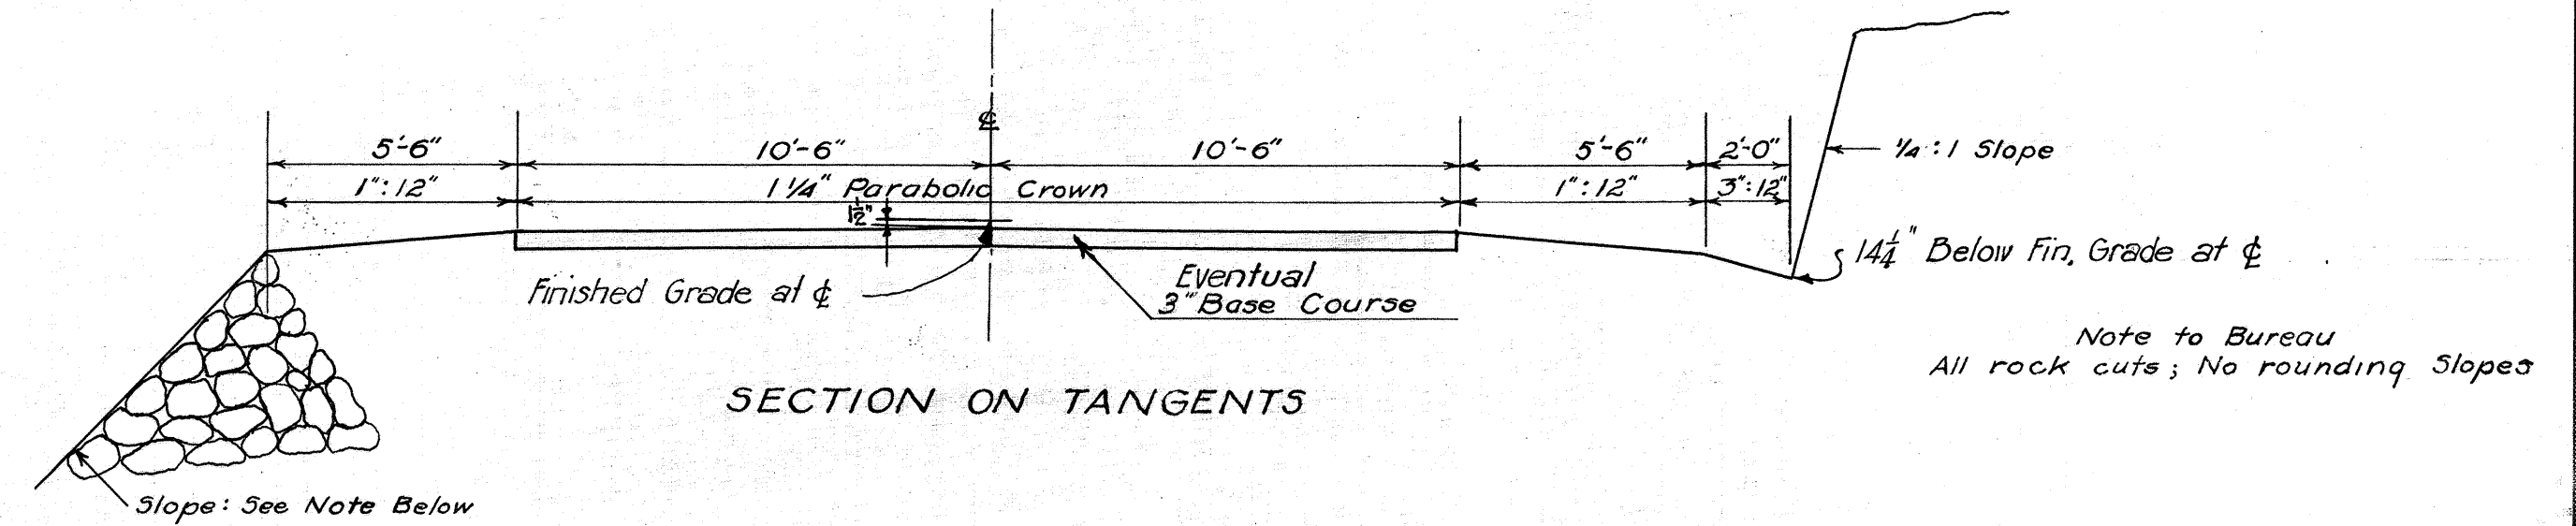

Existing 3/4:1 and 1:1 Slope Sta. 146+21 3/4 to 222+50
3/4:1 or 1:1 Slope Sta. 222+50 to 272+50
As Directed by Engineer

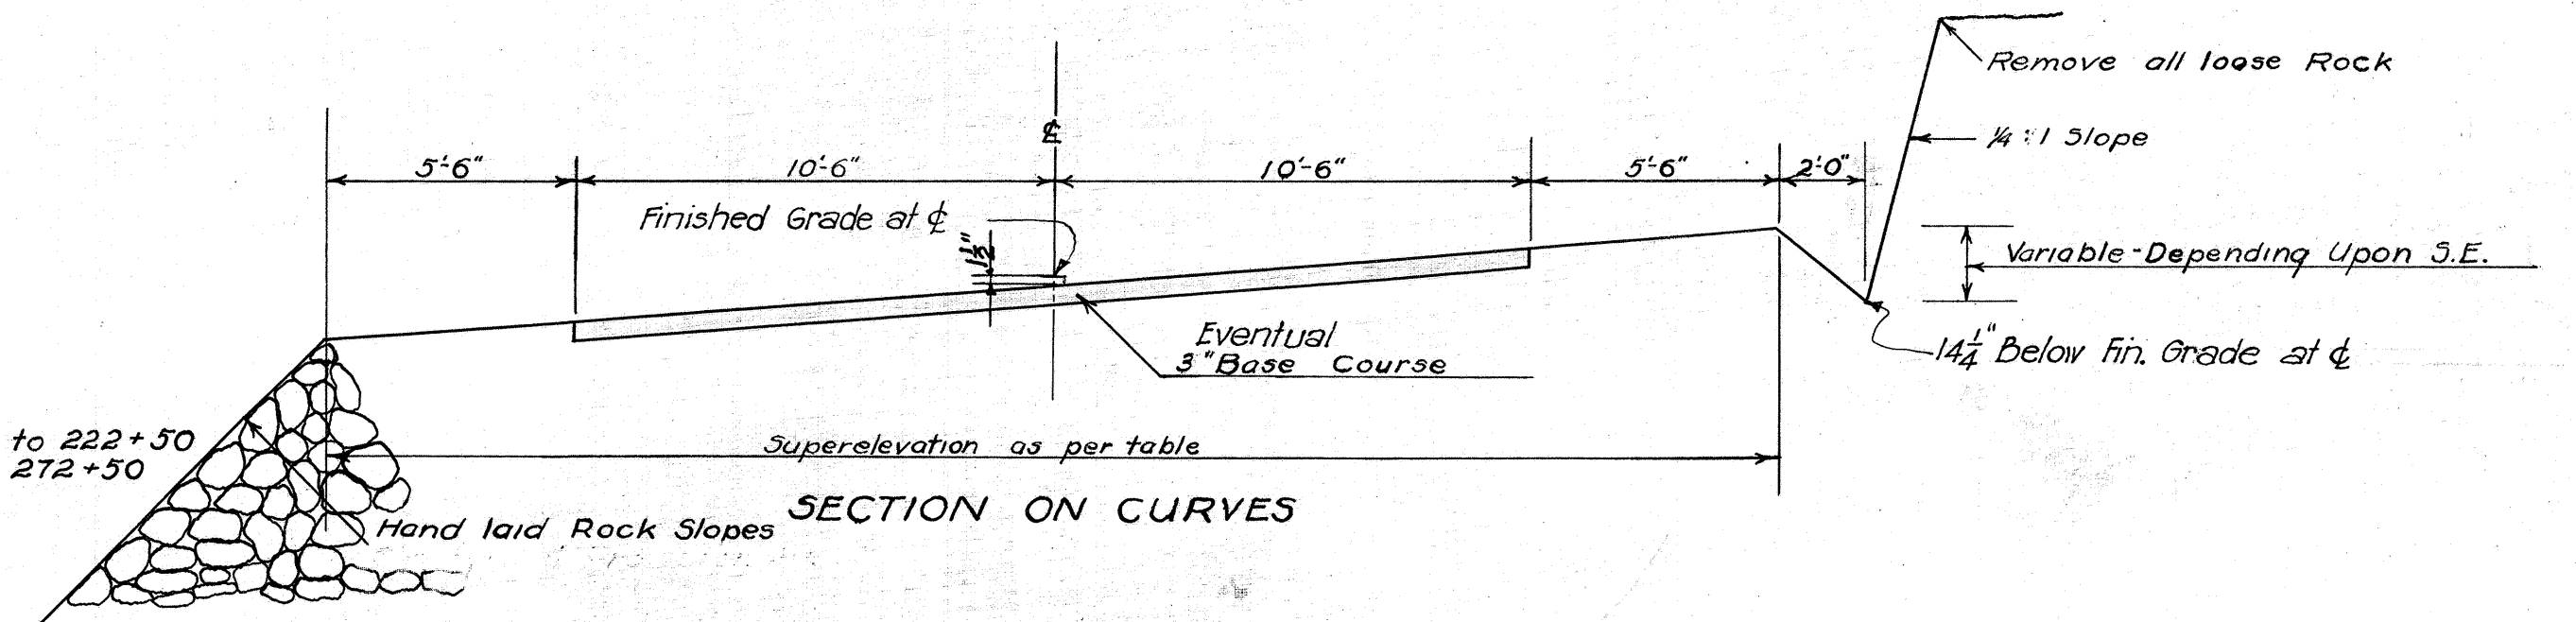

TYPICAL SECTIONS STA. 146+21 3/4 to 272+50
Scale 1/4" = 1'-0"

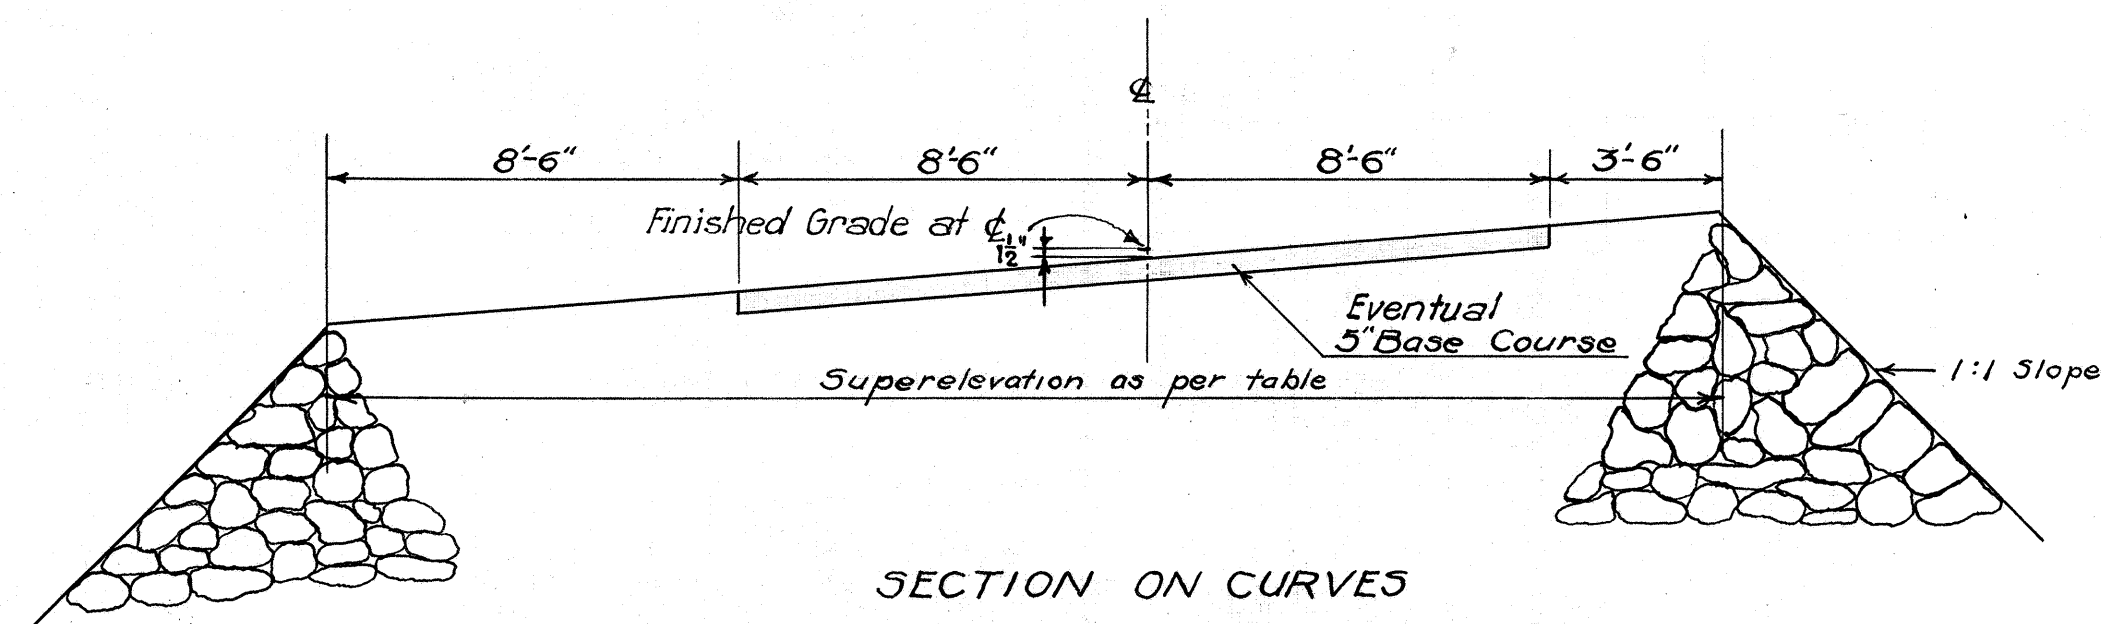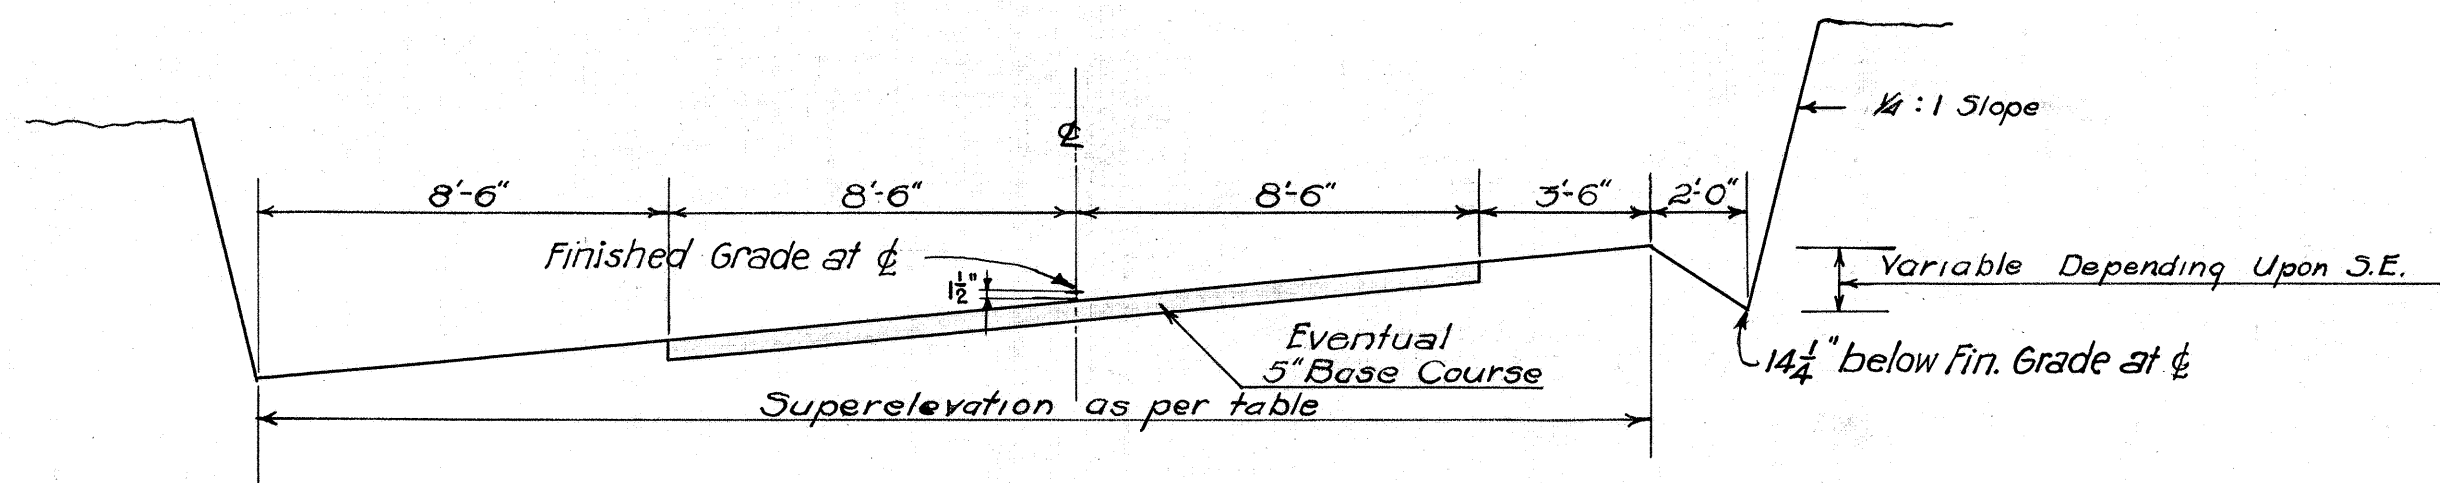

TYPICAL SECTIONS STA. 146+50 to 146+21 3/4
Scale 1/4" = 1'-0"

NOT APPLICABLE TO F.A.P. 8-G.