

INDEX TO DRAWINGS	
SHEET No	DESCRIPTION
1	Title Sheet
2	Typical Road Sections
3	Standard Bridge Details
4-35	Bridge Details

TERRITORY OF HAWAII
TERRITORIAL HIGHWAY DEPARTMENT
HONOLULU · T. H.

PLANS OF
HAWAII BELT ROAD
FEDERAL AID PROJECT NO. 18-B
REVISED
DISTRICT OF KAU
ISLAND OF HAWAII

CONVENTIONAL SIGNS

Present Road

Boundary Line (not fenced)

Centerline

Bridge

Culvert

Wire Fence


Railroad

LAYOUT OF PROJECT

GROSS LENGTH = 4.699 MILES

BRIDGES OVER 20' SPAN = 0.073 MILES

NET LENGTH OF ROADWAY = 4.626 MILES

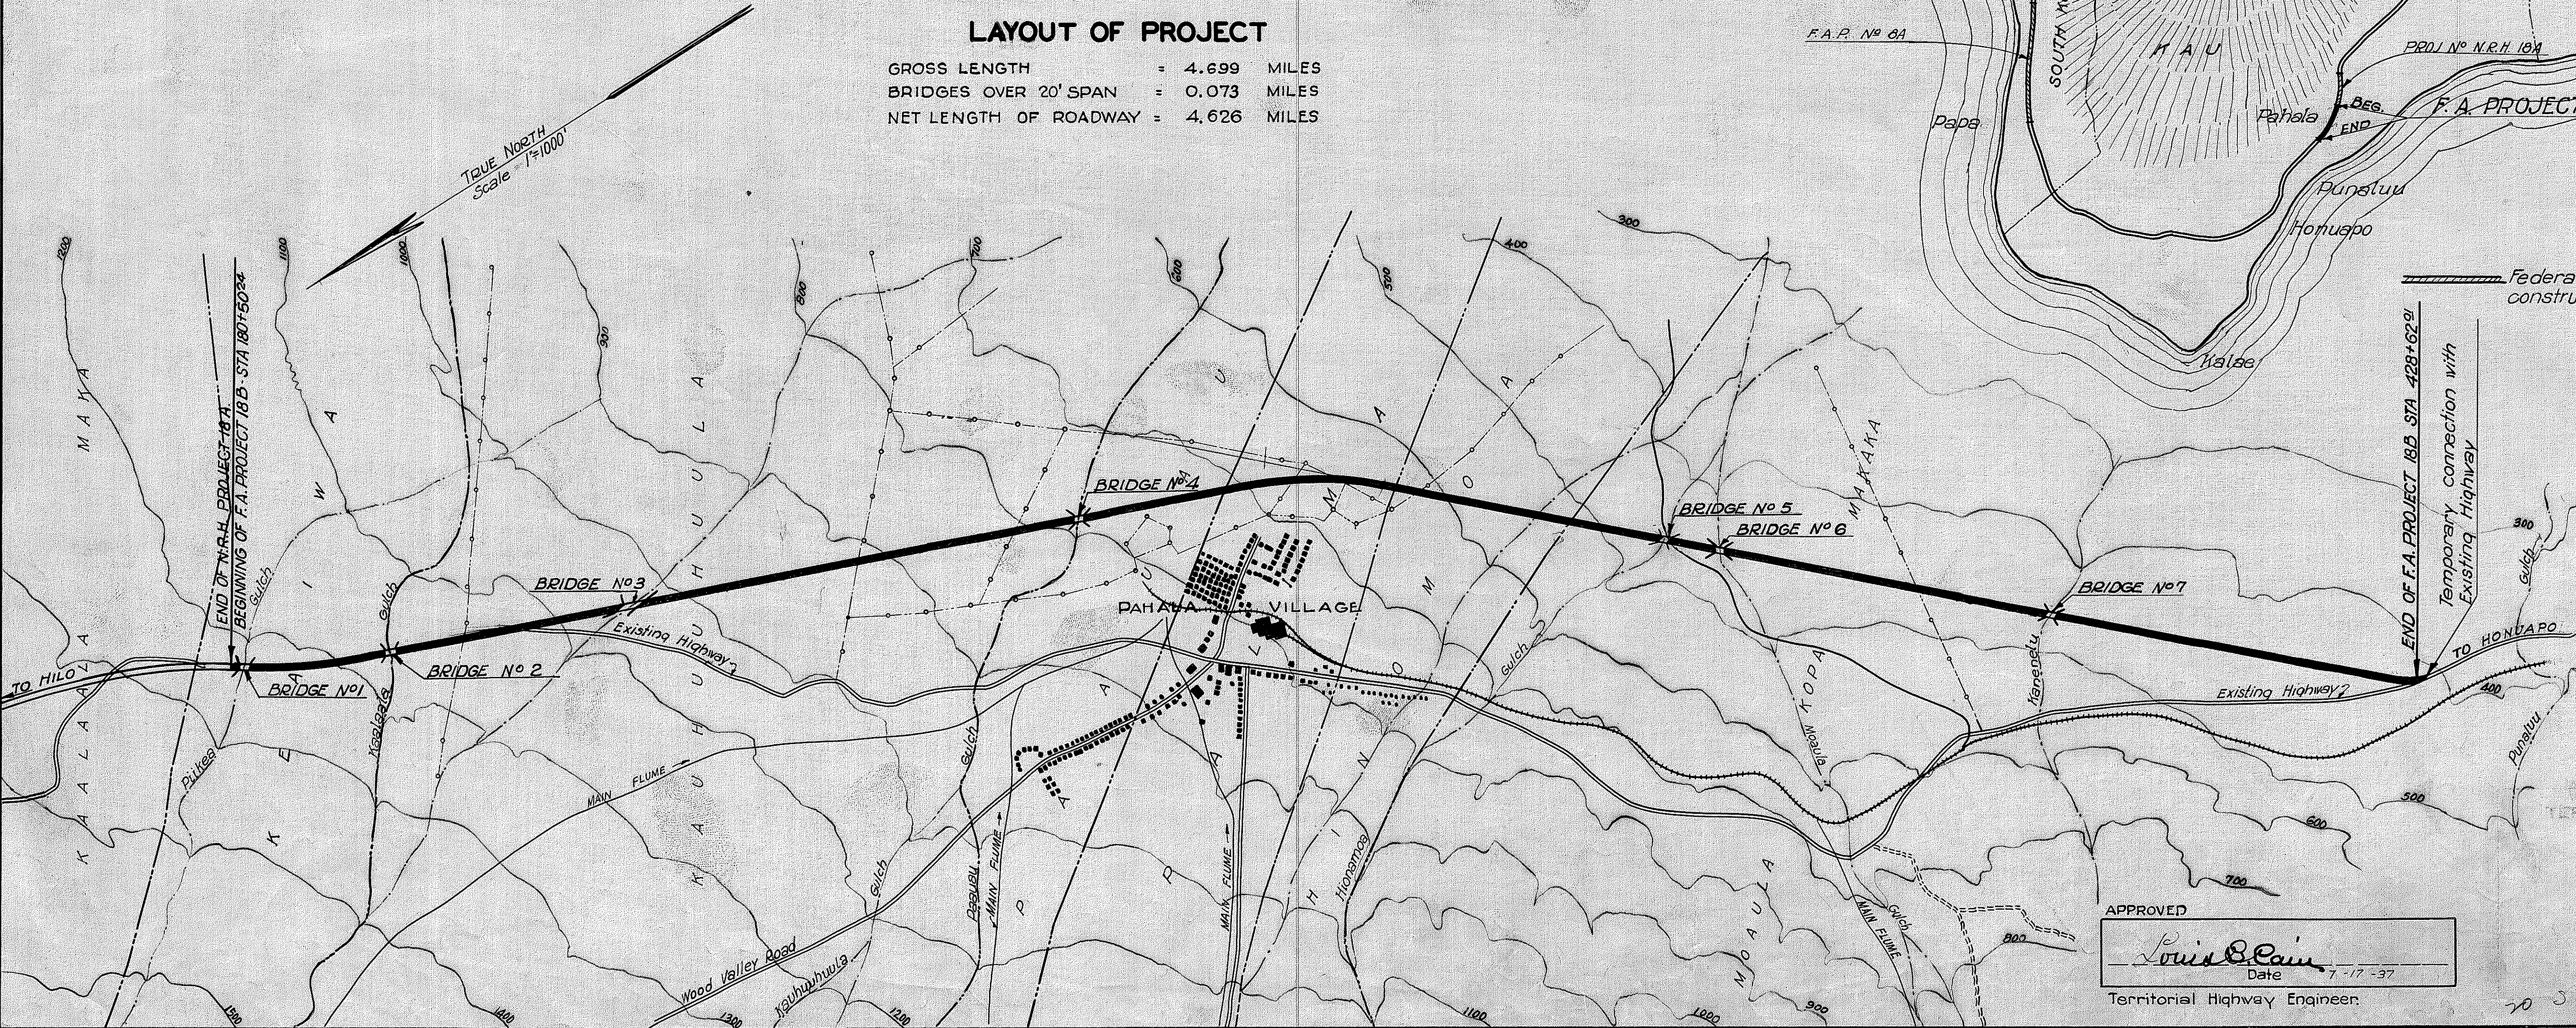

FED. ROAD DIST. NO.	STATE	FED. AID PROJ. NO.	FISCAL YEAR	SHEET NO.	TOTAL SHEETS
HAWAII	HAW	18-B	1937	1	35

PROJ. No. N.R.H. 141
PROJ. No. N.R.H. 142
PROJ. No. N.R.H. 143
PROJ. No. N.R.H. 144
PROJ. No. N.R.H. 145
PROJ. No. N.R.H. 146
PROJ. No. N.R.H. 147
PROJ. No. N.R.H. 148
PROJ. No. N.R.H. 149
PROJ. No. N.R.H. 150

W.P.G.H. No. 14E

F.A. PROJECT No. 18-B

RECOMMENDED FOR APPROVAL

Principal Highway Engineer - Bureau of Public Rds.

RECOMMENDED FOR APPROVAL

Chief Engineer - Bureau of Public Roads

APPROVED

Chief - Bureau of Public Roads

APPROVED

Louis D. Cain

Date 7-17-37

Territorial Highway Engineer