



TOP OF CUT SLOPES ARE TO BE ROUNDED AS SHOWN AT THE PLACES INDICATED BY THE ENGINEER. HE WILL REQUIRE THAT THIS BE DONE IN ALL SAND, EARTH & CONGLOMERATE MATERIAL BUT NOT IN SOLID ROCK & NOT IN CONGLOMERATE THAT HE BELIEVES WILL REMAIN IN A CEMENTED STATE. ROUNDED TOPS OF CUTS ARE PAID FOR BY THEIR LENGTH AS PER THE SPECIFICATIONS. MATERIAL EXCAVATED IN THE SHADED AREA WILL NOT BE INCLUDED IN PAYMENT UNDER THE ITEMS FOR EXCAVATION AND OVERHAUL.

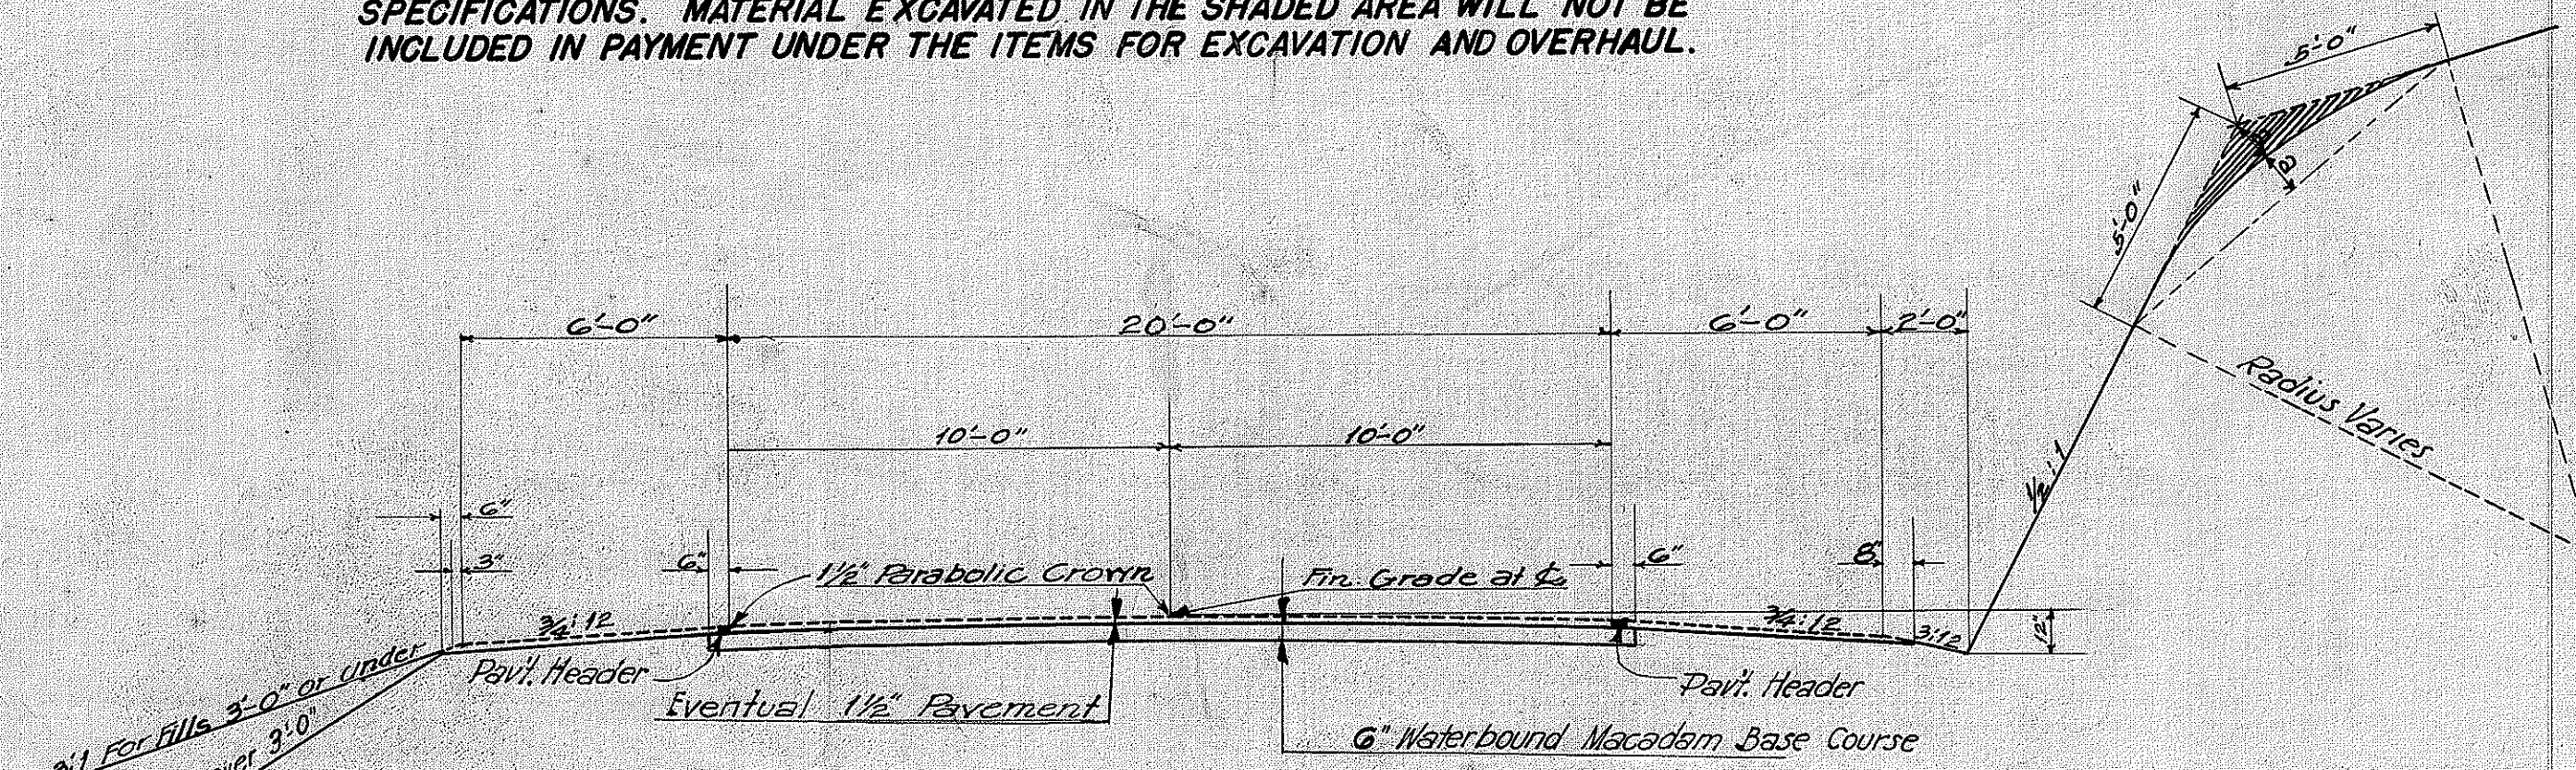

TYPICAL ROAD SECTIONS ON TANGENTS
FROM STATION 180+50.24 TO STATION 295+00
Scale 1/4" = 1'-0"

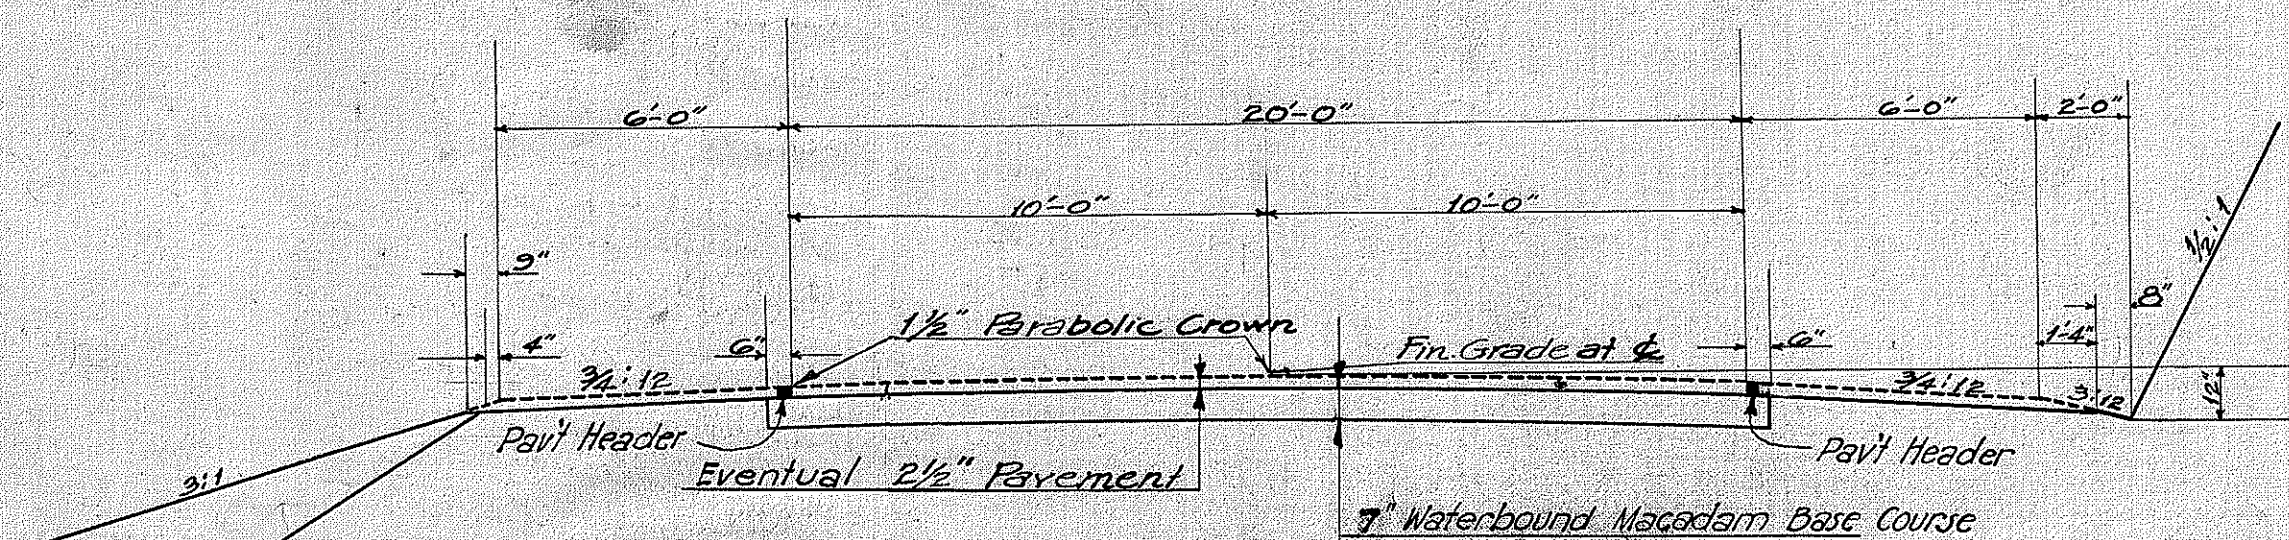


TYPICAL ROAD SECTIONS ON TANGENTS
FROM STATION 295+00 TO STATION 428+62
Scale 1/4" = 1'-0"

NOTES ON BASE COURSE & PAVEMENT


WATERBOUND MACADAM BASE COURSE: 6" & 7" Compacted Thickness

BITUMINOUS SURFACE TREATMENT: Type B


GENERAL NOTES:- PARTICULAR REFERENCE IS MADE TO THE SPECIFICATIONS AND SPECIAL PROVISIONS COVERING THESE ITEMS OF WORK

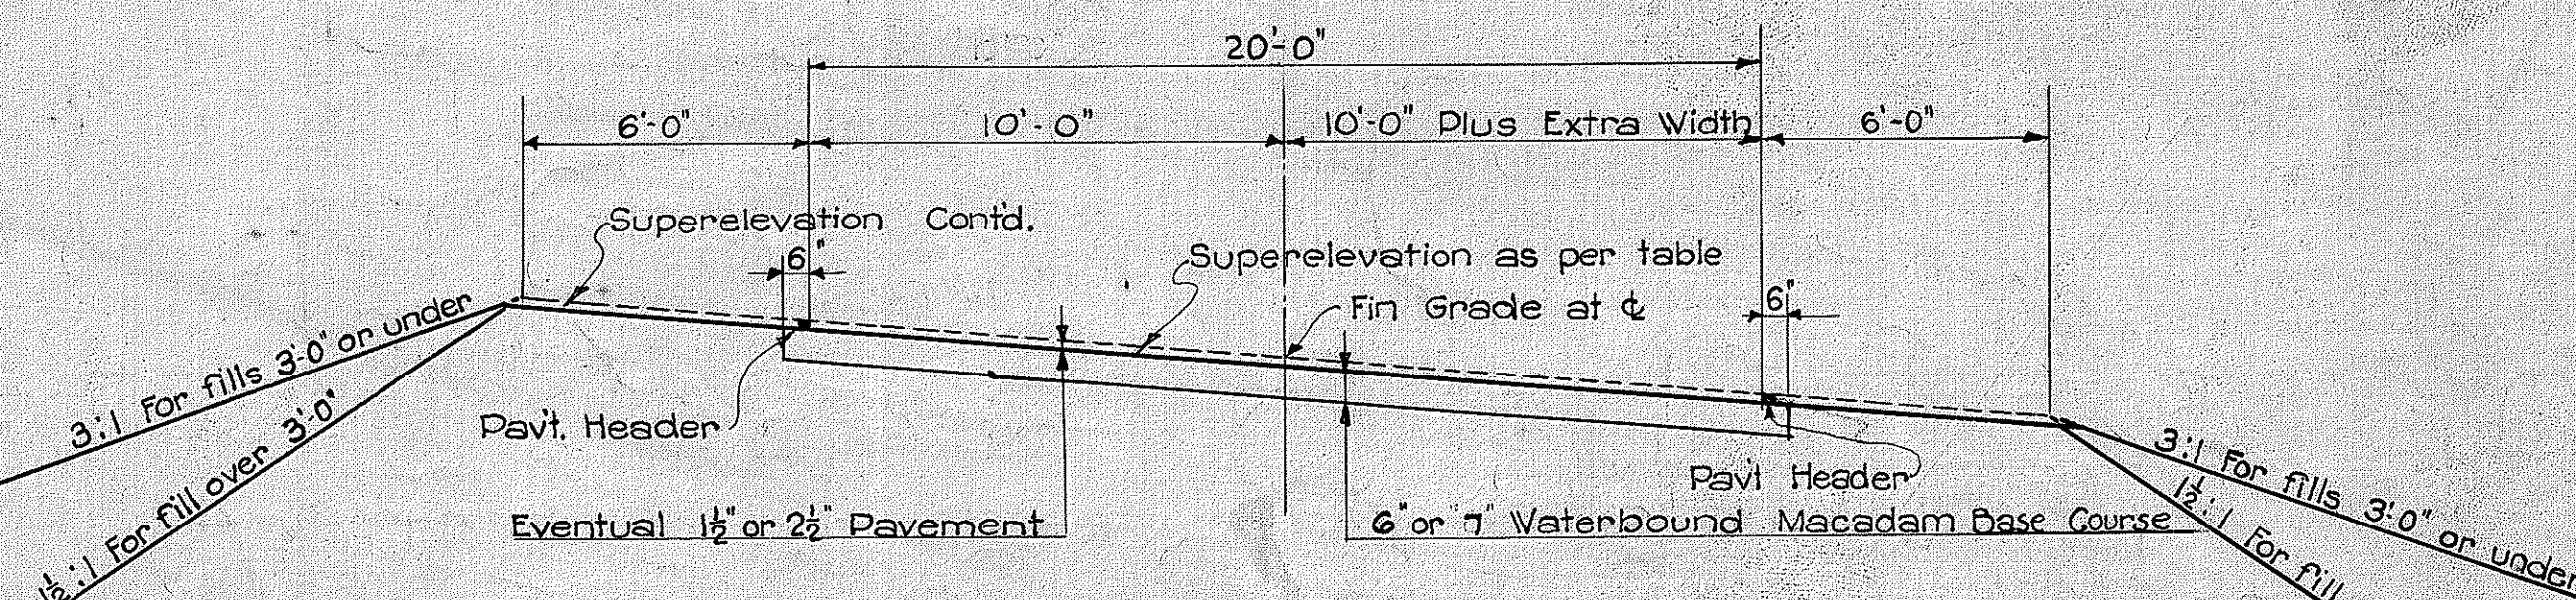

TYPICAL ROAD SECTIONS ON CURVES
SHOWING SUPERELEVATION IN FILL SECTIONS
Scale 1/4" = 1'-0"

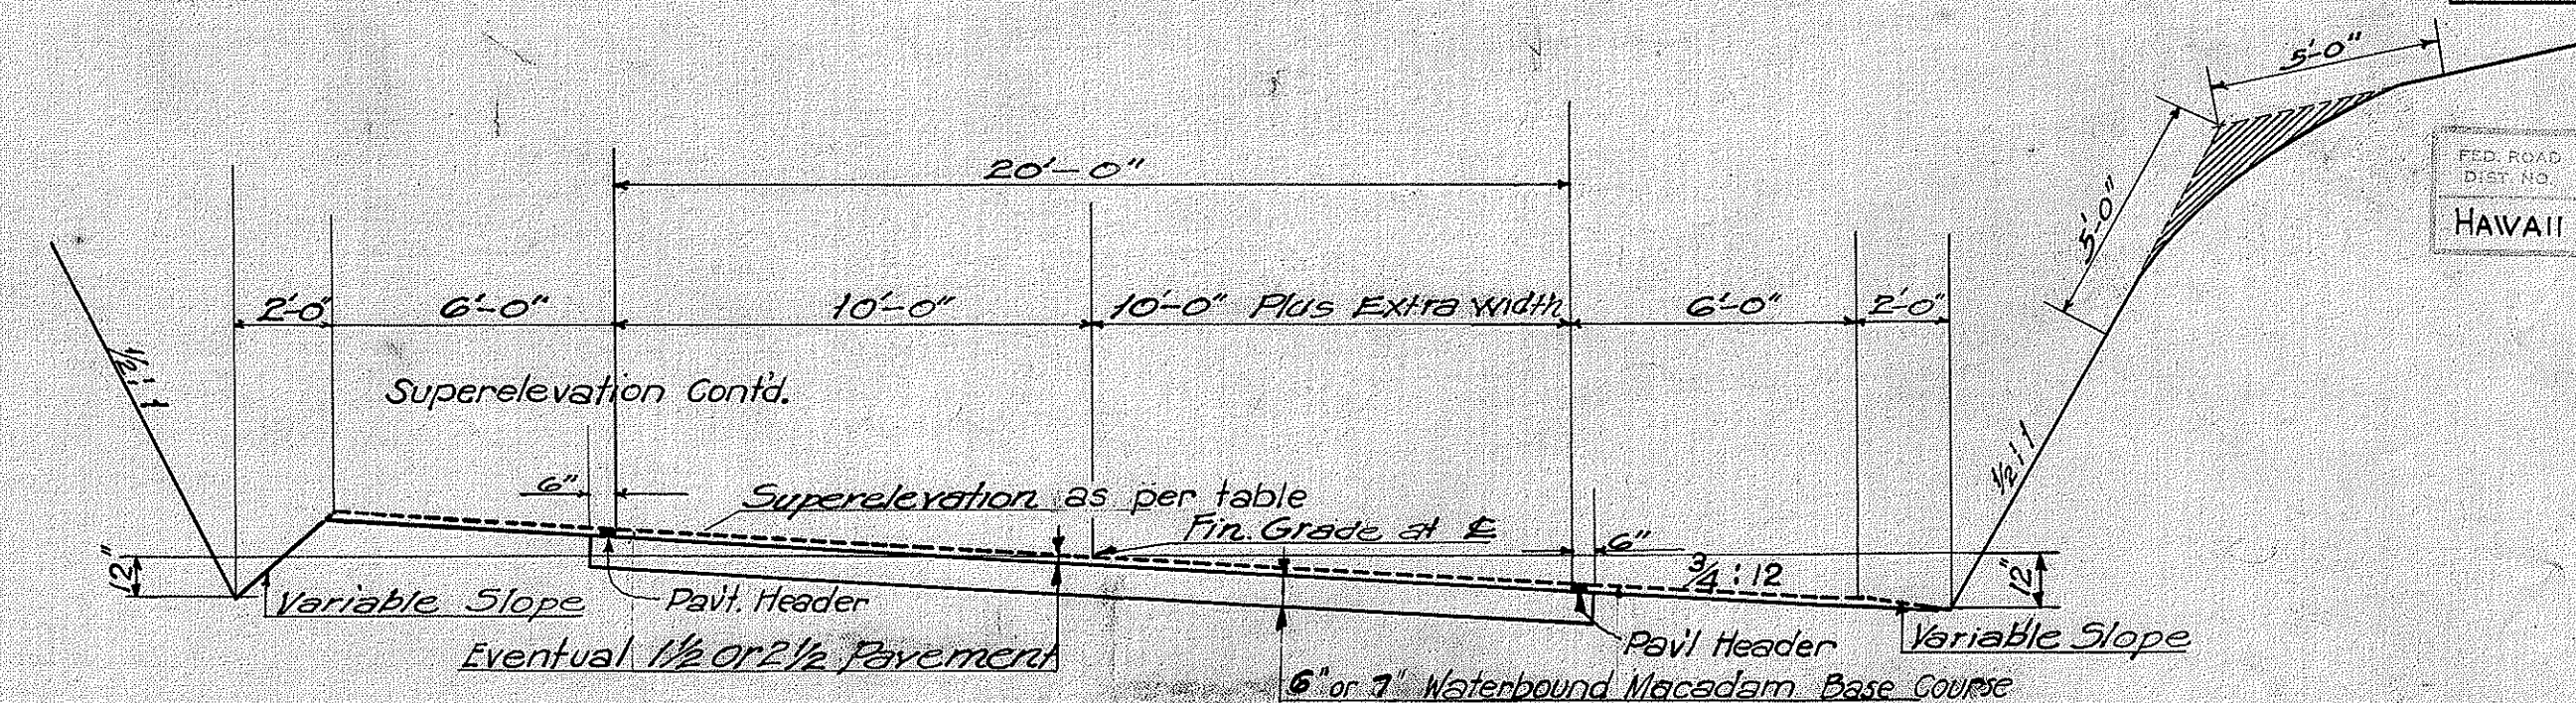

TYPICAL ROAD SECTIONS ON CURVES
SHOWING SUPERELEVATION IN CUT SECTIONS
Scale 1/4" = 1'-0"

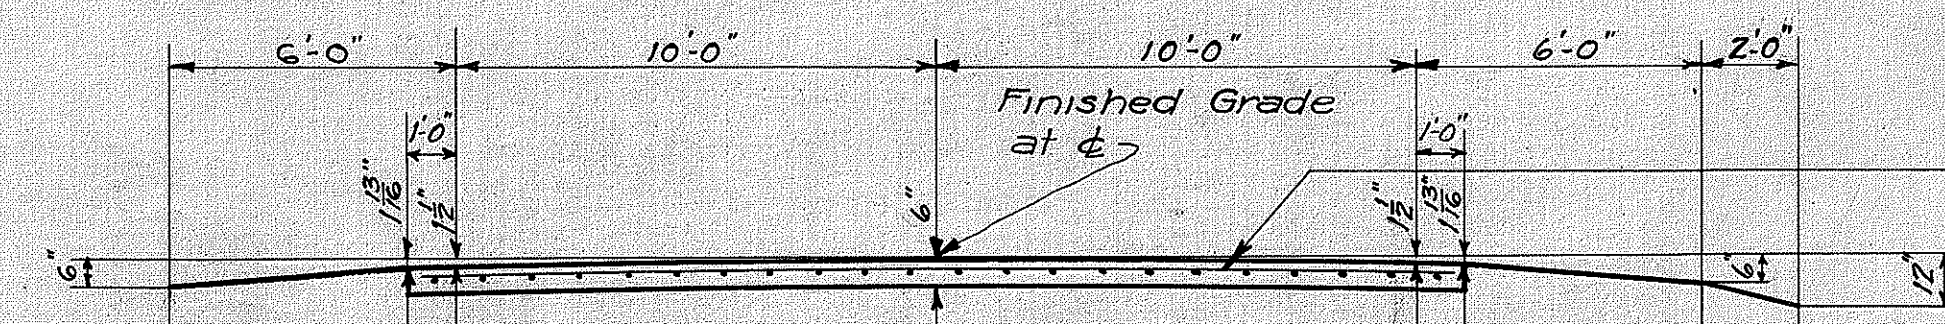

CONCRETE TRACTOR CROSSING
Scale 1/4" = 1'-0"

Wire Mesh Reinforcement 40 lbs. per 100 sq. ft. to be paid for under item for Reinf. steel other than in bridges.

Crossing to be 18' wide and to conform with eventual finished pavement grades.

FED. ROAD DIST. NO.	STATE	FED. AID PROJ. NO.	FISCAL YEAR	SHEET NO.	TOTAL SHEETS
HAWAII	HAW	18-B	1936	2	39

FED. ROAD DIST. NO.	STATE	FED. AID PROJ. NO.	FISCAL YEAR	SHEET NO.	TOTAL SHEETS
HAWAII	HAW	18-B	1937	2	35

SURVEY PLOTTED BY	DATE
DESIGNED BY	"
DRAWN BY	"
CHECKED BY	"
ORIGINAL PLAN	No.
NOTE BOOK	No.

TERRITORIAL HIGHWAY DEPARTMENT
HONOLULU, HAWAII

SHEET NO. 4386.2

4406.2 4386.2