



Cheele, " 1938 "

- LIST OF COMMON ABBREVIATIONS**
- C.R.M. Cement Rubble Masonry
 - D.R.M. Dry Rubble Masonry
 - Circ. Conc. Culvt. Circular Concrete Culvert which is either:
 - (a) Cast-in-place Circular Concrete Culvert or
 - (b) Concrete Pipe Culvert
 - C.D.I. Concrete Drop Intake
 - M.D.I. Masonry Drop Intake
 - C.H.W. Concrete Headwall (Class "A" Conc.)
 - M.H.W. Masonry Headwall
 - T.P. Telephone Pole
 - E.P. Wood Electric Pole
 - ⊕ Mon. Large Tree
 - ⊕ Mon. Centerline Monument

FED. ROAD DIST. NO.	STATE	FED. AID PROJ. NO.	FISCAL YEAR	SHEET NO.	TOTAL SHEETS
HAWAII	HAW.	FAP/BC/1938	1938	3	44

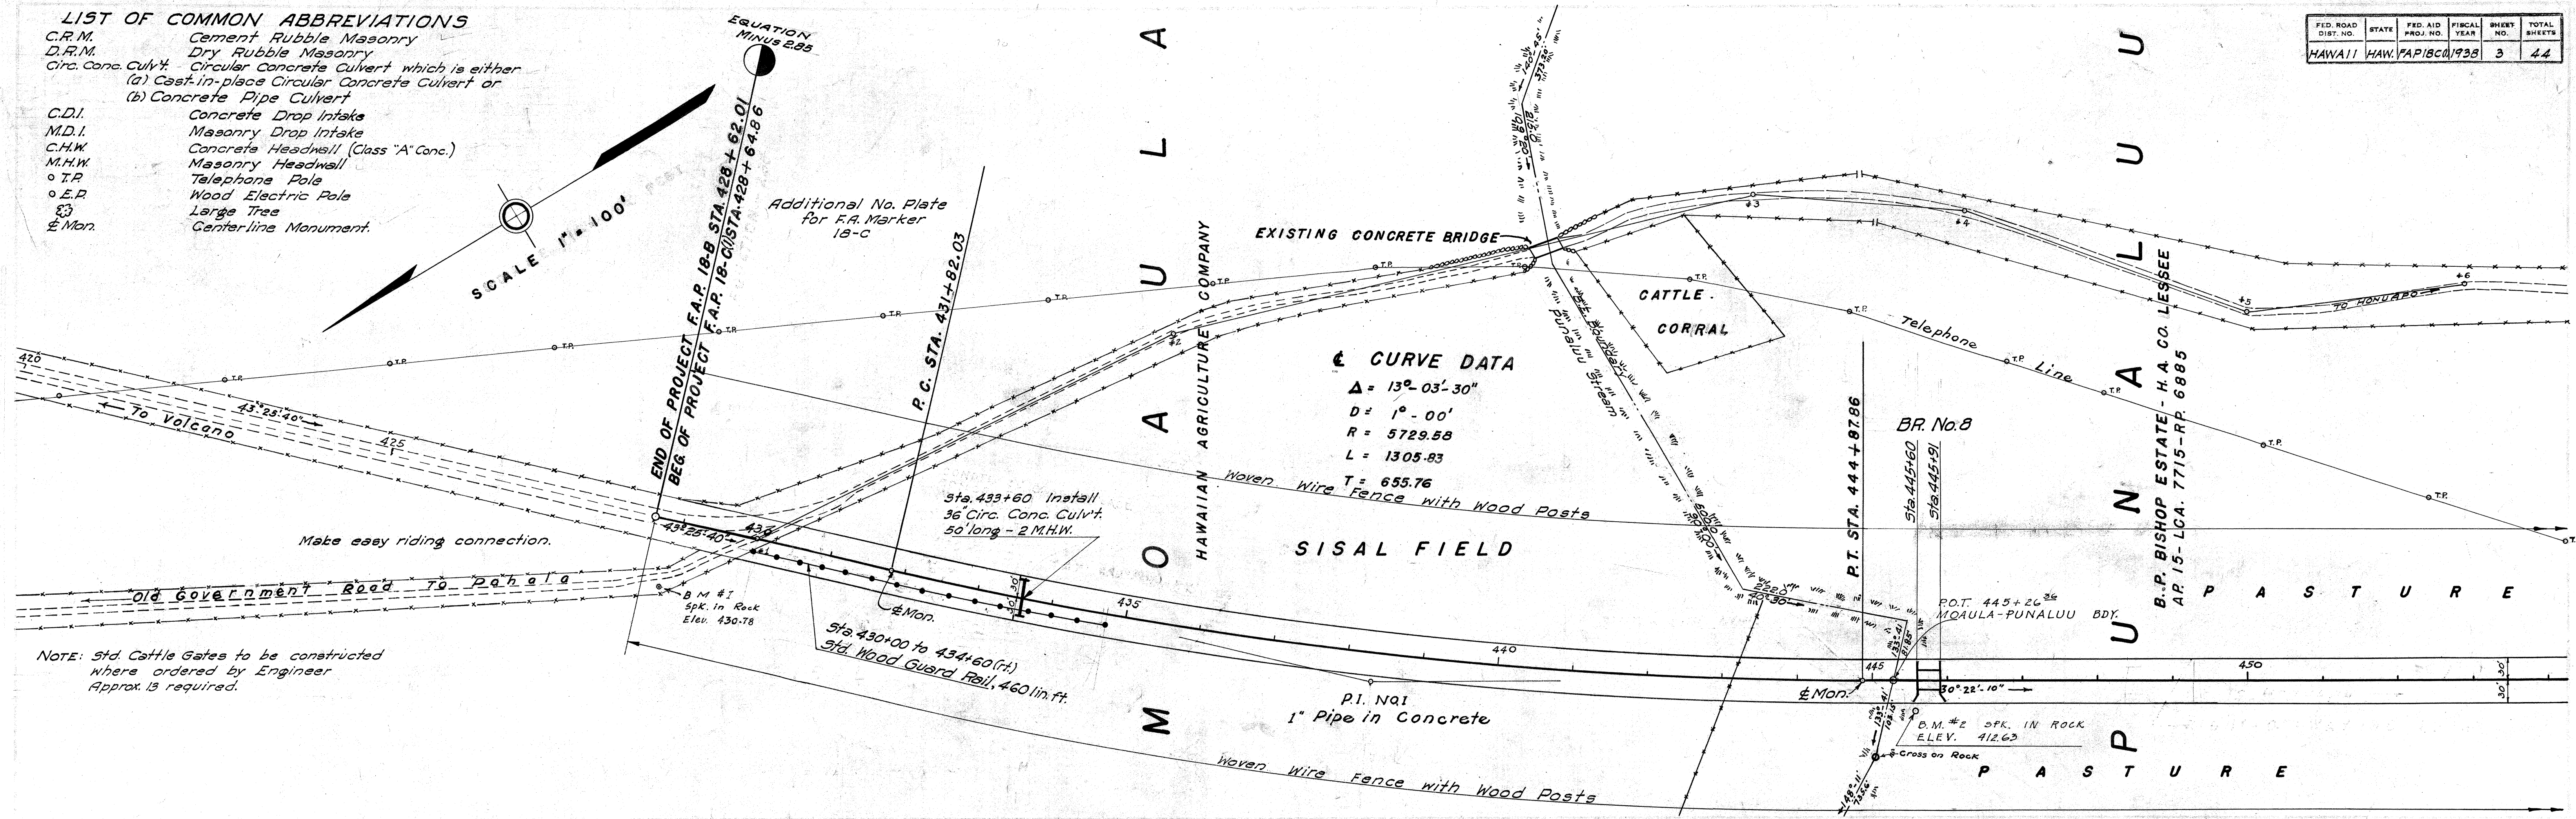


Cheele & Weeks " 1938 "

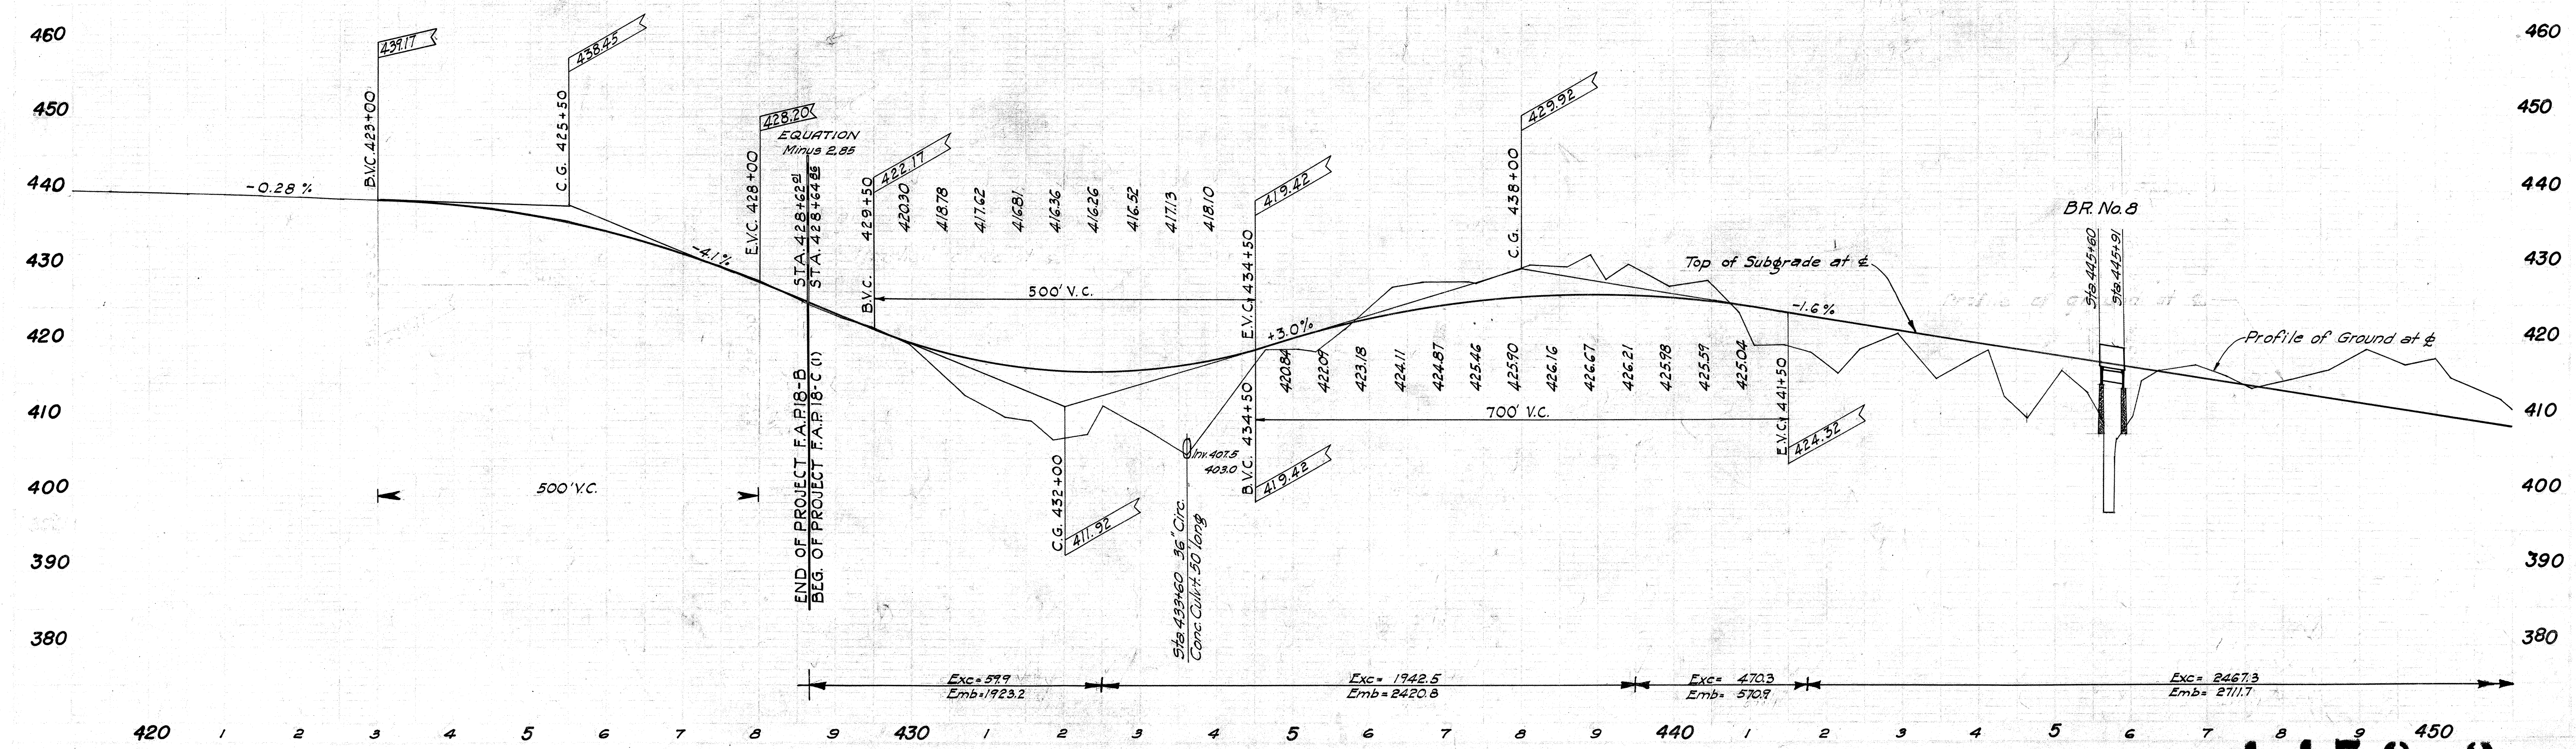

4478.3

Cheele 1938

Cheele & Weeks 1938


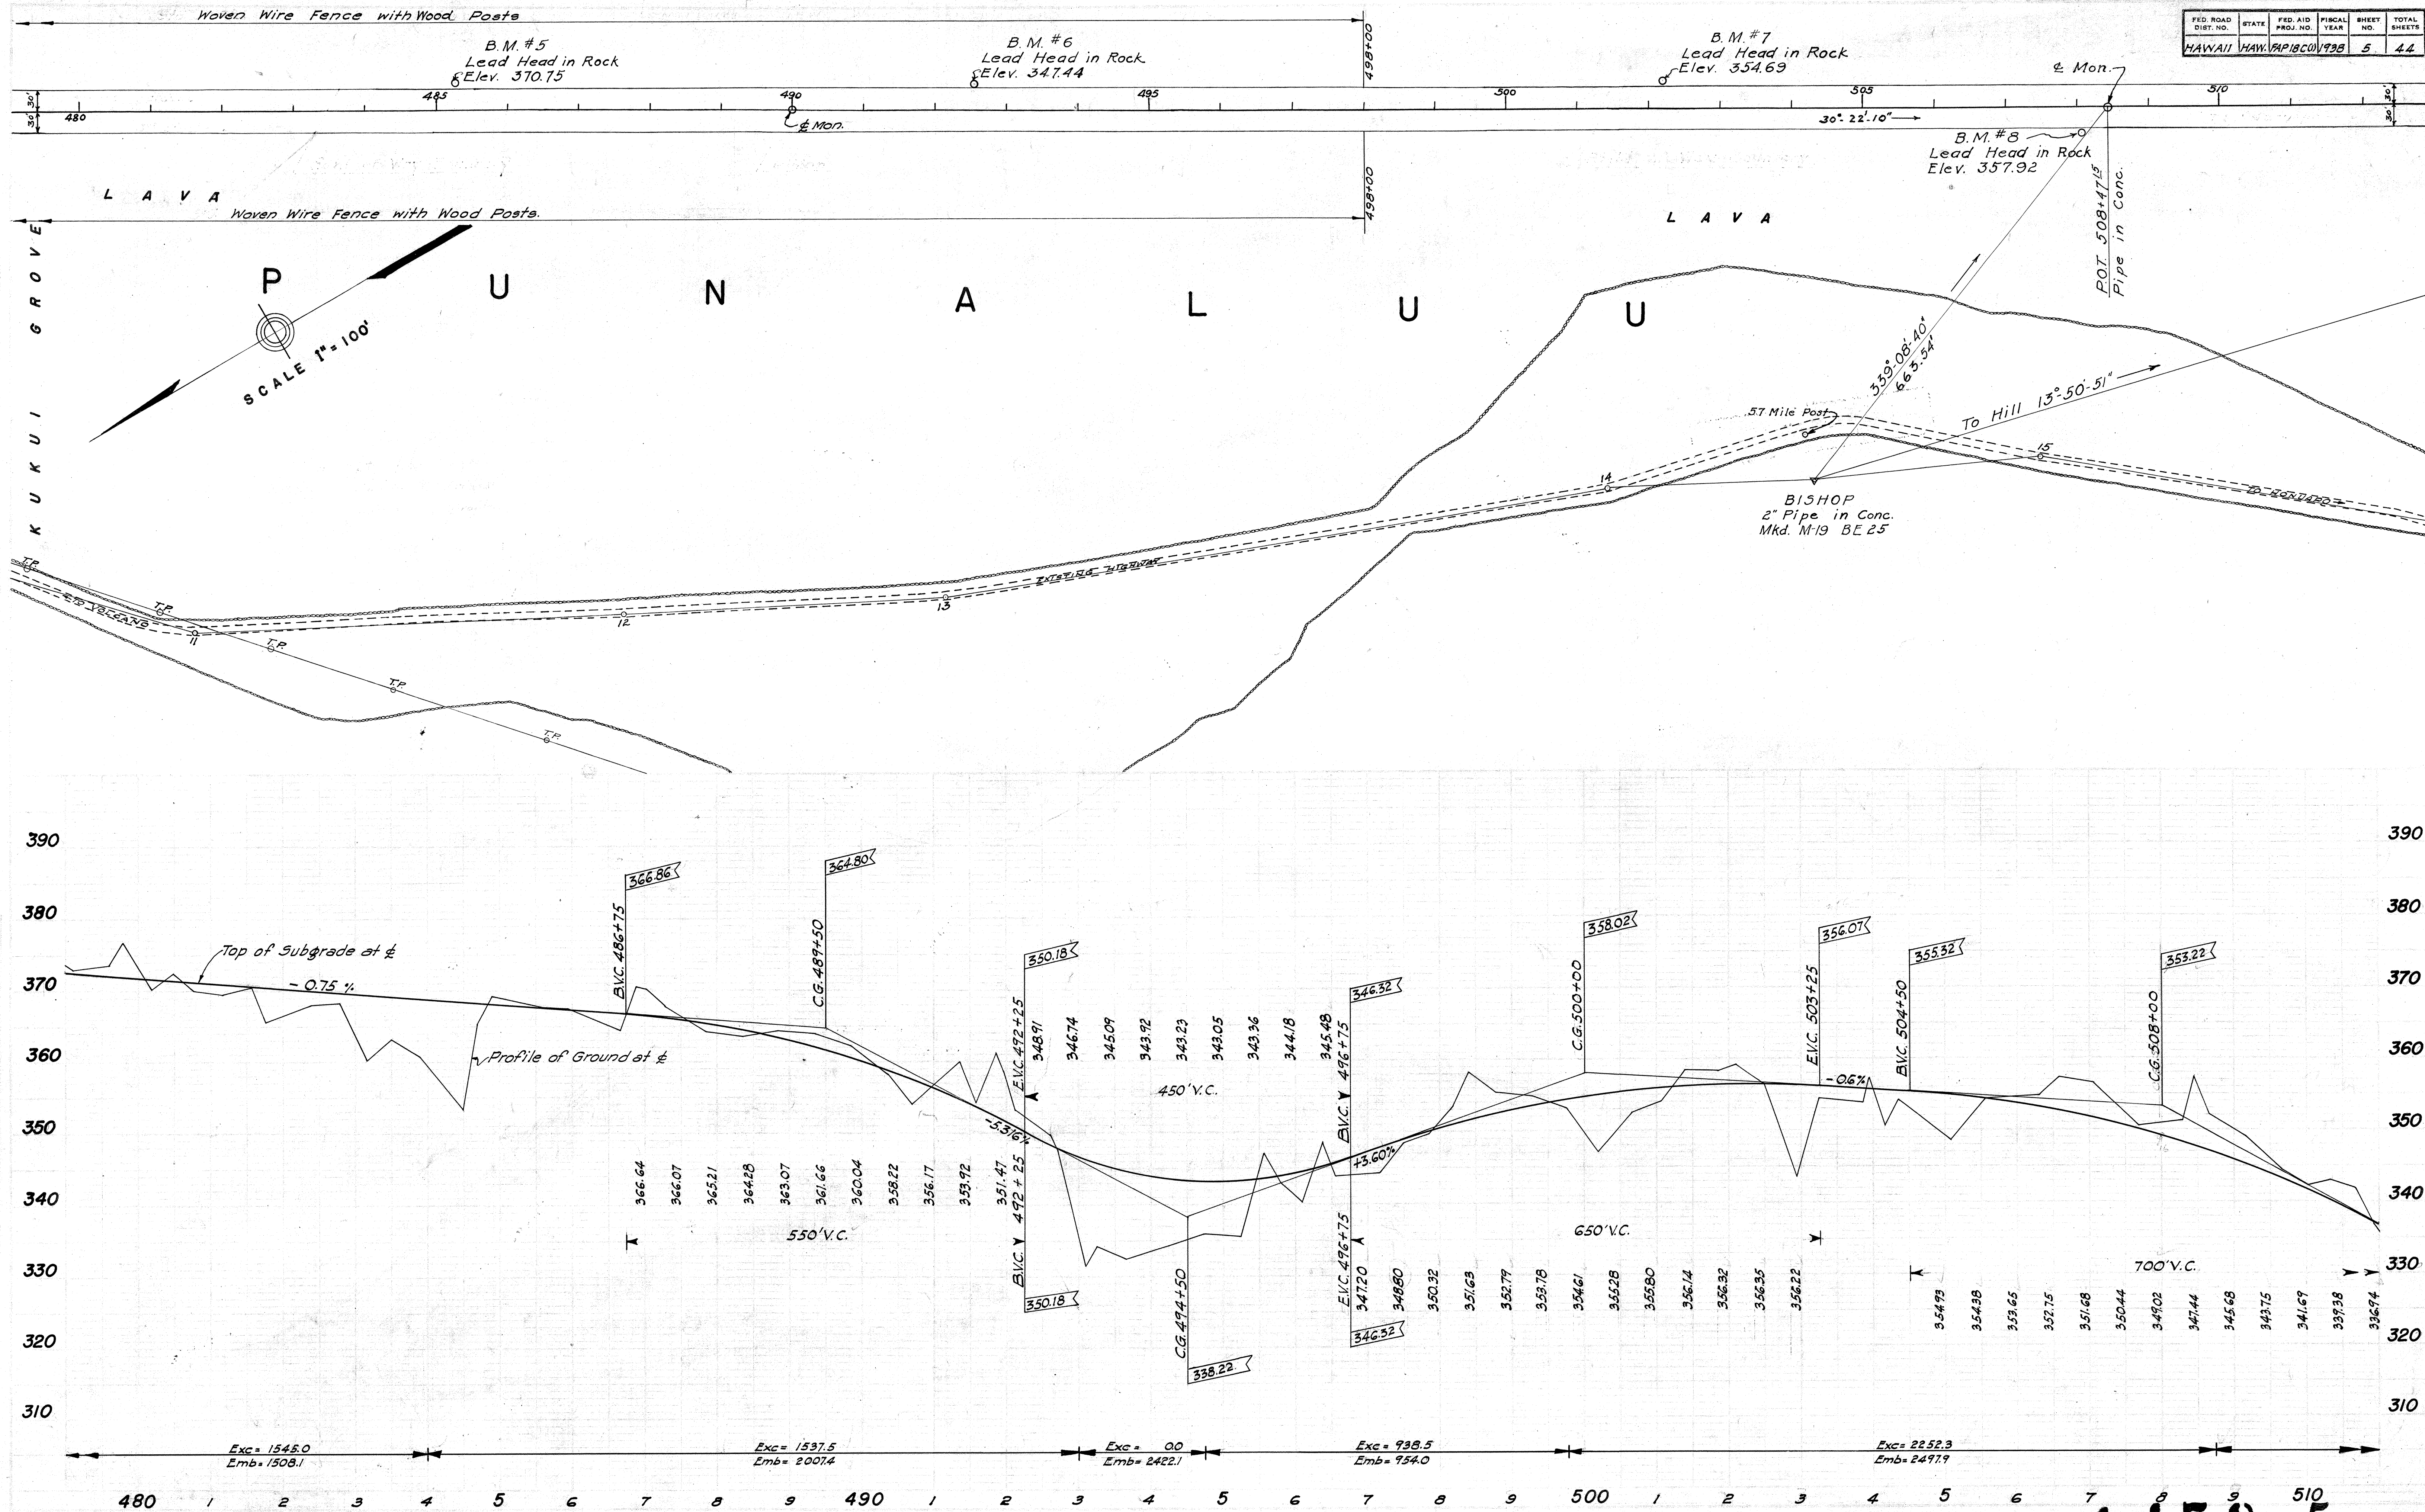


FED. ROAD DIST. NO.	STATE	FED. AID PROJ. NO.	FISCAL YEAR	SHEET NO.	TOTAL SHEETS
HAWAII	HAW.	HP18C01	1938	5	44



4478.5

FED. ROAD DIST. NO.	STATE	FED. AID PROJ. NO.	FISCAL YEAR	SHEET NO.	TOTAL SHEETS
HAWAII	HAW.	FA-100	1938	6	44


Checky & Woods 6-28 7-38
 Checky

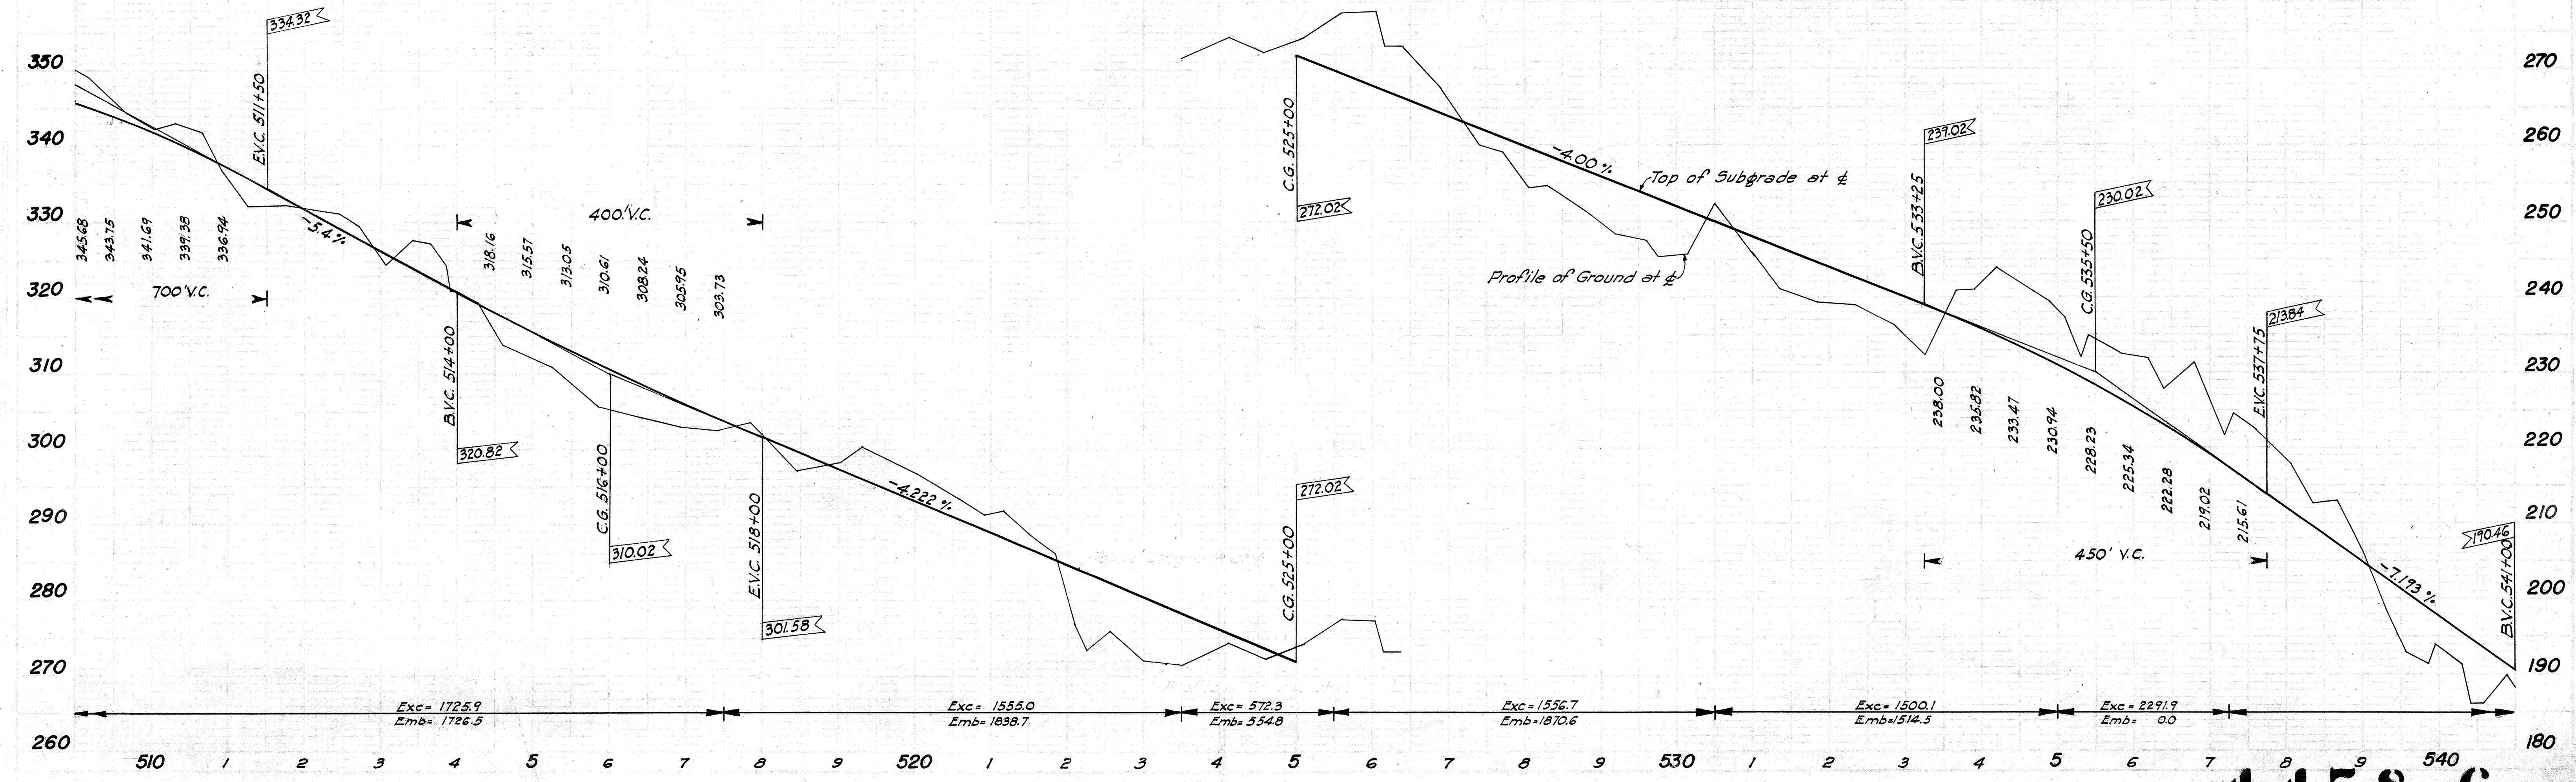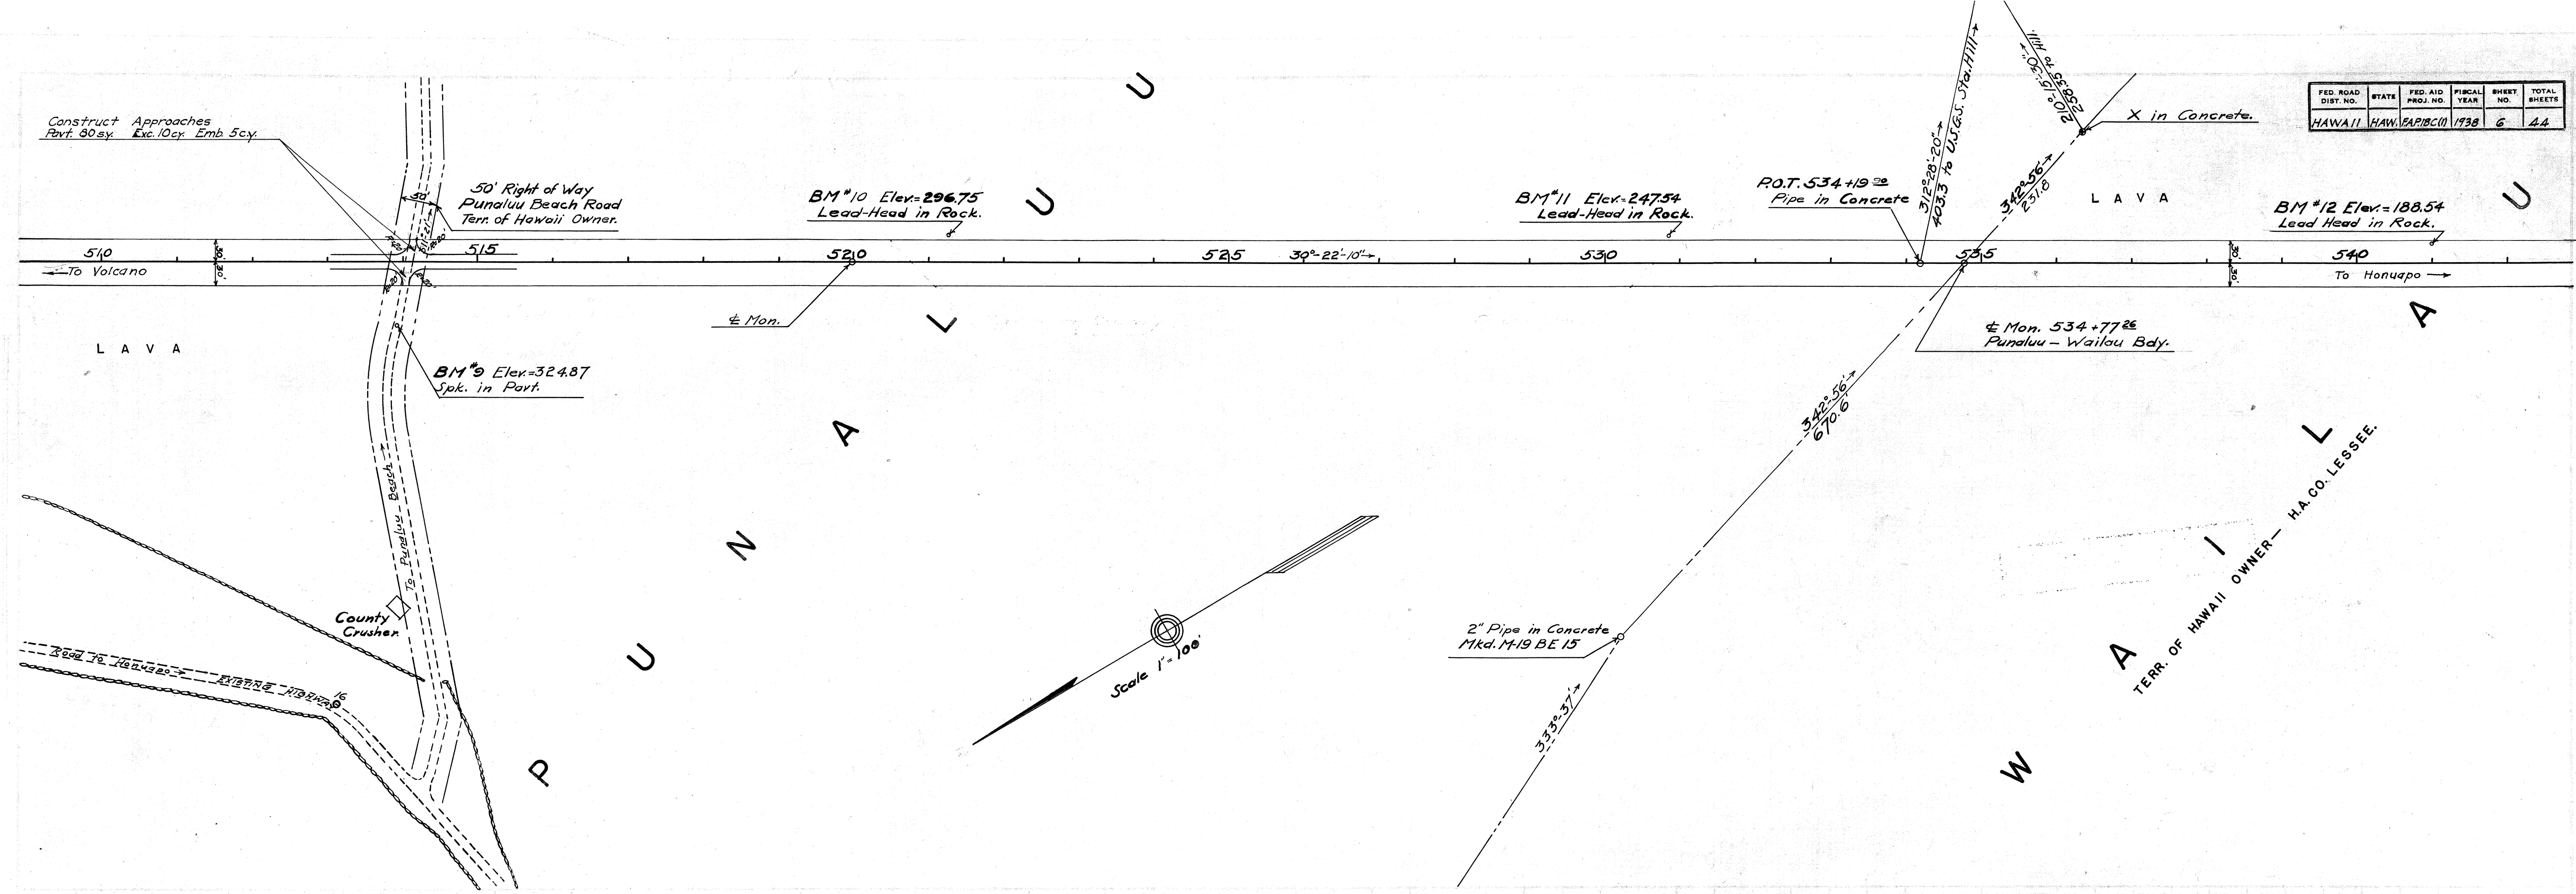

FED. ROAD DIST. NO.	STATE	FED. AID PROJ. NO.	FISCAL YEAR	SHEET NO.	TOTAL SHEETS
HAWAII	HAW.	747(B.C.)	1936	7	44

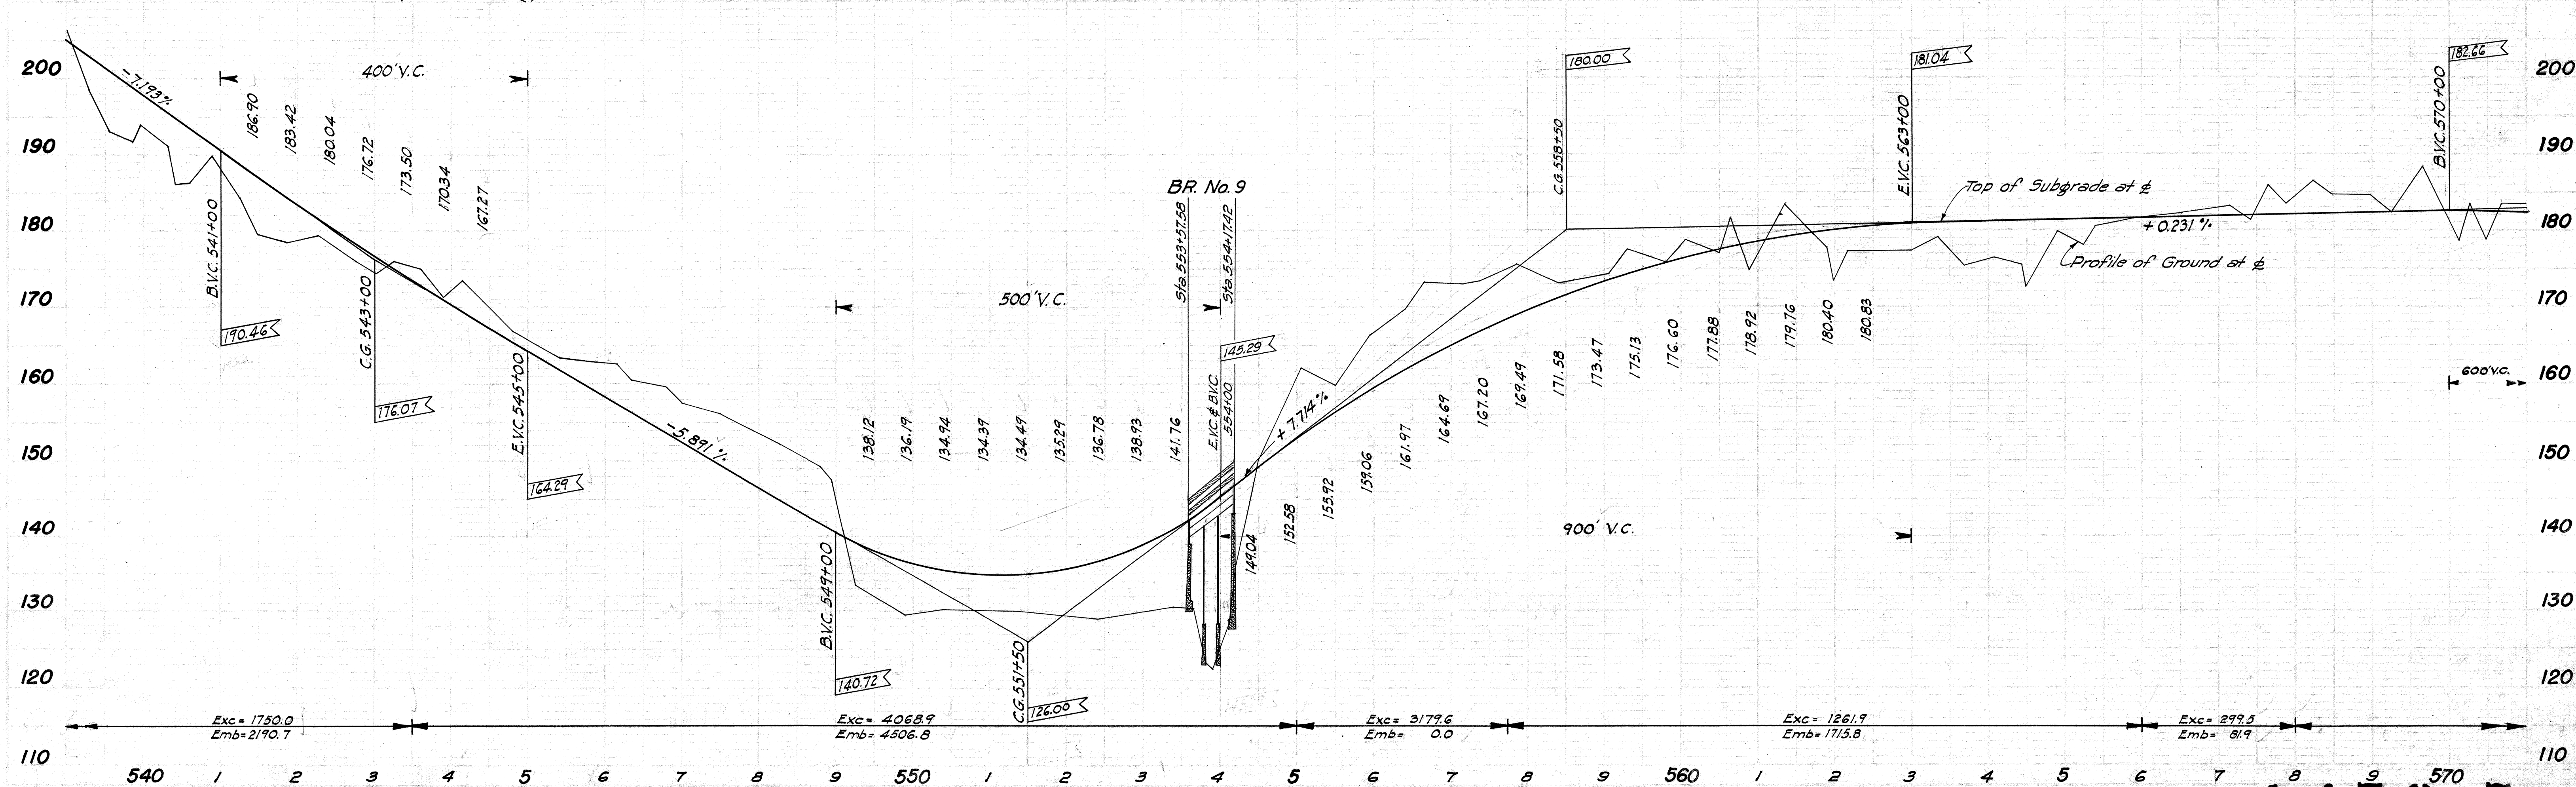
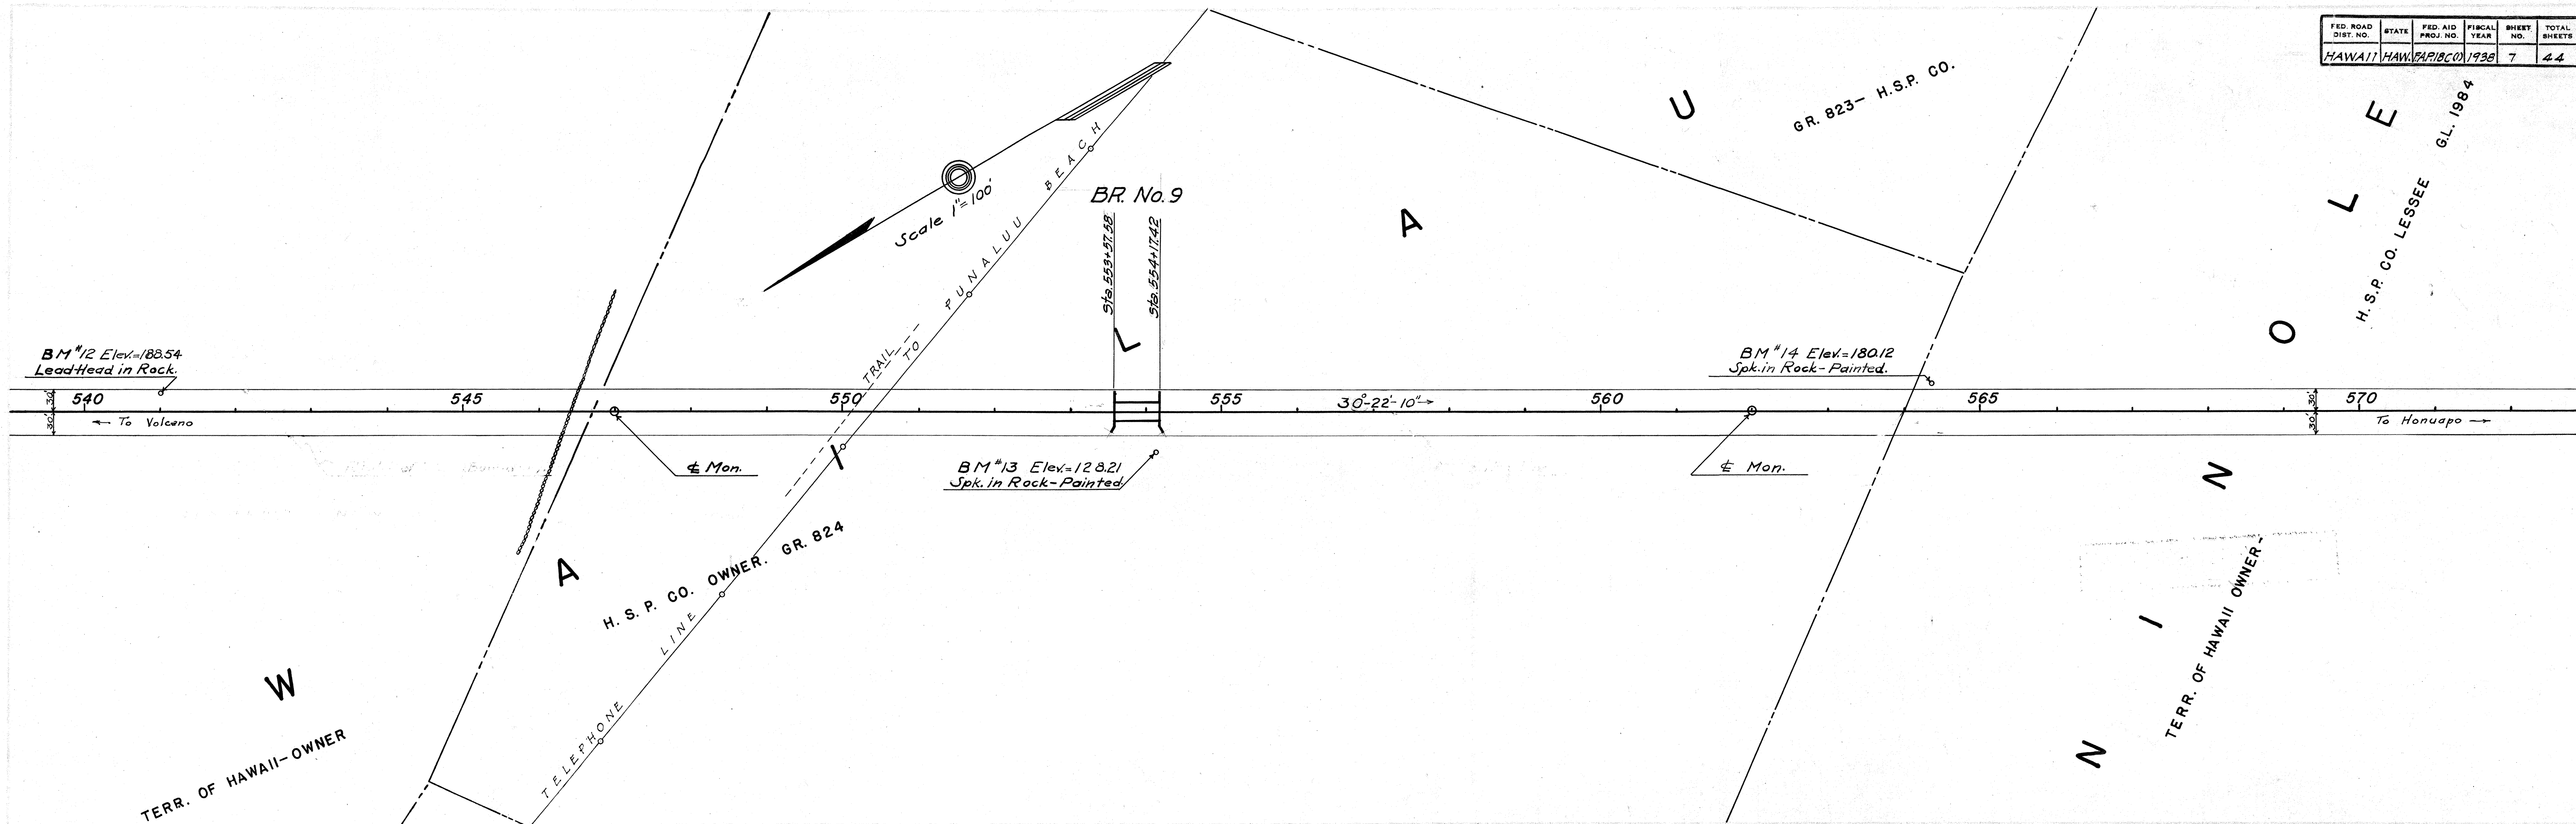


FED. ROAD DIST. NO.	STATE	FED. AID PROJ. NO.	FISCAL YEAR	SHEET NO.	TOTAL SHEETS
HAWAII	HAW.	FAPBCO	1938	8	44

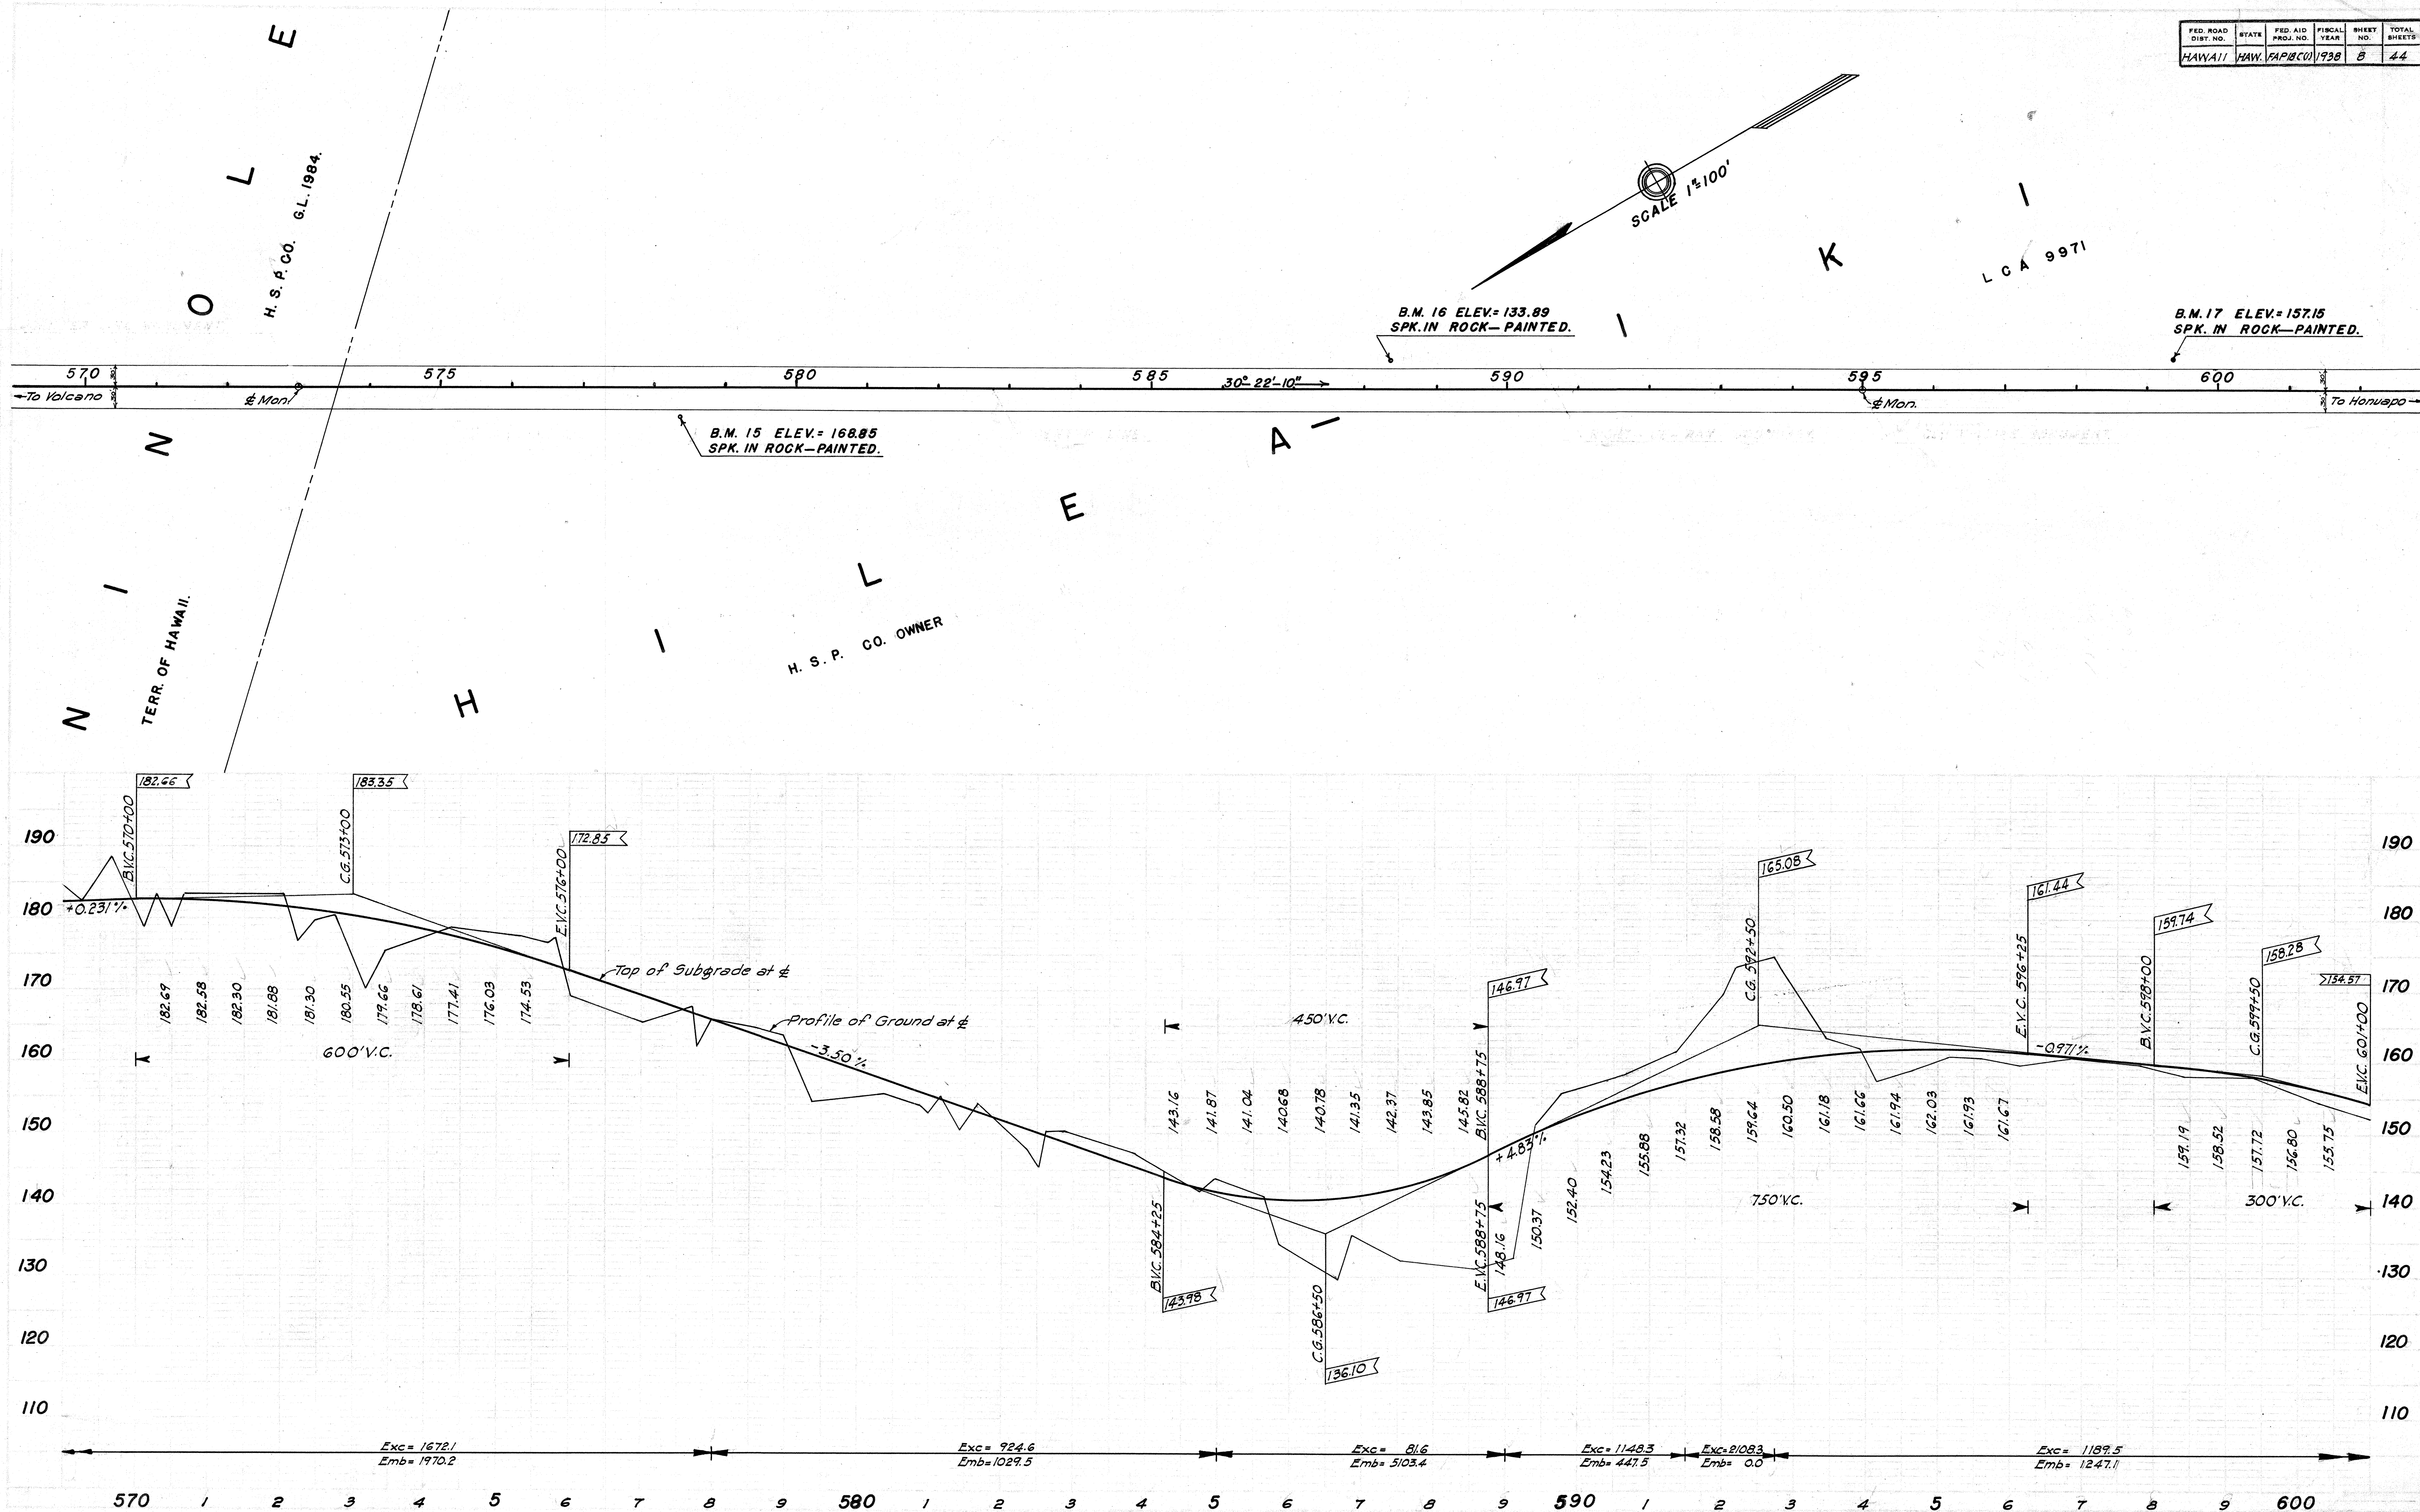

4478.S

FED. ROAD DIST. NO.	STATE	FED. AID PROJ. NO.	FISCAL YEAR	SHEET NO.	TOTAL SHEETS
HAWAII	HAW.	FAP18C(1)	1938	9	44

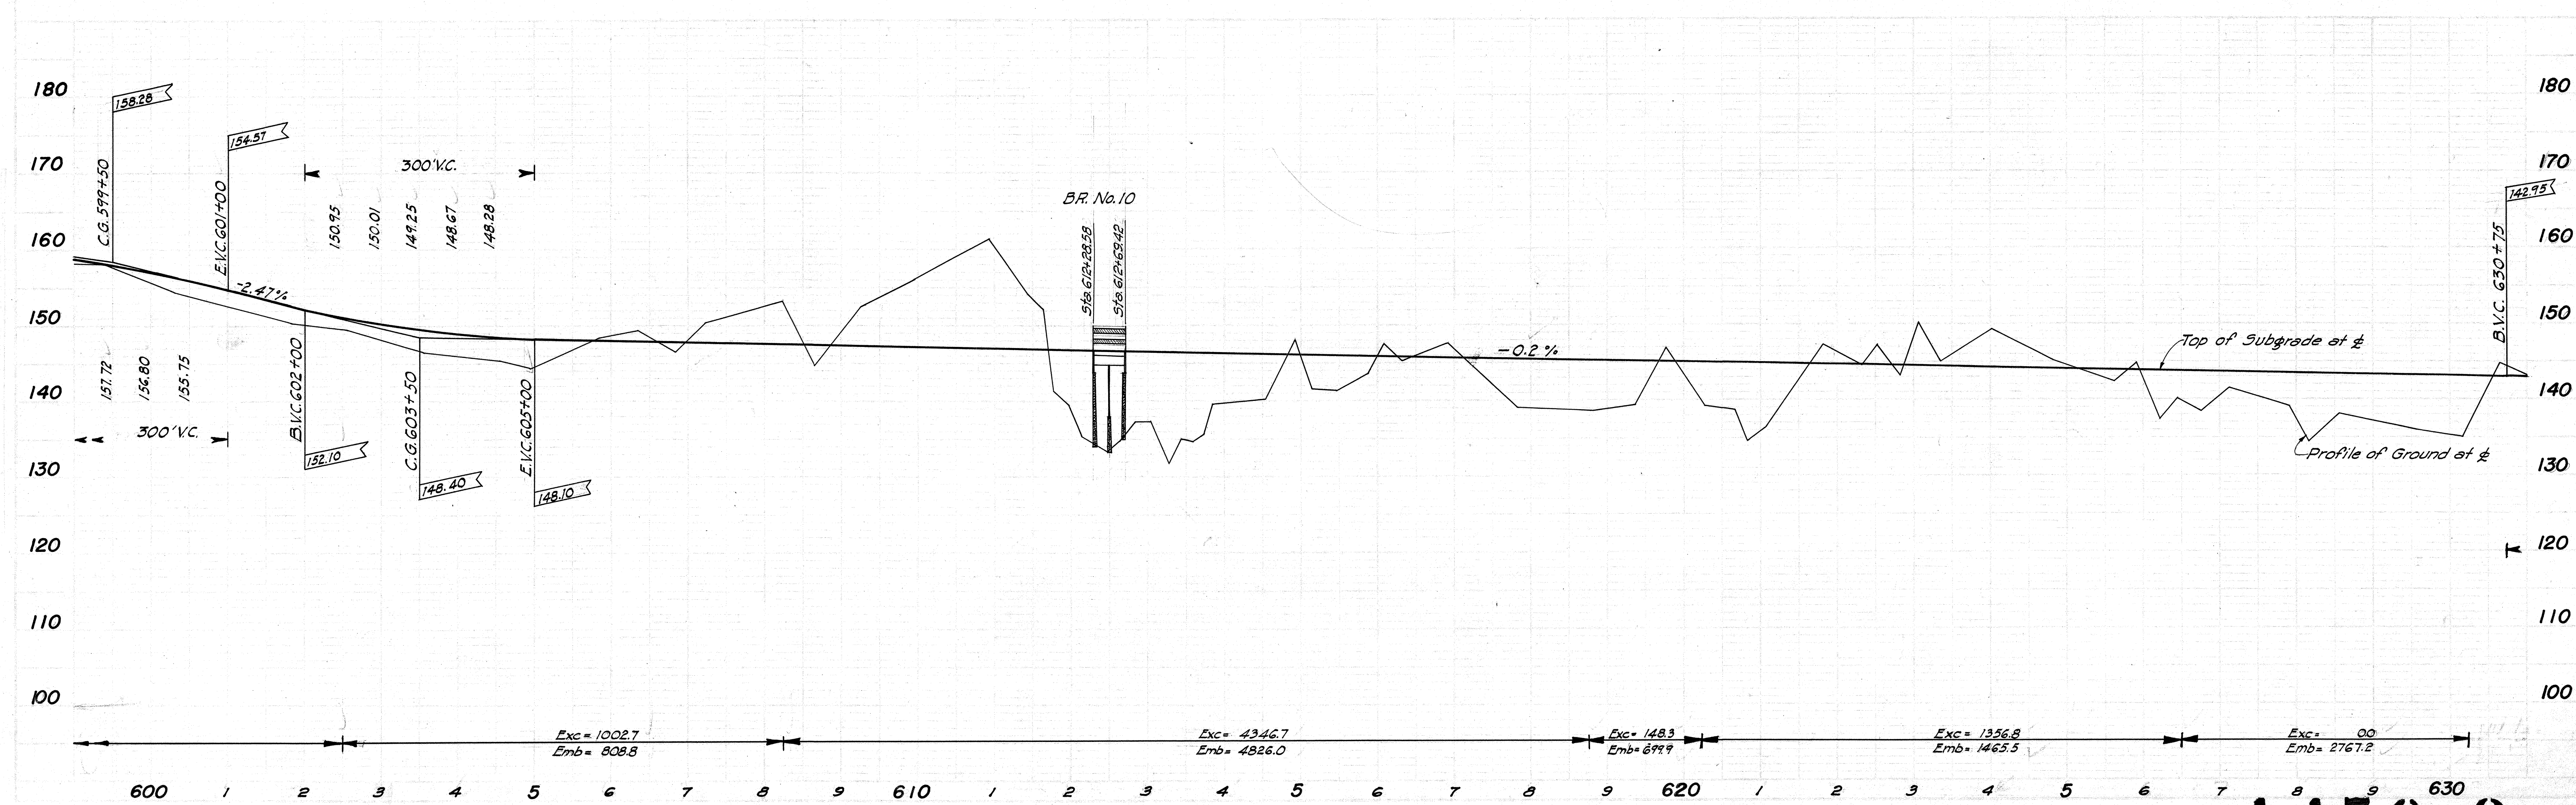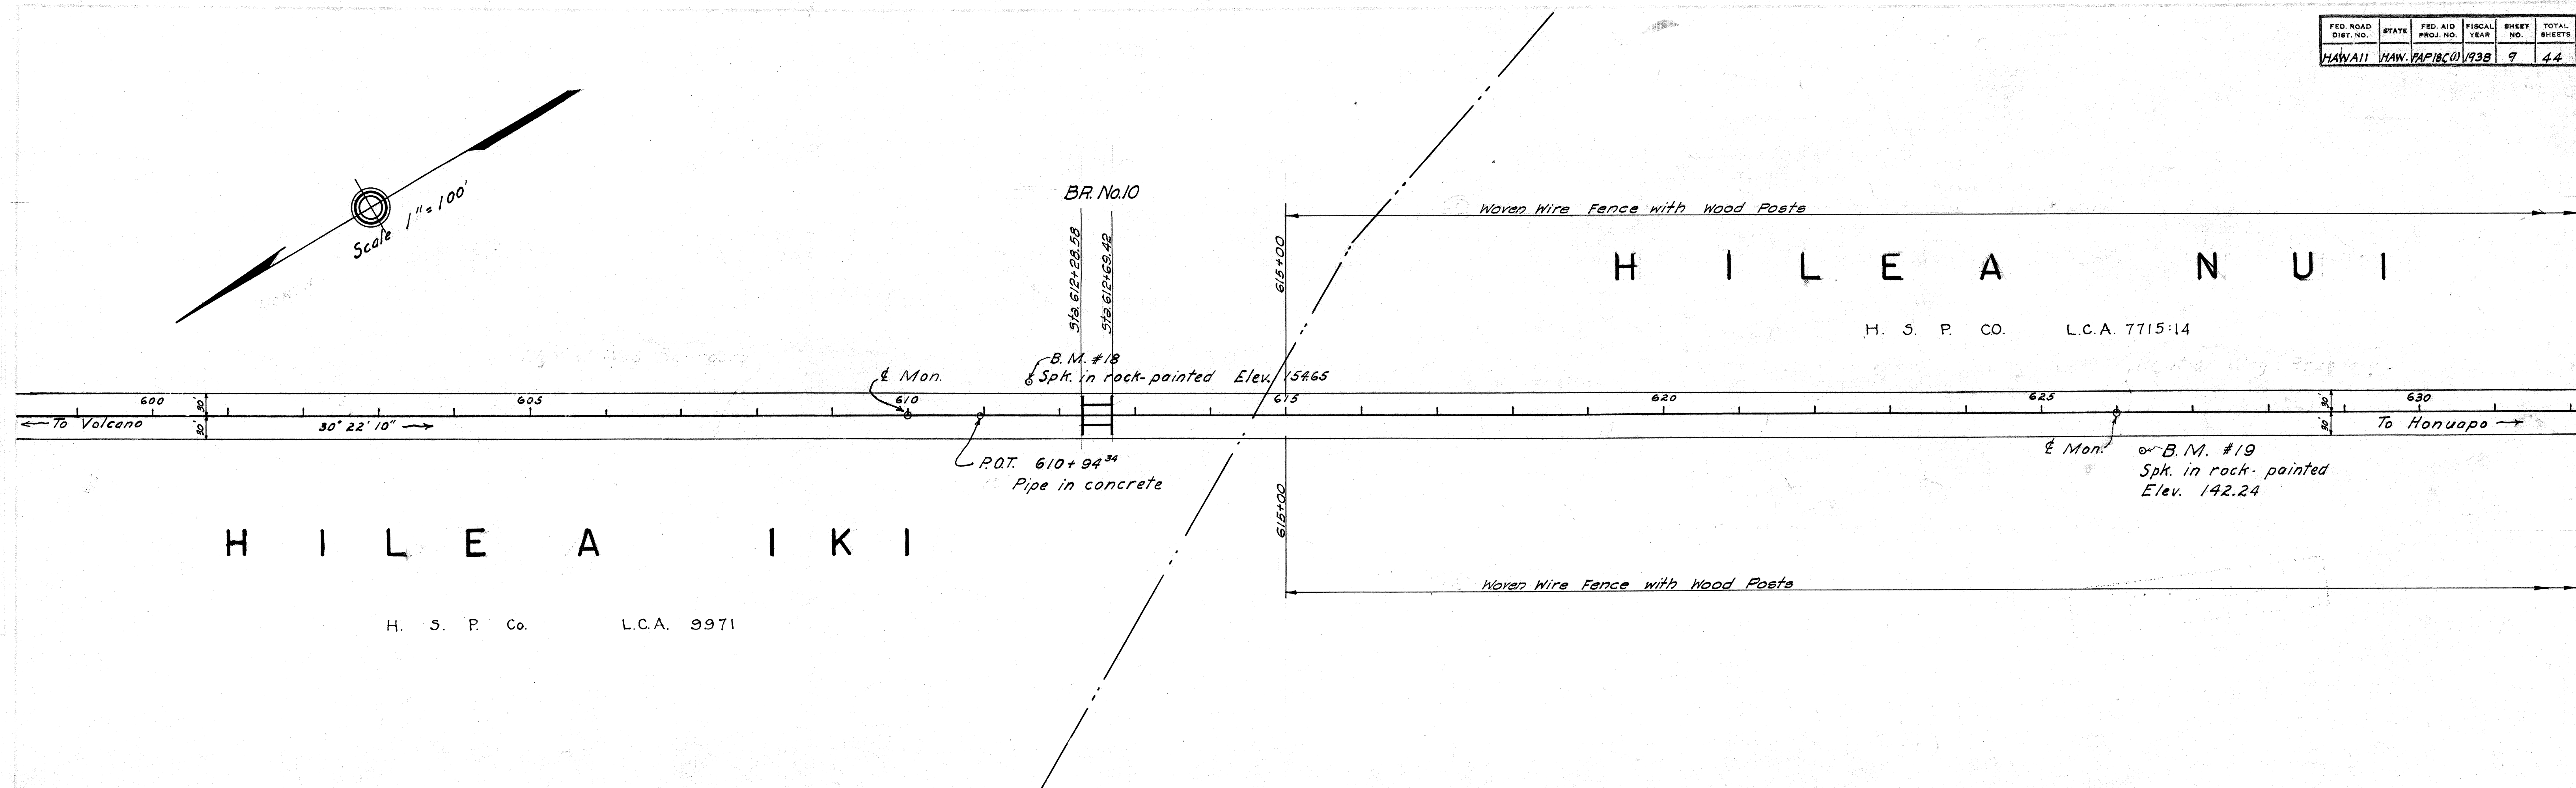


4478.9

FED. ROAD DIST. NO.	STATE	FED. AID PROJ. NO.	FISCAL YEAR	SHEET NO.	TOTAL SHEETS
HAWAII	HAWAII	PAP/BCU	1938	10	44

H I L E A N U I

H. S. P. CO. L. C. A. 9 9 7 1


SCALE 1"=100'

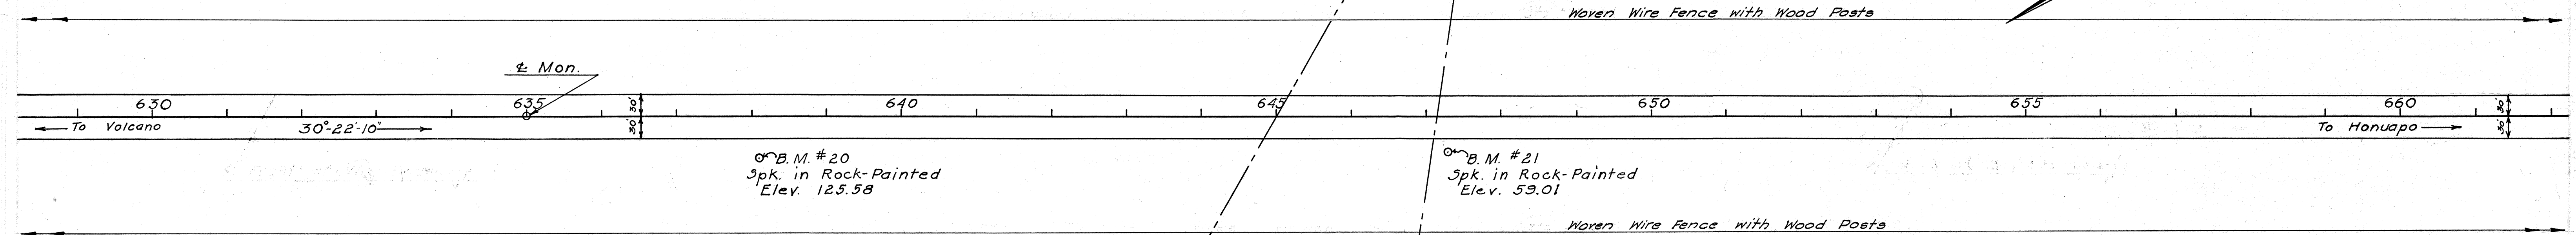



K A A L A I K I

H. S. P. CO.
G R A N T 2 6 4 8

MASARU OKUNO 3/5
MRS. KAHILANI KUMUKOA 1/5
MRS. LIZZIE NAPOLEON 1/5


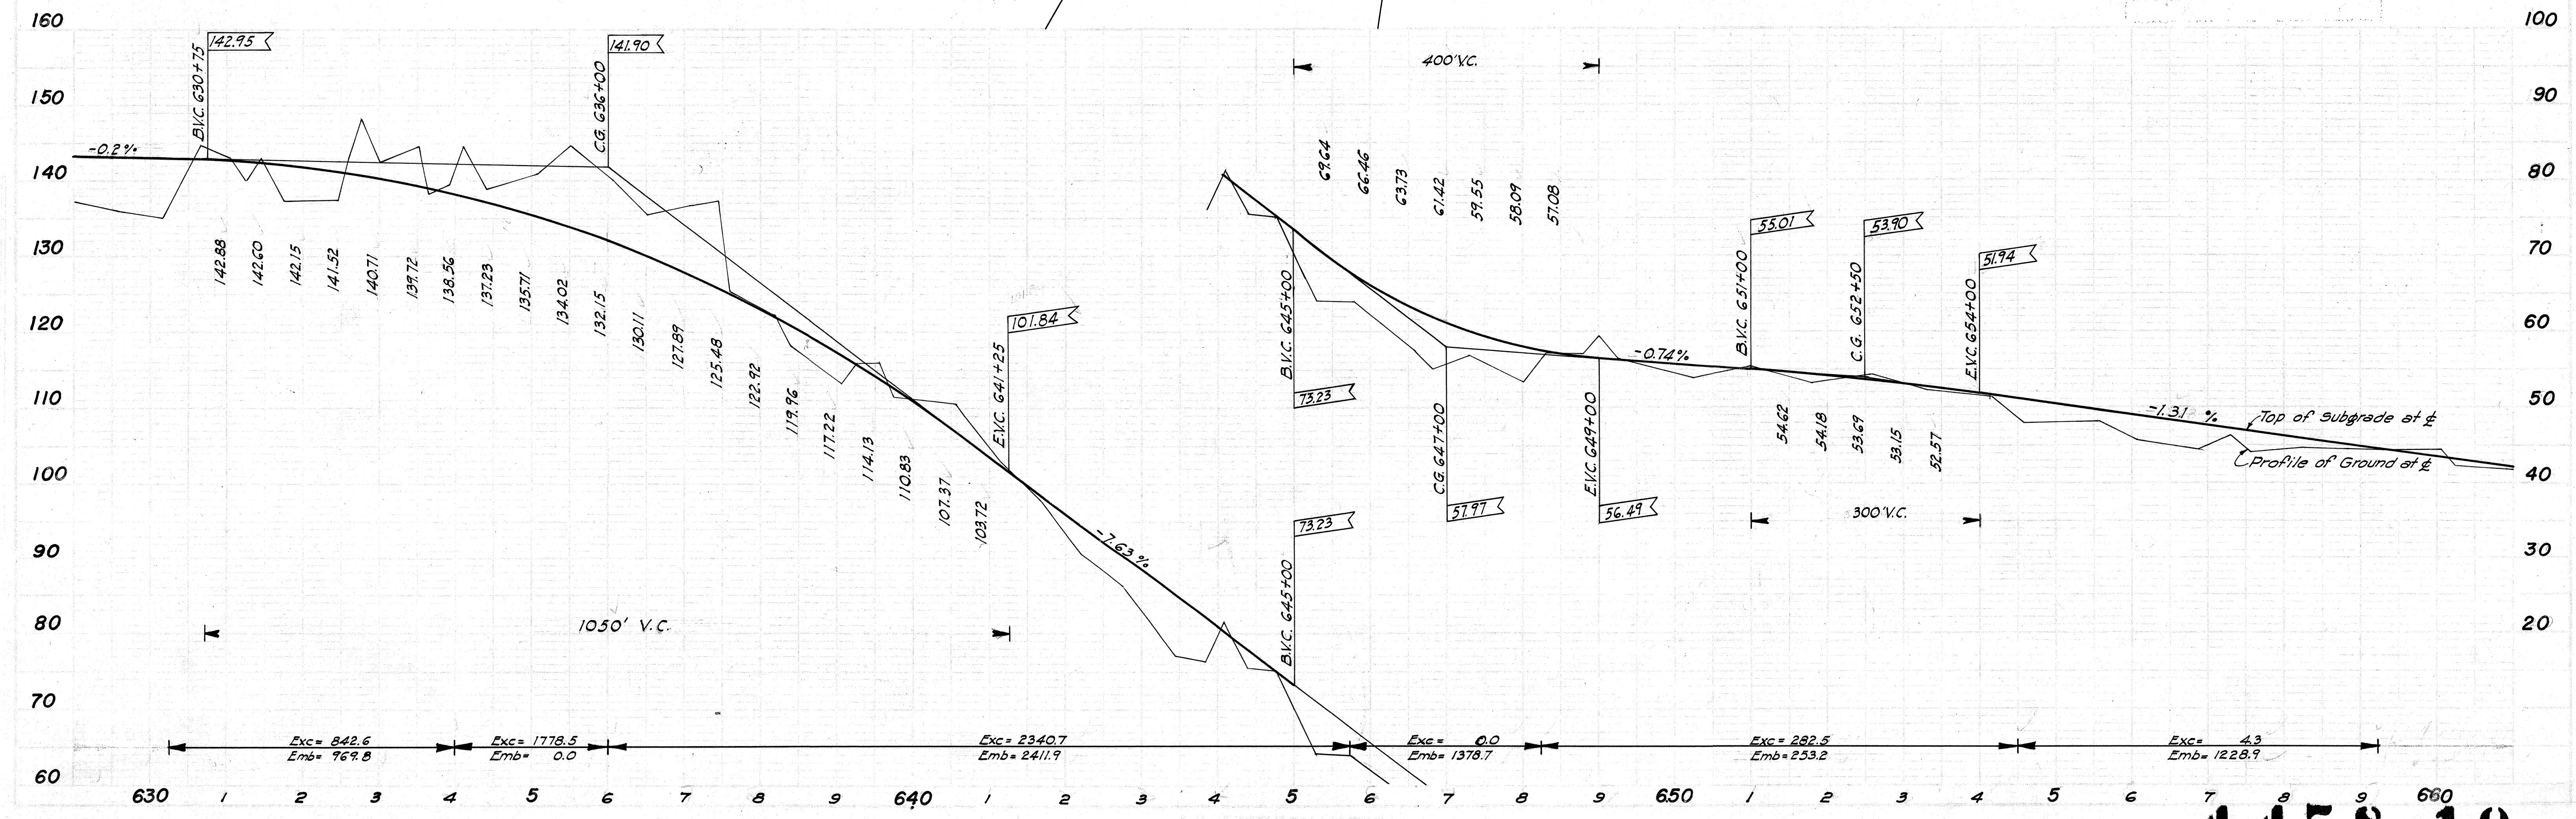


FED. ROAD DIST. NO.	STATE	FED. AID PROJ. NO.	FISCAL YEAR	SHEET NO.	TOTAL SHEETS
HAWAII	HAW.	FAP 18C01	1938	11	44

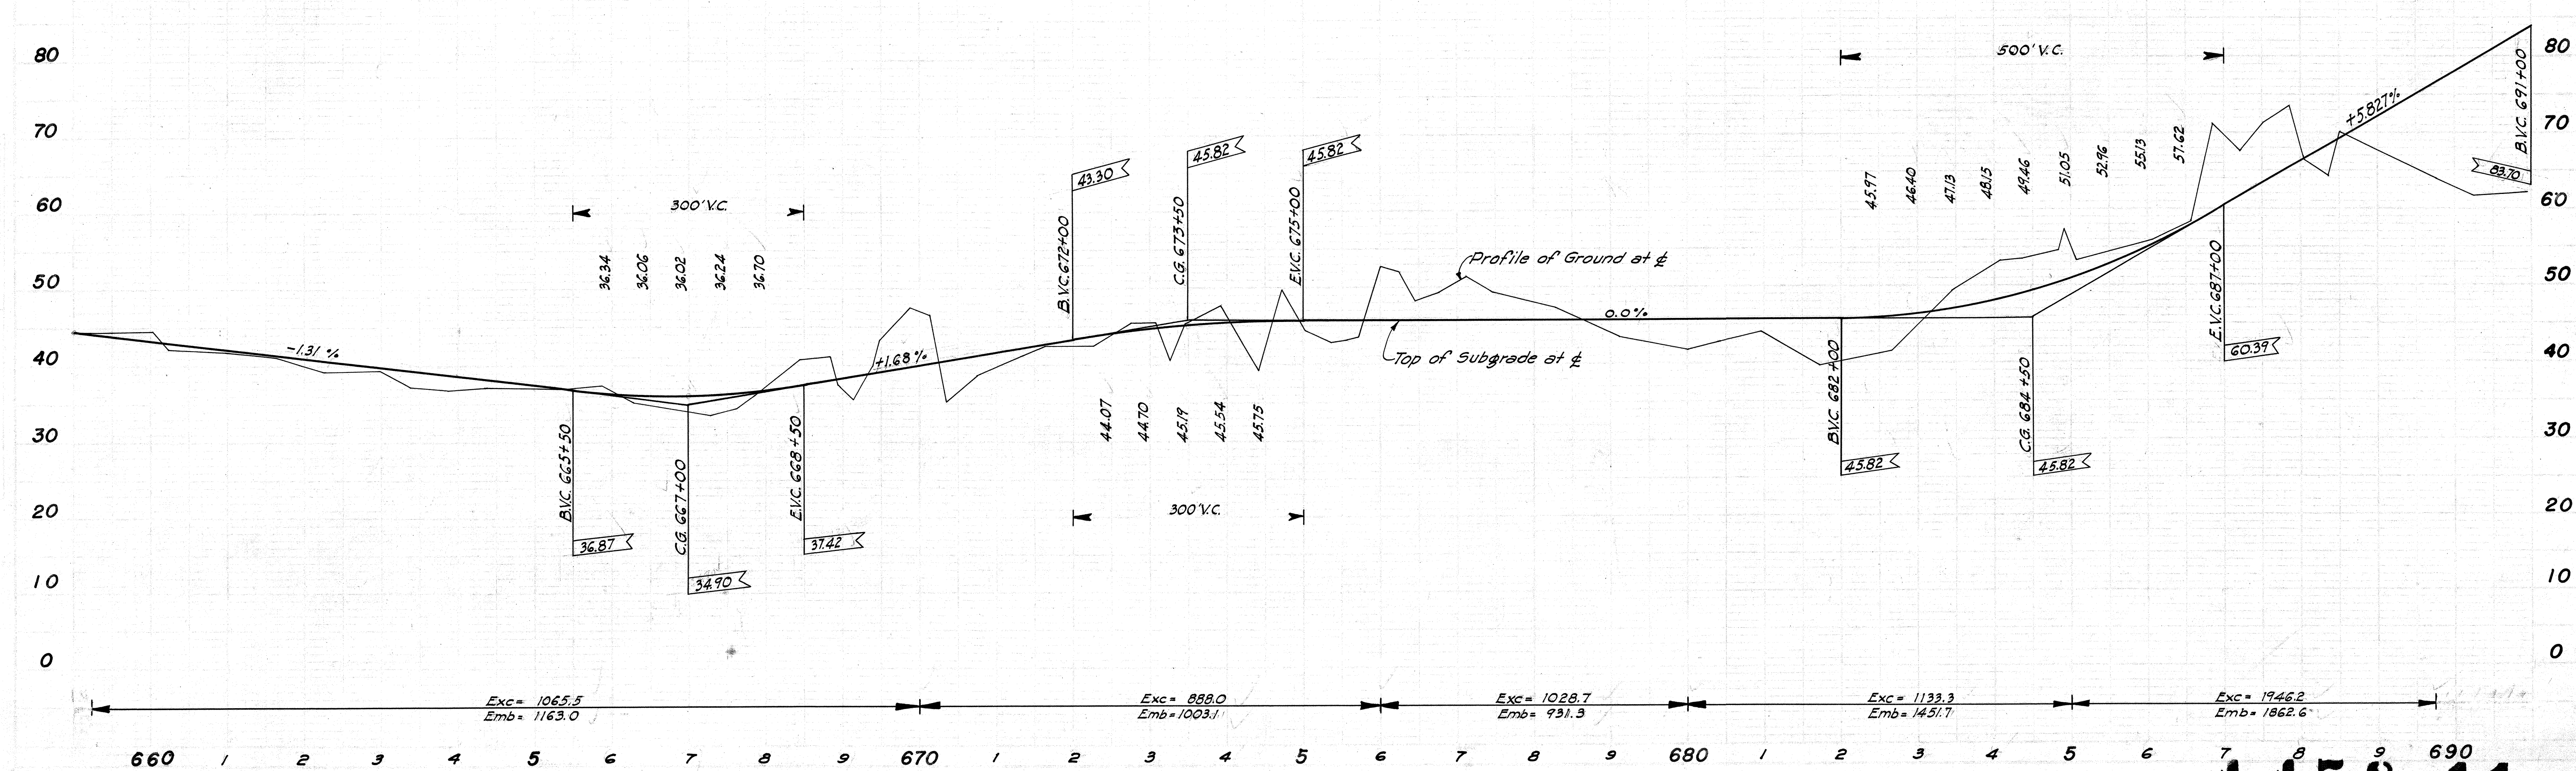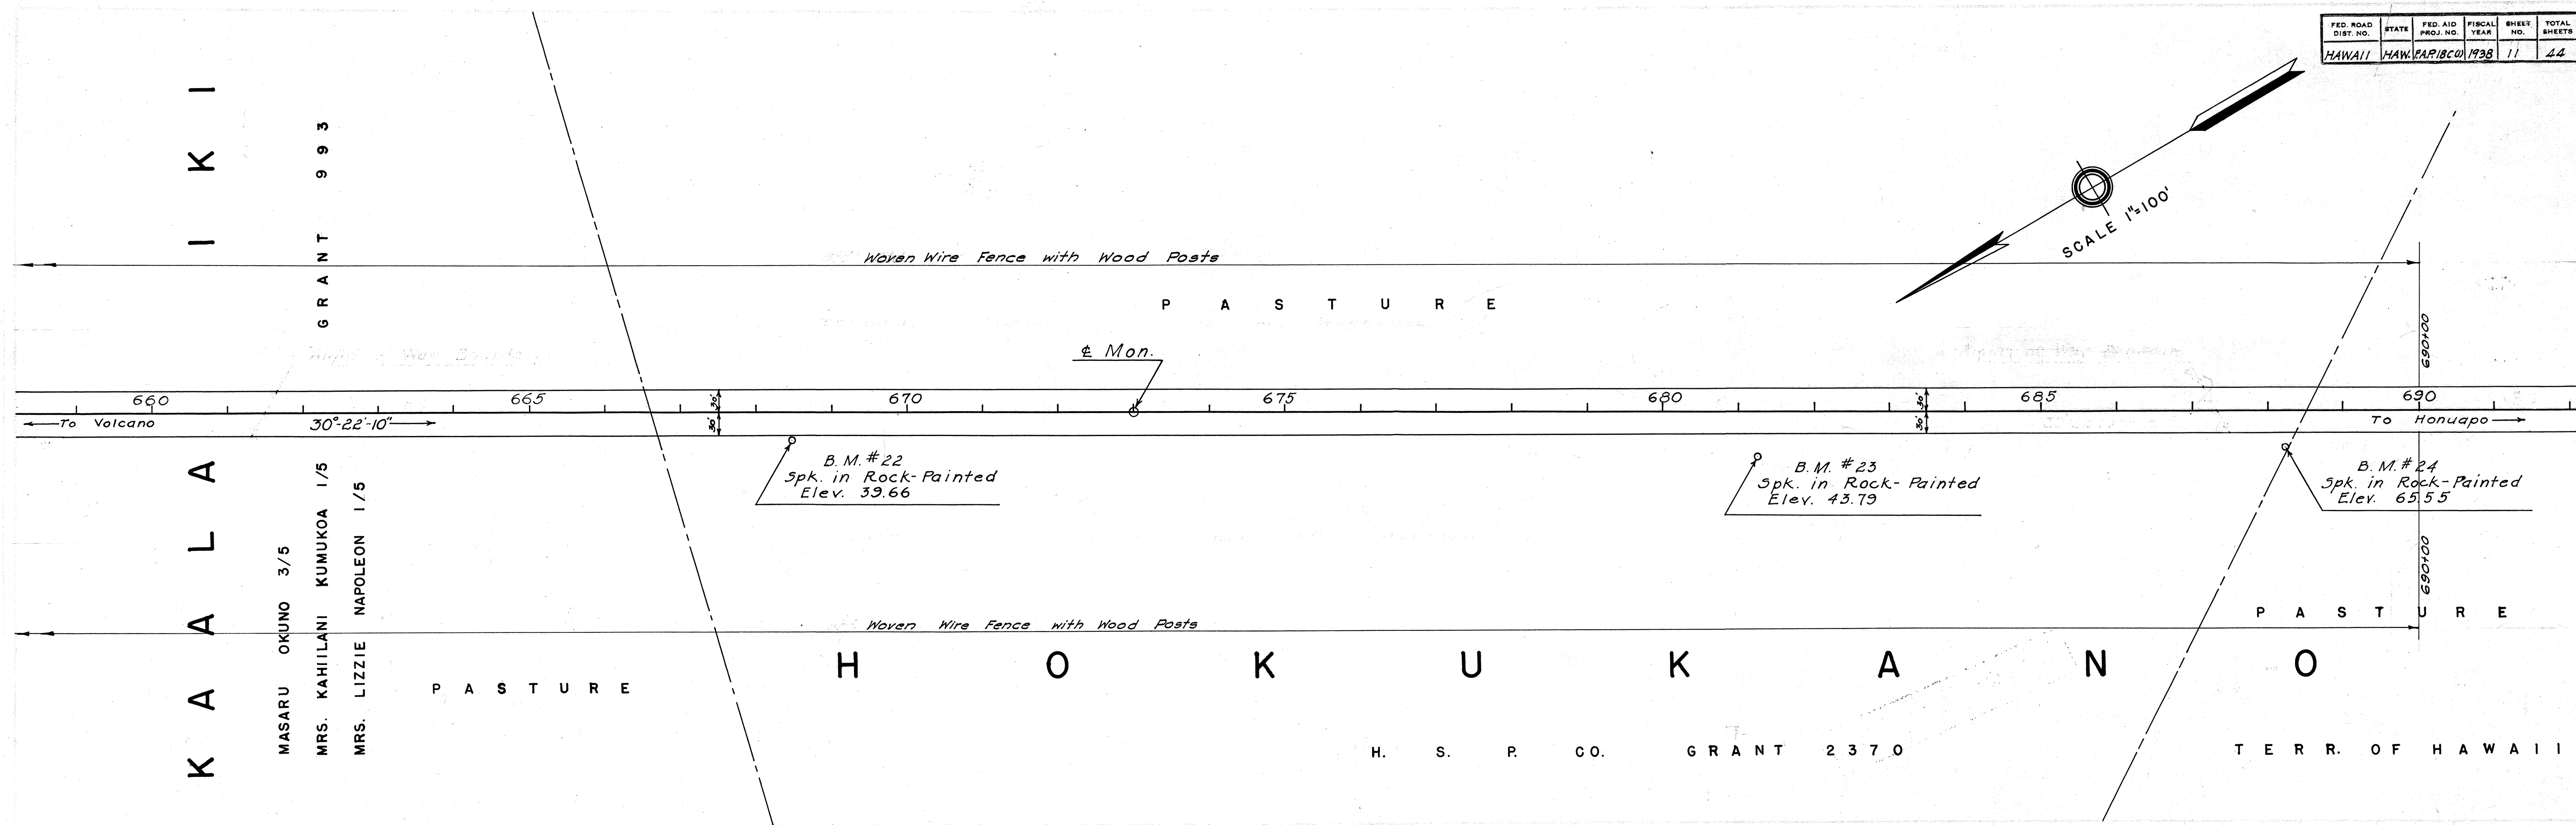


4478.11

FED. ROAD DIST. NO.	STATE	FED. AID PROJ. NO.	FISCAL YEAR	SHEET NO.	TOTAL SHEETS
HAWAII	HAW.	FAP18C0	1938	12	44

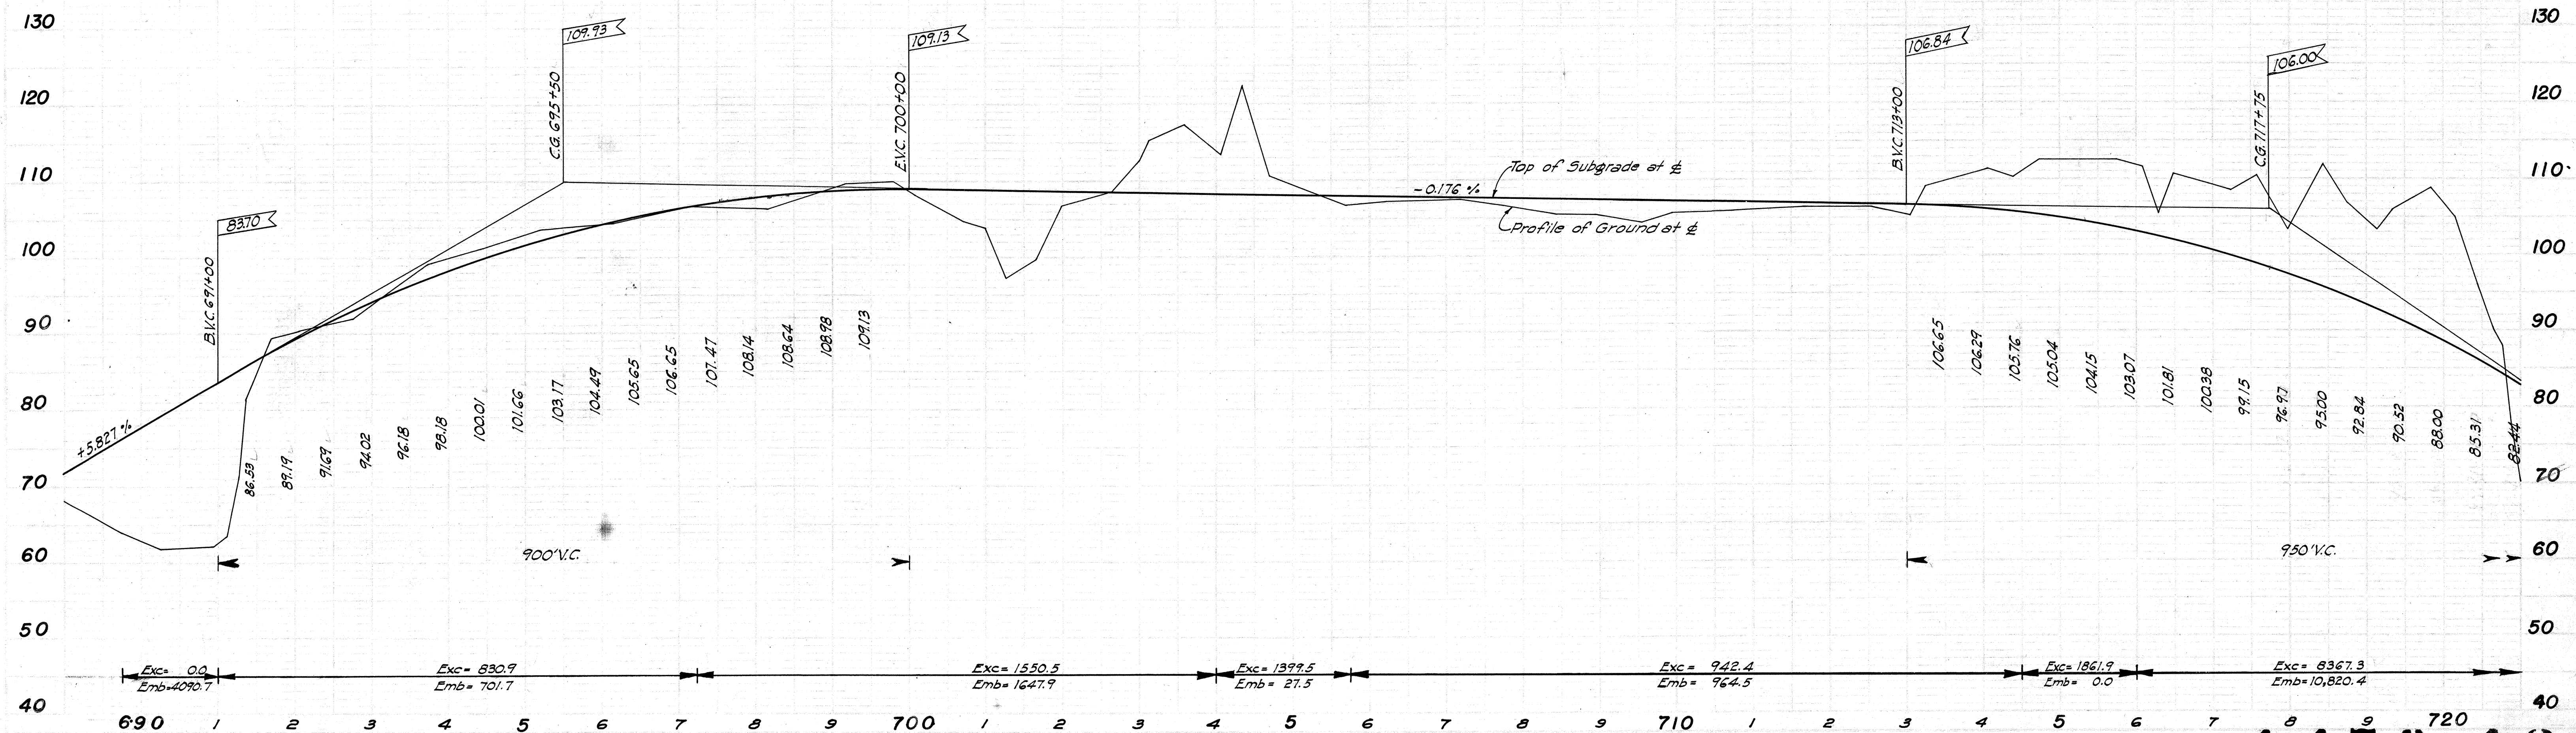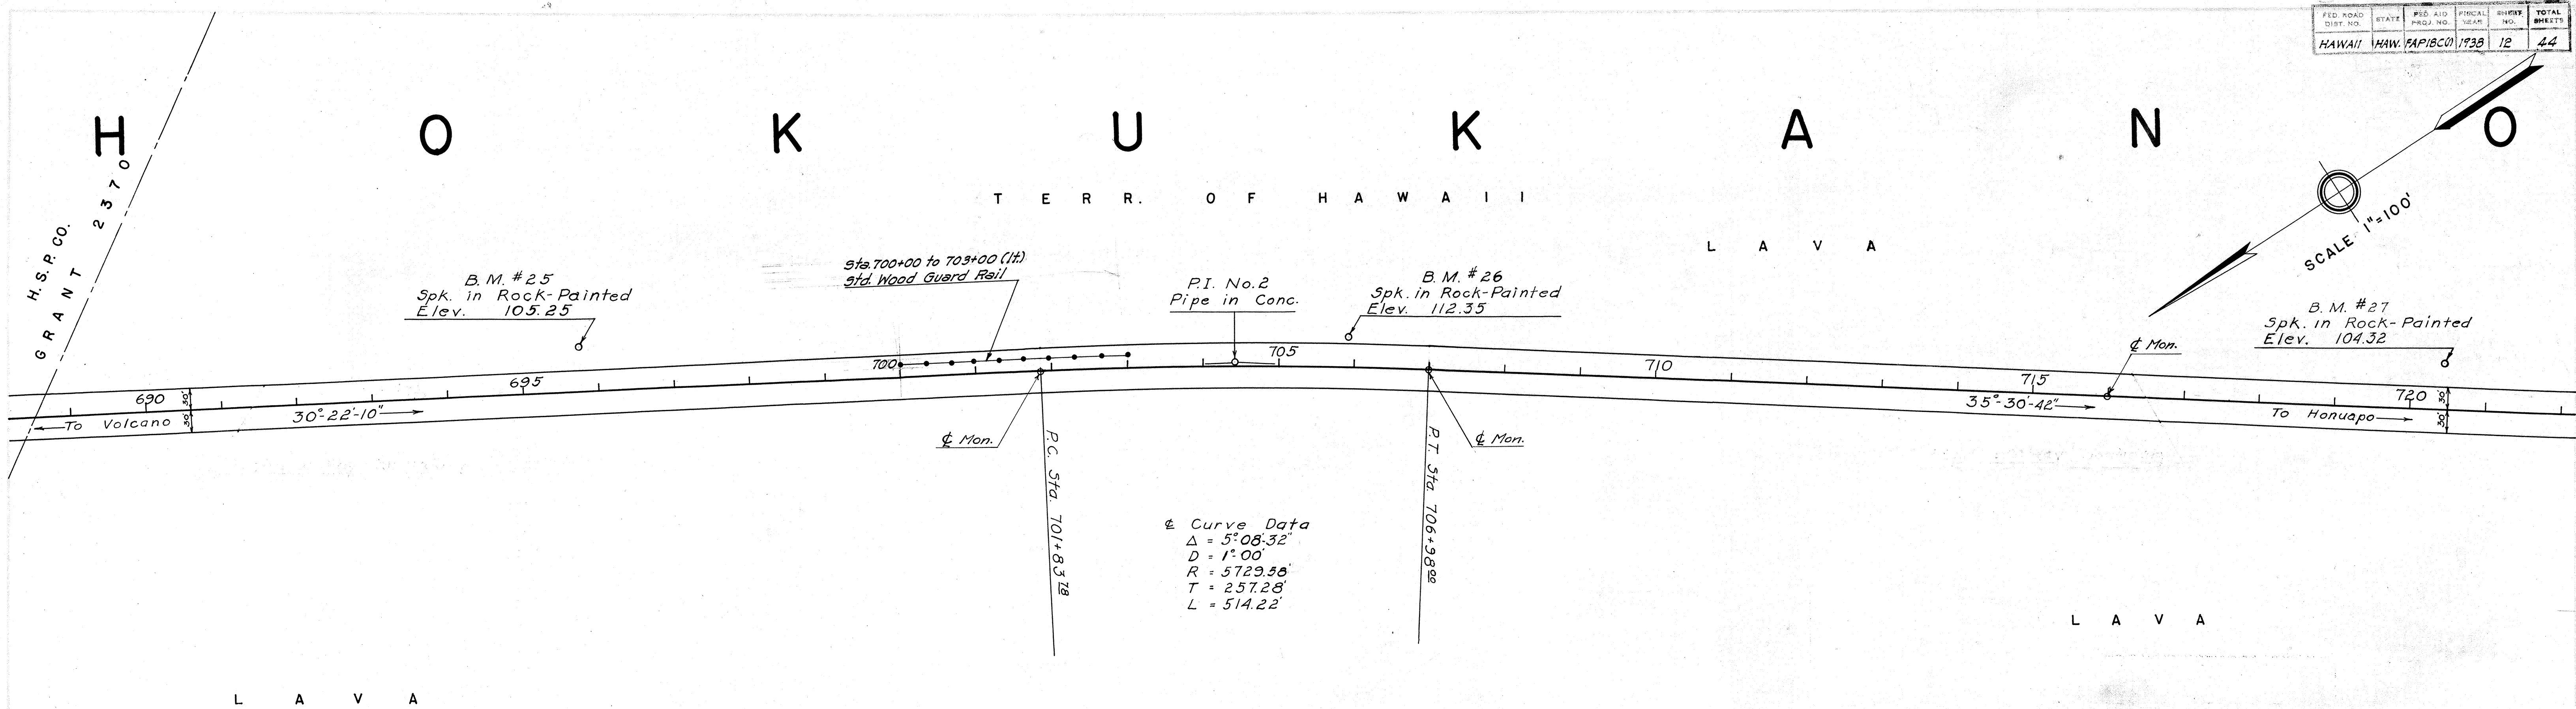


4478.12

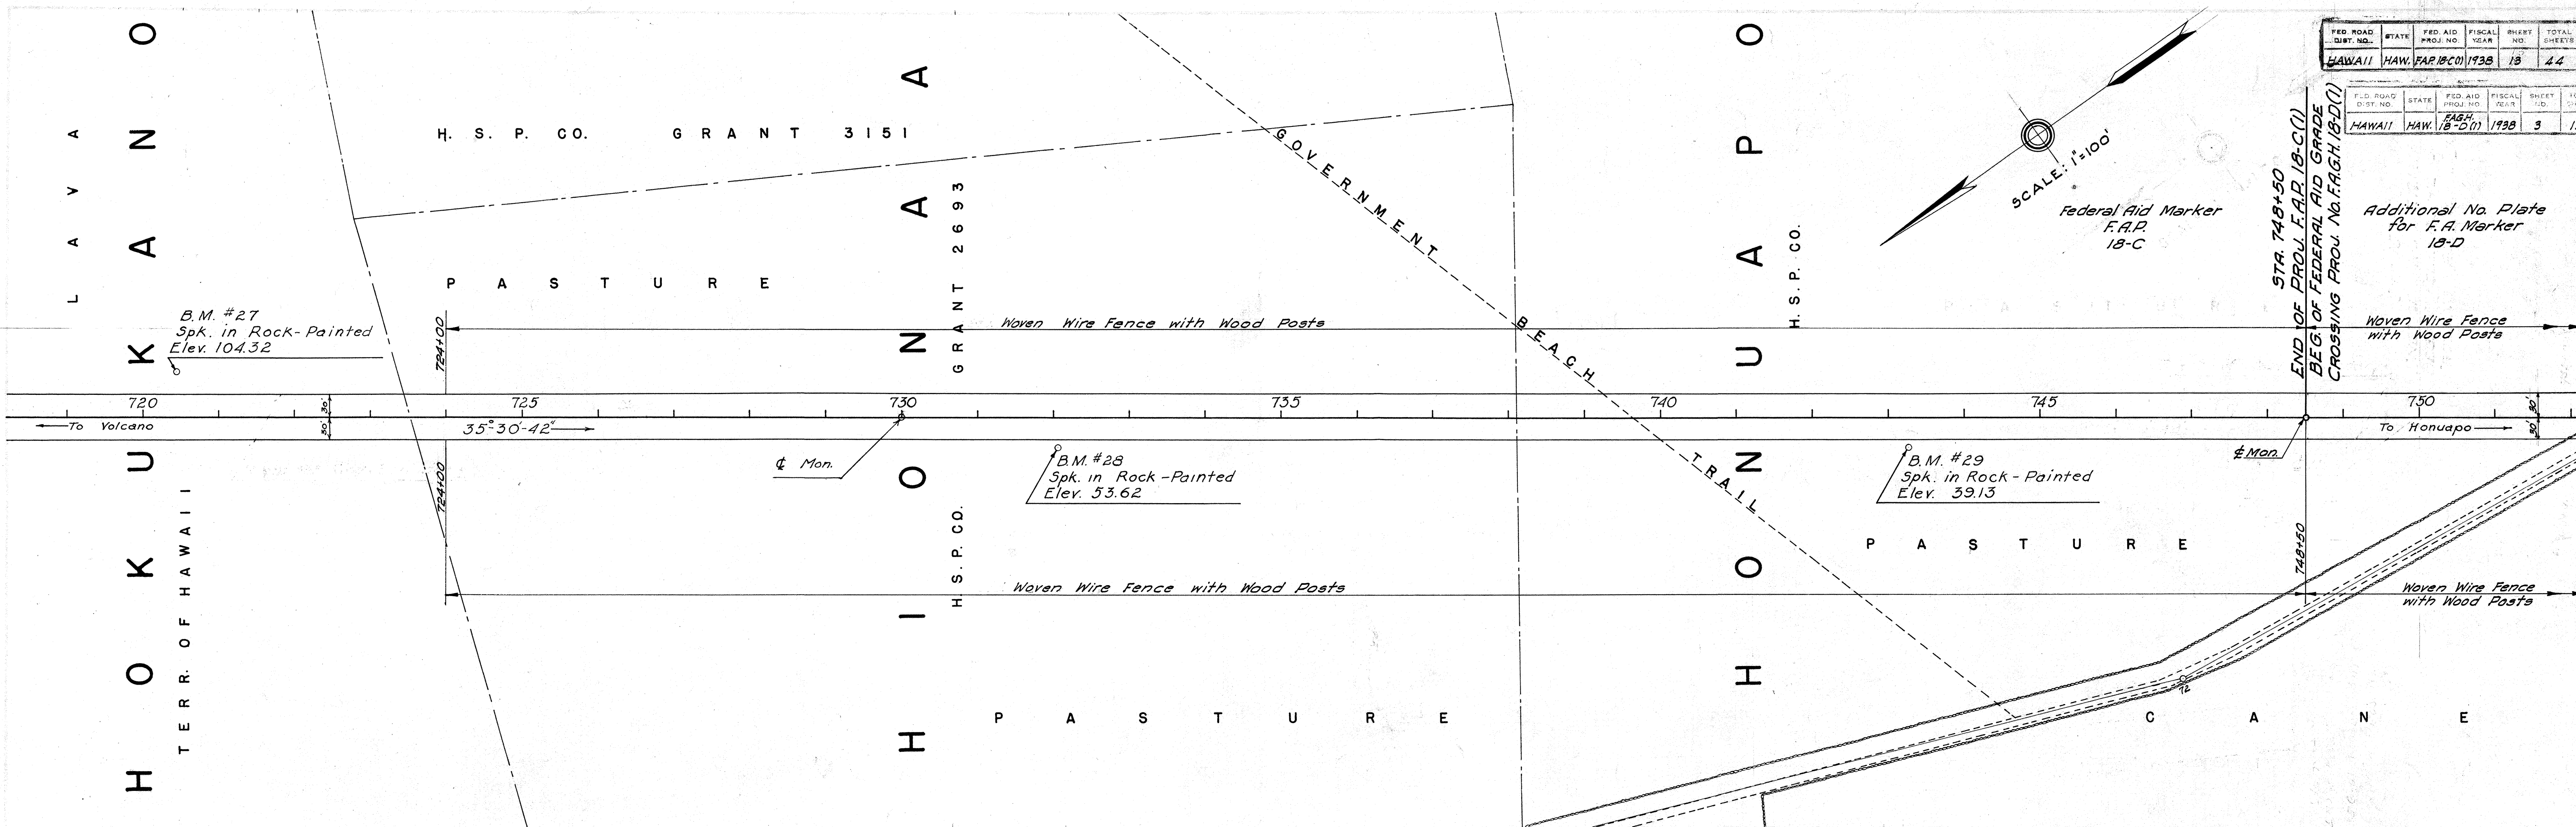

FED. ROAD DIST. NO.	STATE	FED. AID PROJ. NO.	FISCAL YEAR	SHEET NO.	TOTAL SHEETS
HAWAII	HAW.	FAR 18-C(1)	1938	13	44

F.D. ROAD DIST. NO.	STATE	FED. AID PROJ. NO.	FISCAL YEAR	SHEET NO.	TOTAL SHEETS
HAWAII	HAW.	FAR 18-D(1)	1938	3	15

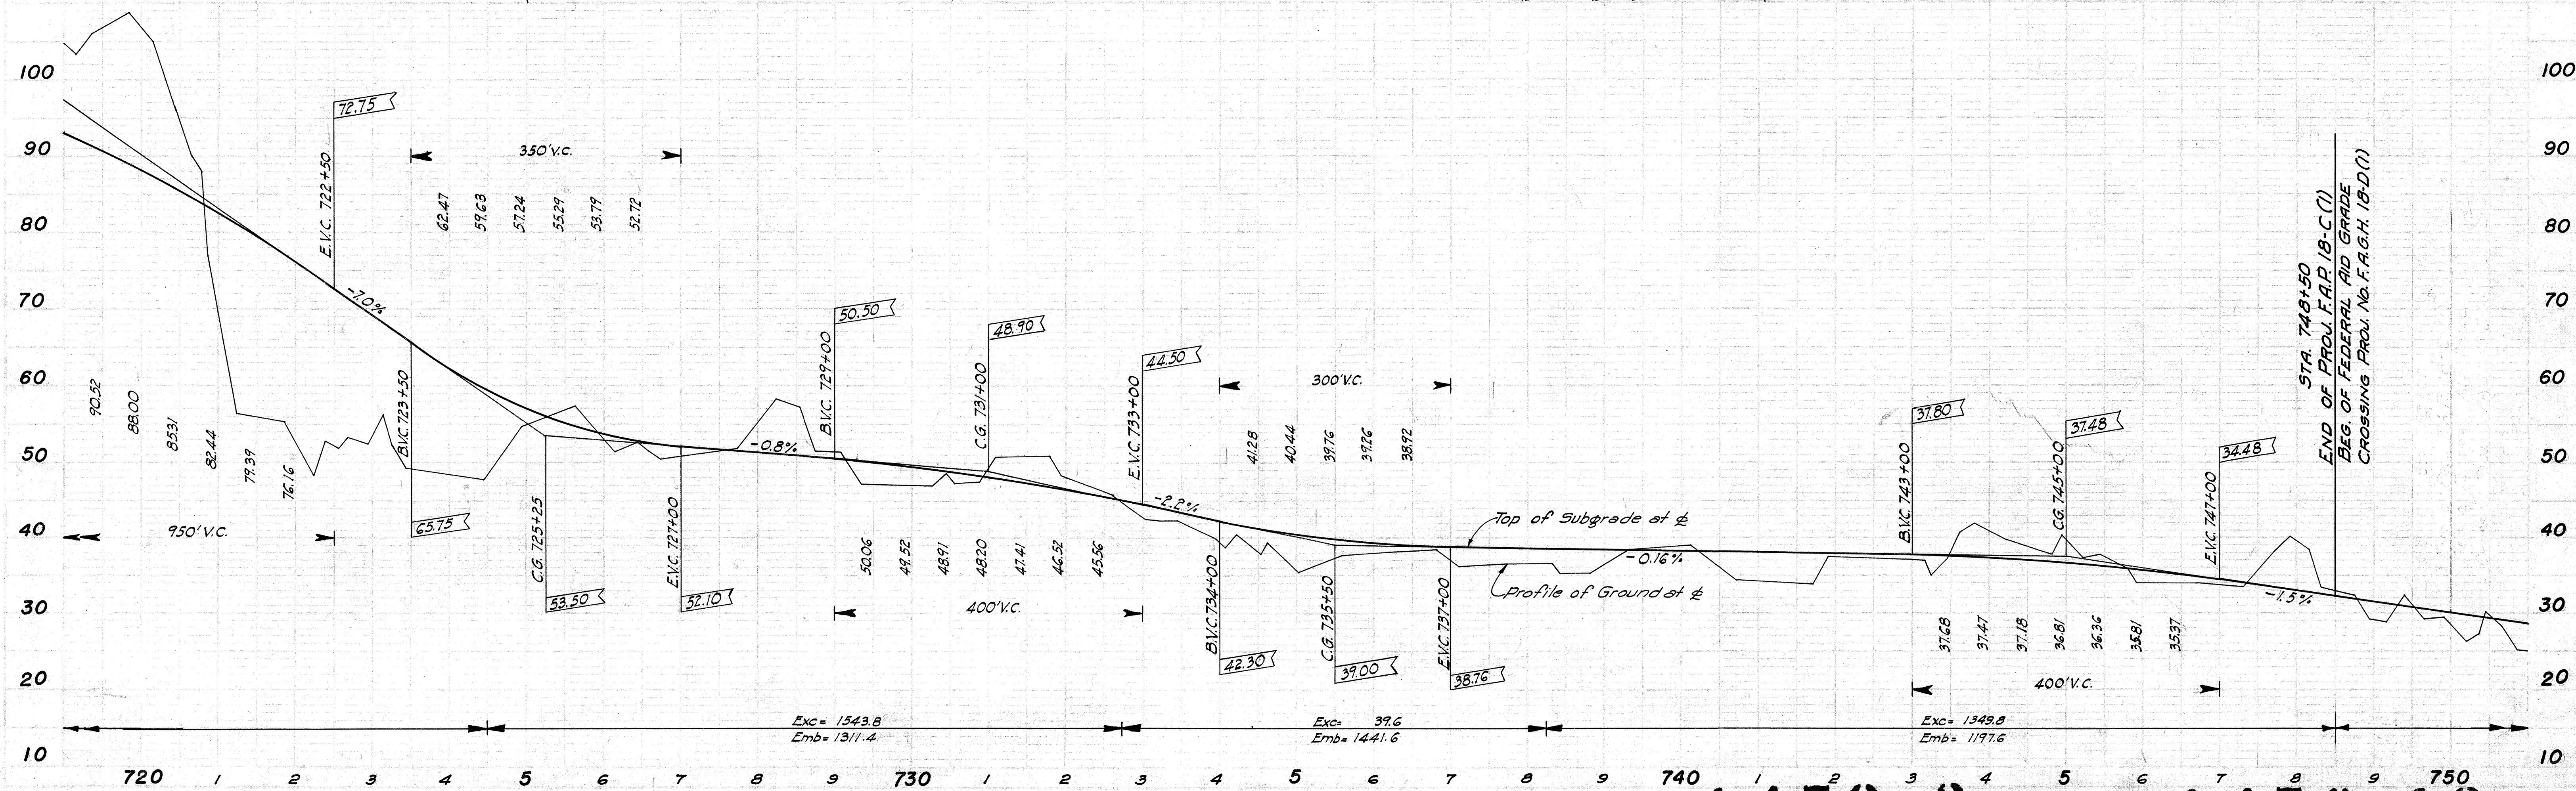

4479.3 4478.13