


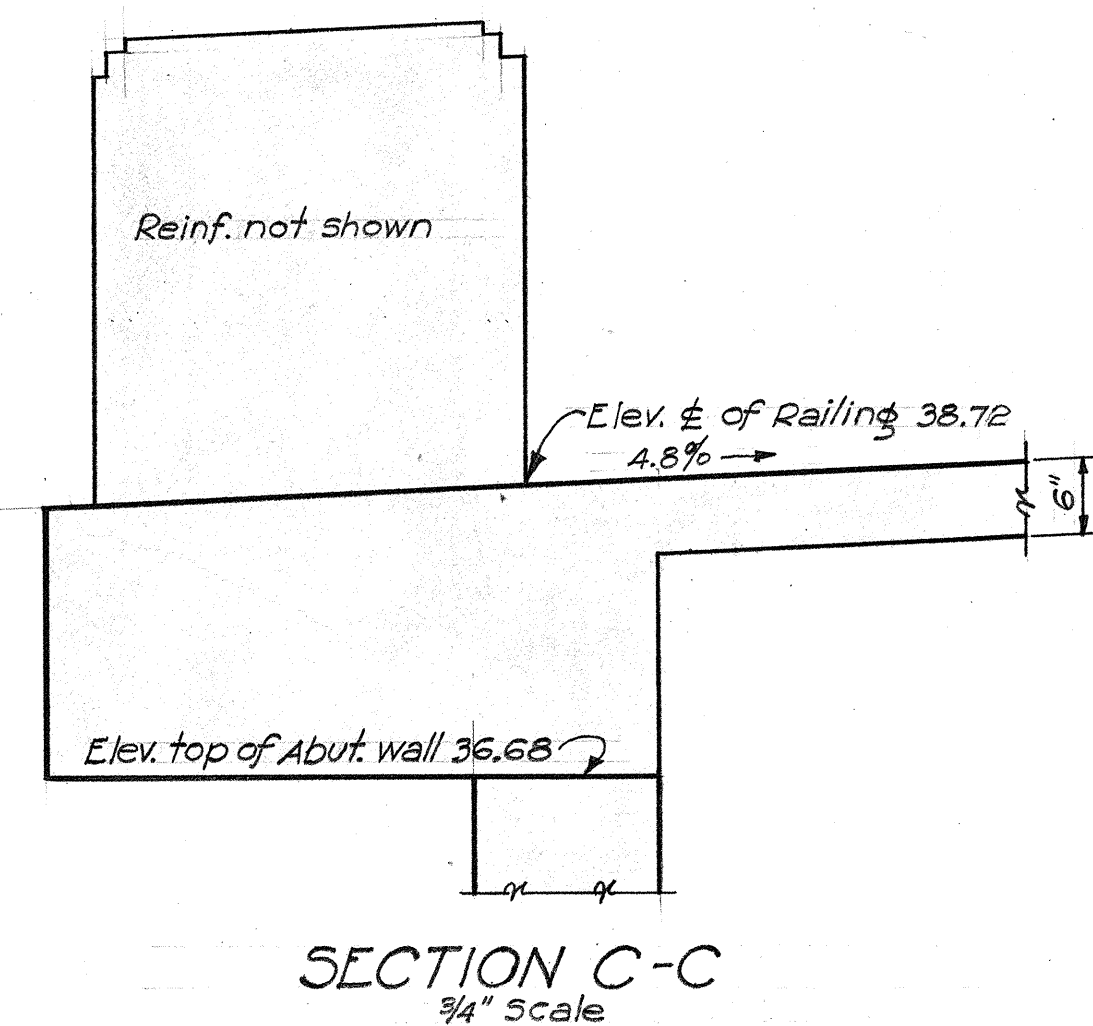
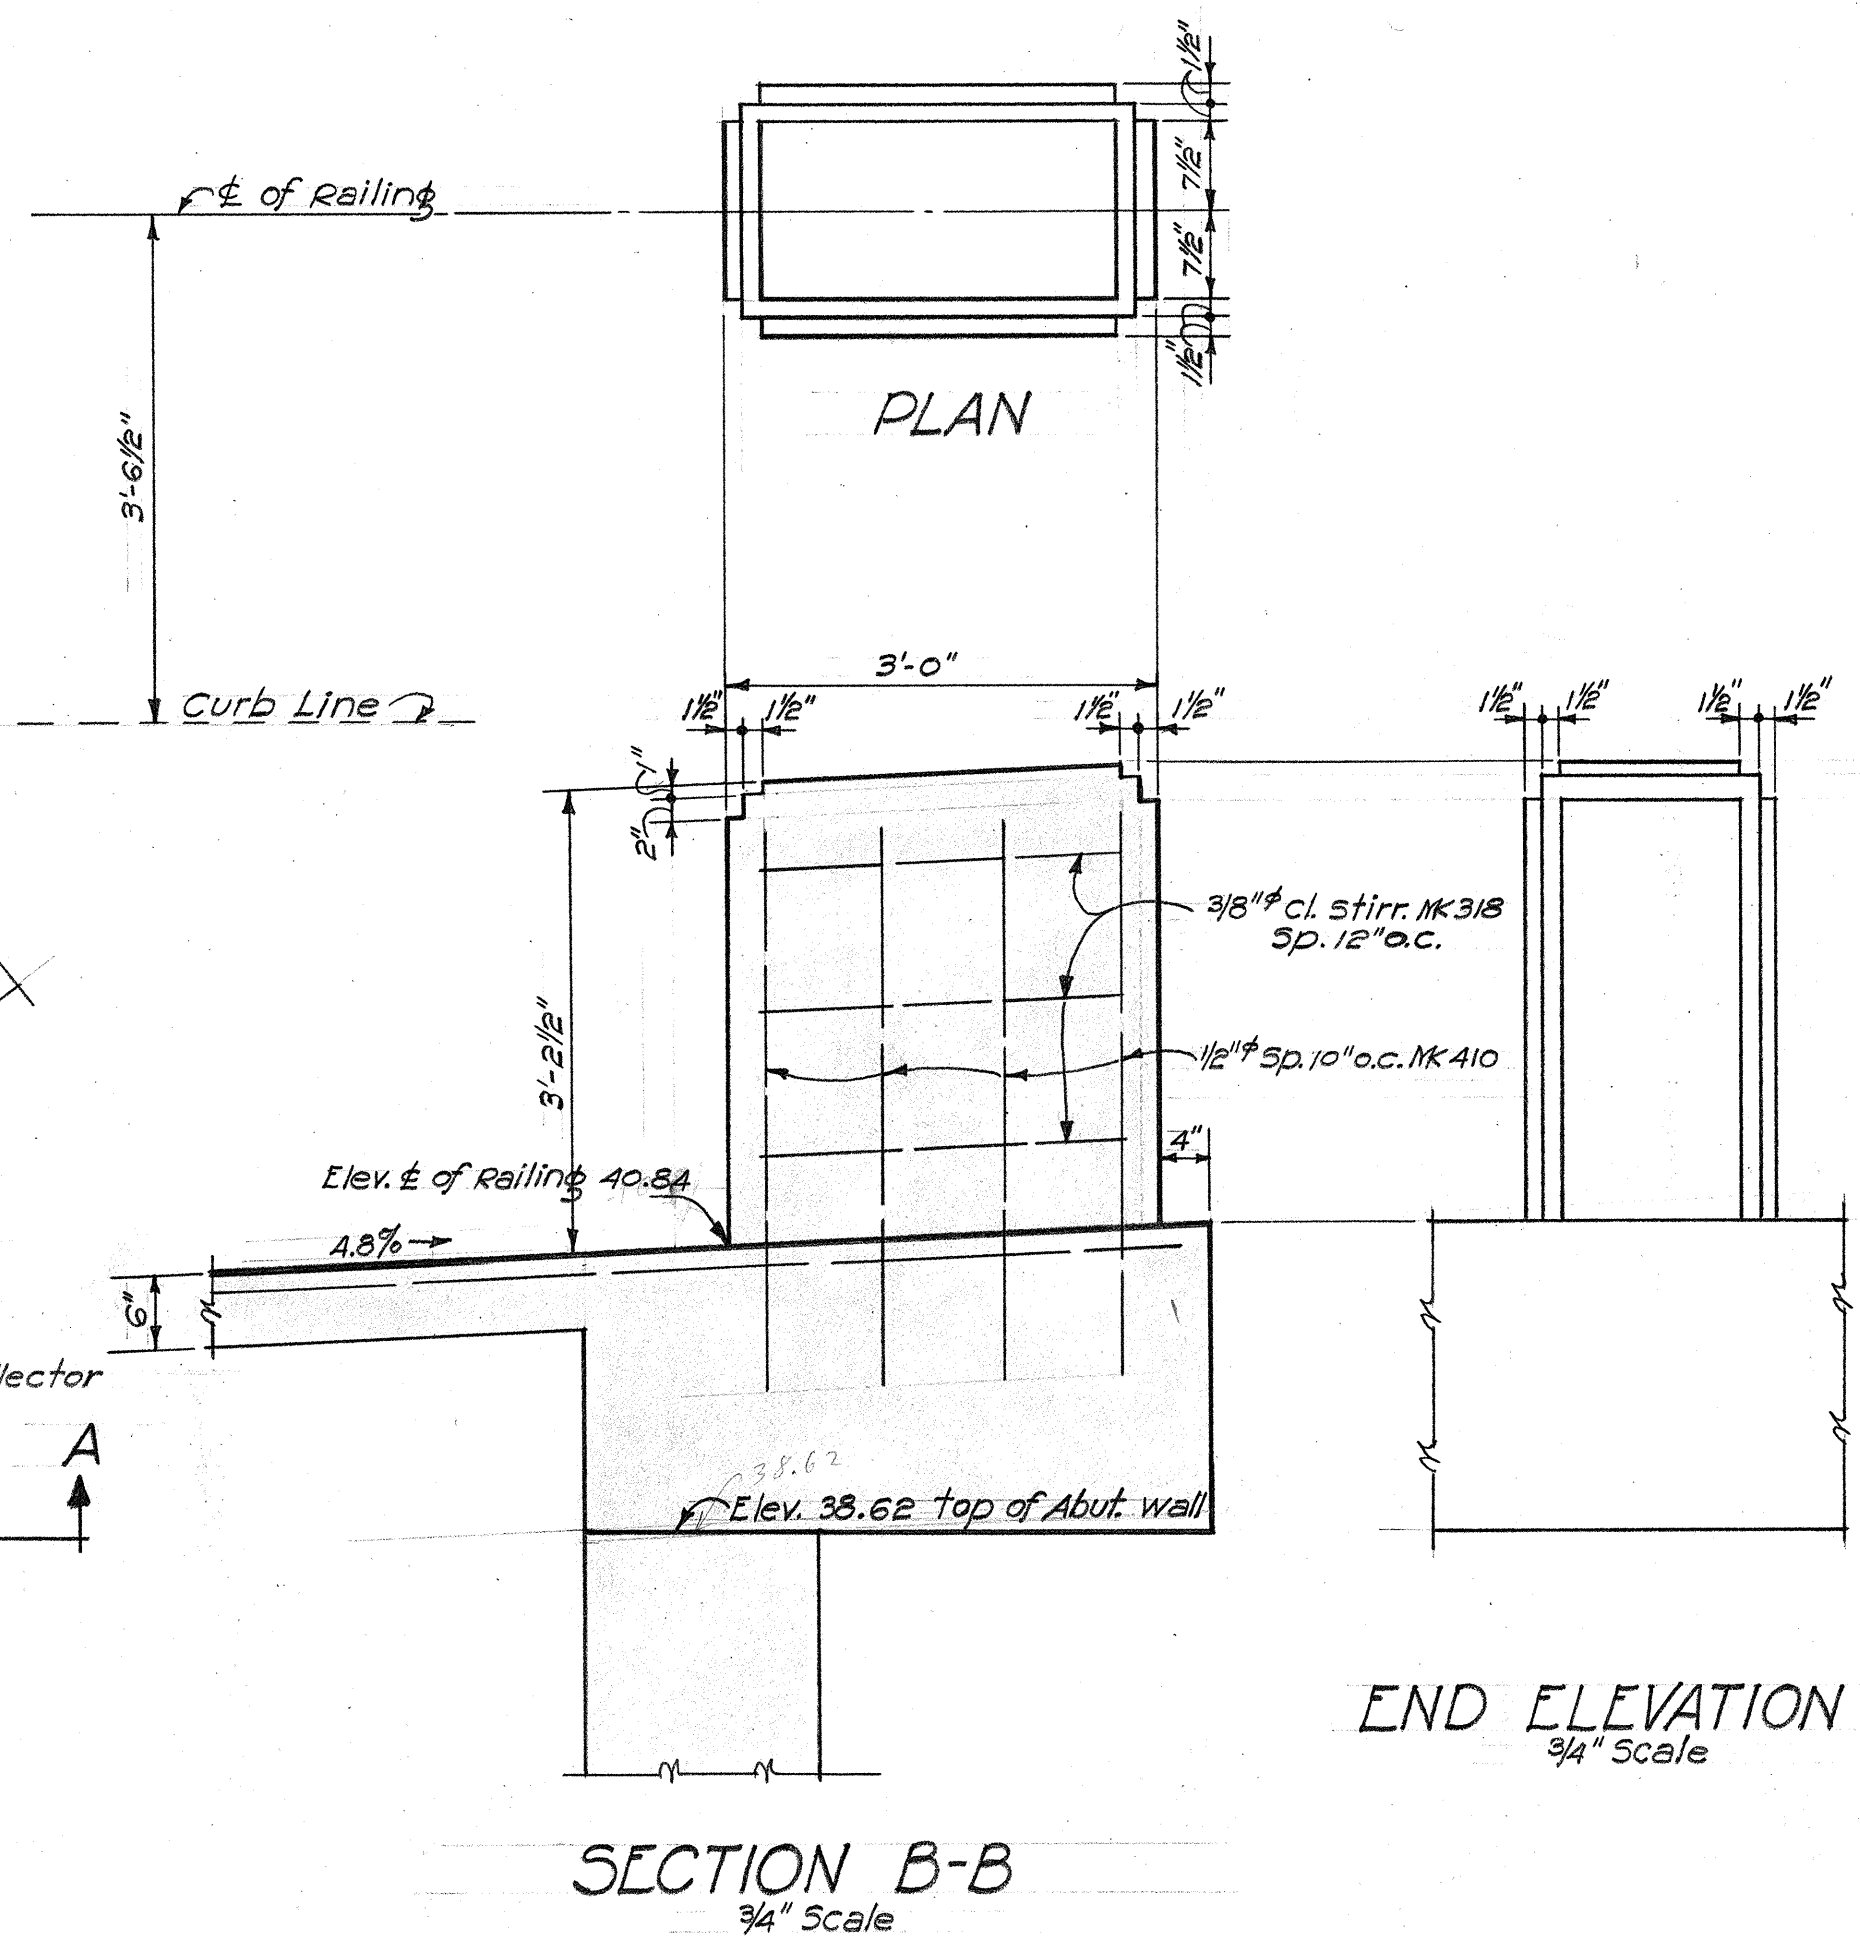
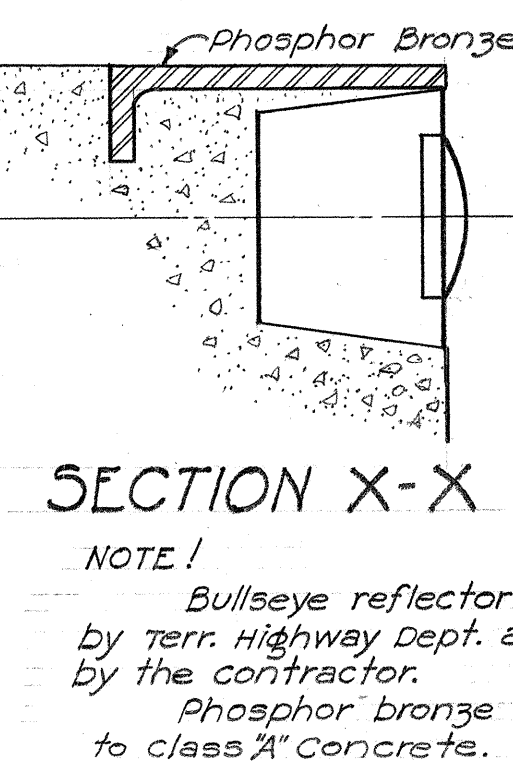
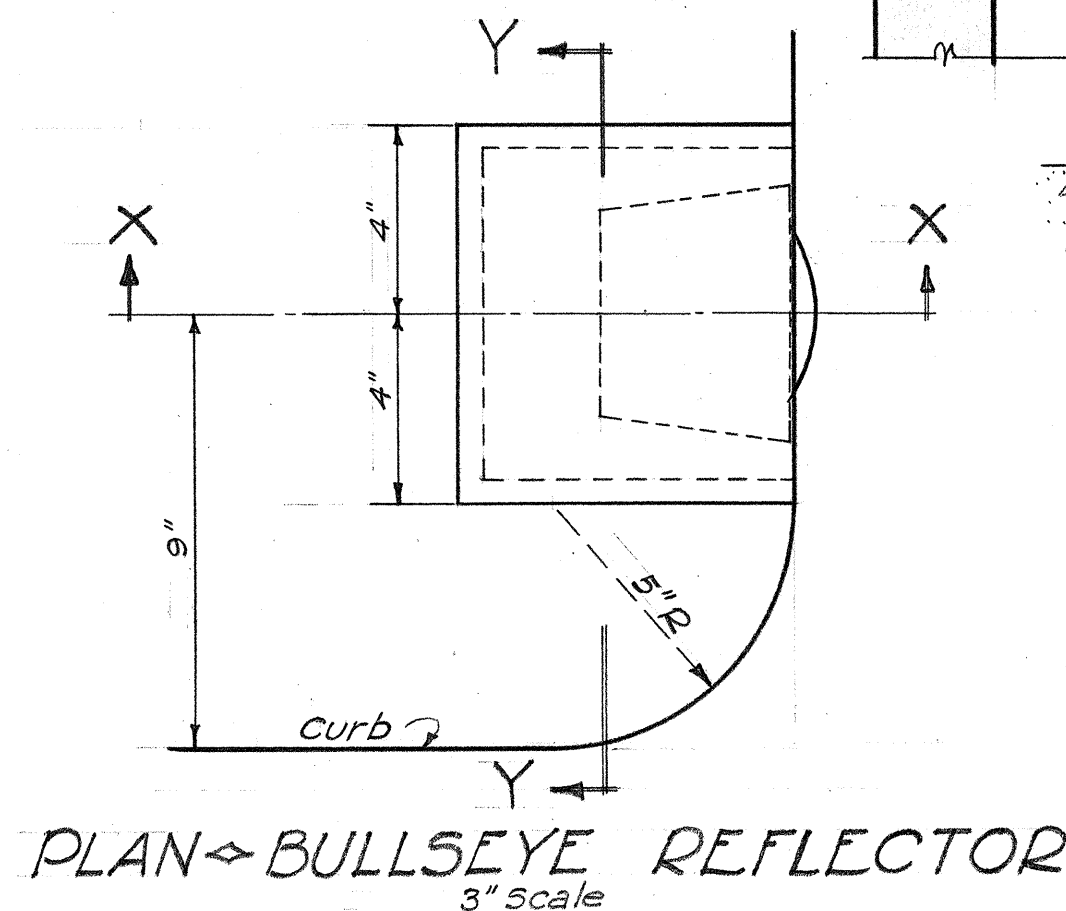
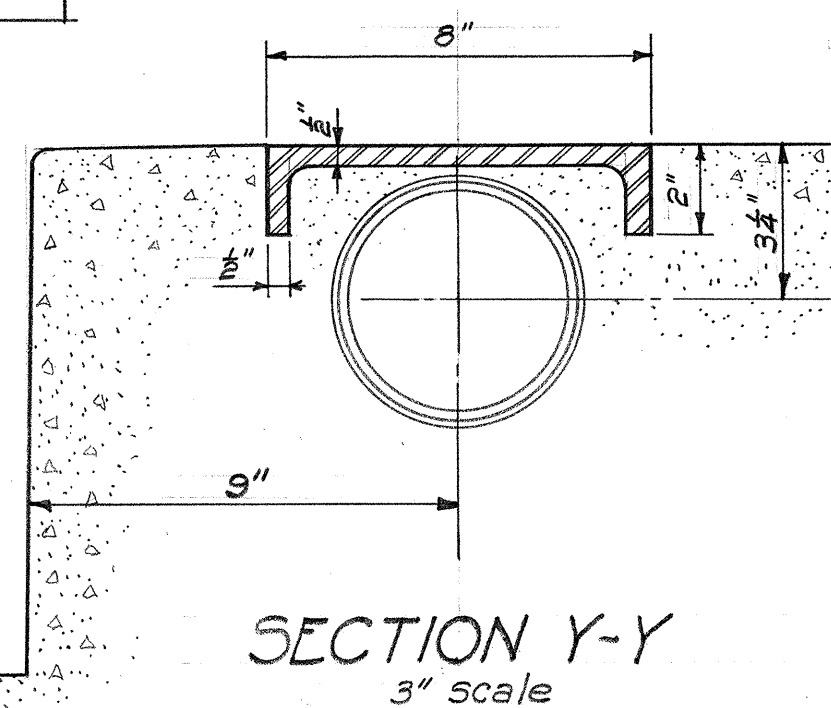
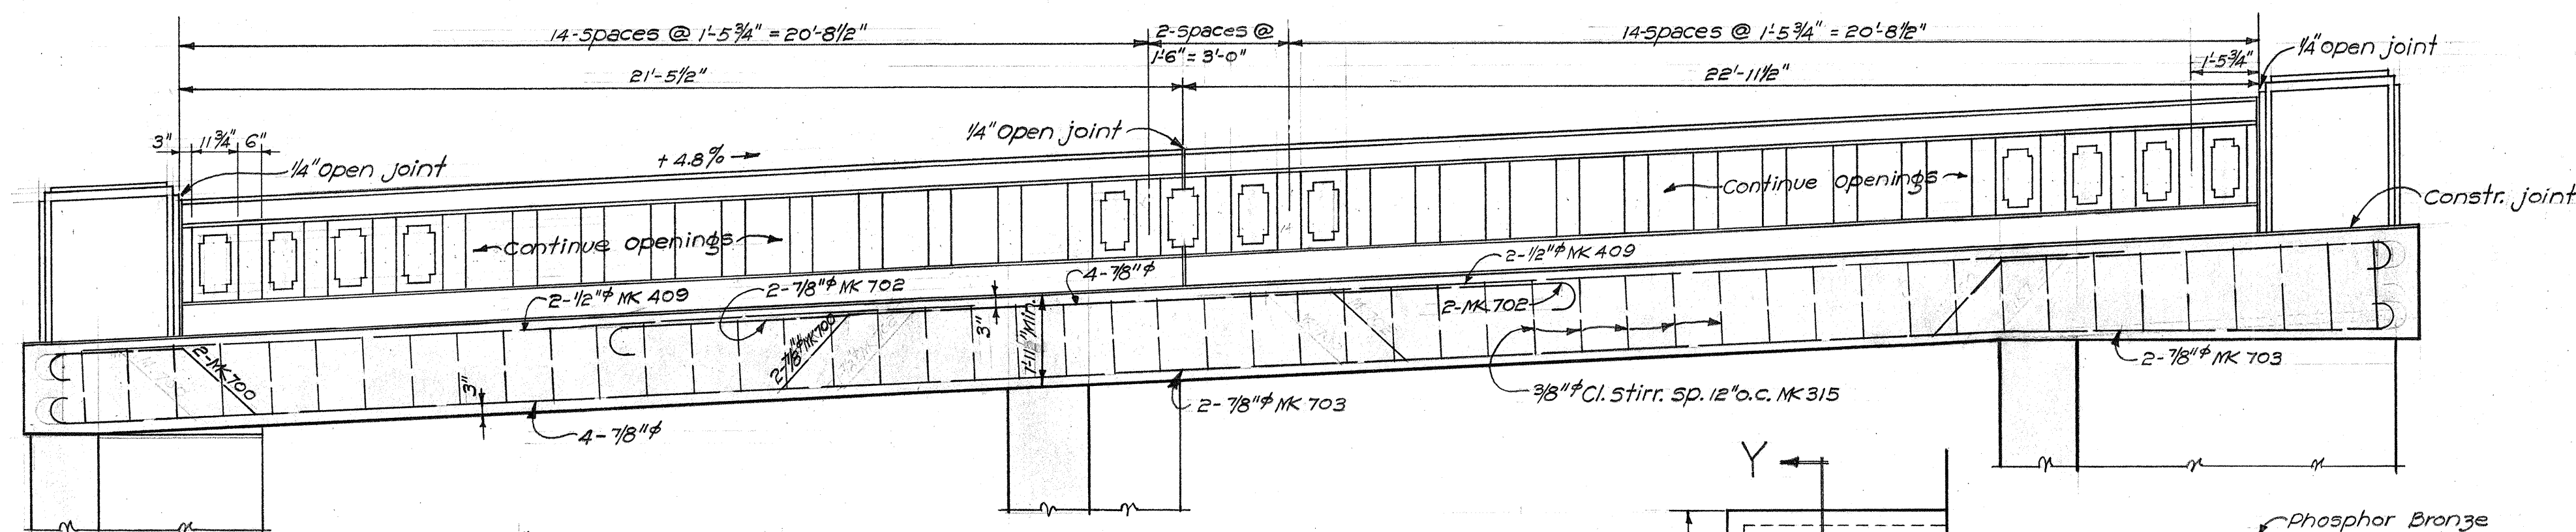
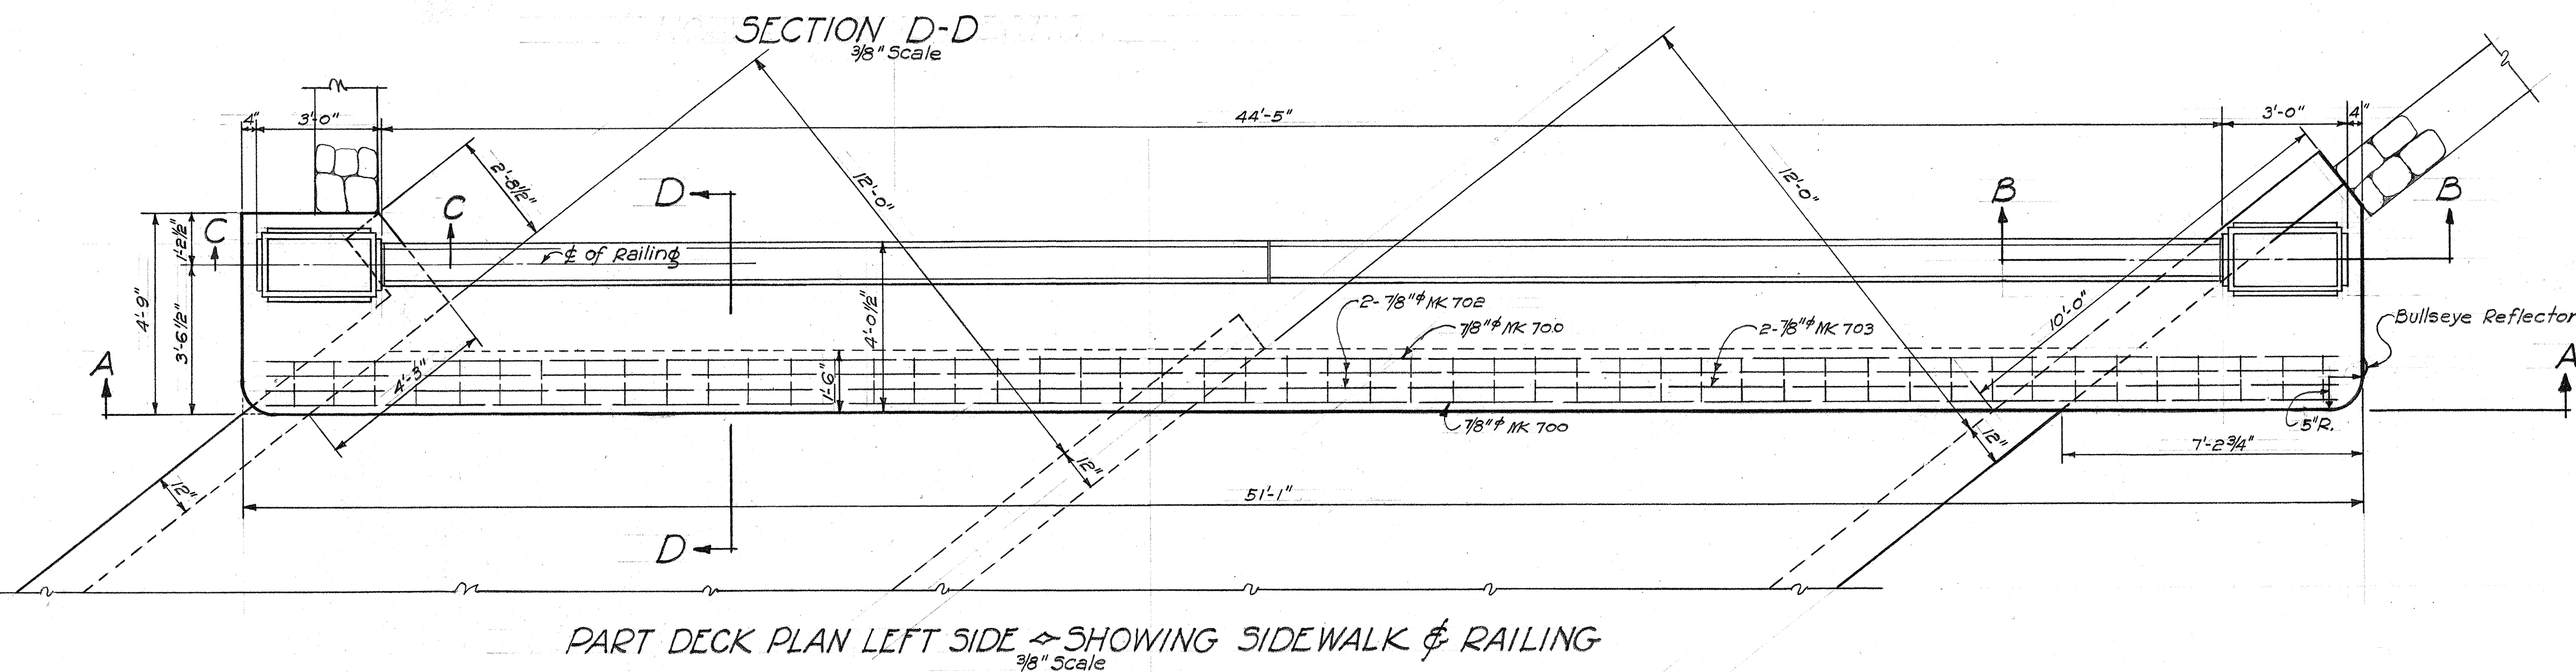
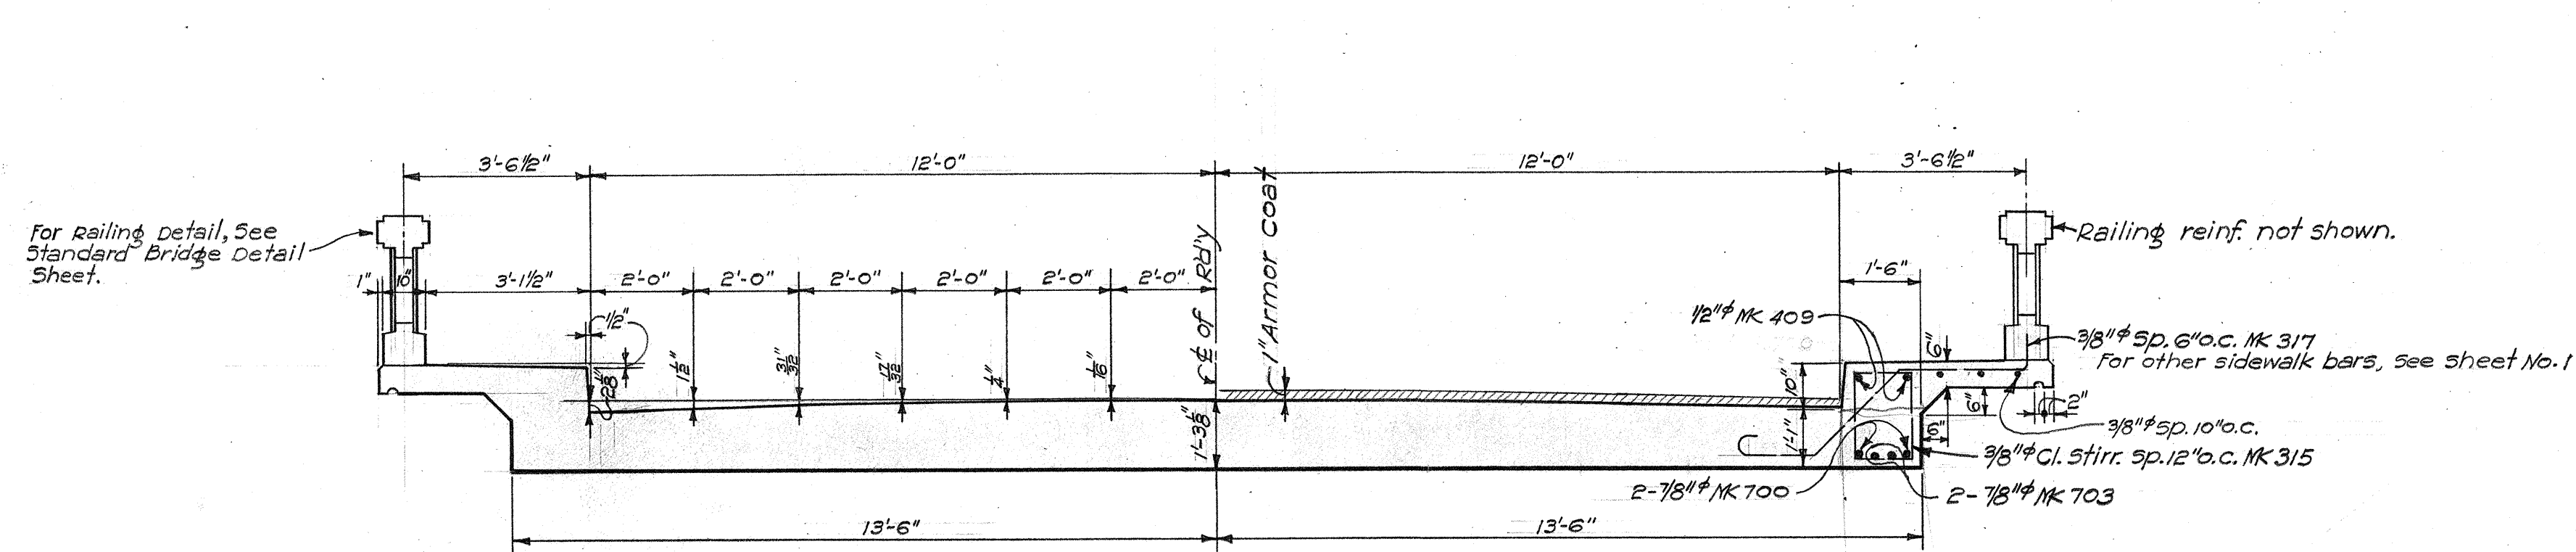
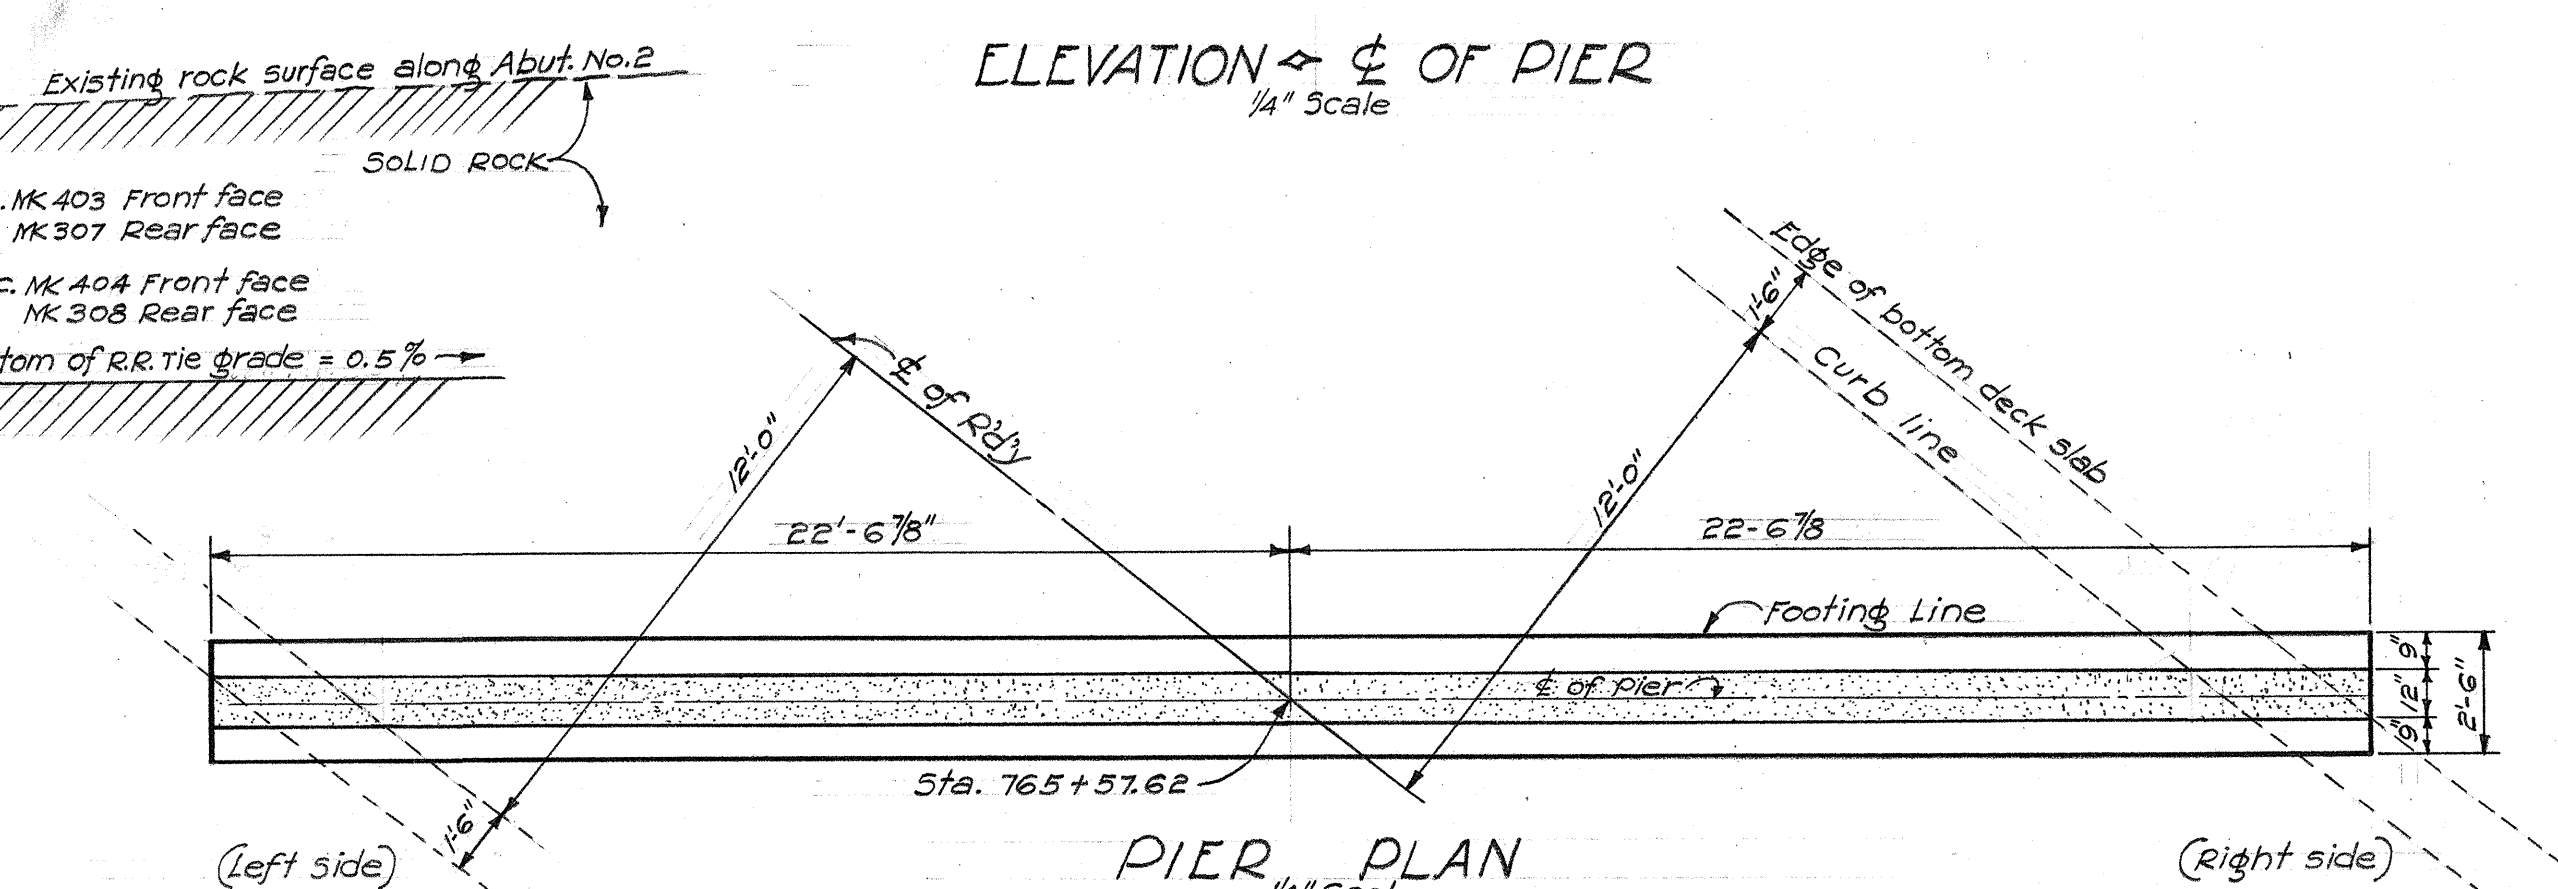
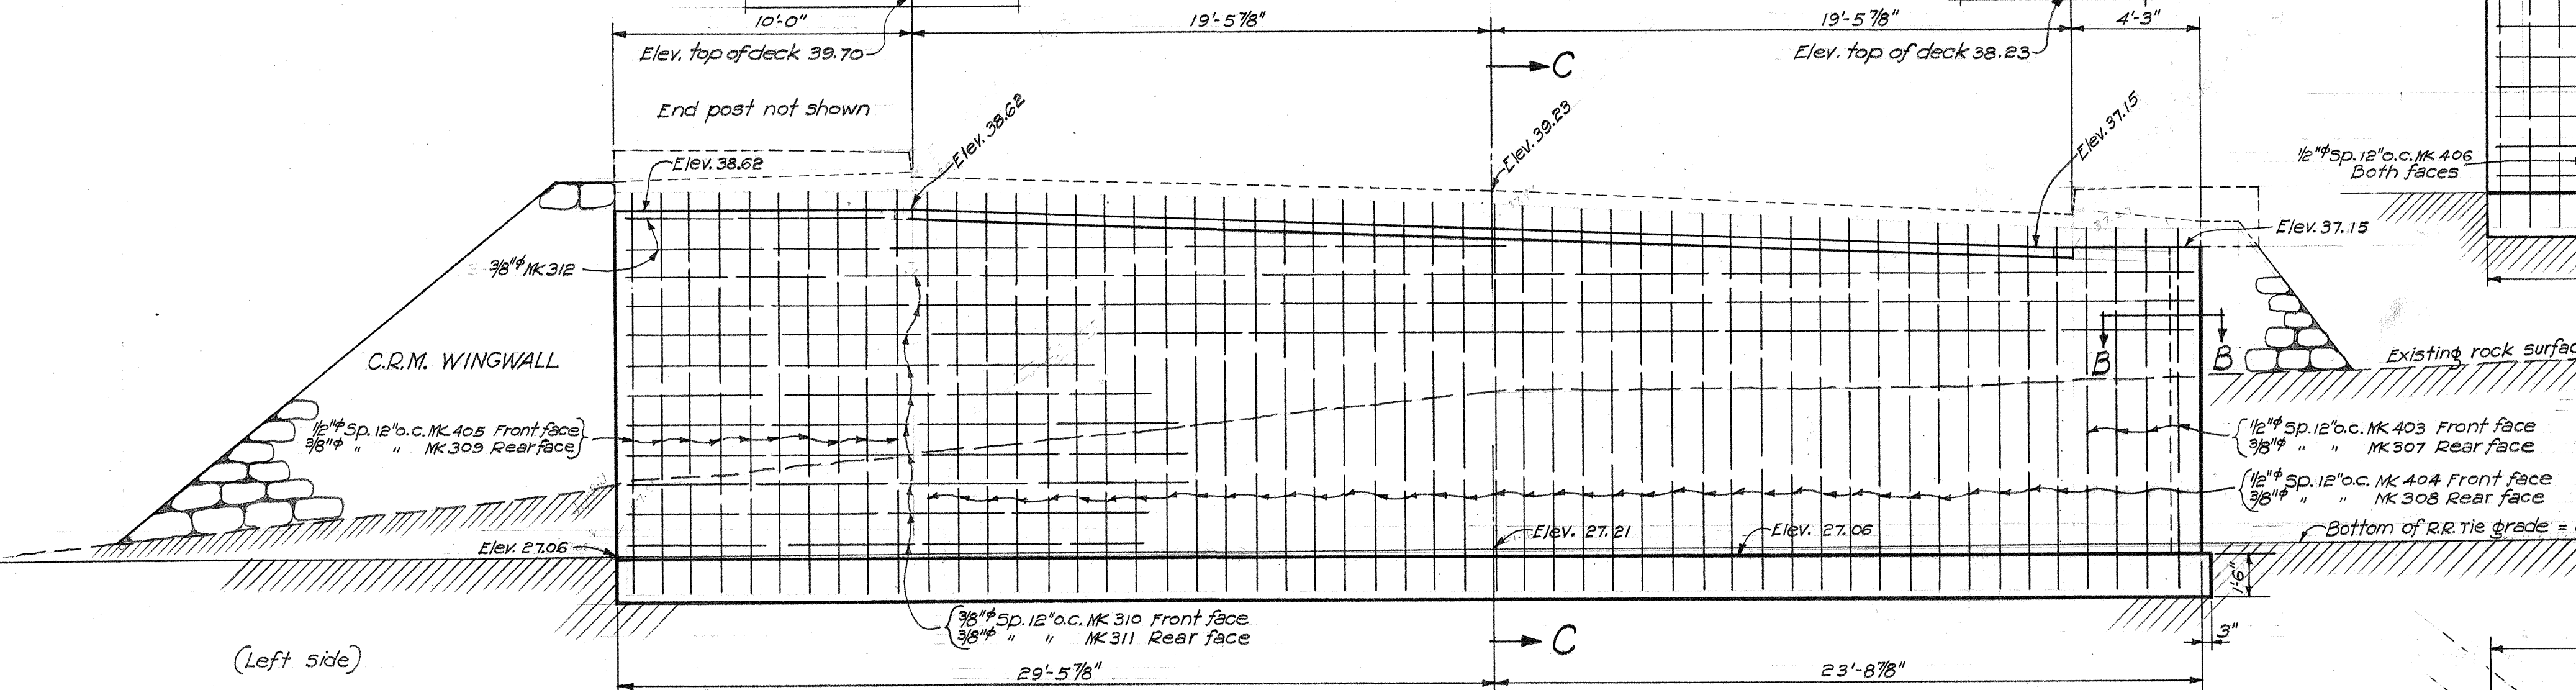
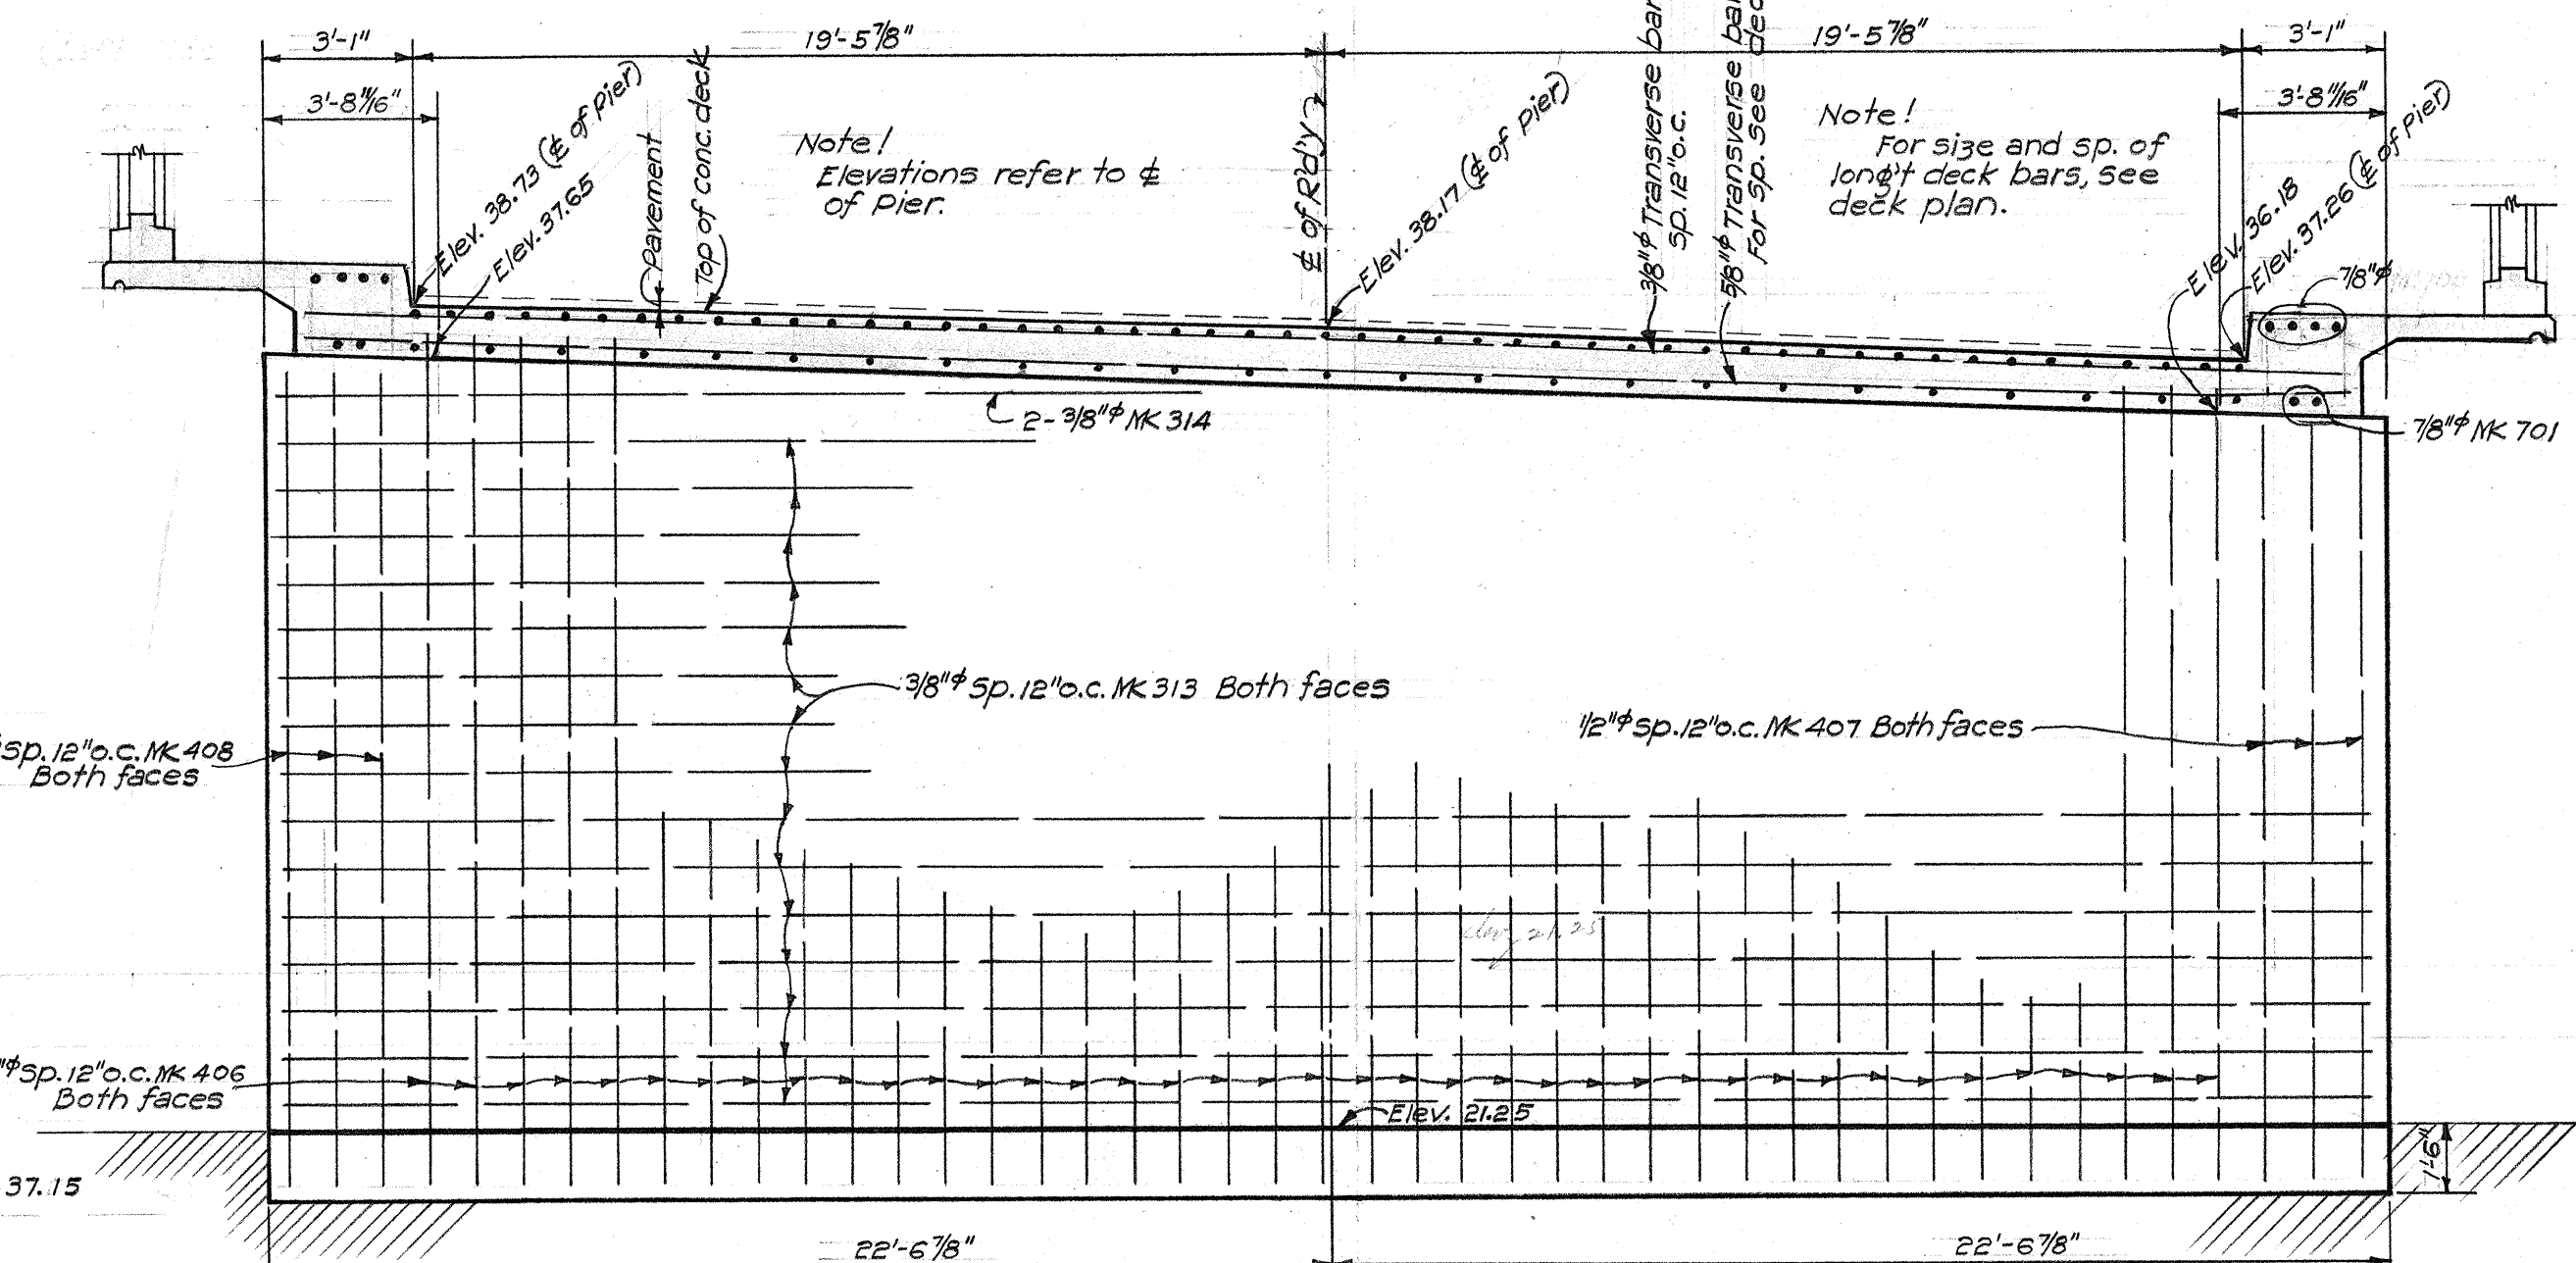
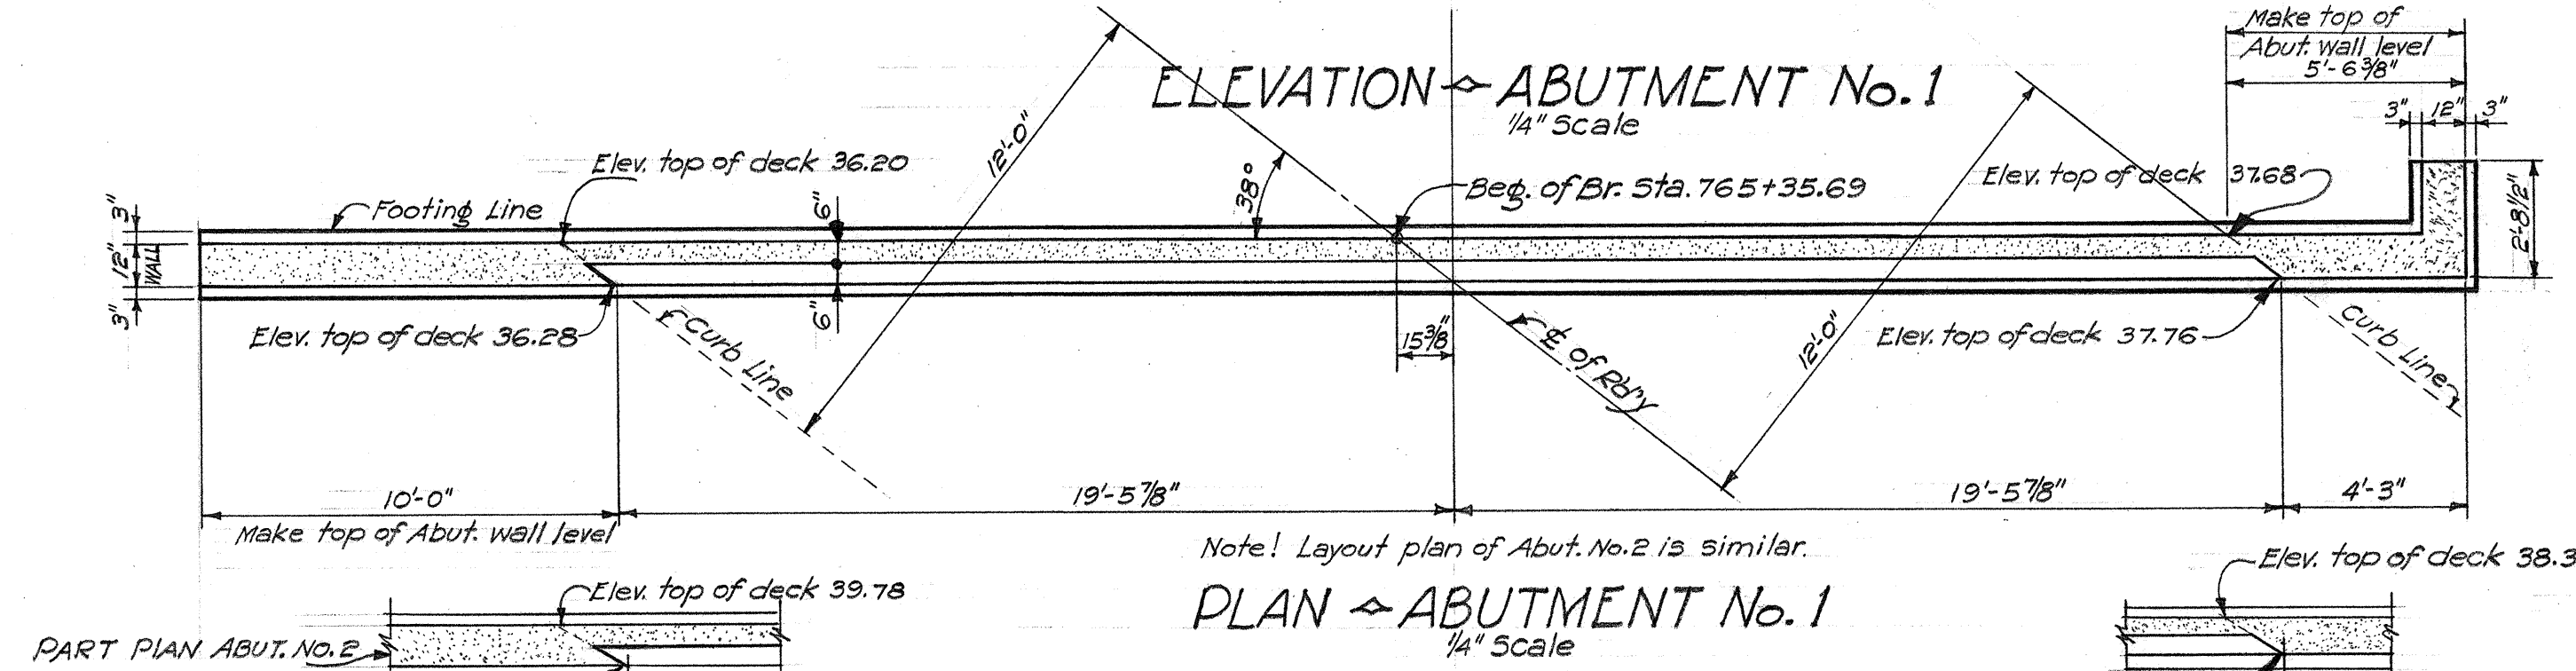


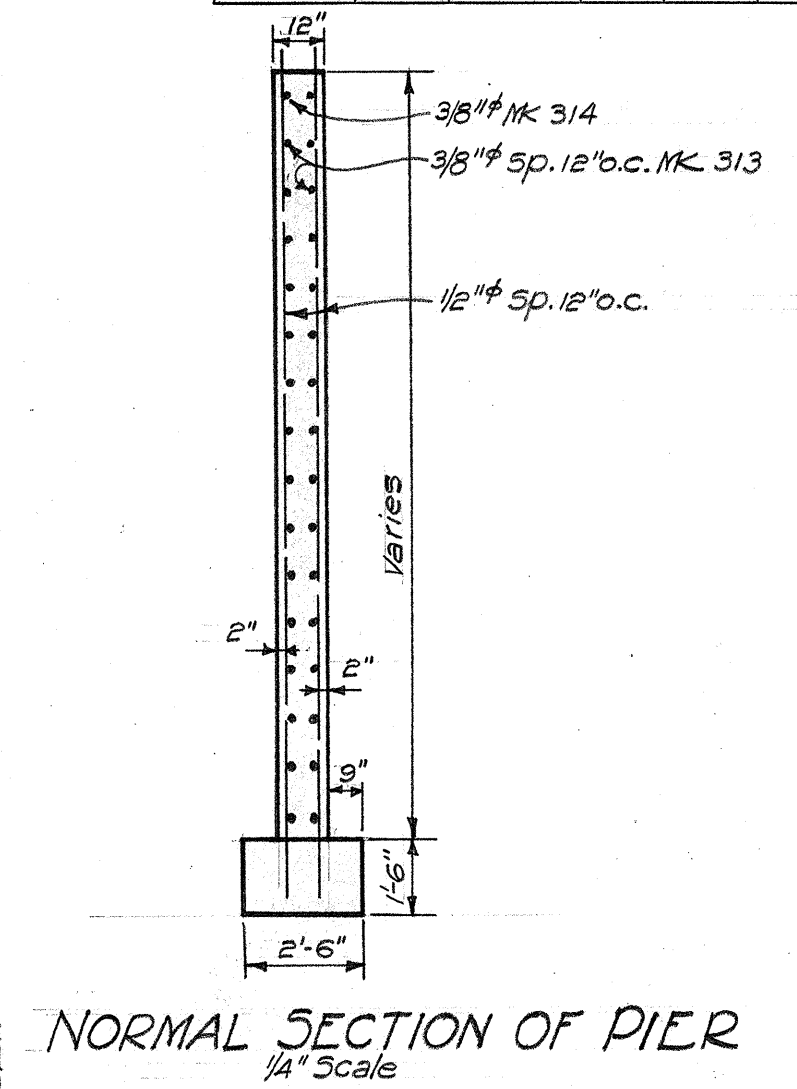



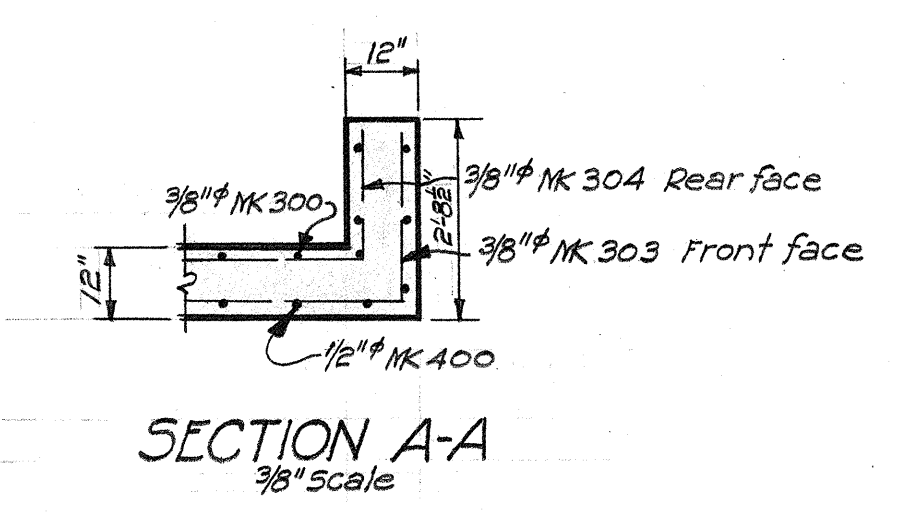


SURVEY PLOTTED BY: DATE: 11/1/38  
DRAWN BY: 11/1/38  
TRACED BY: 11/1/38  
QUANTITIES CHECKED BY: 11/1/38  
ORIGINAL PLAN NOTE BOOK No.

| FED. ROAD DIST. NO. | STATE | FED. AID PROJ. NO. | FISCAL YEAR | SHEET NO. | TOTAL SHEETS |
|---------------------|-------|--------------------|-------------|-----------|--------------|
| HAWAII              | HAW.  | FA5H18D            | 1938        | 10        | 15           |

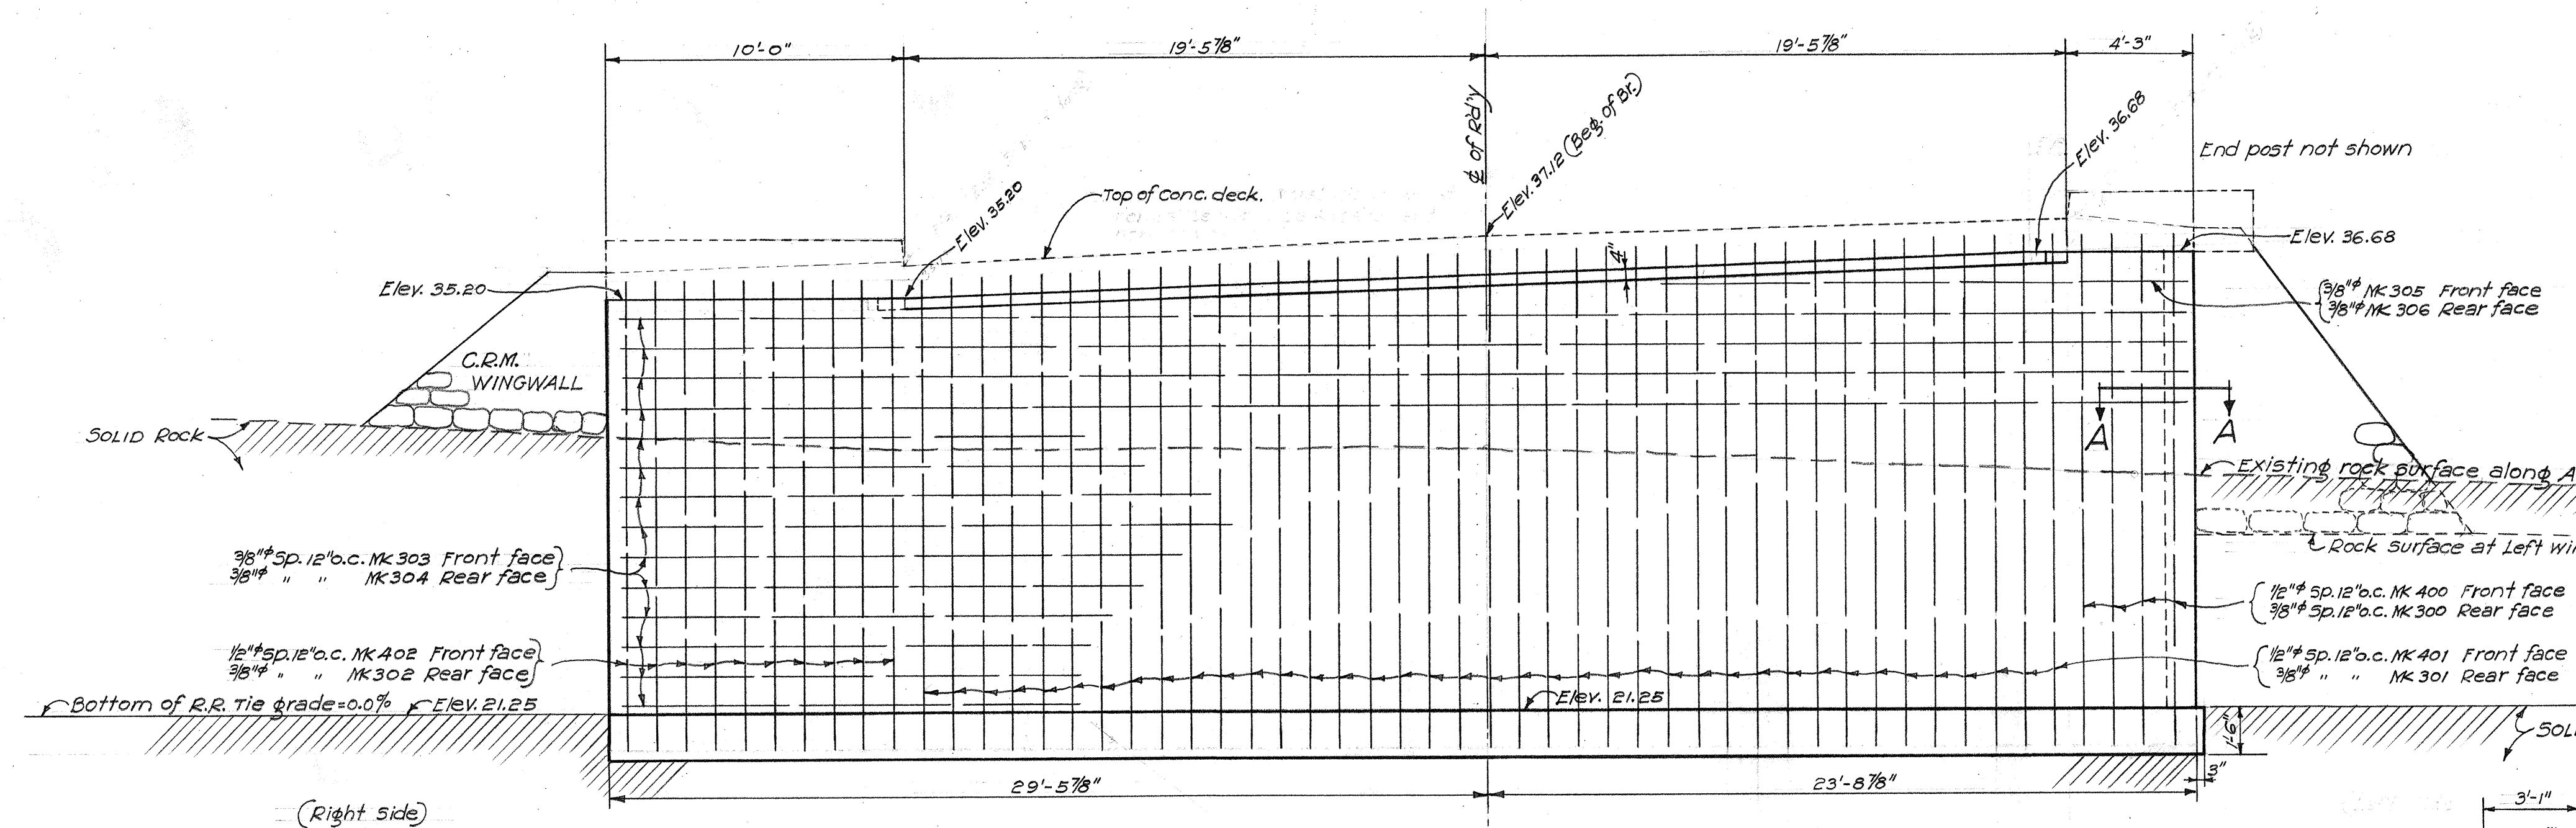

|                       |      |
|-----------------------|------|
| DESIGNED BY           | DATE |
| DRAWN BY              |      |
| CHECKED BY            |      |
| NOTED BY              |      |
| QUANTITIES CHECKED BY |      |
| CHECKED BY            |      |

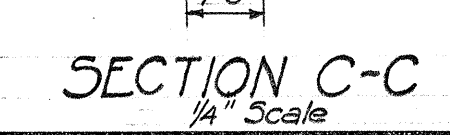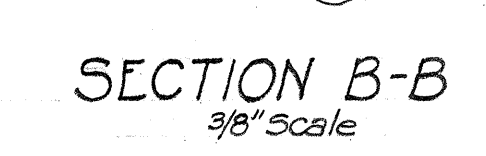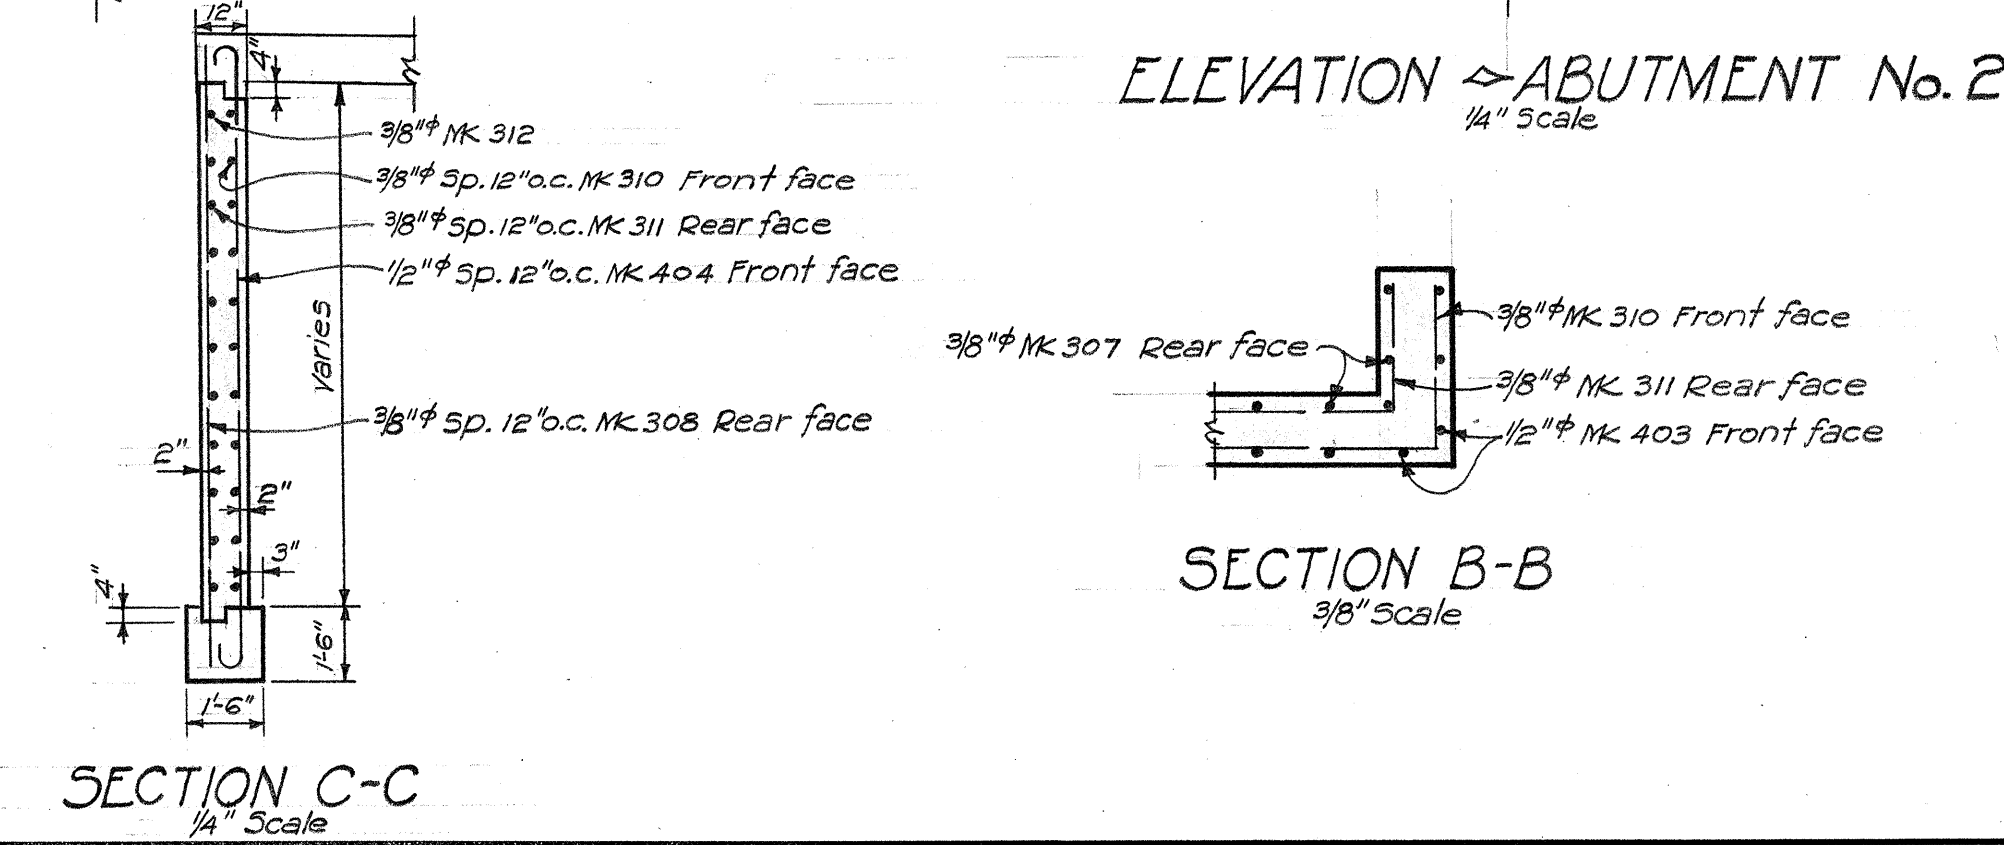

TERRITORIAL HIGHWAY DEPARTMENT  
TERRITORY OF HAWAII  
HIGHWAY OVERPASS  
HAWAII BELT ROAD F.A.G.H. 18 D (1)  
DATE: Nov. 1938  
SHEET No 3 OF 3 SHEETS

4479.10