

INDEX TO DRAWINGS	
SHEET NO.	DESCRIPTION
1	Title Sheet
2	Typical Section
3-5	Plan and Profile
6-7	Standard Details
8-11	Bridge Details
12-15	Cross Sections

FED. ROAD DIST. NO.	STATE	FED. AID PROJ. NO.	FISCAL YEAR	SHEET NO.	TOTAL SHEETS
HAWAII	HAW.	F.A.G.H. 18-D(1)	1938	1	15

TERRITORY OF HAWAII

TERRITORIAL HIGHWAY DEPARTMENT



HONOLULU - T. H.

PLANS OF

HAWAII BELT ROAD

PAHALA — HONUAPO SECTION

FEDERAL AID GRADE CROSSING PROJECT NO. F. A. G. H. 18-D(1)

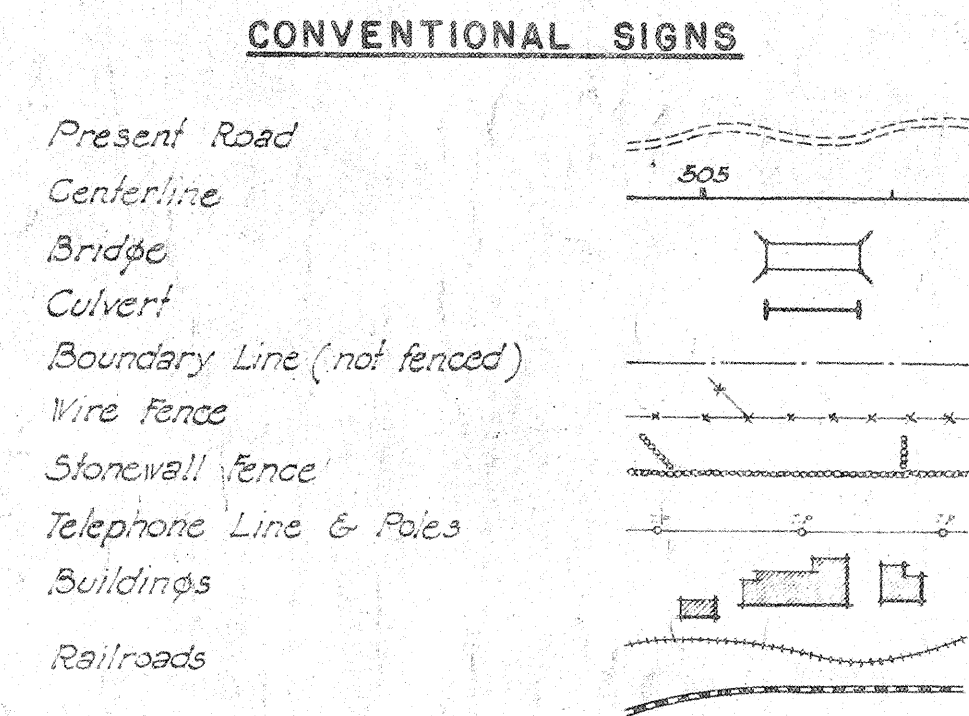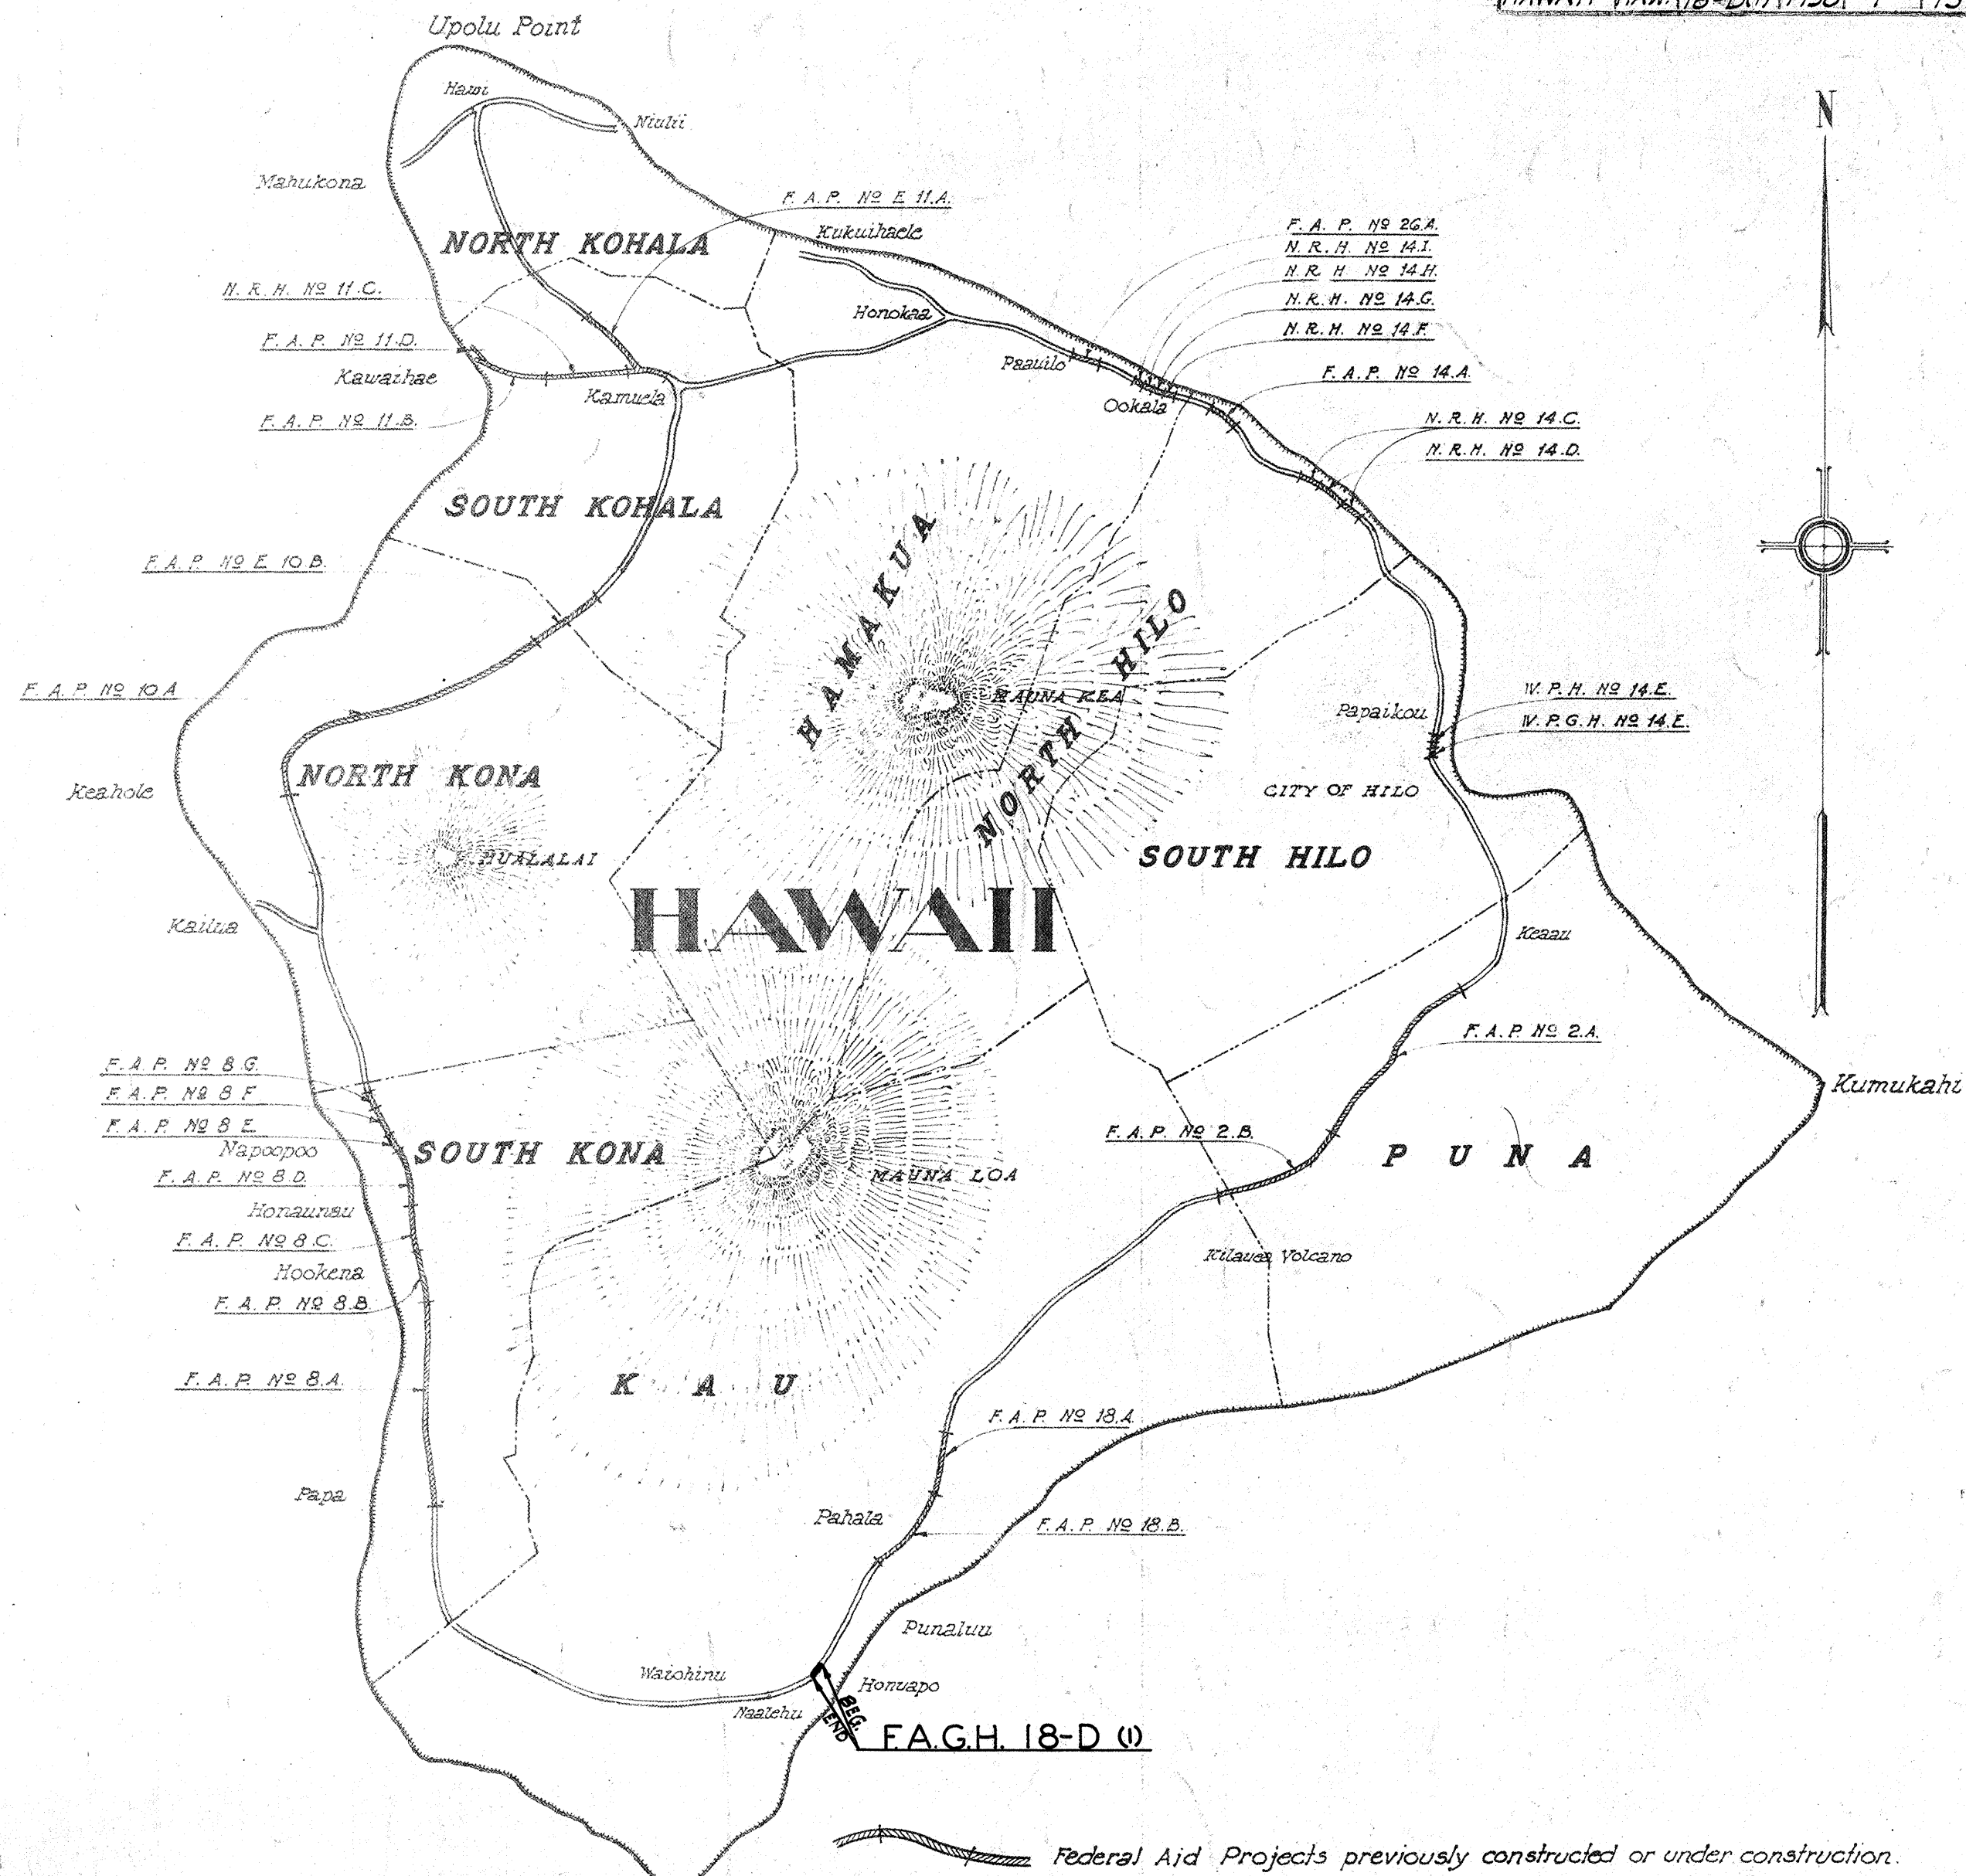

DISTRICT OF KAU

ISLAND OF HAWAII

PLAN

1 INCH

=

100 FEET

PROFILE

HOR. 1 INCH

=

100 FEET

VER. 1 INCH

=

10 FEET

CROSS SECTION

1 INCH


=

10 FEET

GENERAL LAYOUT PLAN OF PROJECT

Scale: 1"=4000'

GROSS LENGTH	0.571 Miles	0.571
BRIDGES OVER 20' SPAN	0.008 "	0.008
NET LENGTH ROADWAY	0.563 "	0.563

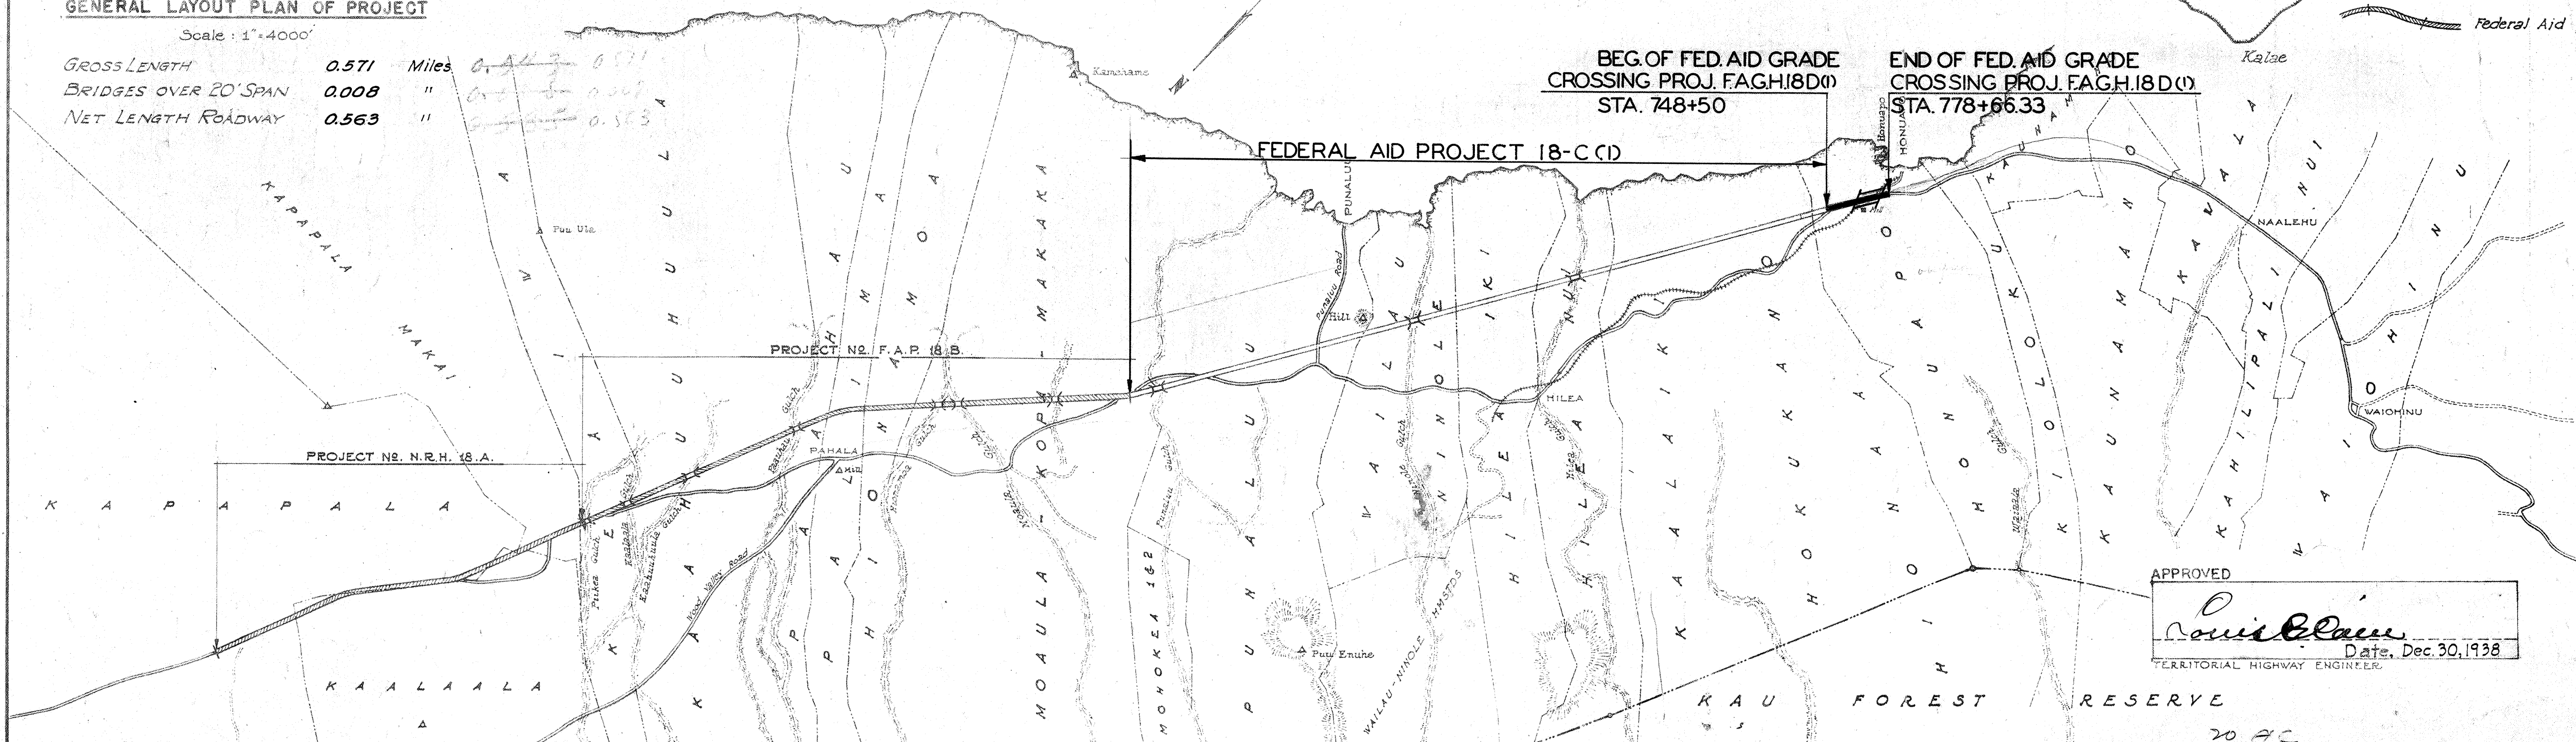

RECOMMENDED FOR APPROVAL

PRINCIPAL HIGHWAY ENGINEER - BUREAU OF PUBLIC ROADS

RECOMMENDED FOR APPROVAL

DEPUTY CHIEF ENGINEER, BUREAU OF PUBLIC ROADS

APPROVED

CHIEF, DIVISION OF DESIGN, BUREAU OF PUBLIC ROADS

APPROVED BY THE SECRETARY OF AGRICULTURE

PROJECT AGREEMENT EXECUTED