HAWAII HAW. WERI(1) 1945 25 38

18"

-3" Series "D" Letters

2" Series "C" Letters

NOTE:

Sions are to be lettered in accordance with Standard Alphabets for Highway Sions approved by A.A.S.H.O. published by Public Roads Administration using 3" Series" D" and 2" Series" C" Letters as noted.


TERRITORIAL HIGHWAY DEPARTMENT TERRITORY OF HAWAII

LETTER LAYOUT DETAIL SPECIAL CAUTION SIGN PROJECT WERP NO. WER (1)

Scale: Full Size

July 1947

SHEET Nº 1 OF 1 SHEETS

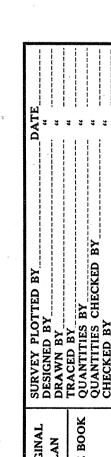

ALBANENE" NO. 195T K&ECO., N.Y. *