



FED. ROAD DIST. NO.	STATE	FED. AID PROJ. NO.	FISCAL YEAR	SHEET NO.	TOTAL SHEETS
HAWAII	HAW	5220(1)	1950	5	60
		11-54-50			

- LEGEND**
- Symbol for existing Stonewall Fences
 - Symbol for Reconstructed Stonewall Fences
 - Symbol for Construction of New Stonewall Fences
 - Symbol for New Standard Wire Fences



CURVE DATA FOR ROADWAY AND R/W

$\Delta = 27^{\circ}10'$
 $D = 2^{\circ}00'$
 $R = 2804.79'$
 $T = 600.15'$
 $L = 1365.83'$
 $C = 1352.09'$
 $SE = 0.02 \text{ ft./ft.}$

TYPICAL DITCH SECTION
Not To Scale

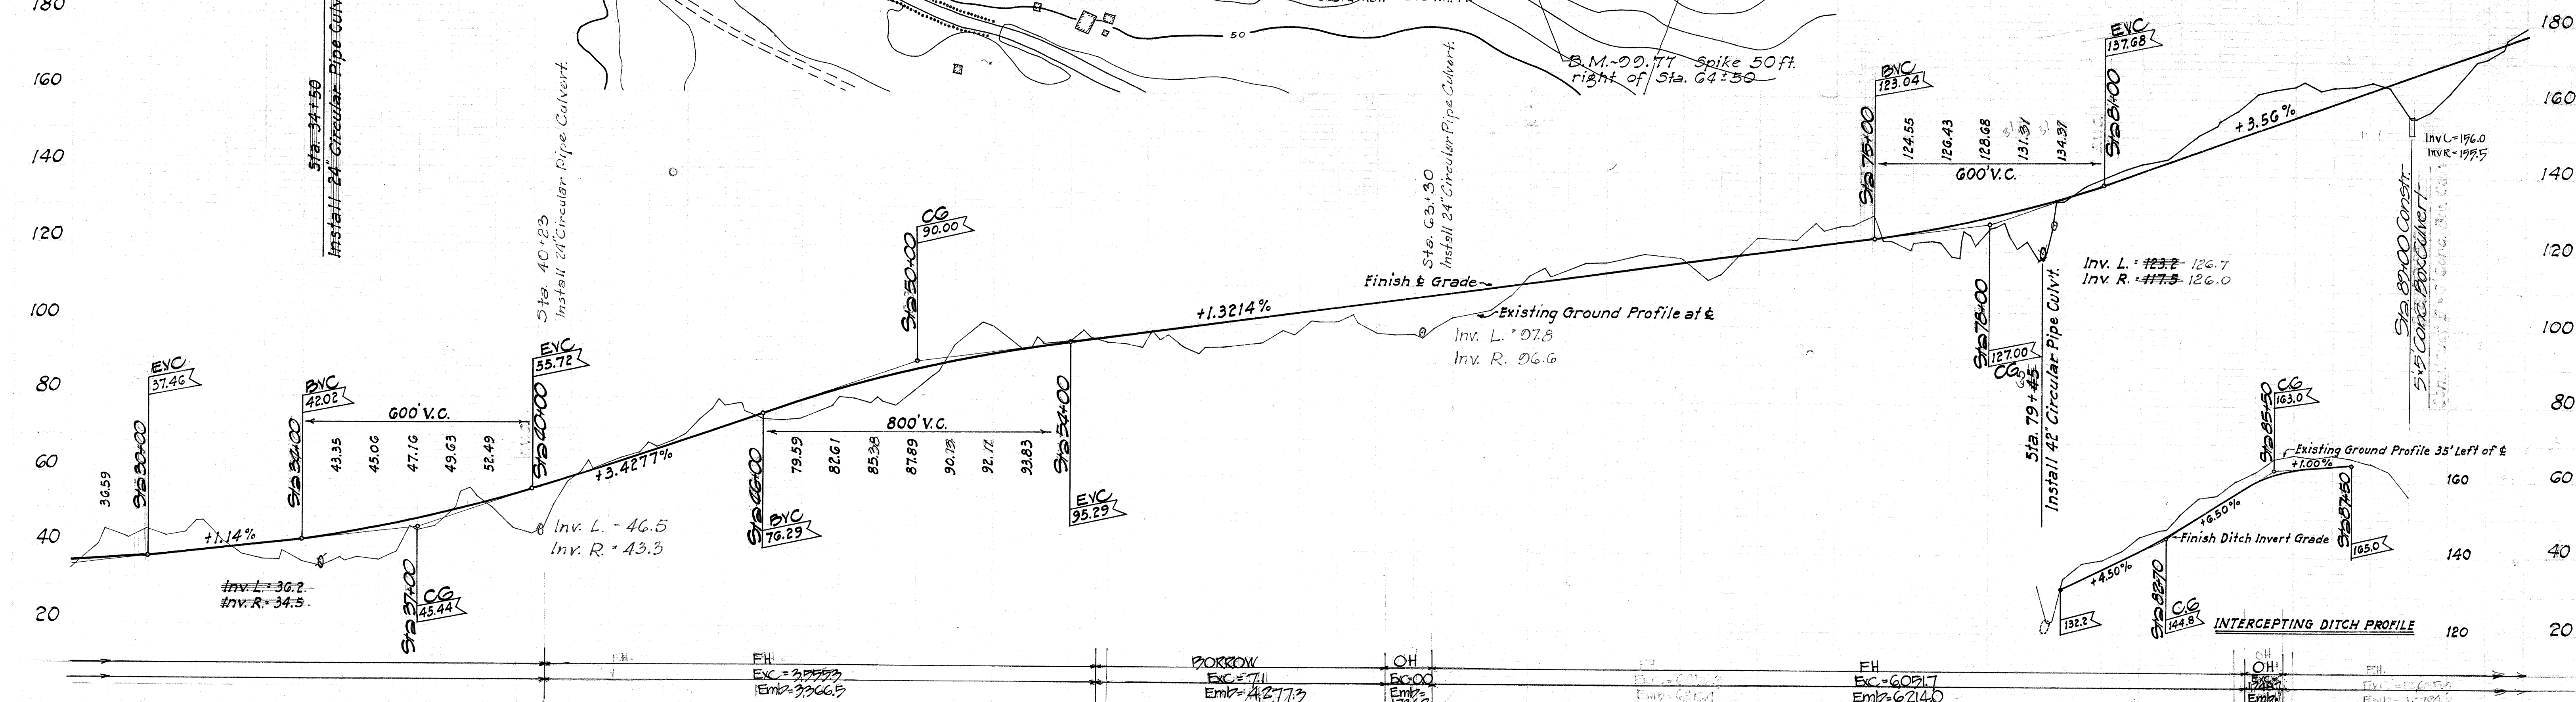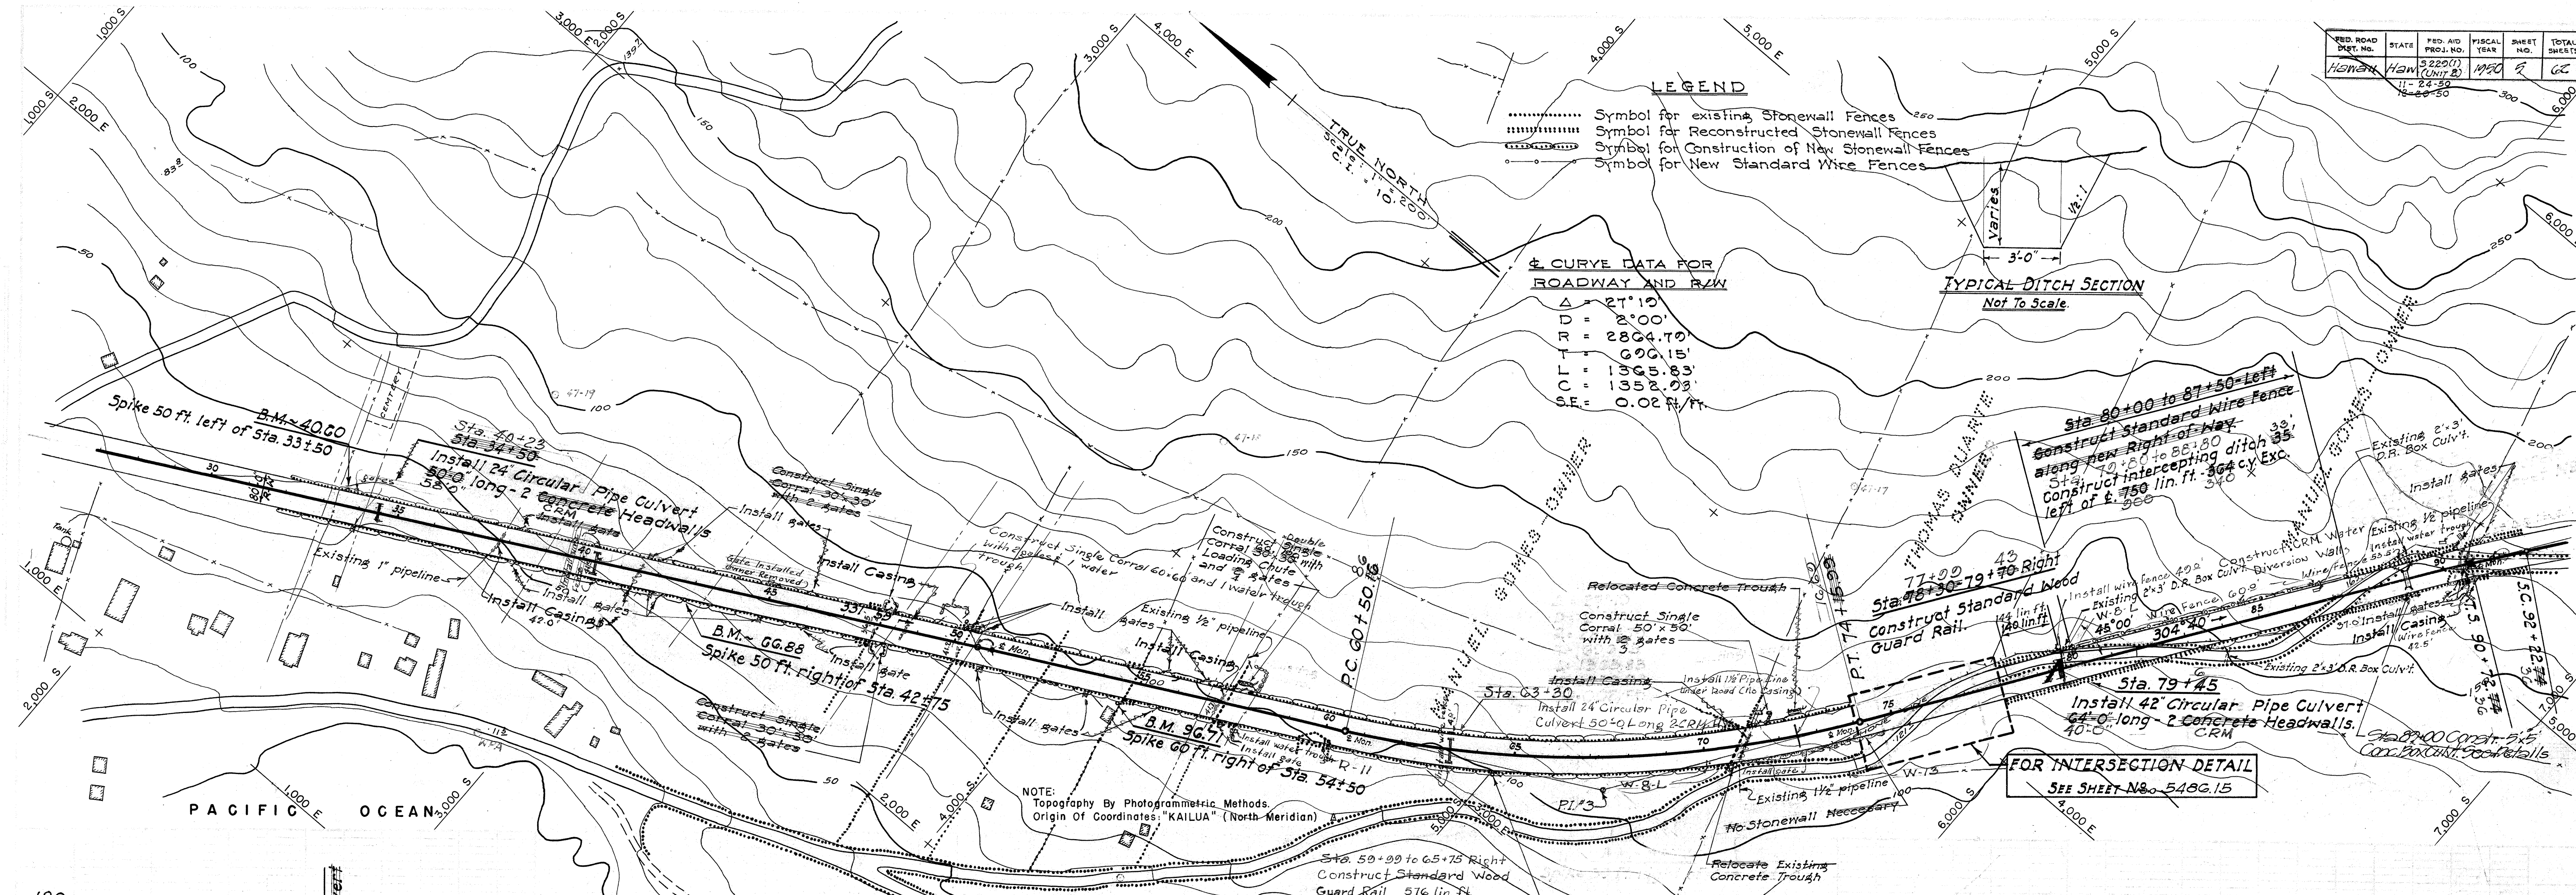


5486.5

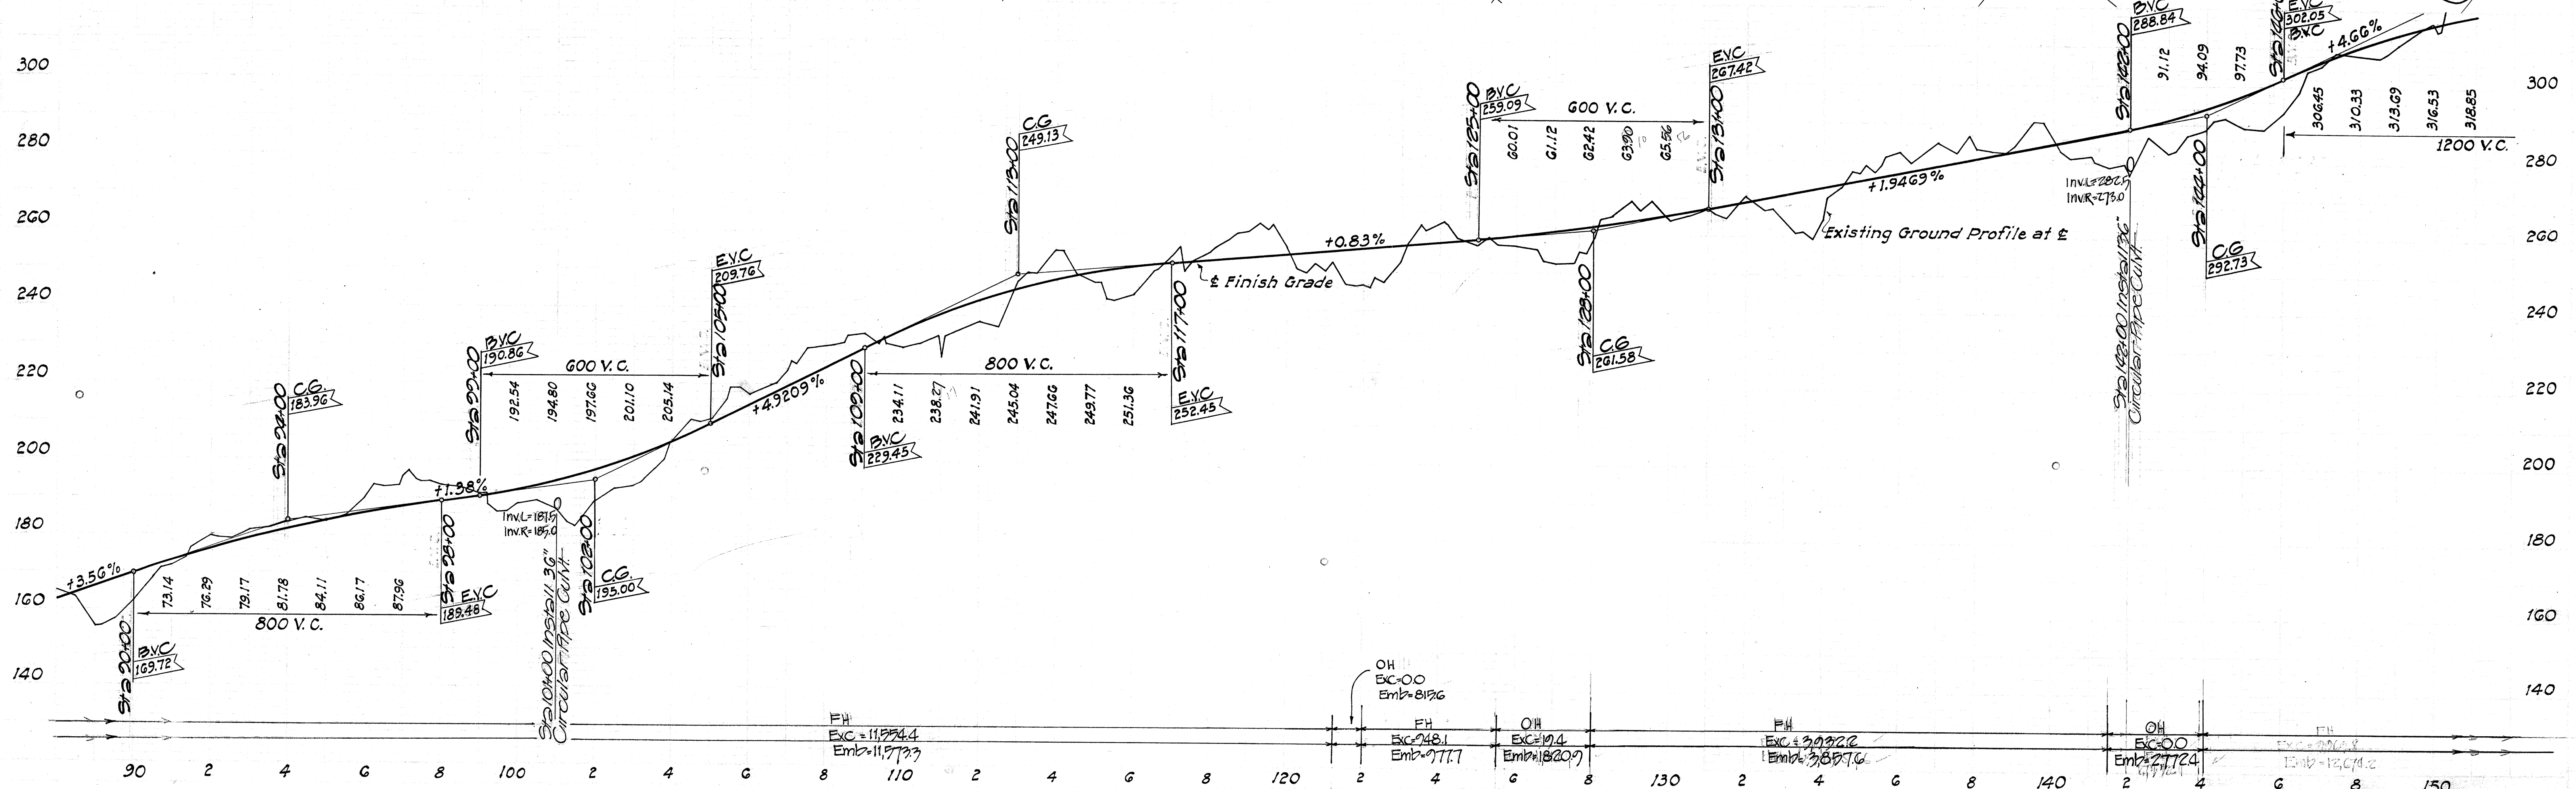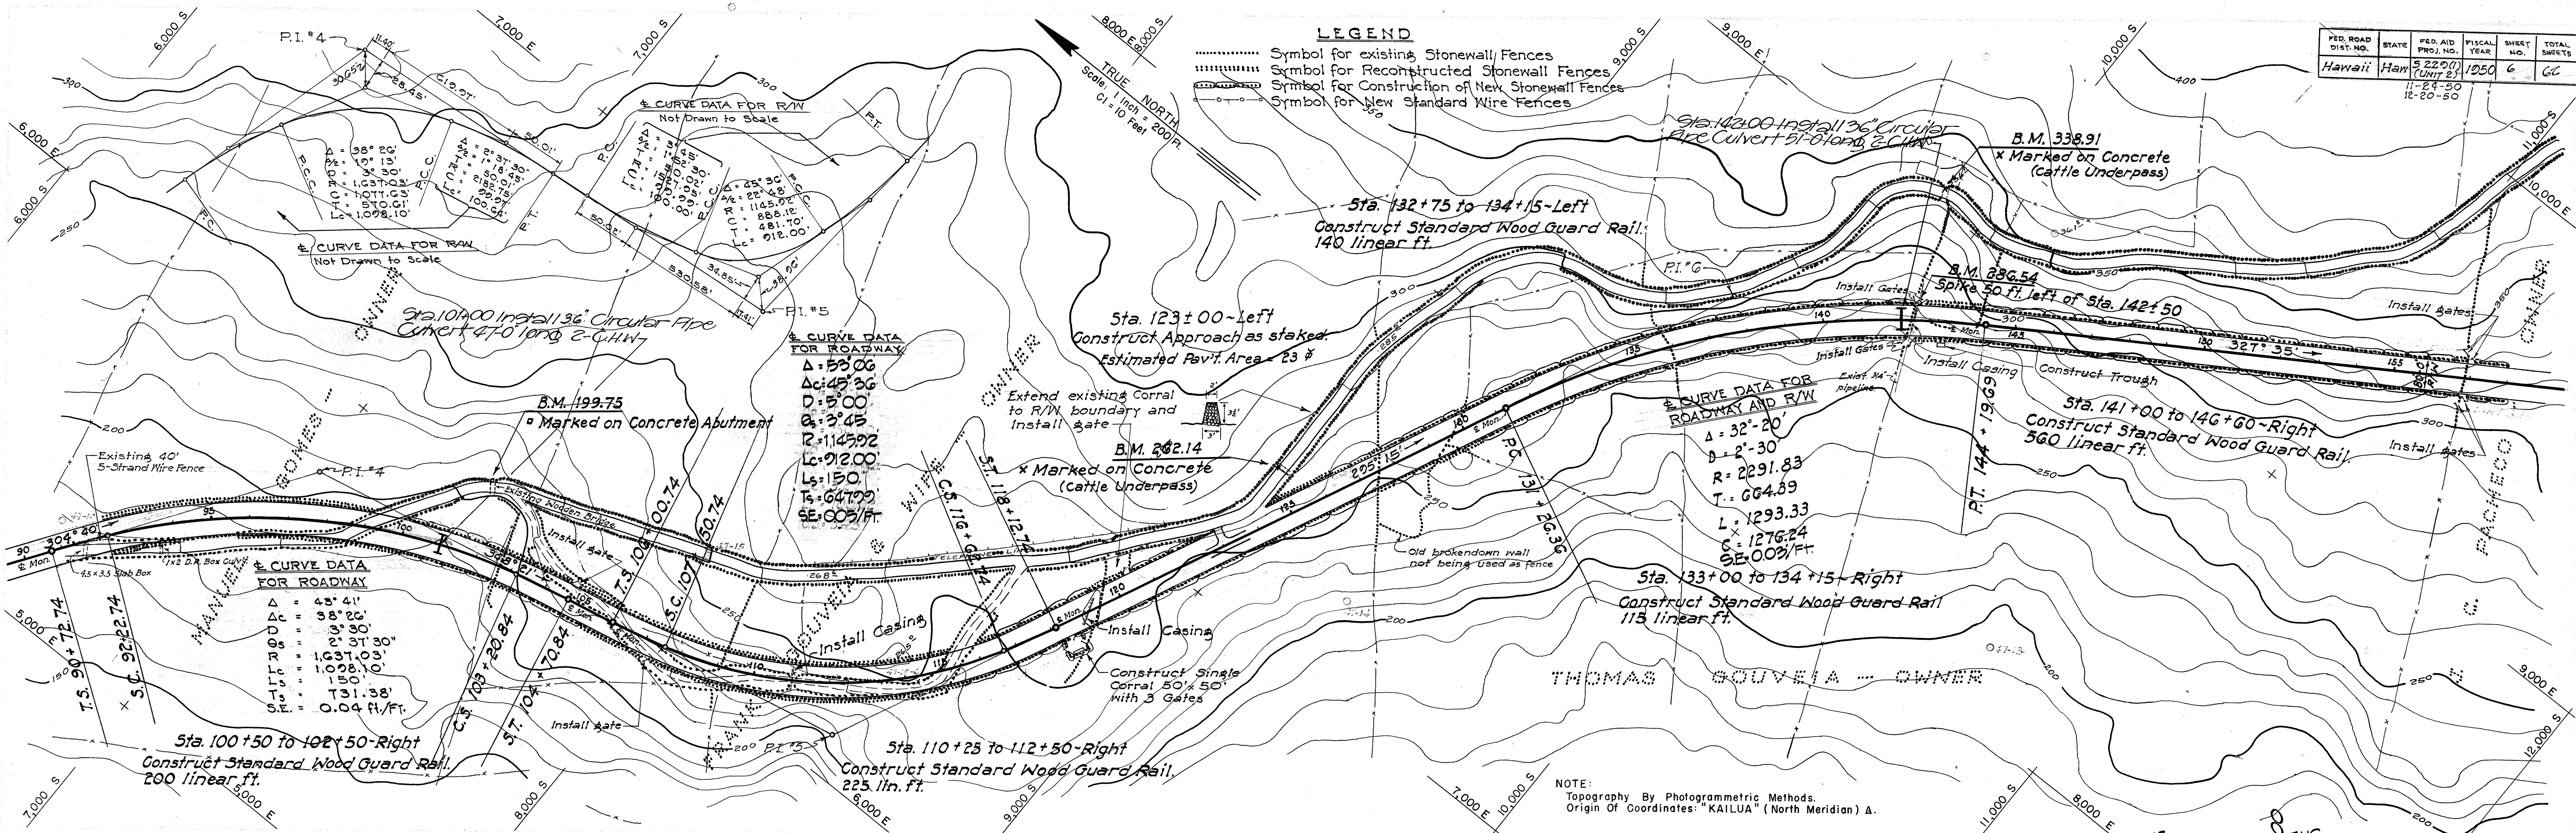

FED. ROAD DIST. NO.	STATE	FED. AID PROJ. NO.	FISCAL YEAR	SHEET NO.	TOTAL SHEETS
Hawaii	Haw	5 225(1) (UNIT 2)	1950	6A	6C

11-24-50
12-20-50


Revision Date: MAR 27 1951

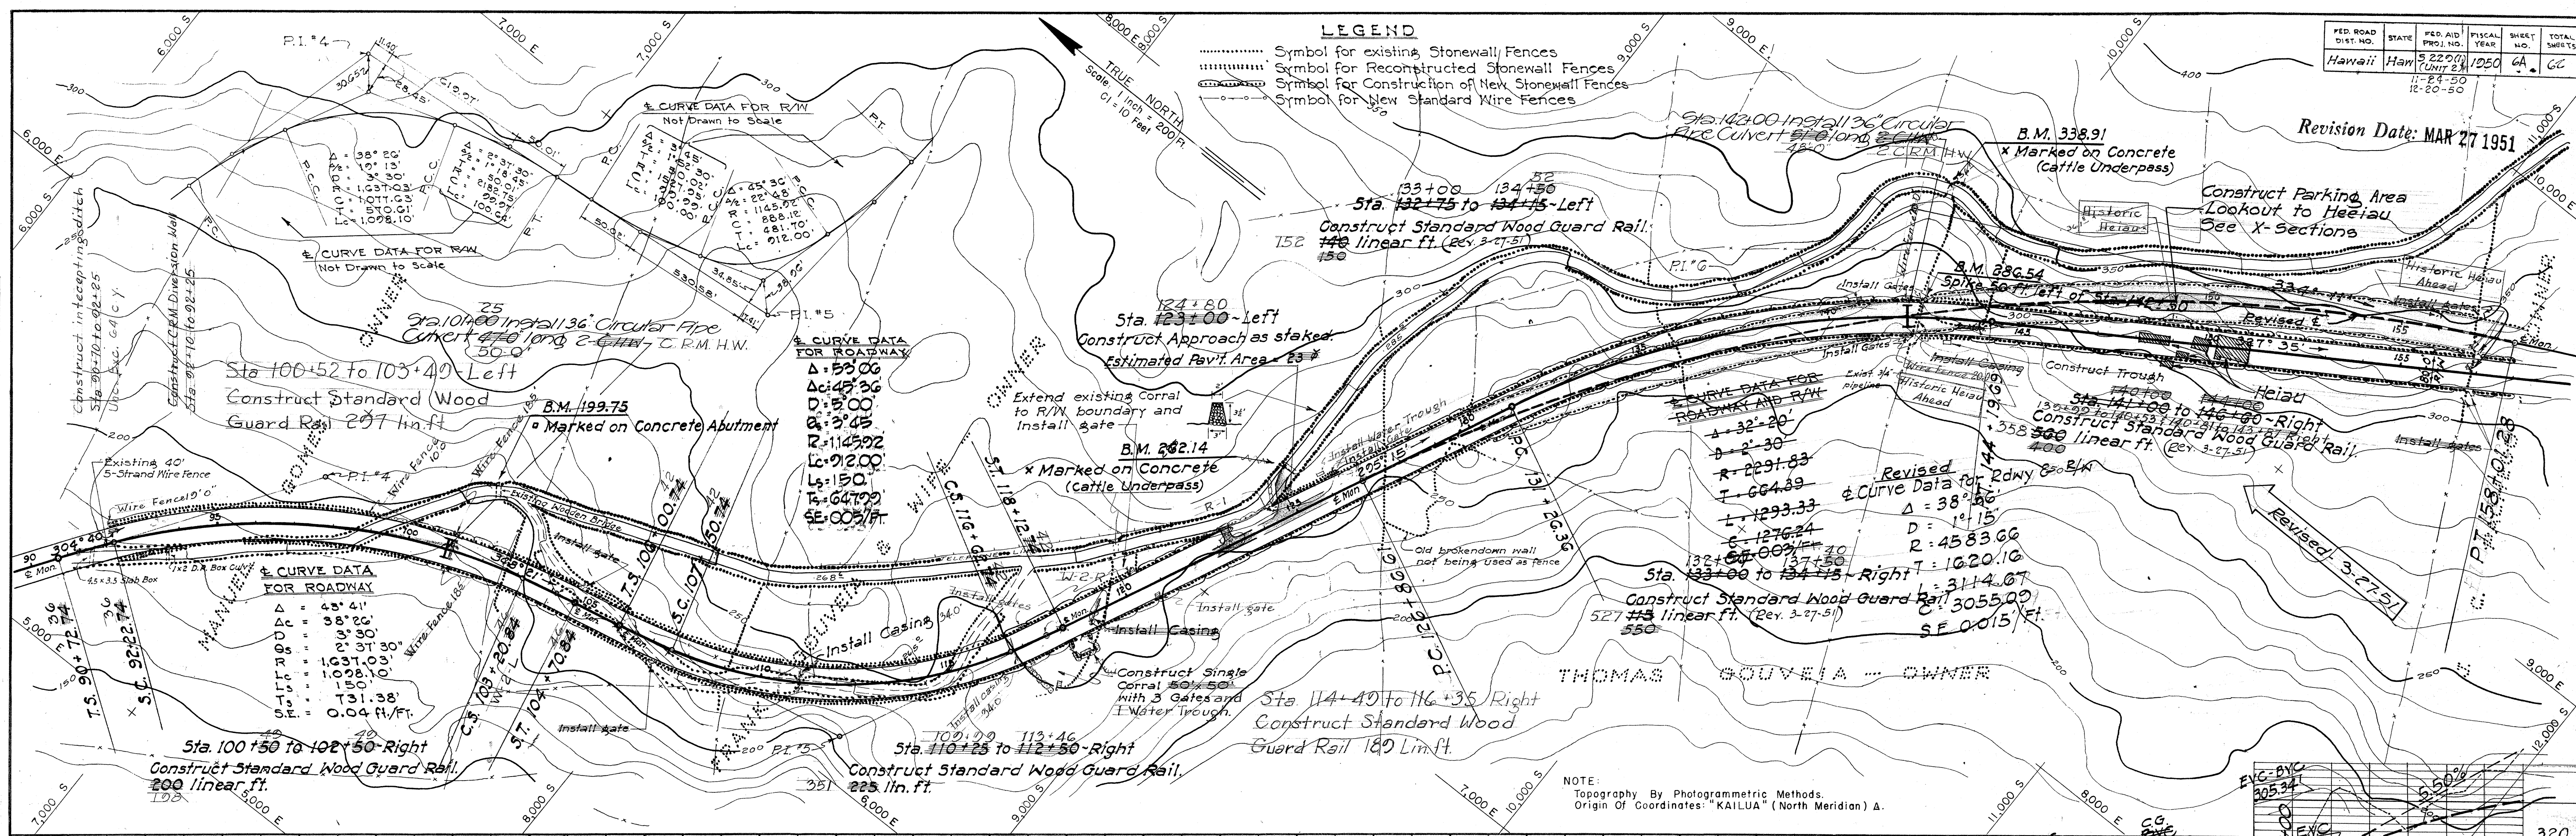

PLAN	SURVEYED	BY	DATE
	PLOTTED		
	NOTE BOOK		
NO.	ALIGNMENT CHECKED		
	RT. OF WAY CHECKED		

PROFILE		BY	DATE
SURVEYED			
PLOTTED			
NOTE BOOK			
GRADES CHECKED			
B. M'S NOTED			
STRUCTURE NOTATIONS CH'KD.			
NO.			

Rev. 3/27/51
Change in alignment
and grades.

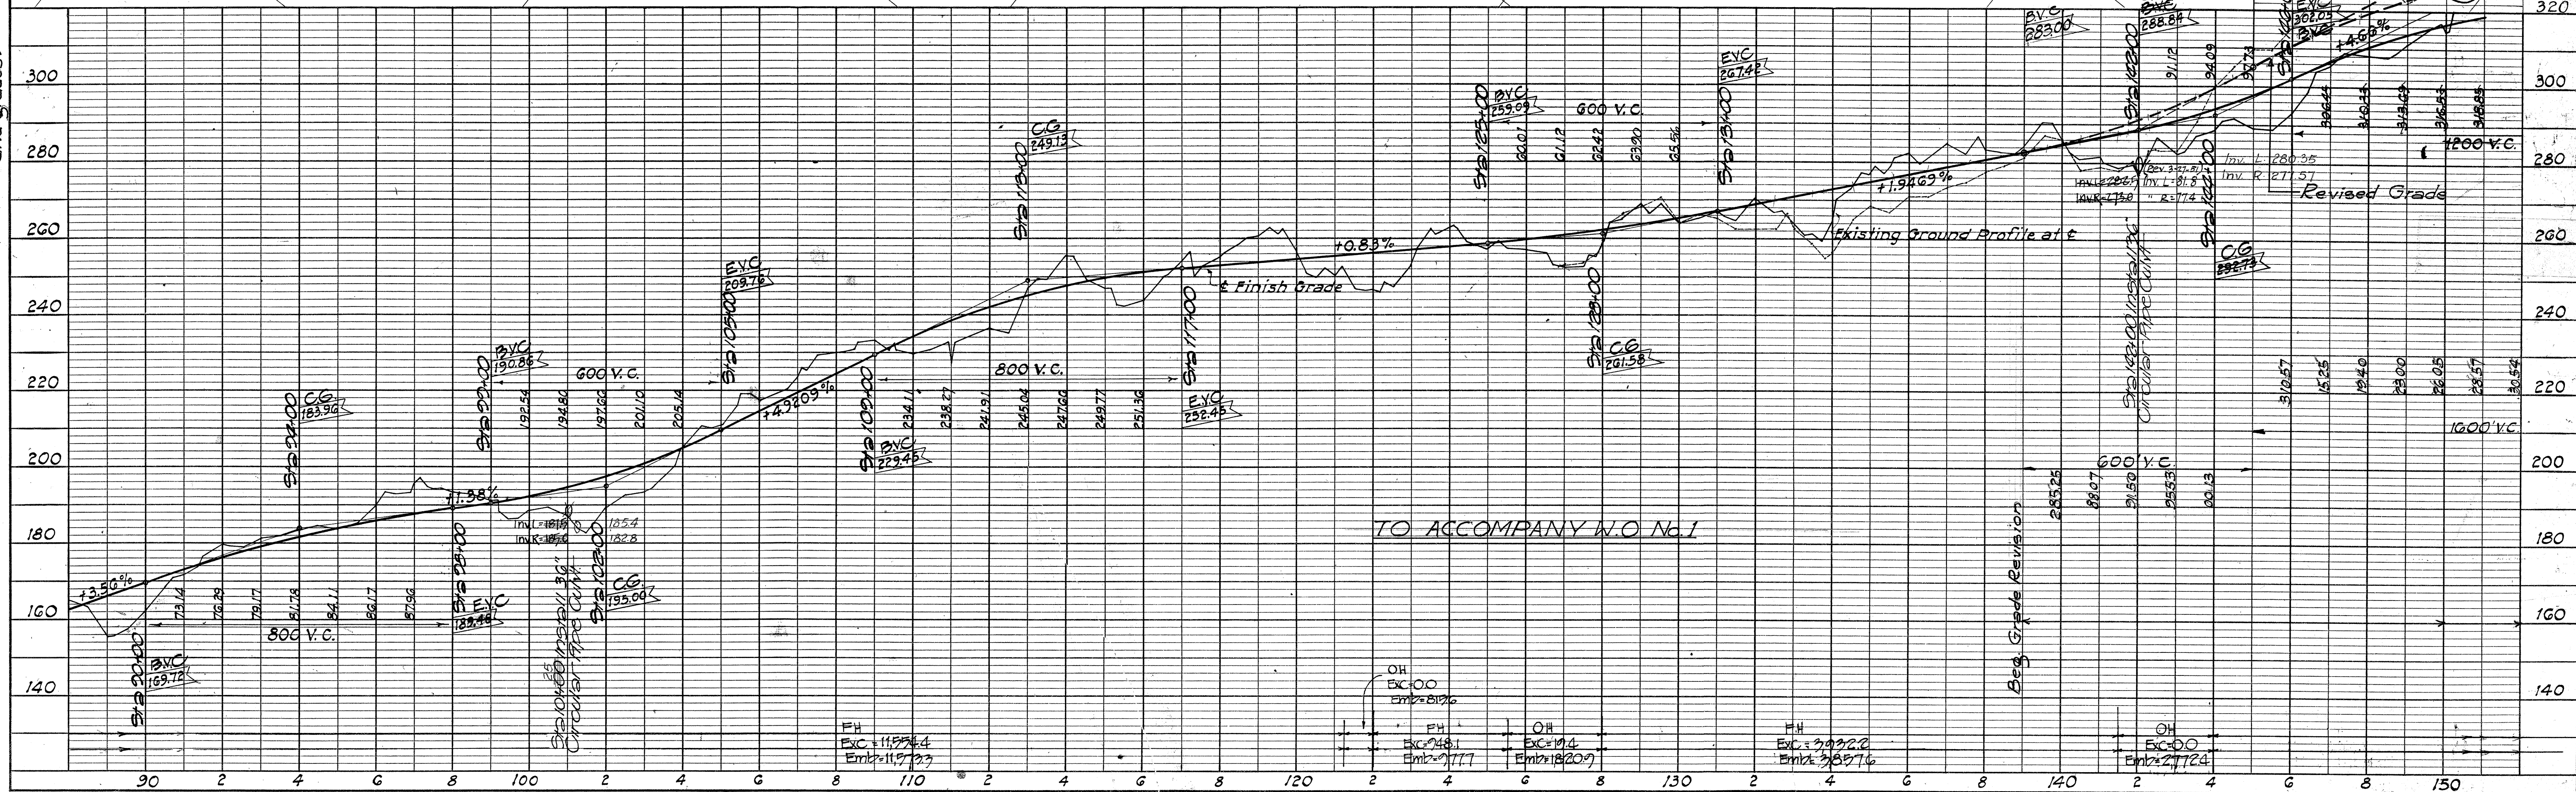

2266
HONOLULU, T. H.



R. M. TOWILL
CIVIL ENGINEER & SURVEYOR

SCHUMAN BLDG. PLATE 1-PLAN-PROFILE © P. R. & R. E. STANDARD
AUGUST 4, 1949 KEUFFEL & ESSER CO., NEW YORK.

5486.6A

5486.6A



FED. ROAD DIST. NO.	STATE	FED. AID PROJ. NO.	FISCAL YEAR	SHEET NO.	TOTAL SHEETS
HAWAII	HAW	5,225 (1) (Unit 2)	1950	7	66
			12-28-50		
			12-28-50		

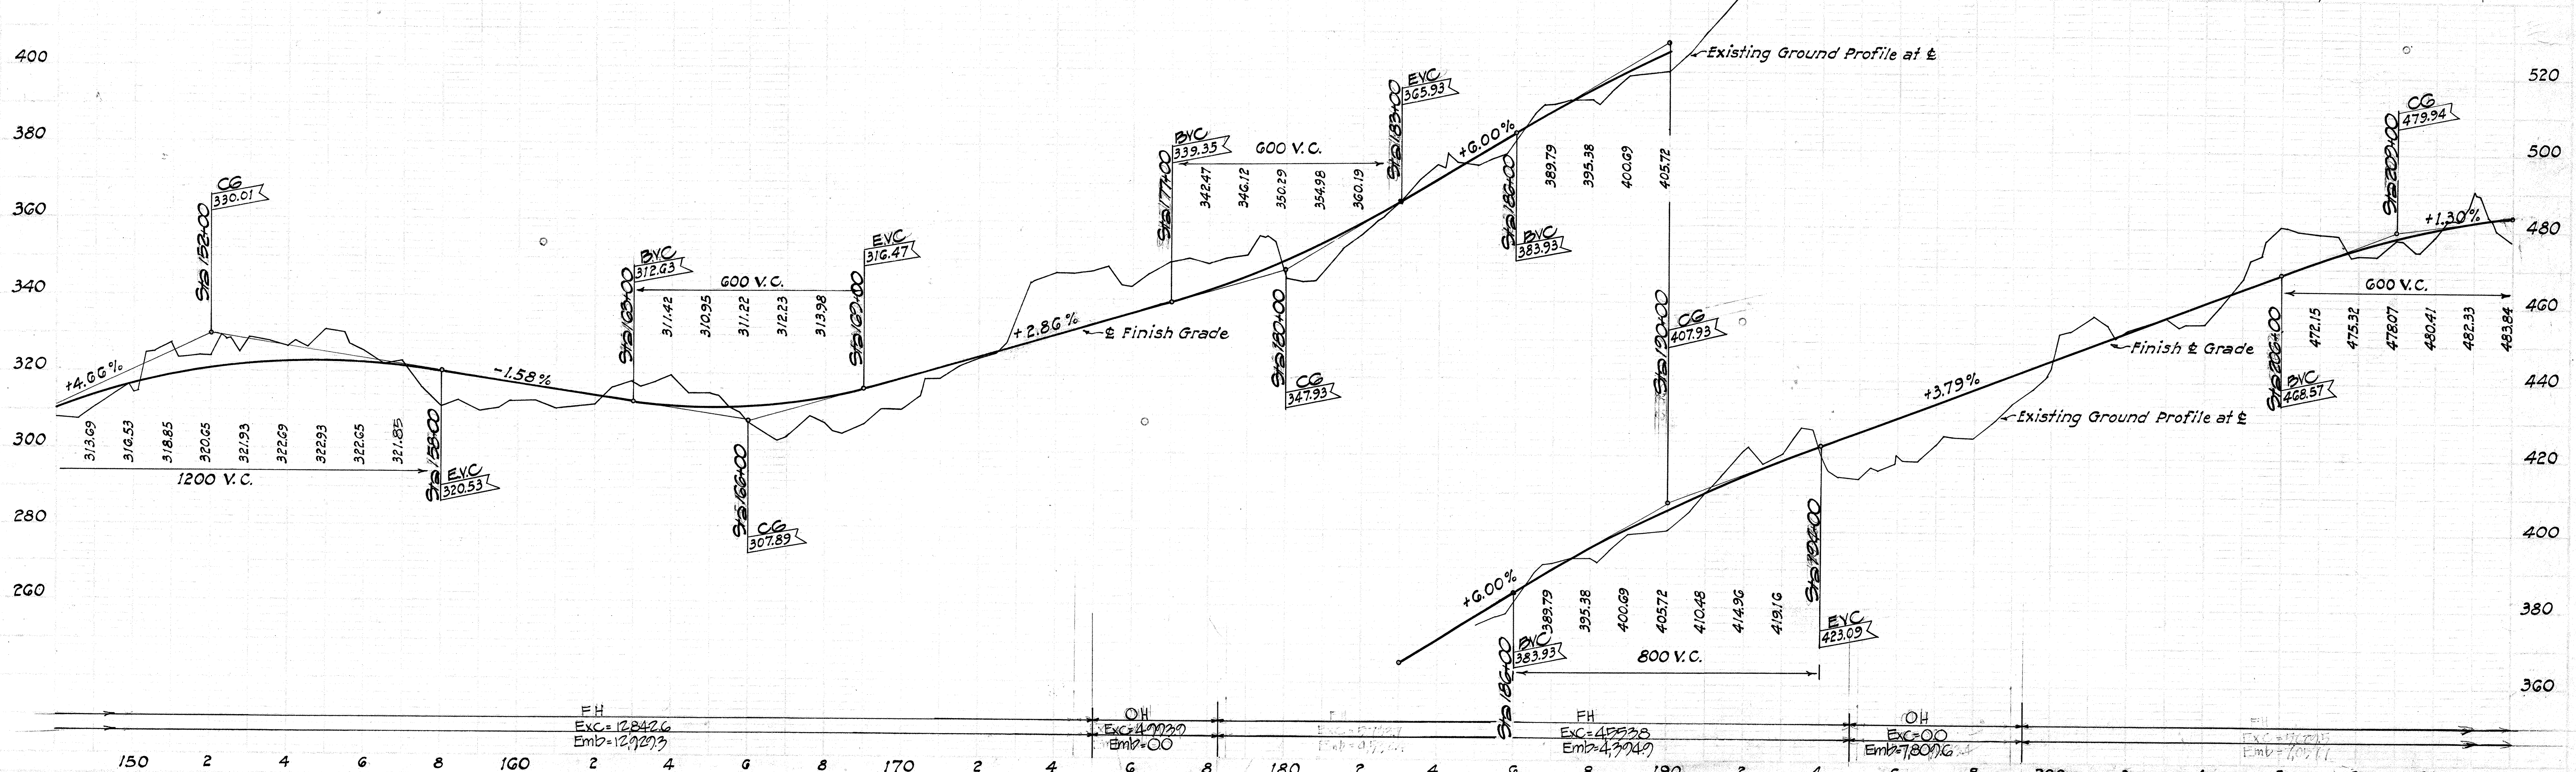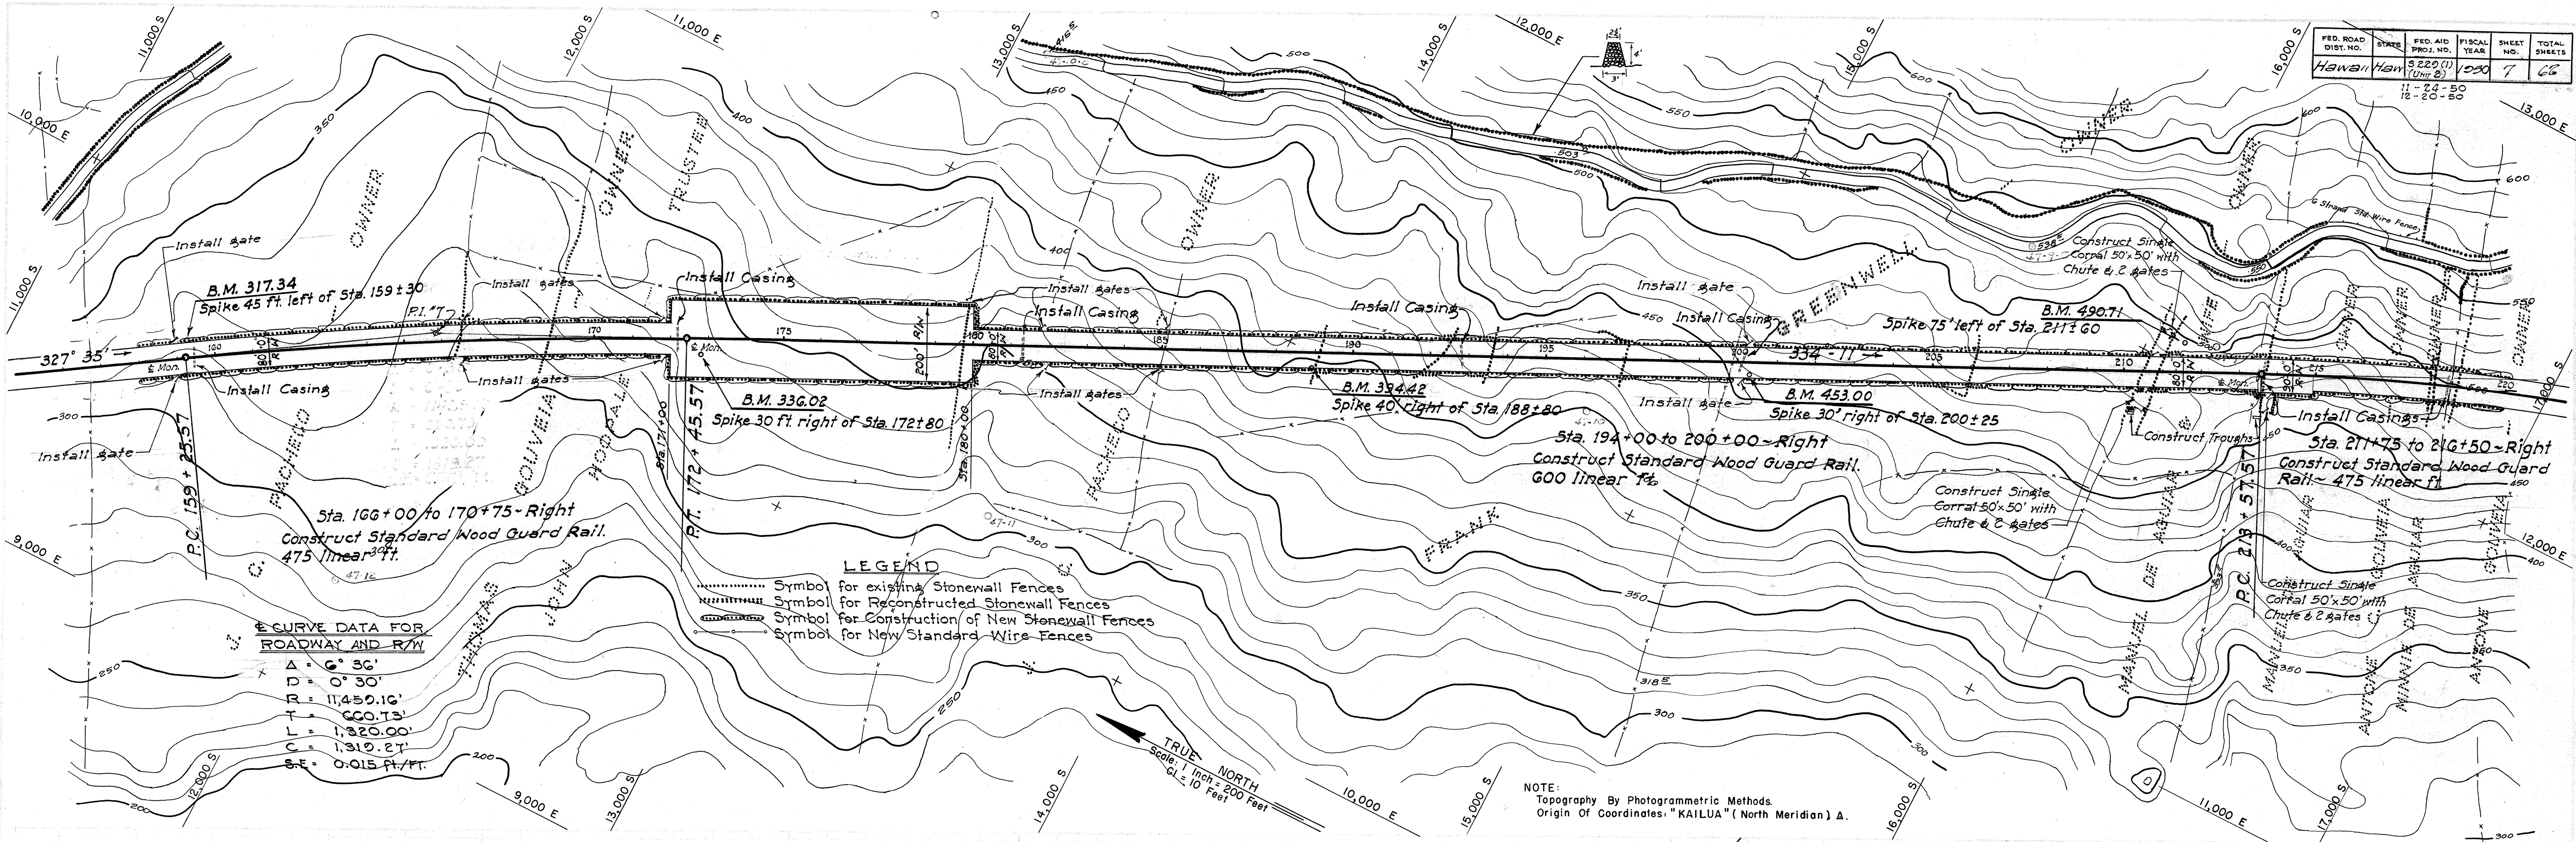



PLAN	DATE	BY
SURVEYED		
NOTED		
ALIGNED		
CHECKED		
NO.		





Rev. 3/27/51
Change in Alignment: 126+86.61 to 172+442.50
and Grades:

PROFILE	DATE	BY
SURVEYED		
NOTED		
GRADES CHECKED		
NO.		

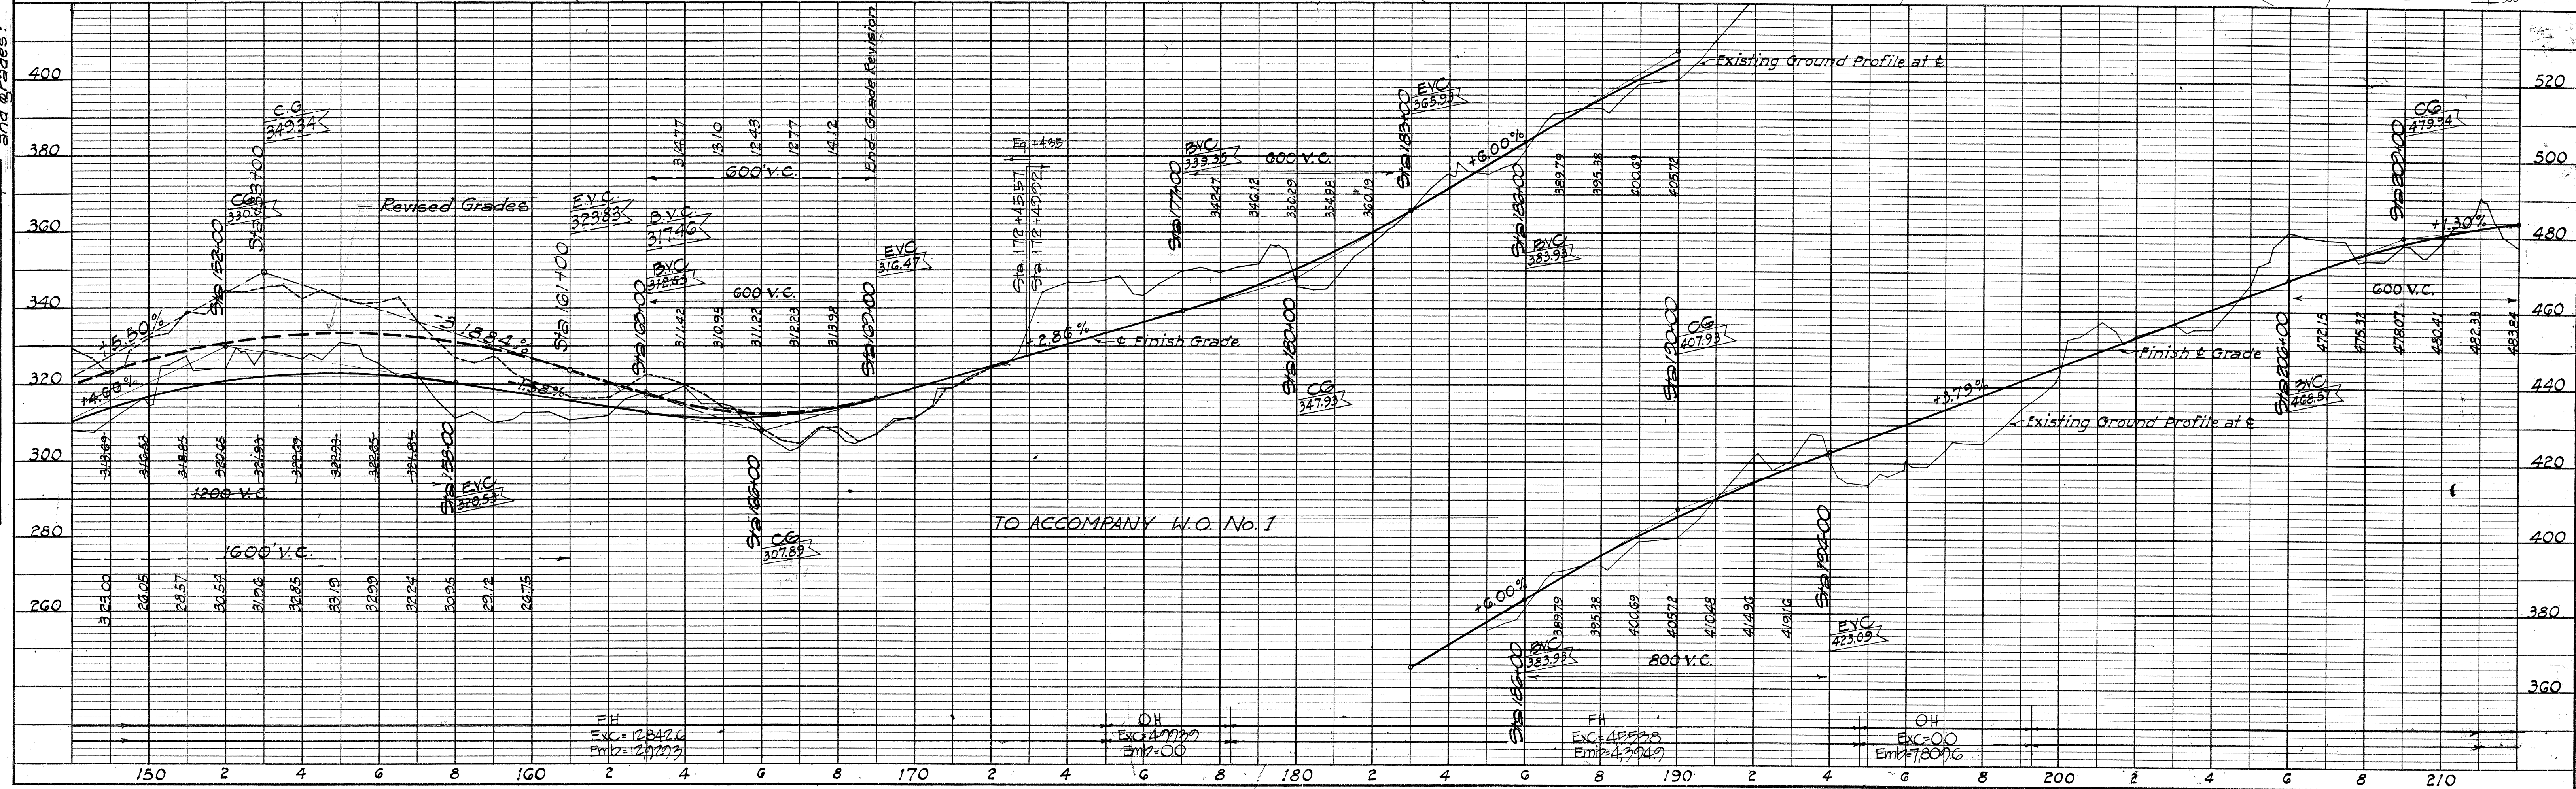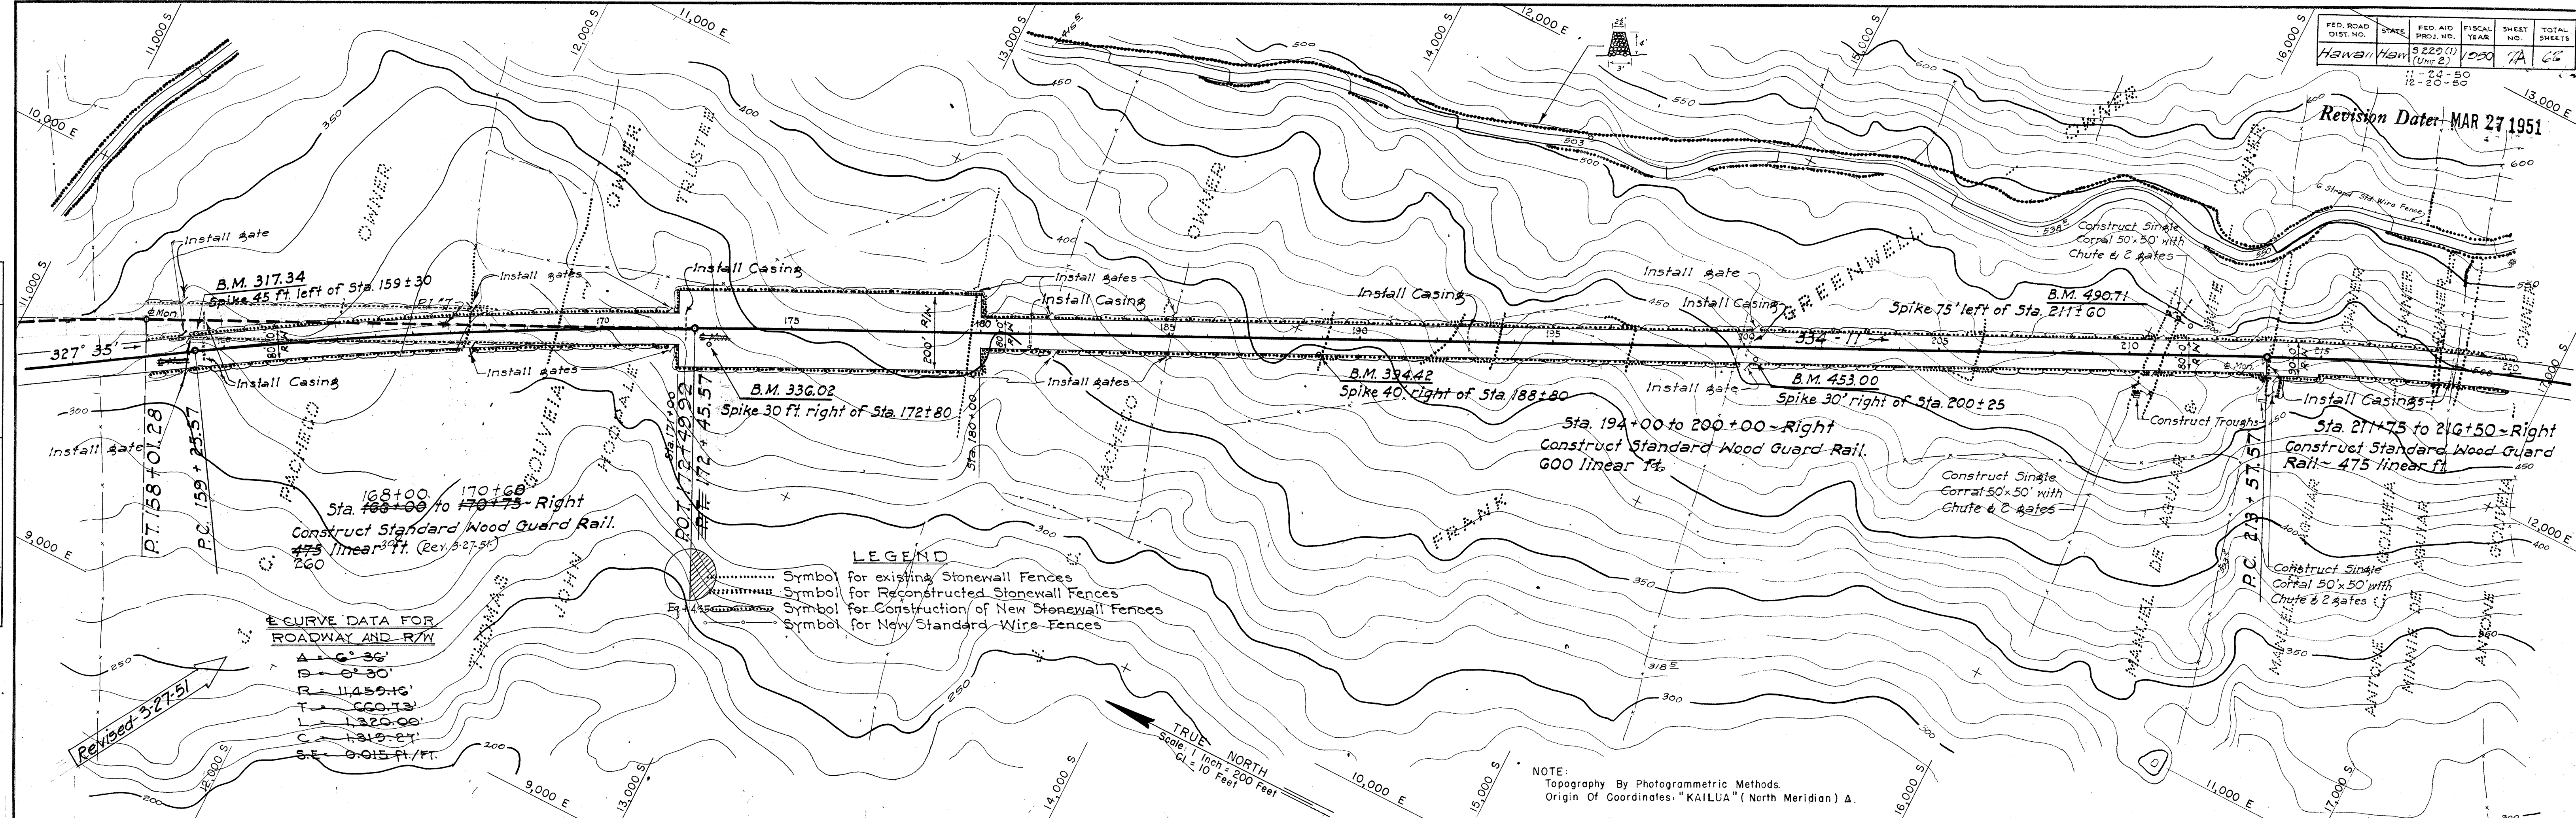

5486.7A

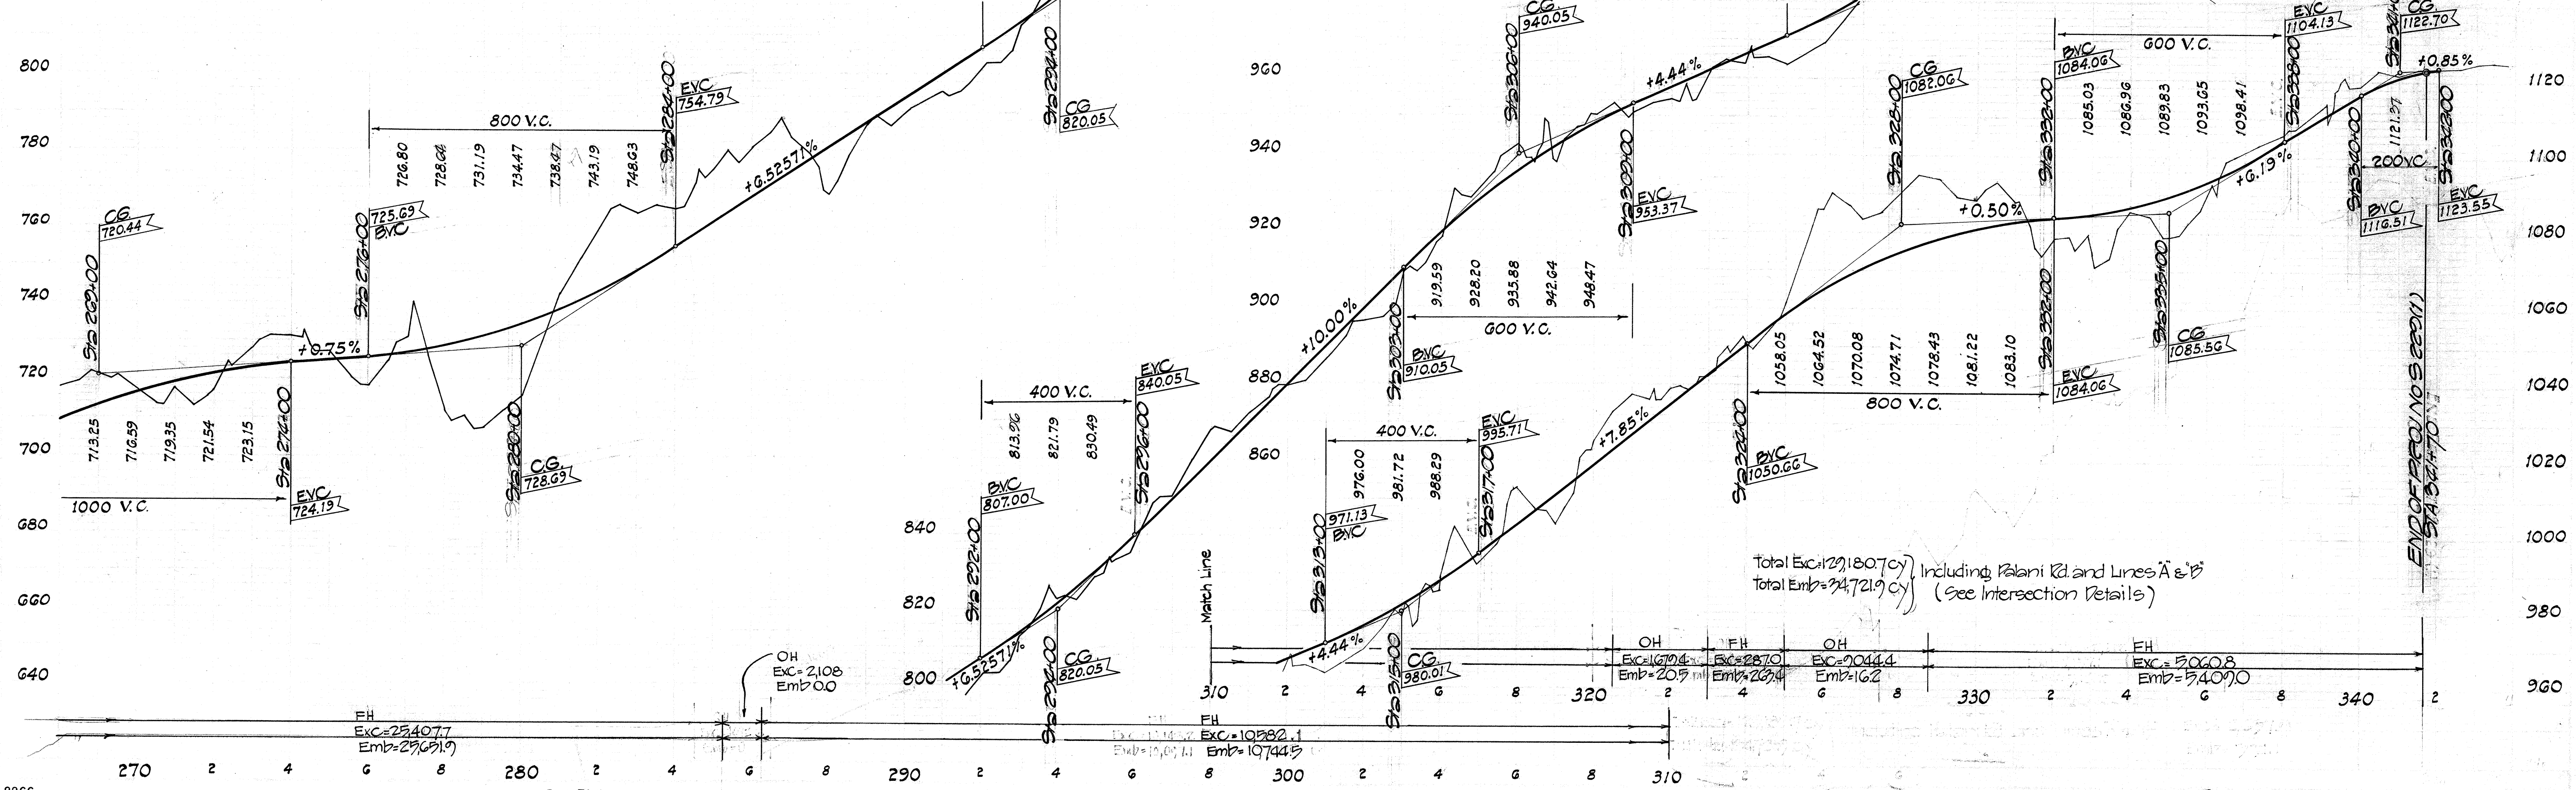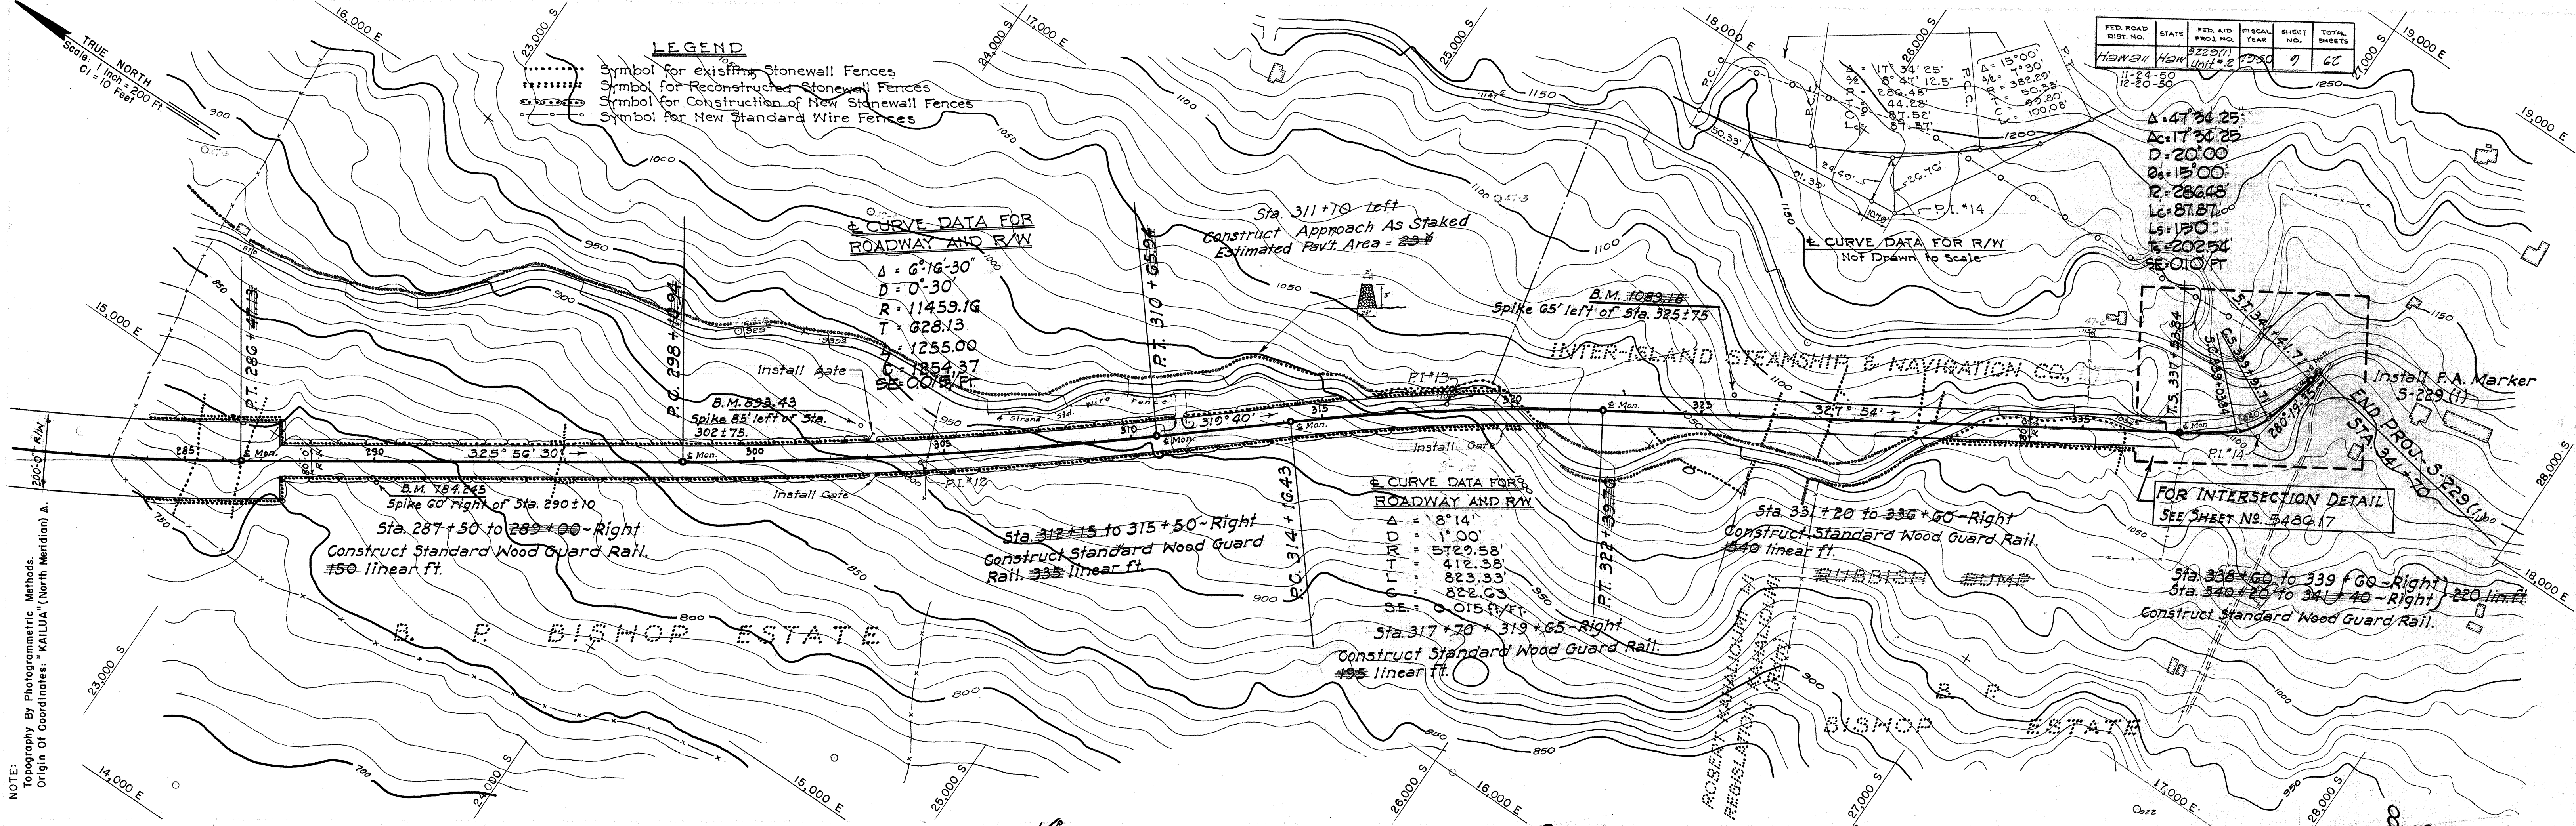

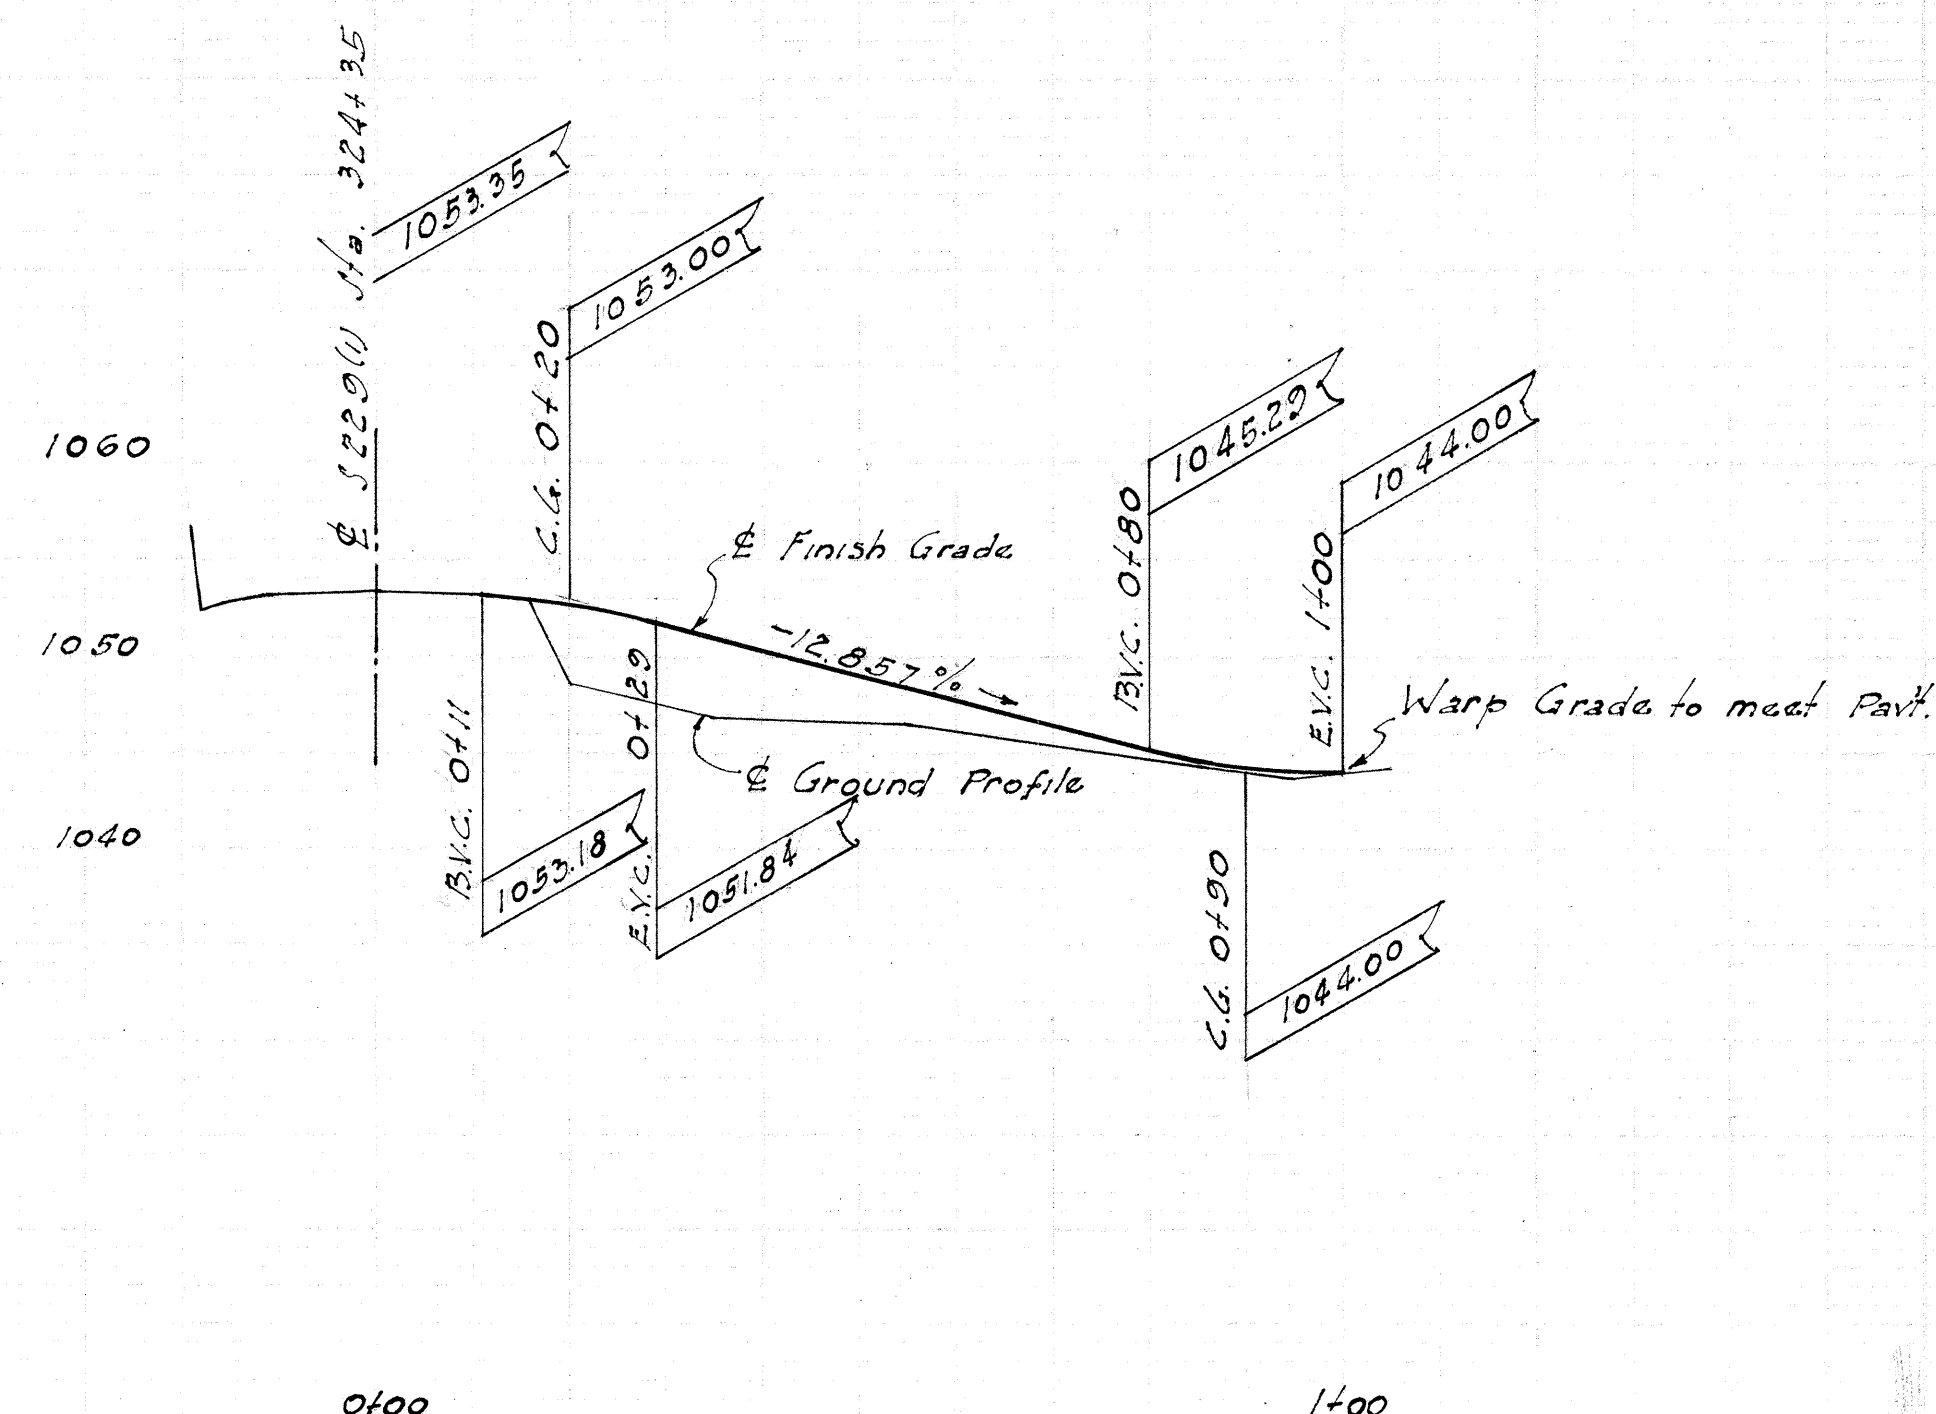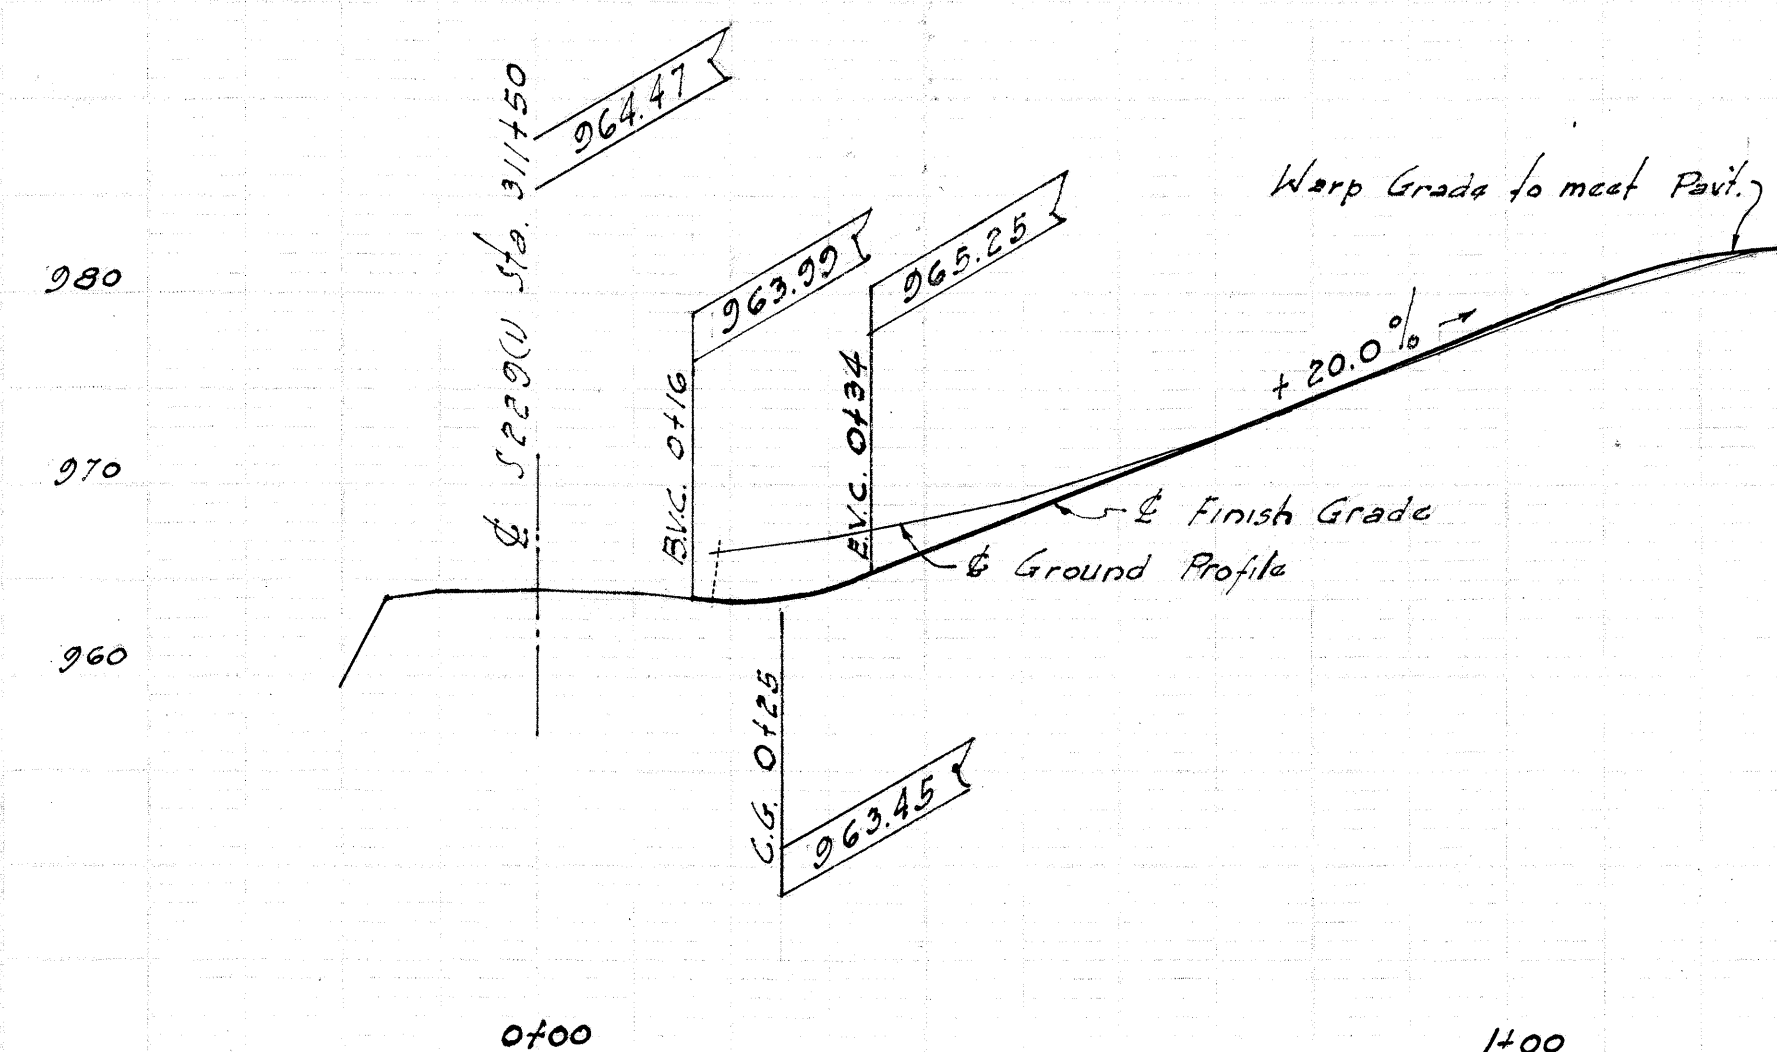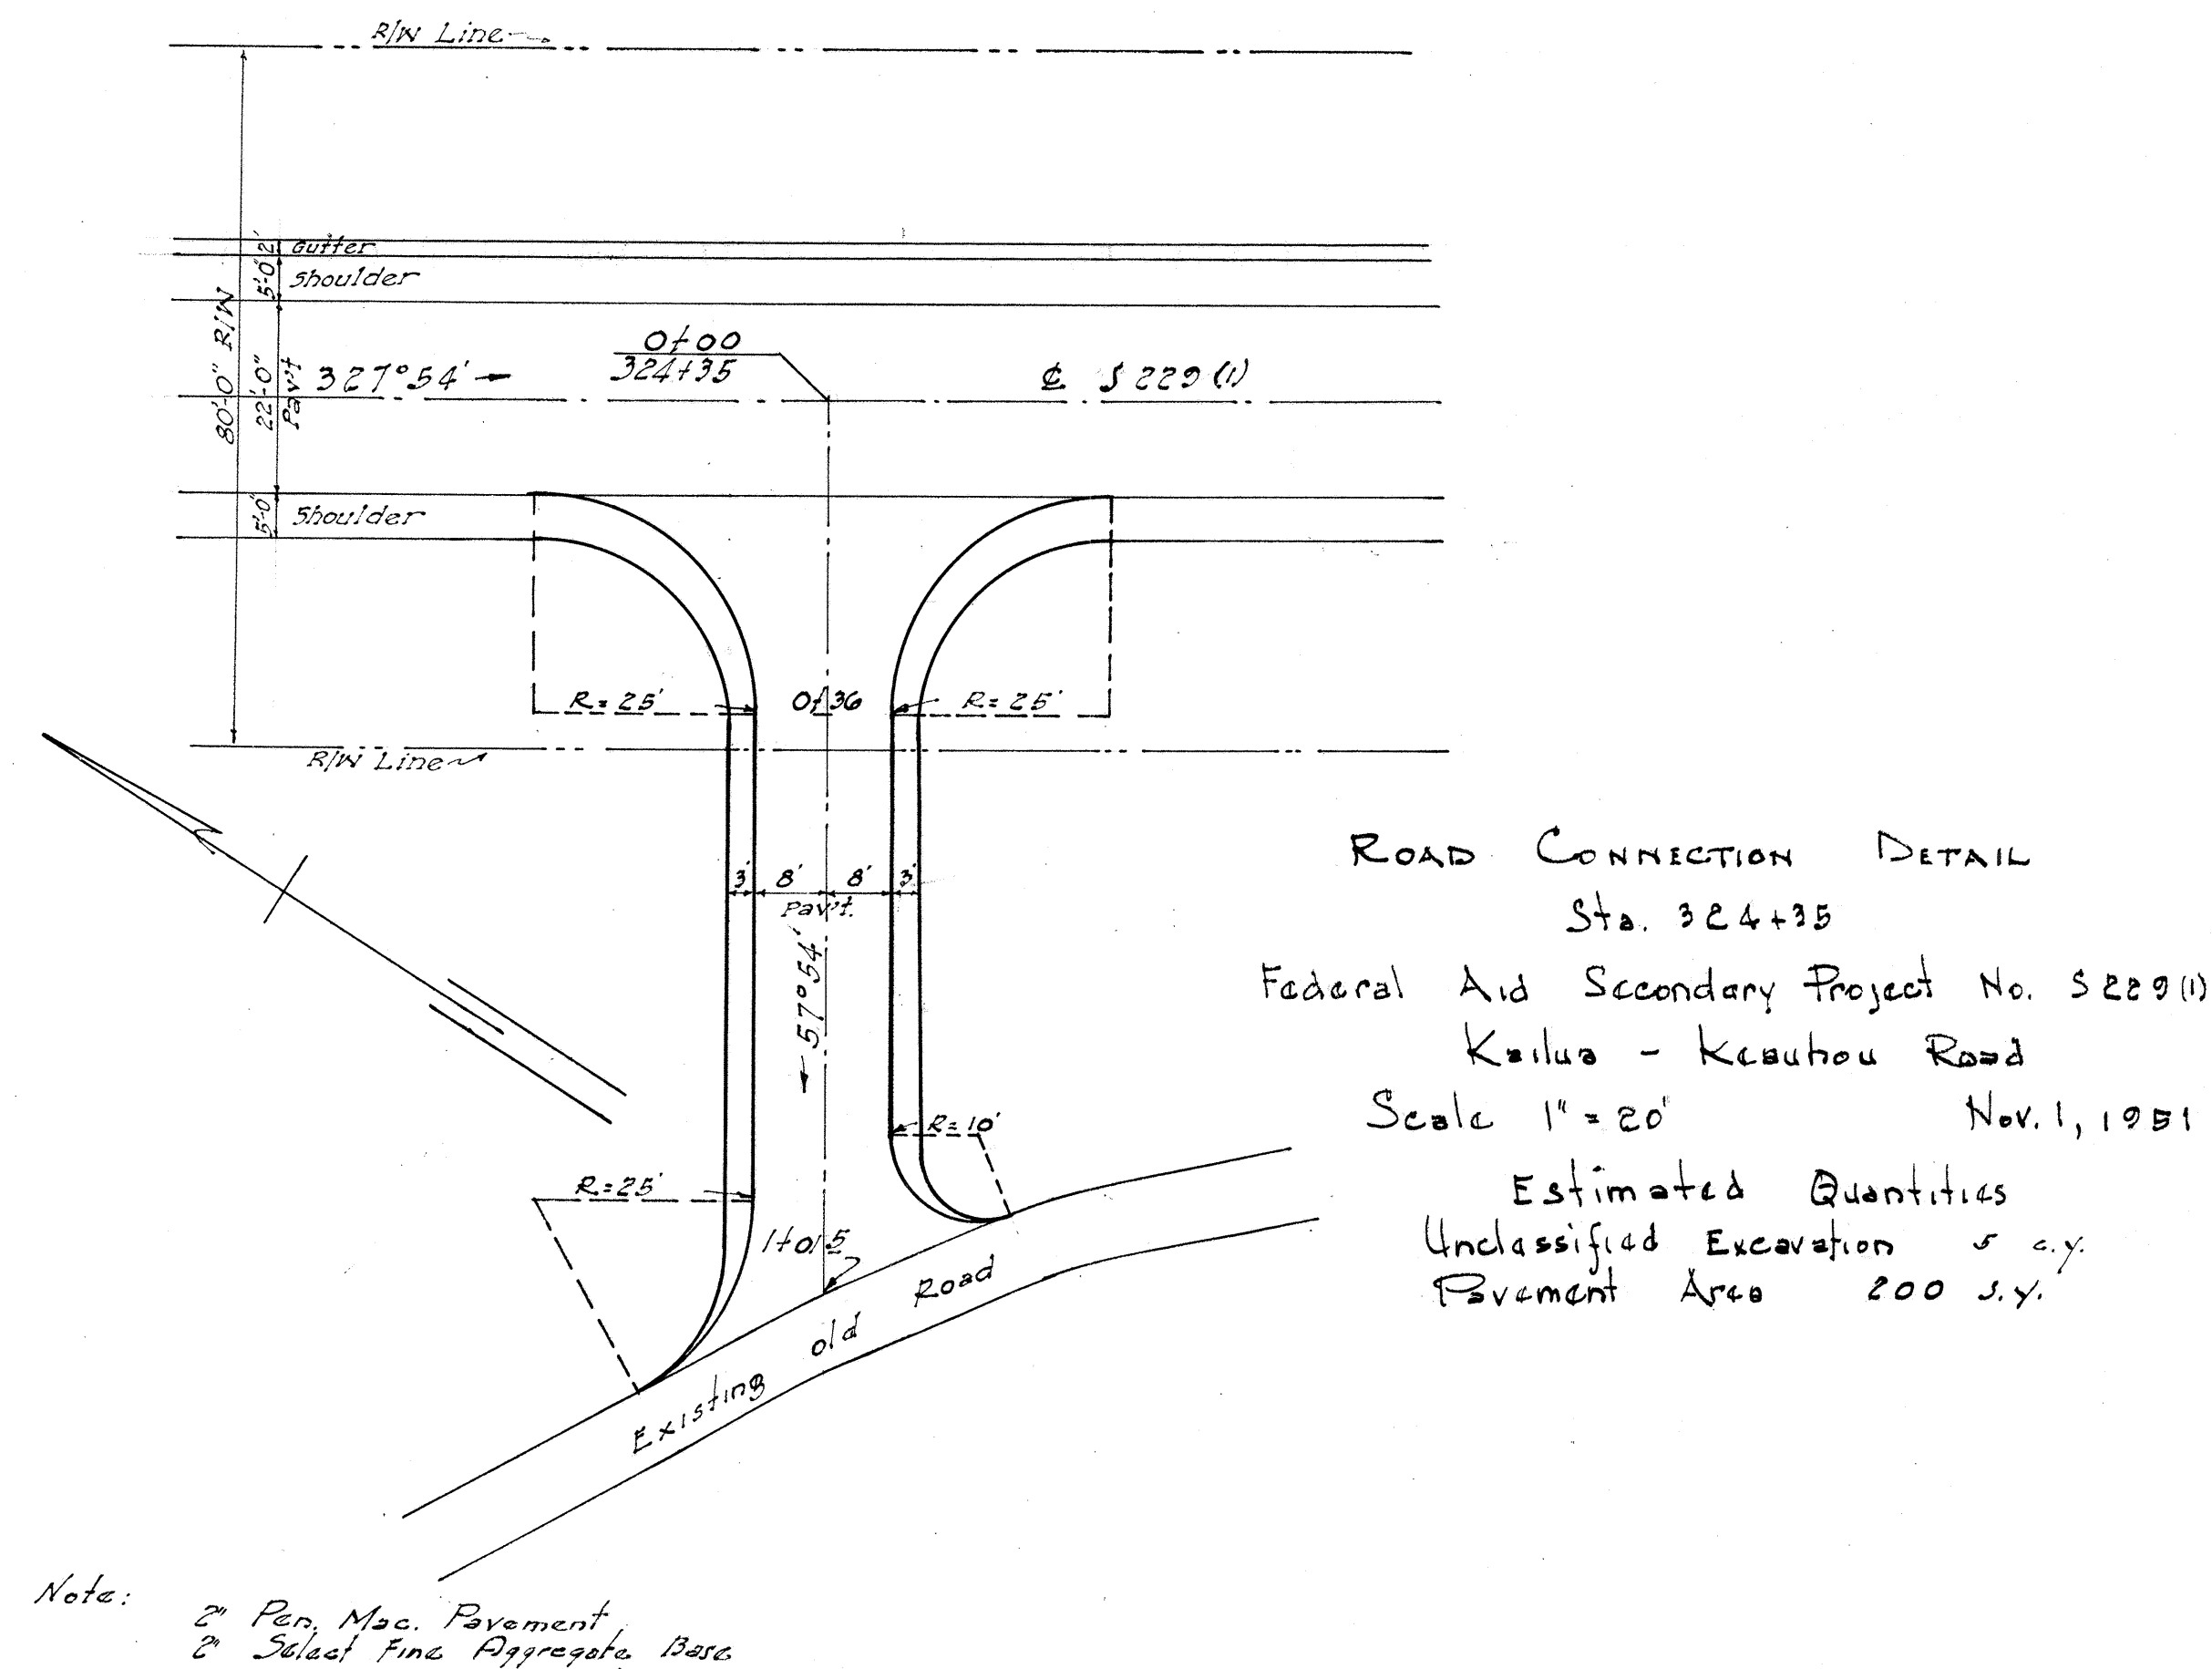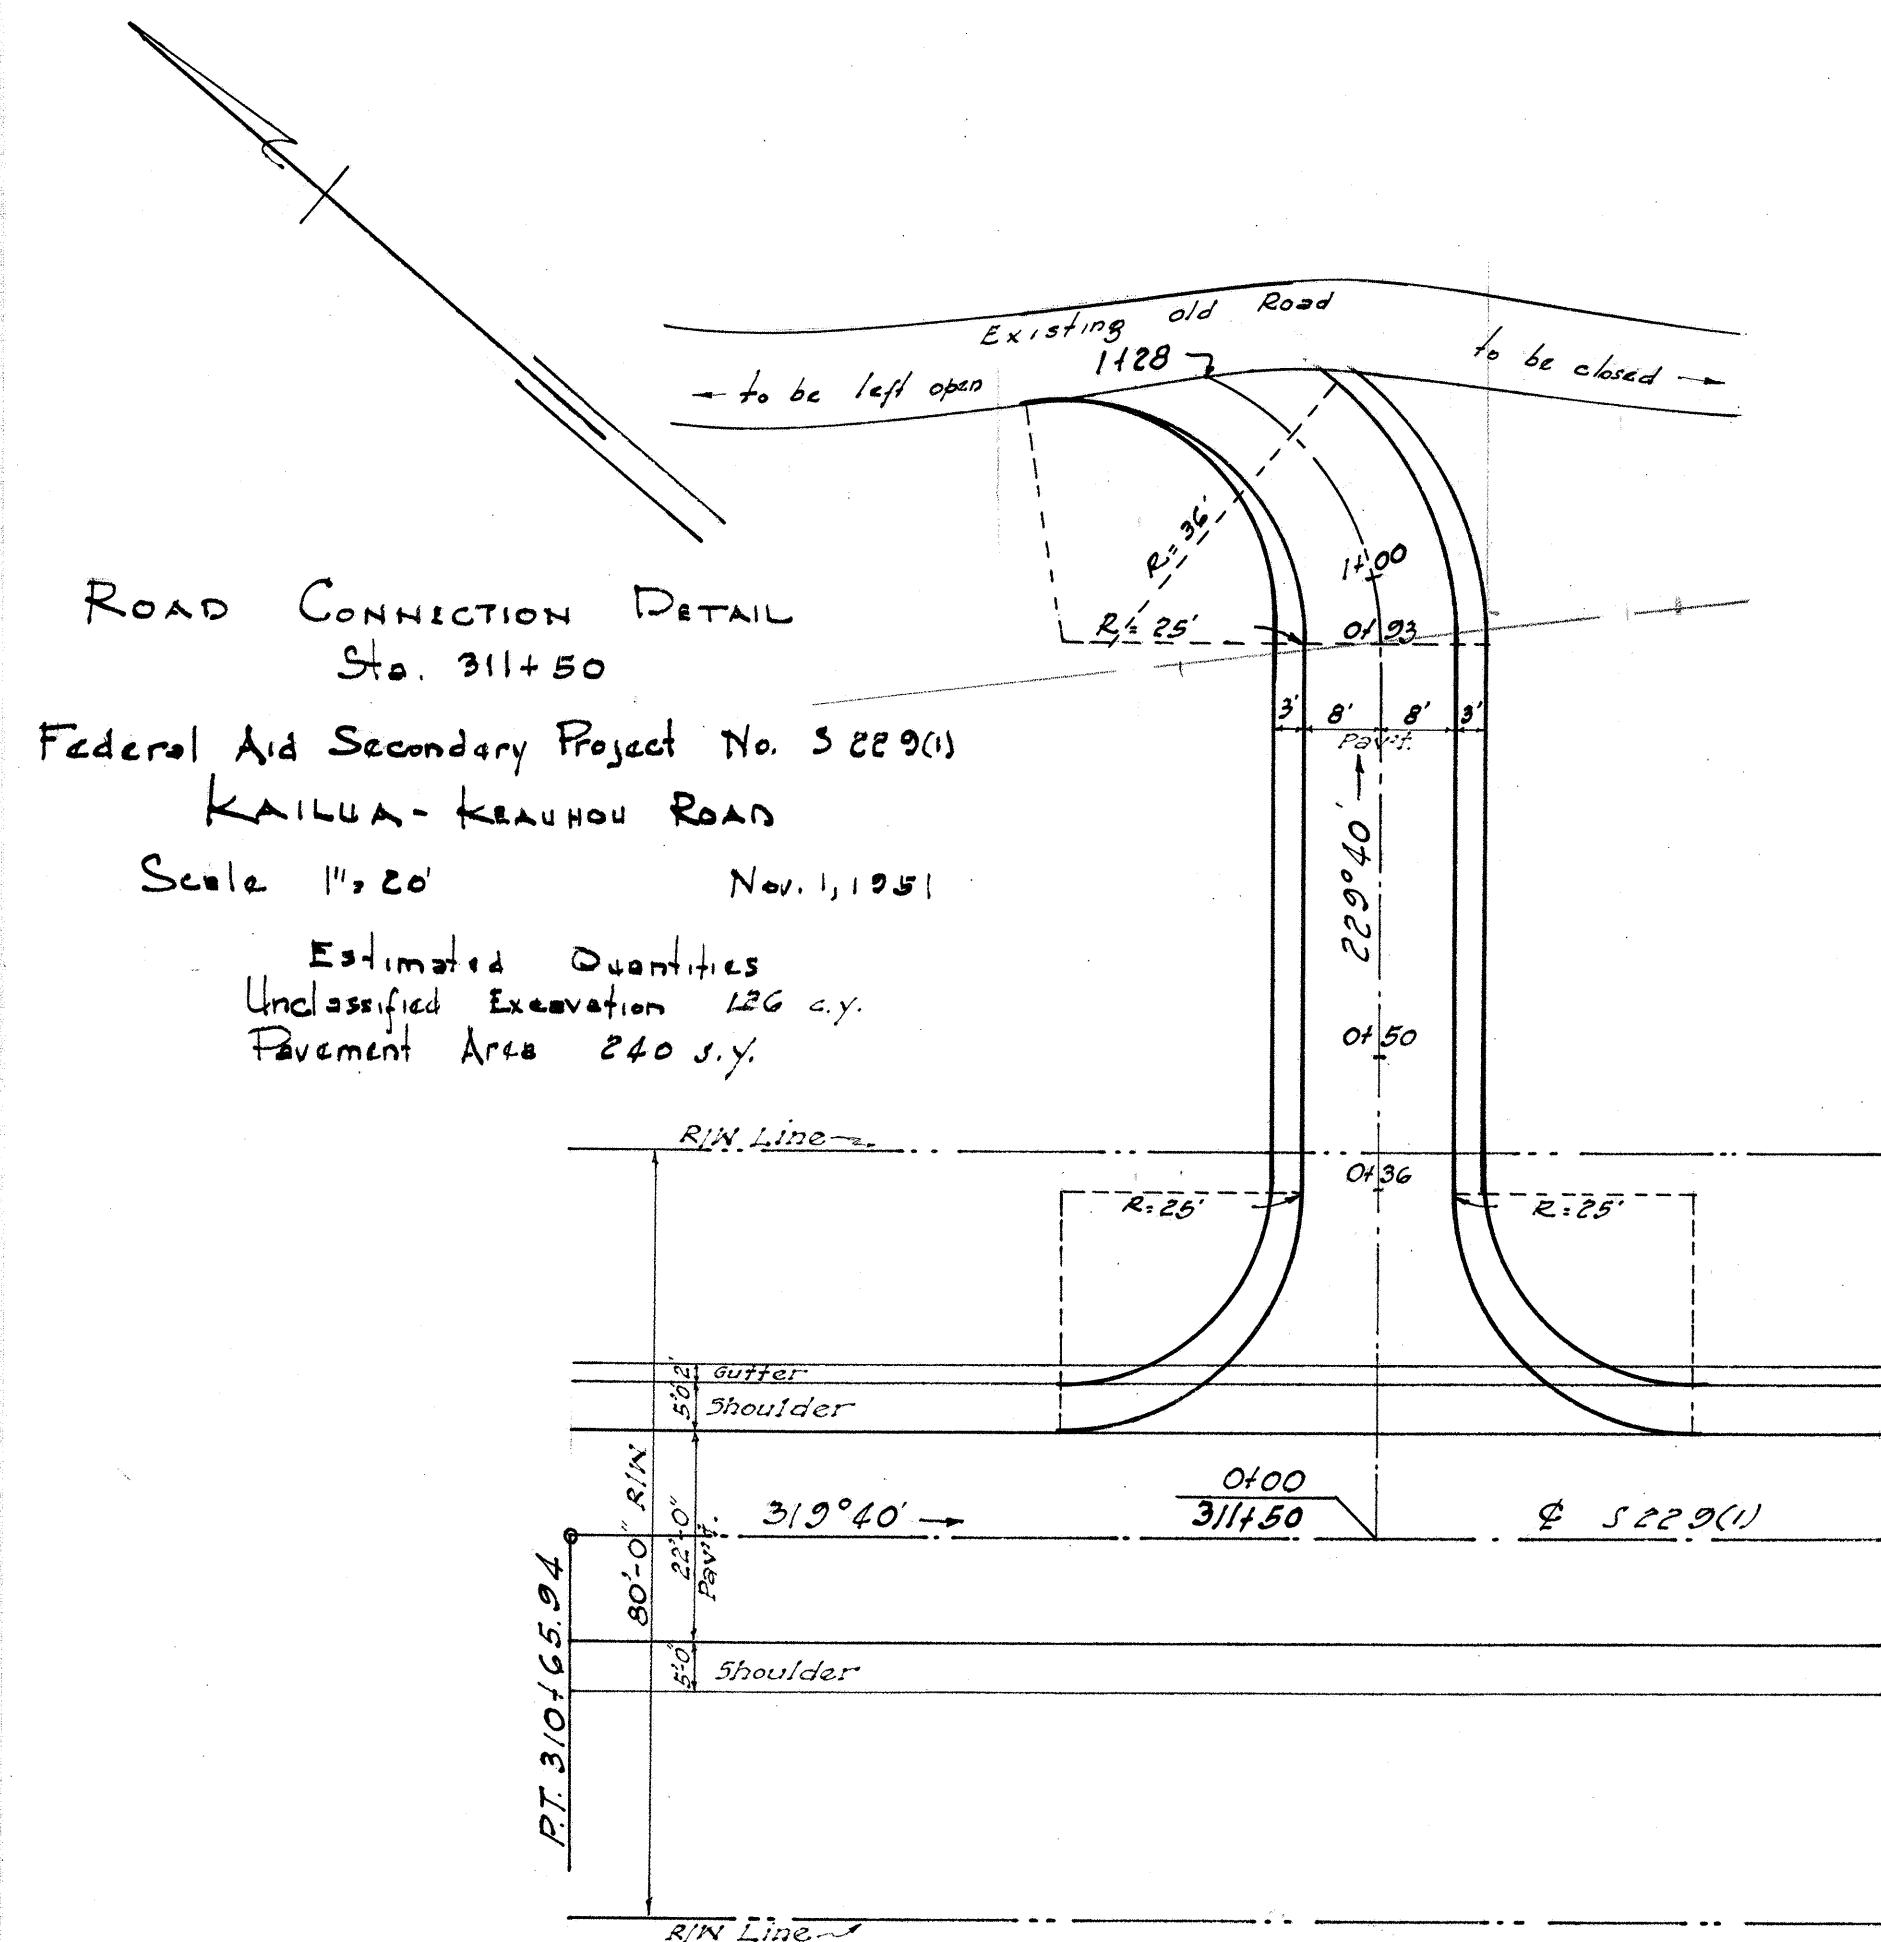

Added Nov. 19, 1951

5486.9A