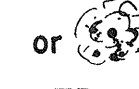


INDEX TO DRAWINGS			
UNIT No.	JOB No.	SHEET	DESCRIPTION
1	5502	1	TITLE SHEET
		2-7	PLAN & PROFILE
2	5486	1	TITLE SHEET
		2	TYPICAL SECTION
		3	BORROW PIT
		4-9	PLAN & PROFILE
		10-12	STANDARD DETAILS
		13-17	INTERSECTION DETAILS
		18	5x5' BOX CULVERT
		19-22	CROSS SECTION

CONVENTIONAL SIGNS USED

Centerline	-----	155
Boundary Lines	-----	or, -----
Fences (Noted)	-----	or, -----
Existing Roadway	-----	
Box Culvert	-----	
Circular Culvert	-----	
Bridge	-----	
Railroad	-----	or, -----
Tree (Large)	-----	or 
Telephone Pole	-----	O TP
Electric Pole	-----	⌘ EP
Warning & Regulatory Signs	-----	
Centerline Monument	-----	⊙


TERRITORY OF HAWAII
TERRITORIAL HIGHWAY DEPARTMENT
HONOLULU T.H.

PLANS OF
KAILUA-KEAUHOU ROAD
FEDERAL AID SECONDARY PROJECT NO. S 229 (I)
UNIT 1 — CLEARING JOB NO. 5502

UNIT 2 — GRADING, PAVING AND STRUCTURES JOB NO. 5486
DISTRICT OF NORTH KONA
ISLAND OF HAWAII

SCALES

PLAN		1 IN. = 200 FT.
PROFILE	HOR.	1 IN. = 200 FT.
	VERT.	1 IN. = 20 FT.
GROSS SECTION	HOR.	1 IN. = 10 FT.
	VERT.	1 IN. = 10 FT.

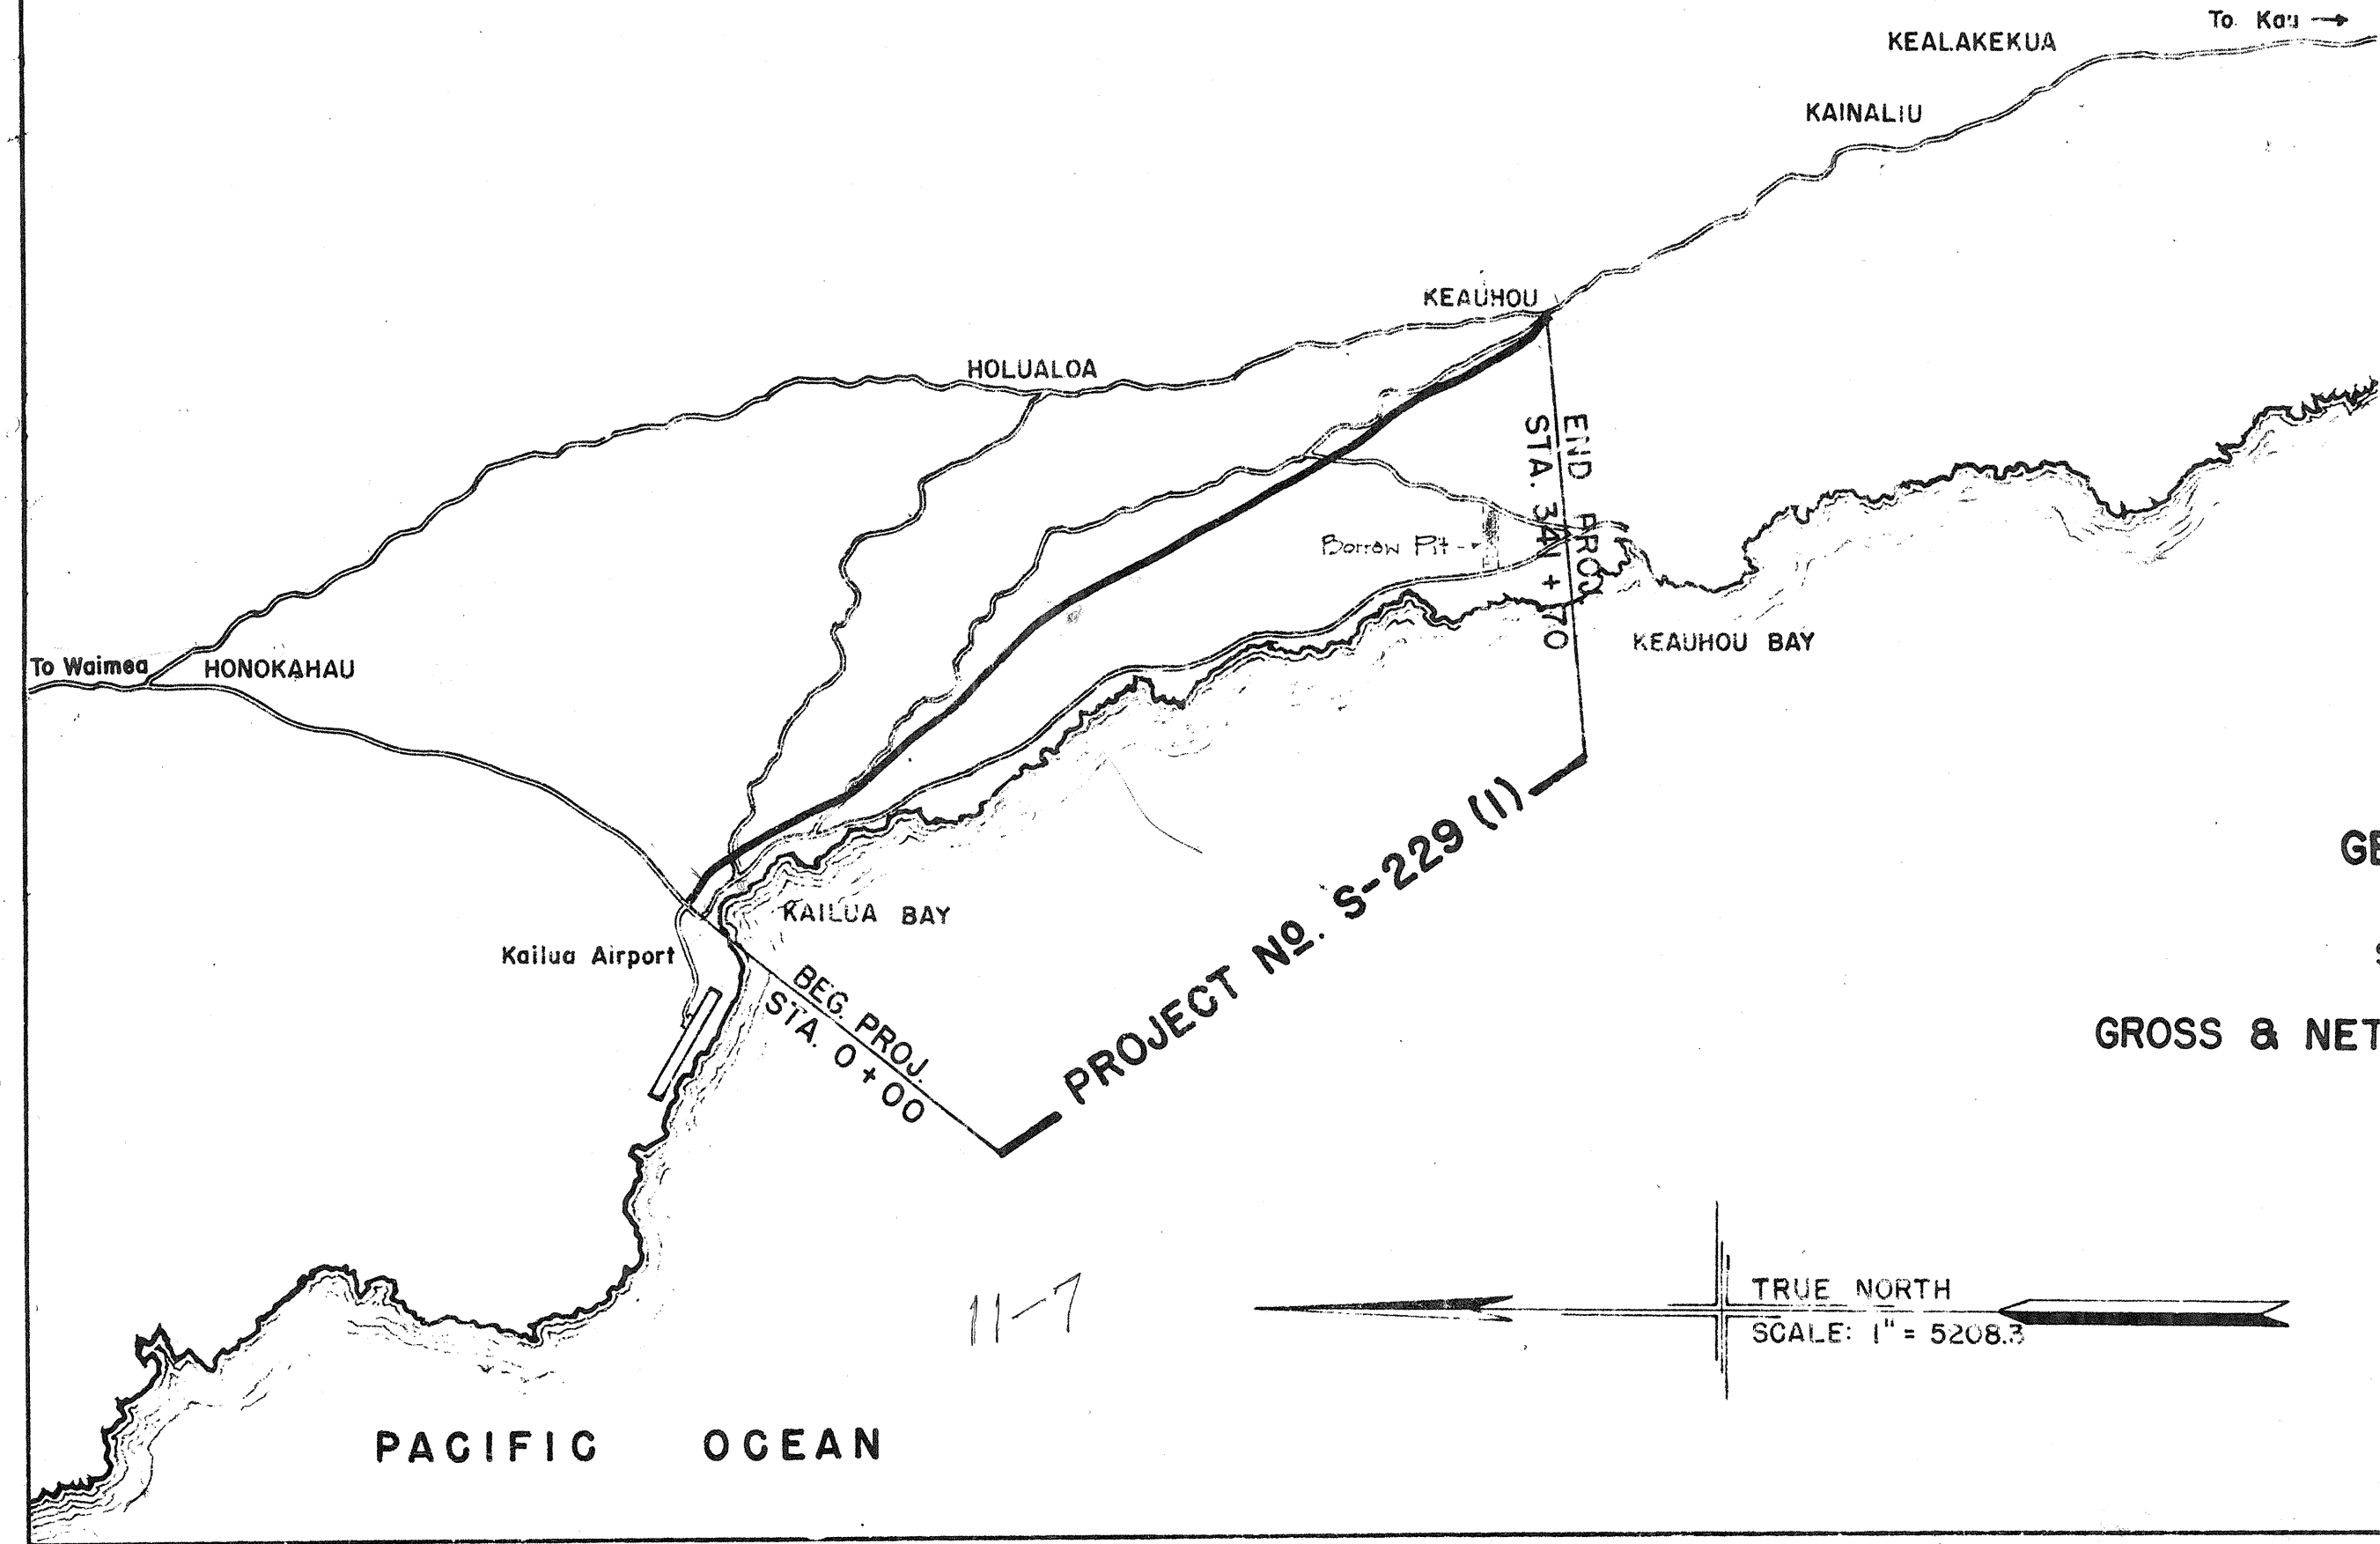


GENERAL LOCATION PLAN

SCALE: 1 INCH = 5208.3 FEET

GROSS & NET LENGTH OF PROJECT = 6.472 MILES

LOCATION OF PROJECT
PROJECT NO. S 229 (I)

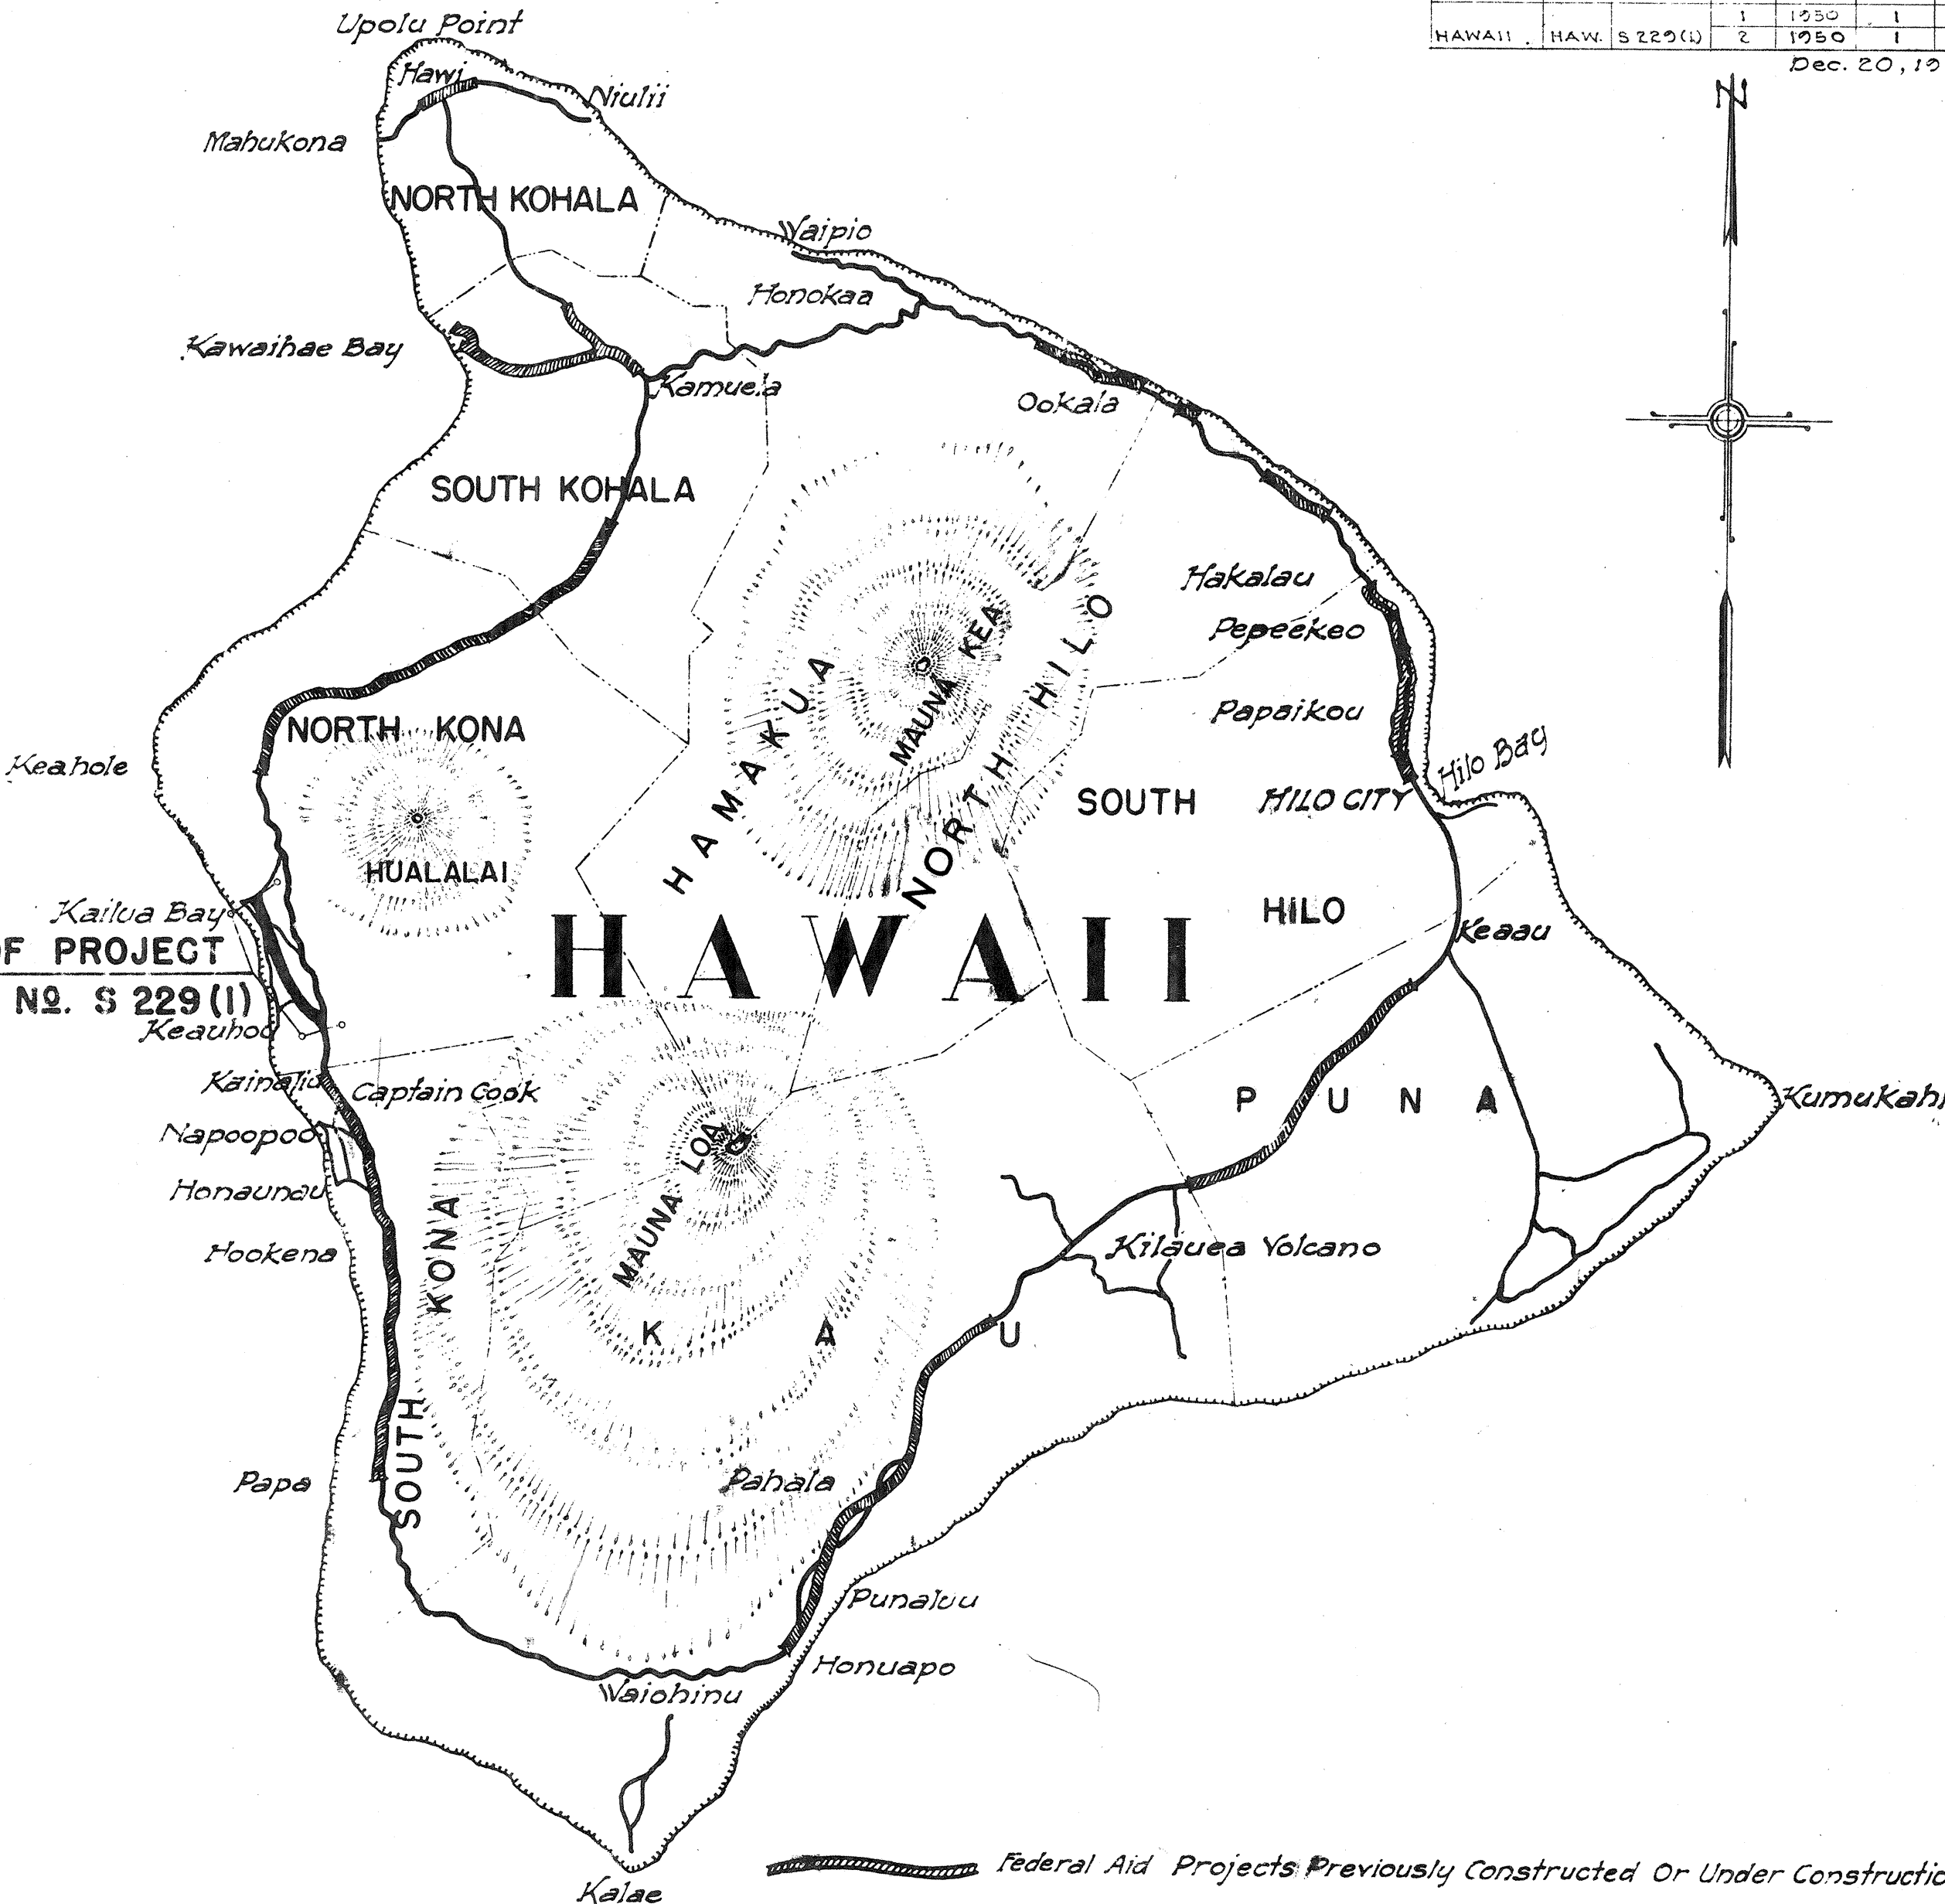

NOTE

ALL CHANGES MADE DURING CONSTRUCTION
HAVE BEEN NOTED IN RED ON THESE
SHEET AND CHECKED BY

Ed Kama
PROJECT ENGINEER
DATE 12/10/54

DEPARTMENT OF COMMERCE BUREAU OF PUBLIC ROADS	
RECOMMENDED FOR APPROVAL:	
DISTRICT ENGINEER	DATE
DIVISION ENGINEER	DATE

APPROVED: *[Signature]* DATE 7-28-50
TERRITORIAL HIGHWAY ENGINEER

(UNIT 1)
5502.1

(UNIT 2)
5486.1