
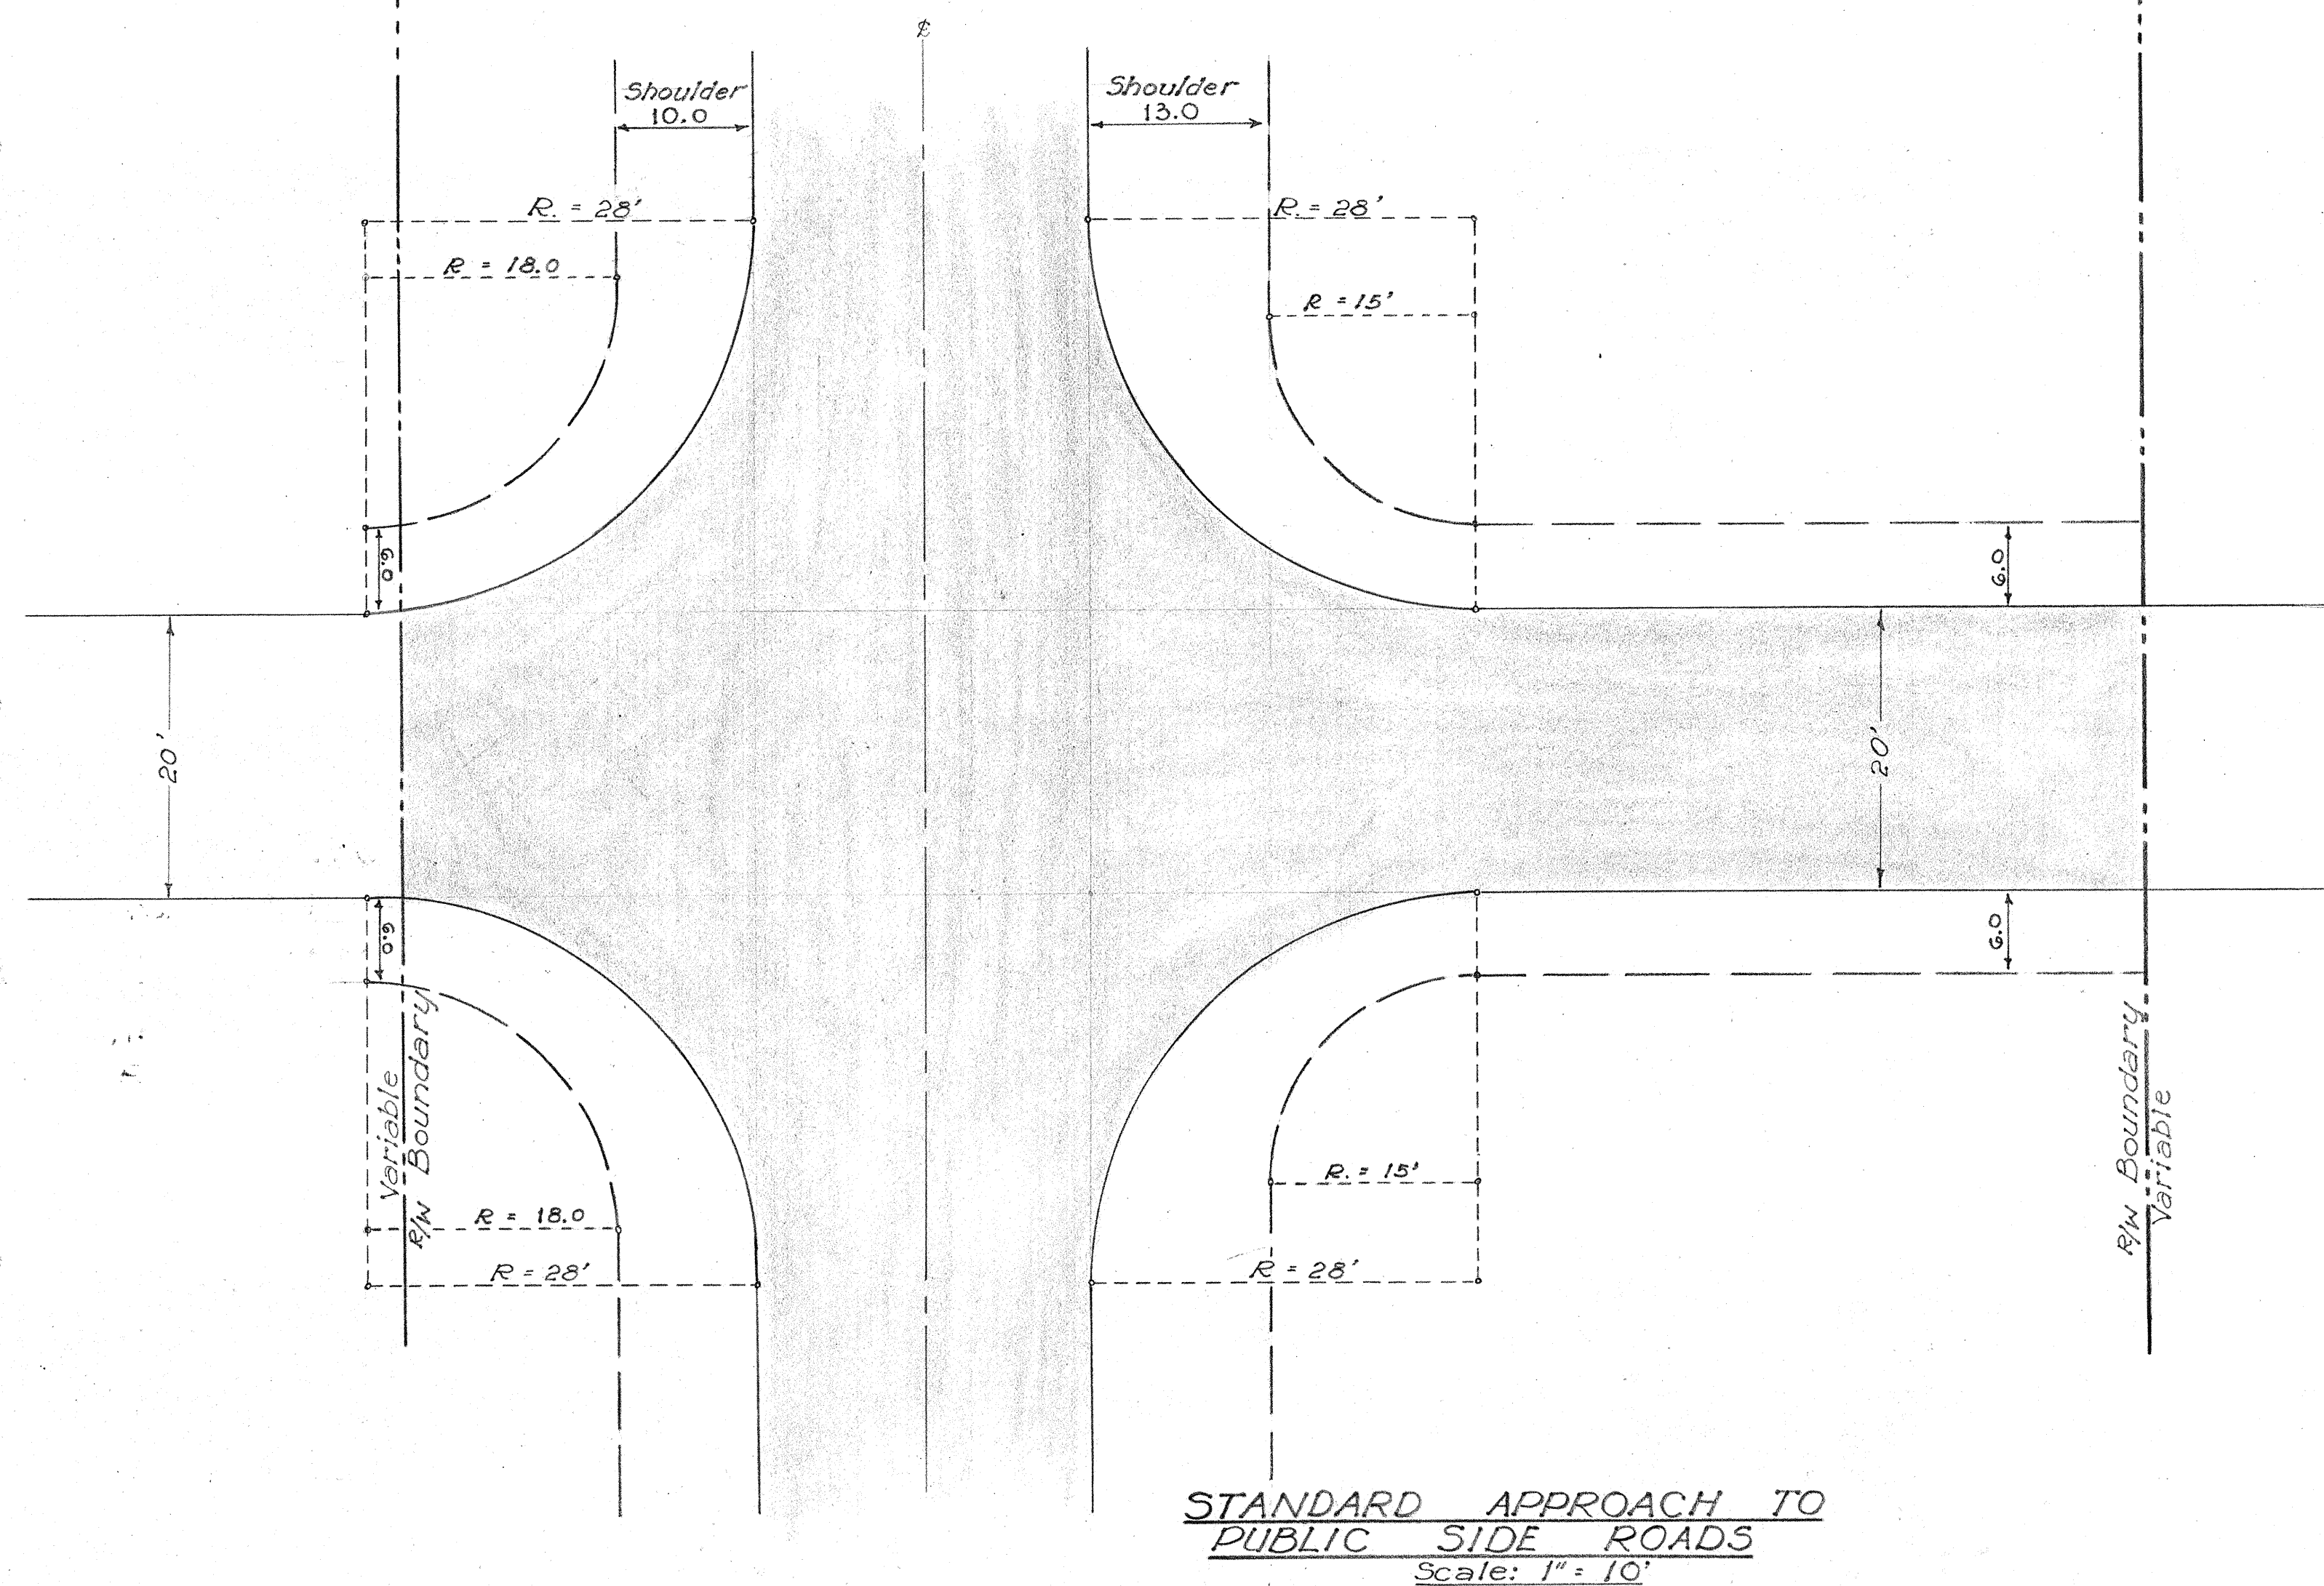


FED. ROAD DIST. NO.	STATE	FED. AID PROJ. NO.	FISCAL YEAR	SHEET NO.	TOTAL SHEETS
HAWAII	HAW	F2(3)	1948	3	42

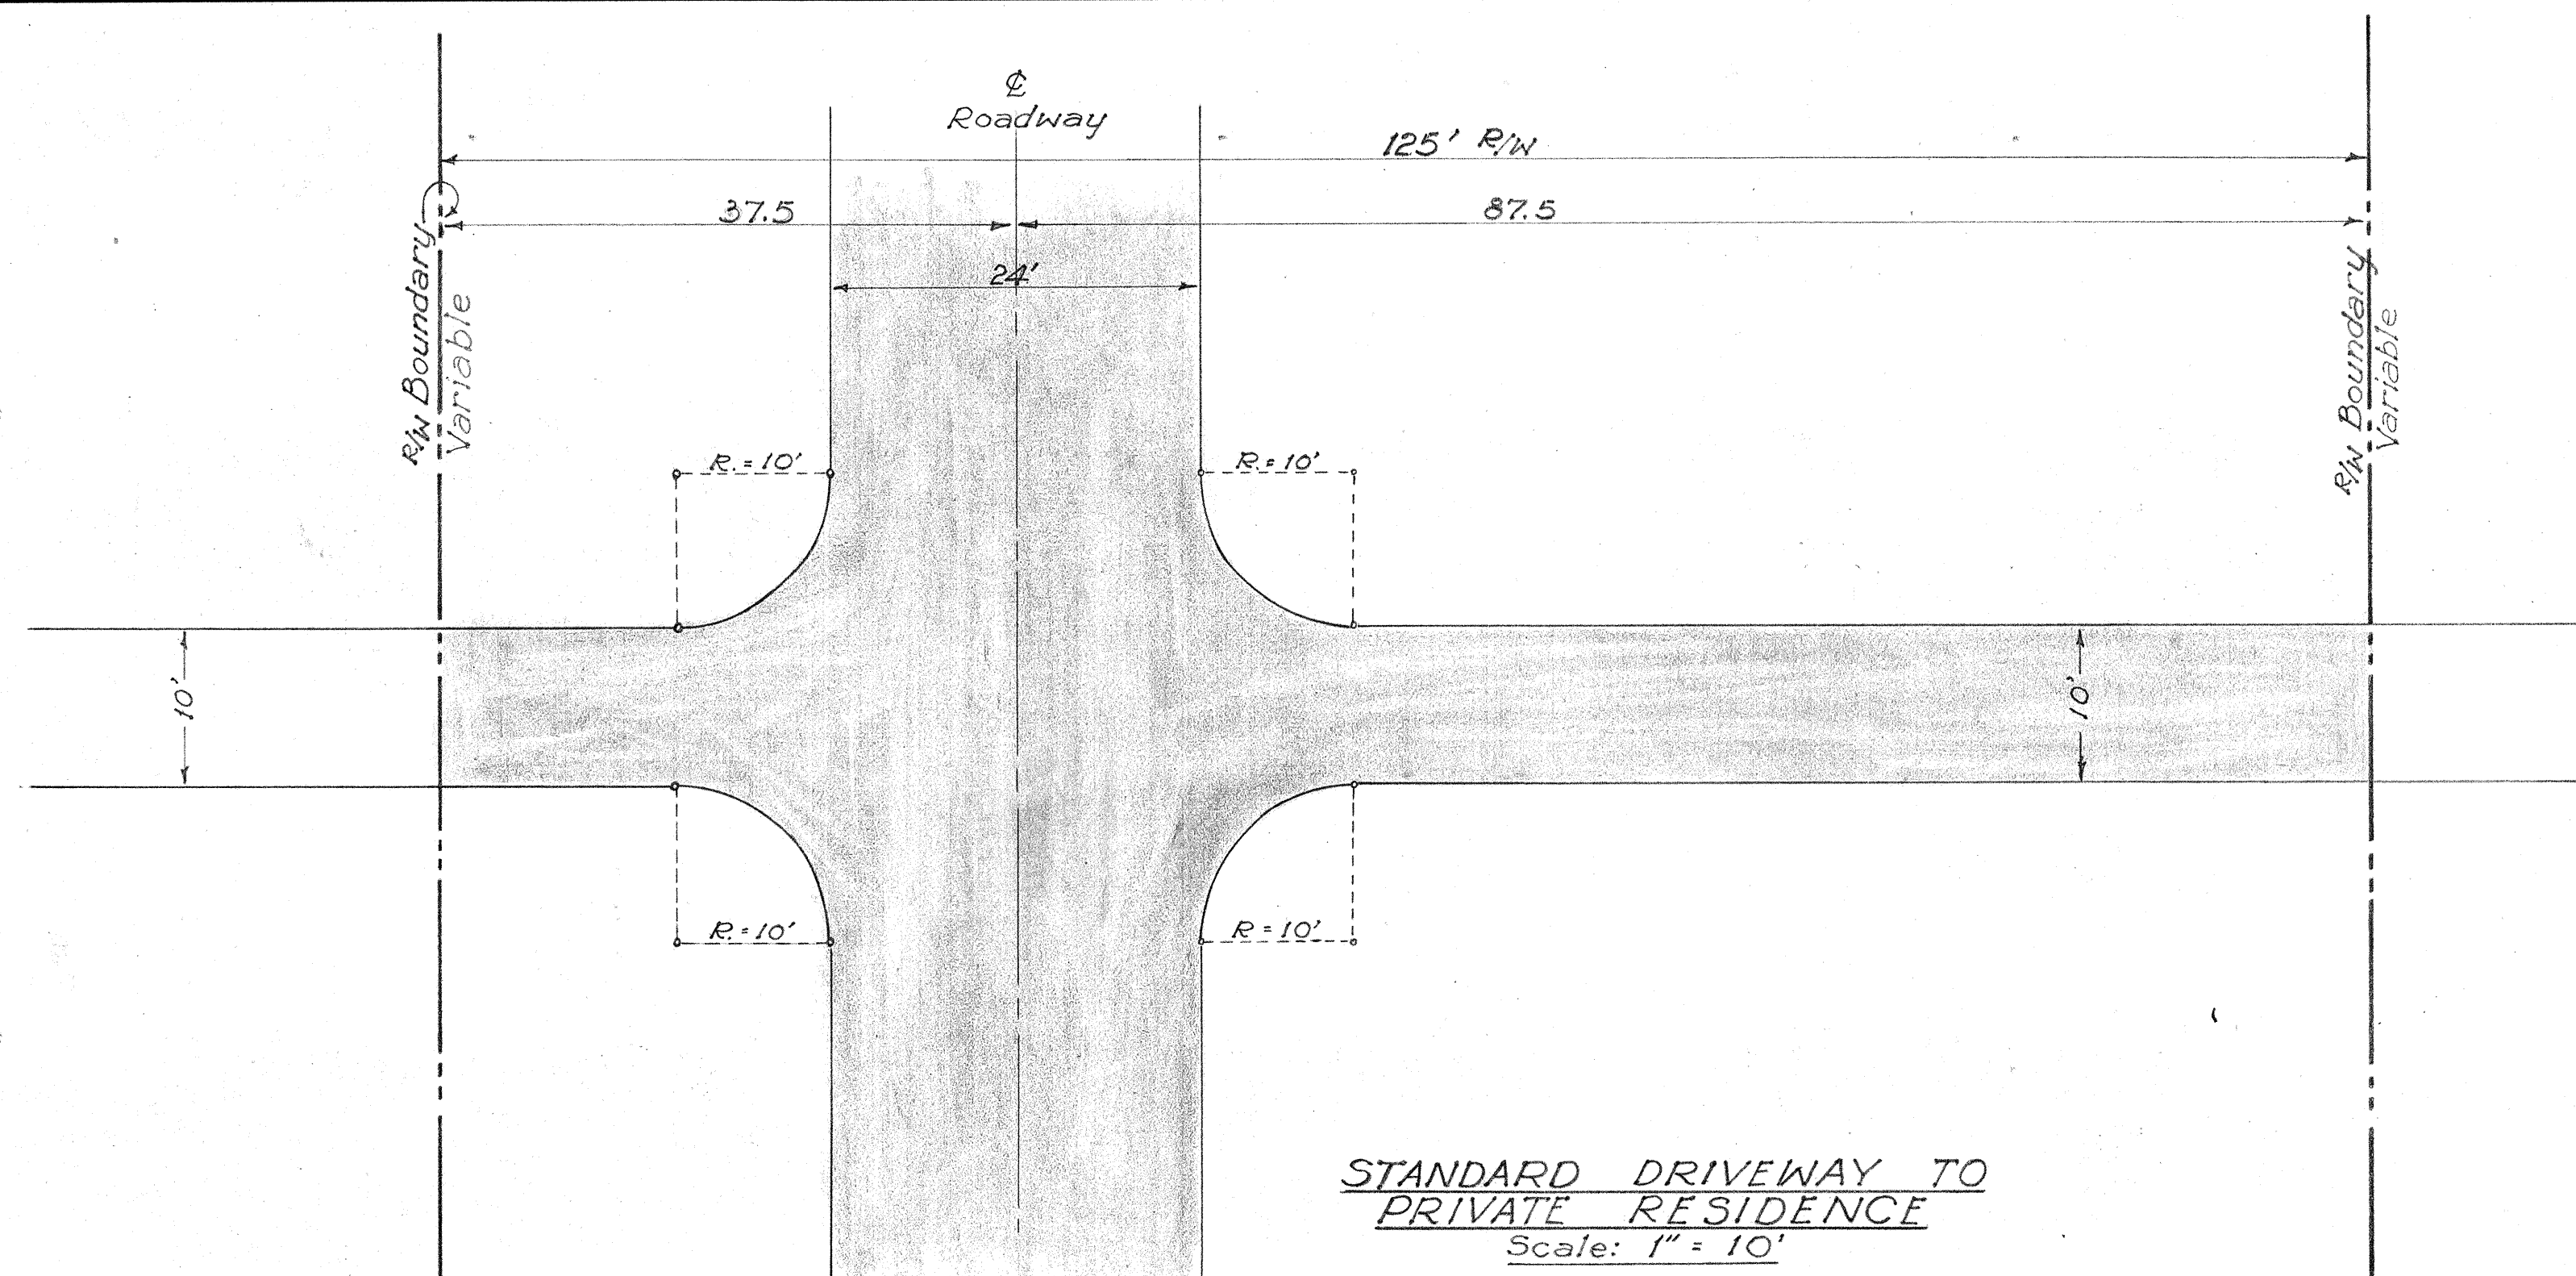

TERRITORIAL HIGHWAY DEPARTMENT
TERRITORY OF HAWAII
DETAIL OF CONNECTIONS
TO SIDEROADS & DRIVEWAYS
WAIAKEA HOMESTEADS
PROJ. NO F 2(3) DEC. 1948
SHEET NO OF SHEETS

5398.3

ORIGINAL PLAN	DATE
DESIGNED BY	
DRAWN BY	
CHECKED BY	
NOTED BY	
QUANTITIES CHECKED BY	
CHECKED BY	
No.	