

INDEX TO DRAWINGS	
SHEET	DESCRIPTION
1	Title Sheet
2	Typical Road Section
3	Detail Of Connections
4-7	Plan & Profile
8-9	Intersection Details
10-15A	Standard Details
16-18	Box Culvert Details
19	Std. Bridge Details
20-25	Bridge Details
26-42	Gross Sections


TERRITORY OF HAWAII
TERRITORIAL HIGHWAY DEPARTMENT
HONOLULU T.H.
PLANS OF
VOLCANO ROAD
FEDERAL AID PROJECT NO. F 2 (3)
DISTRICT OF SOUTH HILO
ISLAND OF HAWAII

CONVENTIONAL SIGNS USED

Centerline	----- 155
Boundary Lines	----- or, -----
Fences (Noted)	-x-x- or, -----
Existing Roadway	-----
Box Culvert	-----
Circular Culvert	-----
Bridge	-----
Railroad	+++++ or, -----
Tree (Large)	----- or, -----
Telephone Pole	----- OTP
Electric Line Pole	----- DEP
Water Main	----- W4-W5
Water Valve	----- XWV
Water Valve Manhole	----- OWMH
Storm Drain Manhole	----- ODMH
Sewer Manhole	----- OSMH
Fire Hydrant	----- OFH
Warning & Regulatory Signs	----- Type
Centerline Monument	----- ©

SCALES

PLAN	HOR.	1 IN. = 100 FT.
PROFILE	VERT.	1 IN. = 100 FT.
GROSS SECTION	HOR.	1 IN. = 10 FT.
	VERT.	1 IN. = 10 FT.

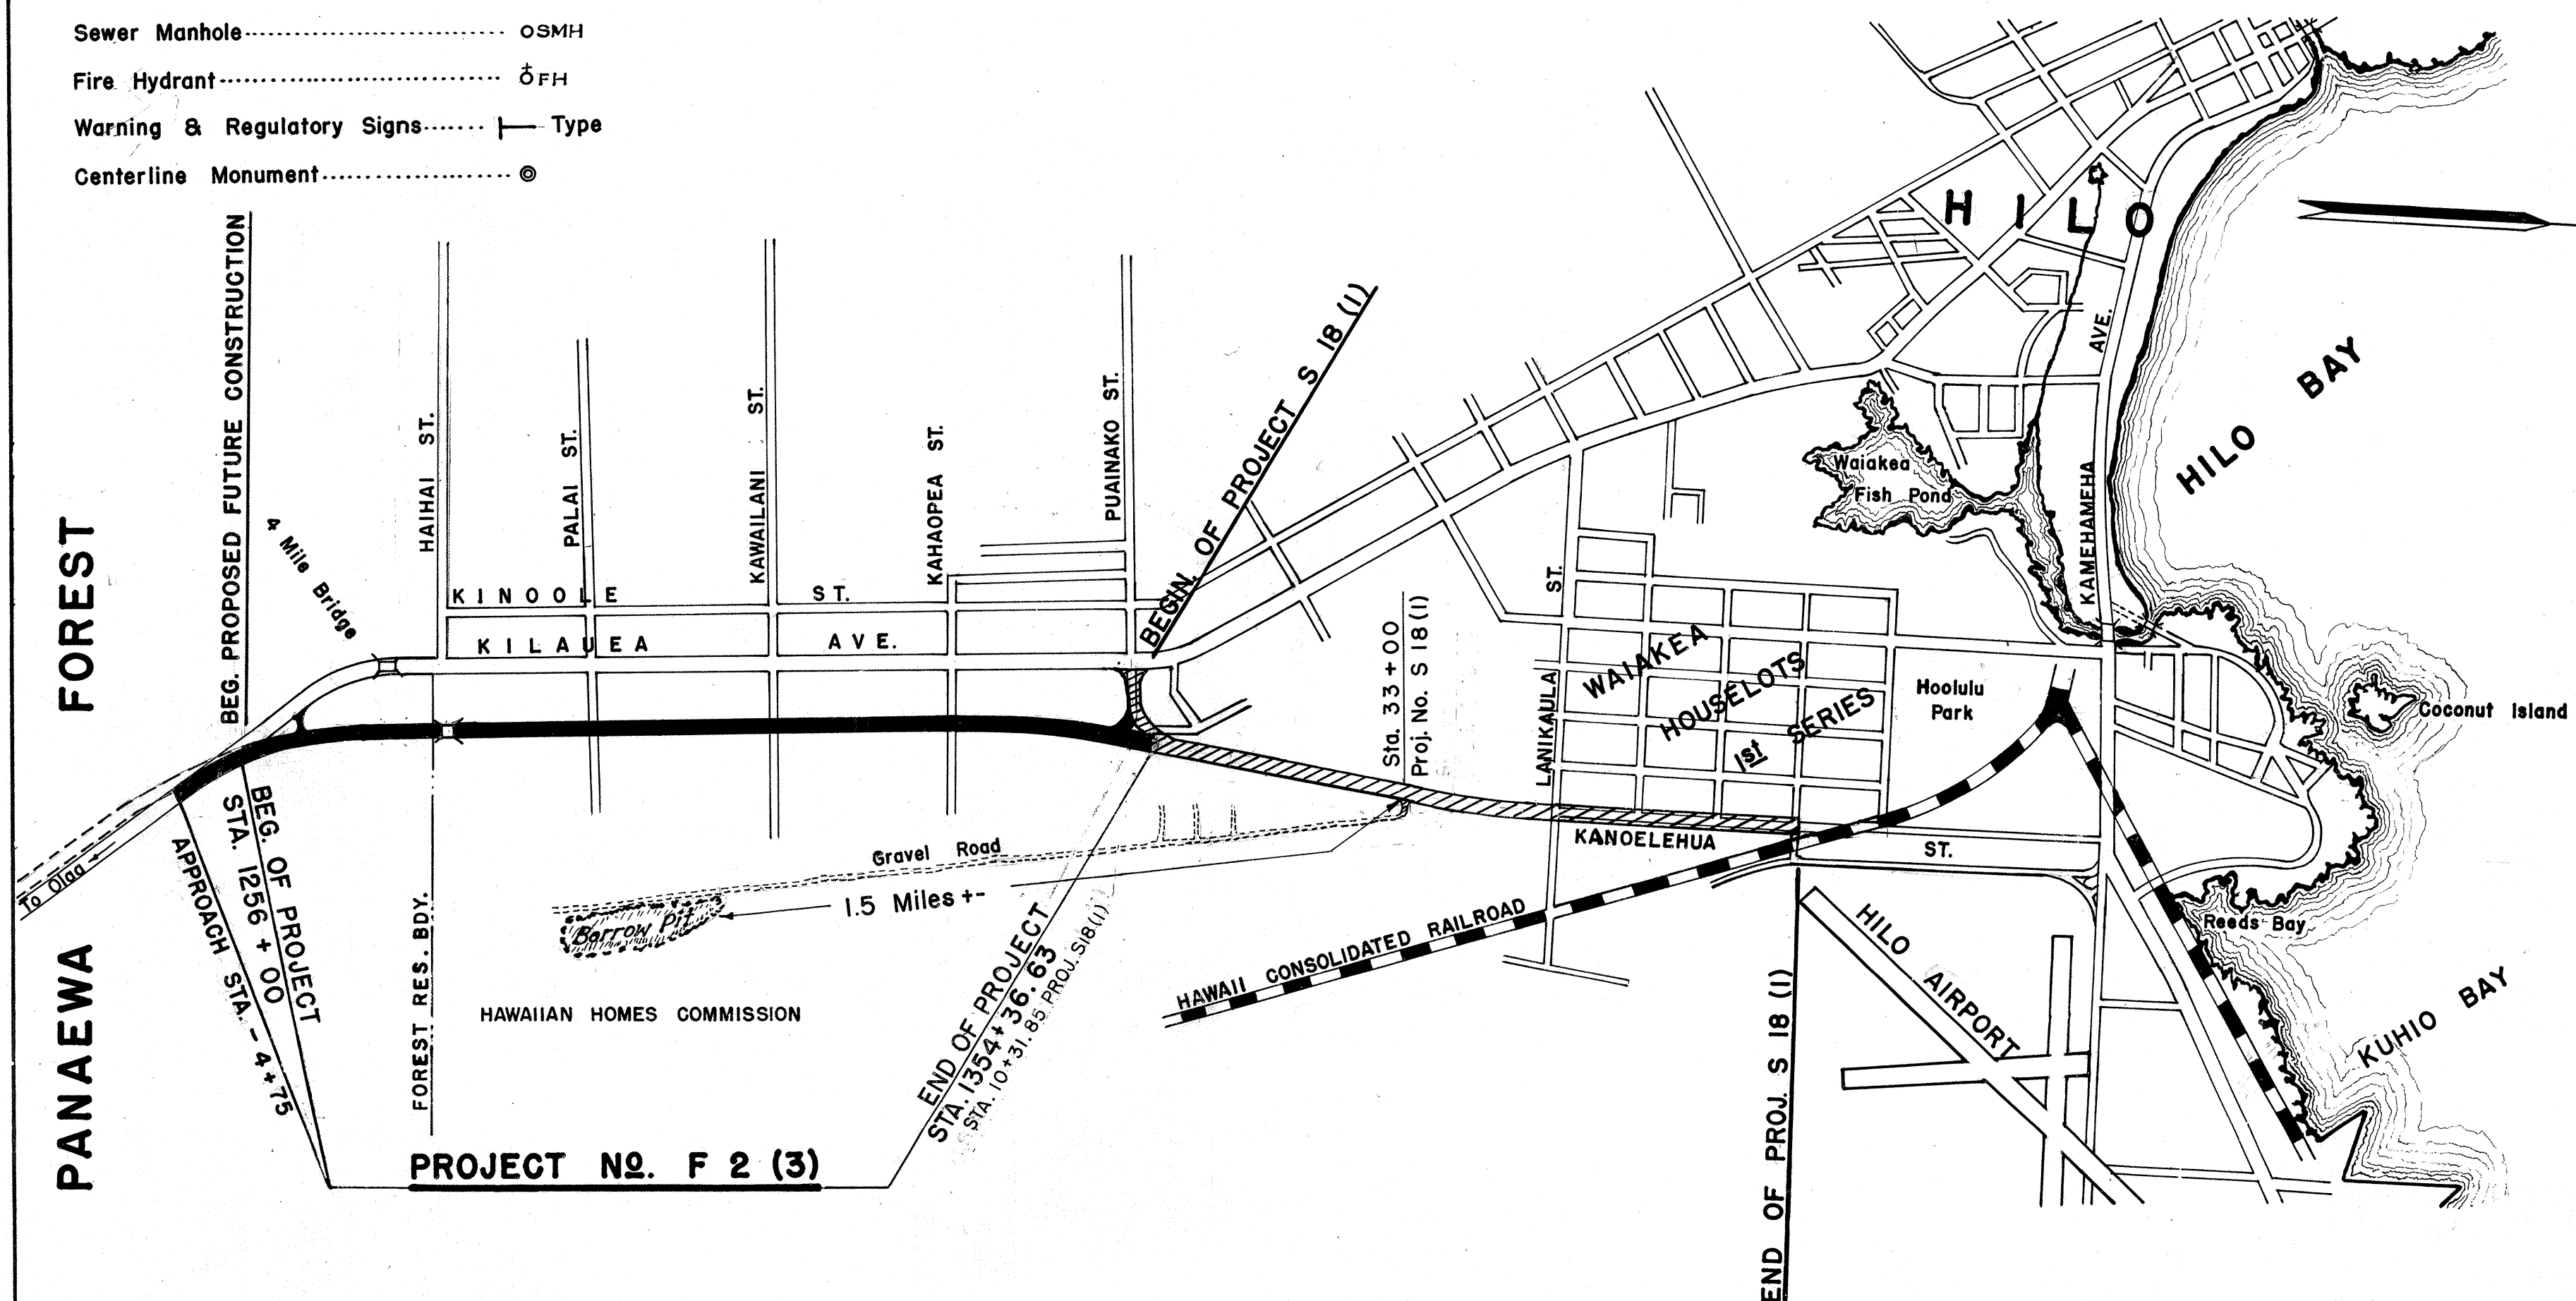

GENERAL LOCATION PLAN

Scale: 1 Inch = 1,760 Feet
Gross Length of Project 1.863 Miles.
Bridge: 0.020 Miles.
Net Length of Project 1.843 Miles.

NOTE:

ALL CHANGES MADE DURING CONSTRUCTION
HAVE BEEN NOTED IN RED ON THESE
TRACINGS AND CHECKED BY:

Eskansa
DISTRICT ENGINEER
3/21/51
DATE

APPROVED: *[Signature]* DATE: 8-25-49
TERRITORIAL HIGHWAY ENGINEER

RECOMMENDED FOR APPROVAL: DATE: _____
DISTRICT ENGINEER
PUBLIC ROADS ADMINISTRATION
FEDERAL WORKS AGENCY
APPROVED: _____ DATE: _____
DIVISION ENGINEER
PUBLIC ROADS ADMINISTRATION
FEDERAL WORKS AGENCY