

7-11-50

1432.0

A-


"

$$\begin{array}{r} 50' 5 \\ \hline 80' 14 \end{array}$$

153

25/50

276

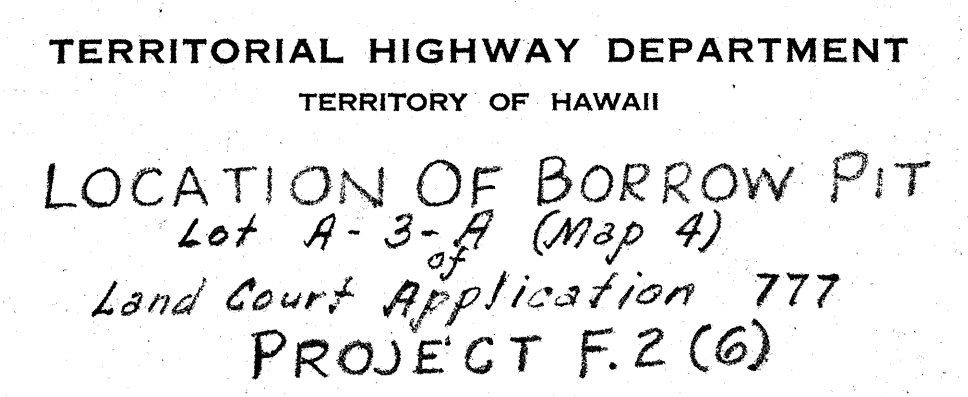

SHEET No. OF SHEETS

54763

P. H. 276