
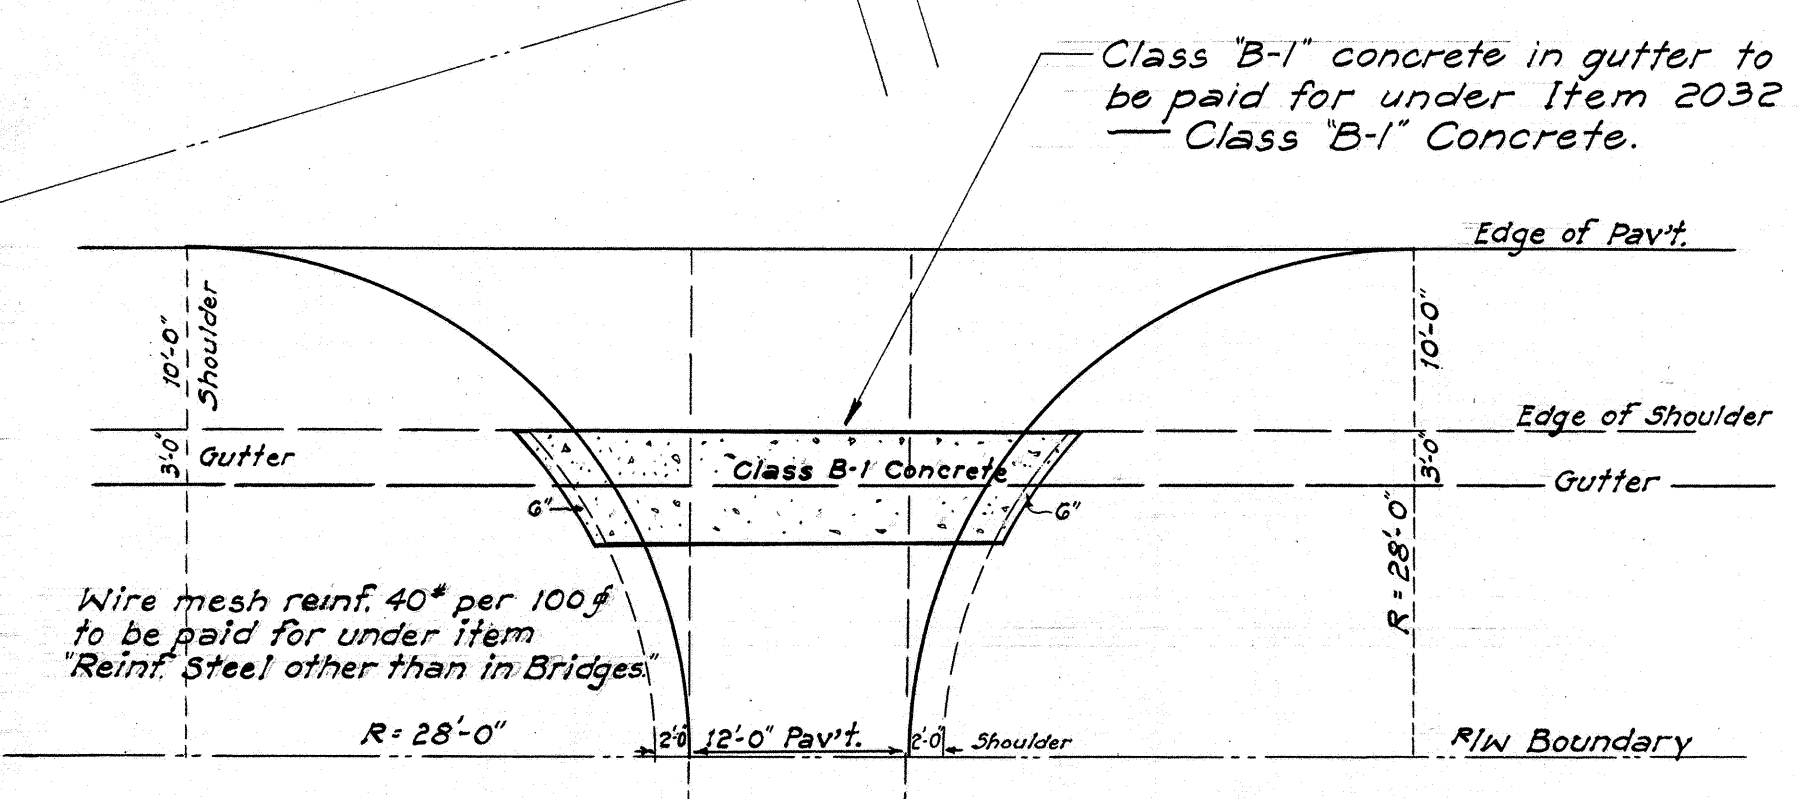


PLAN
SHEET NO. 4 OF 4
NOTE: ROAD ALIGNMENT CHANGED BY ORDER OF HON. CHIEF OF HIGHWAYS


PROFILE
SHEET NO. 5 OF 5
NOTE: ROAD CHANGES CHANGED BY ORDER OF HON. CHIEF OF HIGHWAYS

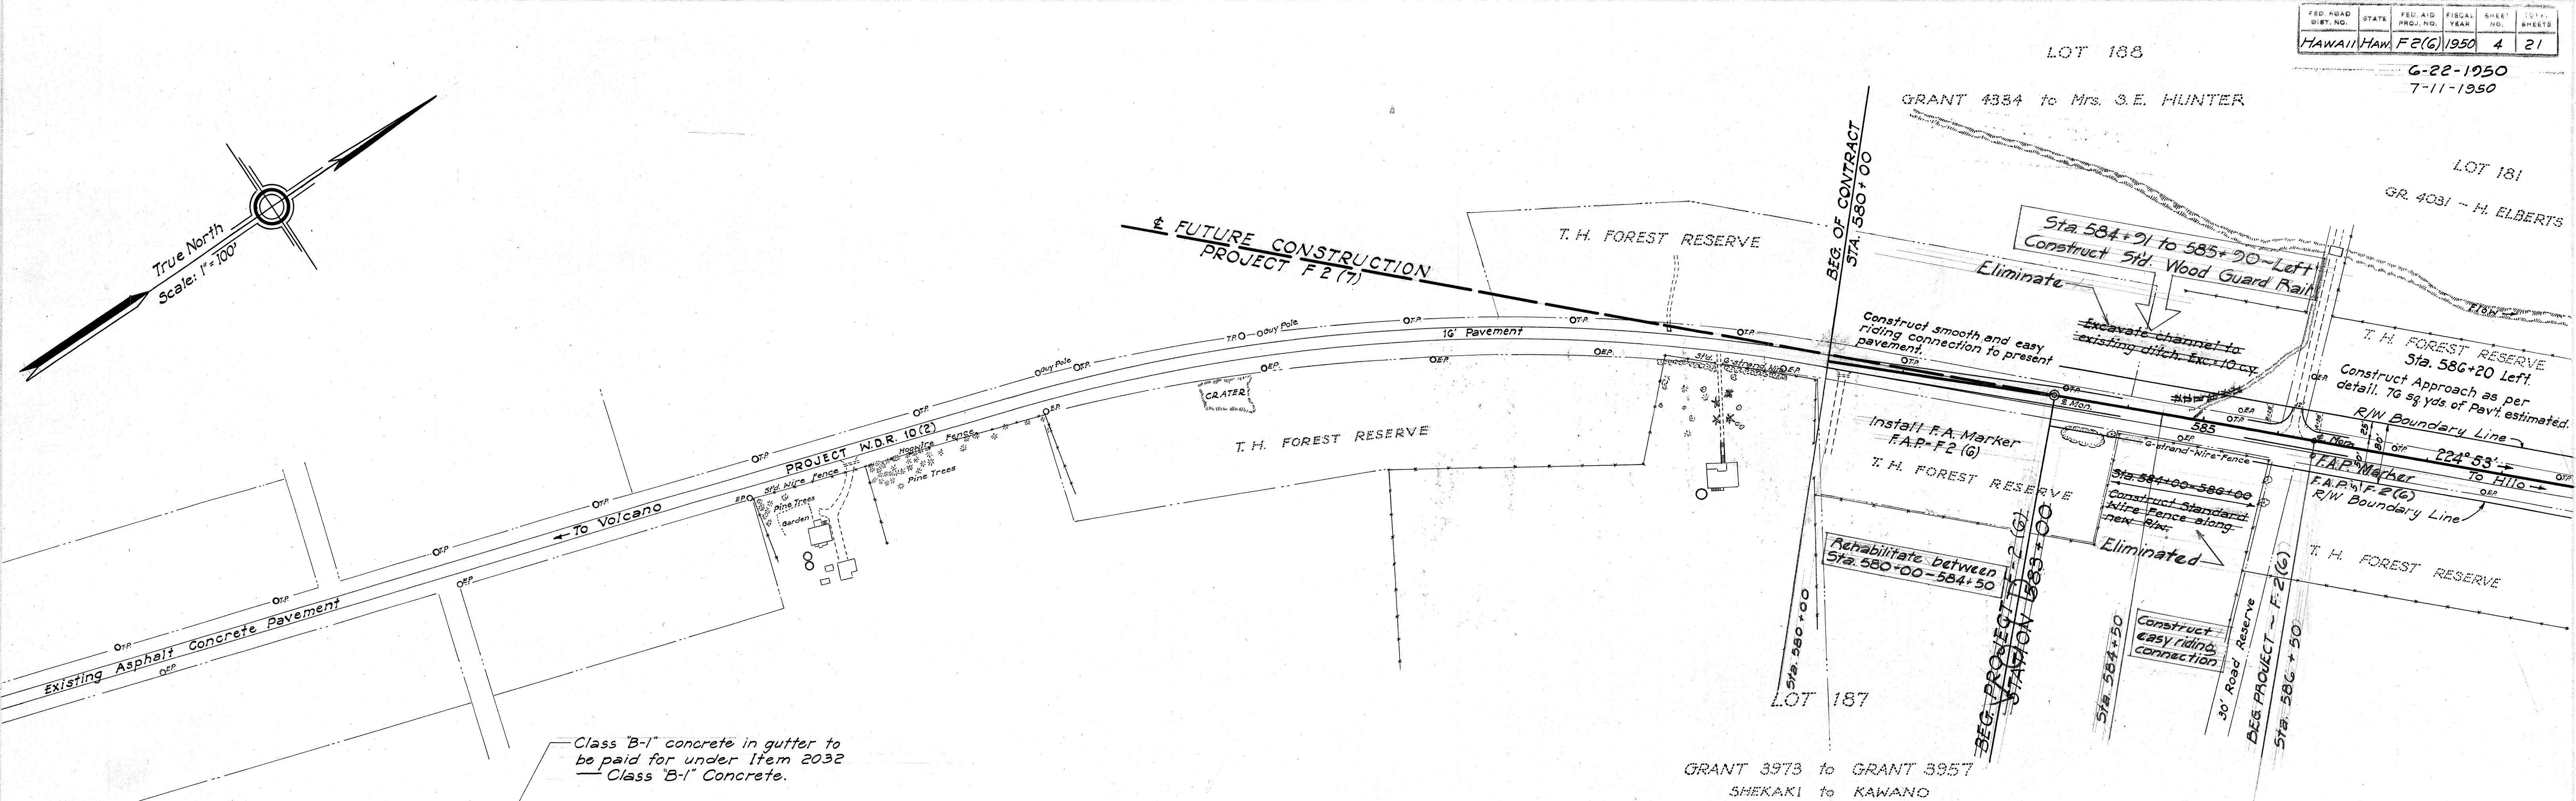


PLAN VIEW
Scale: 3/32" = 1'-0"

DETAIL OF CONCRETE PAVED GUTTER

SCALE: AS NOTED

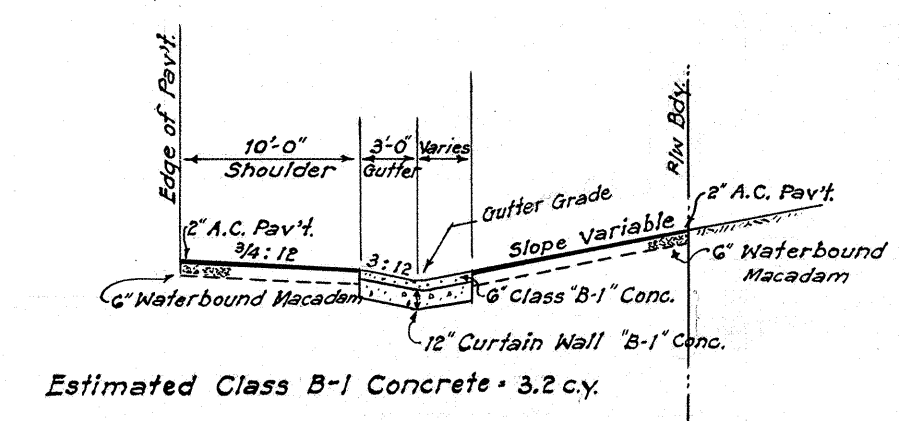


SECTION VIEW
Scale: 3/32" = 1'-0"

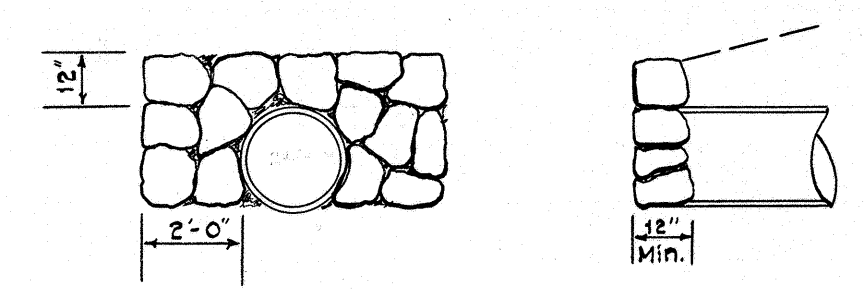


DETAIL OF DRY RUBBLE MASONRY HEADWALL

SCALE: 1/4" = 1'-0"

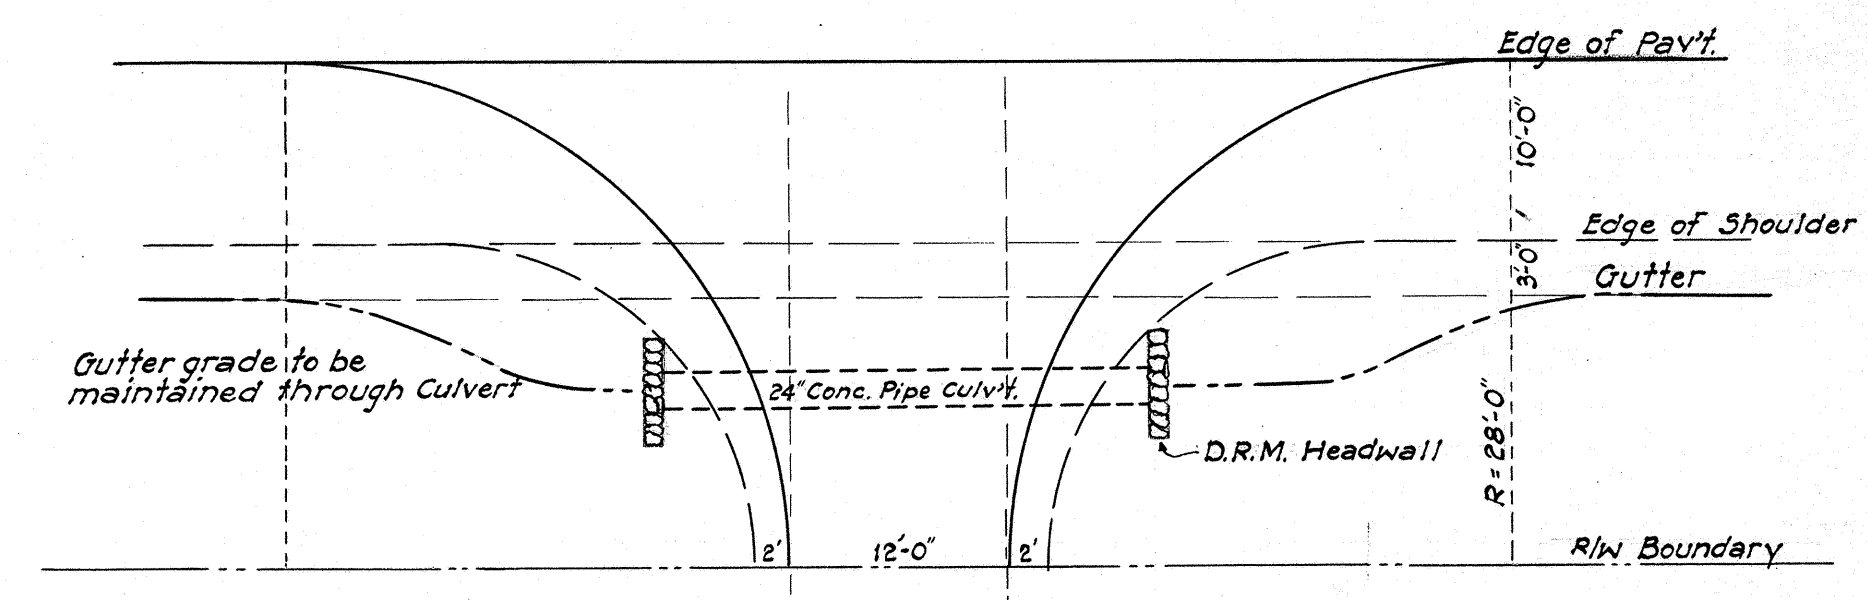

PLAN VIEW
Scale: 3/32" = 1'-0"

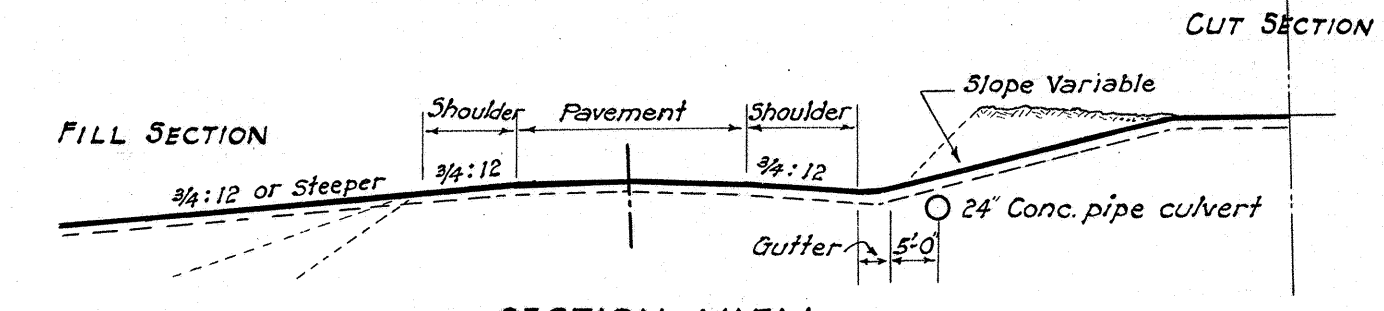


SECTION VIEW
Not to Scale

DETAIL SHOWING CULVERT LOCATION FOR SIDE ROAD

SCALE: AS NOTED

OVERHAUL SUMMARY						
From Station	To Station	Overhaul Distance	Fine Material	Select Material	C.Y. Overhaul	Station Mile
651+40	663+00	1160			1605	2568
663+00	663+25	2445			2170	1085.0
663+25	664+20	3820			2000	1400.0
664+20	665+20	4705			1230	1107.0
665+20	605+50	8210	1146	19,817	20,963	33540.8
605+50	607+00	7010	150		150	206.7
607+00	626+00	5794	968	14,831	15,799	17,378.9
626+00	633+50	7050	775		775	1,007.5
633+50	644+50	7984	560	7,523	8,083	12,124.5
644+50	651+00	8850	645		645	1,096.5
651+00	652+50	9250	76	771	847	1,524.6
652+50	653+00	9350	26		26	46.8
653+00	655+00	9484	102	1,275	1,377	2,478.6
655+00	659+00	9784	375		375	712.5
659+00	667+00	10,884	150		150	333.9
TOTALS			4991	44,217	56,213	2,568,74,043.3

NOTE: Cinder Borrow Pit 1.3 mi. NW of Sta. 617+80 (GOG4' ±)

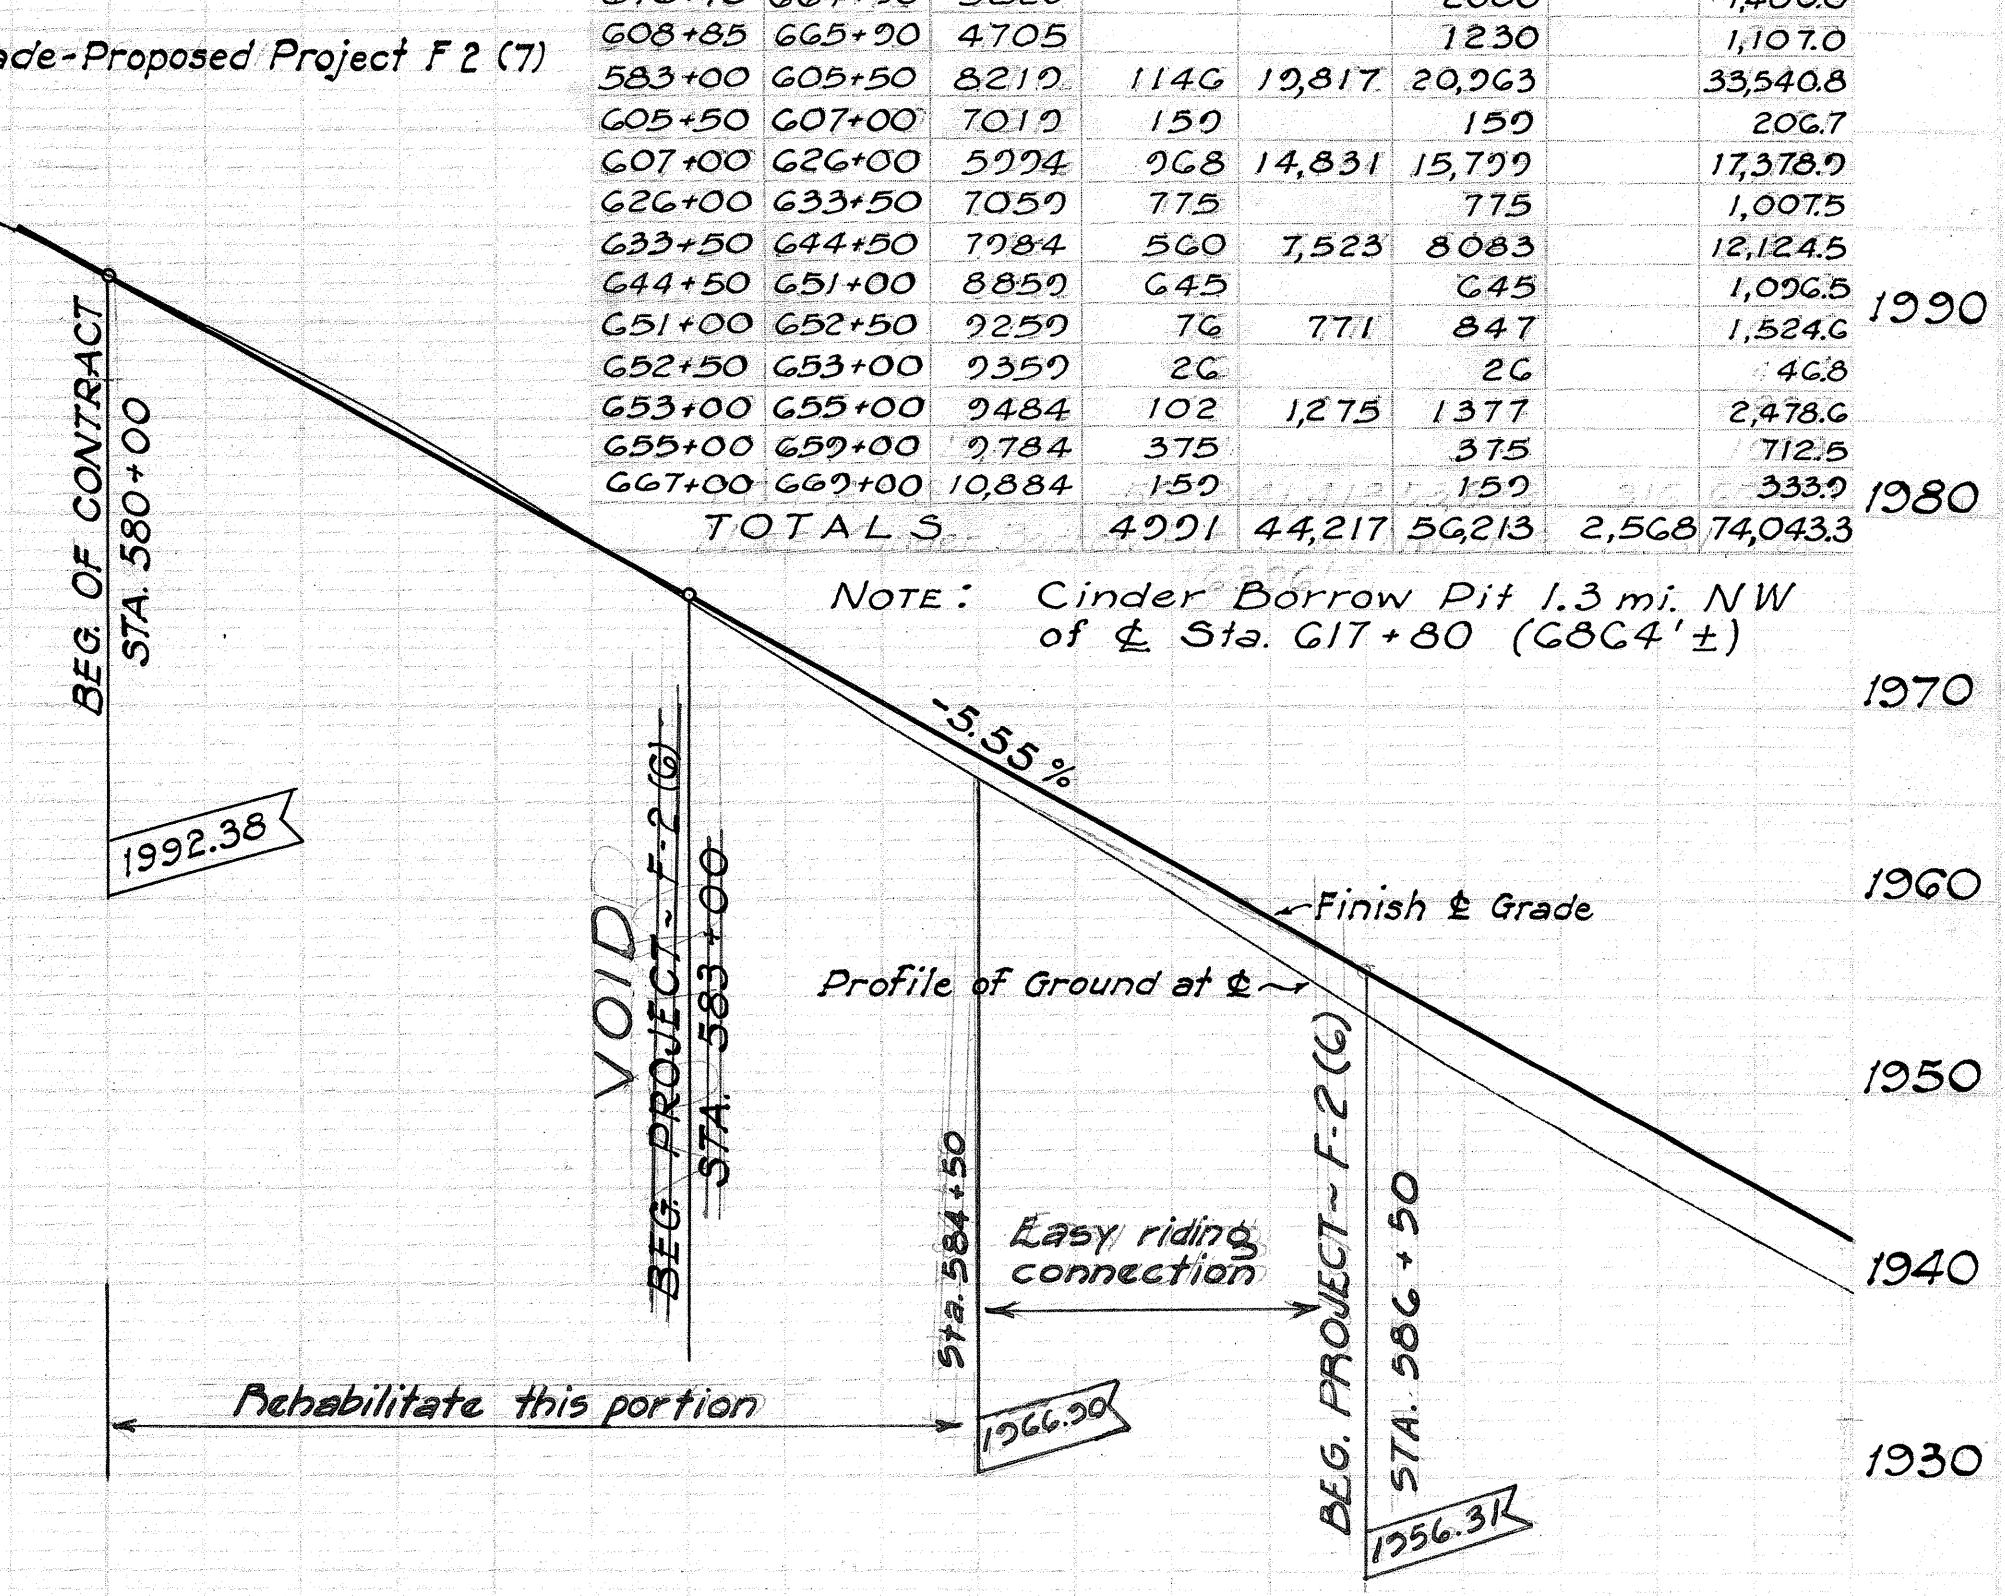

5476.4

6-22-1950
7-11-1950

APPROACHES


STATION	PAV'T. AREA	EXCAVATION	B-1 CONCRETE FOR PAVED GUTTER
586+20 Left	76 #		
591+67 Right	76 #	2 cu. yds.	
594+72 Left	76 #		
602+50 Left	76 #	3 cu. yds.	3.2 cu. yds.
605+19 Left	76 #	3 cu. yds.	
606+67 Right	76 #	18 cu. yds.	
608+17 Right	76 #	29 cu. yds.	
594+12 Right	76 #	4 cu. yds.	

B.M. 1910.64
x Marked on concrete, 75.15 ft. left of Sta. 594+50.


LOT 181
GRANT 4031 to H. ELBERTS

GRANT 4363 to H. G. JUNKIN

LOT 166
GRANT 3976 to J. E. STAPLES

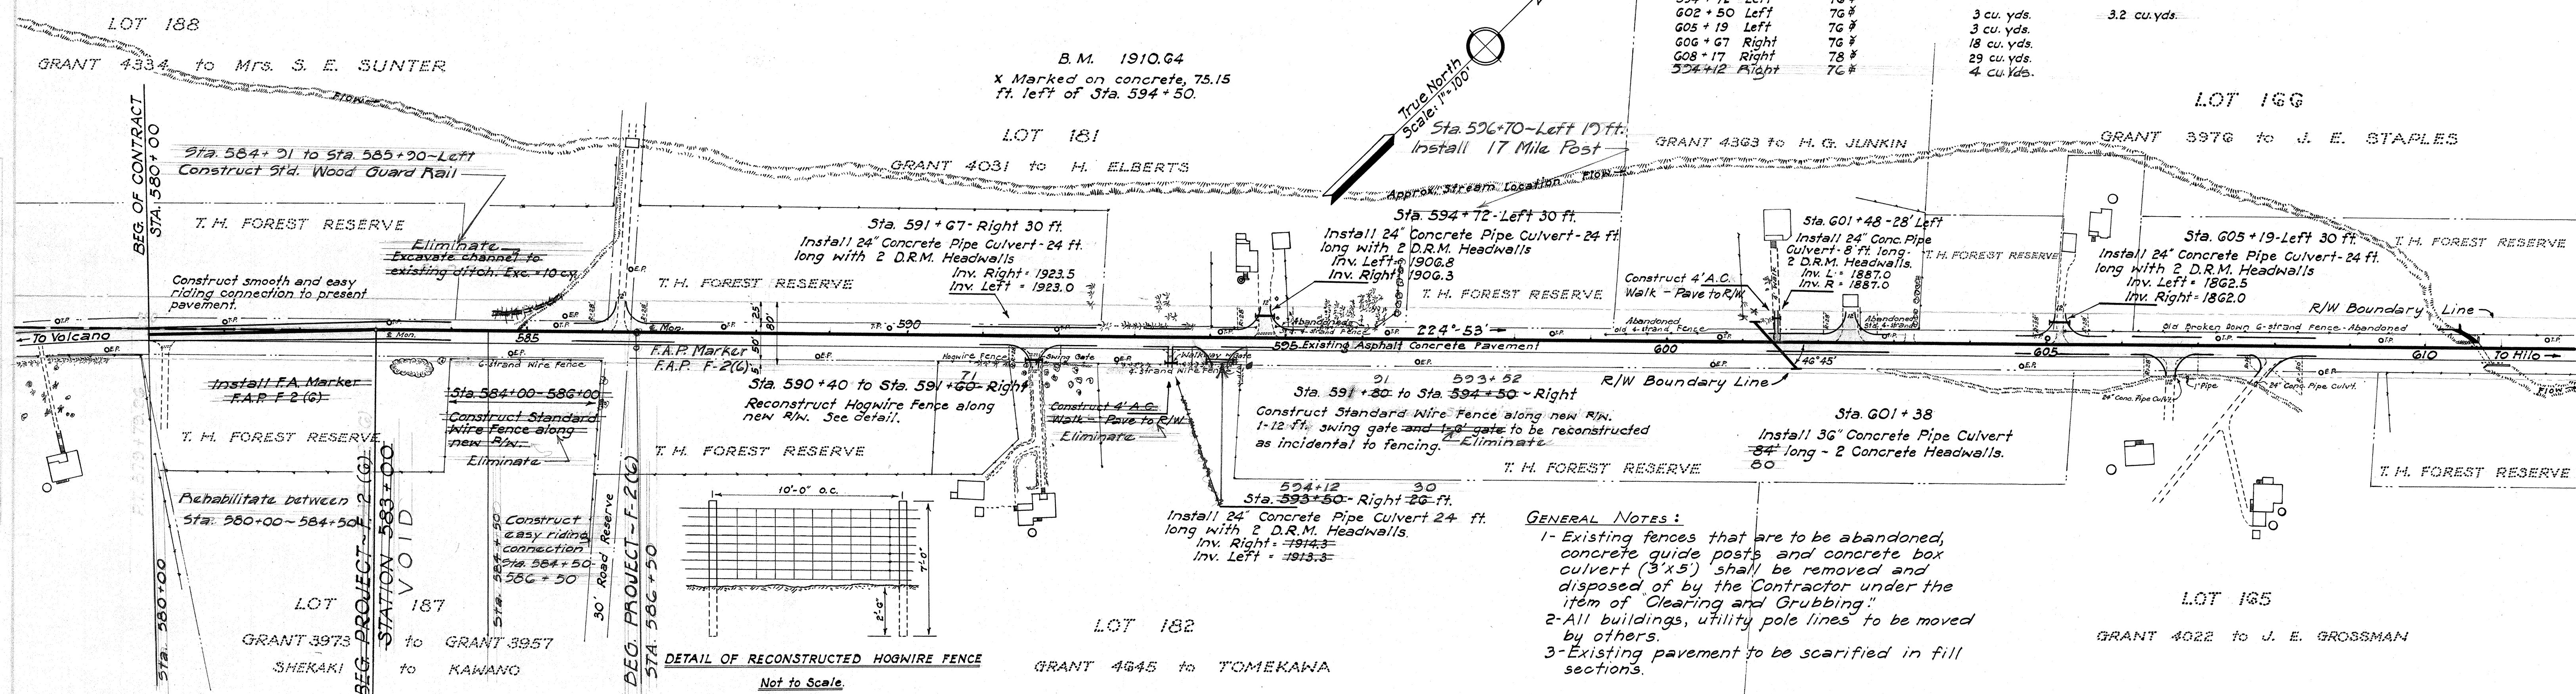


- GENERAL NOTES:**
- Existing fences that are to be abandoned, concrete guide posts and concrete box culvert (3'x5') shall be removed and disposed of by the Contractor under the item of "Clearing and Grubbing".
 - All buildings, utility pole lines to be moved by others.
 - Existing pavement to be scarified in fill sections.

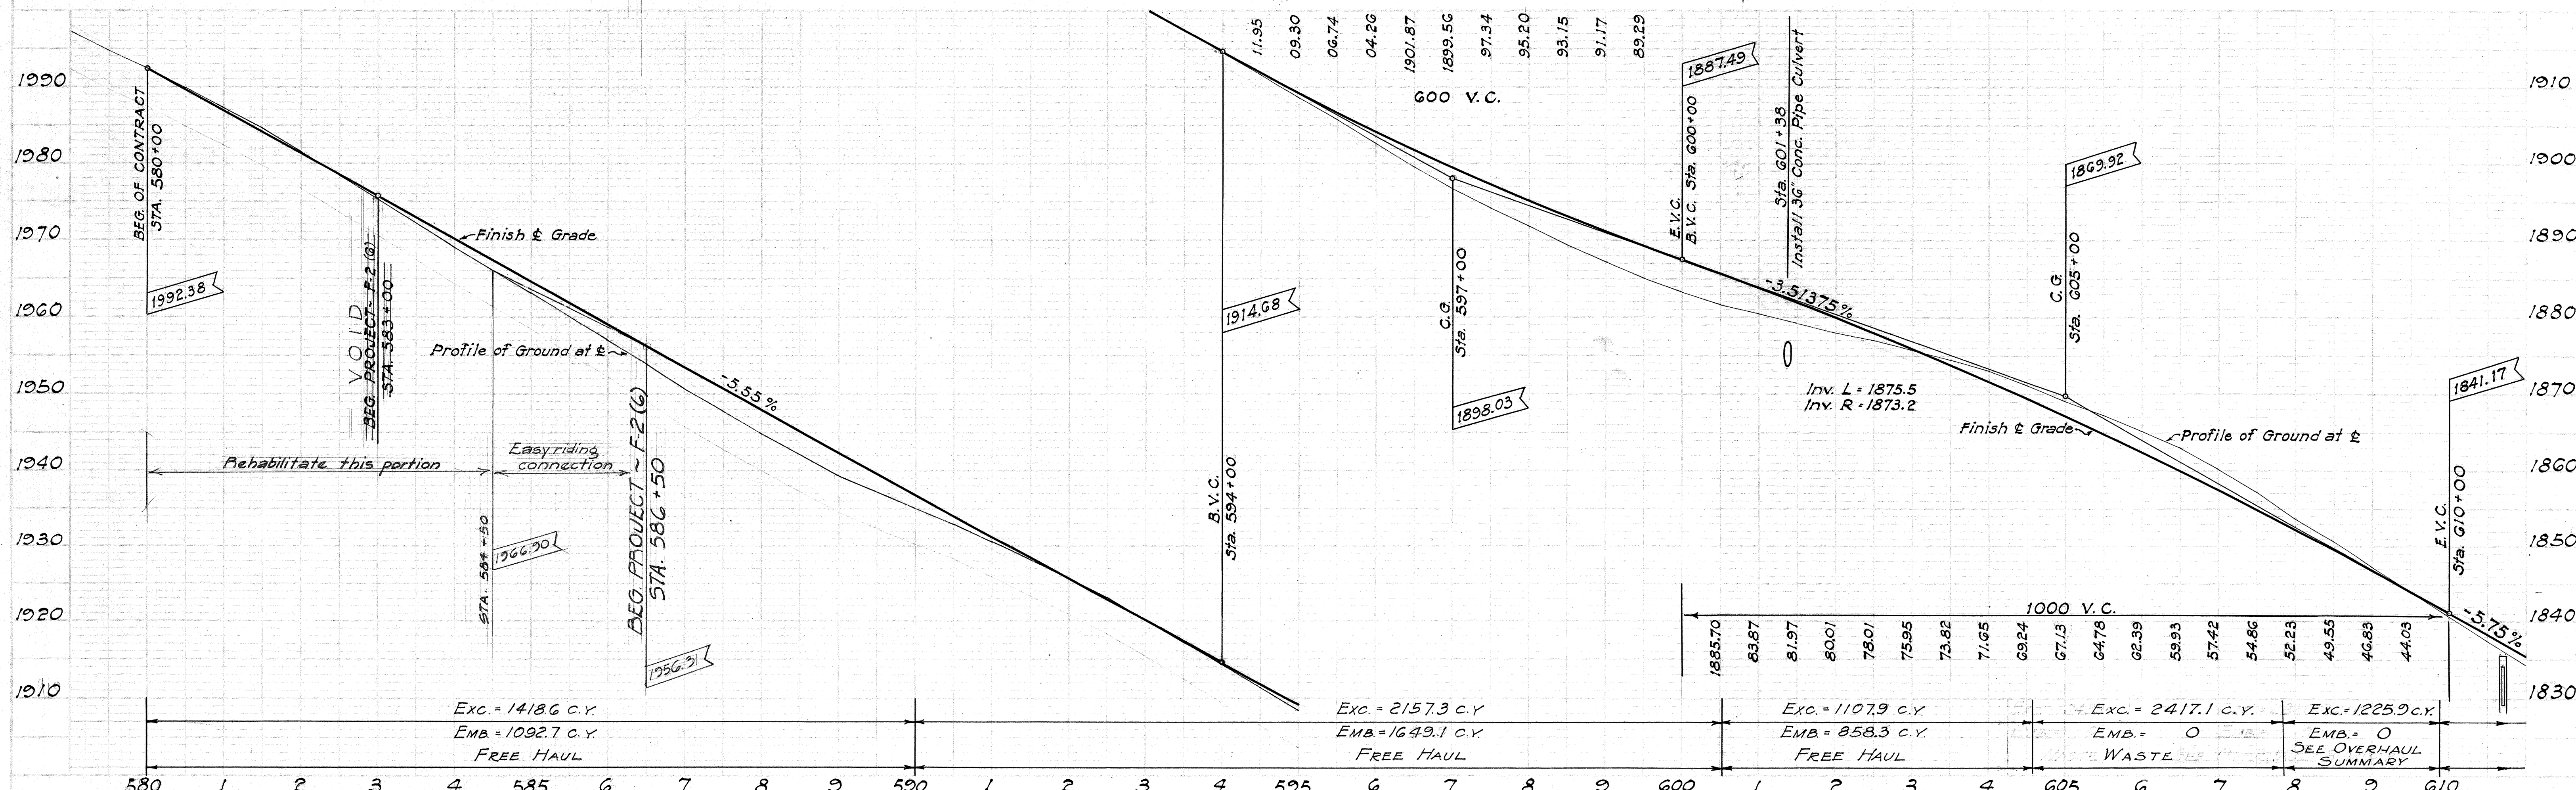

5476.5

PLAN
 DATE
 DRAWN BY
 CHECKED BY
 IN CHARGE
 SCALE

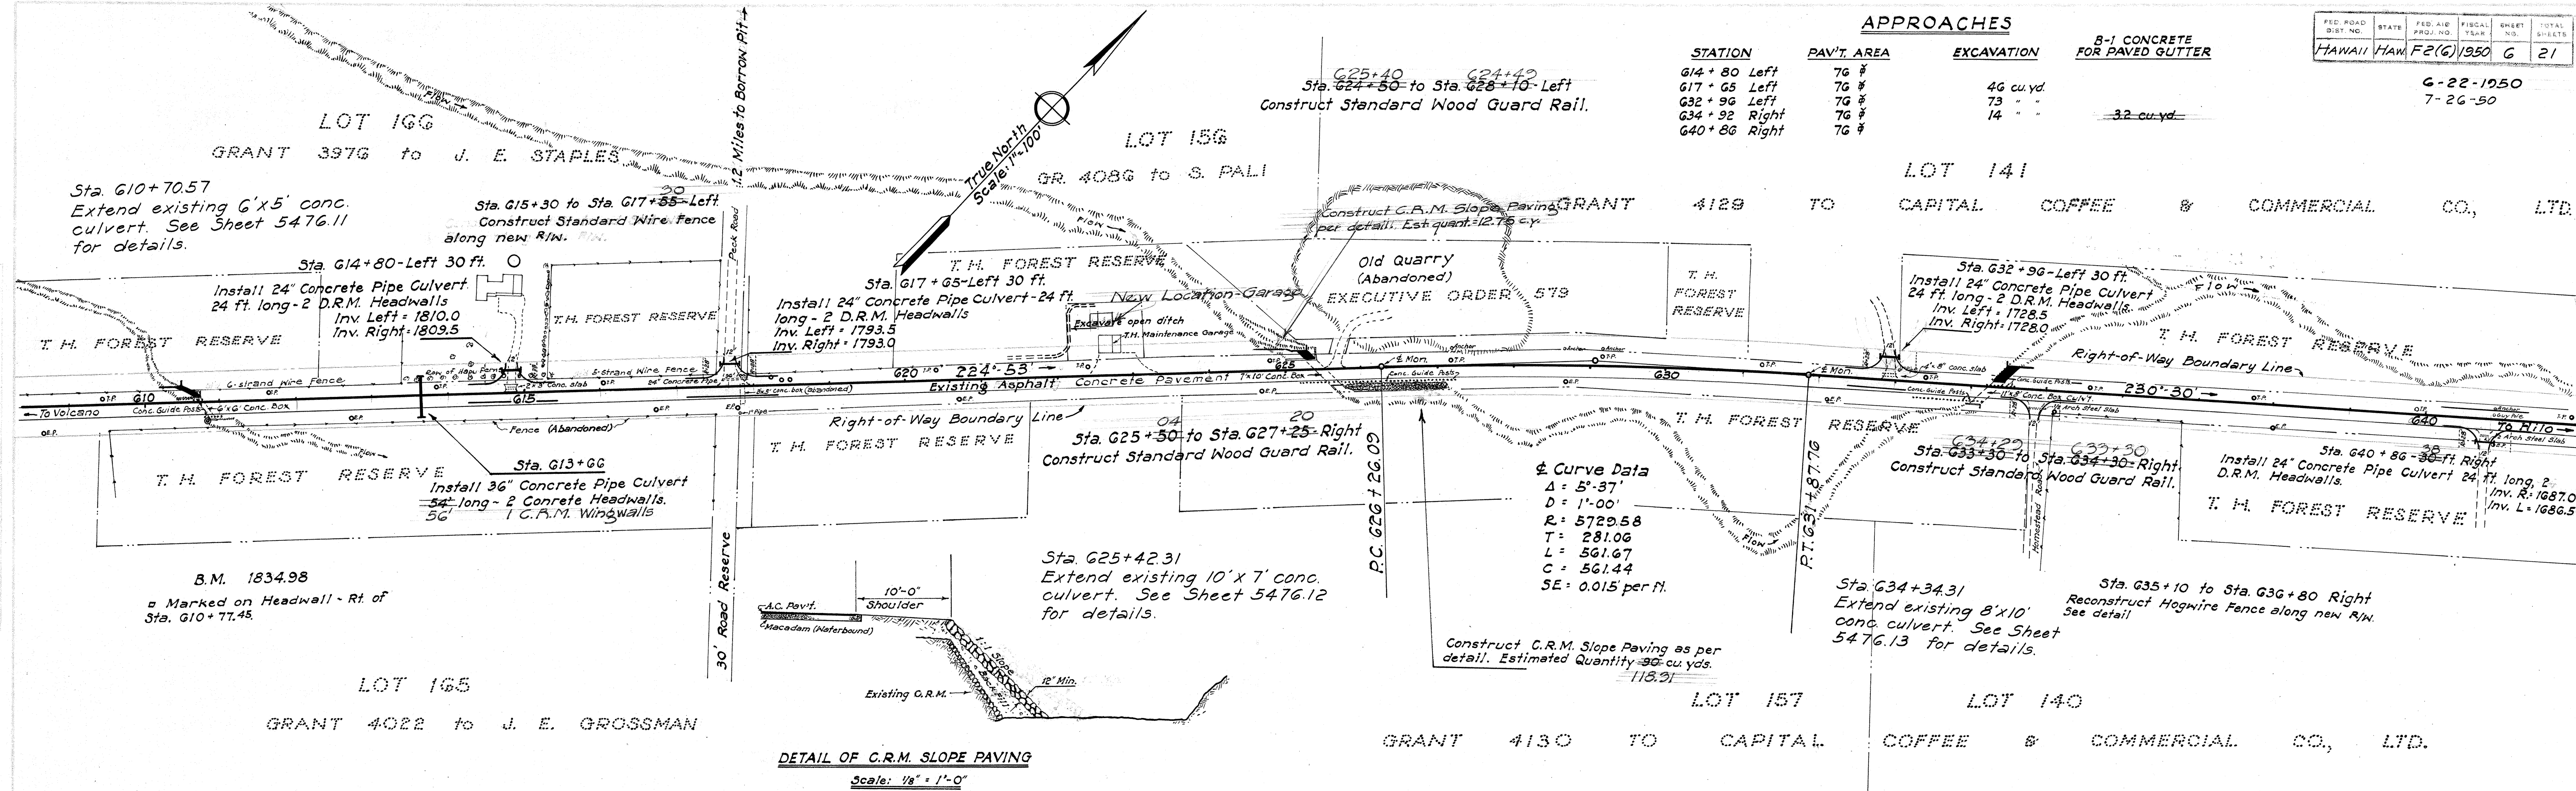

APPROACHES

STATION	PAV'T. AREA	EXCAVATION	8-1 CONCRETE FOR PAVED GUTTER
614 + 80 Left	76 %		
617 + 55 Left	76 %	46 cu. yd.	
632 + 96 Left	76 %	73 "	
634 + 92 Right	76 %	14 "	32 cu. yd.
640 + 86 Right	76 %		


LOT 166
 GRANT 3976 to J. E. STAPLES

LOT 156
 GR. 4086 to S. PALI

LOT 141
 GRANT 4129 TO CAPITAL COFFEE & COMMERCIAL CO., LTD.

LOT 157
 GRANT 4130 TO CAPITAL COFFEE & COMMERCIAL CO., LTD.

LOT 140
 GRANT 4130 TO CAPITAL COFFEE & COMMERCIAL CO., LTD.

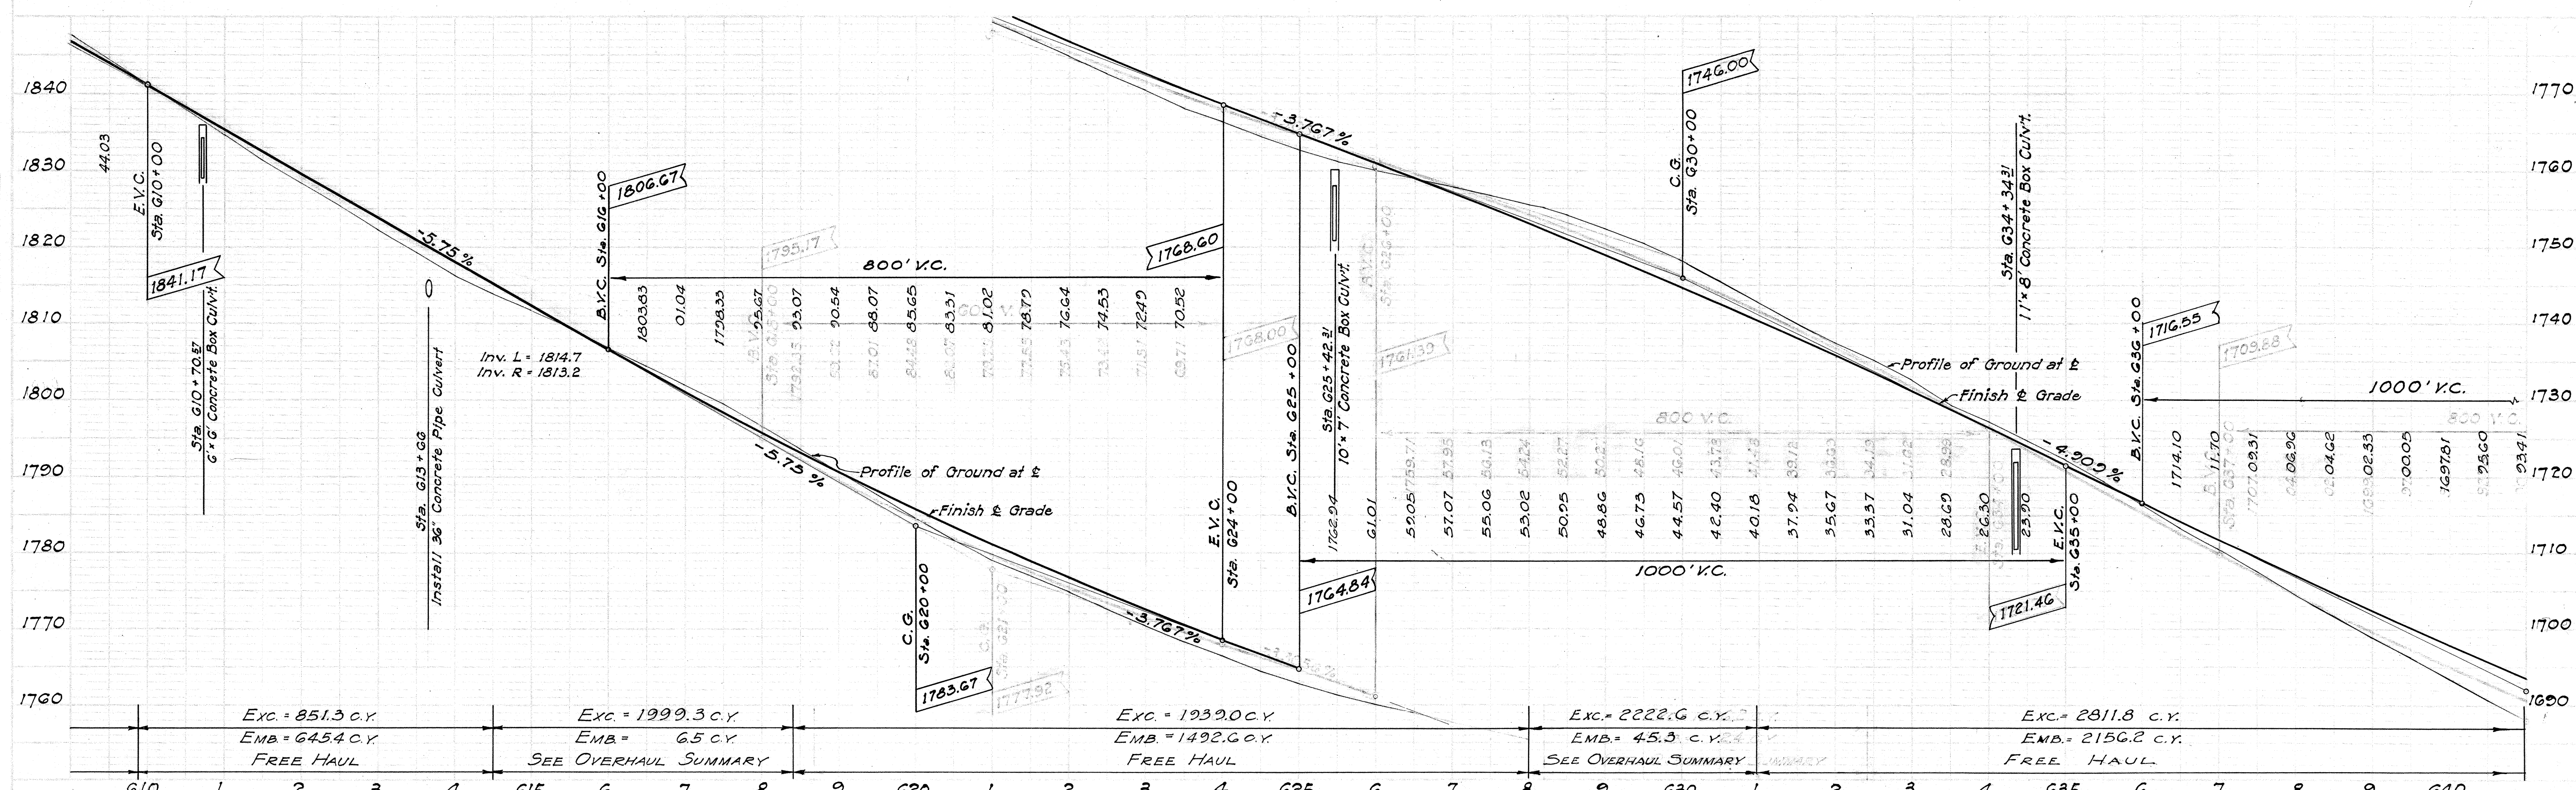

5476.6

6-22-1950

Sta. 642+46.77
Extend existing 10'x9'
conc. culvert. See Sheet
5476.14 for details.

GRANT 4129

C O F F E E

GRANT 4128

GRANT 4128

170.



GRANT 4130 TO CAPITAL COFFEE & COMMERCIAL CO., LTD.

