
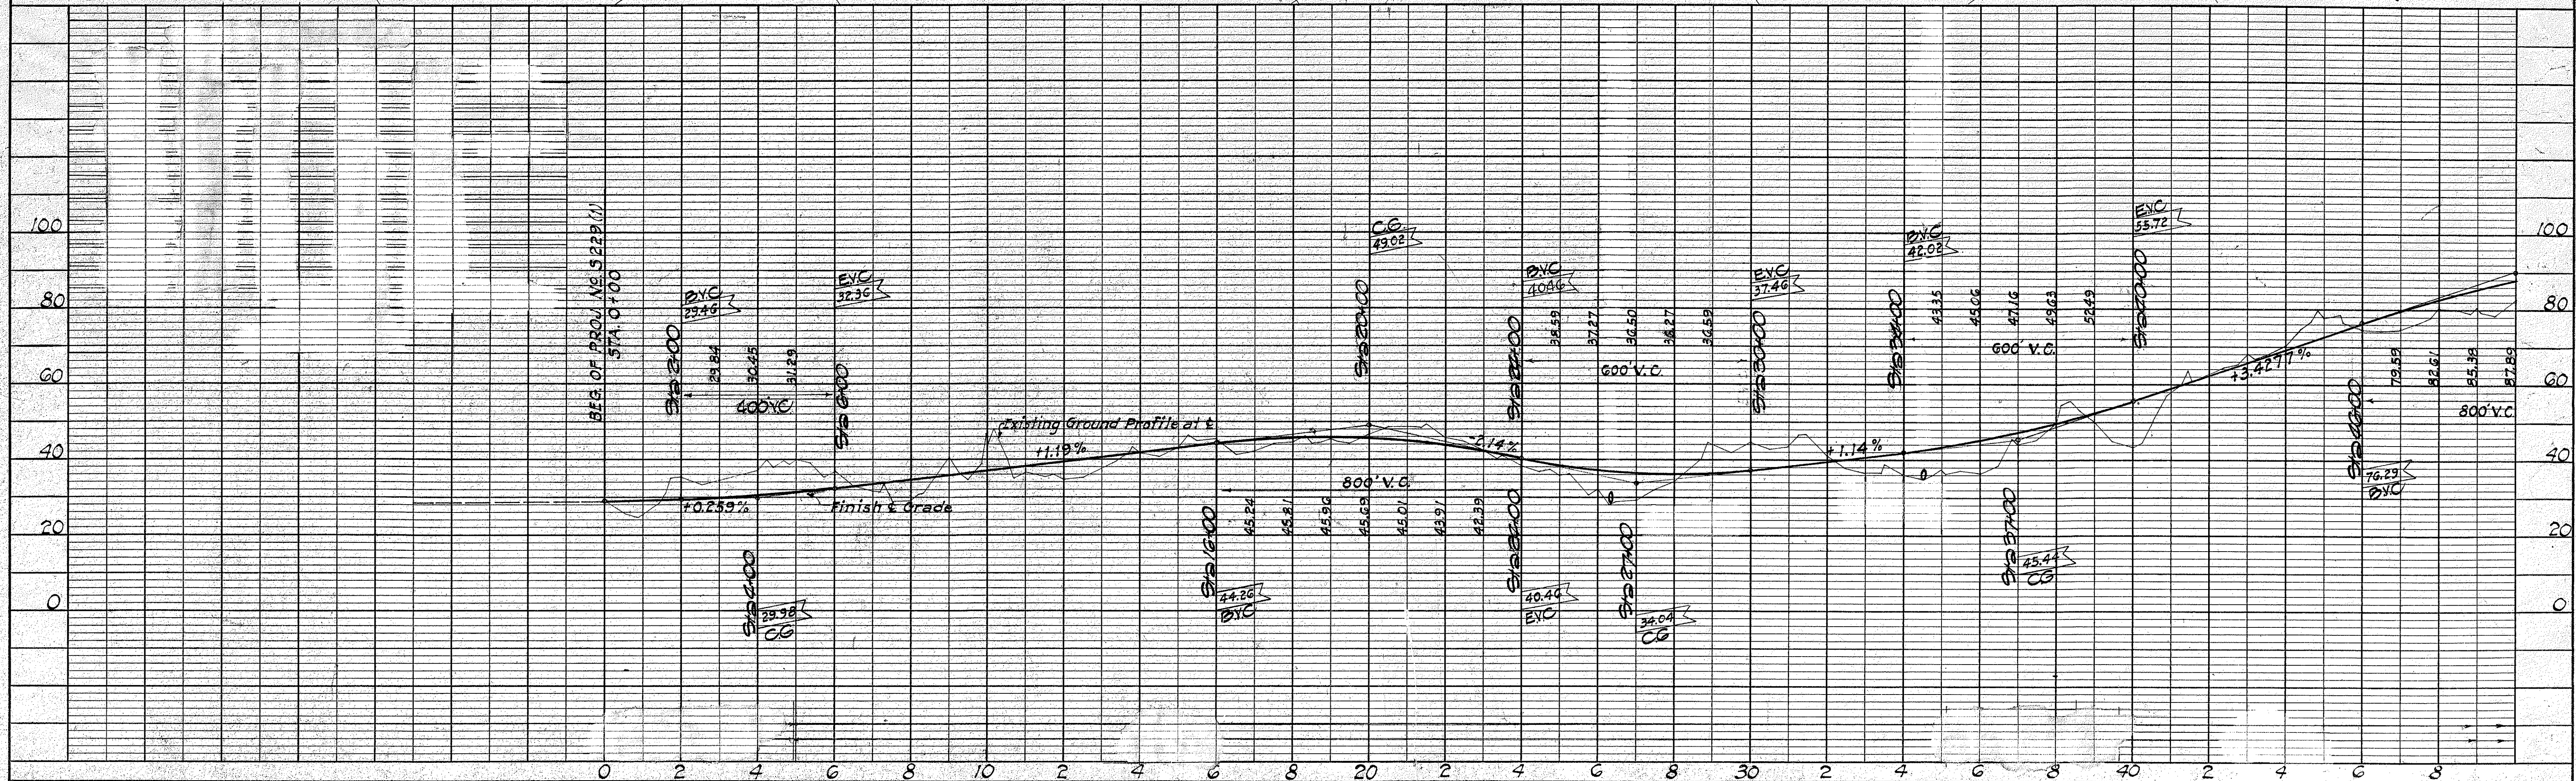


PLAN	DATE	BY
SURVEYED		
PLOTTED		
NOTED		
NO.		

PROFILE	DATE	BY
SURVEYED		
PLOTTED		
NOTED		
NO.		

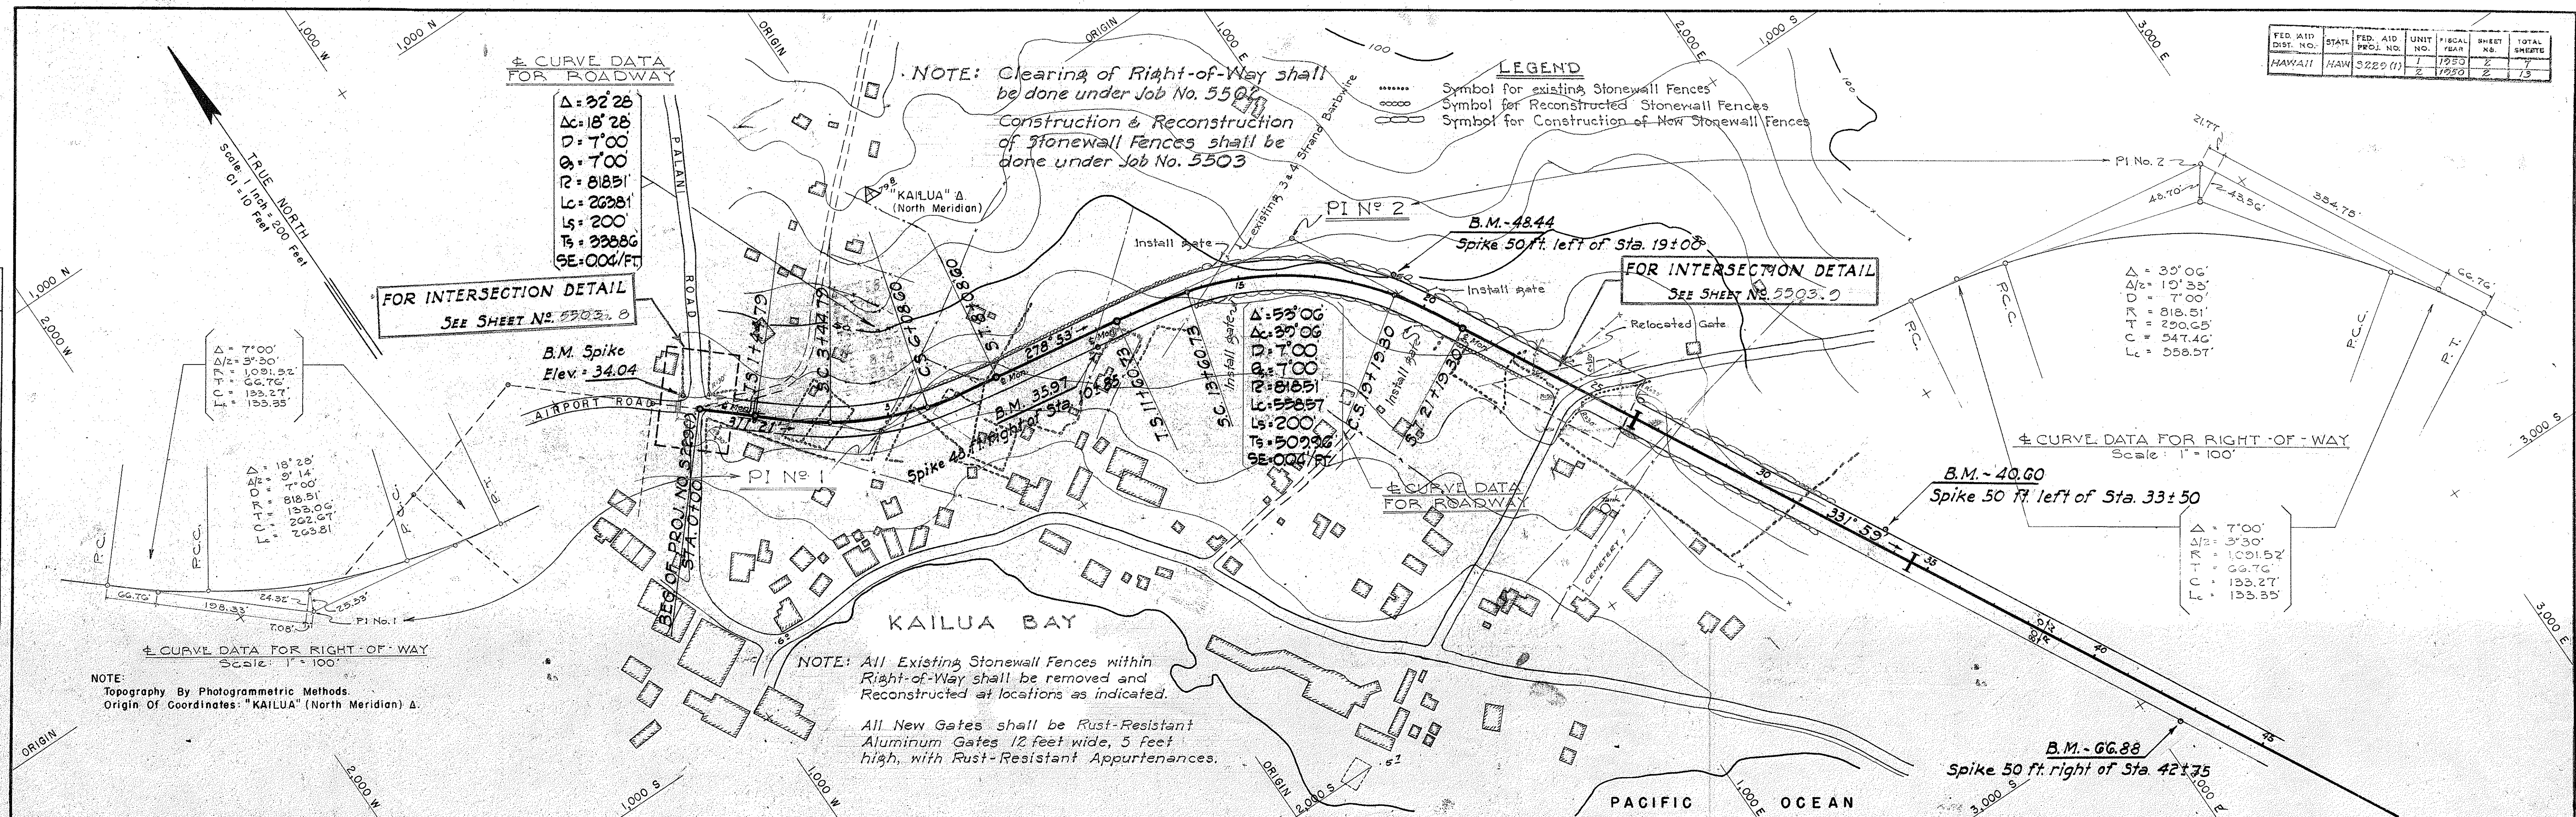

FED. ROAD DIST. NO.	STATE	FED. AID PROJ. NO.	UNIT NO.	FISCAL YEAR	SHEET NO.	TOTAL SHEETS
HAWAII	HAW	SR29(1)	1	1950	3	7
			2	1950	3	13

LEGEND

- Symbol for existing Stonewall Fences.
 Symbol for Reconstructed Stonewall Fences.
 Symbol for Construction of New Stonewall Fences

TYPICAL DITCH SECTION
Not To Scale.


1. CURVE DATA FOR
ROADWAY AND R/W

$\Delta = 27^{\circ} 19'$
 $D = 2^{\circ} 00'$
 $R = 2864.79$
 $T = 696.15$
 $L = 1365.83$
 $C = 1352.93$
 $SE = 002^{\circ} / Pt.$

FOR INTERSECTION DETAIL
SEE SHEET No. 5503.10


NOTE:
Topography By Photogrammetric Methods
Origin Of Coordinates: "KAILUA" (North)

B.M. ~ 99.77
Spike 50 ft right of Sta. 64 ± 50

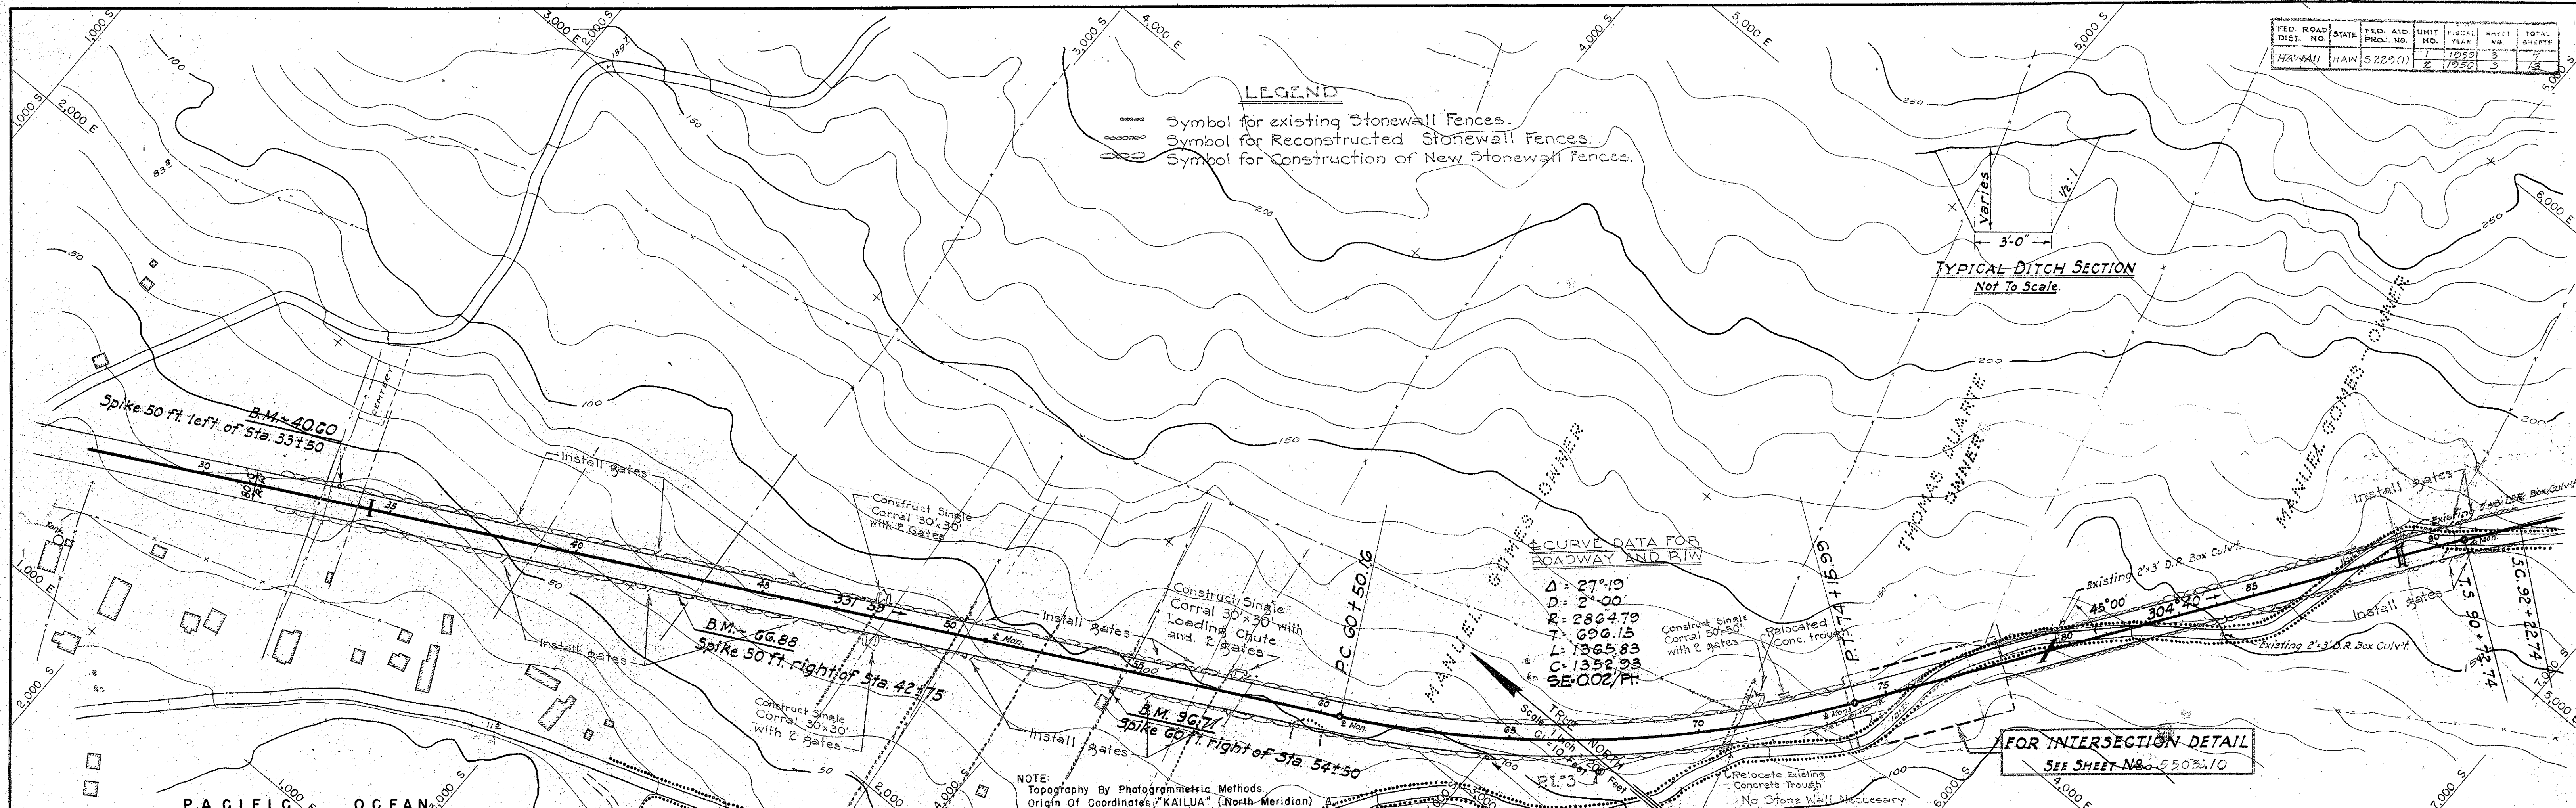



PLAN	SURVEYED	BY	DATE
	PLOTTED		
	NOTE BOOK		
	ALIGNMENT CHECKED		
NO.	RT. OF WAY CHECKED		

PROFILE	SURVEYED	BY	DATE
NOTE BOOK	PLOTTED		
NO. _____	GRADES CHECKED		
	B. M'S NOTED		
	STRUCTURE NOTATIONS CHECKED		

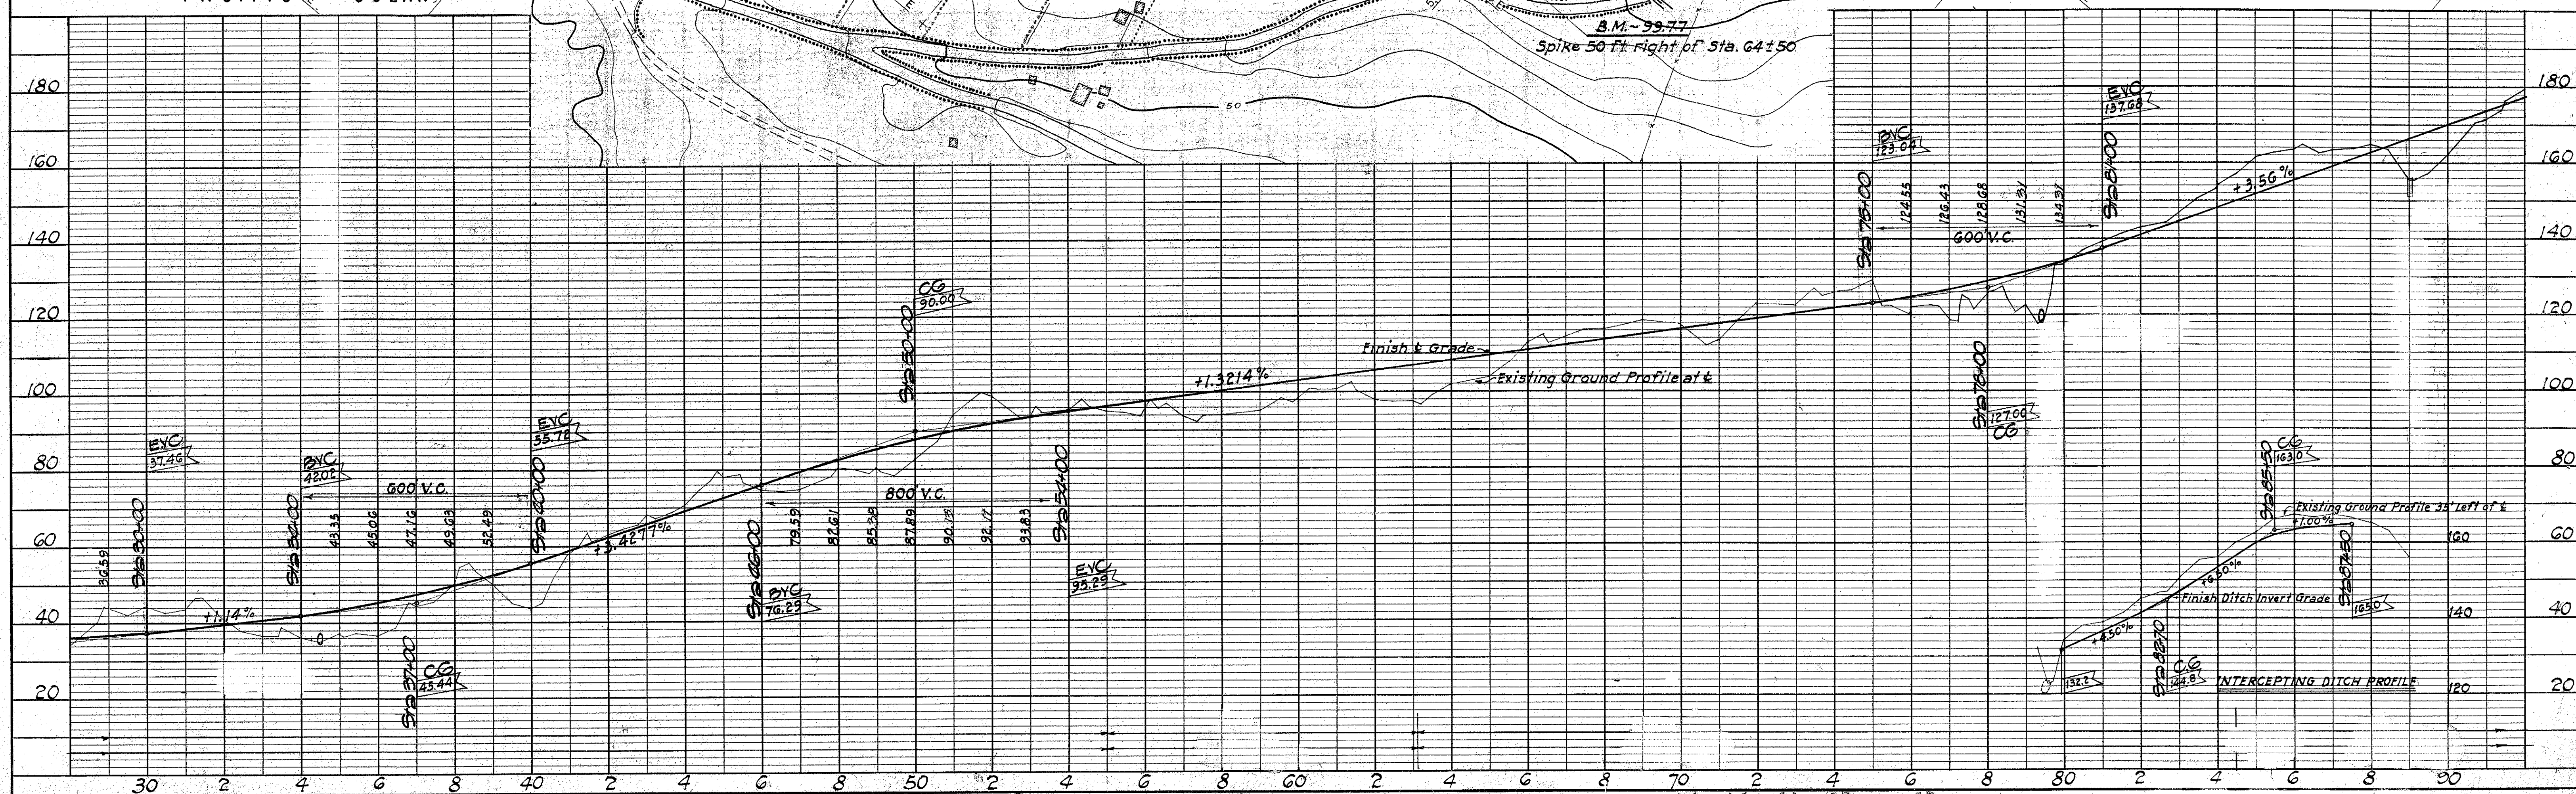

PLAN	DATE
SURVEYED	
NOTED	
NOTE BOOK	
RT. OF WAY CHECKED	
NO.	



PROFILE	DATE
SURVEYED	
NOTED	
NOTE BOOK	
STRUCTURE NOTATIONS CHECKED	
NO.	

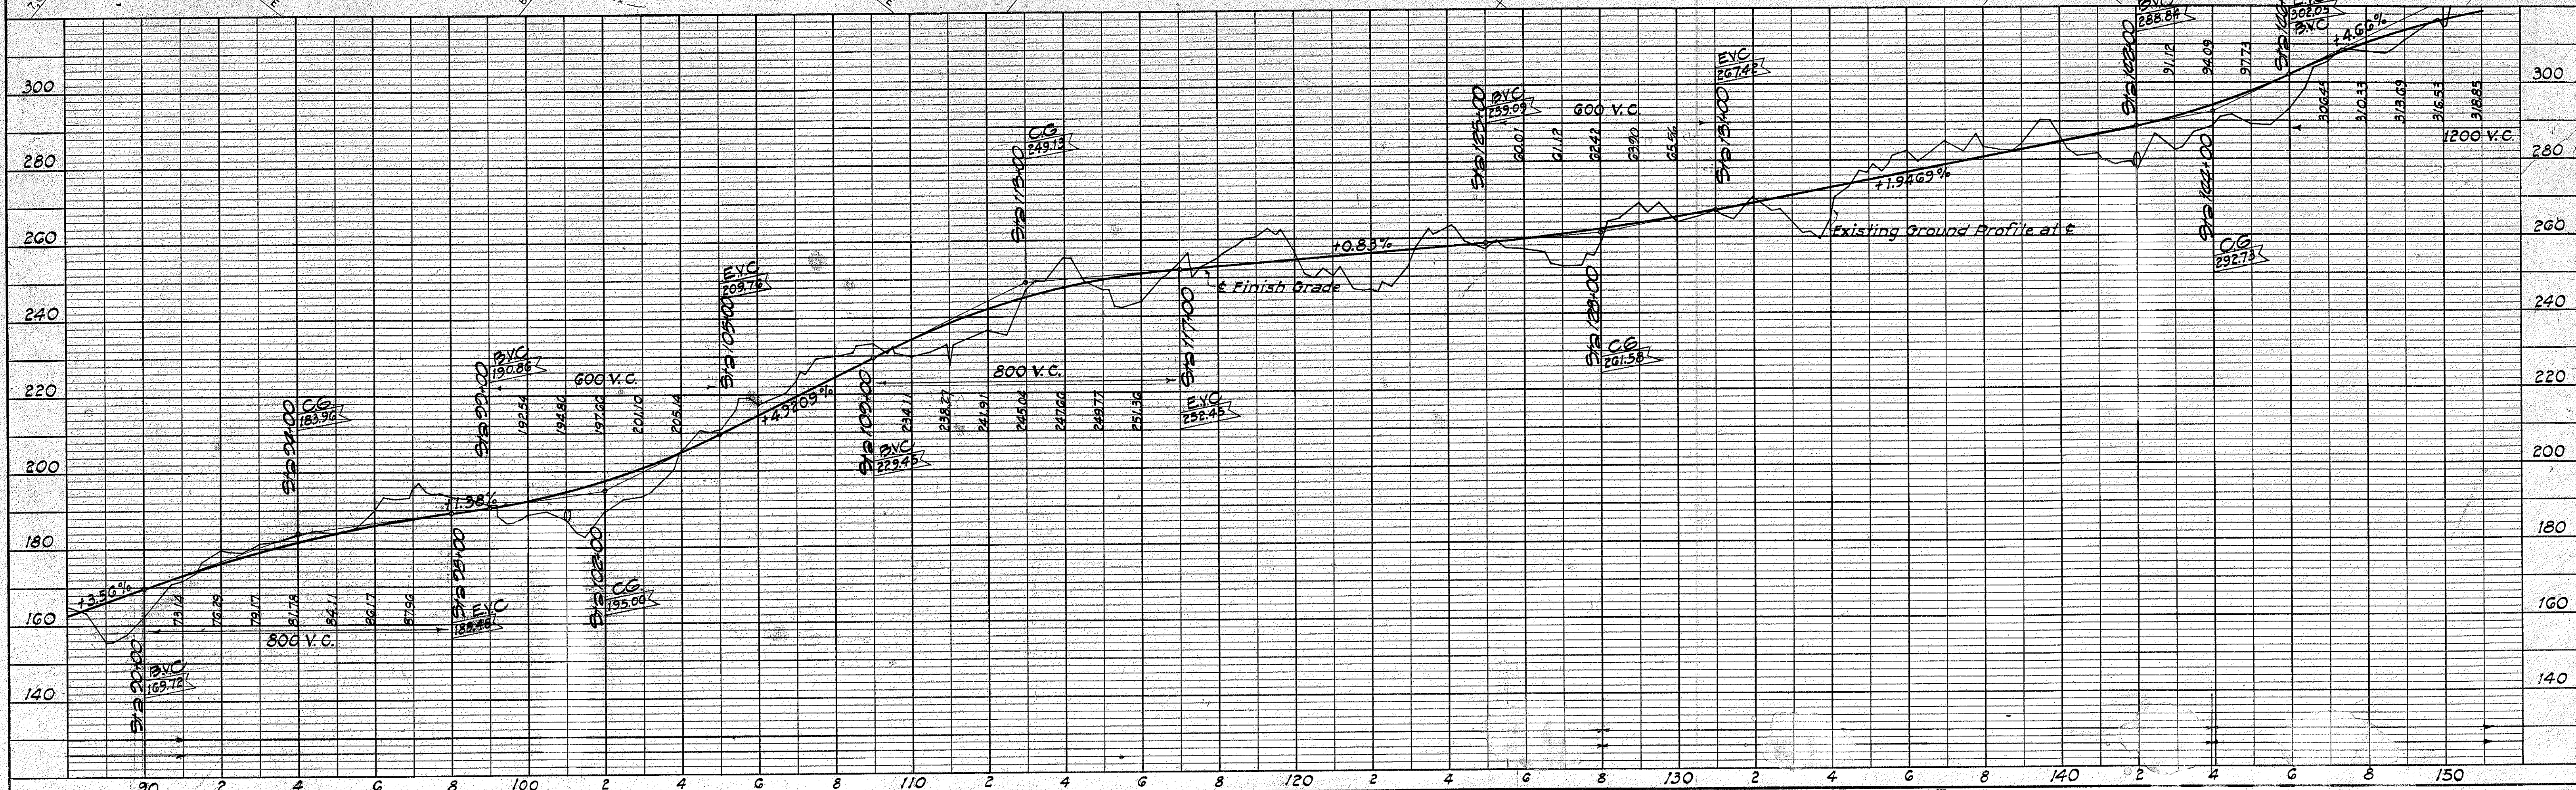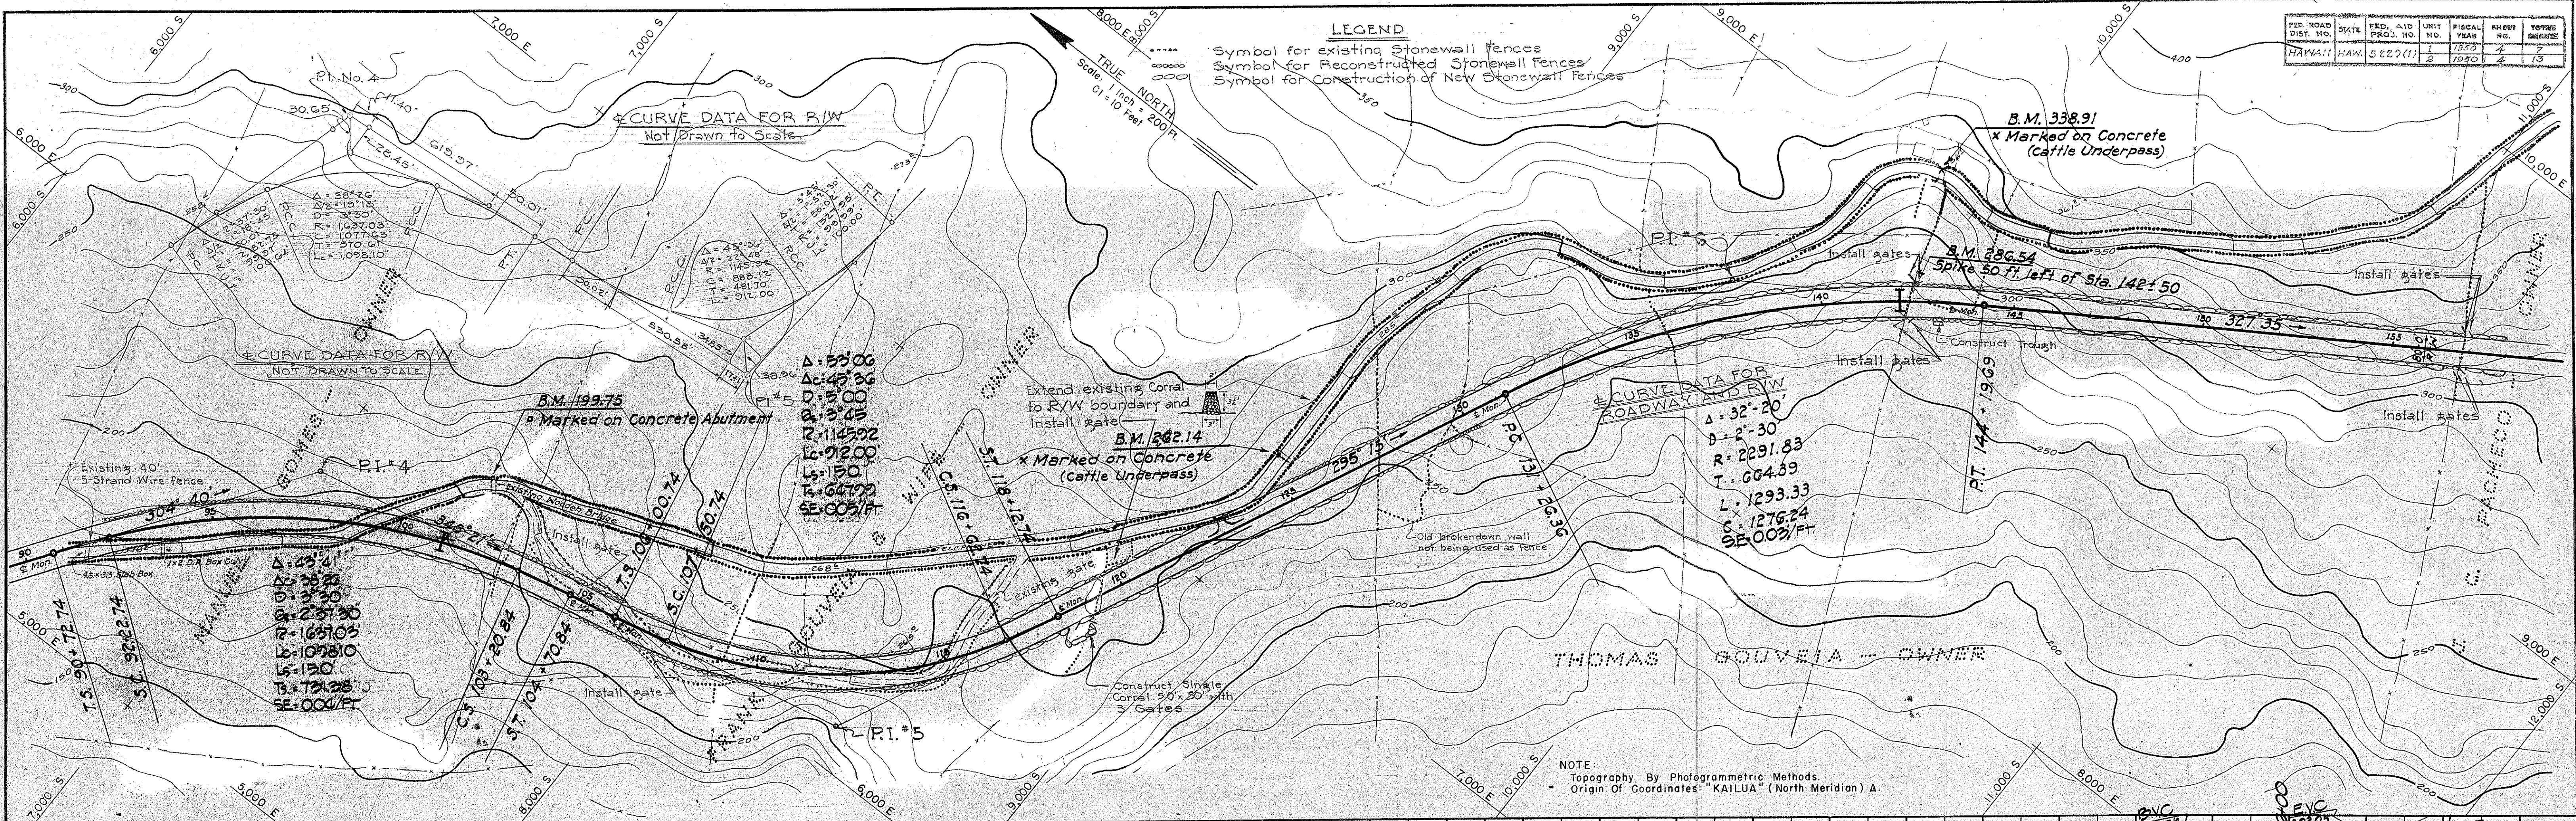

FED. ROAD DIST. NO.	STATE	FED. AID PROJ. NO.	UNIT NO.	FISCAL YEAR	SHEET NO.	TOTAL SHEETS
1976	HAWAII	5220(1)	2	1976	15	15



PLAN	SURVEYED	DATE	BY
NOTE BOOK GRADES CHECKED			
RT. OF WAY CHECKED			
NO.			

PROFILE	SURVEYED	DATE	BY
NOTE BOOK GRADES CHECKED			
B.M.S. NOTED			
STRUCTURE NOTING CHKO.			
NO.			

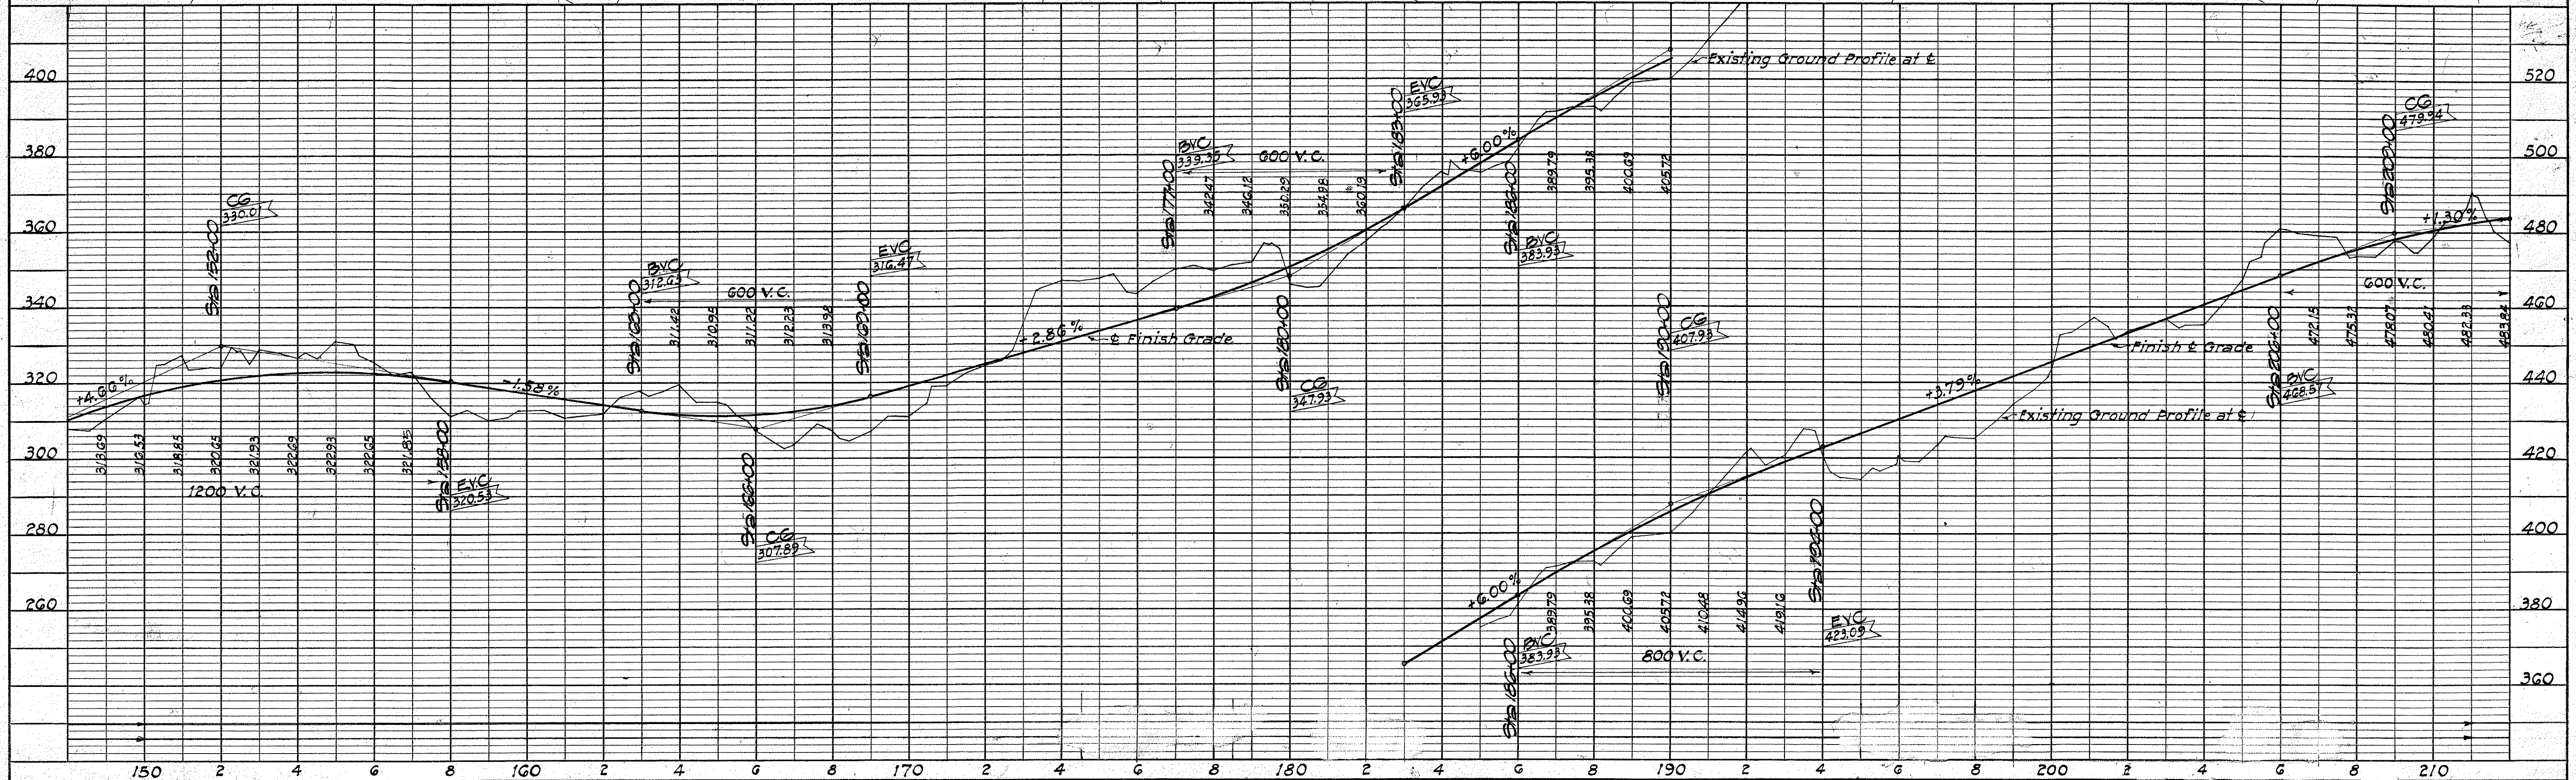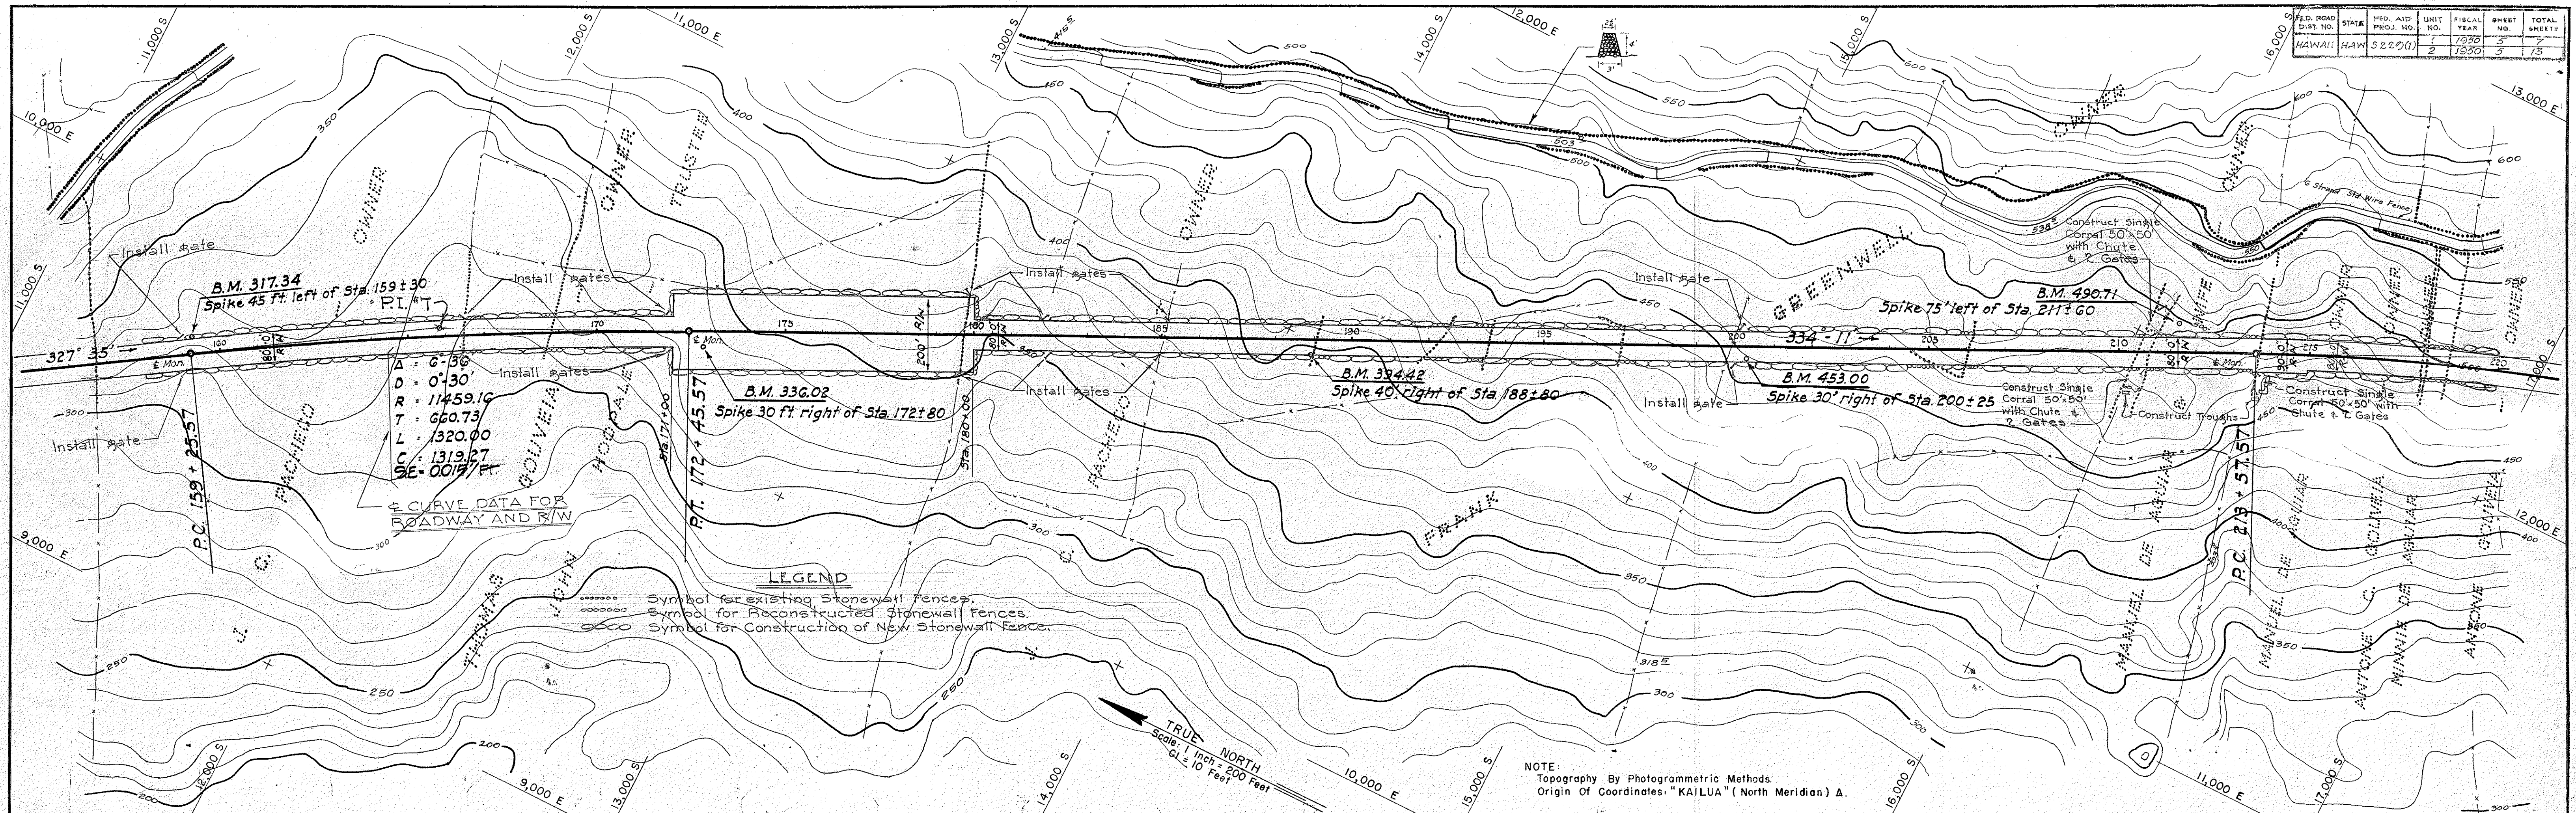

PLAN	DATE	BY
SURVEYED		
PLOTTED		
NOTE BOOK		
NO.		

PROFILE	DATE	BY
SURVEYED		
PLOTTED		
NOTE BOOK		
NO.		

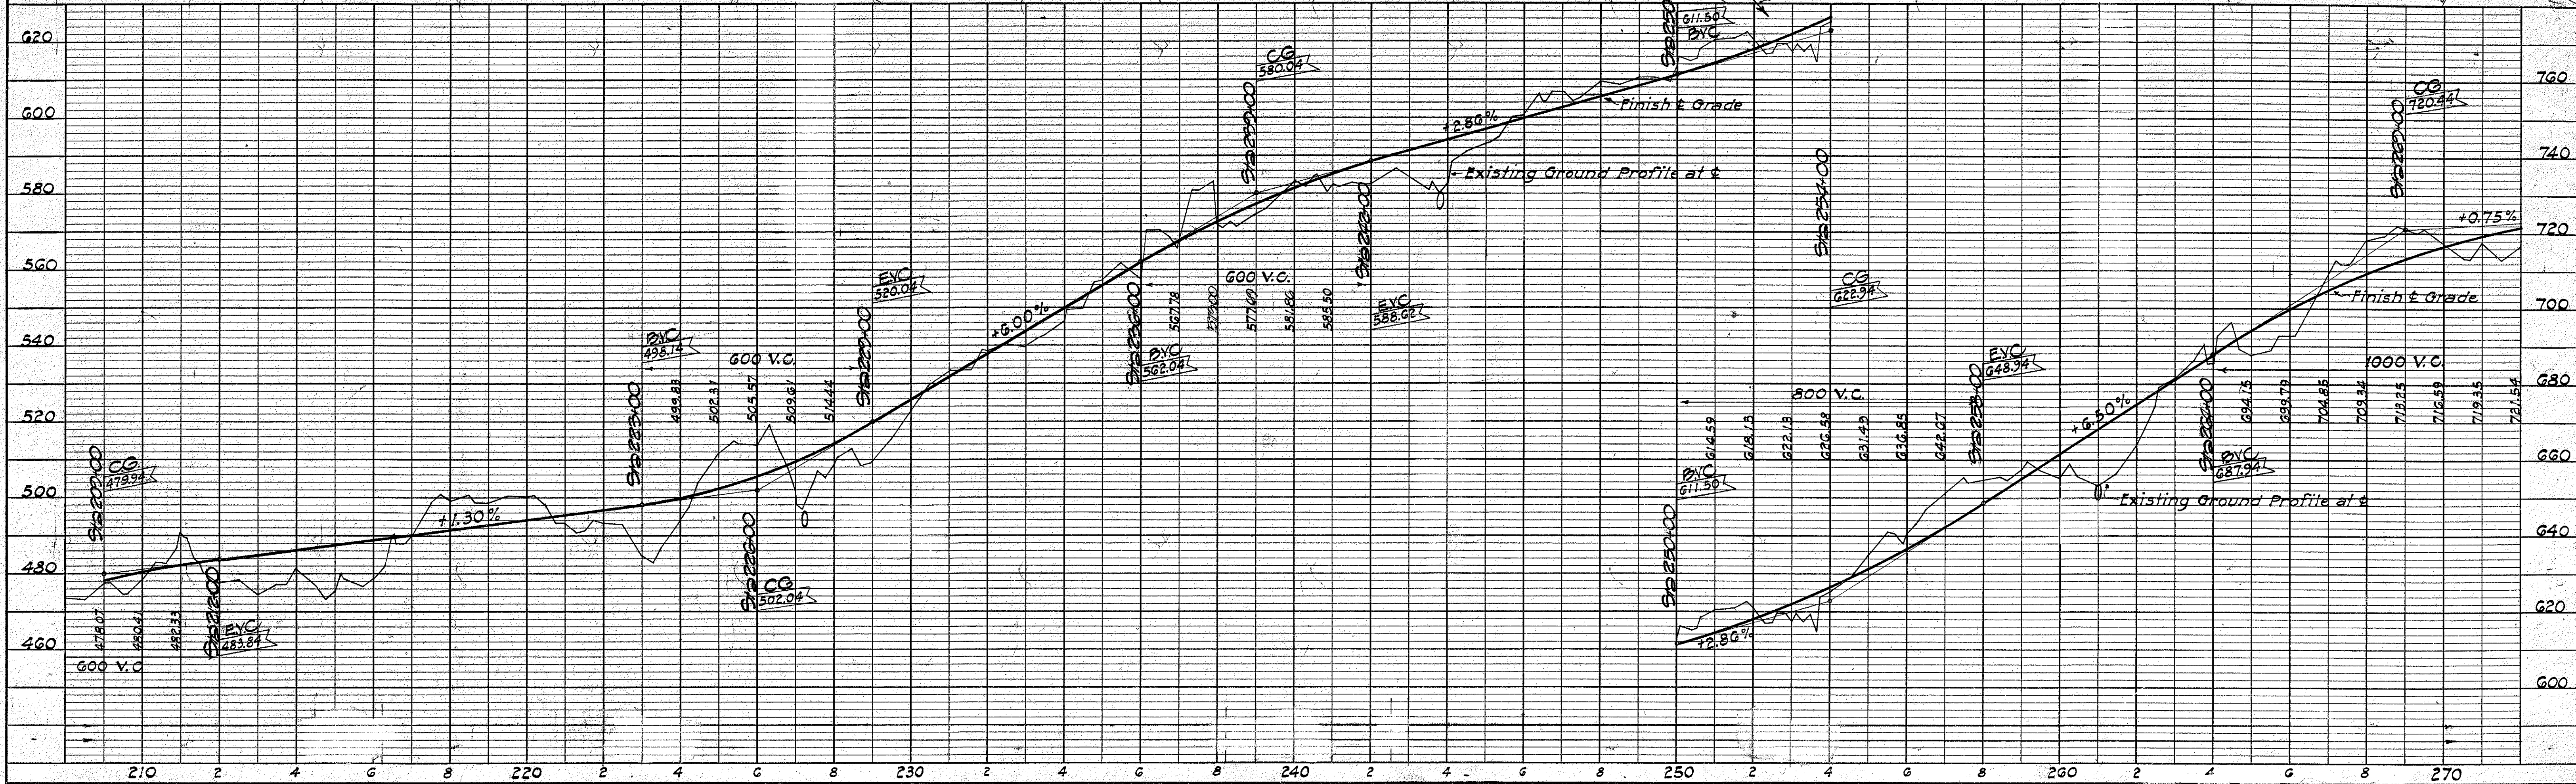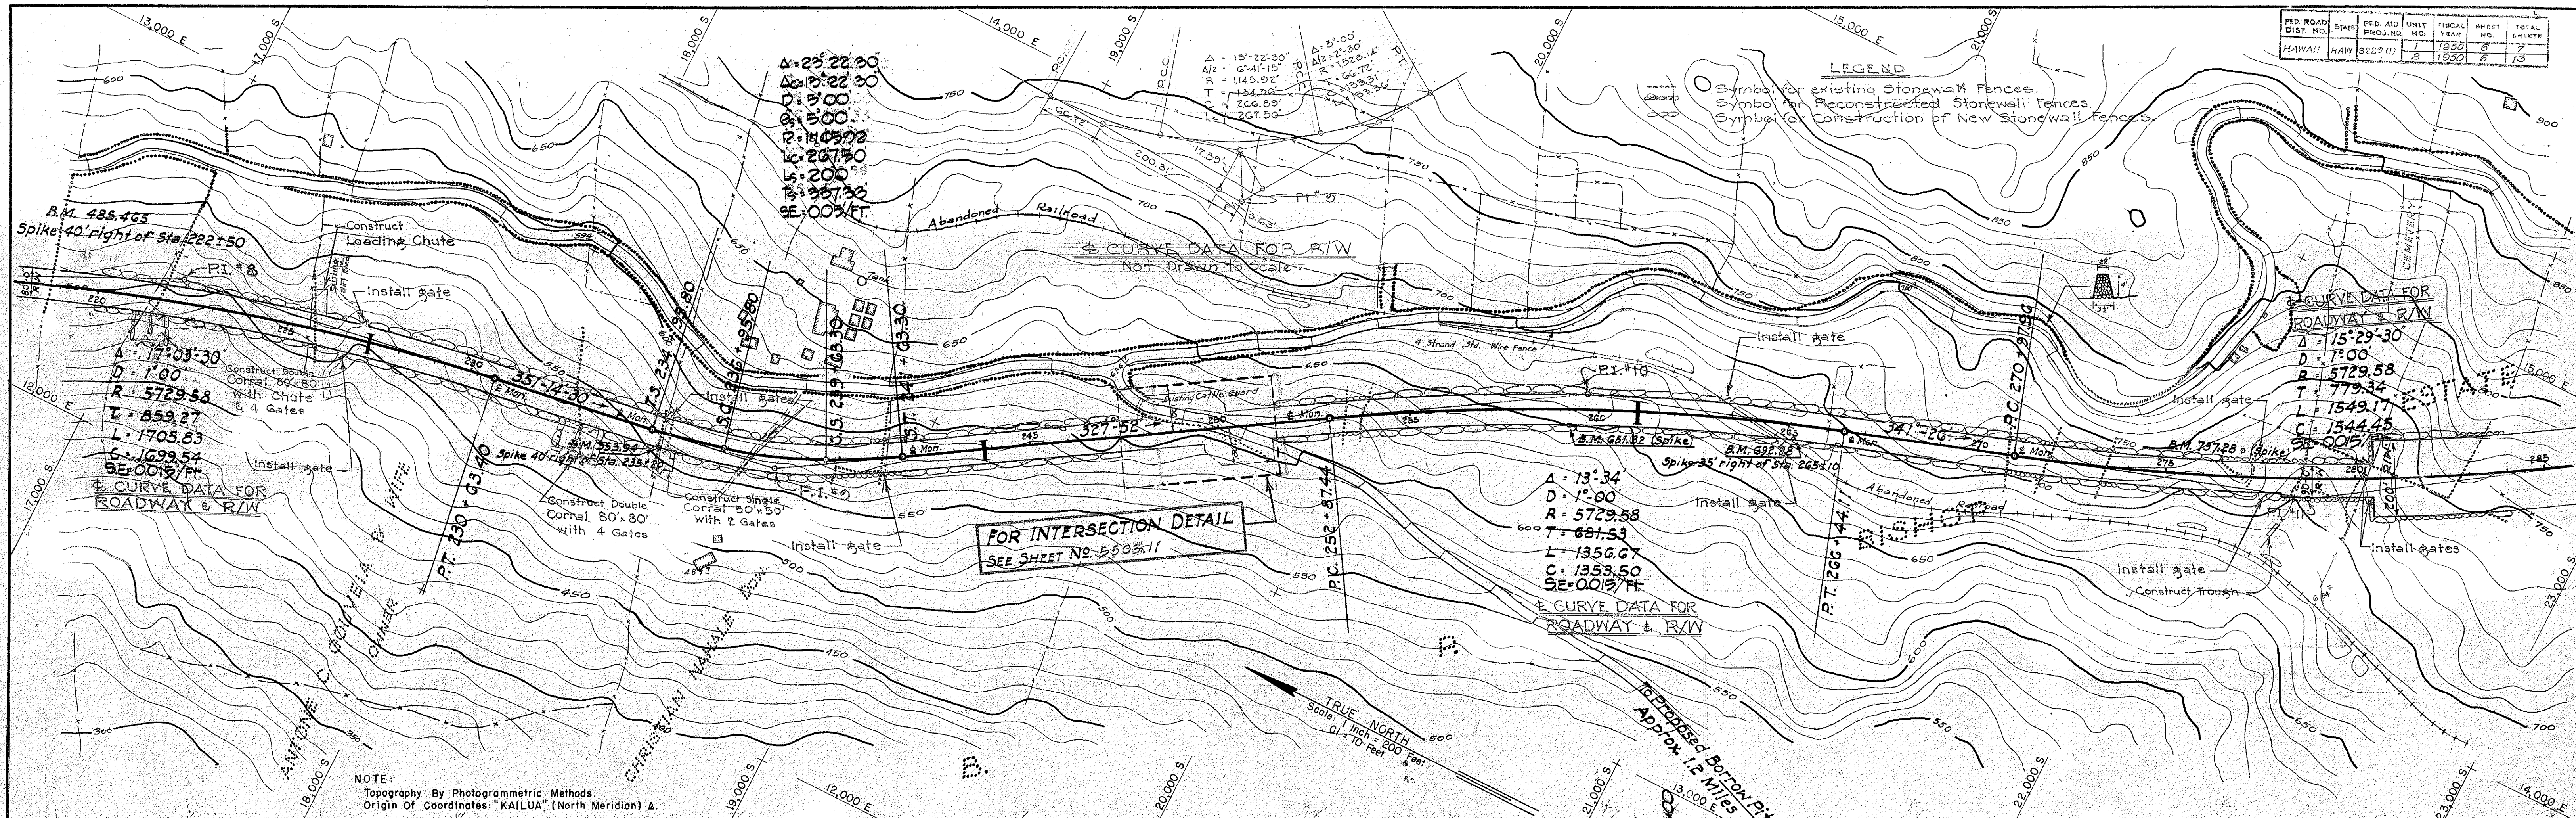

PLAN	DATE
SURVEYED	
PLOTTED	
NOTE BOOK	
RT. OF WAY CHECKED	
NO.	

PROFILE	DATE
SURVEYED	
PLOTTED	
NOTE BOOK	
GRADES CHECKED	
STRUCTURE NOTATIONS CHD.	
NO.	

