
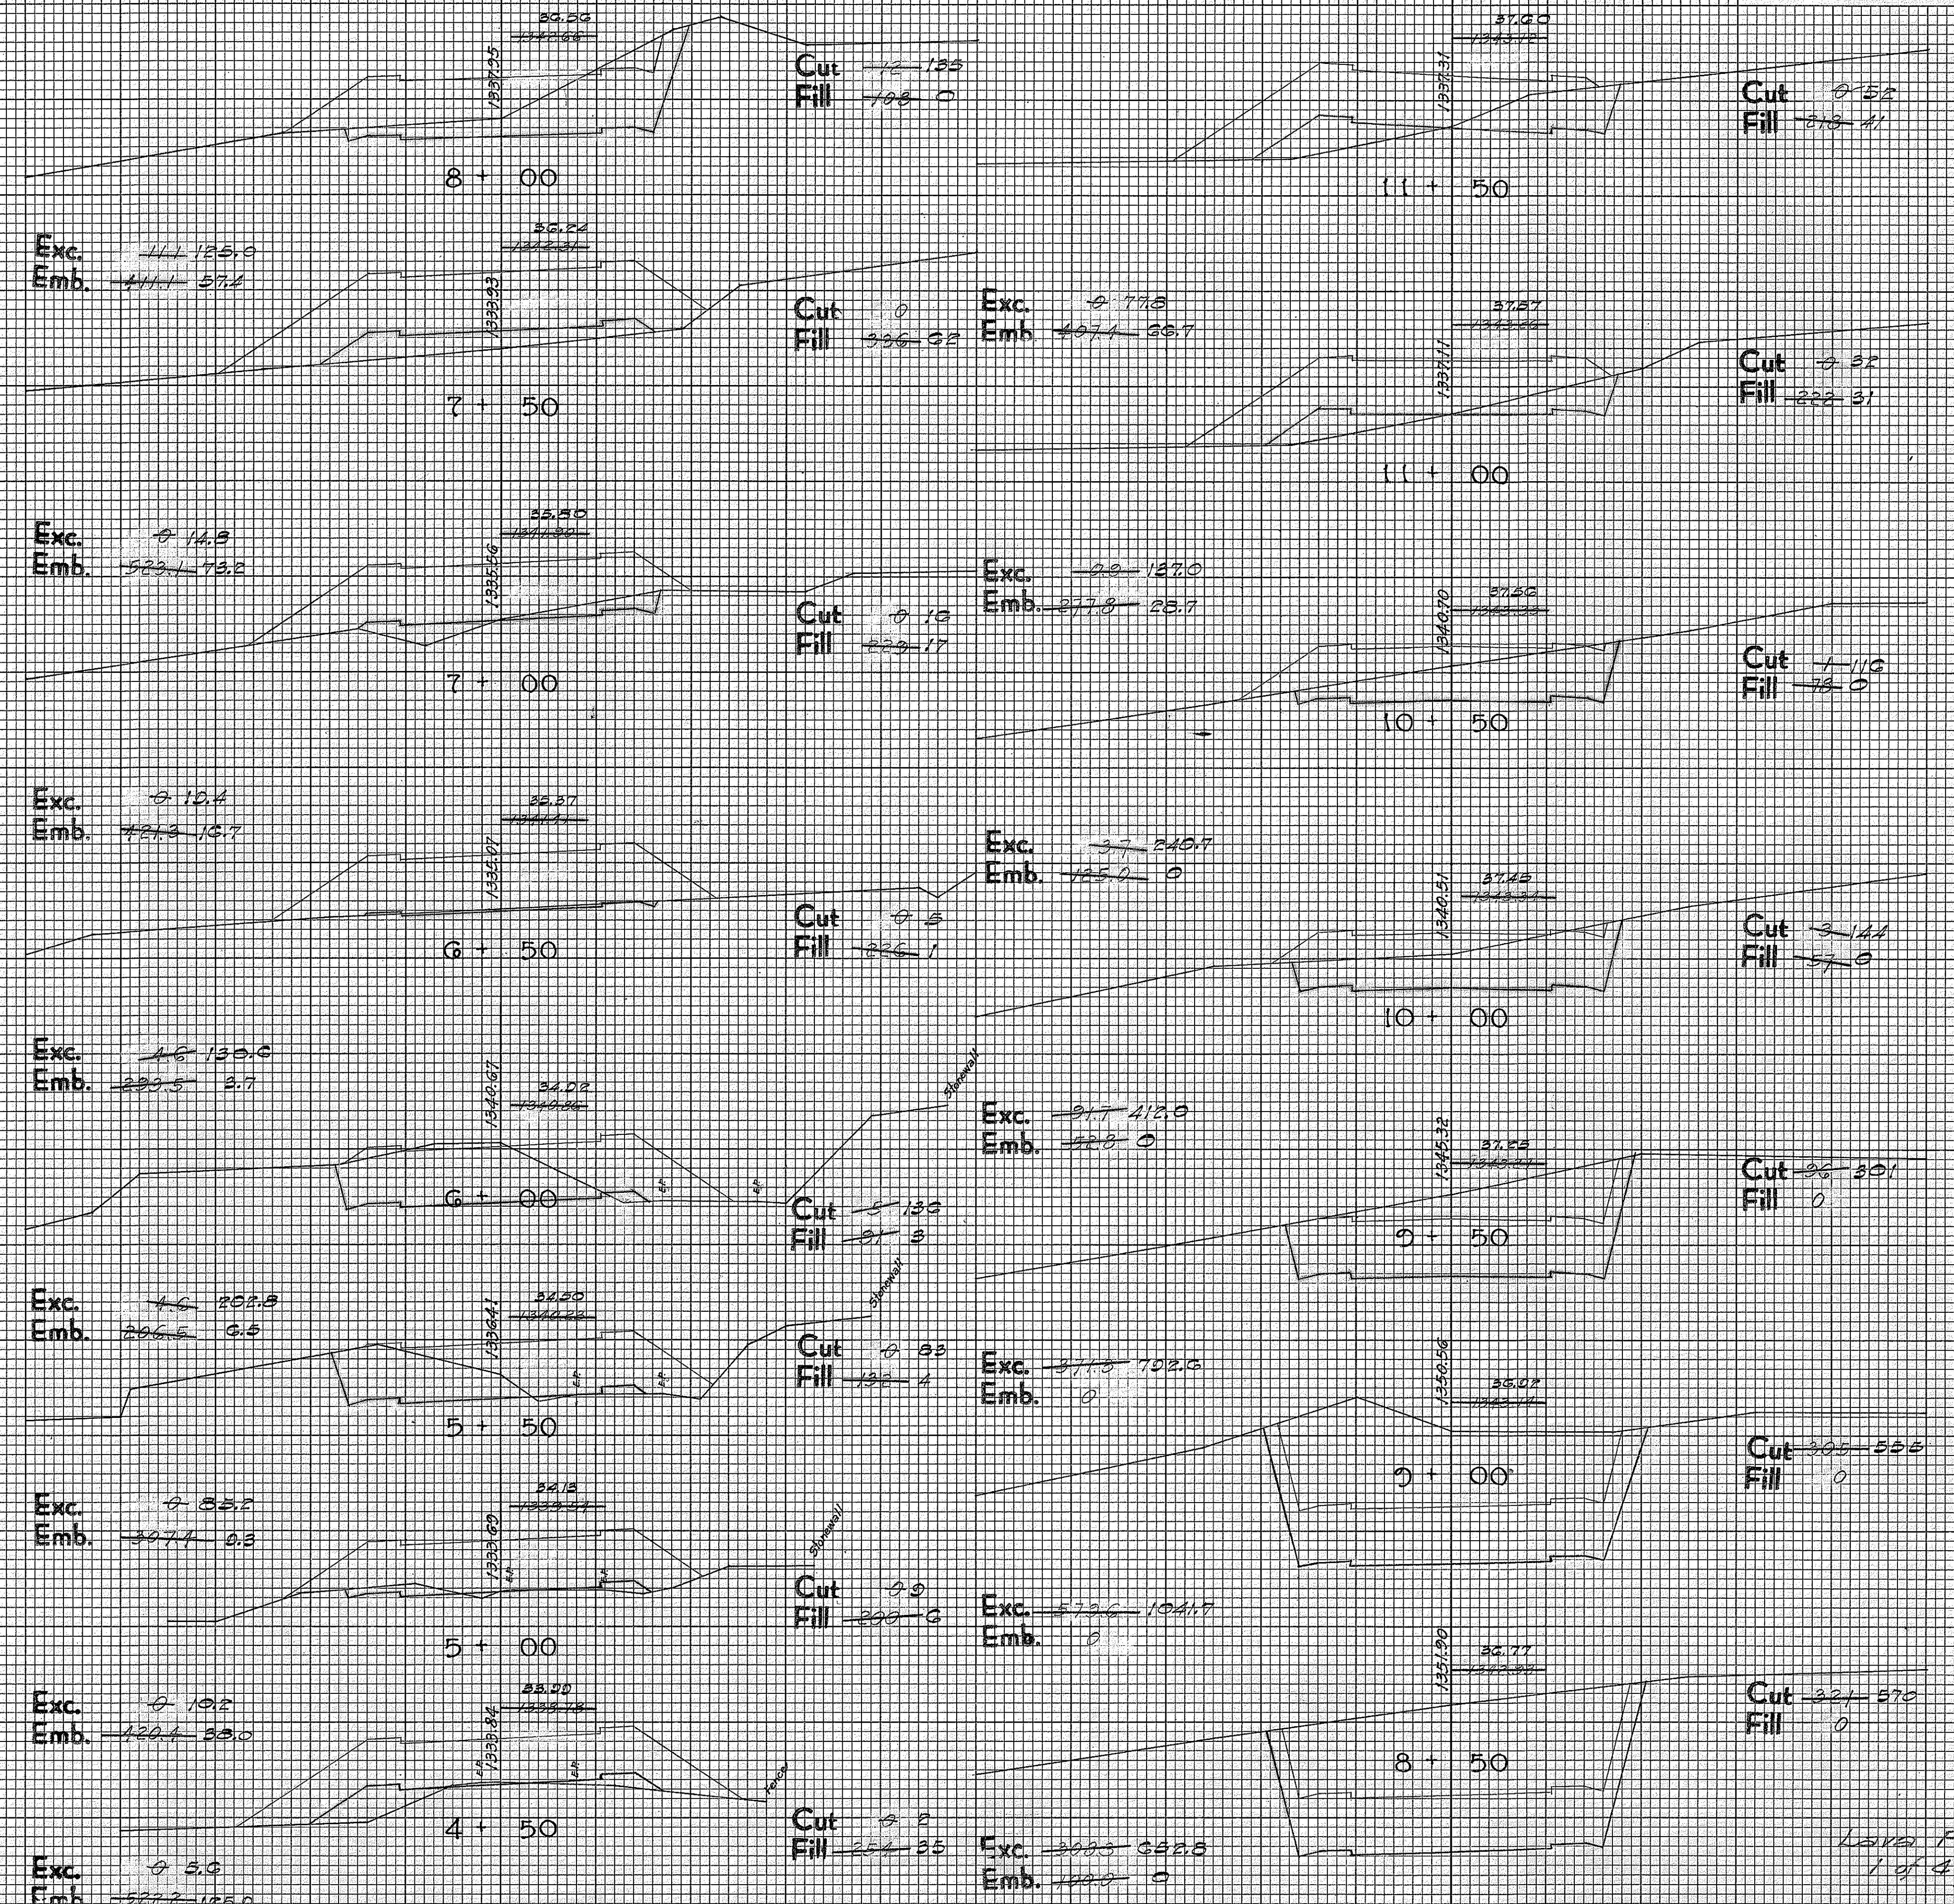



FINAL SURVEY
NOTE BOOK
NO. 115-100-100

ORIGINAL SURVEY
NOTE BOOK
NO. 115-100-100

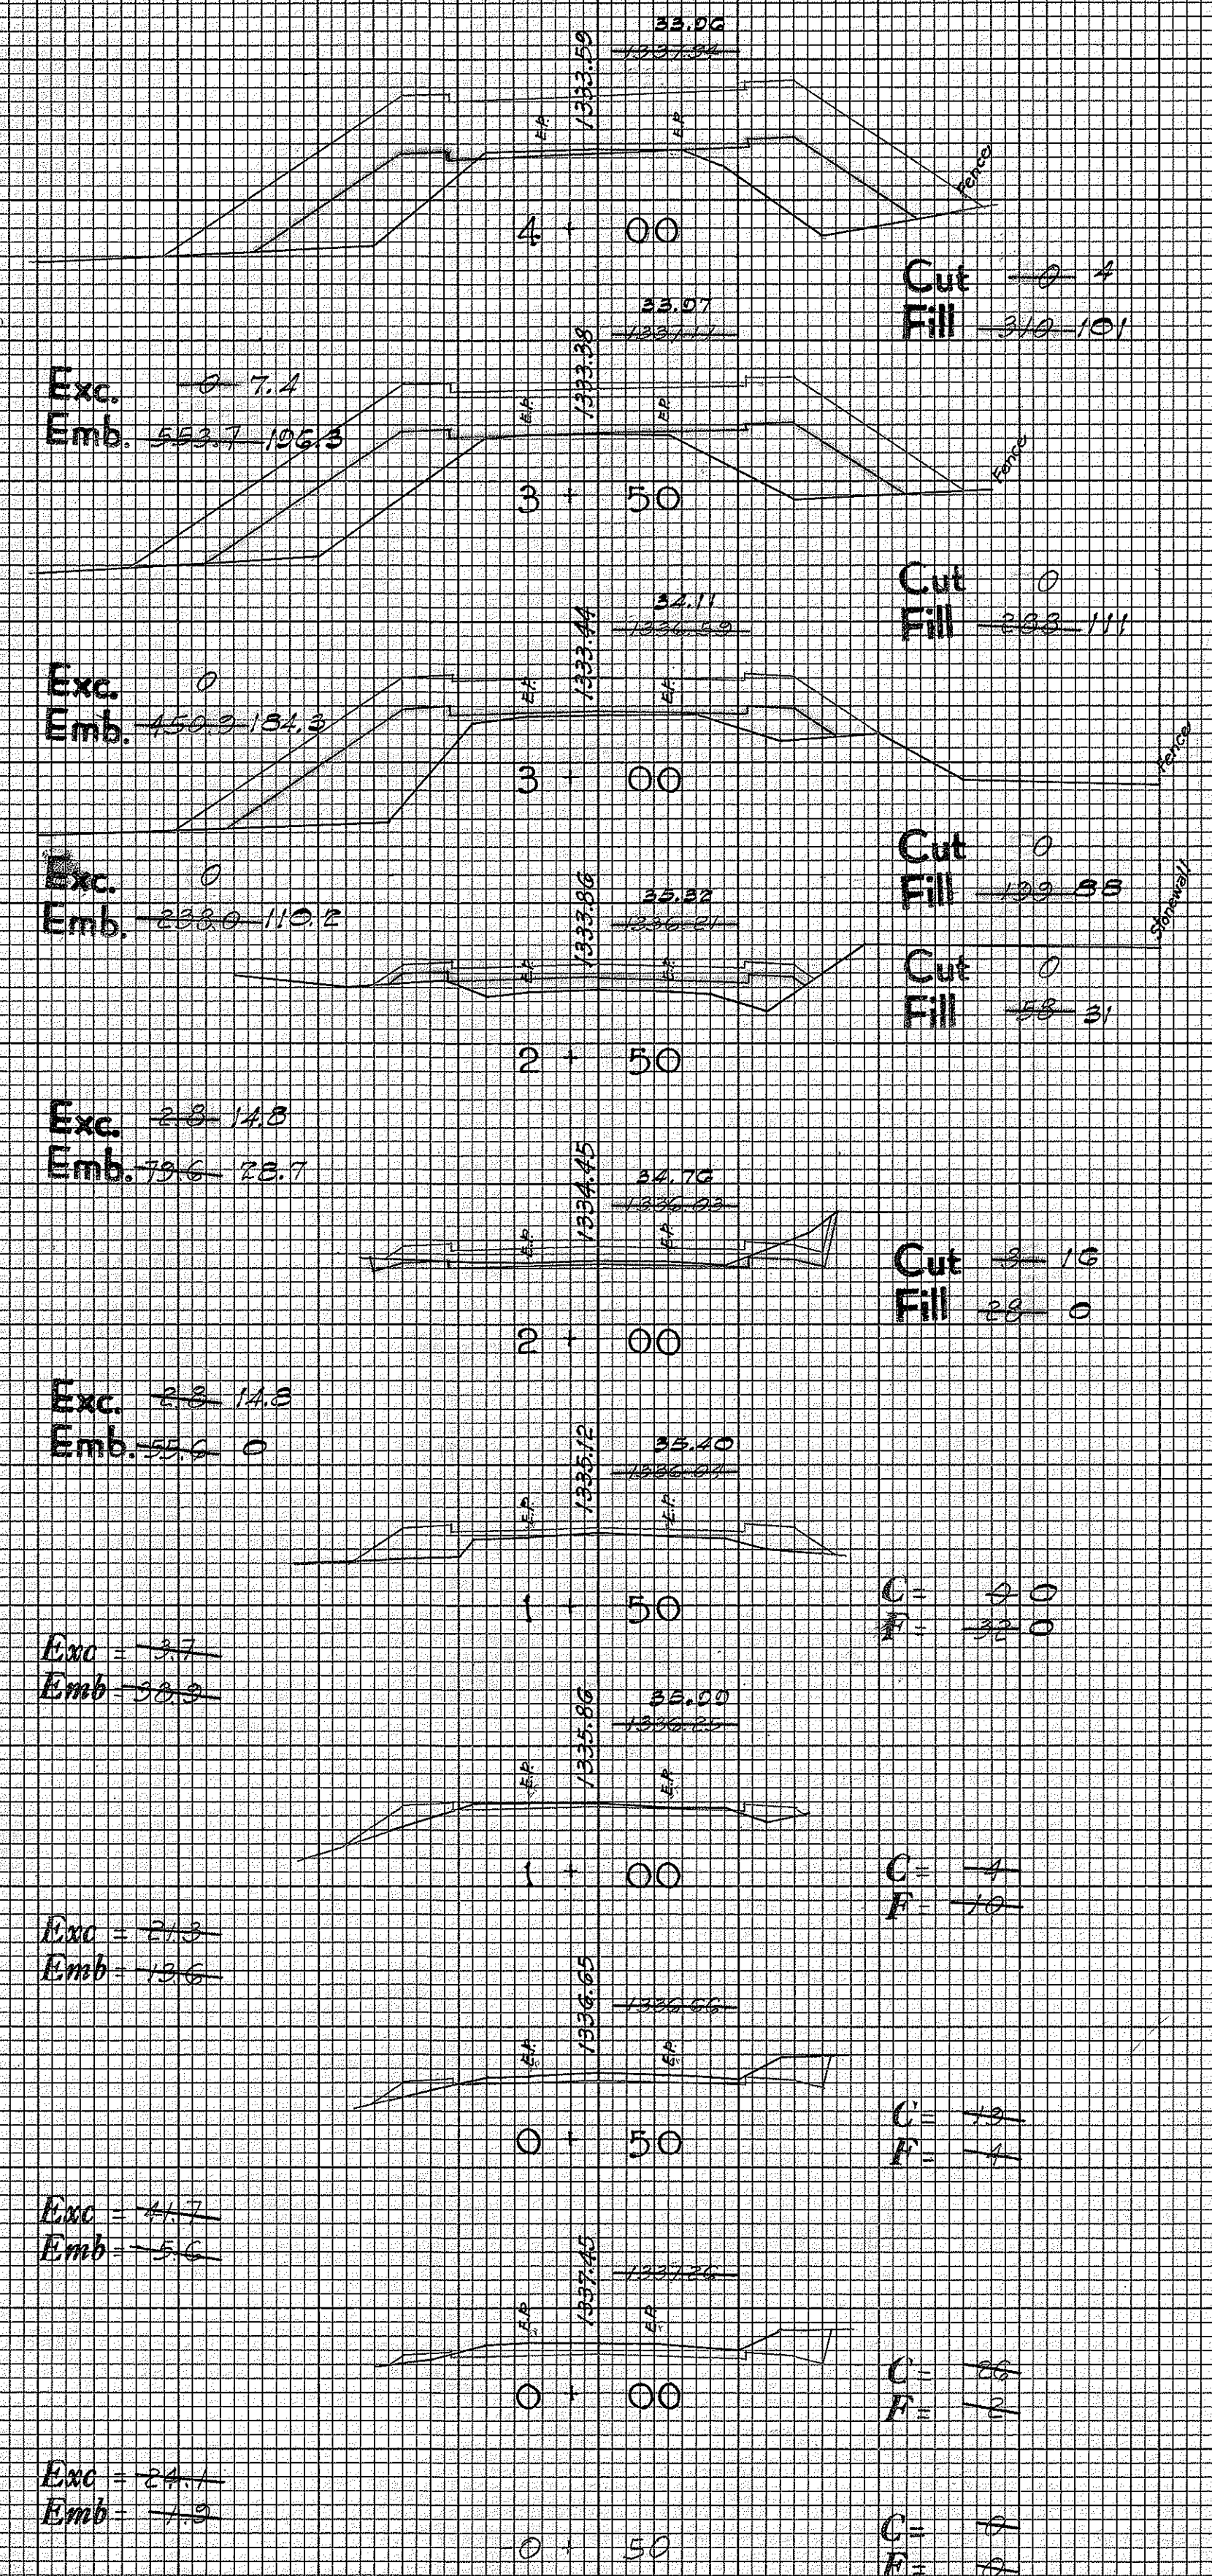

FINAL SURVEY PLOTTED
NOTE BOOK NO. _____
DATE _____ BY _____


ORIGINAL SURVEY PLOTTED
NOTE BOOK NO. _____
DATE _____ BY _____

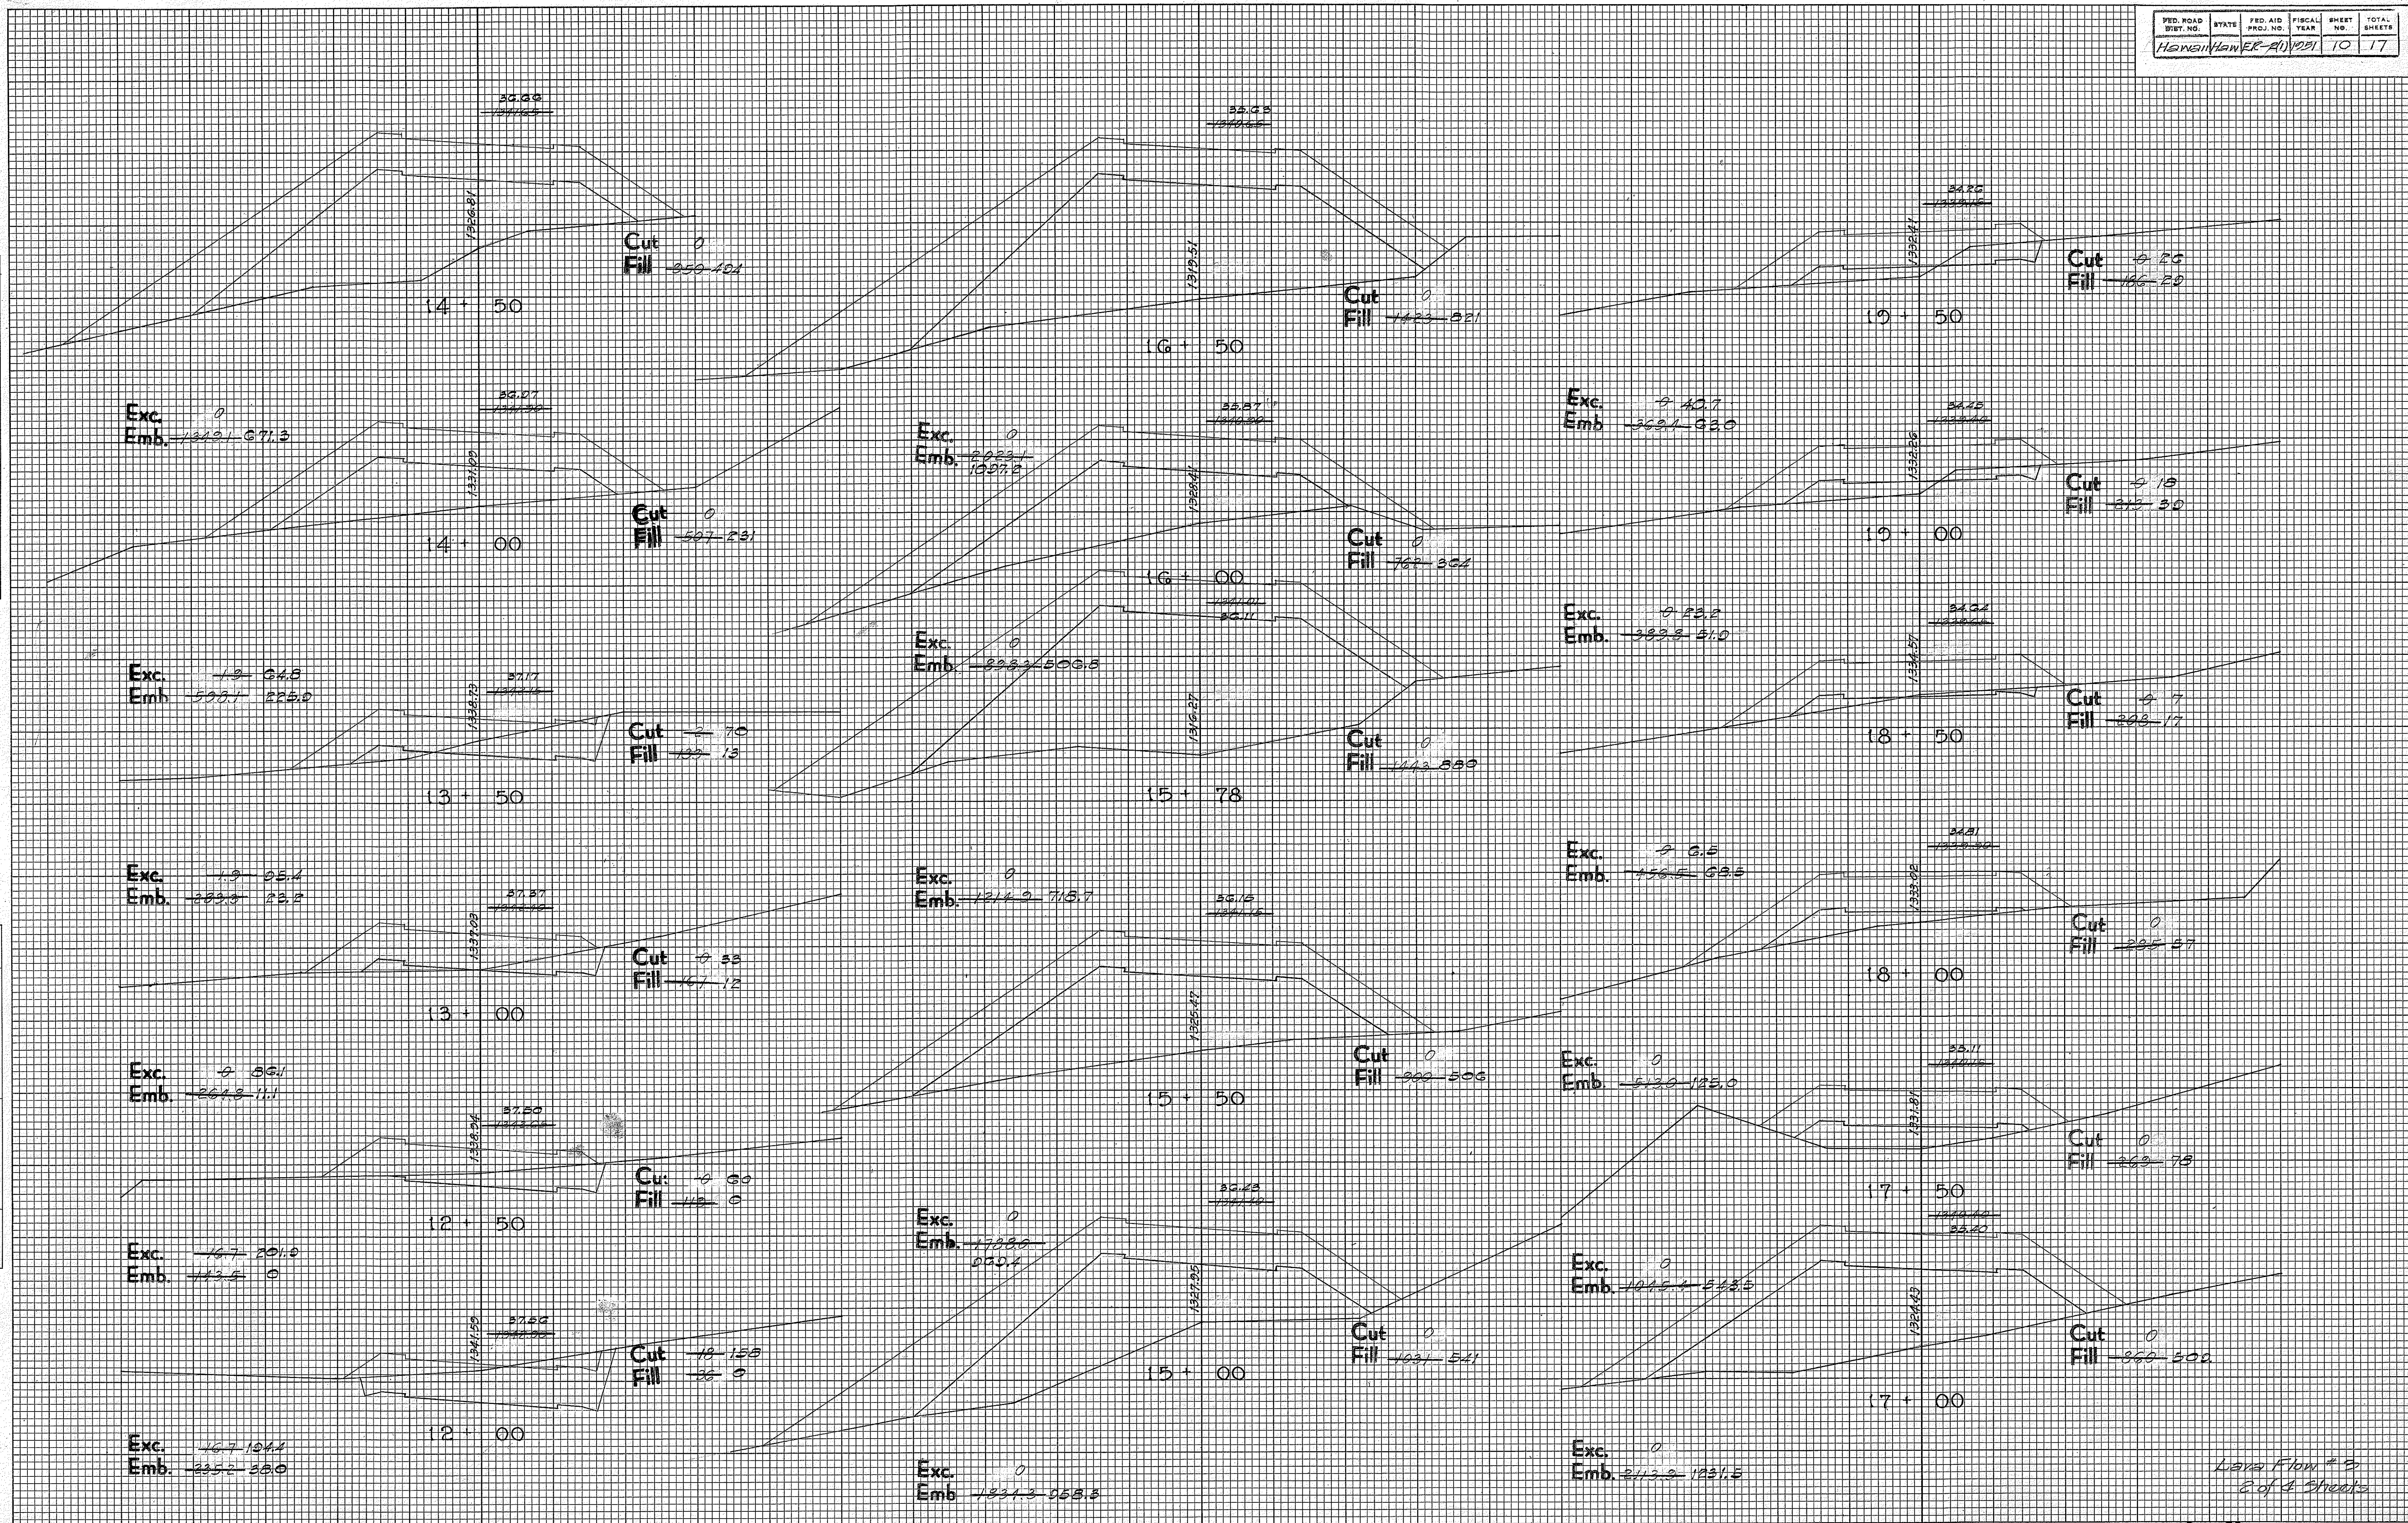


Water Flow # 3
2 of 4 Sheets

FINAL SURVEY	BY	DATE
SURVEYED		
PLOTTED		
NOTE BOOK		
AREAS CHECKED		

ORIGINAL SURVEY	BY	DATE
SURVEYED		
PLOTTED		
NOTE BOOK		
AREAS CHECKED		

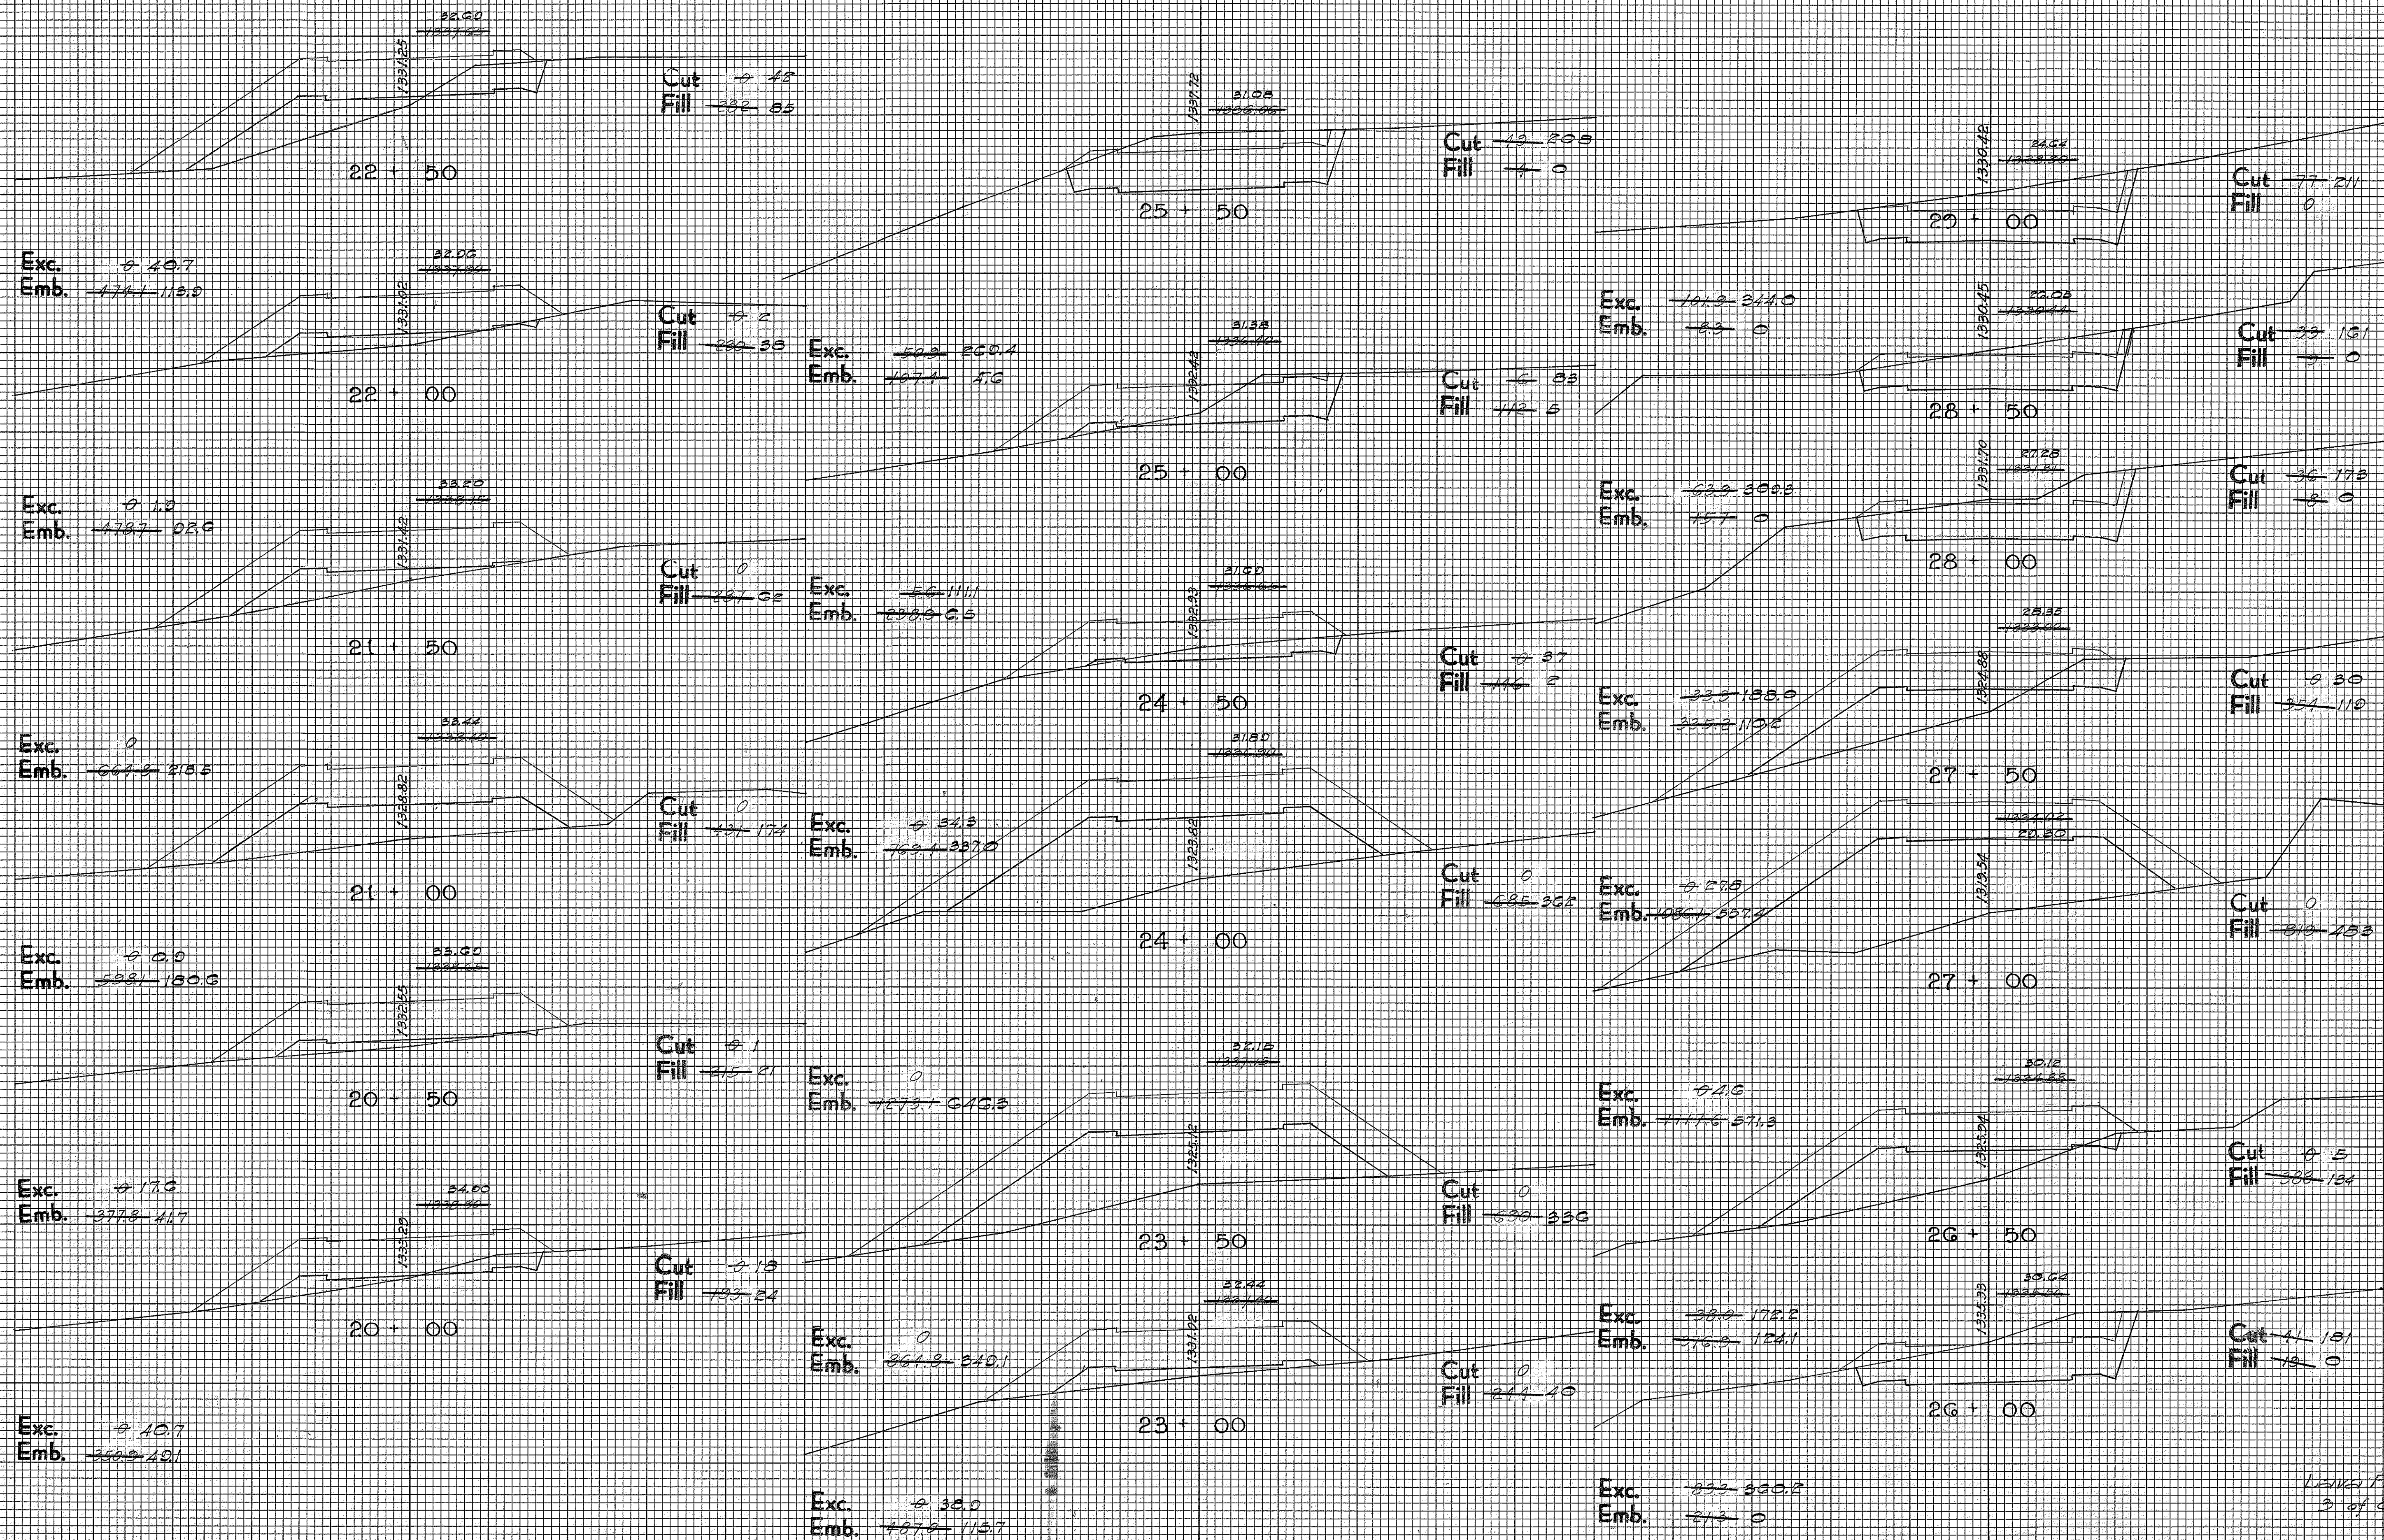


ORIGINAL SURVEY		BY		DATE
SURVEYED				
PLOTTED				20-12-10
TEMPLATE				
AREAS				
AREAS CHECKED				

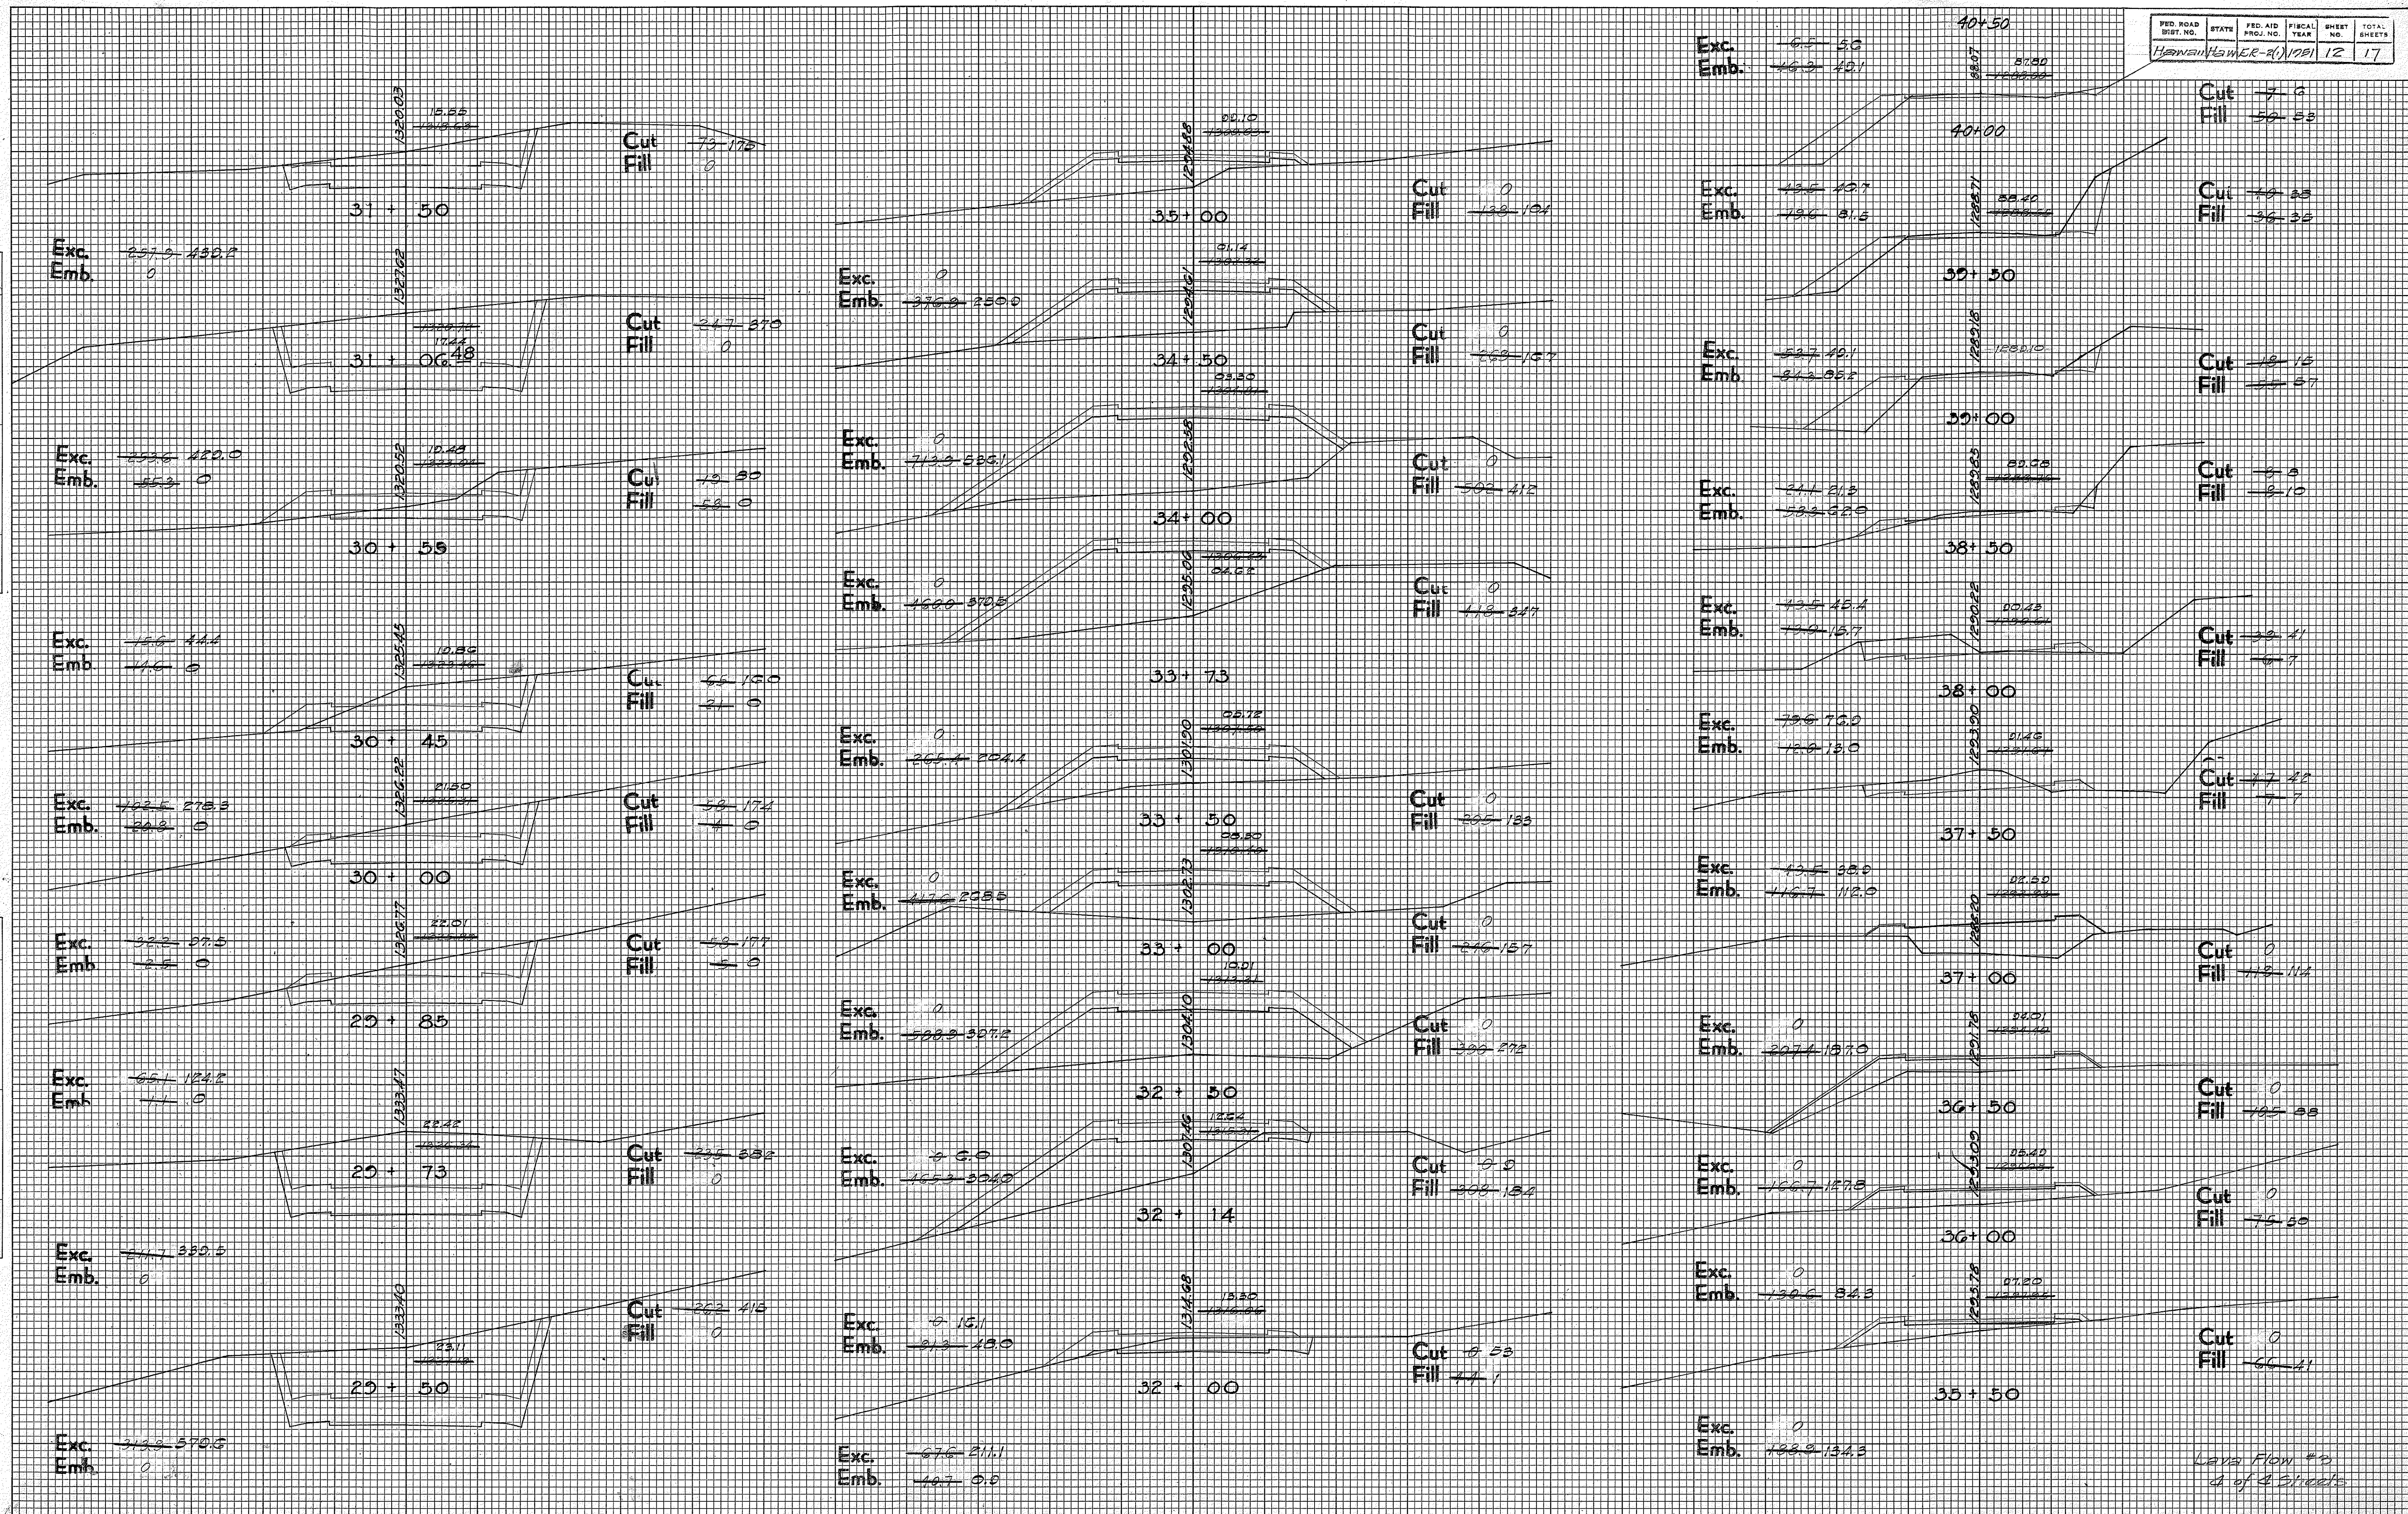

FINAL SURVEY NOTE BOOK NO. _____	SURVEYED _____	BY _____	DATE _____
	PLOTTED _____		
	TEMPLATE _____		
	AREAS _____		
	AREAS CHECKED _____		


ORIGINAL SURVEY			
	SURVEYED	BY	DATE
	PLOTTED		
	TEMPLATE		
	AREAS		
	AREAS CHECKED		
NOTE BOOK			
NO.			

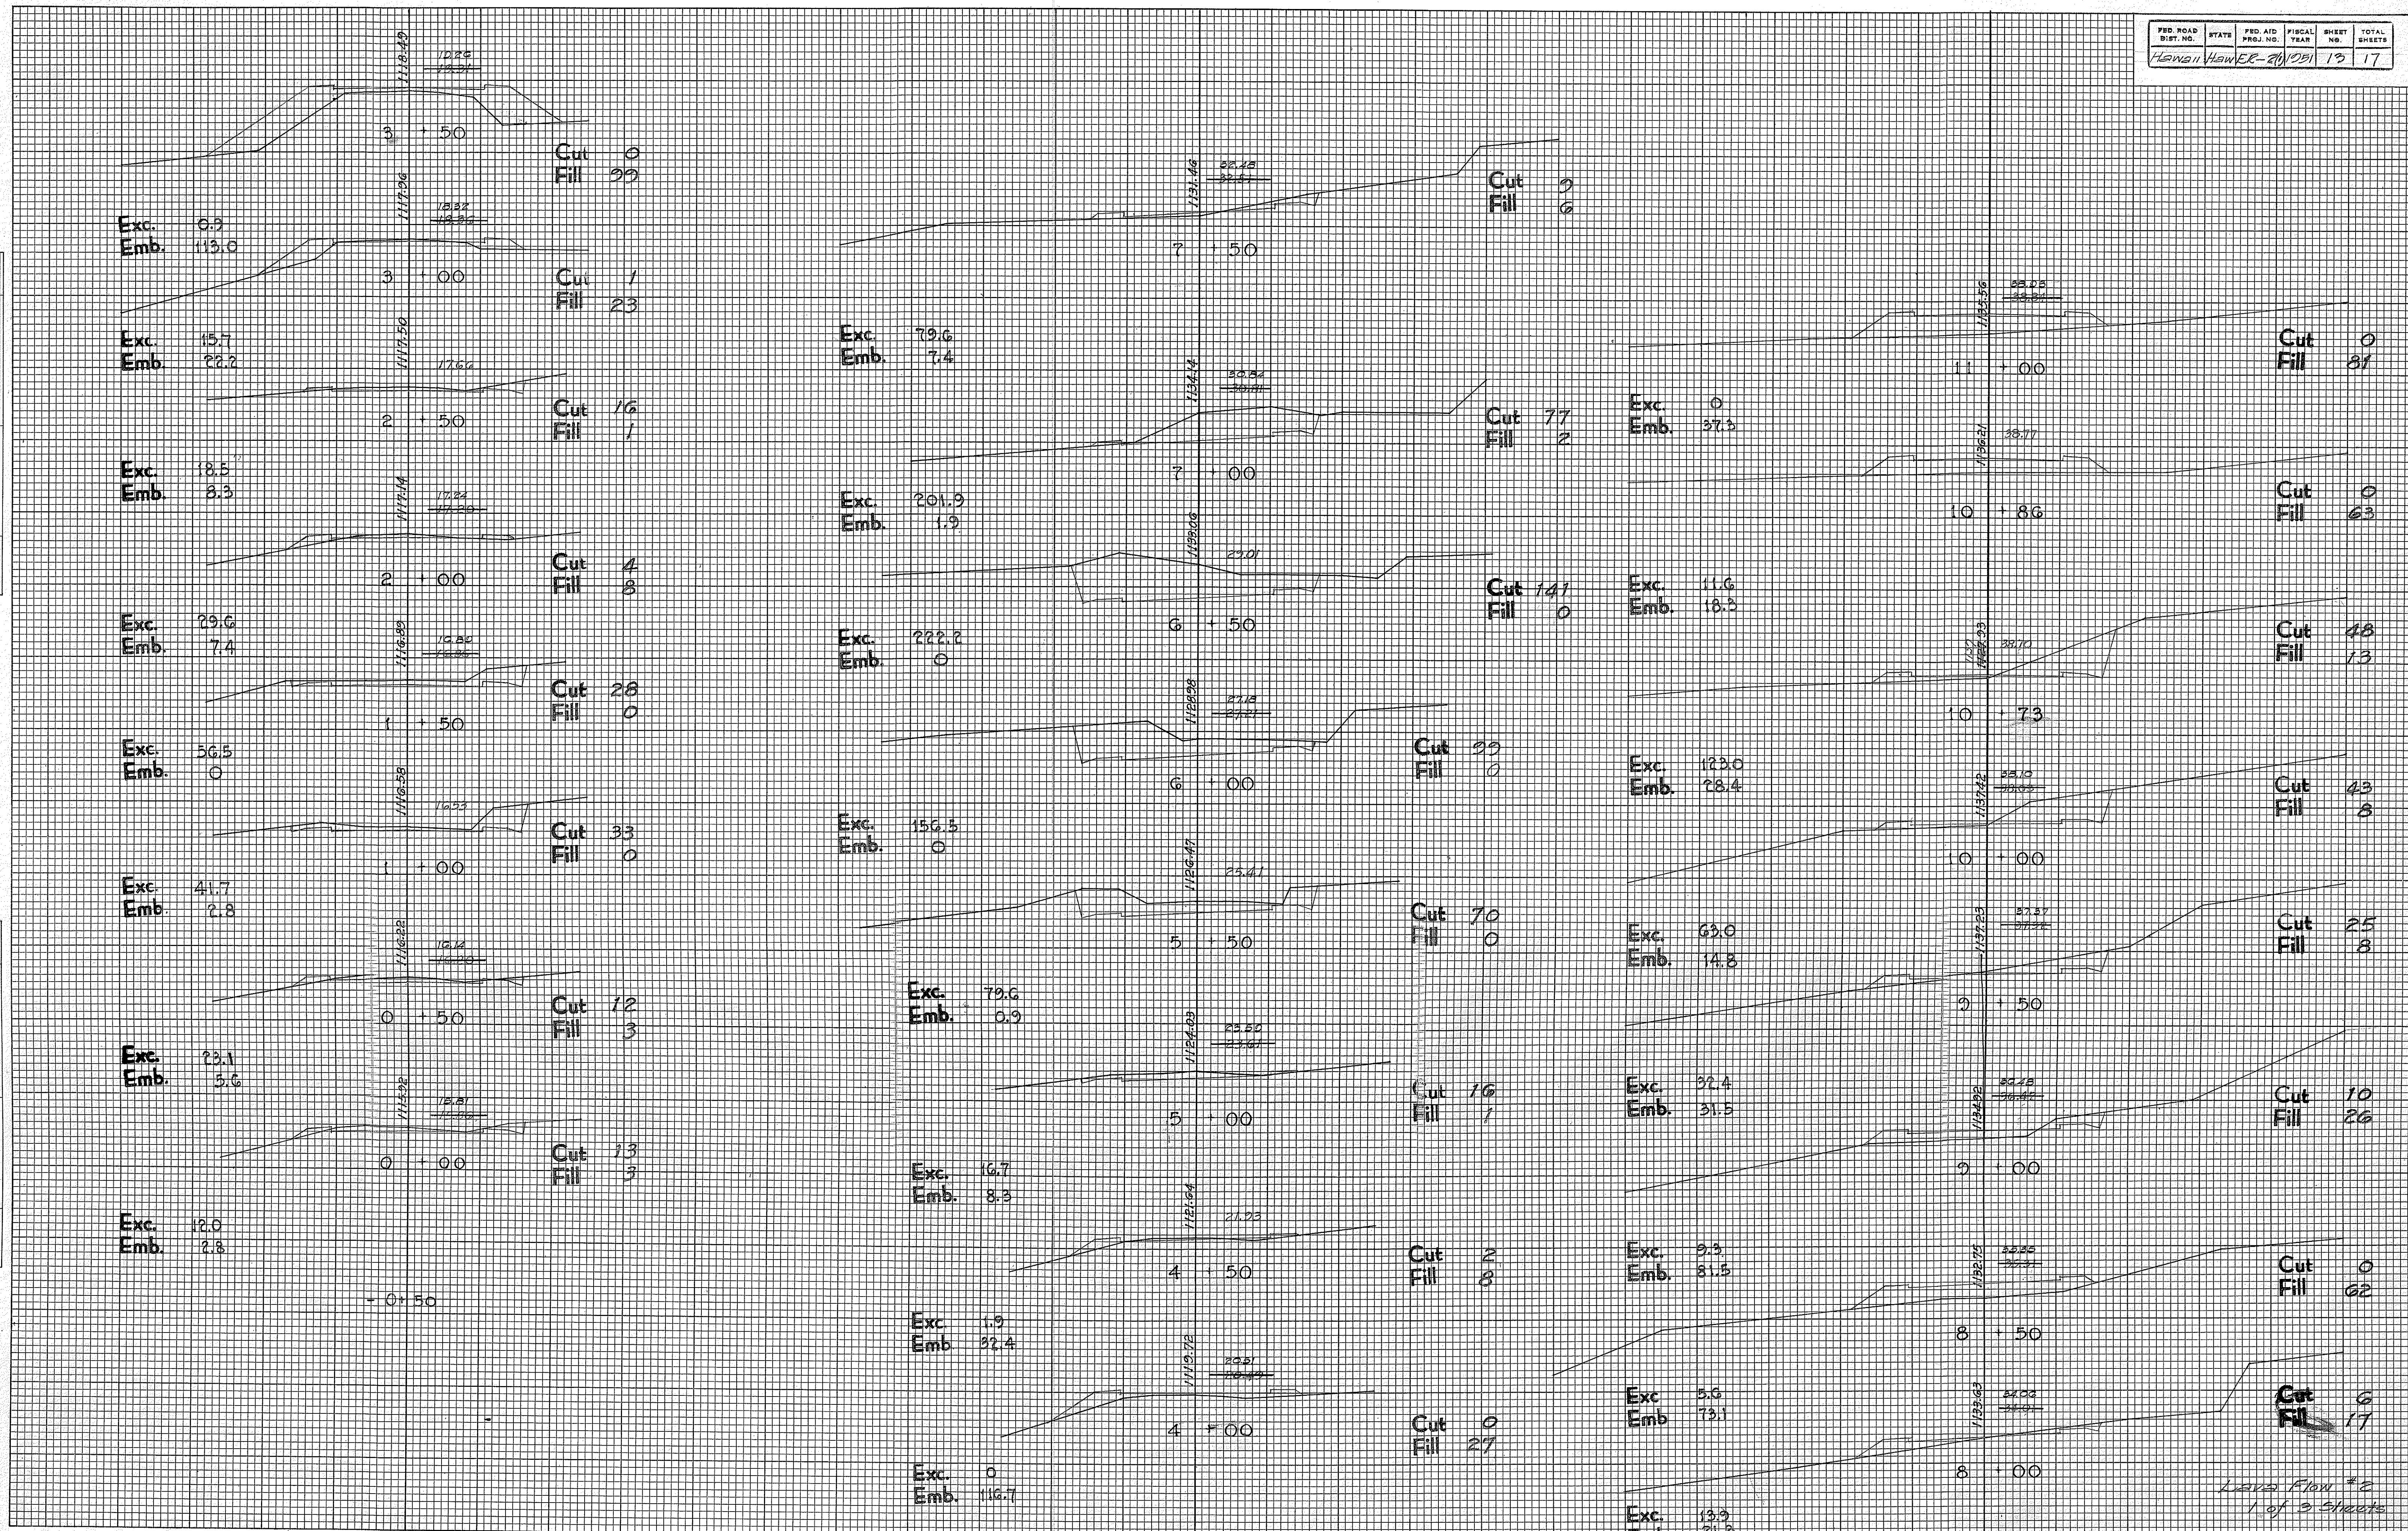

FED. ROAD DIST. NO.	STATE	FED. AID PROJ. NO.	FISCAL YEAR	SHEET NO.	TOTAL SHEETS
HAWAII	HAWAII	ER-21	1961	14	17

FINAL SURVEY	SURVEYED _____	BY _____	DATE _____
	PLOTTED _____		
	TEMPLATE _____		
	AREAS _____		
	AREAS CHECKED _____		
NOTE BOOK			
NO. _____			

ORIGINAL SURVEY	SURVEYED _____	BY	DATE
	PLOTTED _____		
	TEMPLATE _____		
	AREAS _____		
	AREAS CHECKED _____		
NO.			

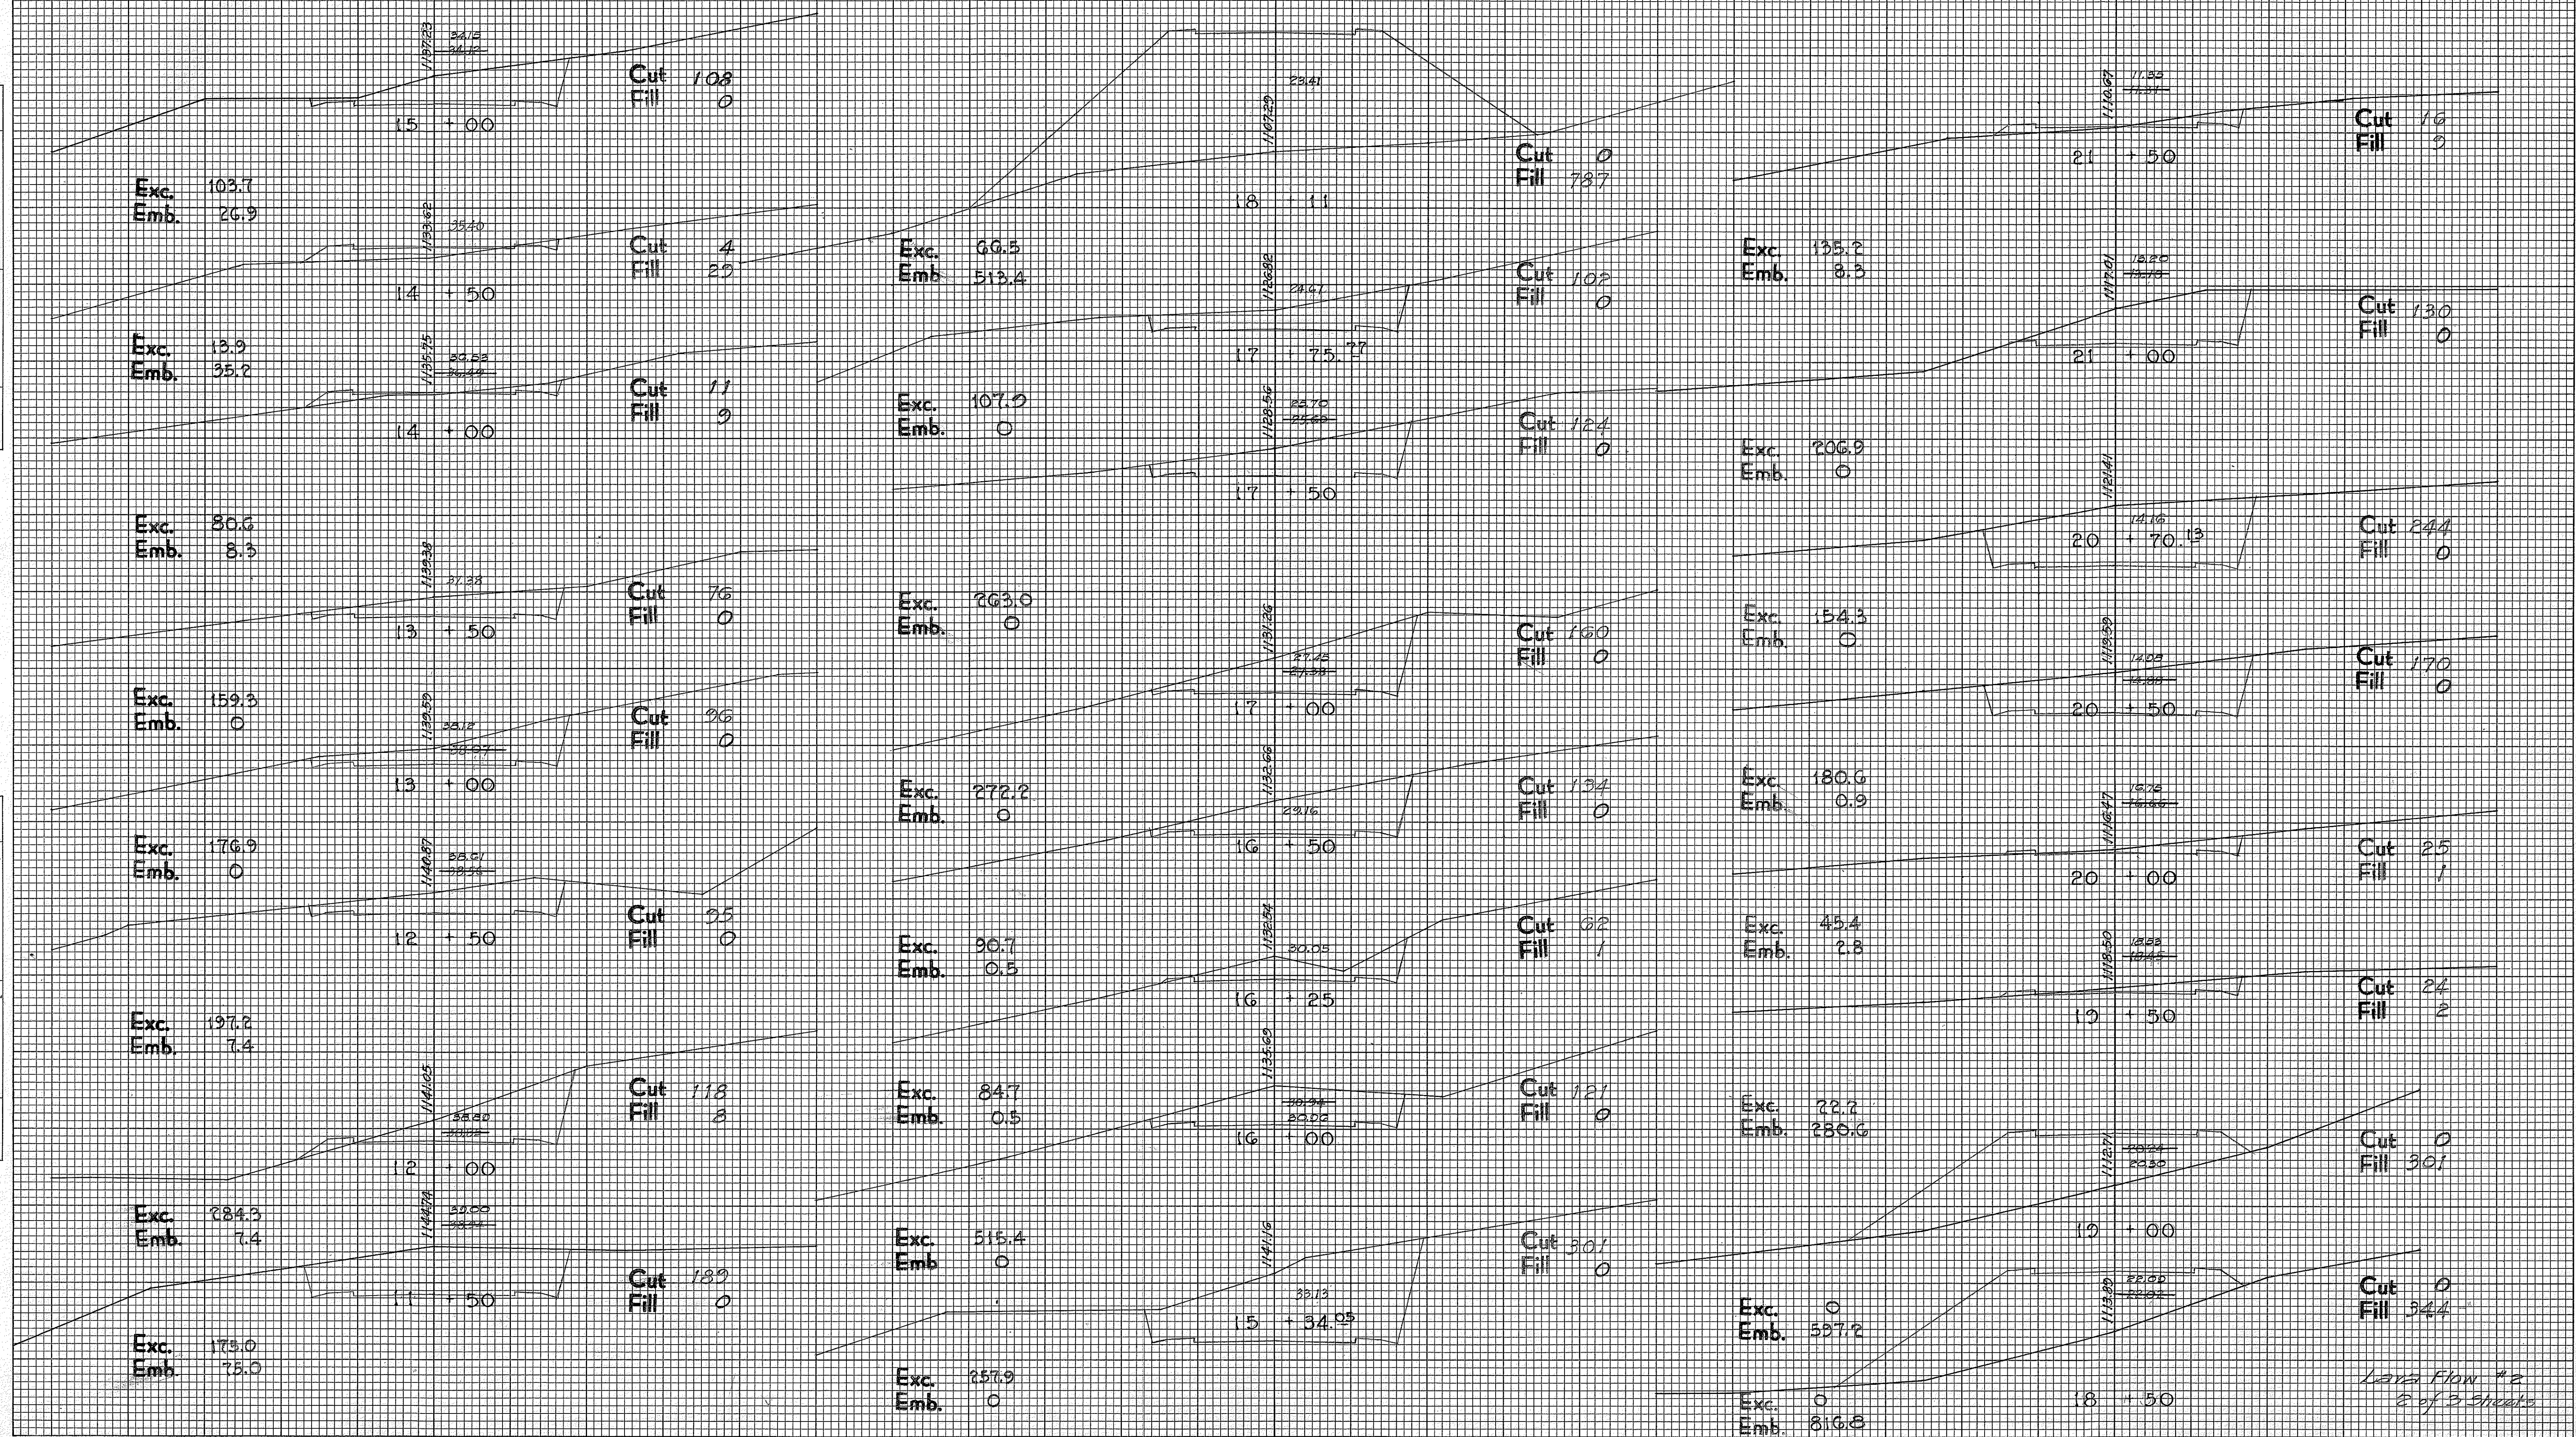

Lava Flow #2
2 of 3 Streets

FINAL SURVEY
NOTE BOOK
NO.


DATE
BY

NO. OF SHEETS
NO. OF SHEETS

ORIGINAL SURVEY
NOTE BOOK
NO.

DATE
BY

NO. OF SHEETS
NO. OF SHEETS

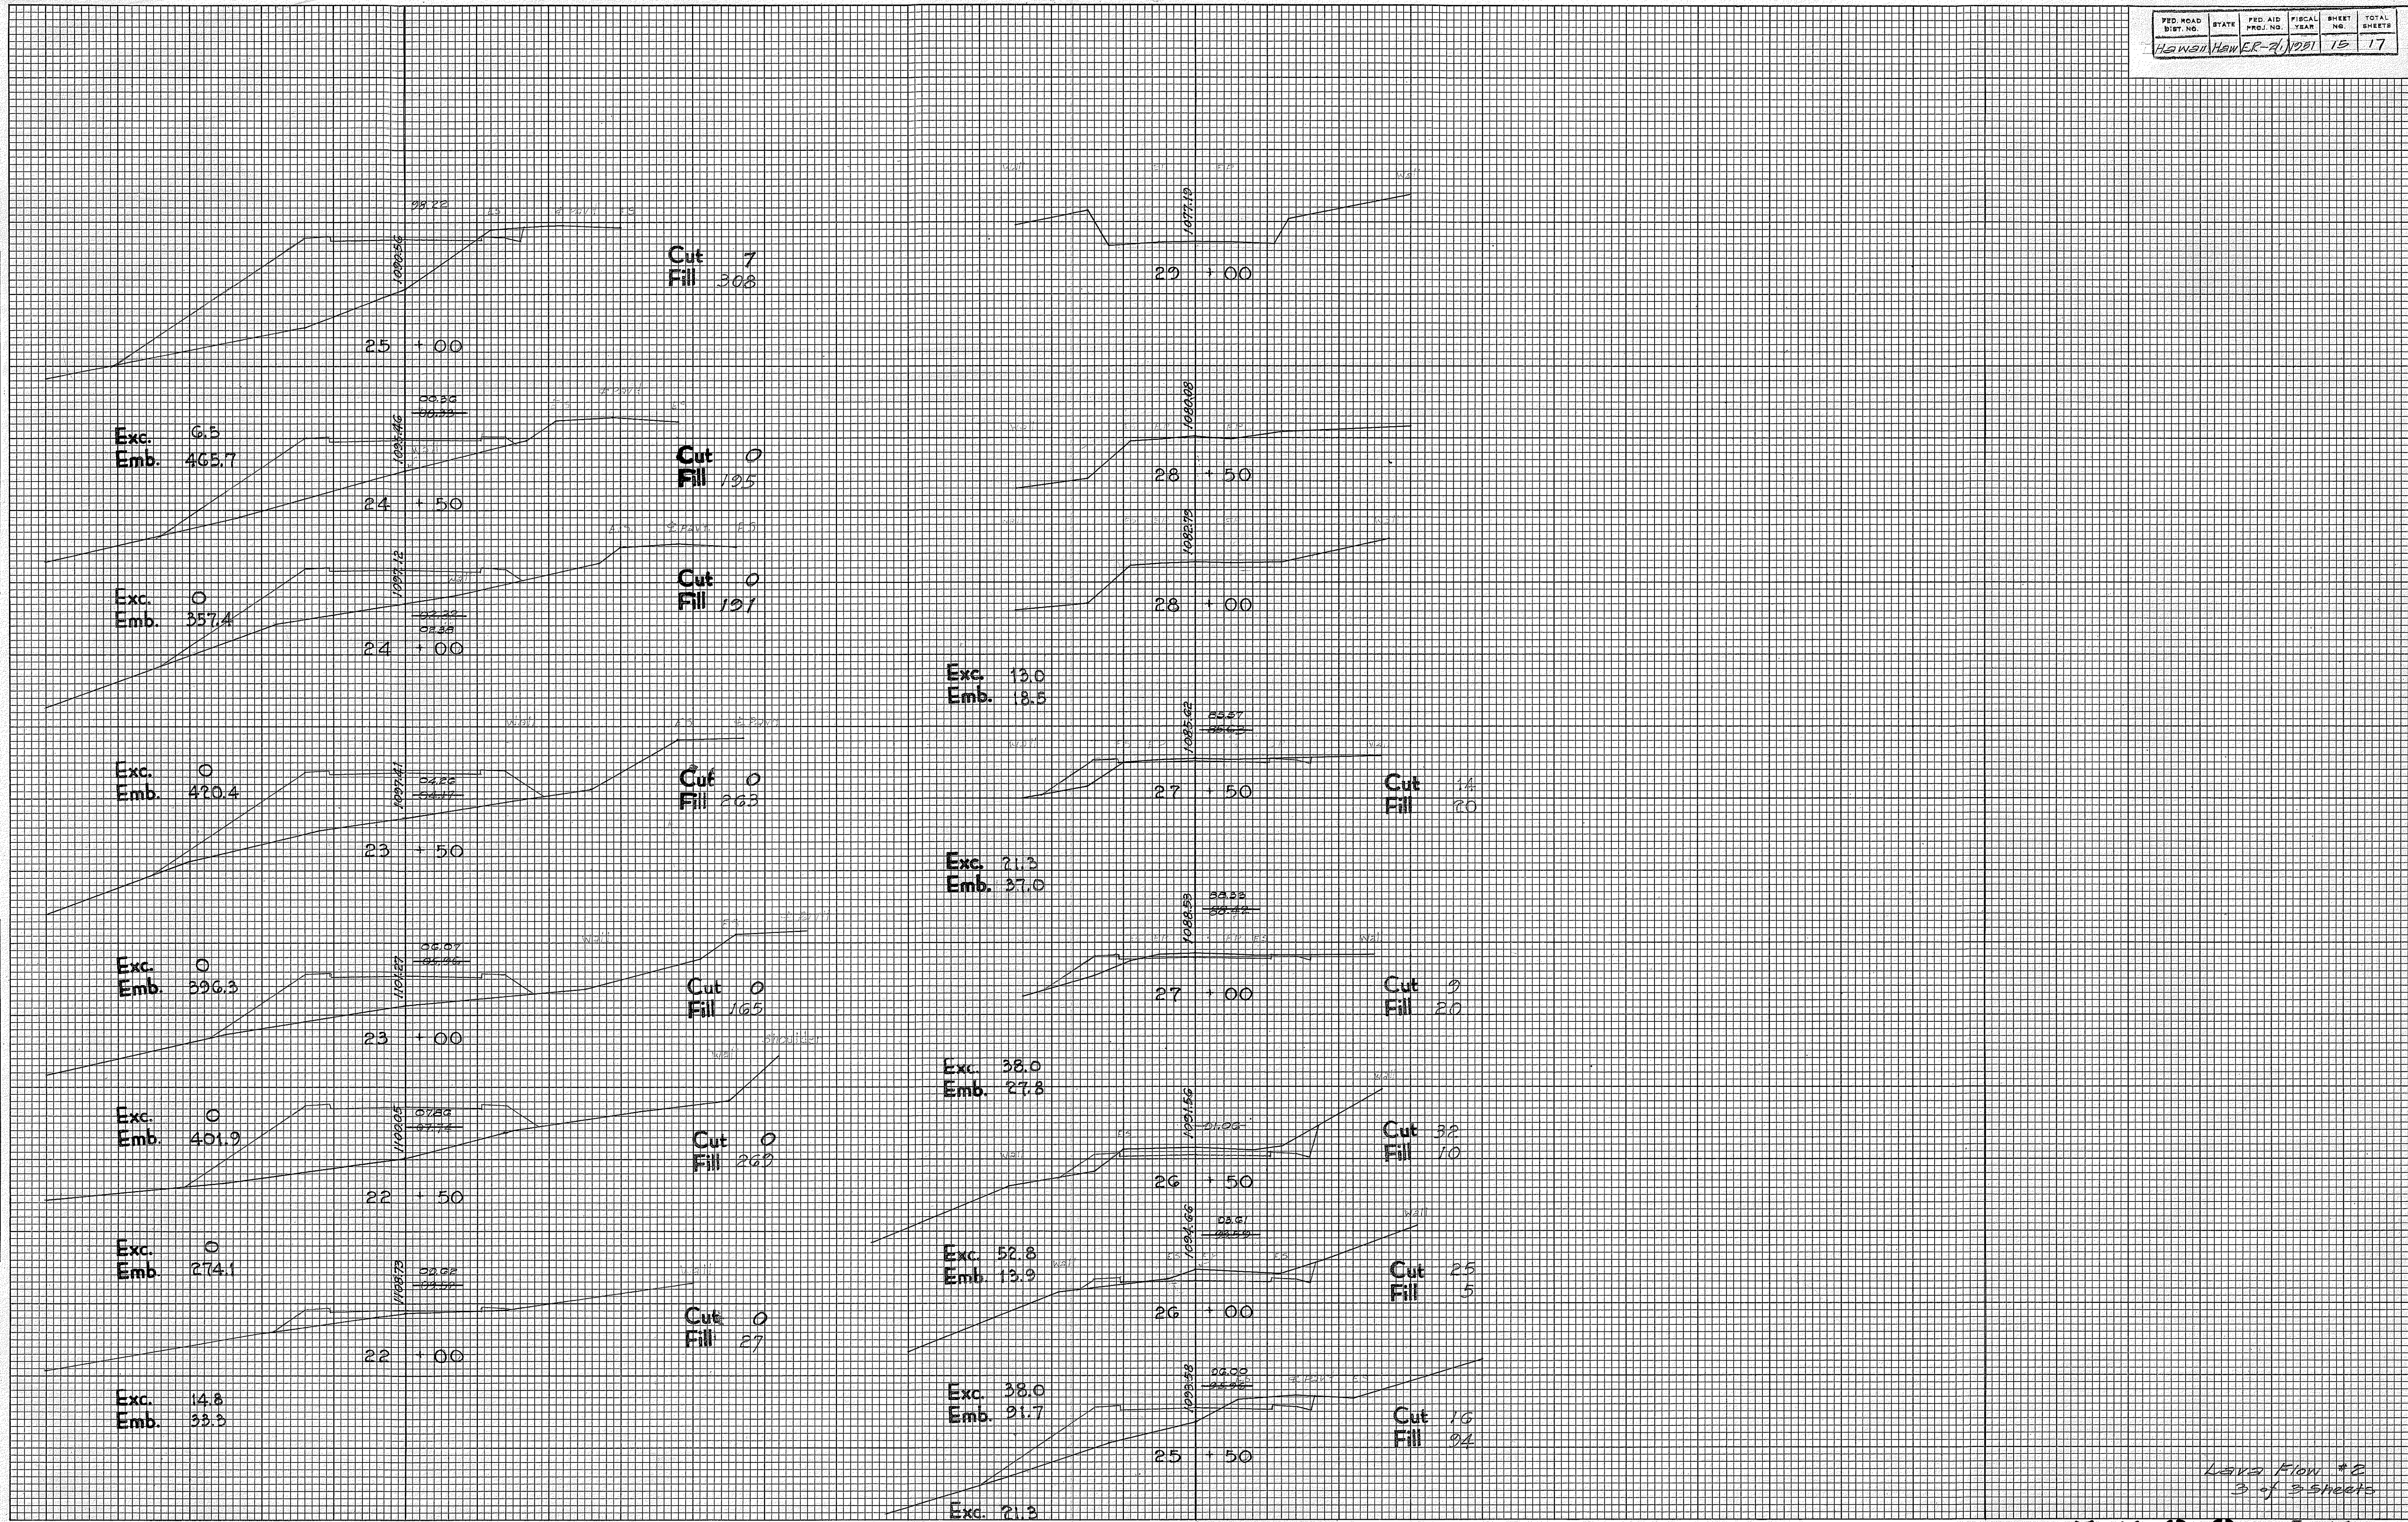

FINAL SURVEY	SURVEYED	DATE
NO.	NO.	BY
NO.	NO.	BY
NO.	NO.	BY

ORIGINAL SURVEY	SURVEYED	DATE
NO.	NO.	BY
NO.	NO.	BY
NO.	NO.	BY

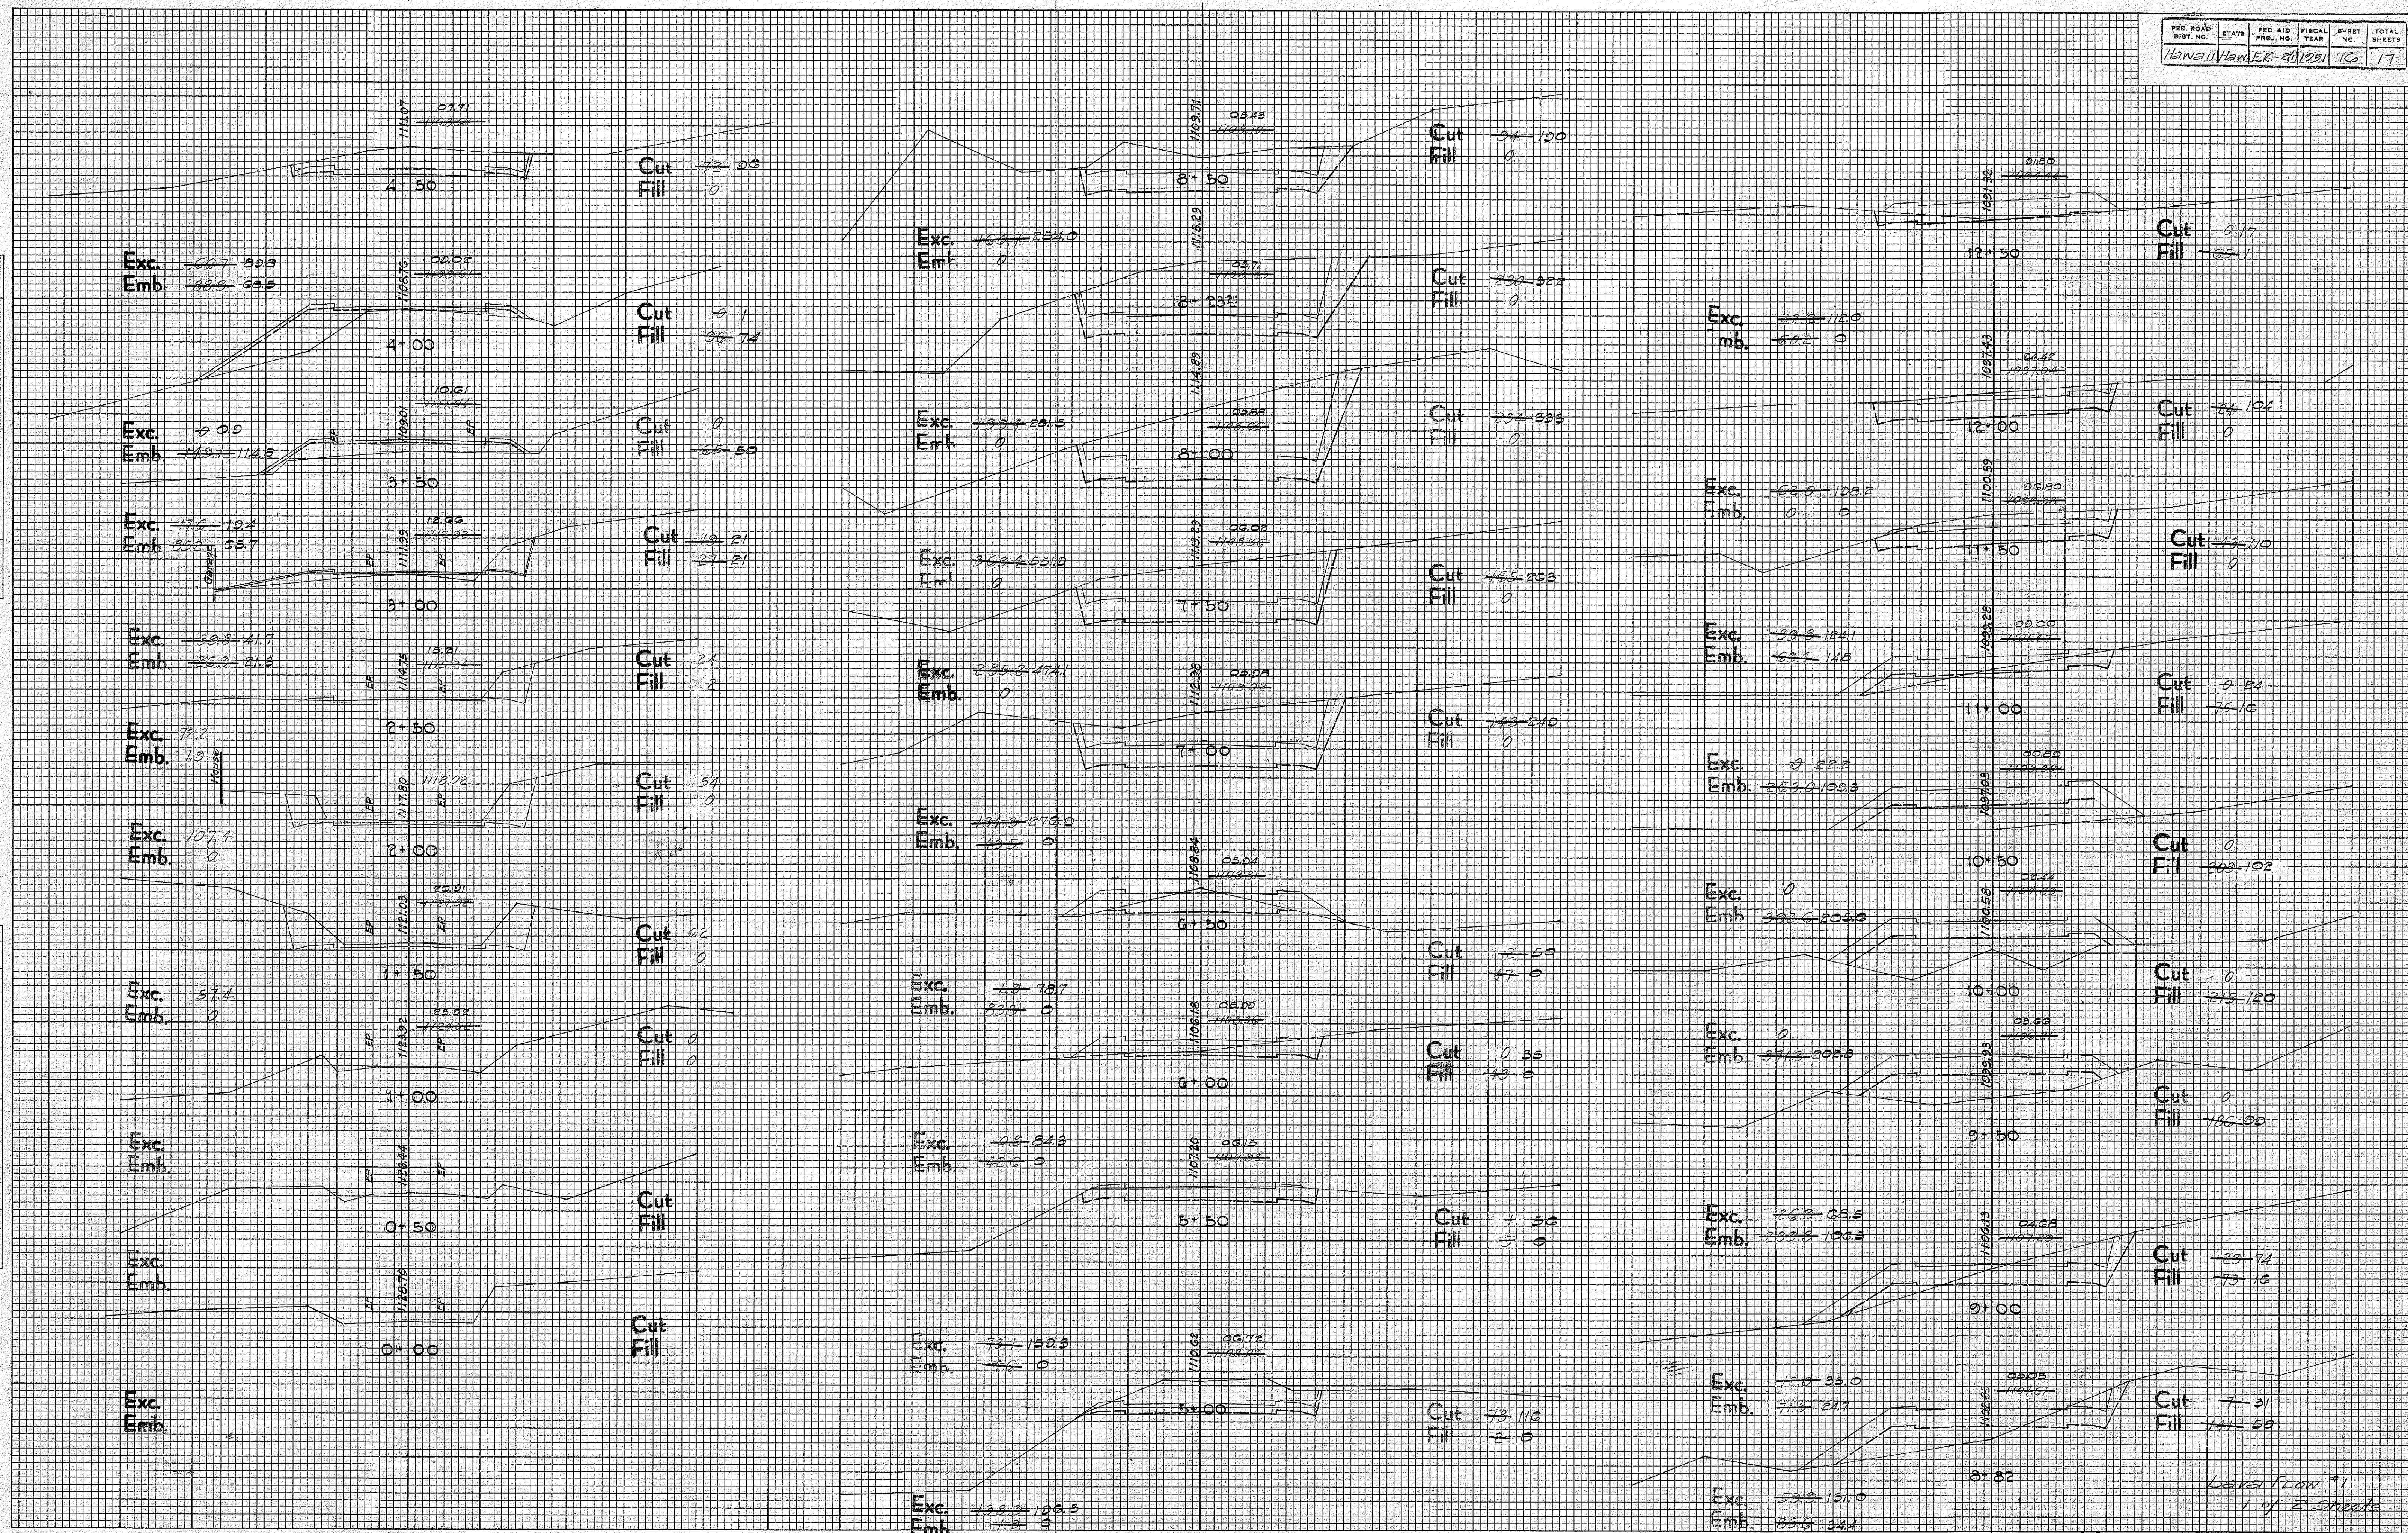


PLATE 3 - CROSS SECTION O.P.R. & R.E. STANDARD
KEUFFEL & ESSER CO., NEW YORK.

FINAL SURVEY NOTE BOOK NO. _____
 DATE _____ BY _____
 SURVEYED _____
 TEMPLATE _____
 AREAS CHECKED _____

ORIGINAL SURVEY NOTE BOOK NO. _____
 DATE _____ BY _____
 SURVEYED _____
 TEMPLATE _____
 AREAS CHECKED _____

