
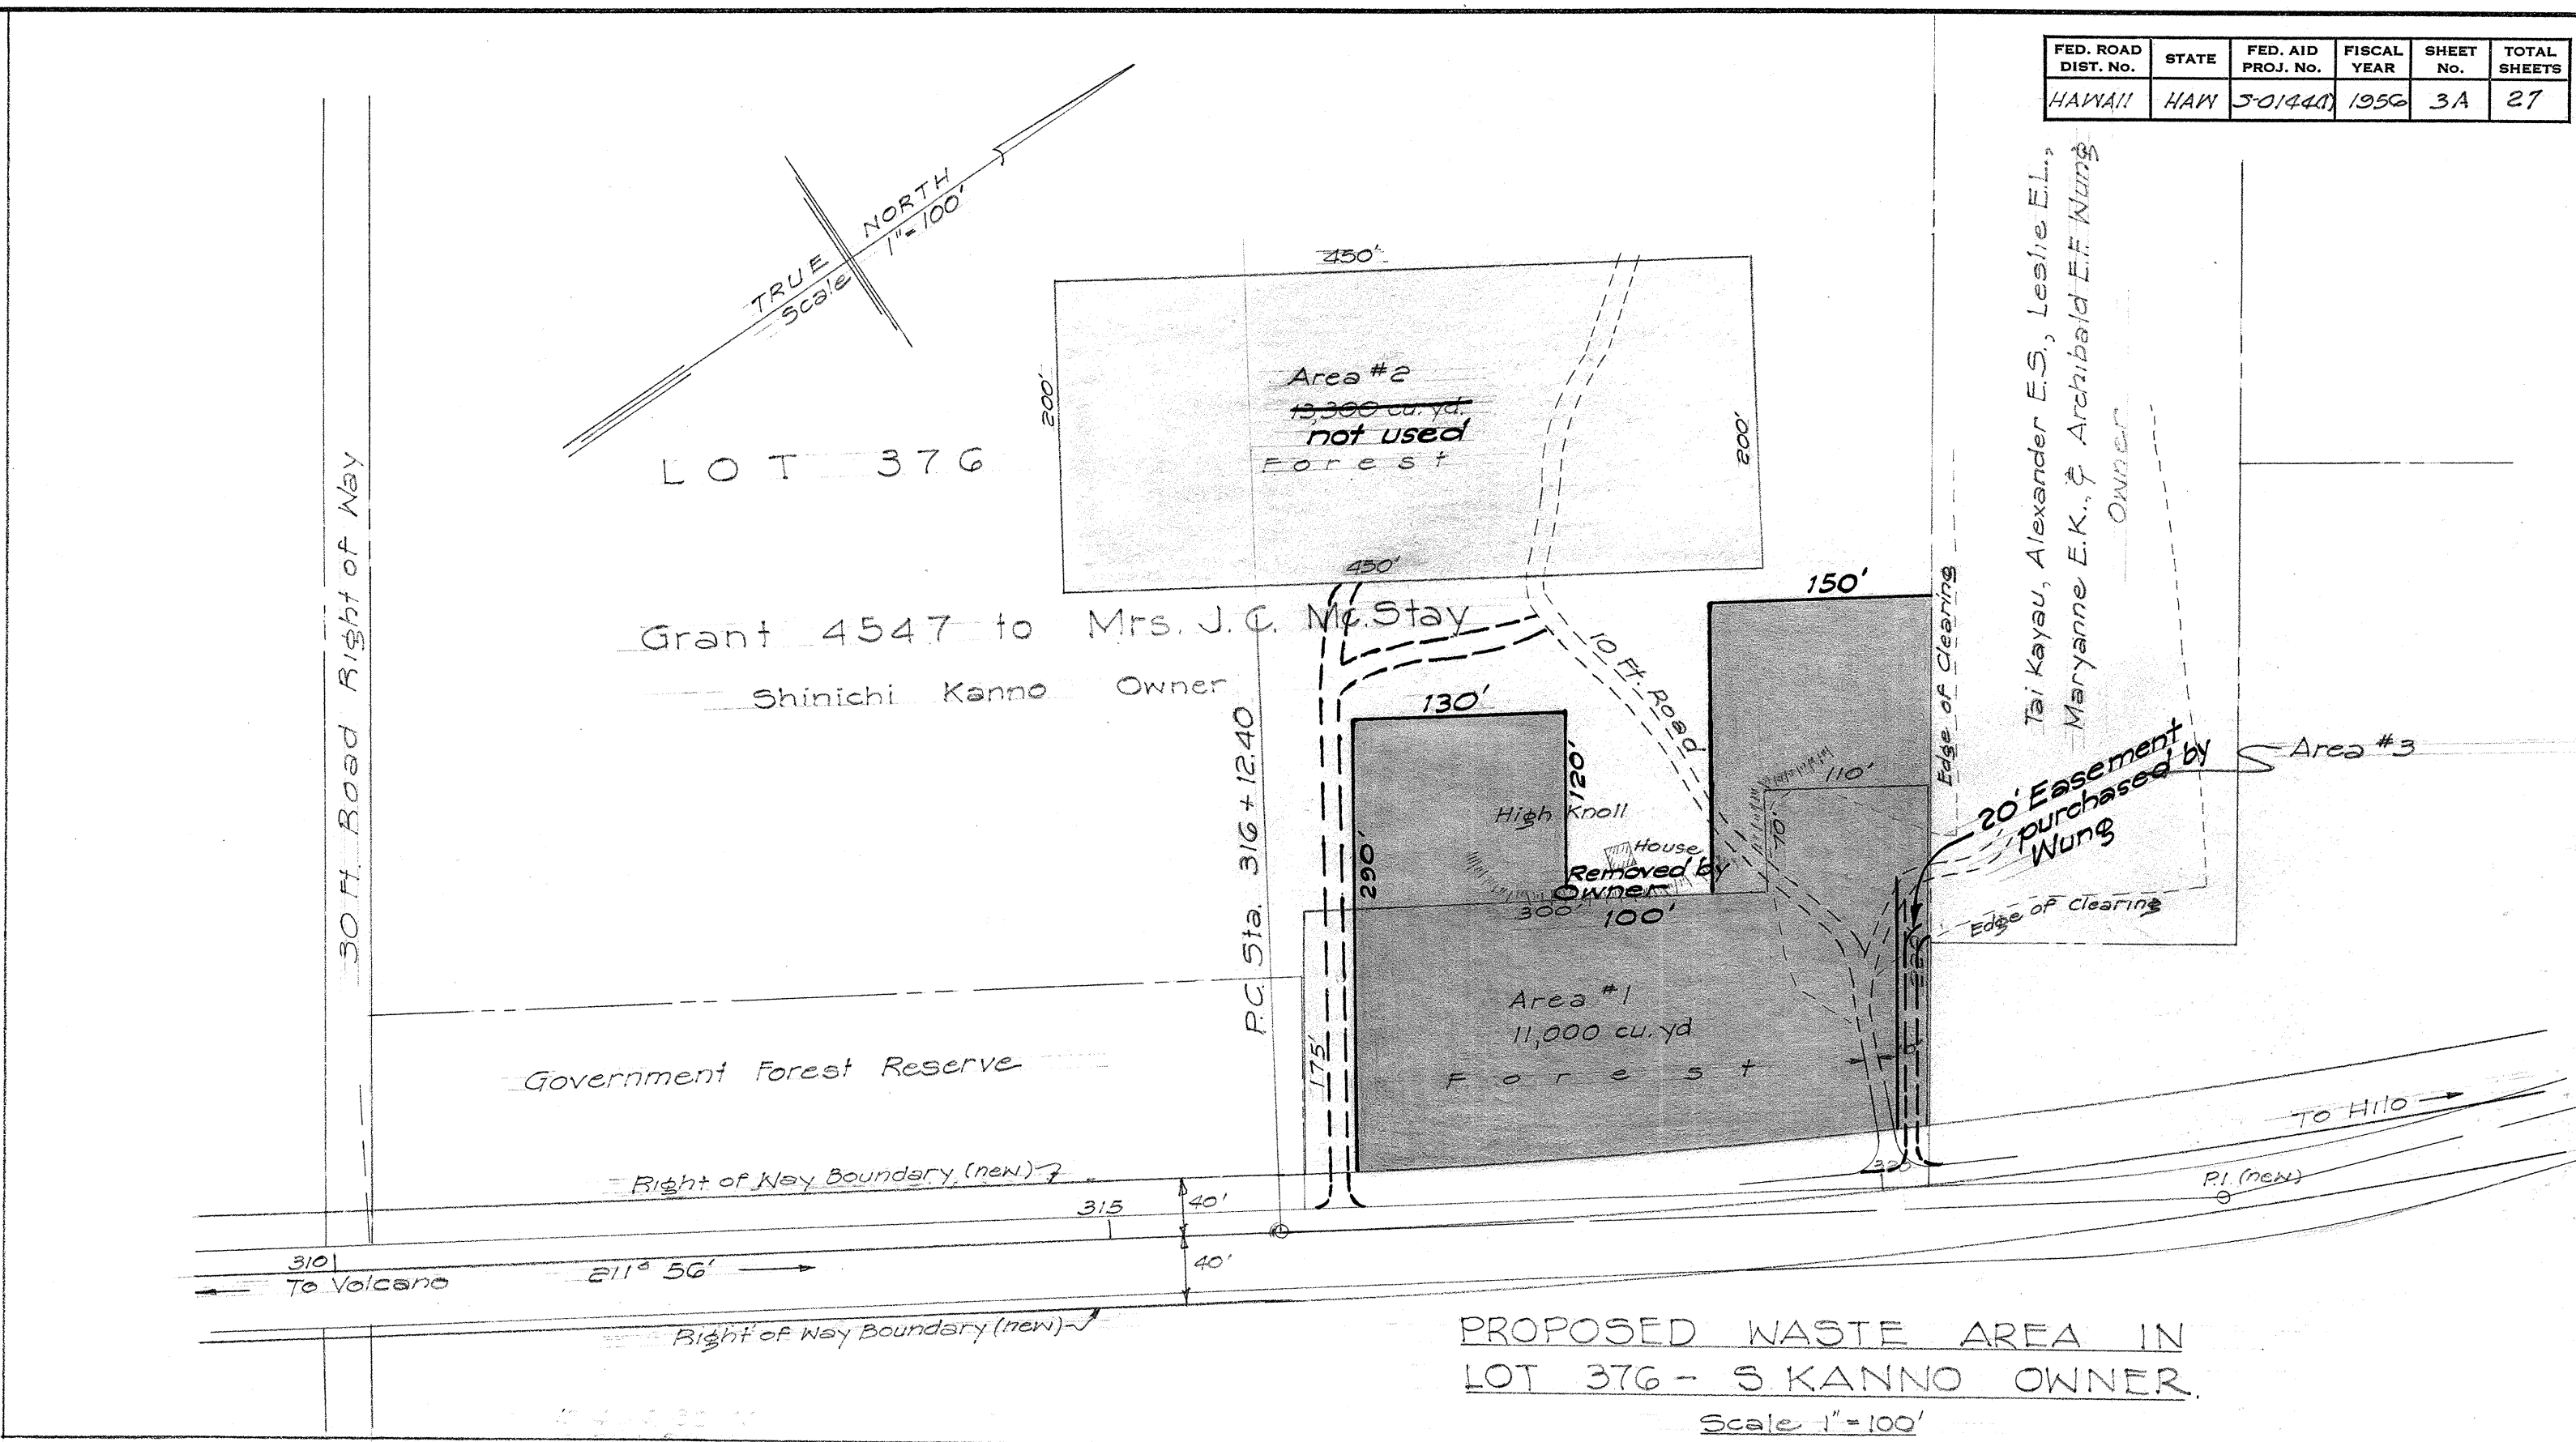


FED. ROAD DIST. NO.	STATE	FED. AID PROJ. NO.	FISCAL YEAR	SHEET NO.	TOTAL SHEETS
HAWAII	HAW	50-1441	1956	3A	27

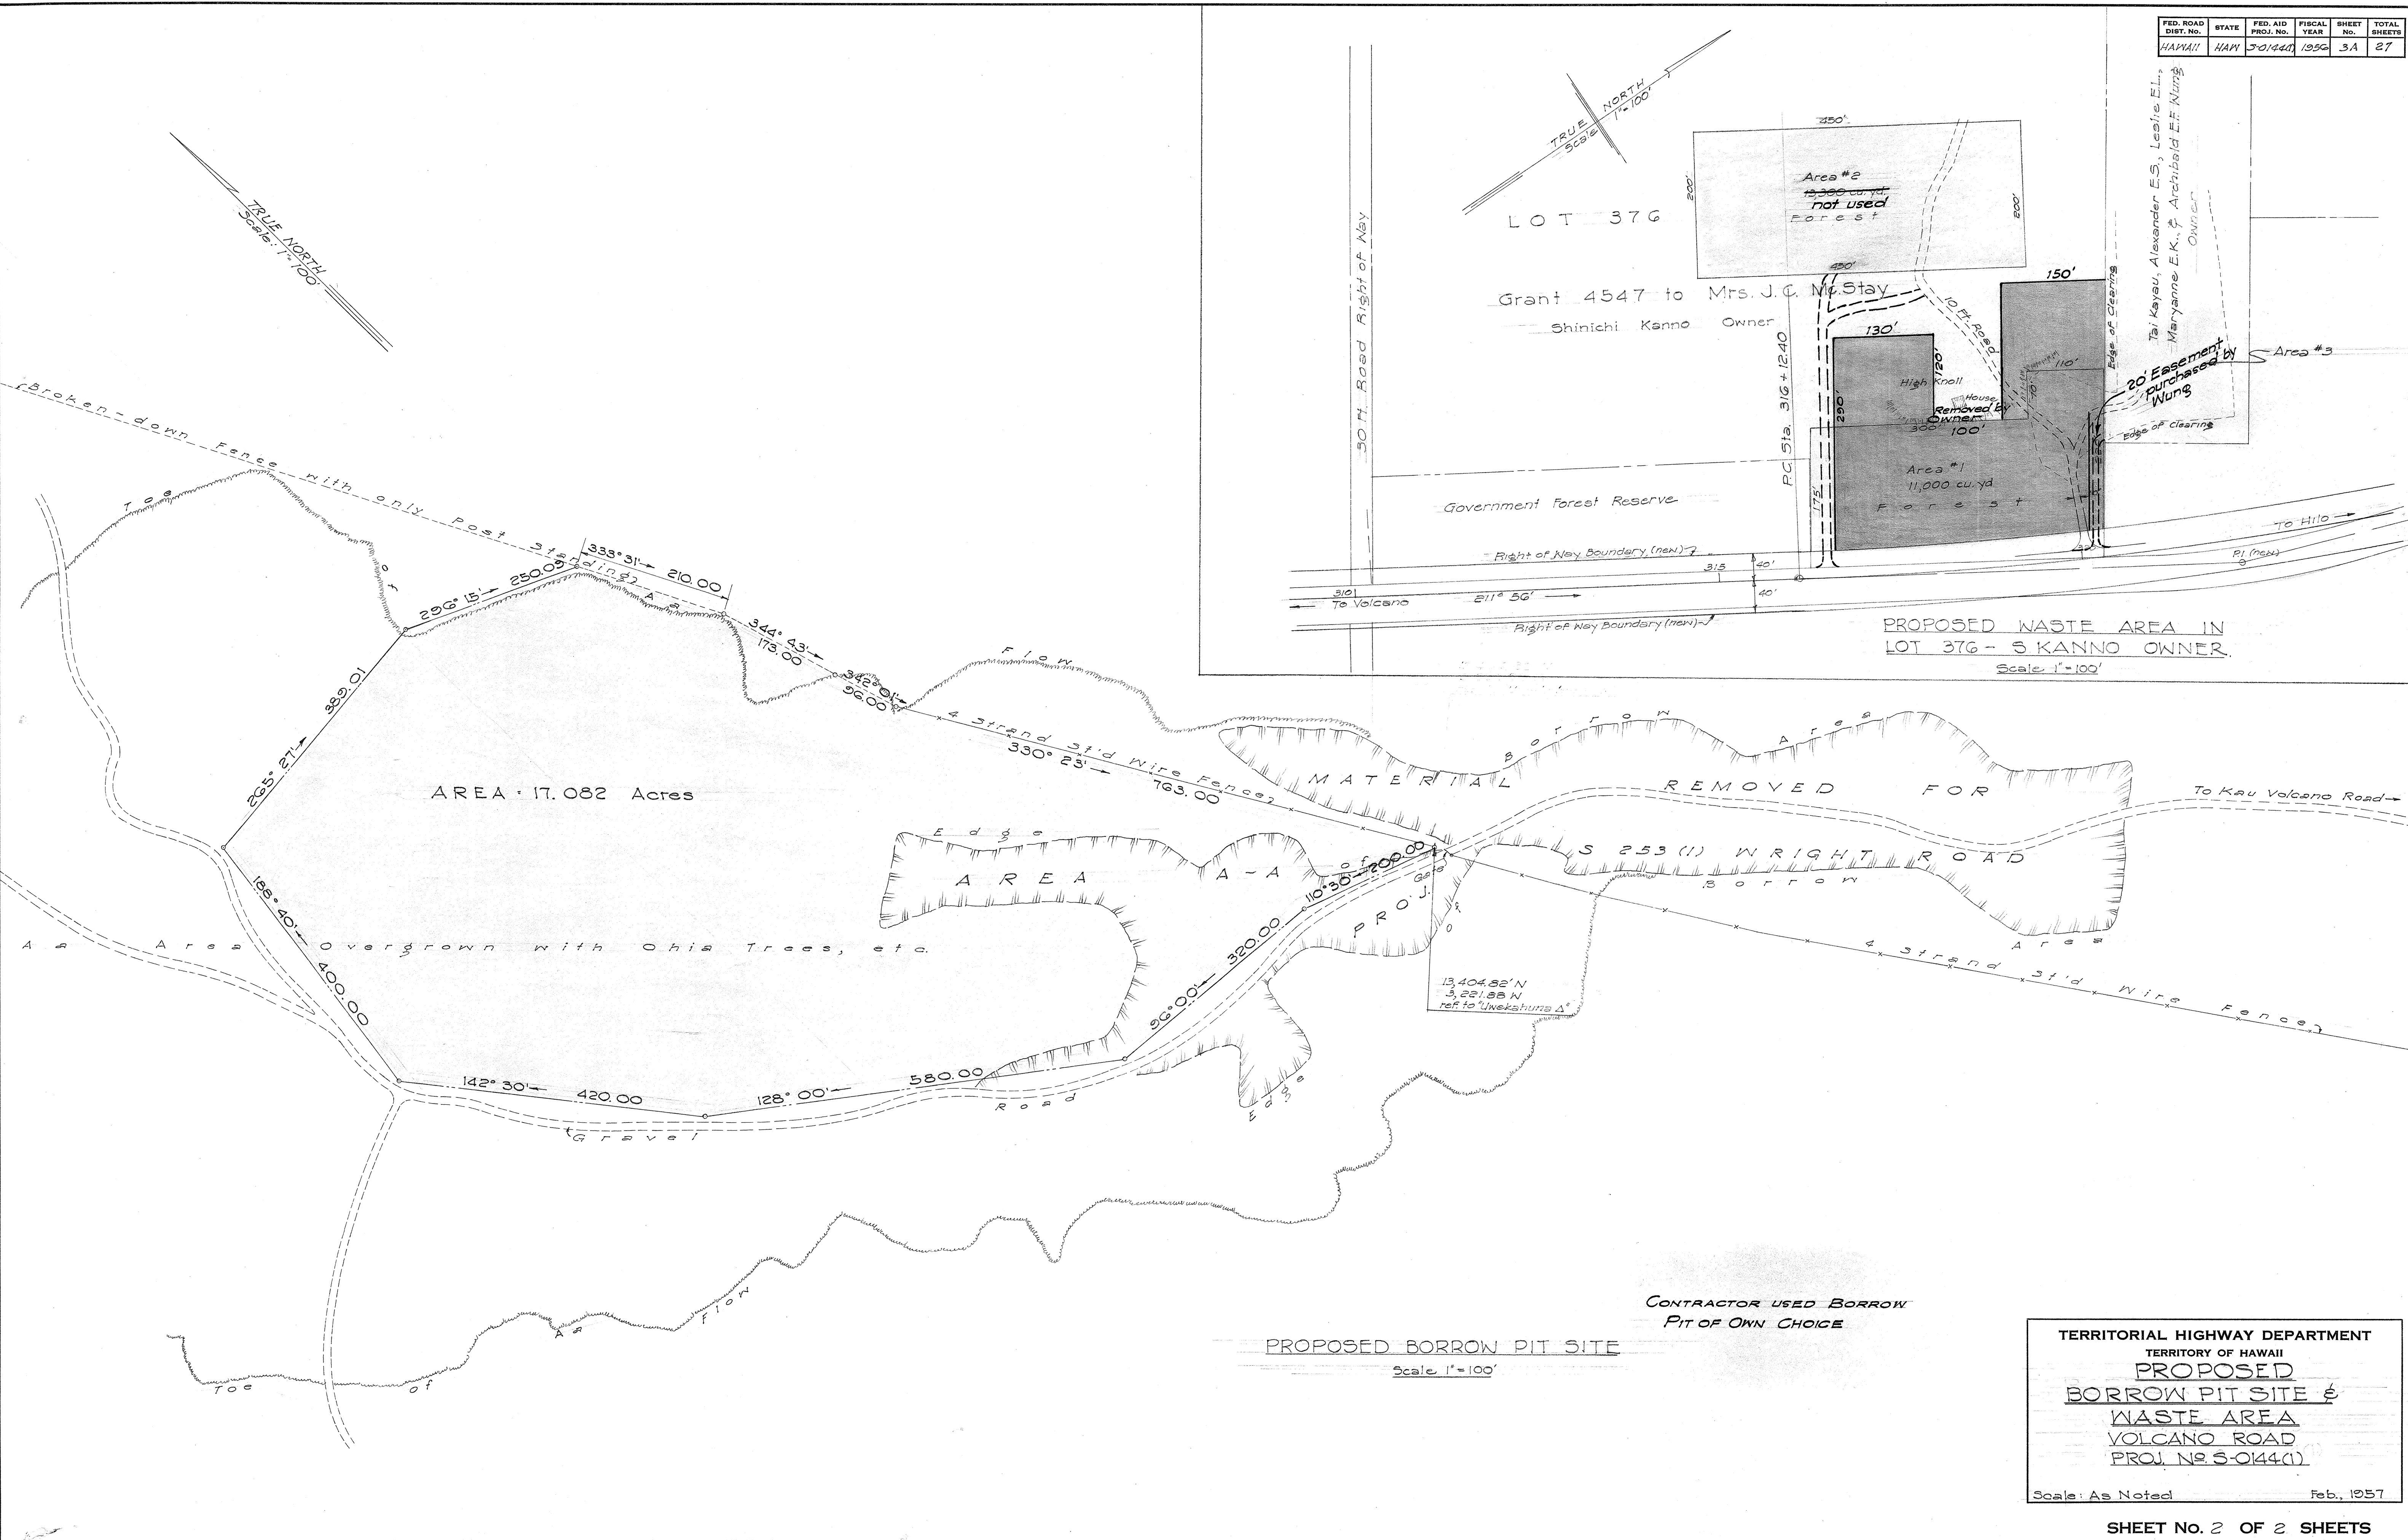

ORIGINAL PLAN No.	SURVEY PLOTTED BY	DATE
	DESIGNED BY	
	TRACED BY	
	QUANTITIES BY	
	CHECKED BY	

TERRITORIAL HIGHWAY DEPARTMENT
TERRITORY OF HAWAII

**PROPOSED
BORROW PIT SITE &
WASTE AREA**

VOLCANO ROAD
PROJ. NO S-0144(1)

Scale: As Noted Feb., 1957