

TERRITORY OF HAWAII
TERRITORIAL HIGHWAY DEPARTMENT
HONOLULU T.H.
PLANS OF

## VOLCANO ROAD

FEDERAL AID SECONDARY PROJECT Nº S-0144(1)

DISTRICT OF PUNA
ISLAND OF HAWAII

SCALES


PLAN\_\_\_\_\_ | INCH = 100 FT.


PROFILE \_\_\_\_\_ HOR. | INCH = 100 FT.

VER. | INCH = 10 FT.

CROSS SECTION \_\_\_\_ HOR. | INCH = 10 FT.

VER. | INCH = 10 FT.

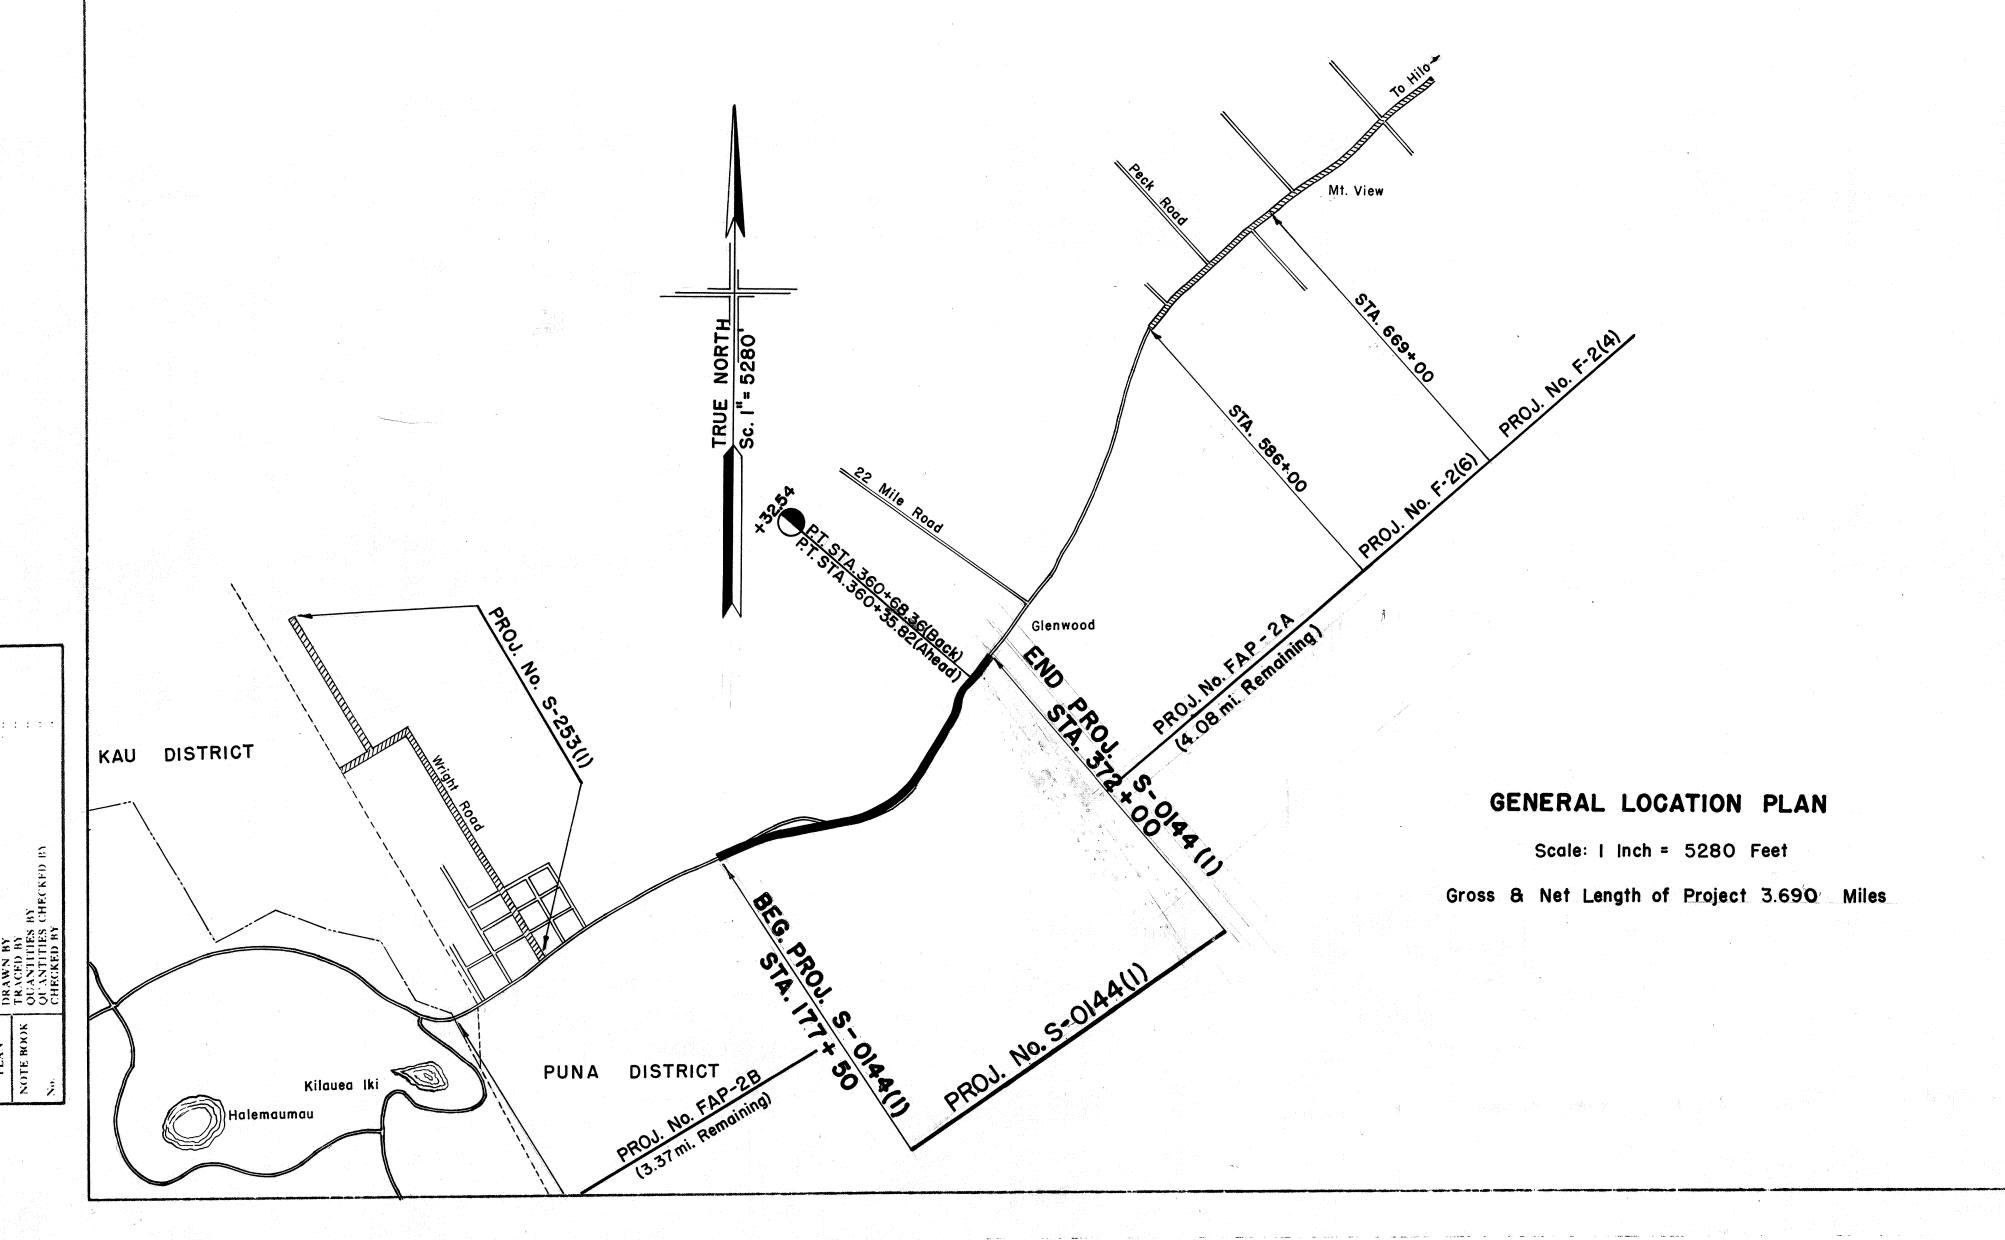

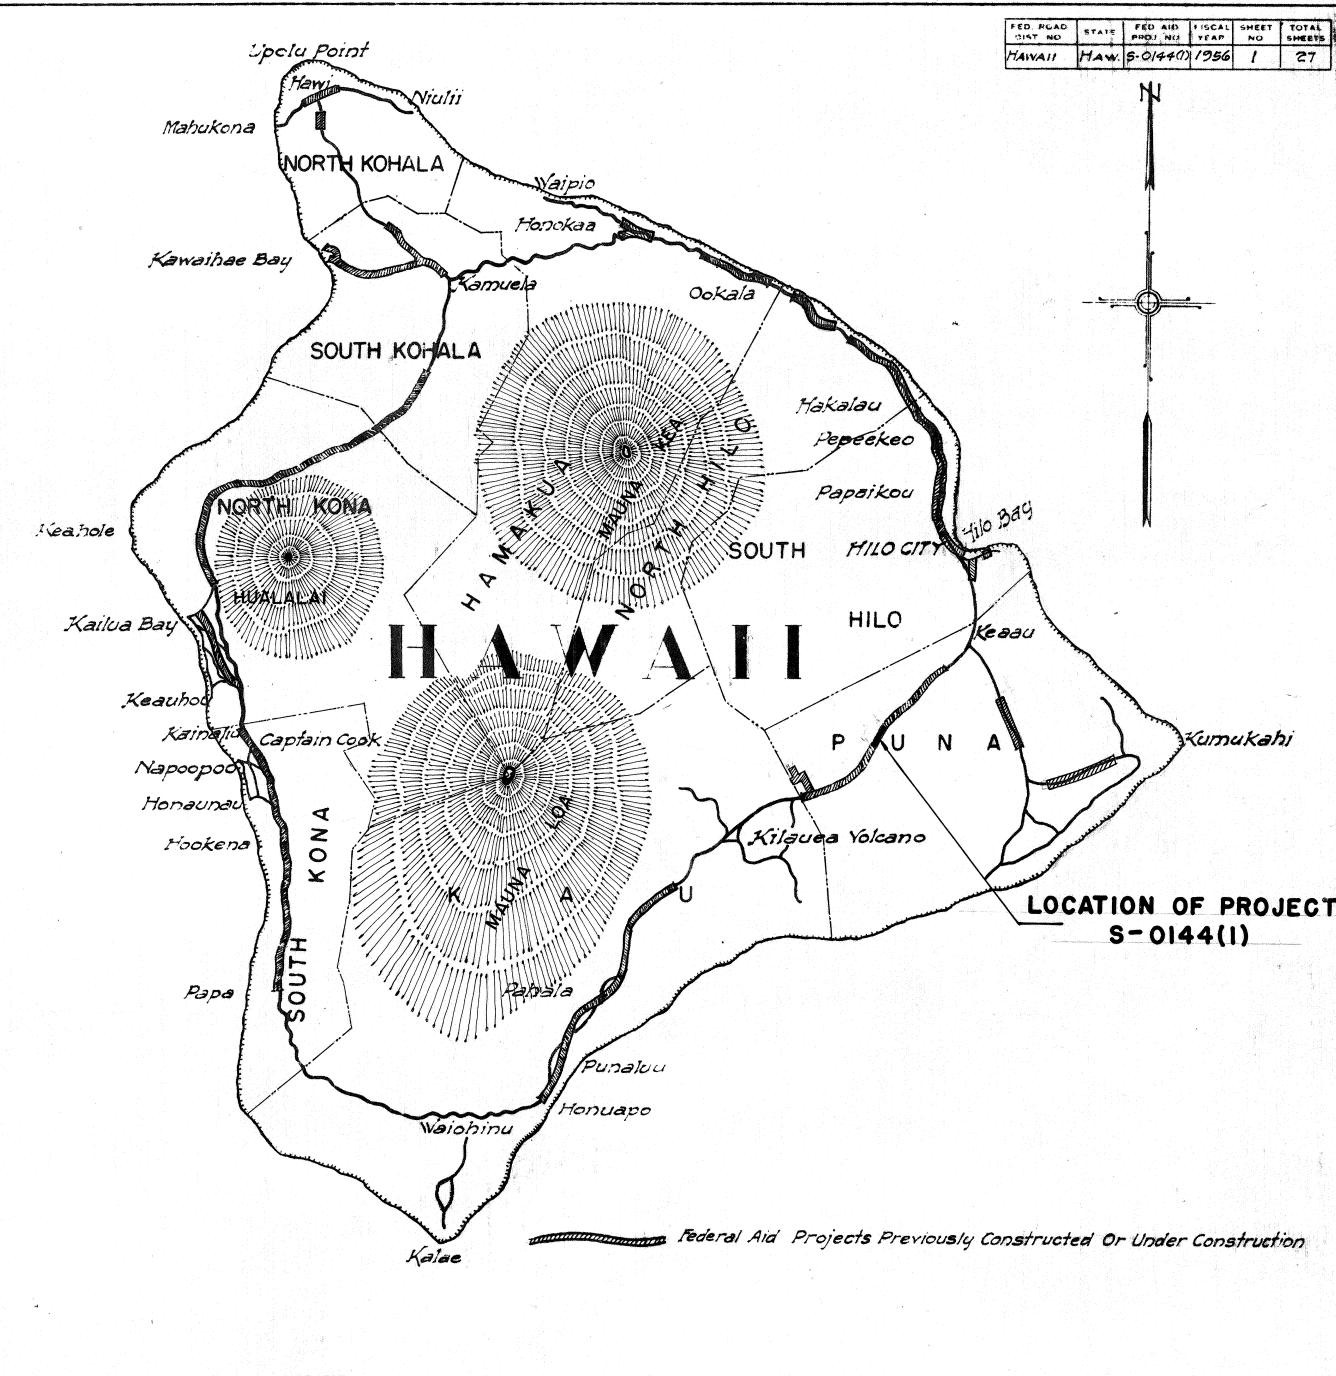

NOTE:


L CHANGES MADE DURING CONSTRUCTION

IAVE BEEN NOTED IN RED ON THESE

TRACINGS AND CHECKED BY:

DISTRICT ENGINEER

10/9/58 DATE

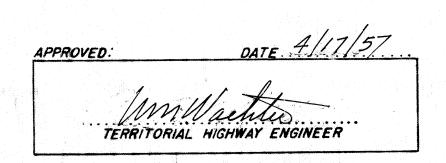

		RTMENT AU OF 1	Specification of the second		1
APPROVE	<b>?</b>				
DI.	STRICT	ENGINEL	:R	C	ATE