

INDEX TO DRAWINGS	
SHEET	DESCRIPTION
1	TITLE SHEET
2	TYPICAL SECTIONS
3-11	PLAN & PROFILE
12-13	CONNECTION DETAILS
14-16	CONCRETE UNDERPASS
17-25	STANDARD & MISC. DETAILS
26-59	CROSS SECTIONS

STATE OF HAWAII
DEPARTMENT OF TRANSPORTATION
DIVISION OF HIGHWAYS
"AS-BUILT" PLANS OF
VOLCANO ROAD
OLAA TO 0.6 MILES SOUTH OF PANAewa STREAM
FEDERAL AID PROJECT NO. FOII-2(2)
DISTRICTS OF PUNA & SOUTH HILO
ISLAND OF HAWAII

SCALES
PLAN
PROFILE
GROSS SECTION

HOR.

VERT.

HOR.


VERT.

1 IN. = 100 FT.

1 IN. = 100 FT.


1 IN. = 10 FT.

1 IN. = 10 FT.

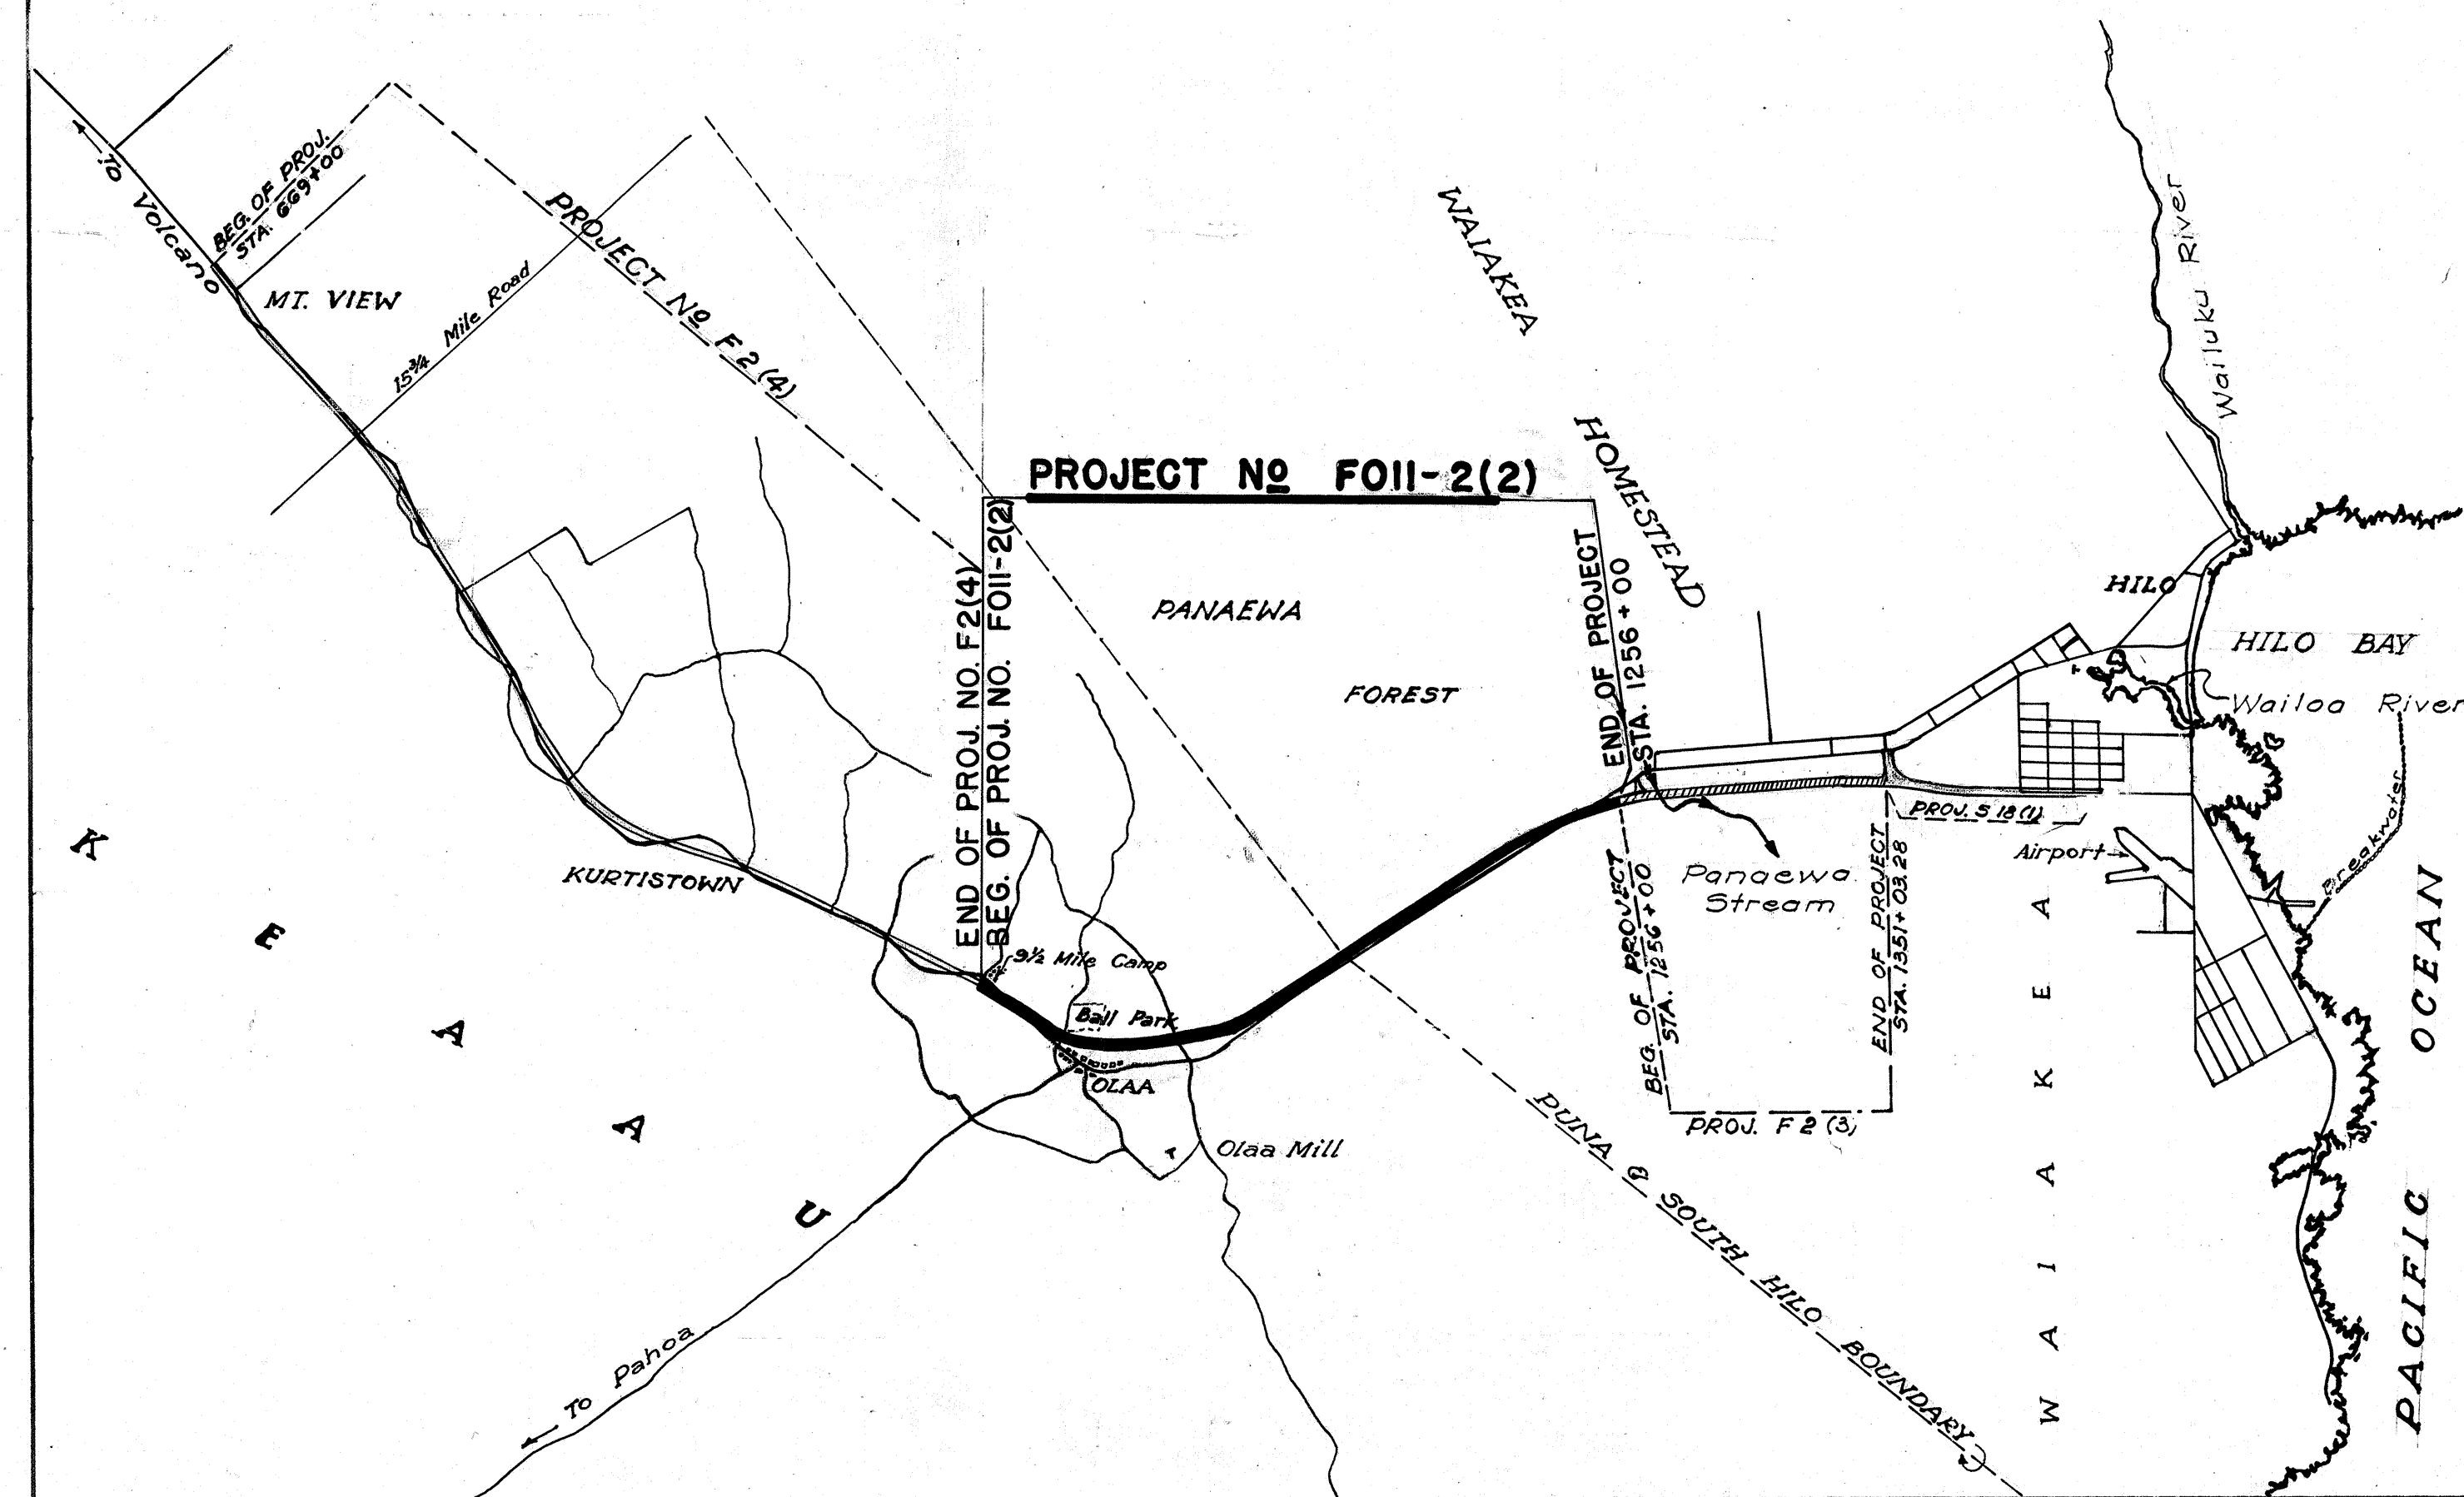

True North

GENERAL LOCATION PLAN
Scale: 1 Inch = 5208.33 Feet
Gross & Net Length of Project: 4.330 Miles

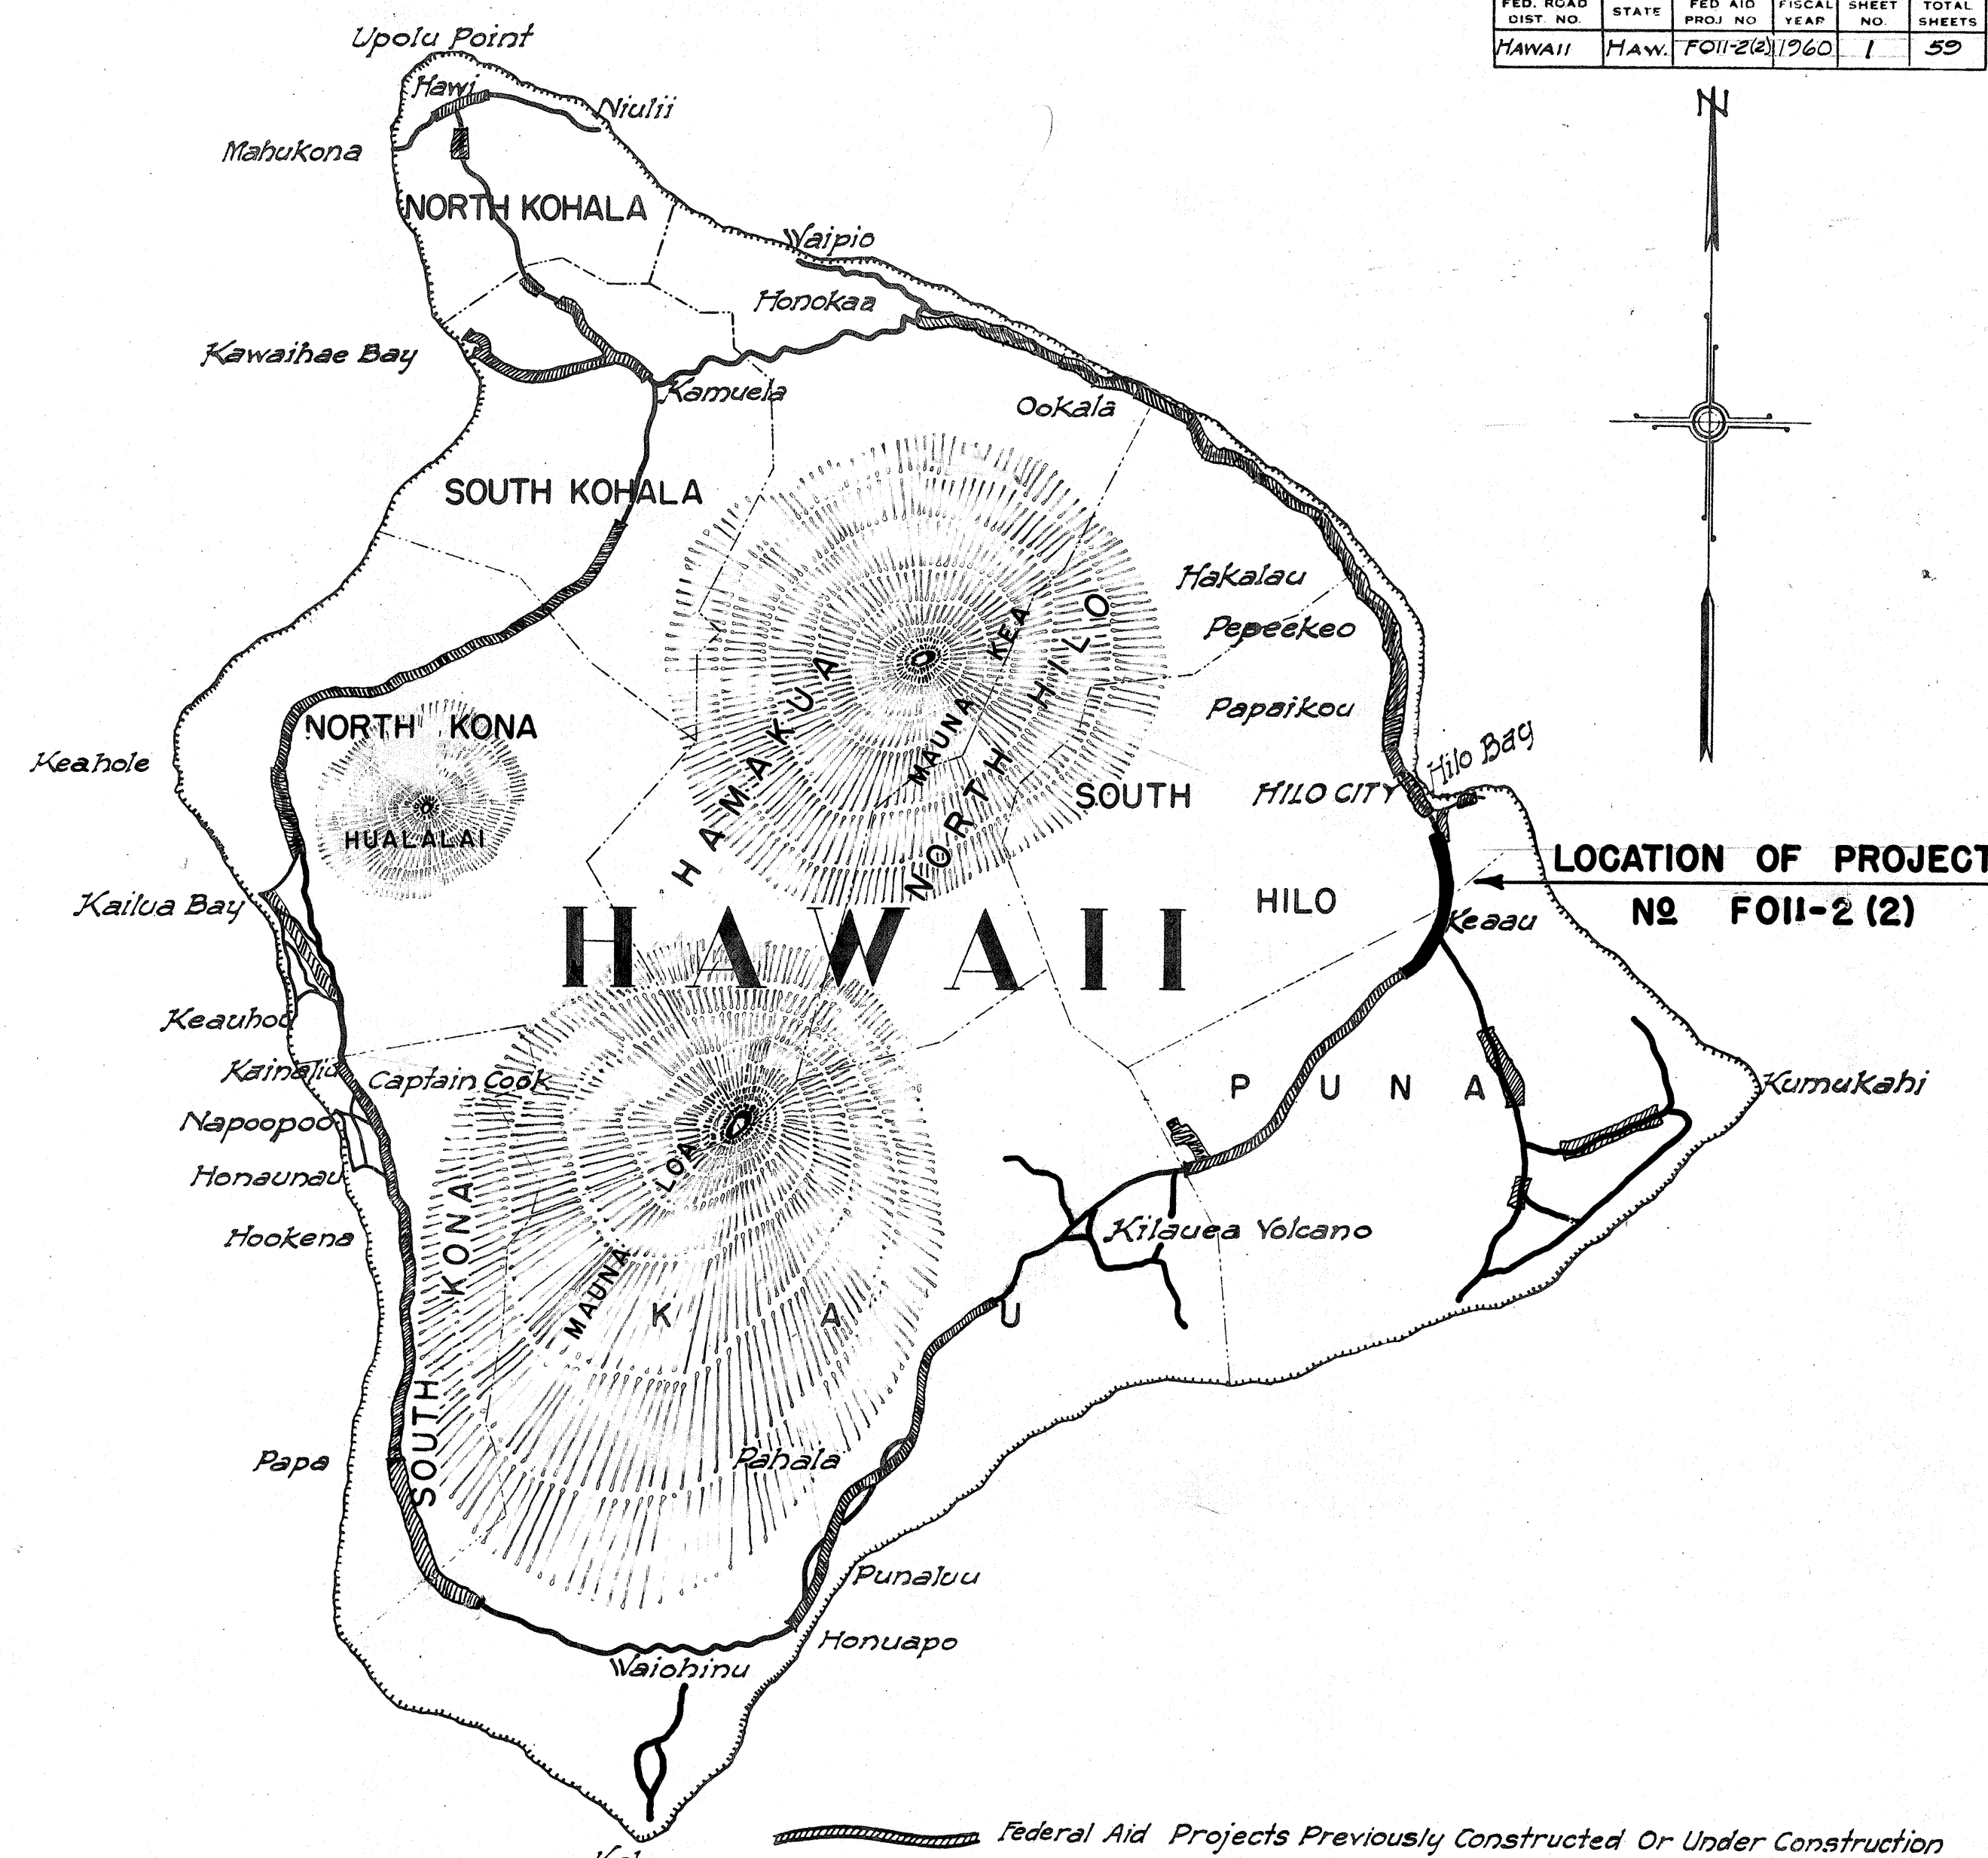

NOTE: ALL CHANGES MADE DURING
CONSTRUCTION HAVE BEEN NOTED
IN RED ON THESE TRACINGS
AND CHECKED BY:

Howard C. Allen

PROJ. ENGINEER

6/21/63

DATE

DEPARTMENT OF COMMERCE
BUREAU OF PUBLIC ROADS

APPROVED:

DIVISION ENGINEER DATE

APPROVED 10/4/63

DATE

DIRECTOR OF TRANSPORTATION