

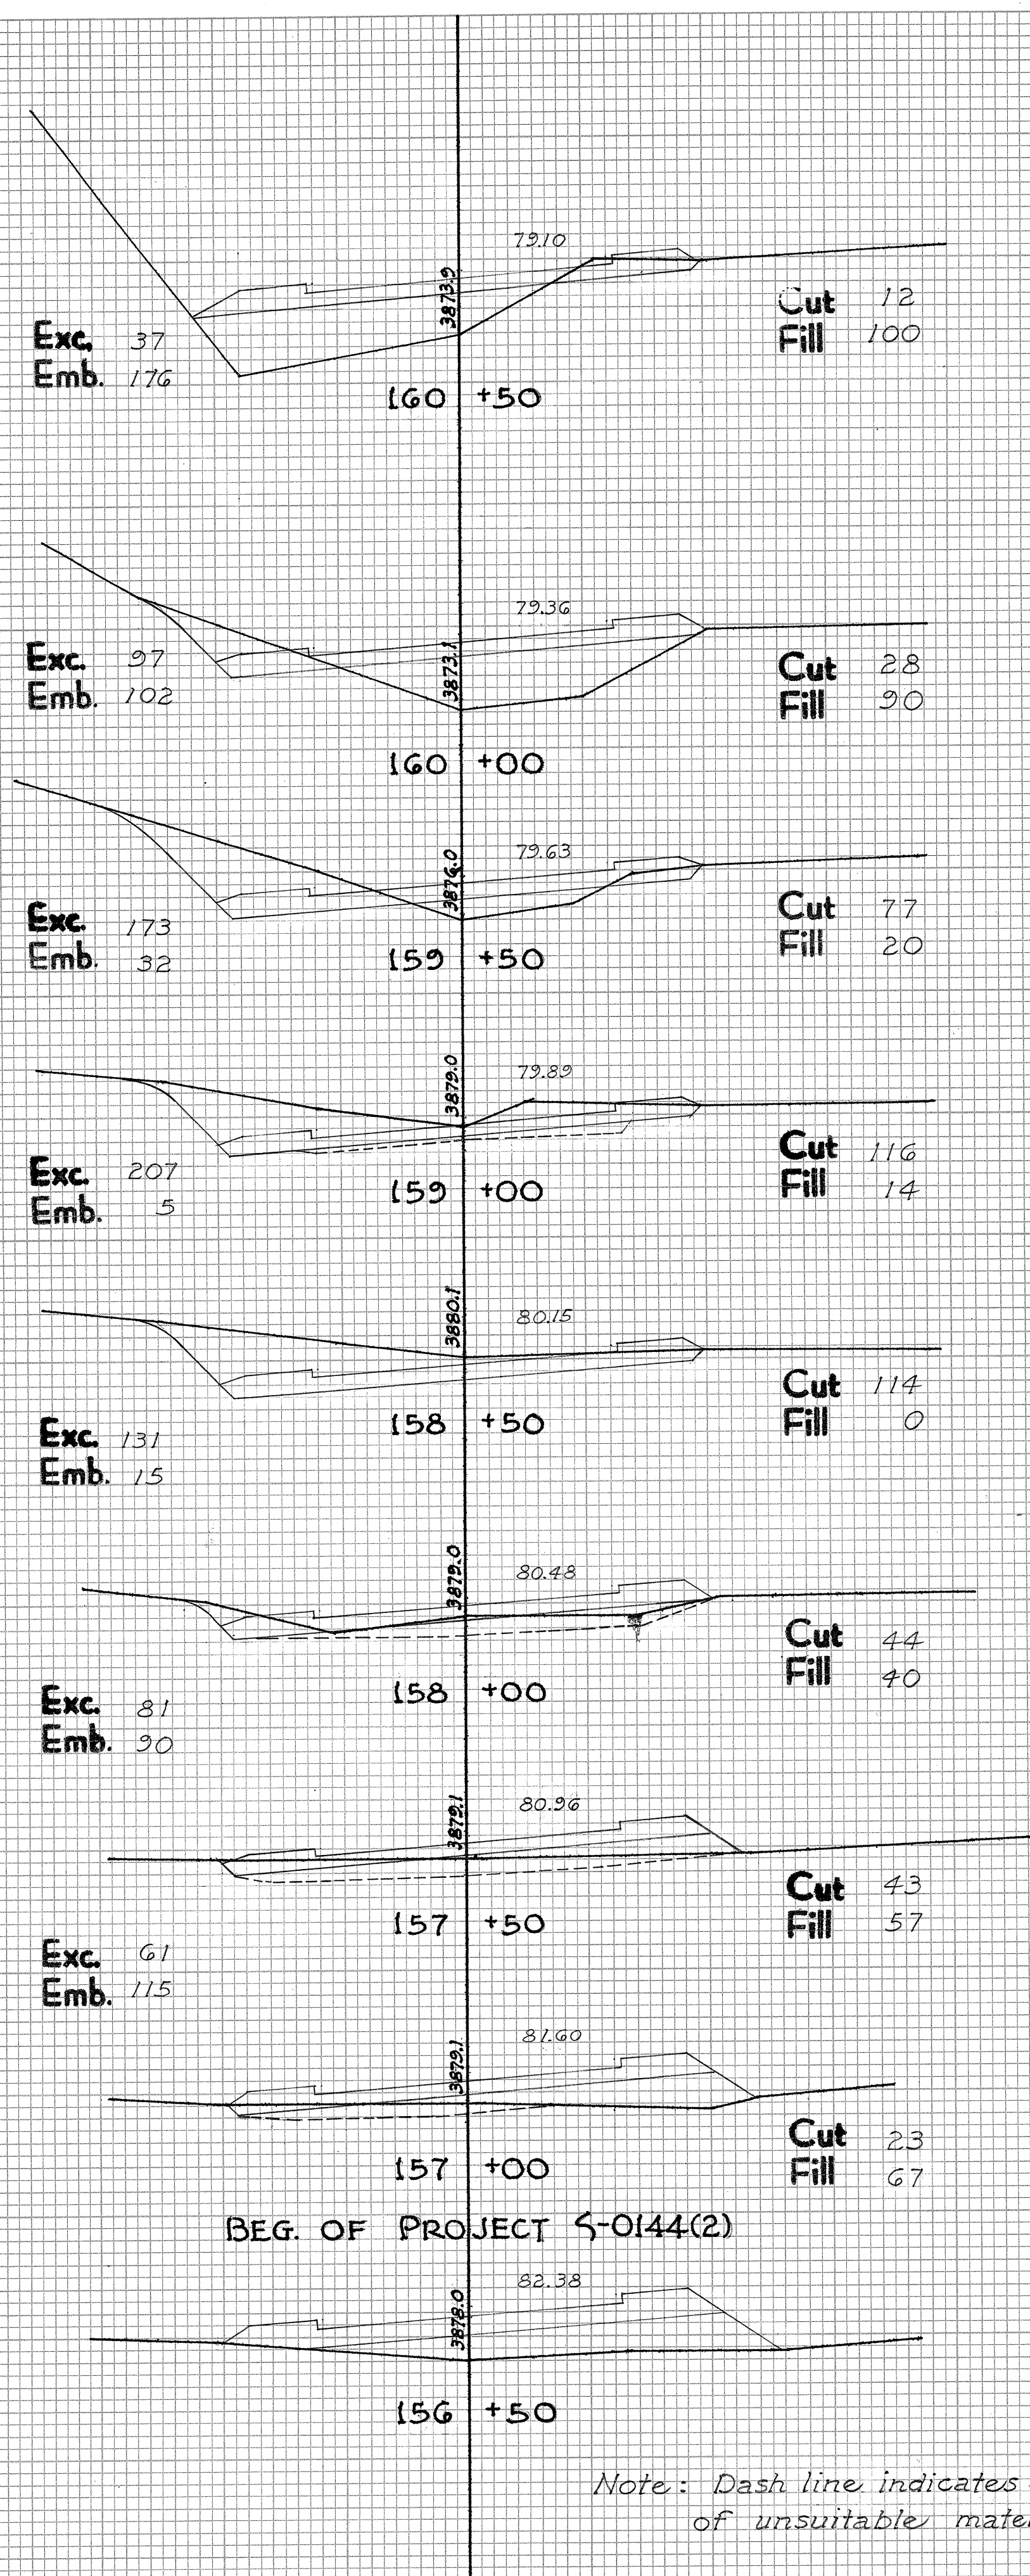


FINAL SURVEY	DATE
	BY
	BURVEYED
	NOTED
	NO.

ORIGINAL SURVEY	DATE
	BY
	BURVEYED
	NOTED
	NO.


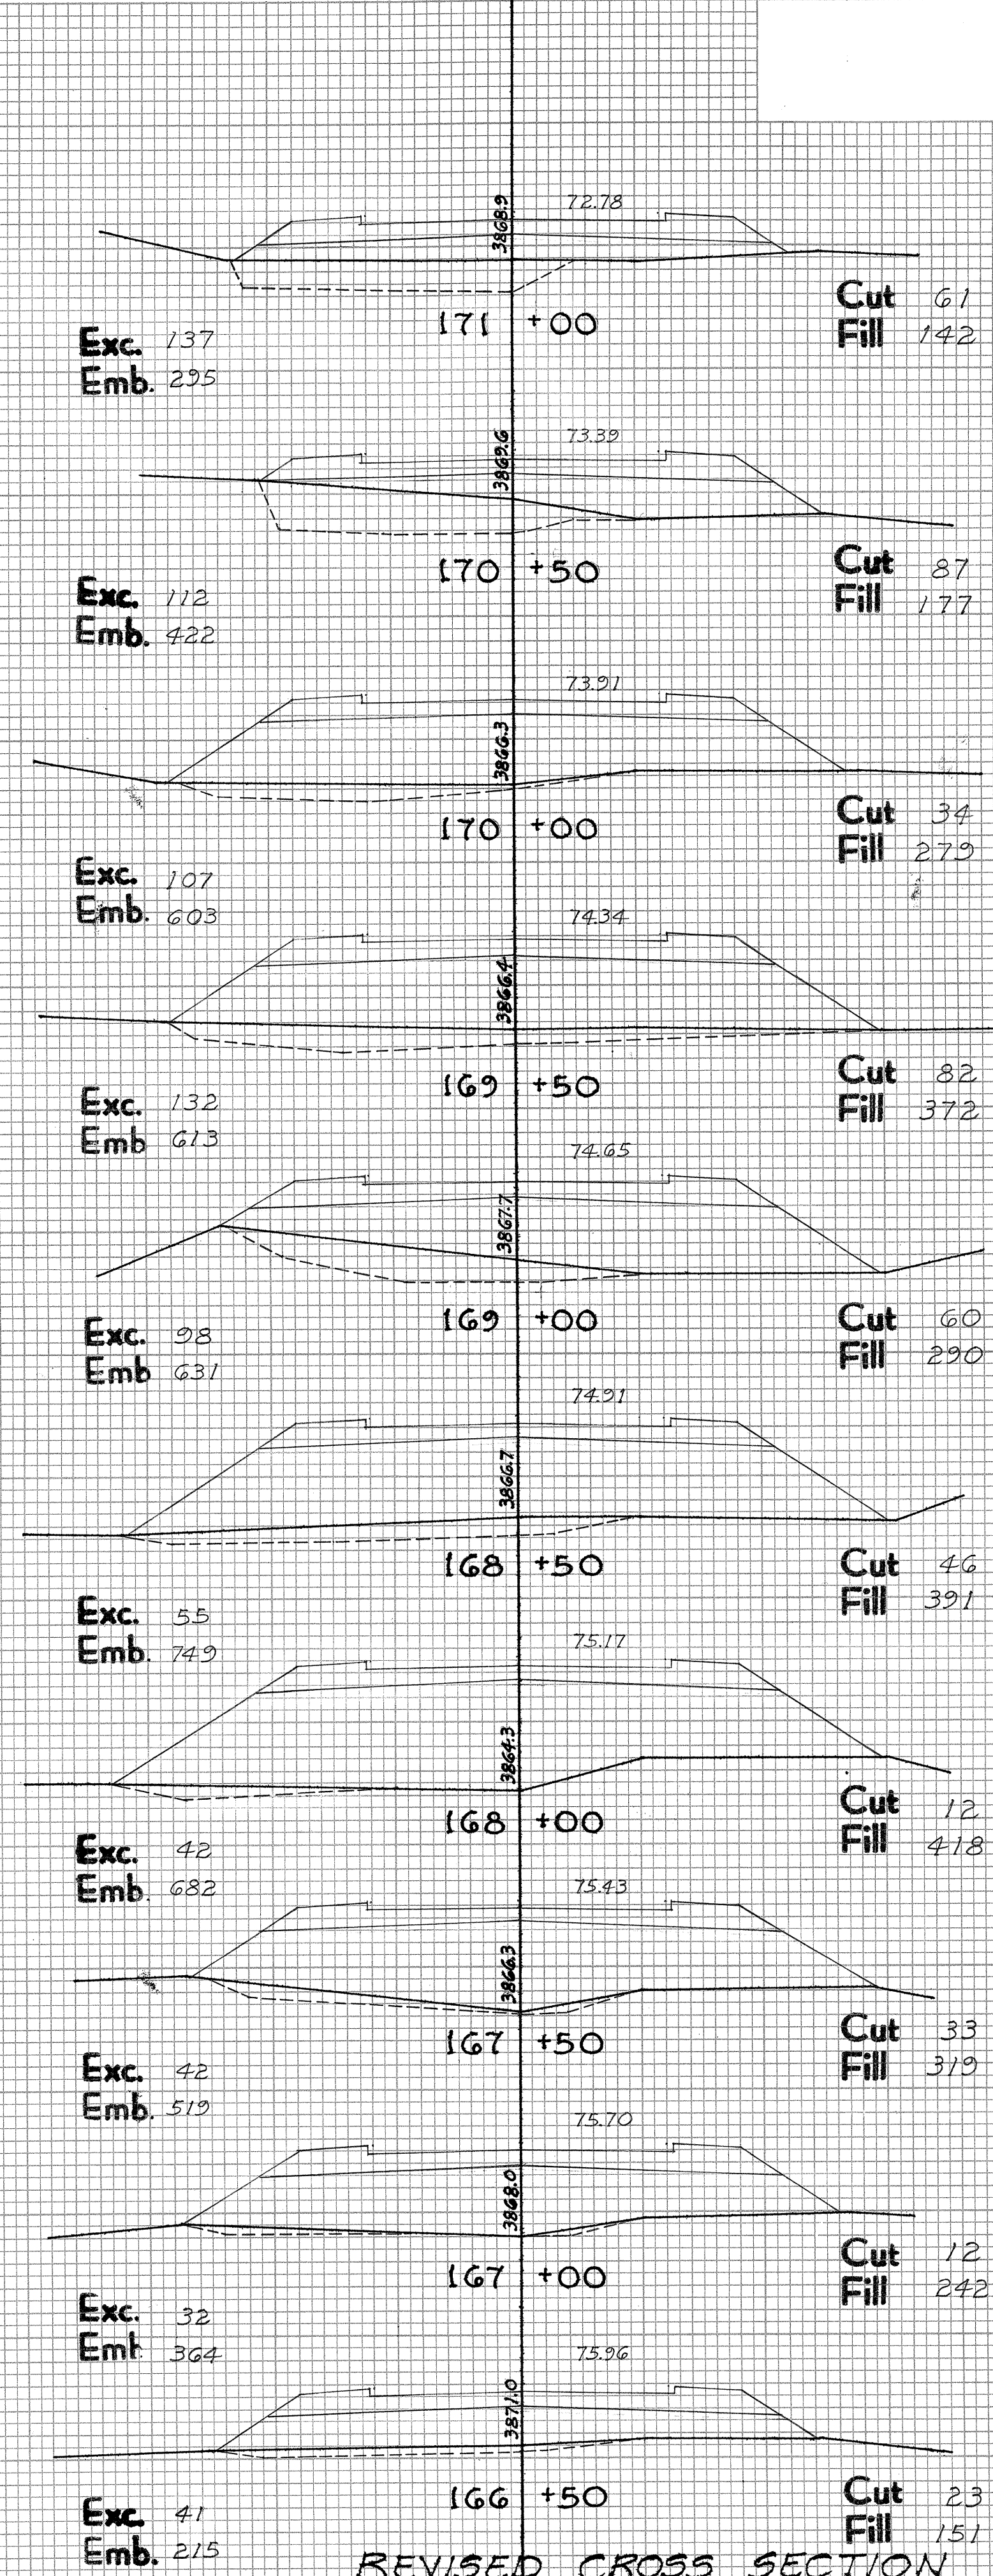


Note: Dash line indicates excavation of unsuitable material.

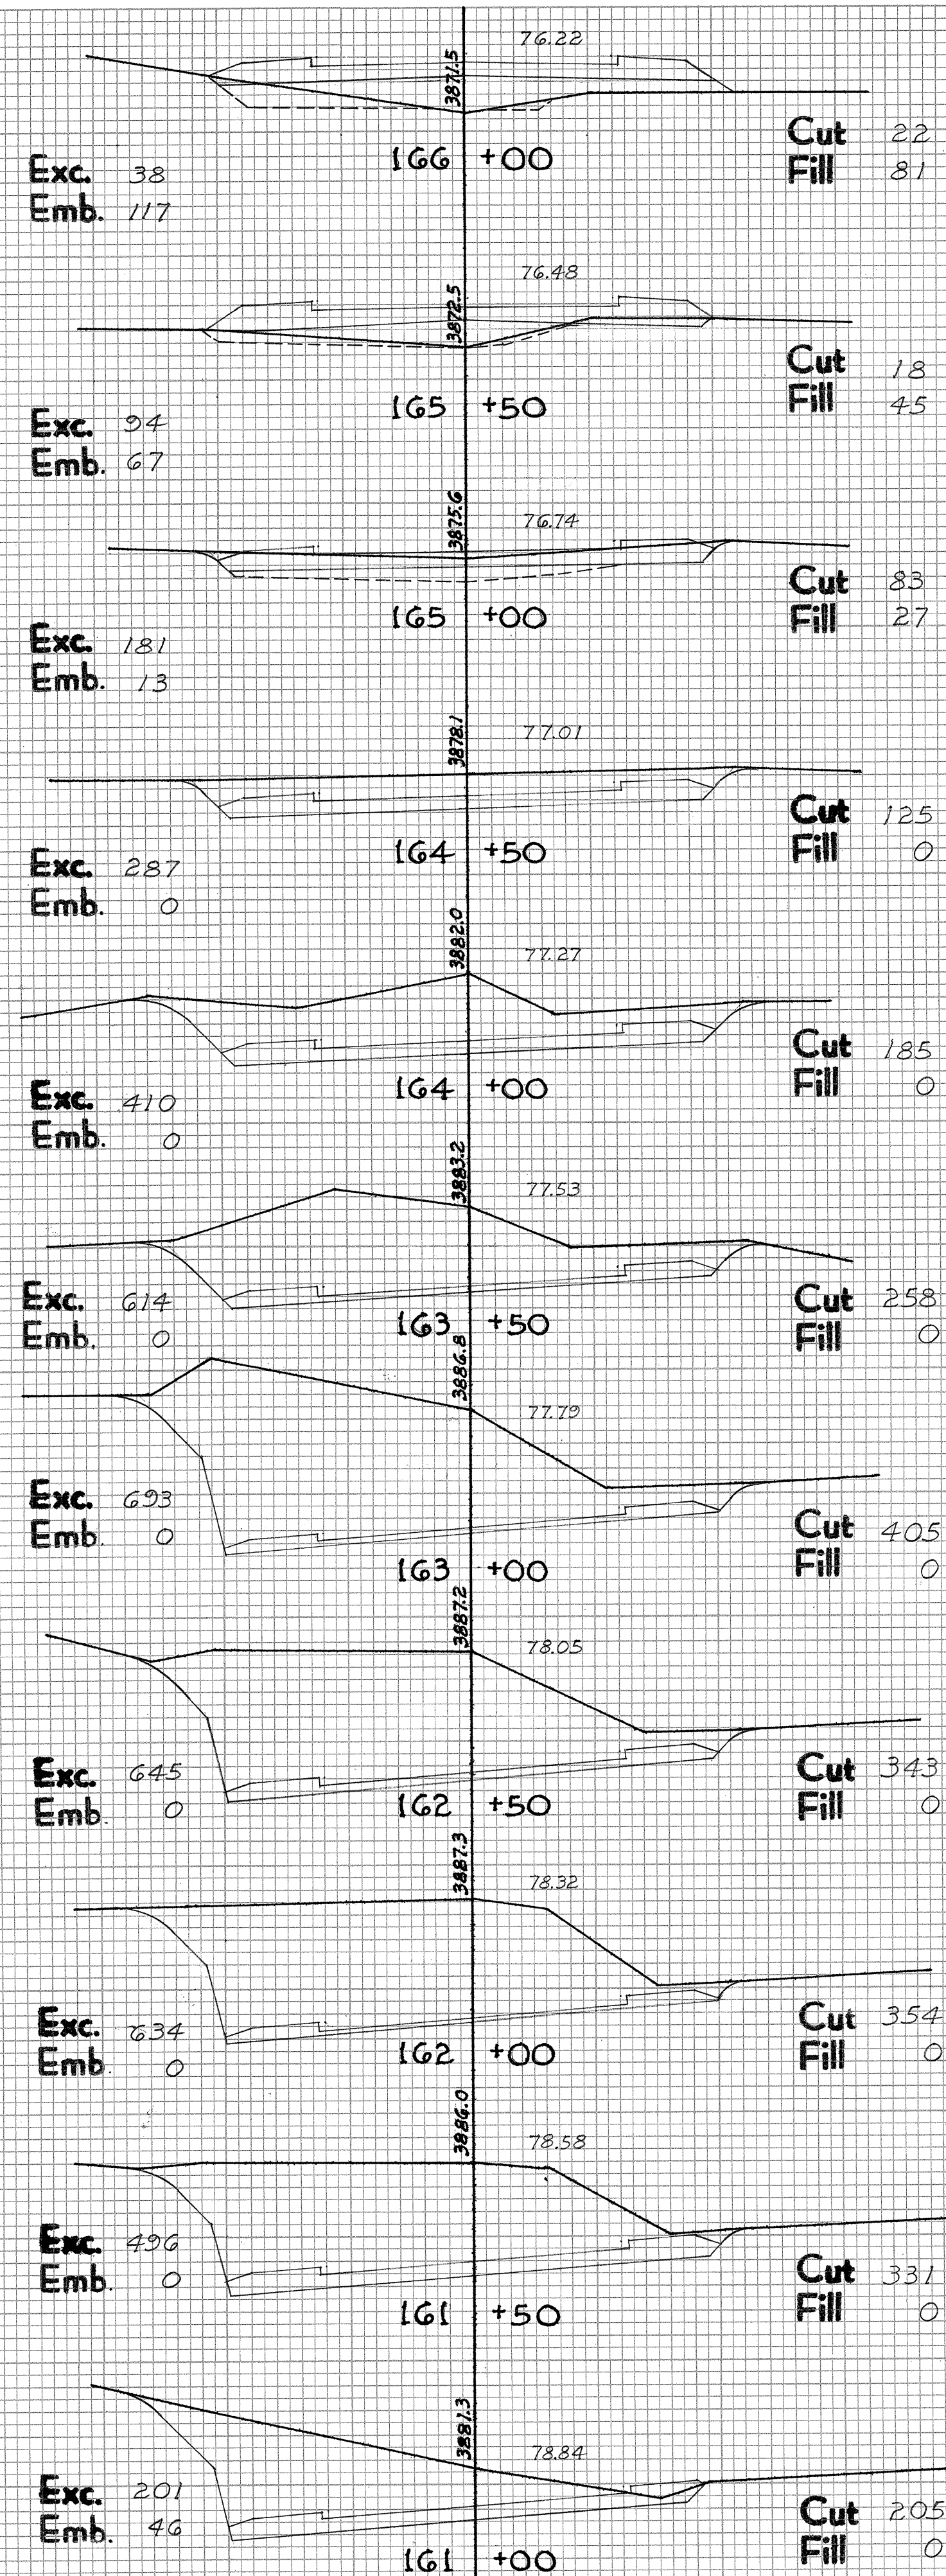


REVISED CROSS SECTION

ORIGINAL SURVEY	SURVEYED _____	BY _____	DATE _____
	PLOTTED _____		
	TEMPLATE _____		
	AREAS _____		
	AREAS CHECKED _____		
NO. _____			

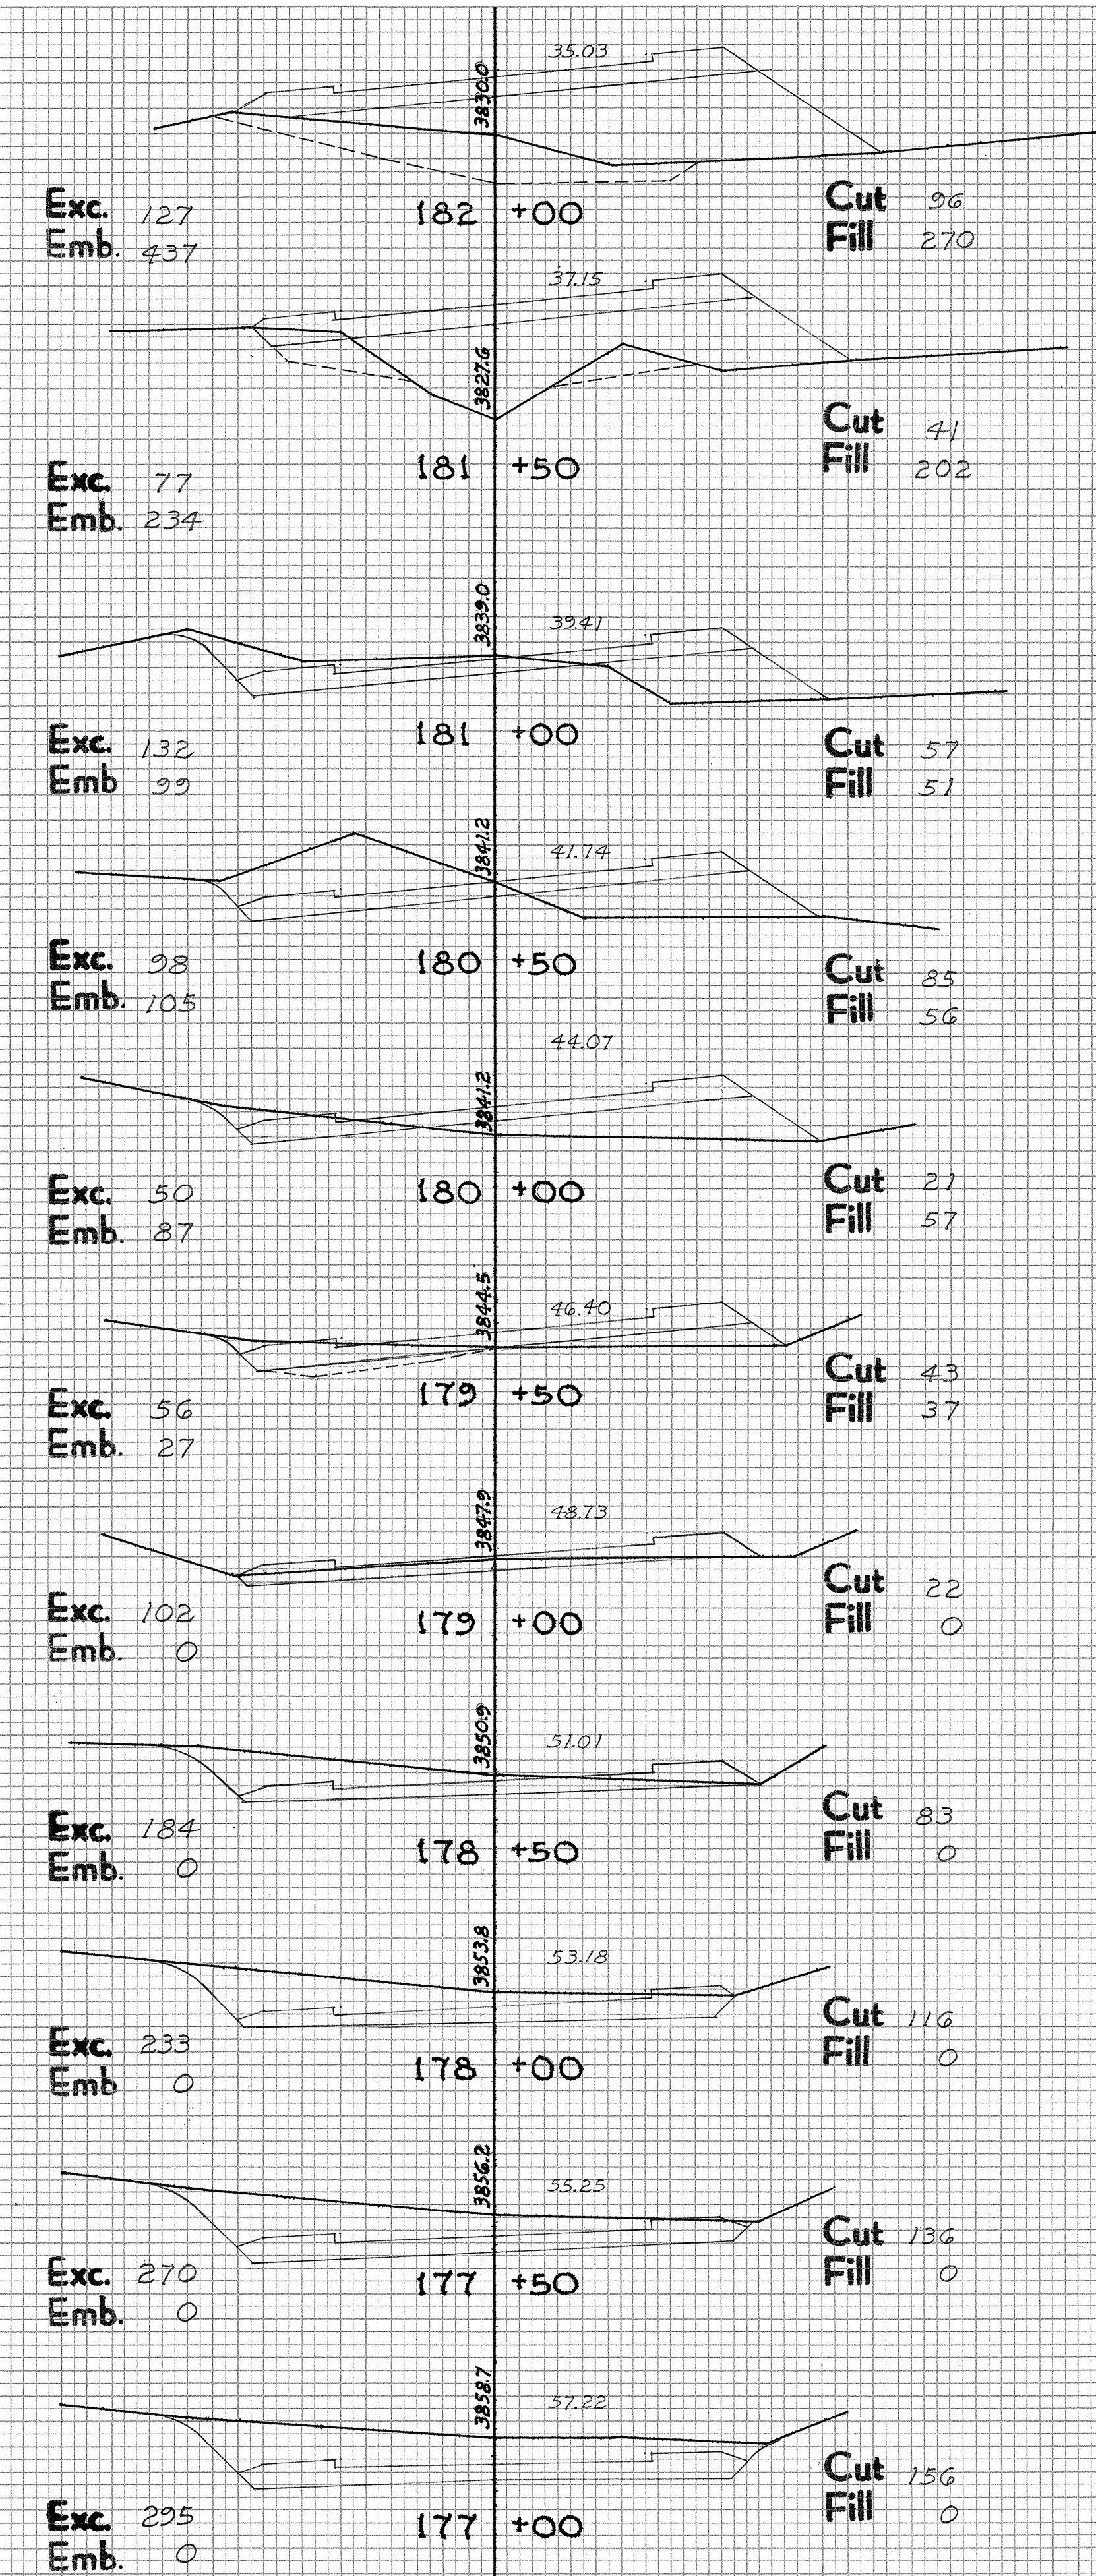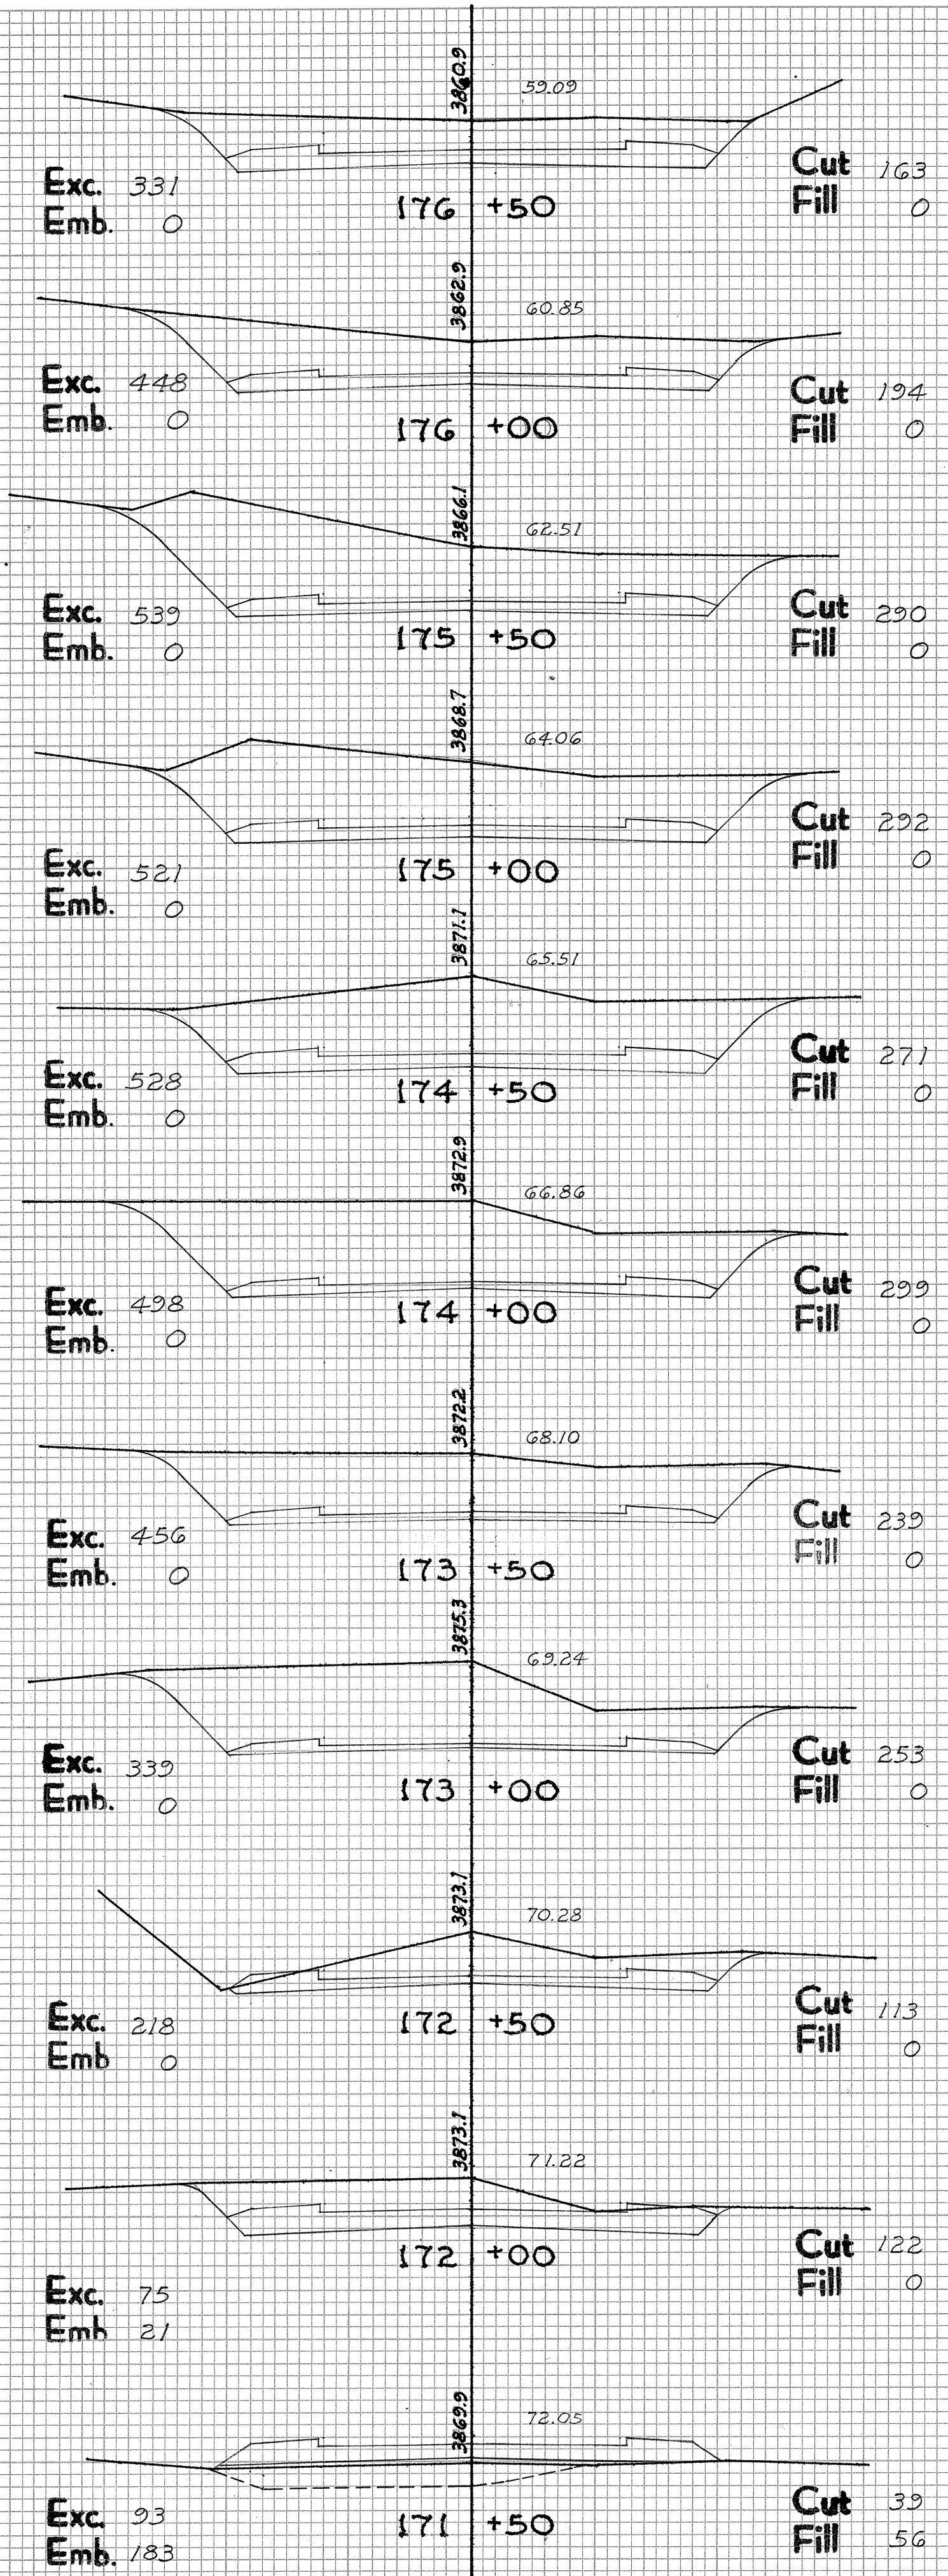

Note: Dash line indicates excavation of unsuitable material.

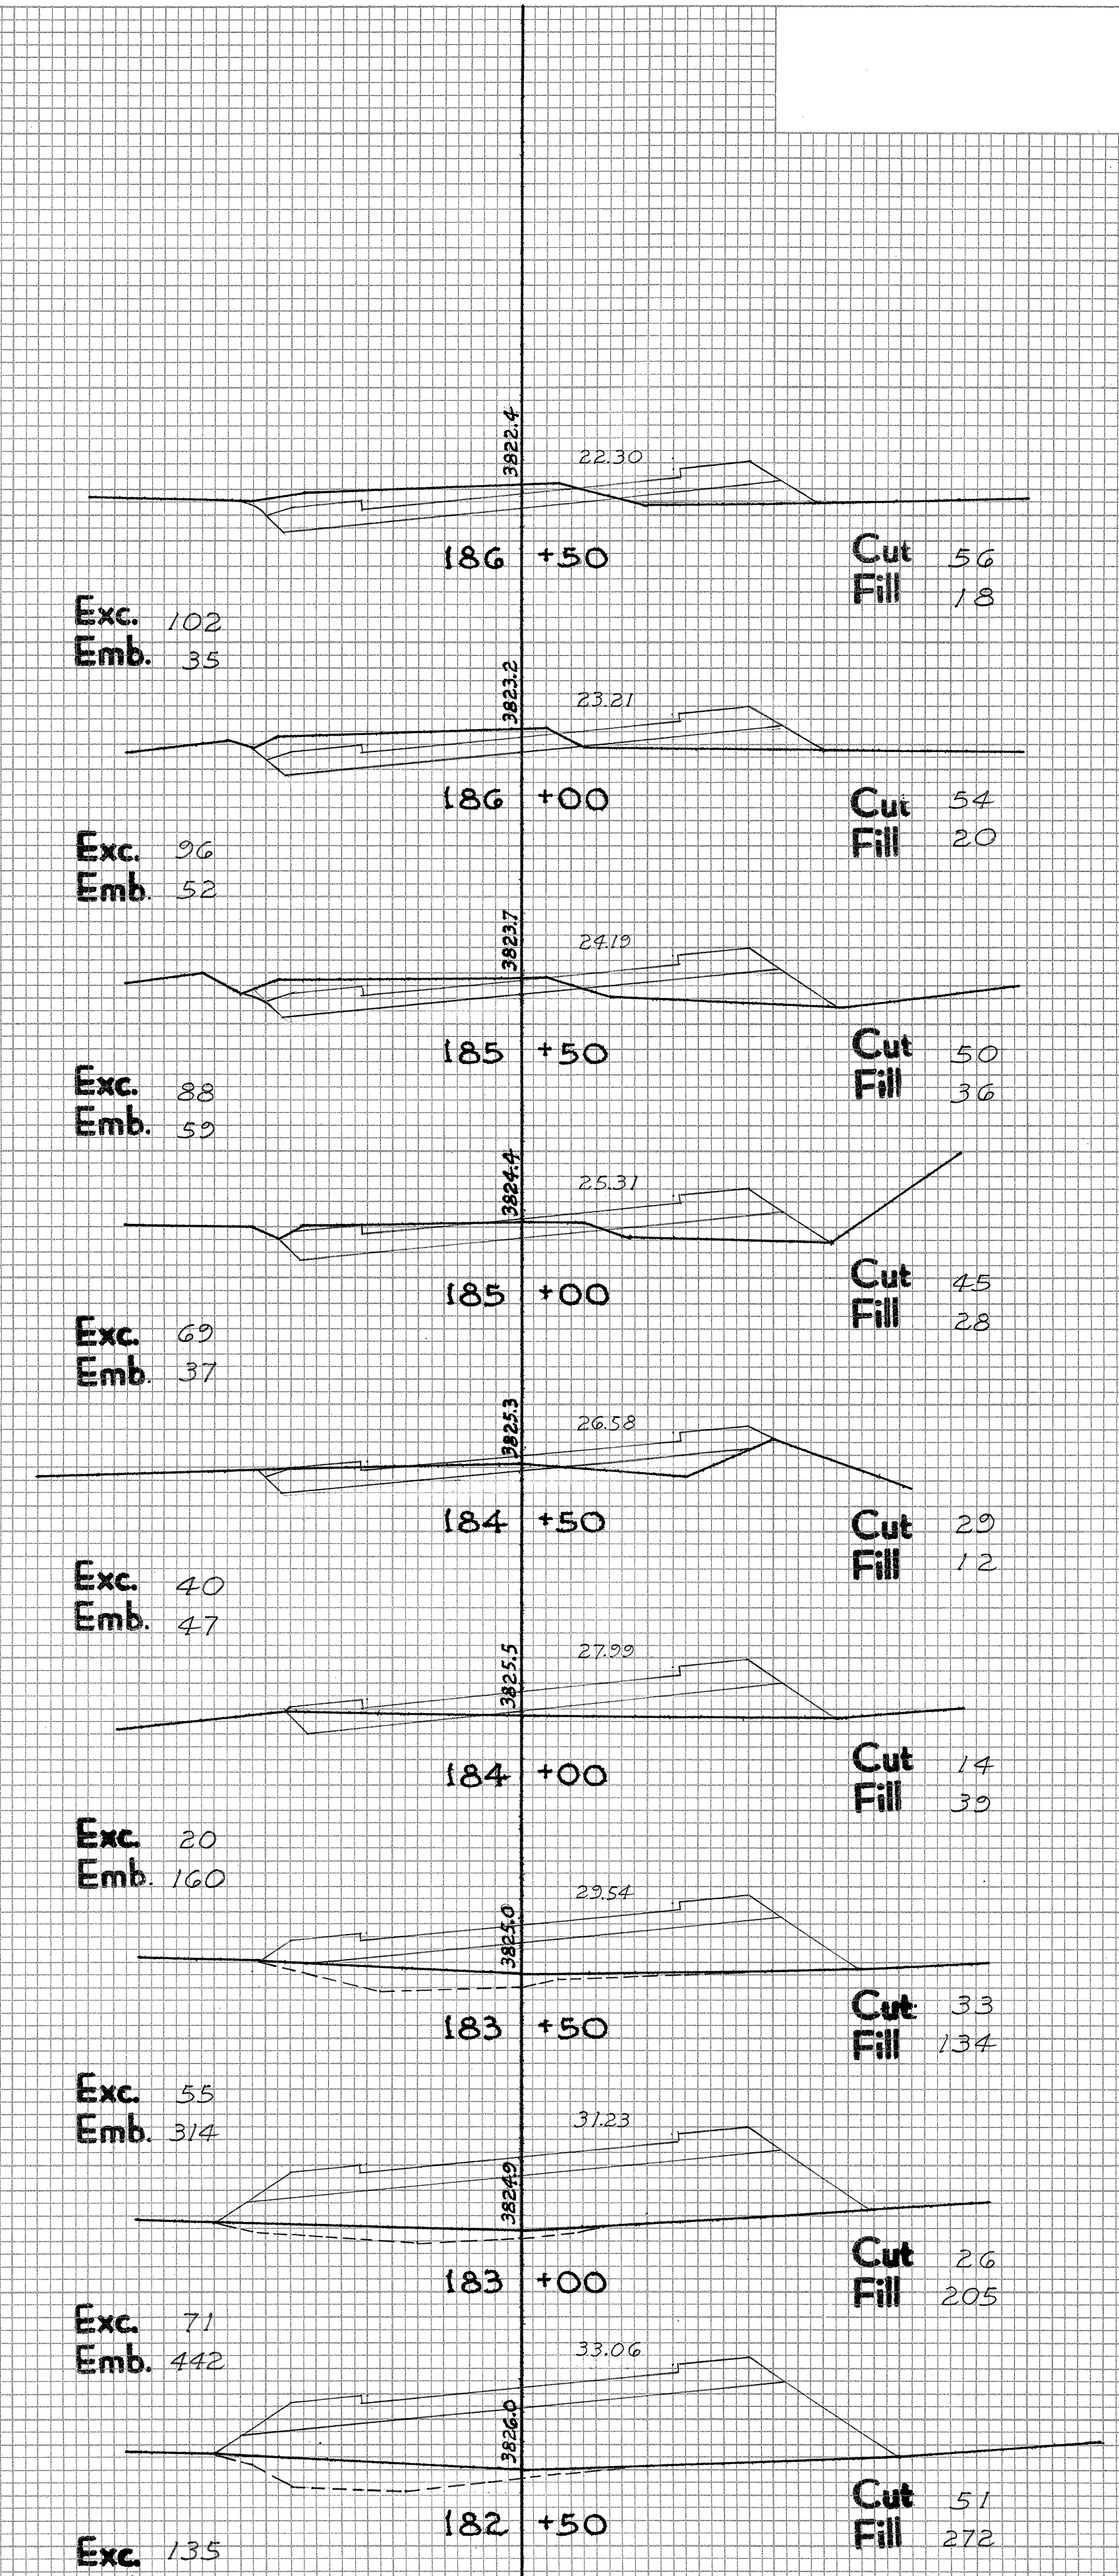

REVISED CROSS SECTION

FINAL SURVEY	DATE	
	BY	
	SURVEYED	
	NOTED	
	AREAS CHECKED	

ORIGINAL SURVEY	DATE	
	BY	
	SURVEYED	
	NOTED	
	AREAS CHECKED	

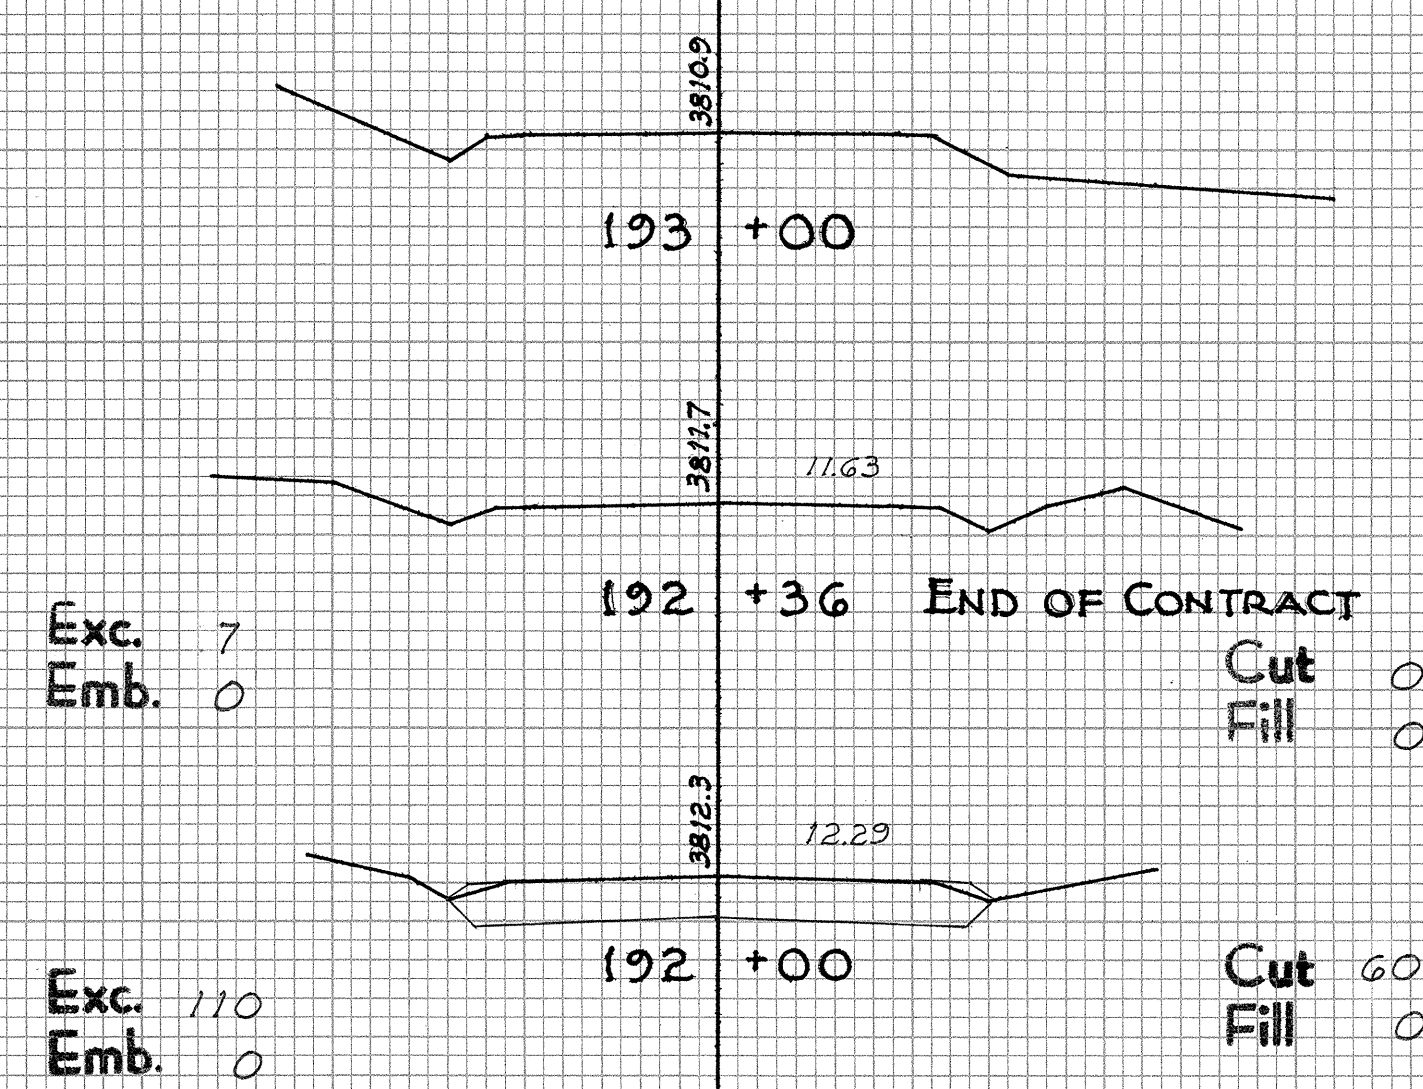
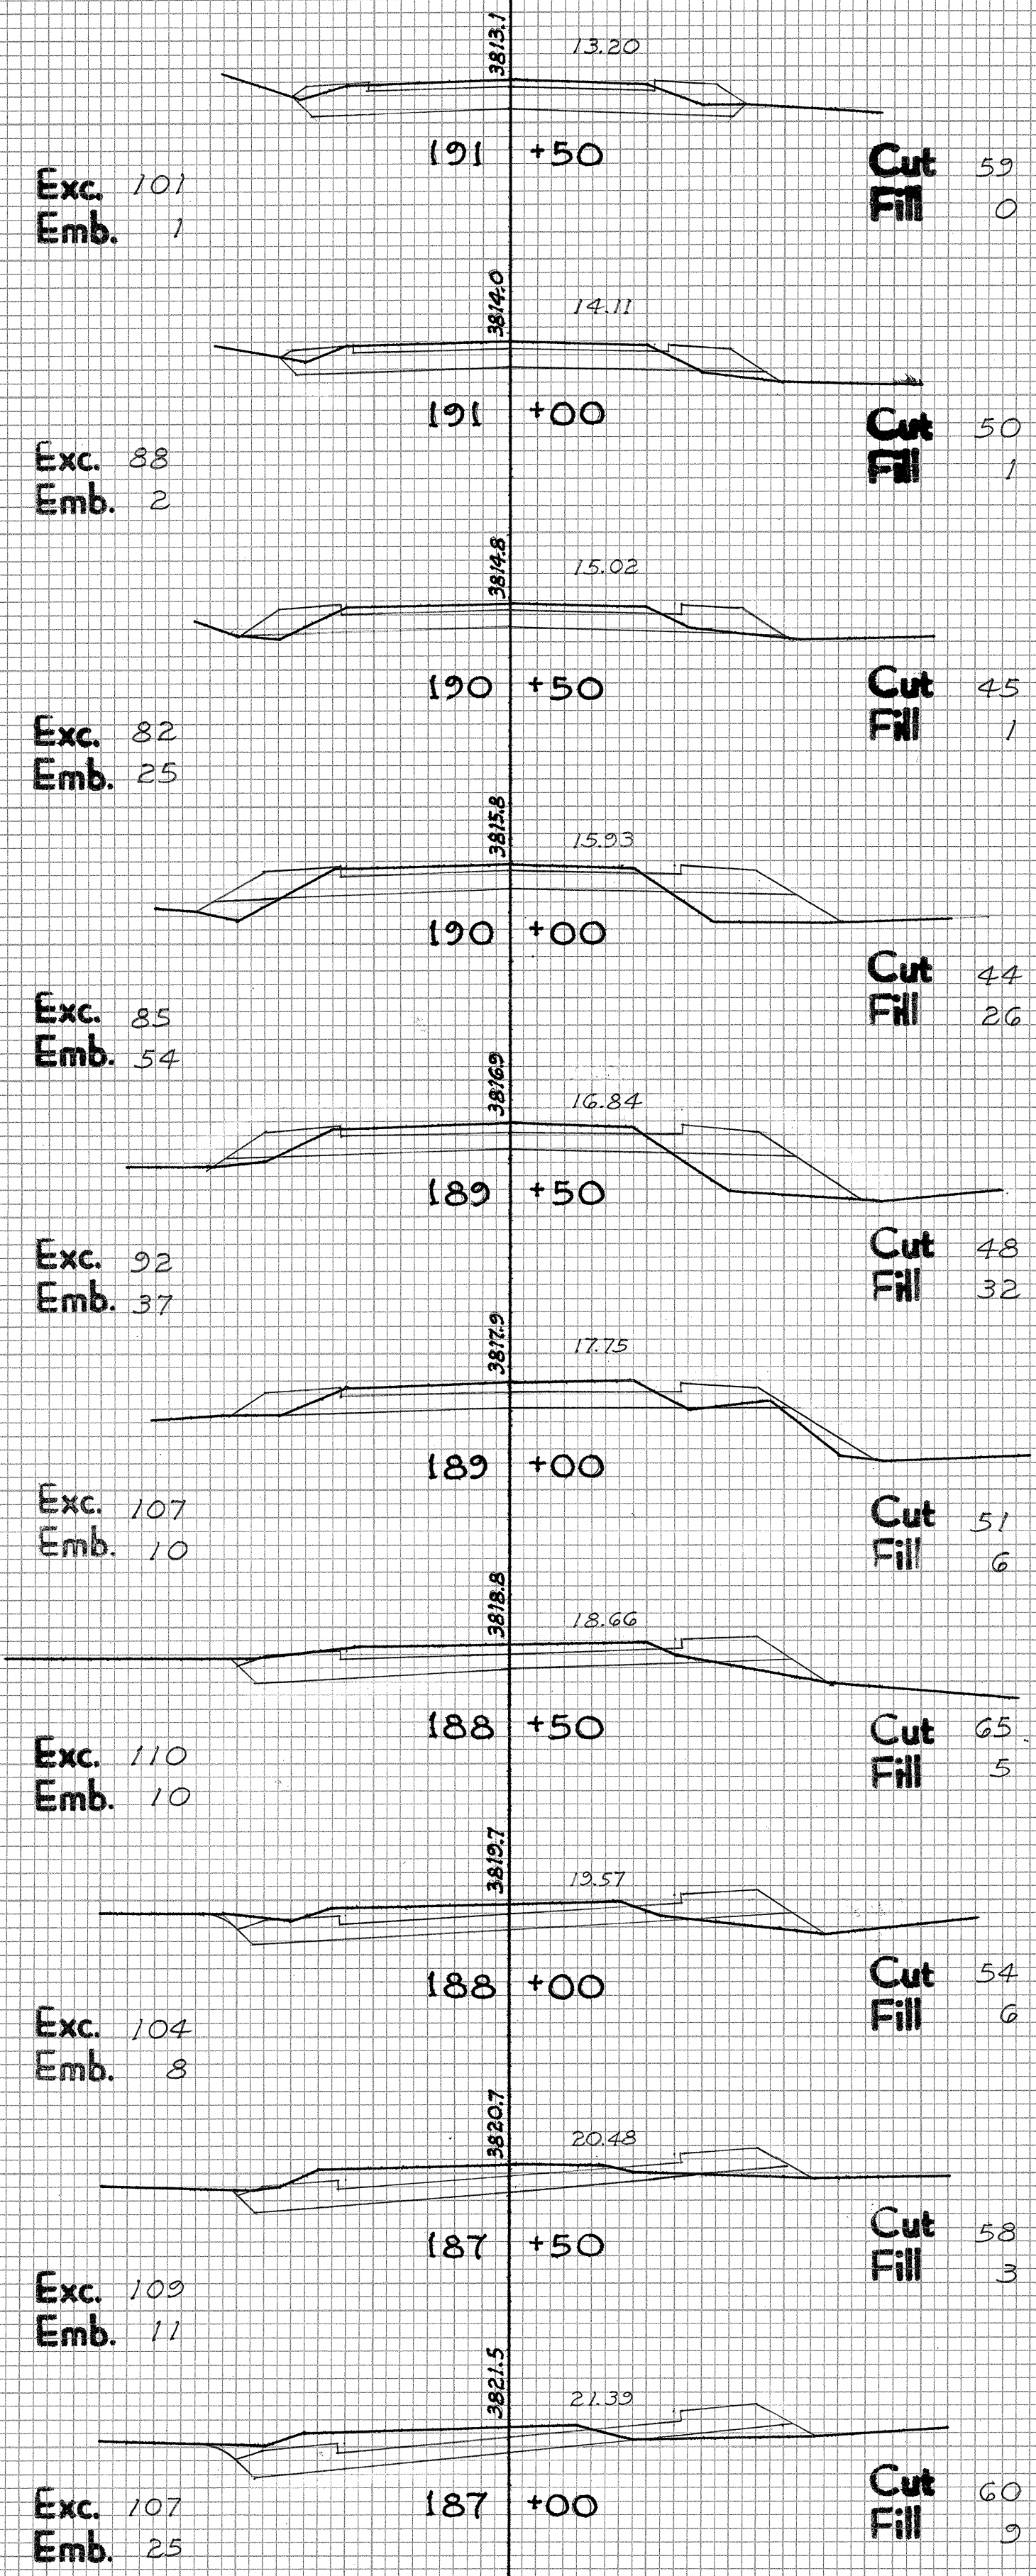


PLATE 3 CROSS SECTION C. P. R. & R. E. STANDARD
100% RAS PAPER-MADE AND PRINTED IN U. S. A.
EUGENE DIETZEN CO.

REVISED CROSS SECTION