

INDEX TO DRAWINGS	
SHEET	DESCRIPTION
1	TITLE SHEET
2	TYPICAL SECTION
3	BORROW PIT LOCATION
4-5	PLAN & PROFILE
6	MISCELLANEOUS DETAILS
7-11	CROSS SECTIONS

STATE OF HAWAII

DEPARTMENT OF TRANSPORTATION

DIVISION OF HIGHWAYS

"AS BUILT" PLANS OF

PORTION OF

HAWAII NATIONAL PARK

HEADQUARTERS BYPASS ROAD

FEDERAL AID SECONDARY PROJ. NO. S-0144(2)

DISTRICT OF PUNA

ISLAND OF HAWAII

PLAN

1 INCH = 100 FT.

PROFILE



HOR. 1 INCH = 100 FT.

VER. 1 INCH = 10 FT.

CROSS SECTION

HOR. 1 INCH = 10 FT.

VER. 1 INCH = 10 FT.

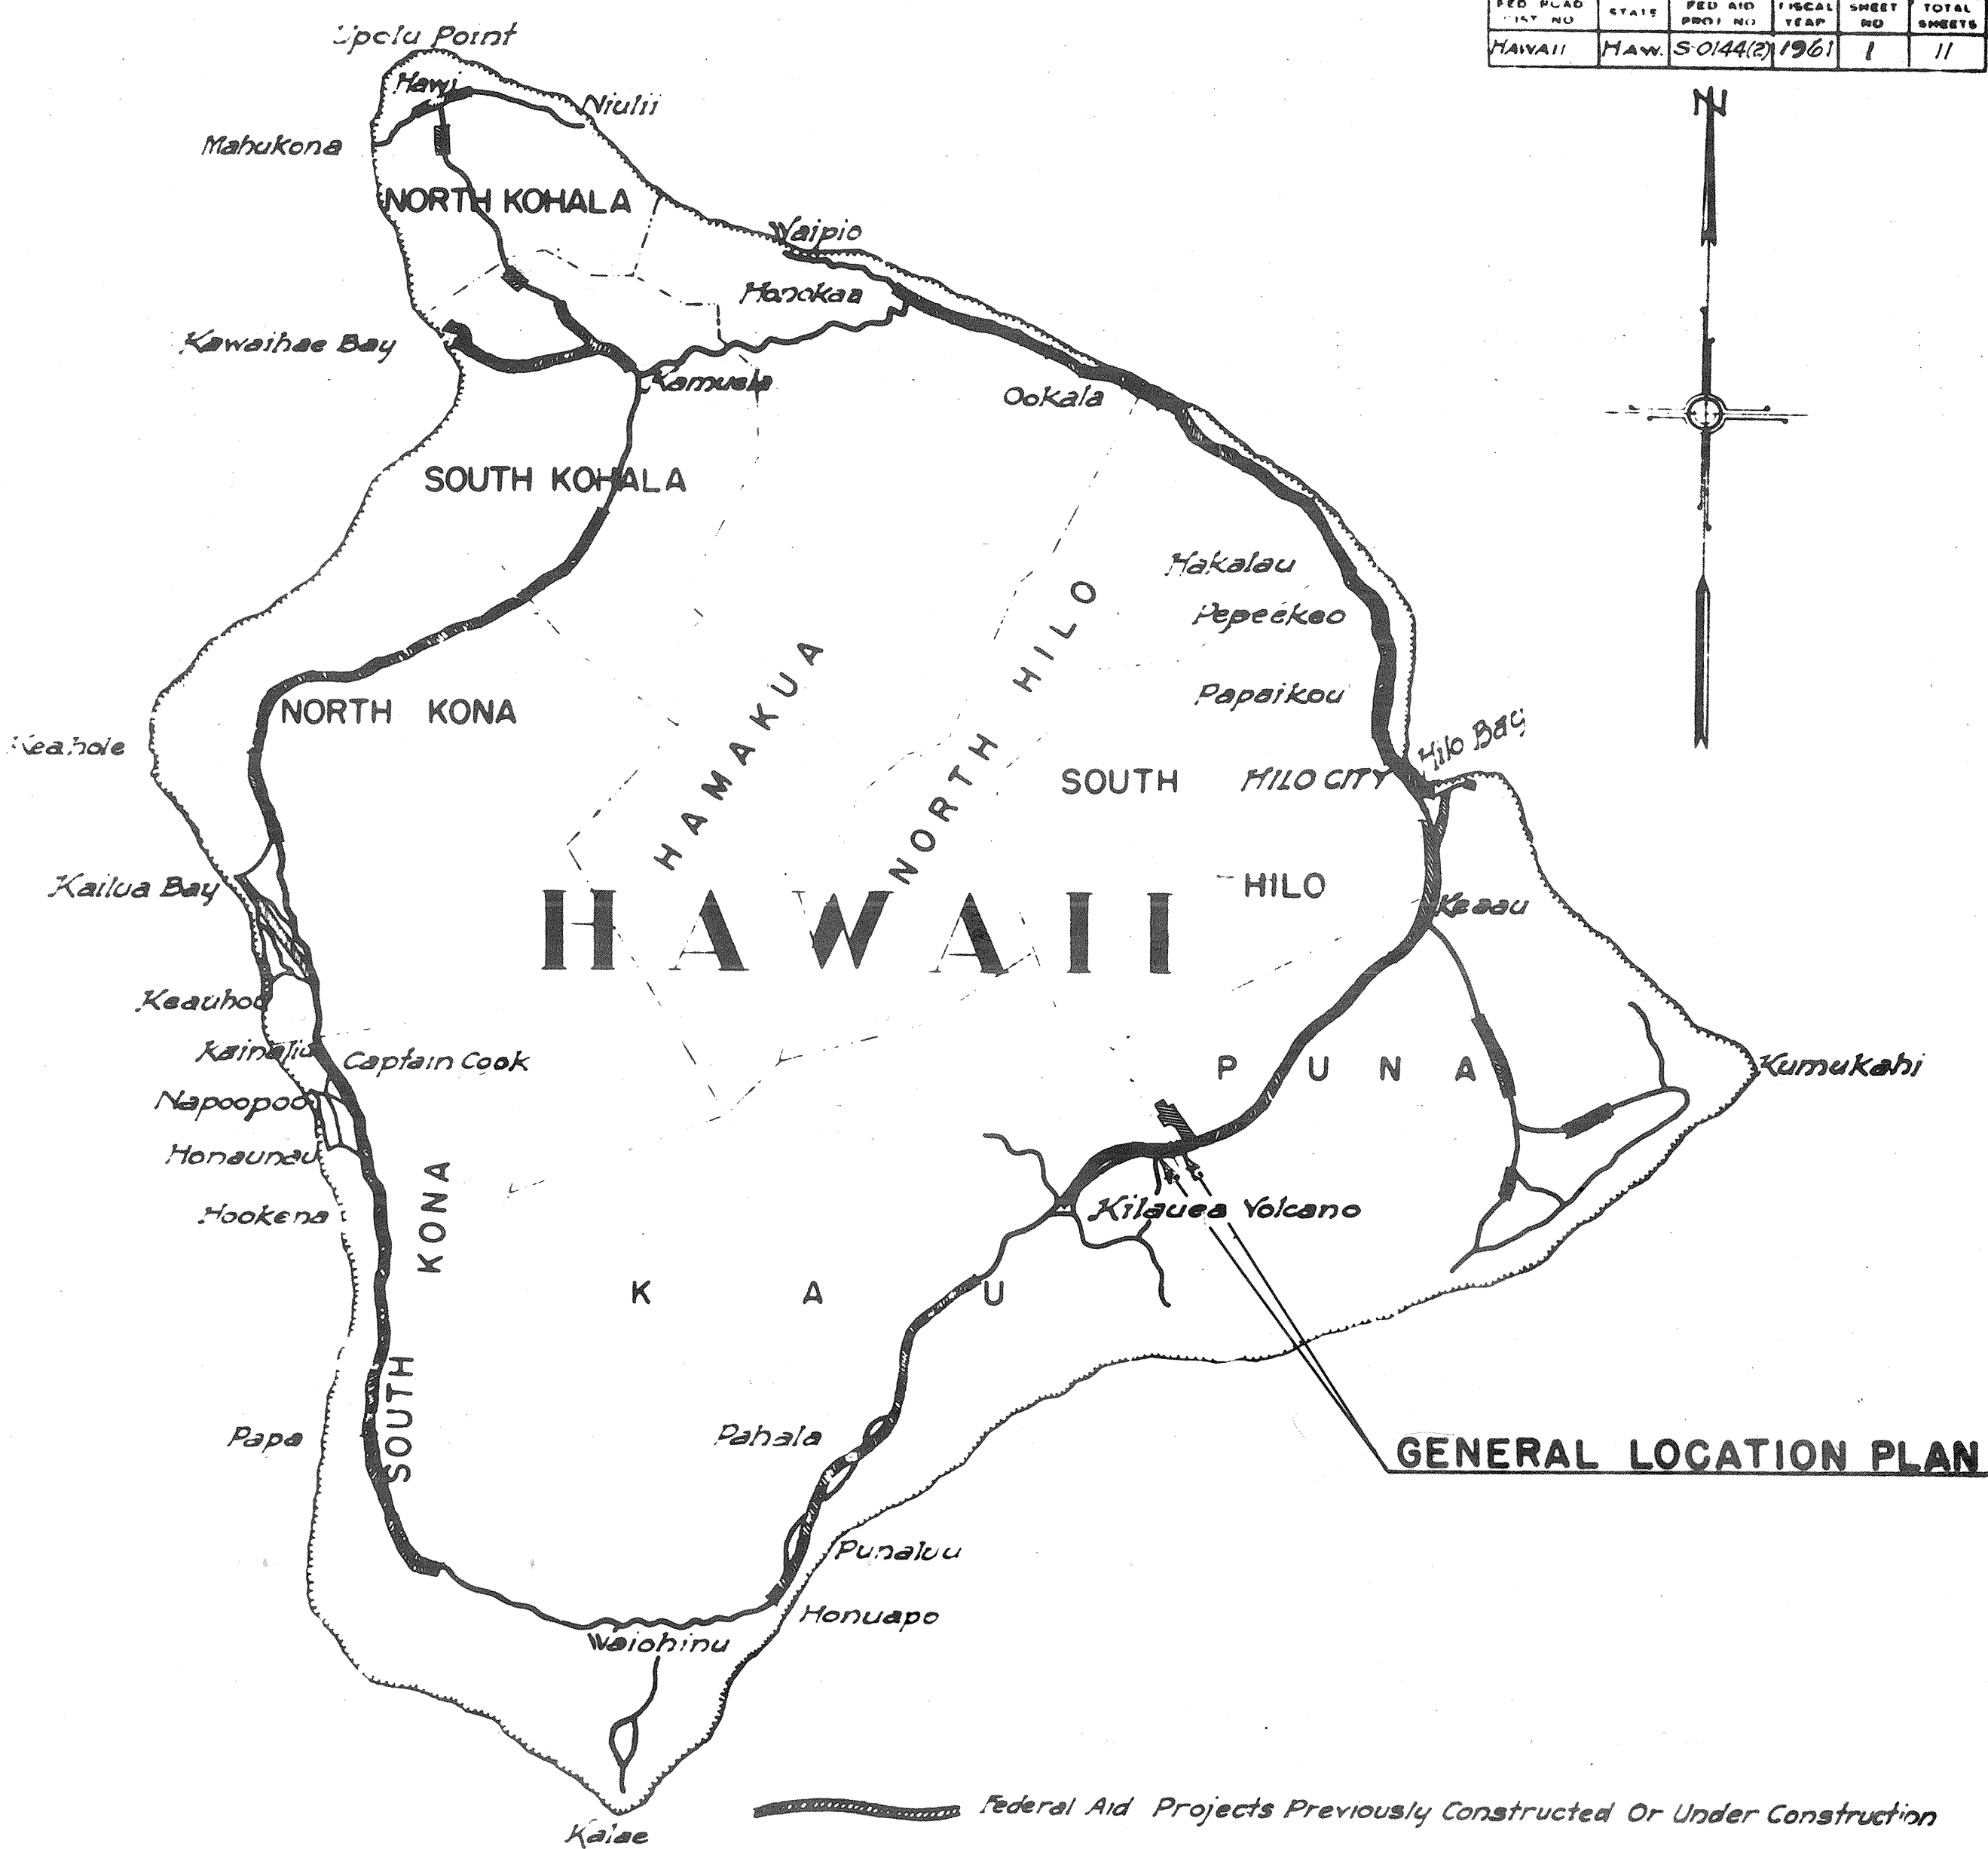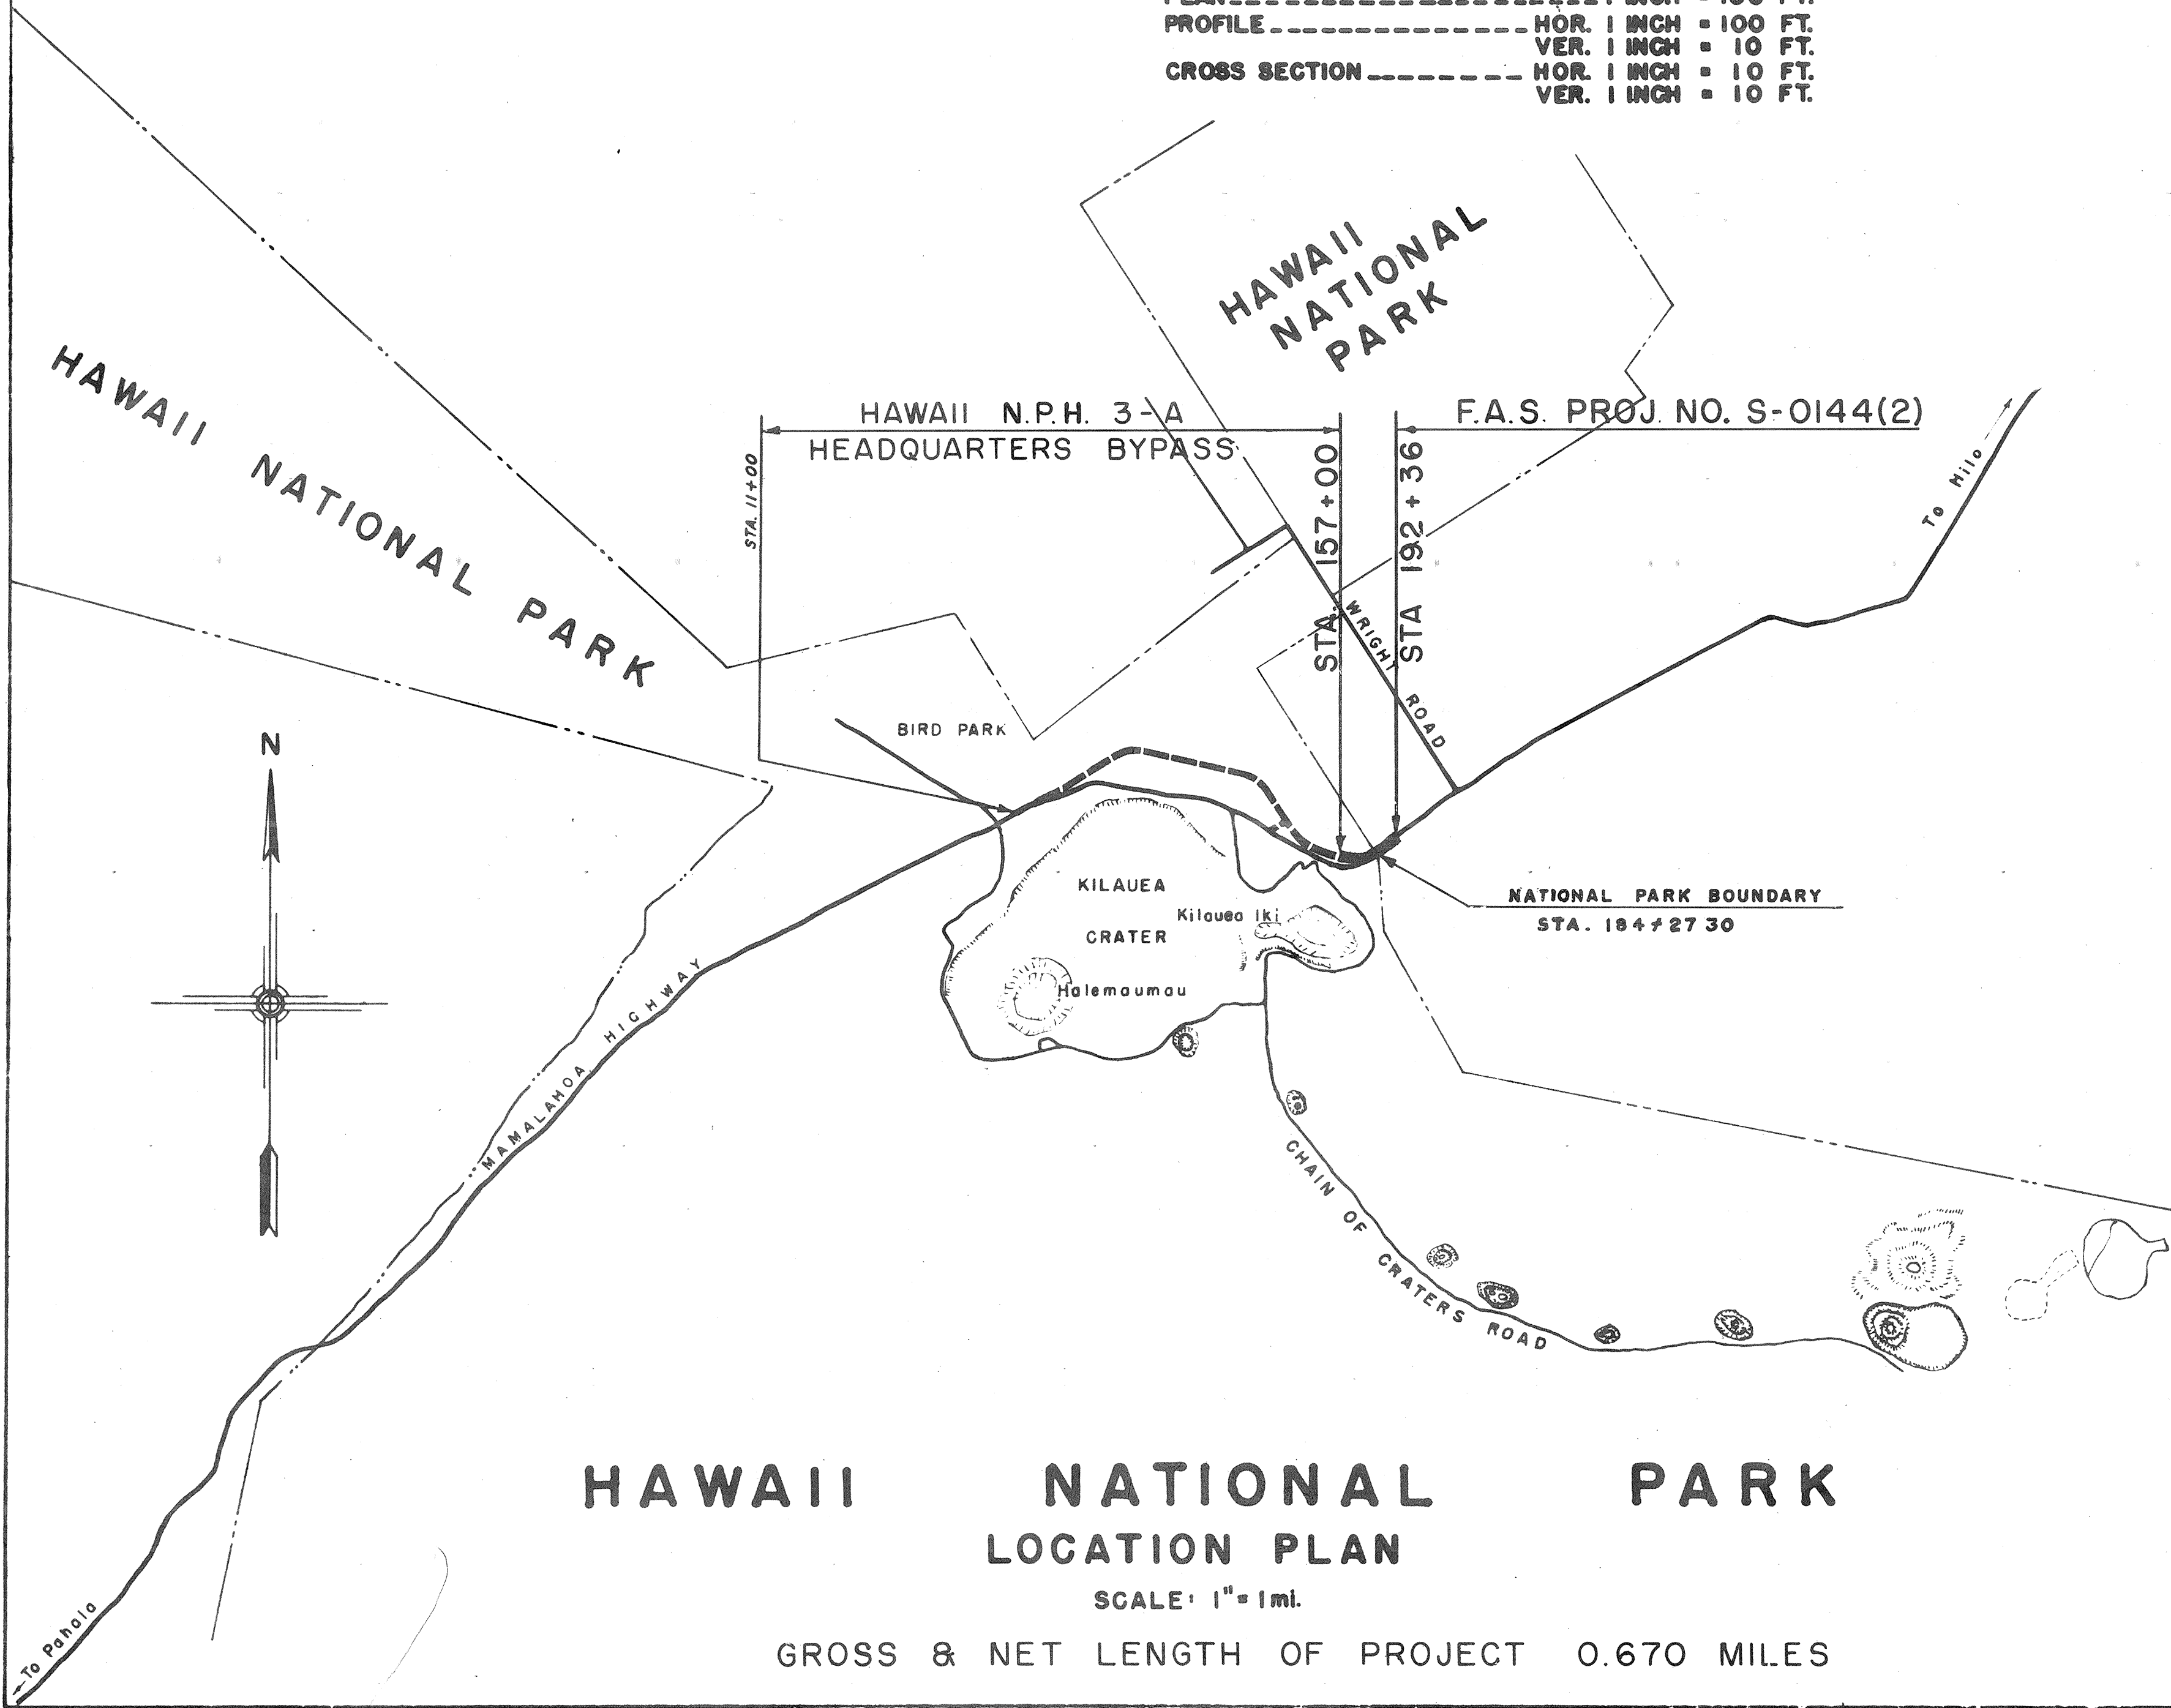

NOTE:

ALL CHANGES MADE DURING CONSTRUCTION

HAVE BEEN NOTED ON THESE TRACINGS IN

RED AND CHECKED BY:

*Angelo Inguineo*

PROJECT ENGINEER

*August 5, 1963*

DATE

DESIGN CLASSIFICATION

ADT (1958)	430
ADT (1978)	850
DHV	45
D	50%
T	25%
V	55 M.P.H.

APPROVED.....

DATE *2/13/61*

*[Signature]*

DIRECTOR OF TRANSPORTATION

DEPARTMENT OF COMMERCE

BUREAU OF PUBLIC ROADS

APPROVED

*[Signature]*

DIVISION ENGINEER

DATE