




FED. ROAD DIST. NO.	STATE	FED. AID PROJ. NO.	FISCAL YEAR	SHEET NO.	TOTAL SHEETS
HAWAII	HAW.	F-011-1(4)	1962	33	40

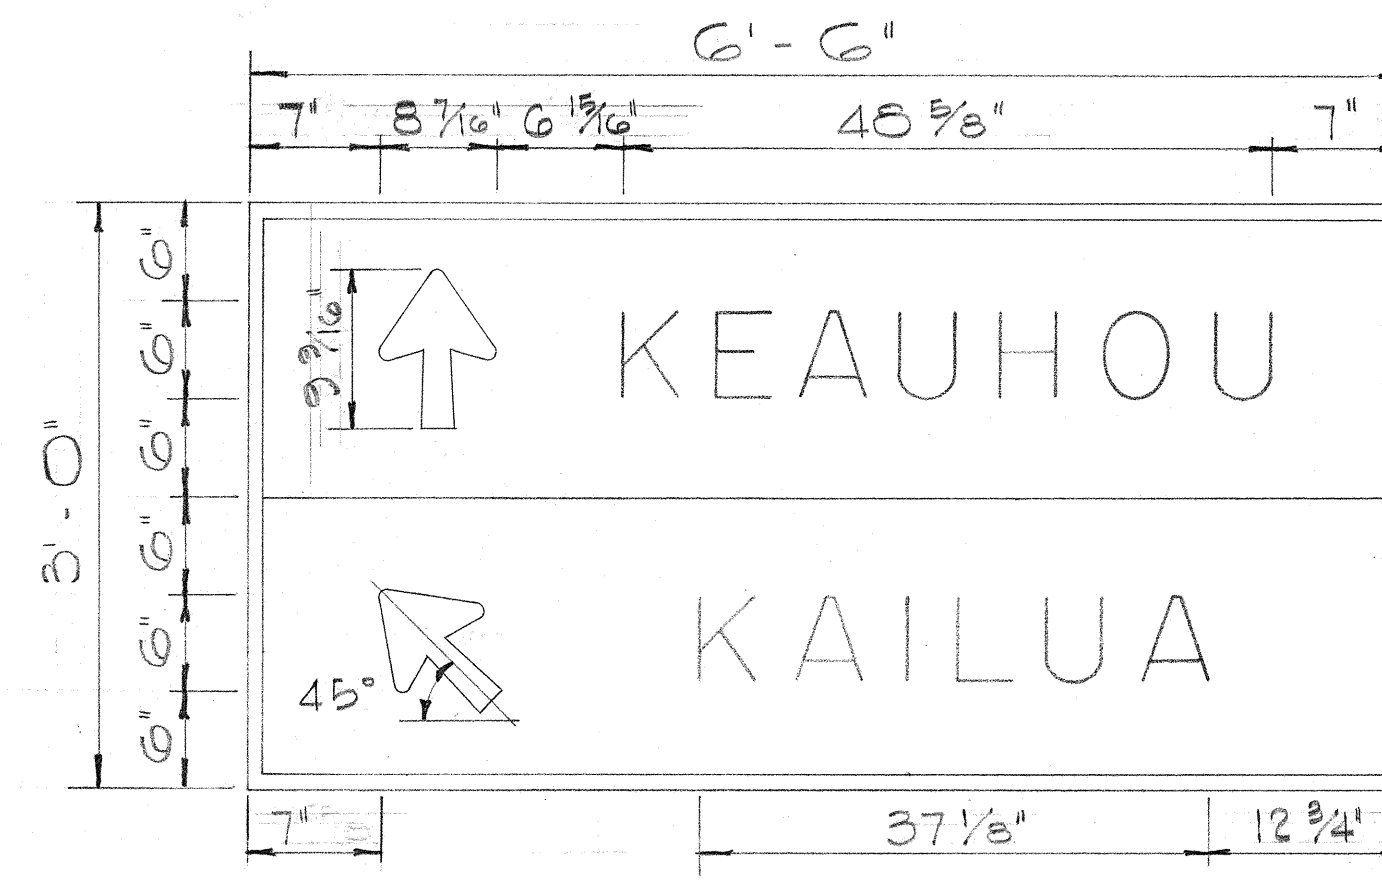


D-1

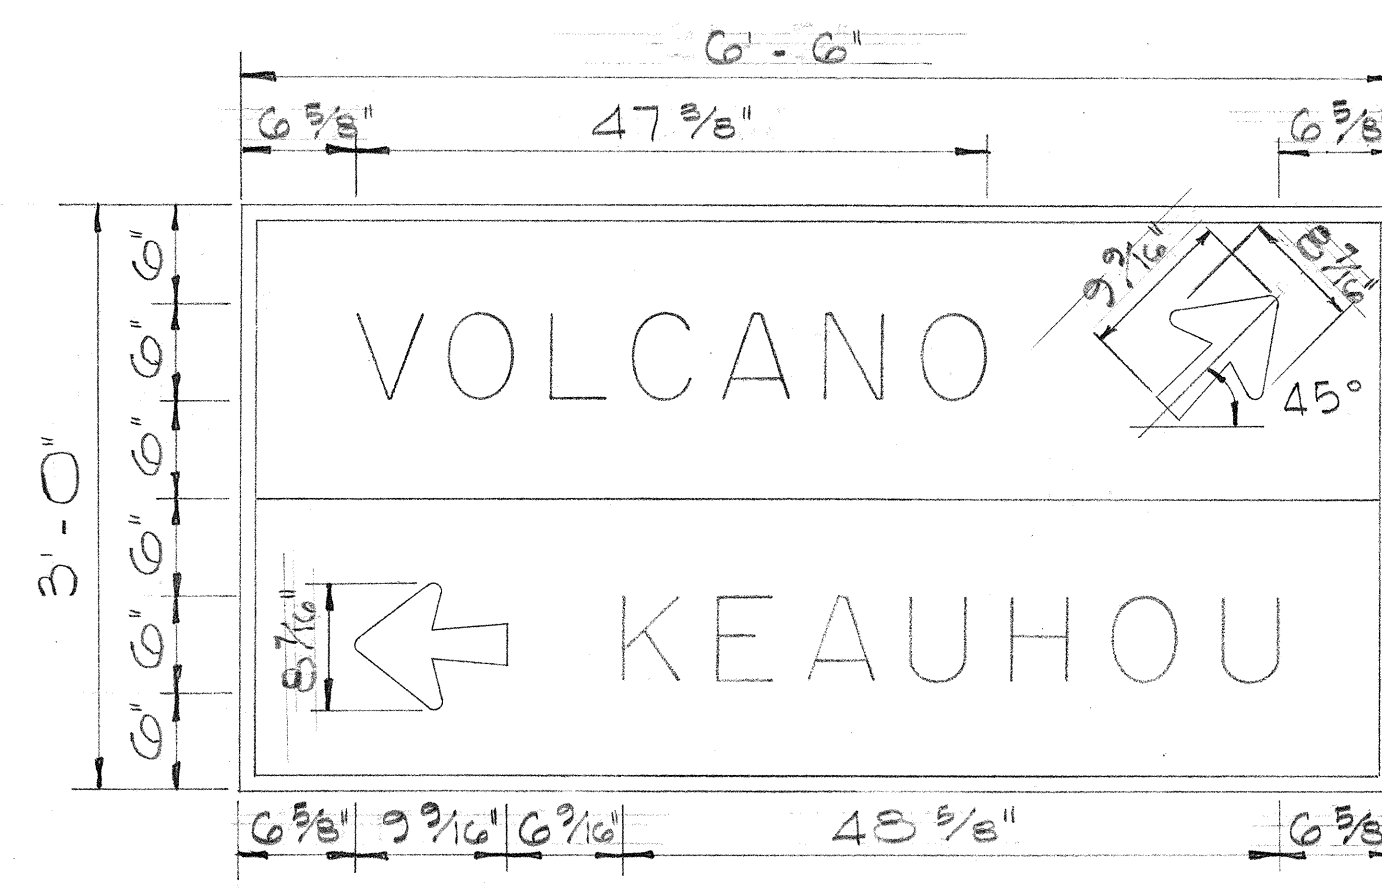


D-2

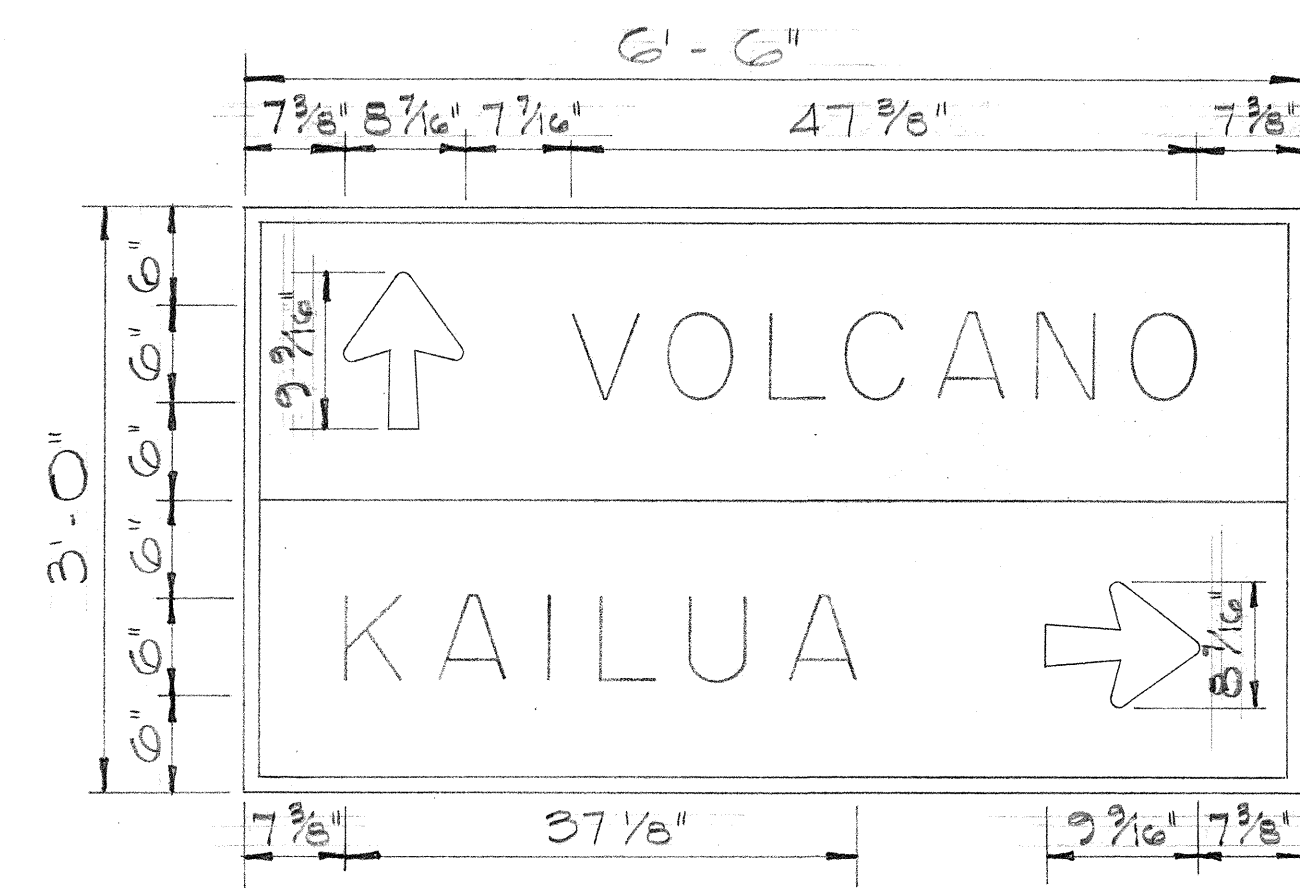


D-3

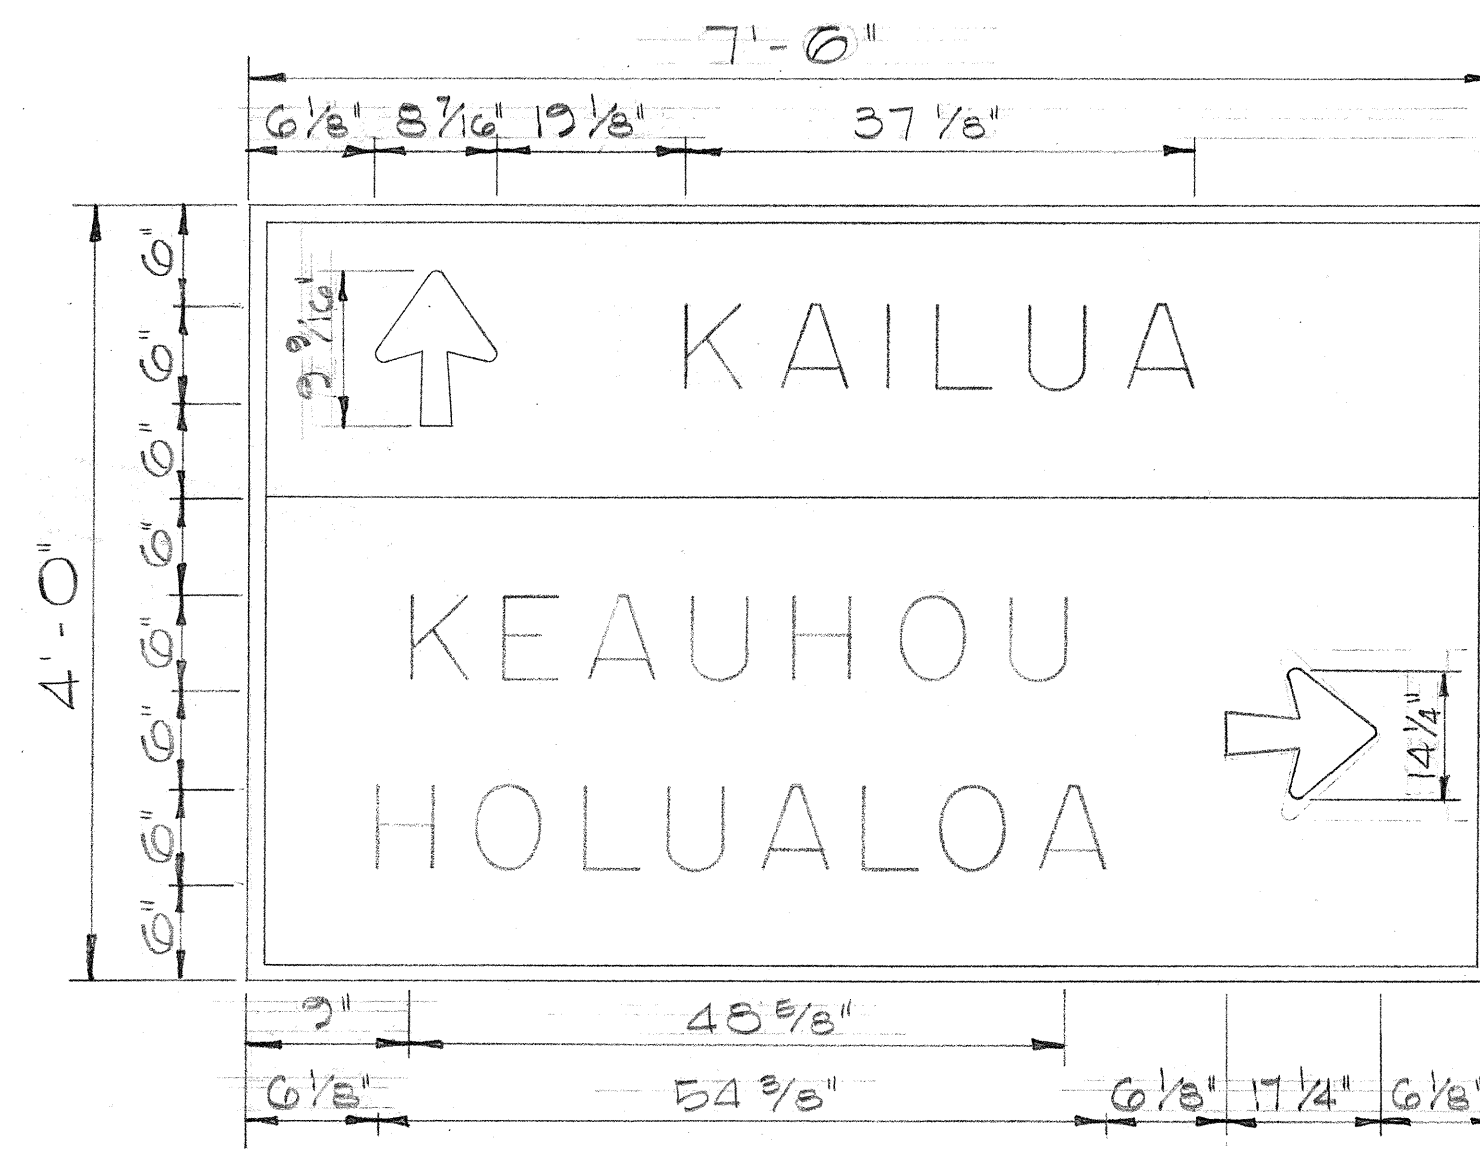


D-4

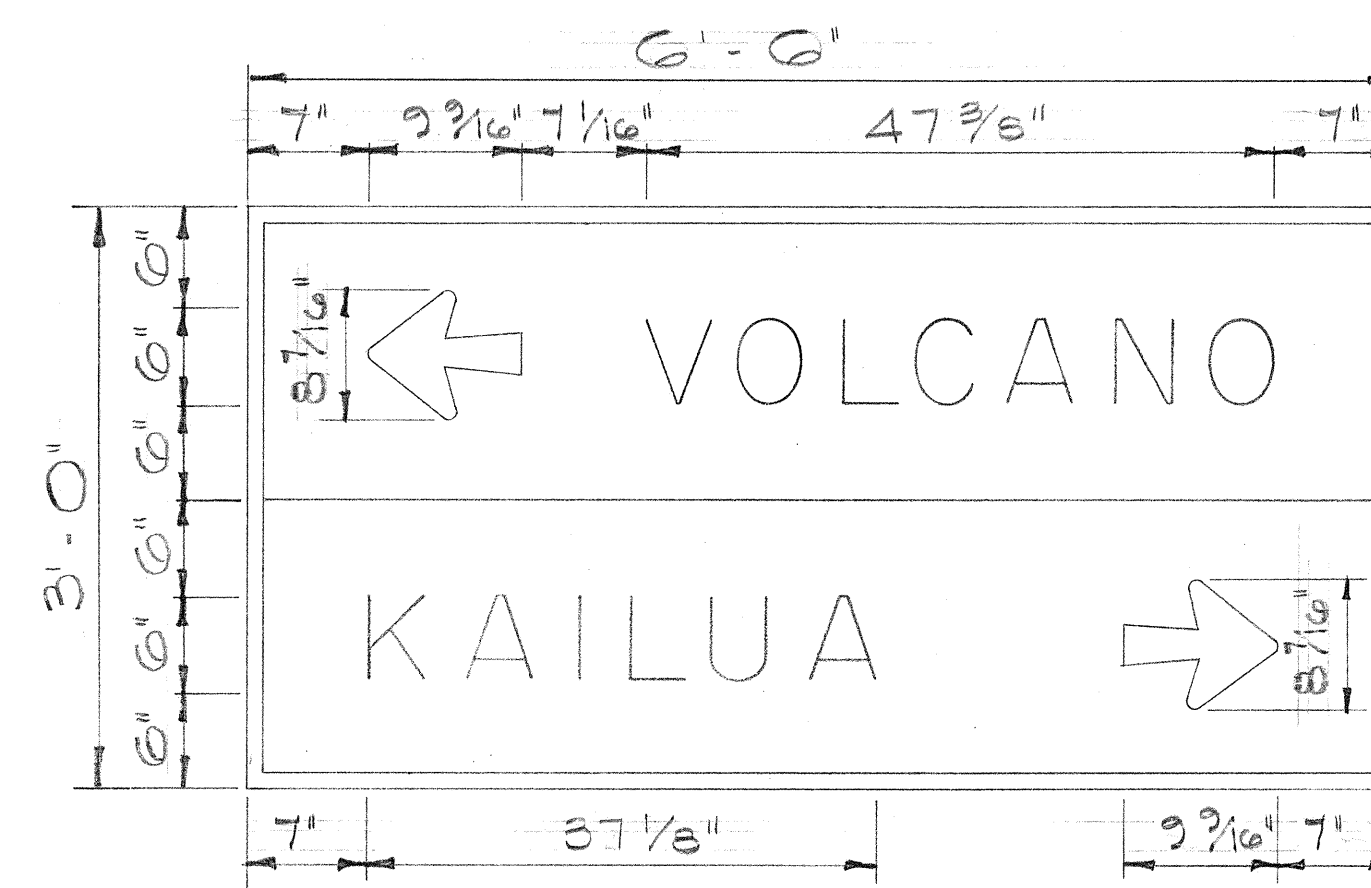


D-5

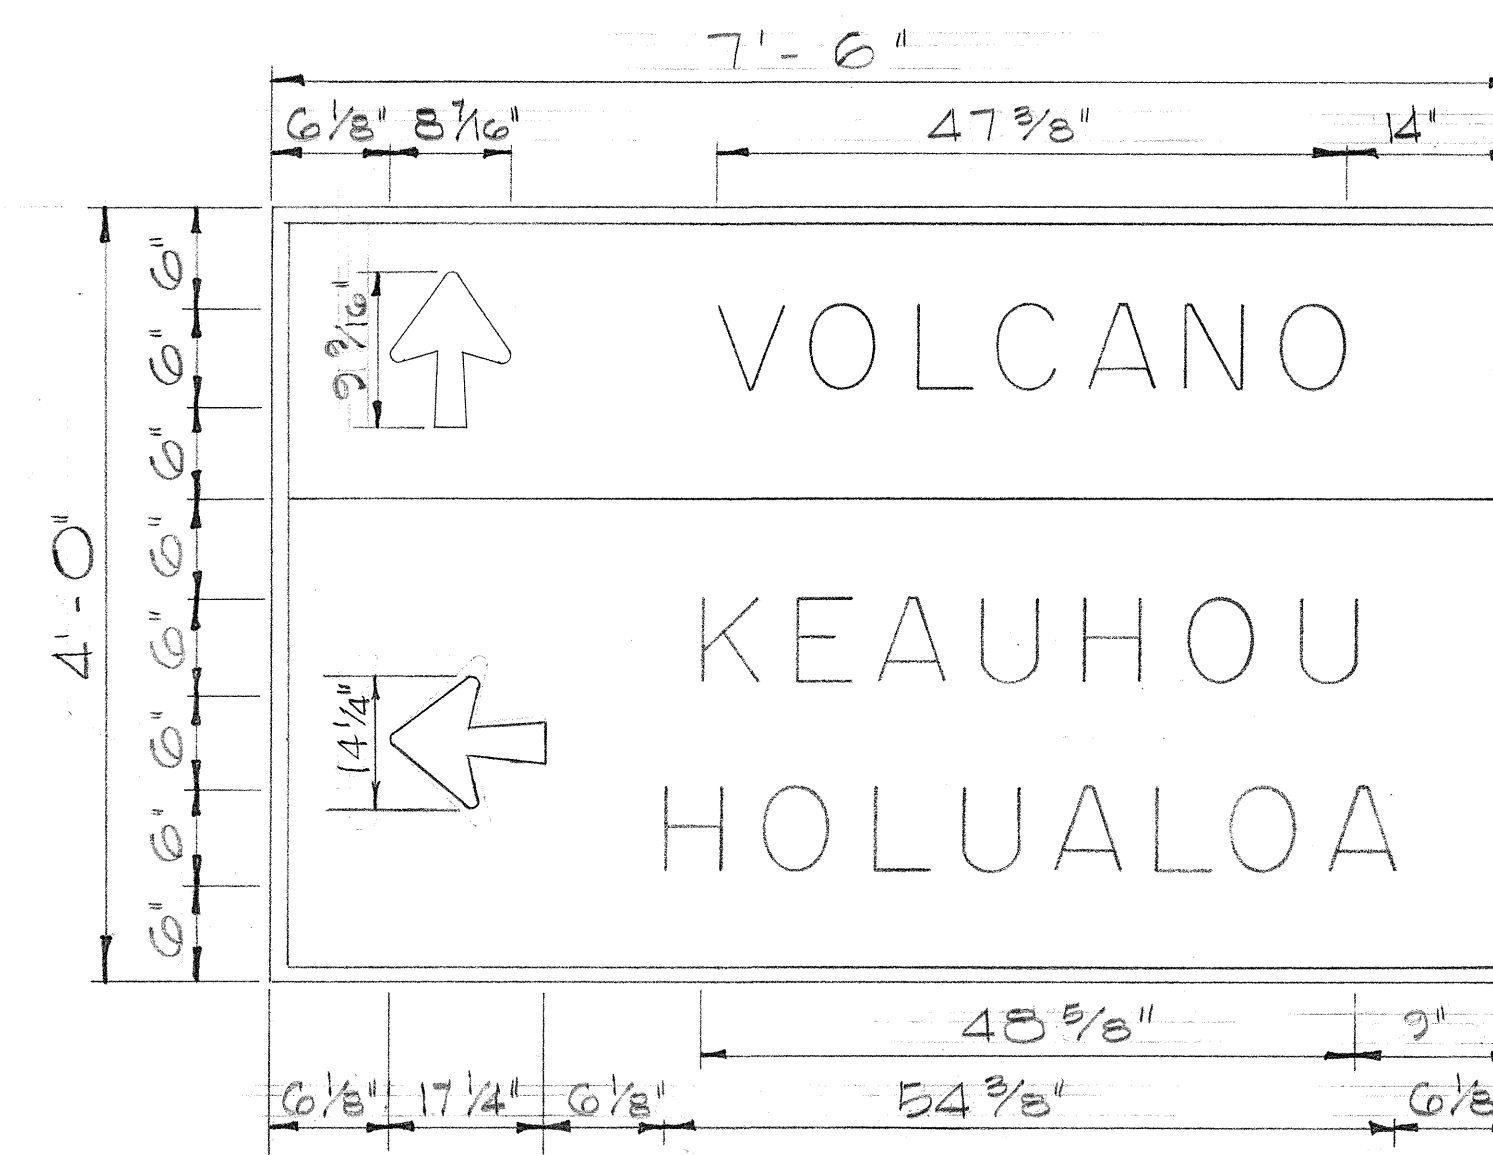


D-6

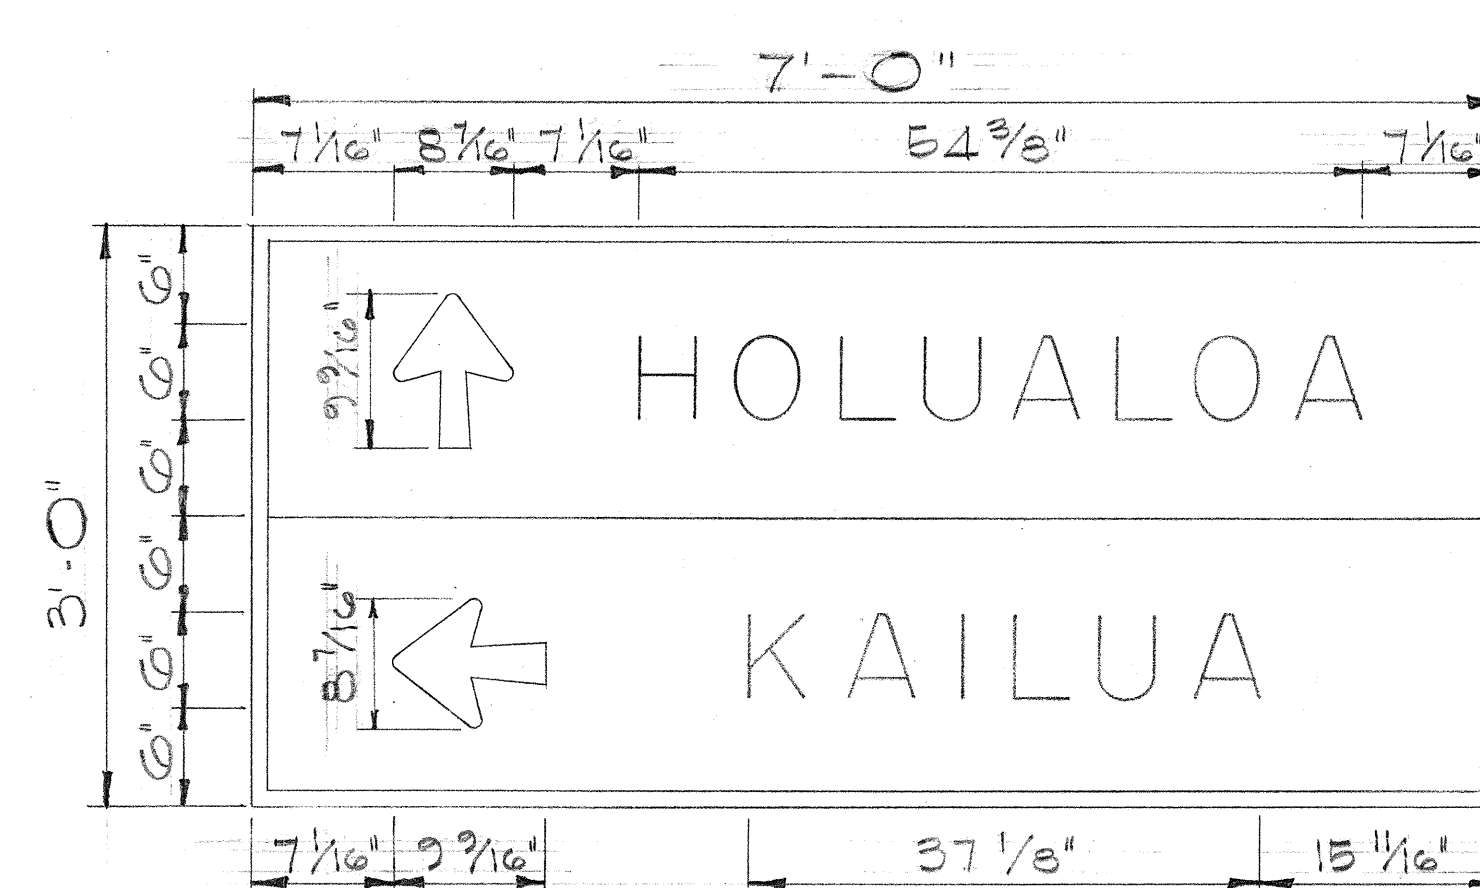

D-7

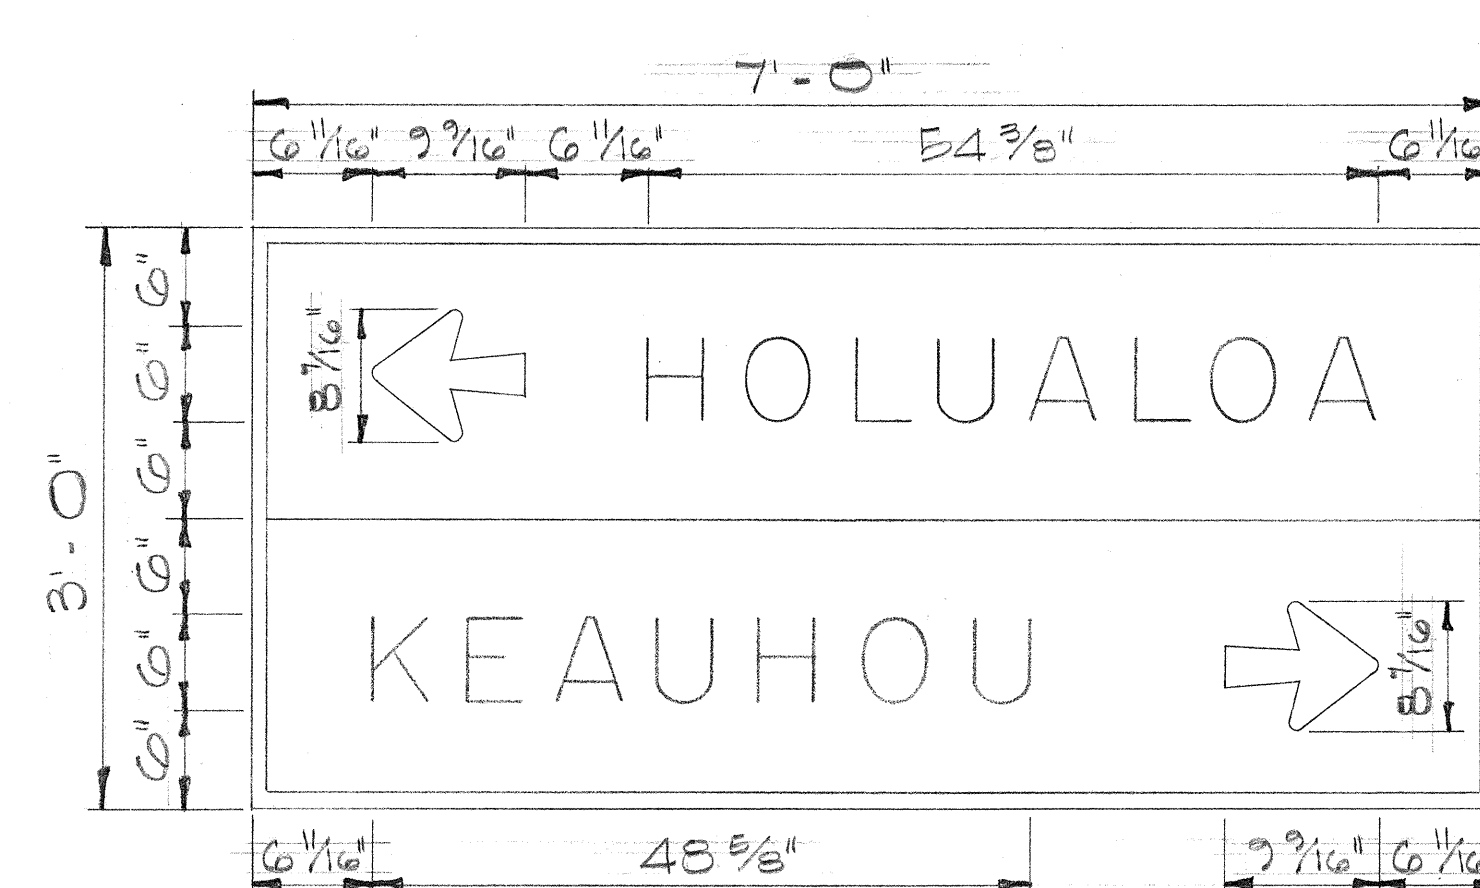

D-8

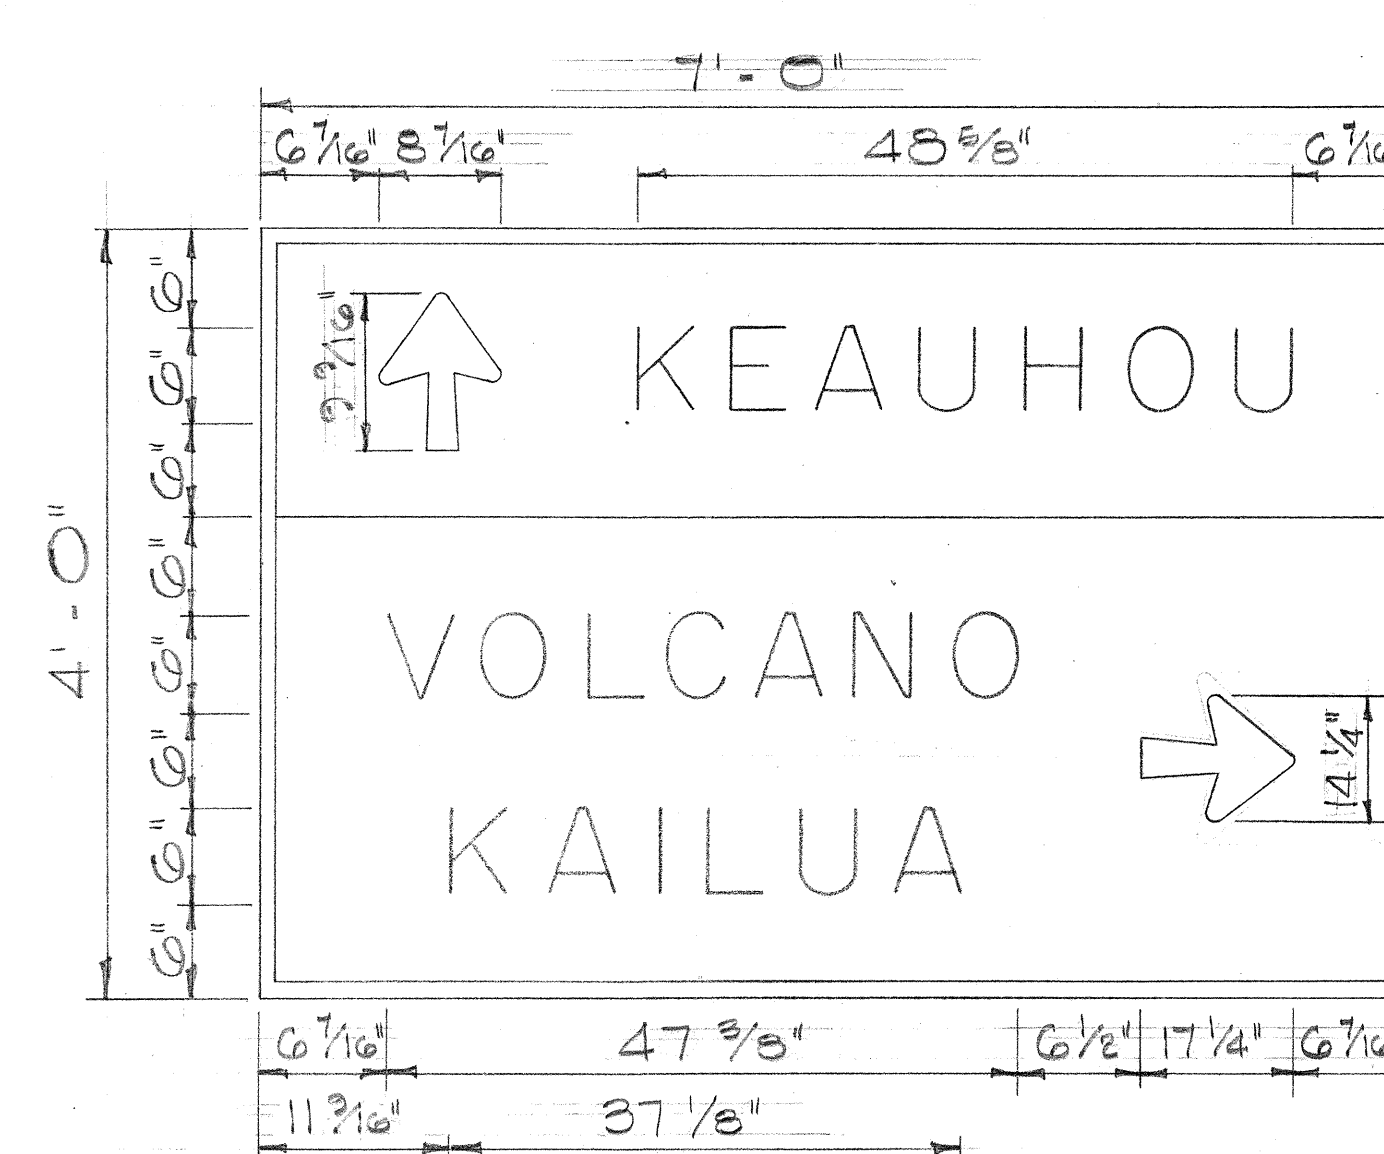

D-9

ORIGINAL PLAN	DATE
NOTED BY	
DESIGNED BY	
QUANTITIES BY	
CHECKED BY	

STATE OF HAWAII
DEPARTMENT OF TRANSPORTATION
HIGHWAYS DIVISION

DESTINATION SIGNS
HAWAII BELT ROAD
PROJ. NO. F-011-1(4)
KAINALIU TO KEAUHOU

Not to Scale Sept. 1962
SHEET No. OF SHEETS