

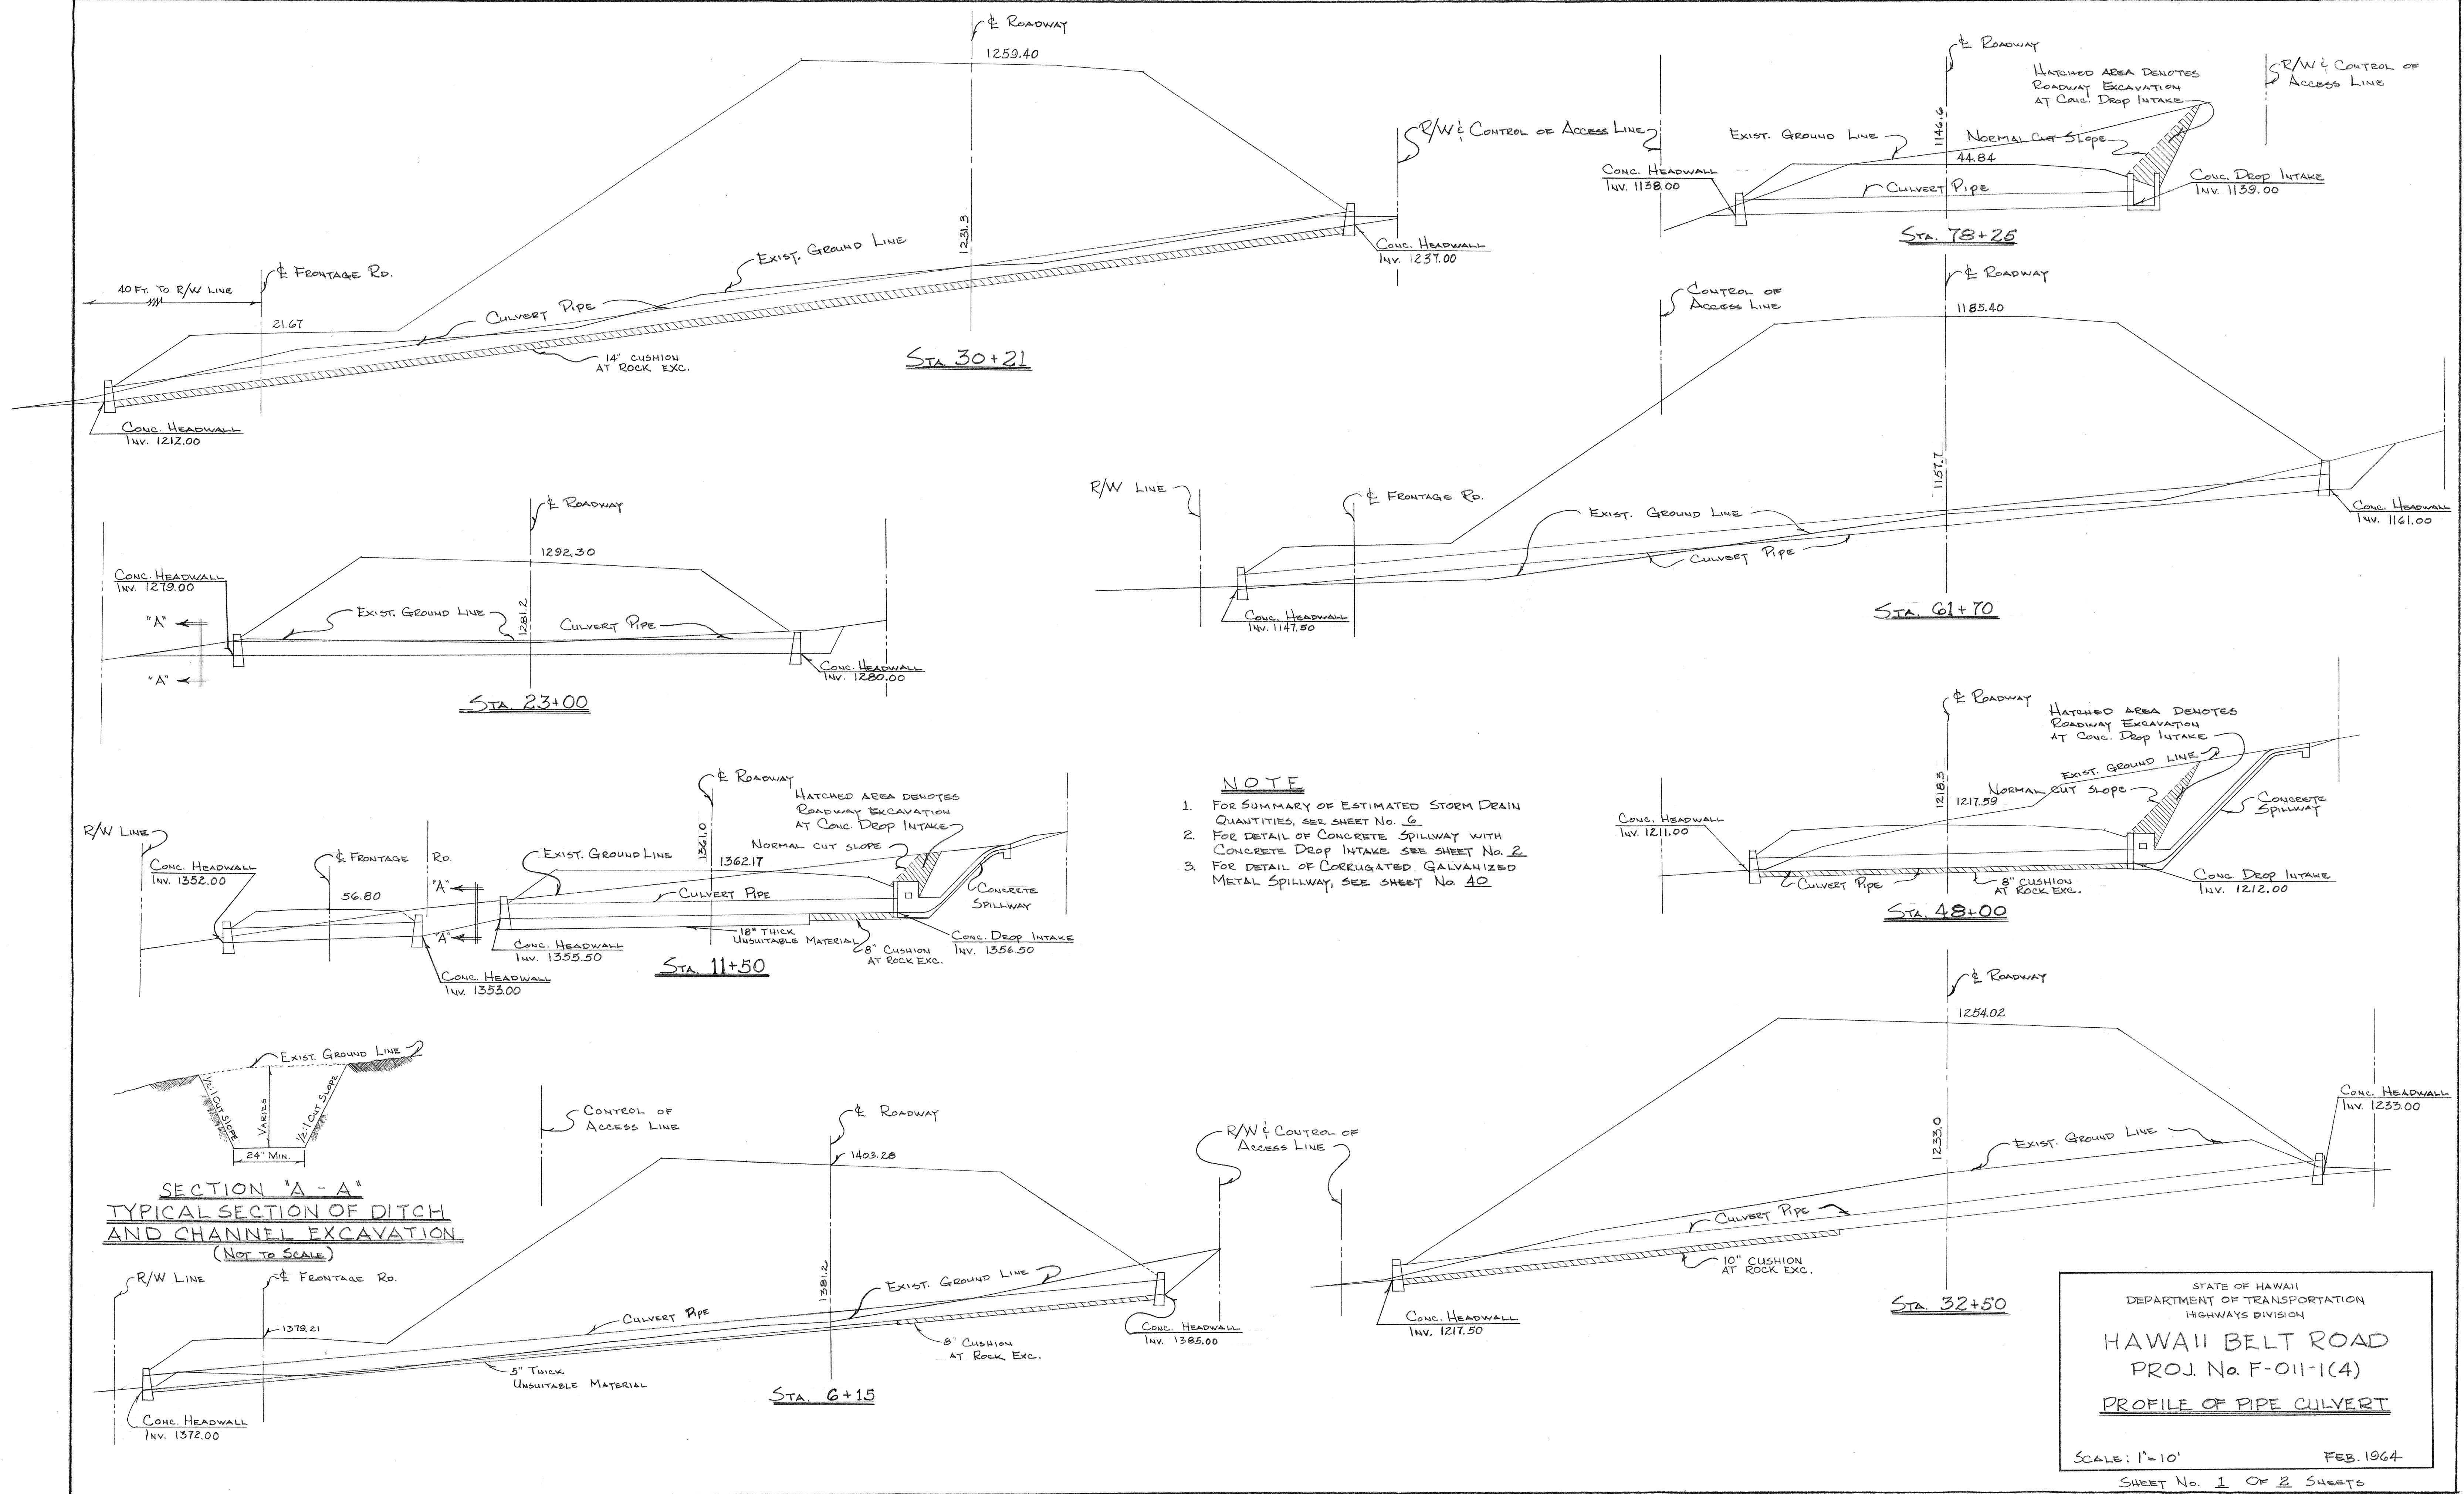


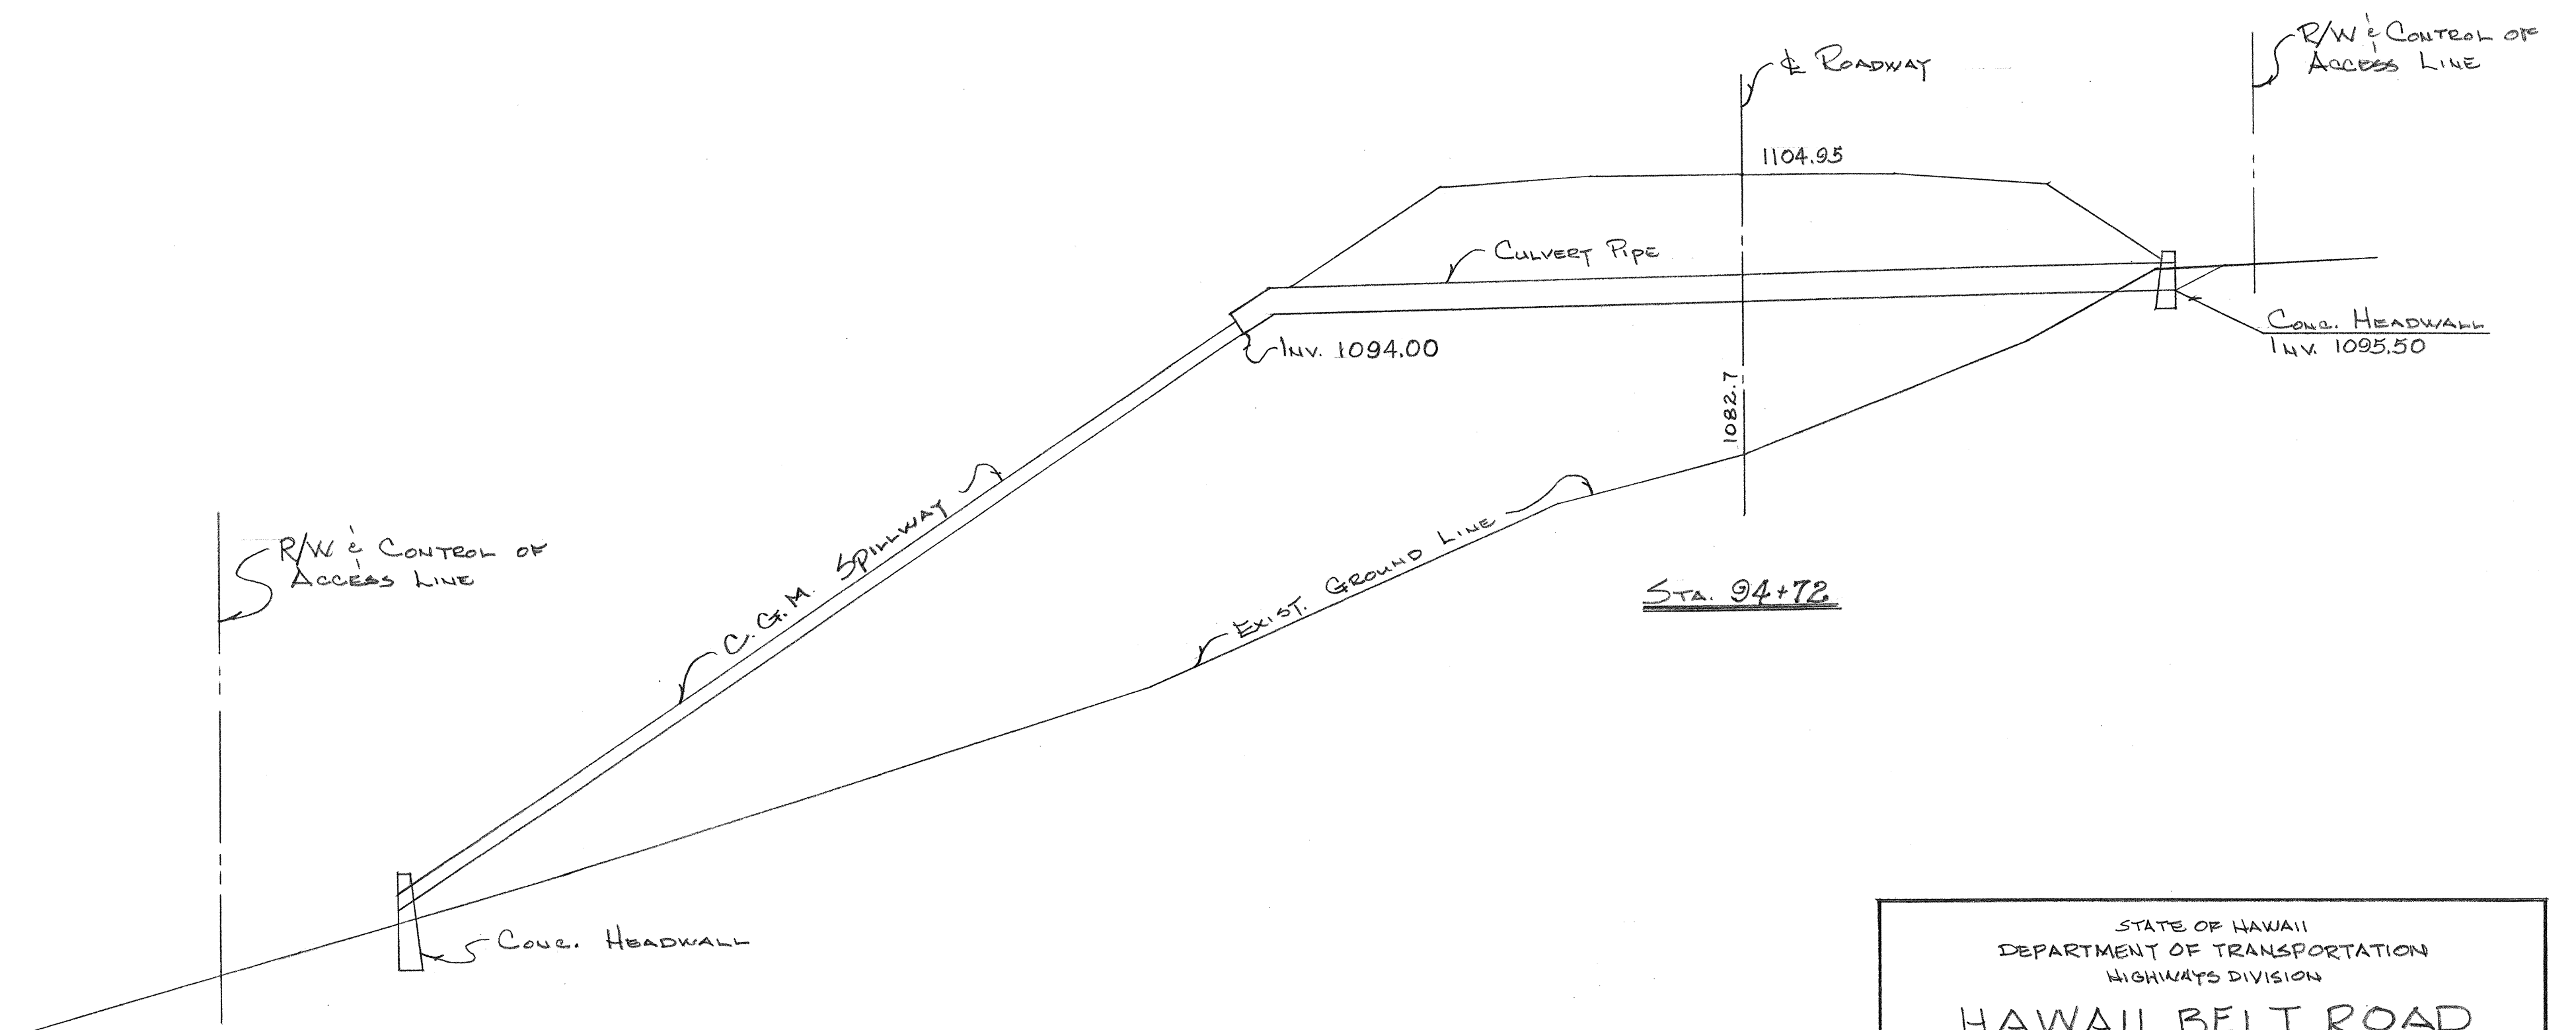

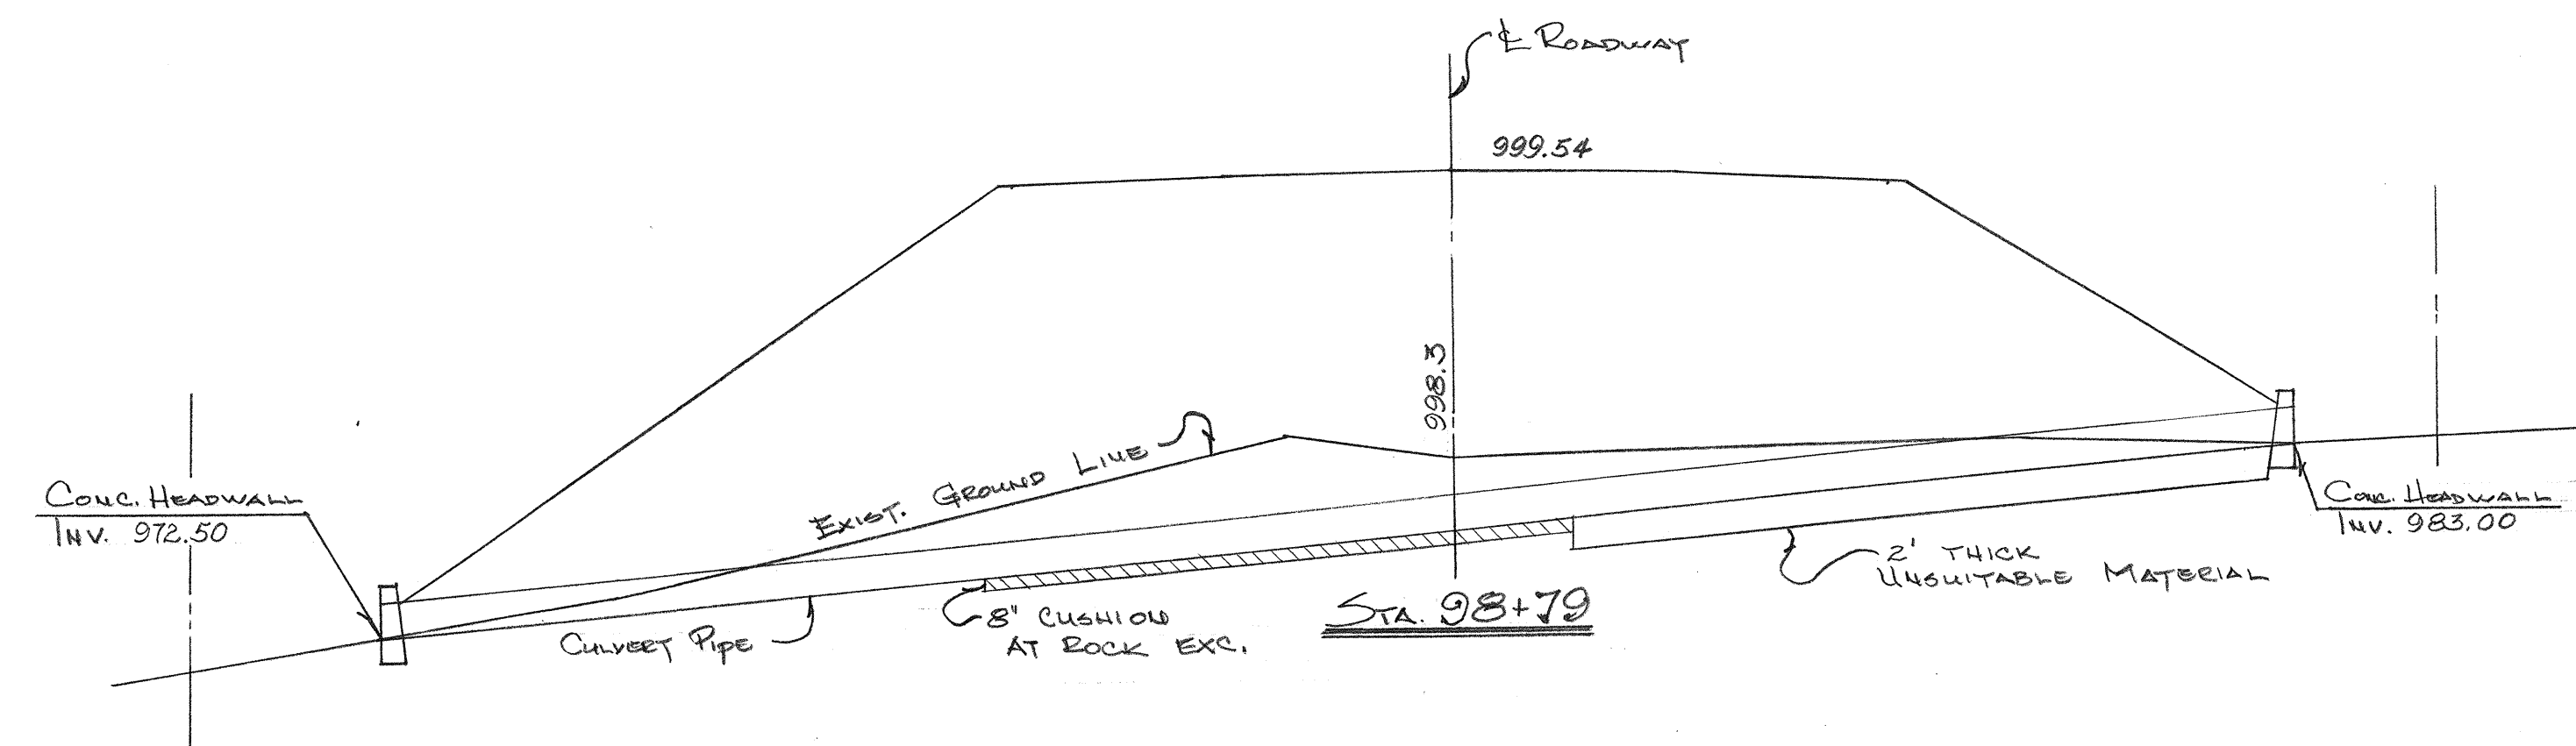

STATE OF HAWAII  
DEPARTMENT OF TRANSPORTATION  
HIGHWAYS DIVISION  
**HAWAII BELT ROAD**  
PROJ. No. F-011-1(4)  
**PROFILE OF PIPE CULVERT**  
SCALE: 1"=10' FEB. 1965  
SHEET NO. 2 OF 2 SHEETS