

INDEX TO DRAWINGS	
SHEET	DESCRIPTION
1	TITLE SHEET
2-3	PLAN & PROFILE
4	STANDARD DETAILS
5-6	CROSS SECTIONS

STATE OF HAWAII

DEPARTMENT OF TRANSPORTATION

"AS BUILT"

PLANS FOR IMPROVEMENTS OF

KANOELEHUA-KEKUANAOA



STREET INTERSECTION

PROJECT NO. P-II-01-65

DISTRICT OF SOUTH HILO

ISLAND OF HAWAII

SCALES	
PLAN	1 INCH = 50 FT.
PROFILE	1 INCH = 50 FT.
VER.	1 INCH = 5 FT.
CROSS SECTION	1 INCH = 10 FT.
HOR.	1 INCH = 10 FT.
VER.	1 INCH = 10 FT.

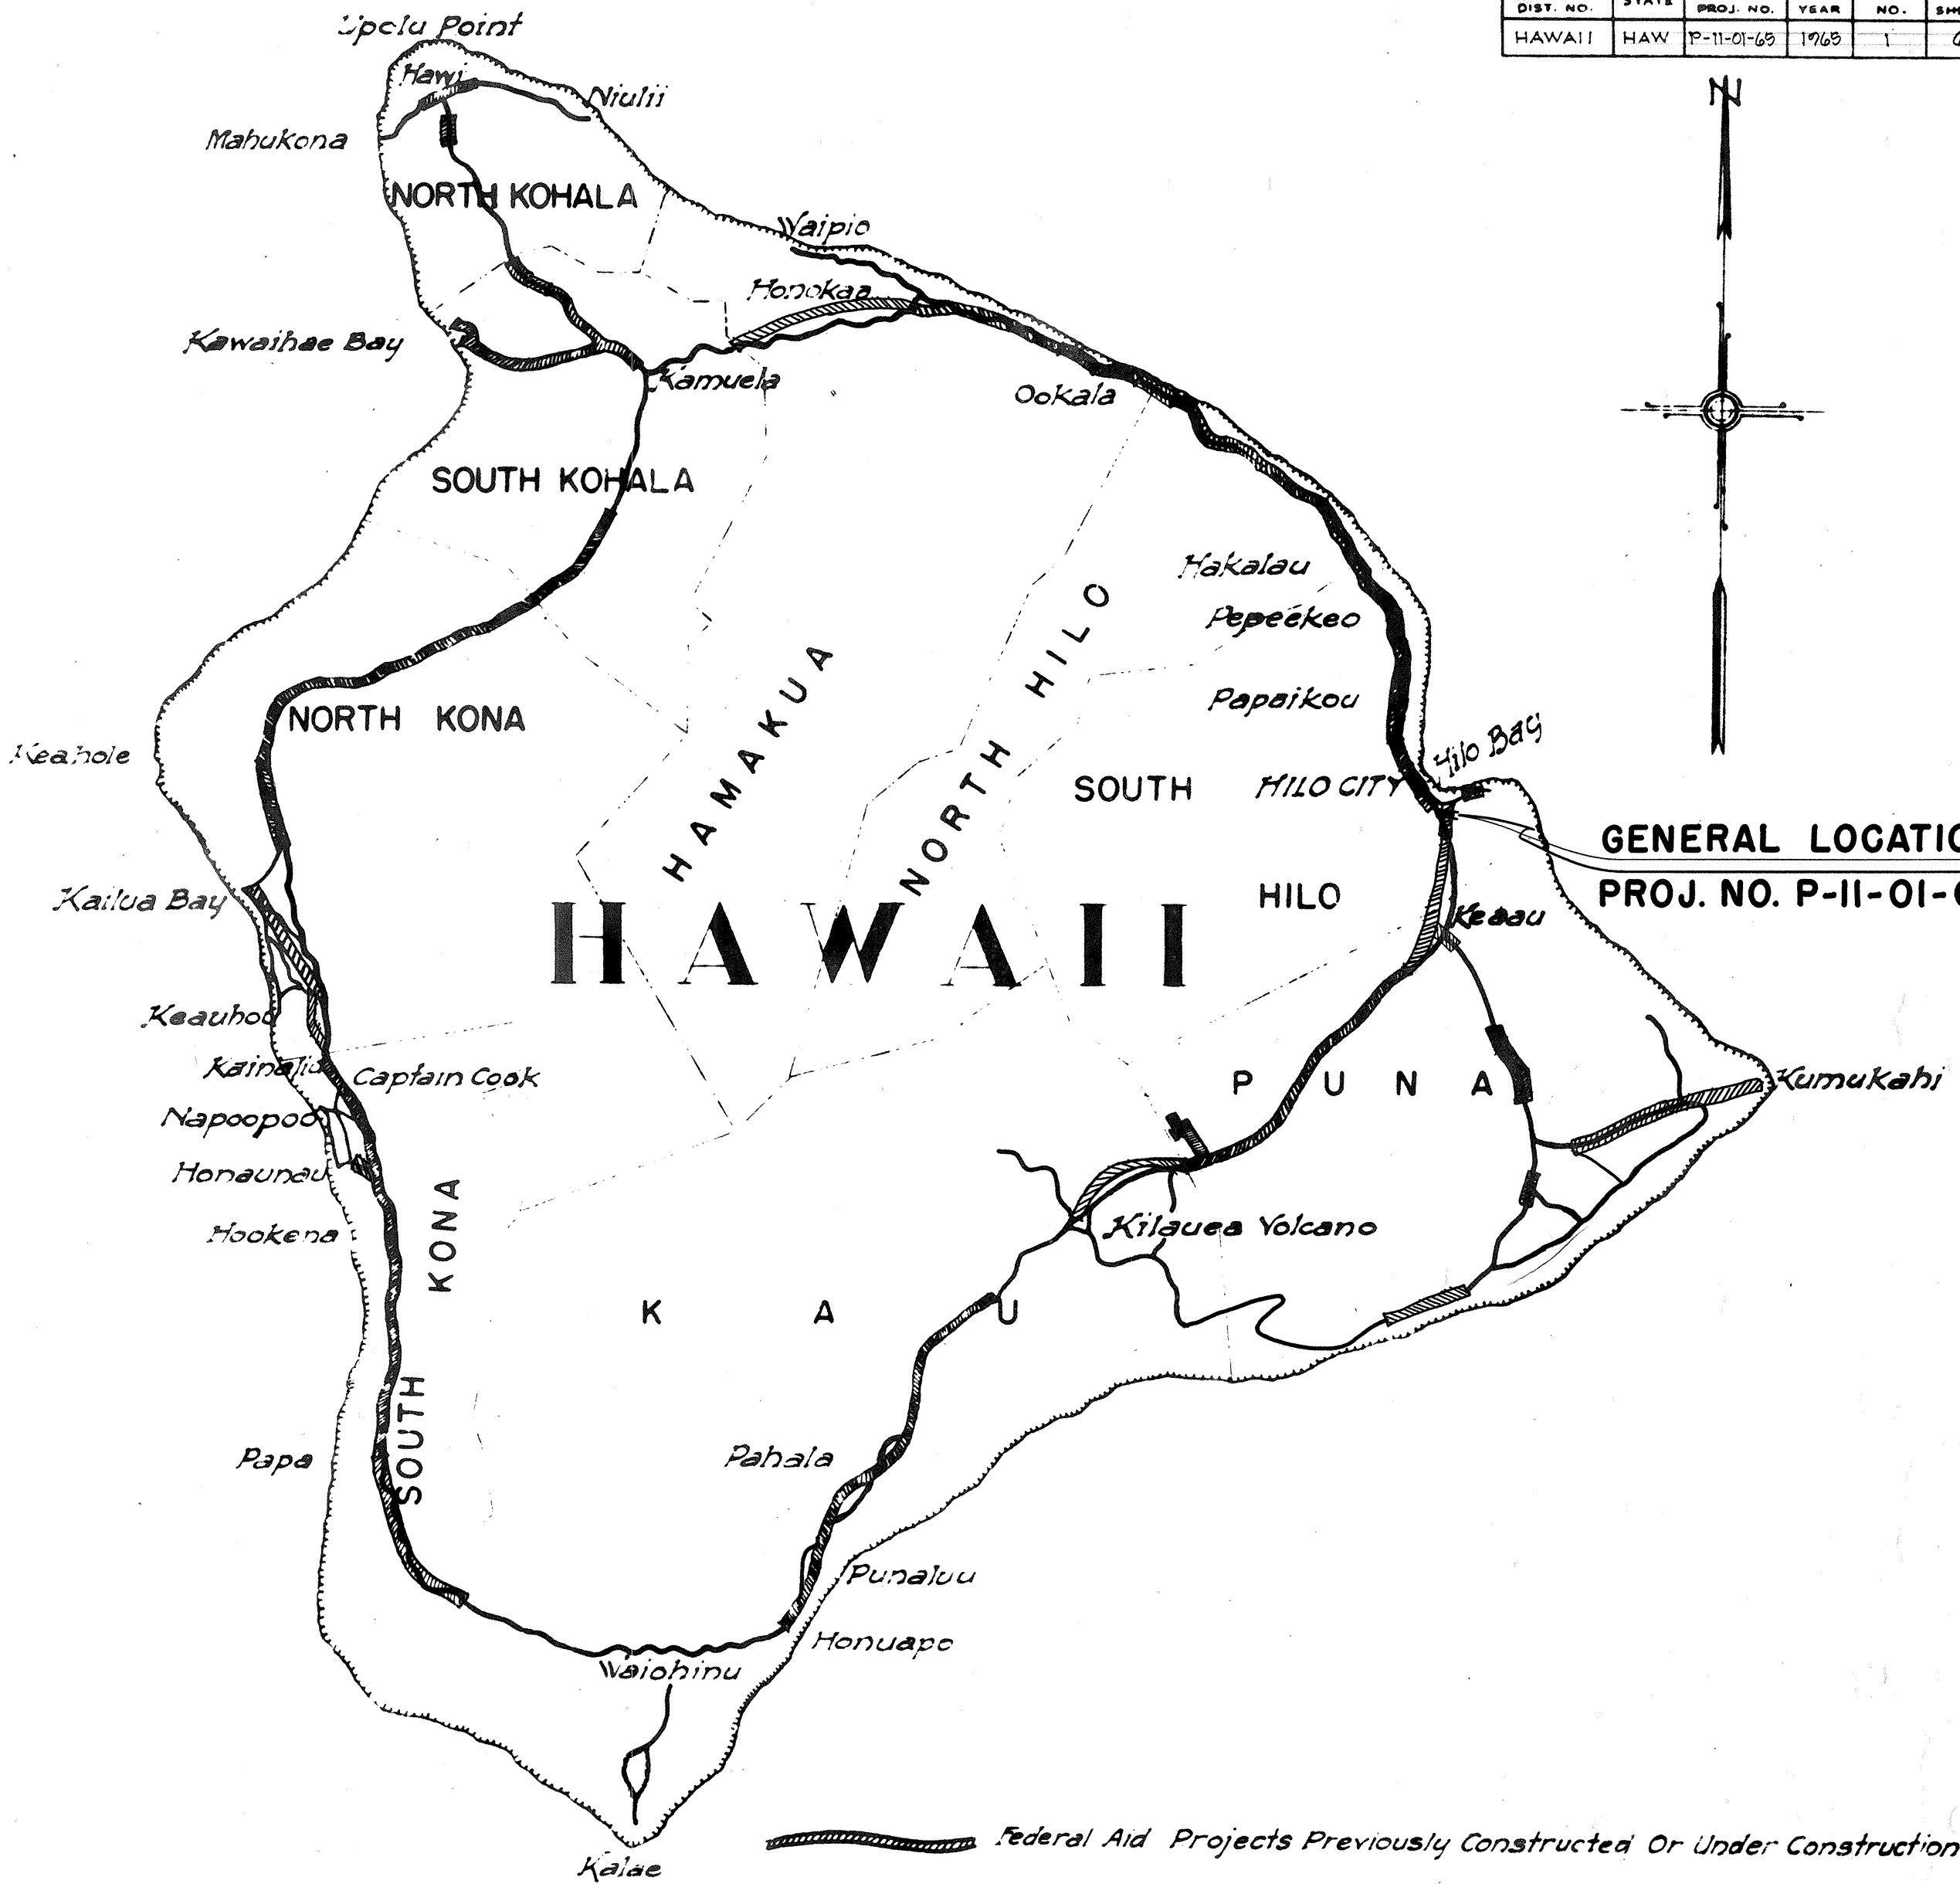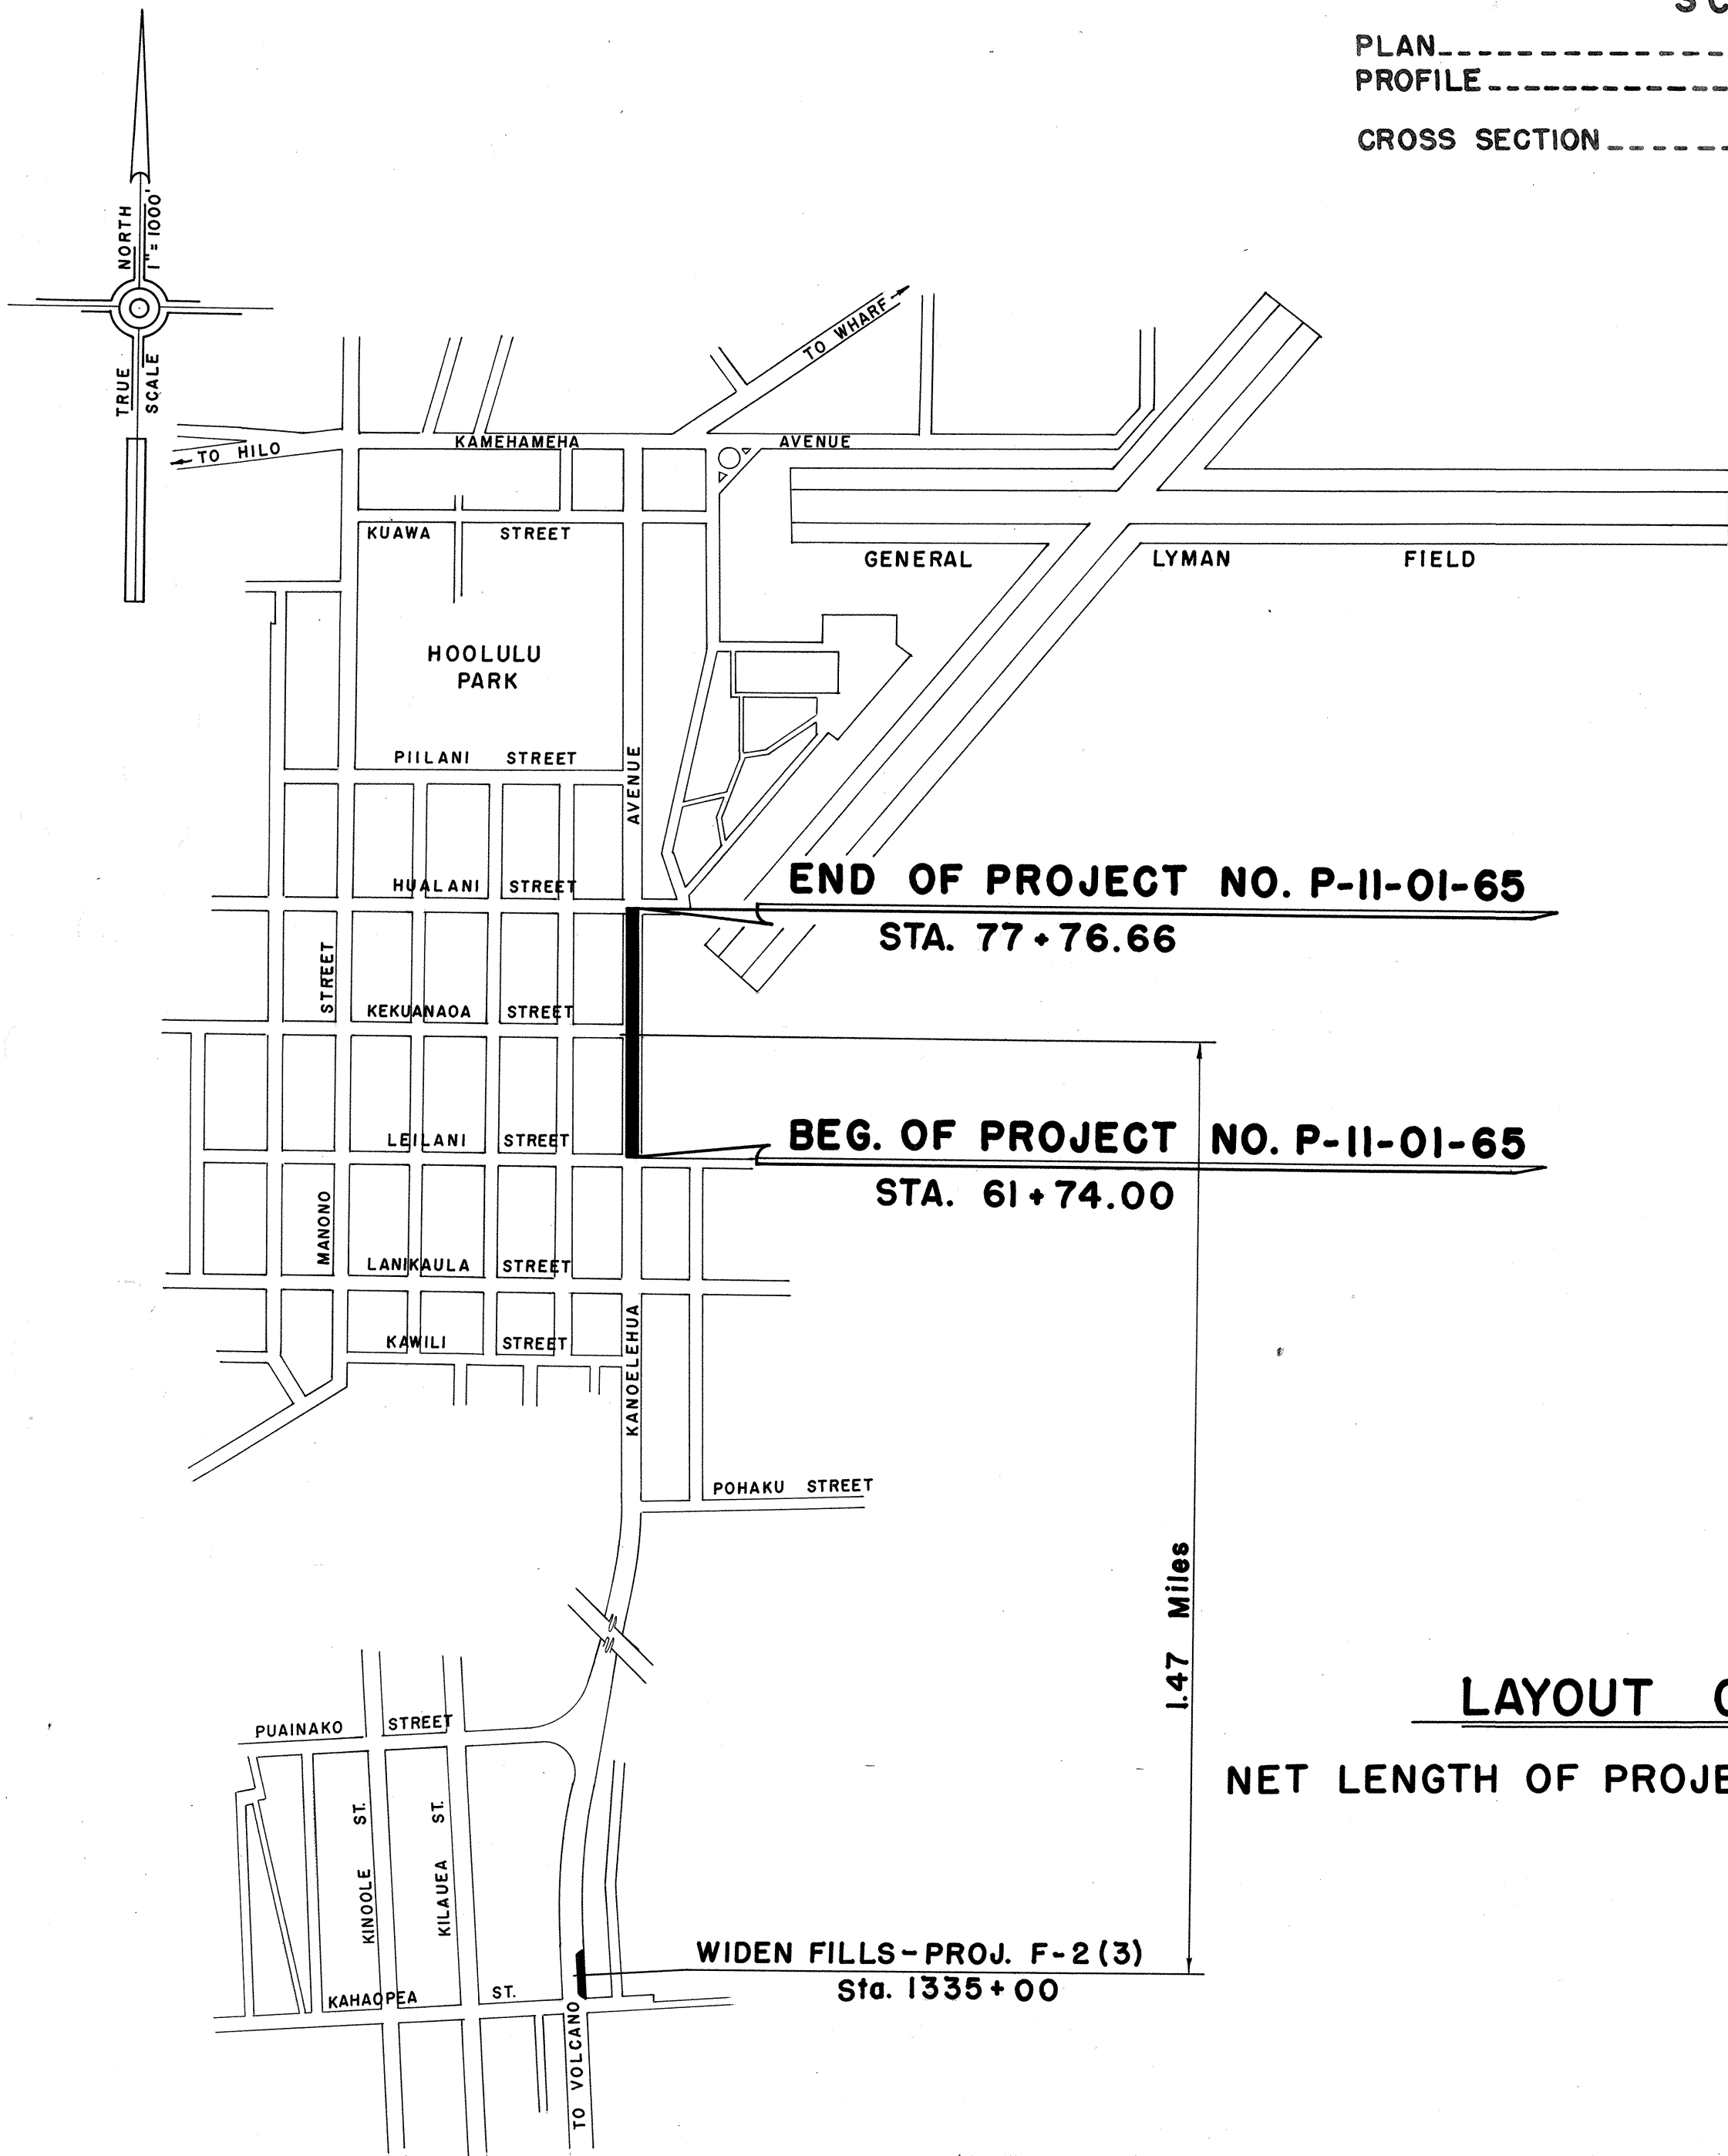

NOTE:

ALL CHANGES MADE DURING CONSTRUCTION

HAVE BEEN NOTED IN RED ON THESE

TRACINGS AND CHECKED BY:

Seward G. Allen

PROJECT ENGINEER

6/9/67

DATE

APPROVED:

DATE 11 May 65

Director of Transportation

DATE

DESIGNED BY

TRACED BY

CHECKED BY

APPROVED BY

DATE