


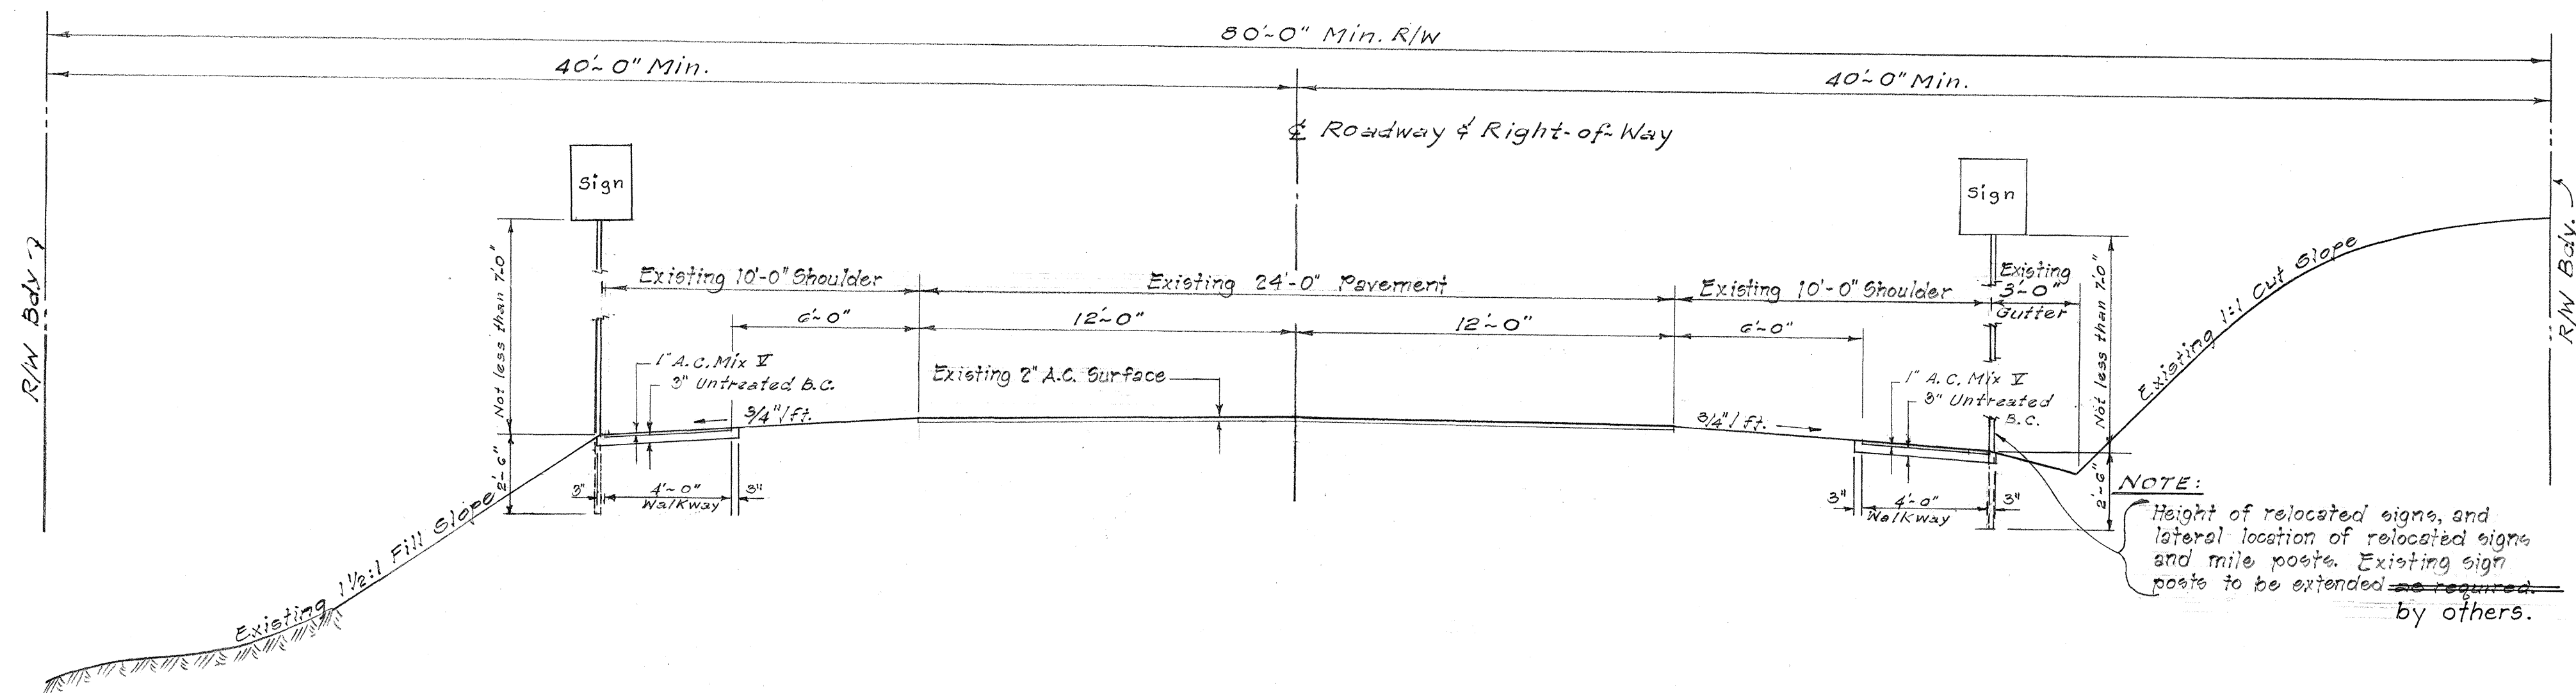

TYPICAL ROAD SECTION


Scale: 1/4" = 1'-0"

MOUNTAIN VIEW TO KURTISTOWN

SHOULDER IMPROVEMENTS

PROJECT NO. M-11-01-65 UNIT 1

NOTE: See plan for A.C. walkway locations.

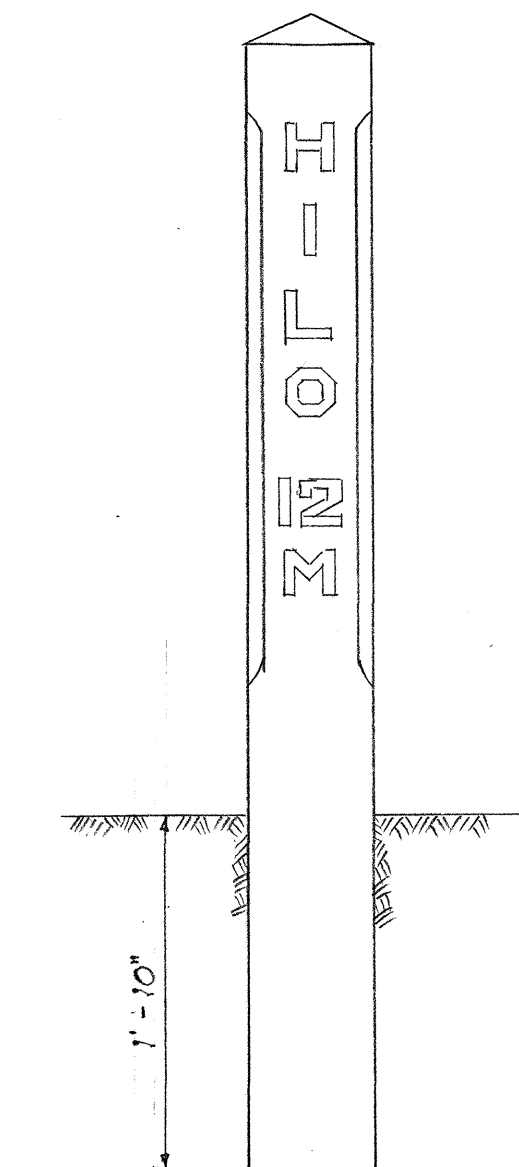

DETAIL FOR RELOCATED MILE POSTS


Scale: 1" = 1'-0"

GENERAL NOTE:

1. Replacement of existing incandescent lamps with mercury vapor lamps and installation of new poles with mercury vapor lamps are not included in this contract and installation.
2. Relocating of existing signs and posts will not be by others. ~~paid for separately but shall be considered incidents to roadway excavation.~~

NOTES FOR TRAFFIC SIGNS

1. The shape, color, dimensions, symbols, wording, lettering, and reflectorization of all signs shall be in accordance with the "Manual on Uniform Traffic Control Devices for Streets and Highways," dated June 1961 and the "BPR Manual 'Standard Highway Signs,' dated September 1961, unless otherwise specified.
2. All warning signs shall be reflectorized unless otherwise specified.
3. All warning signs shall have 3/8" bolt holes drilled at appropriate locations unless otherwise noted.



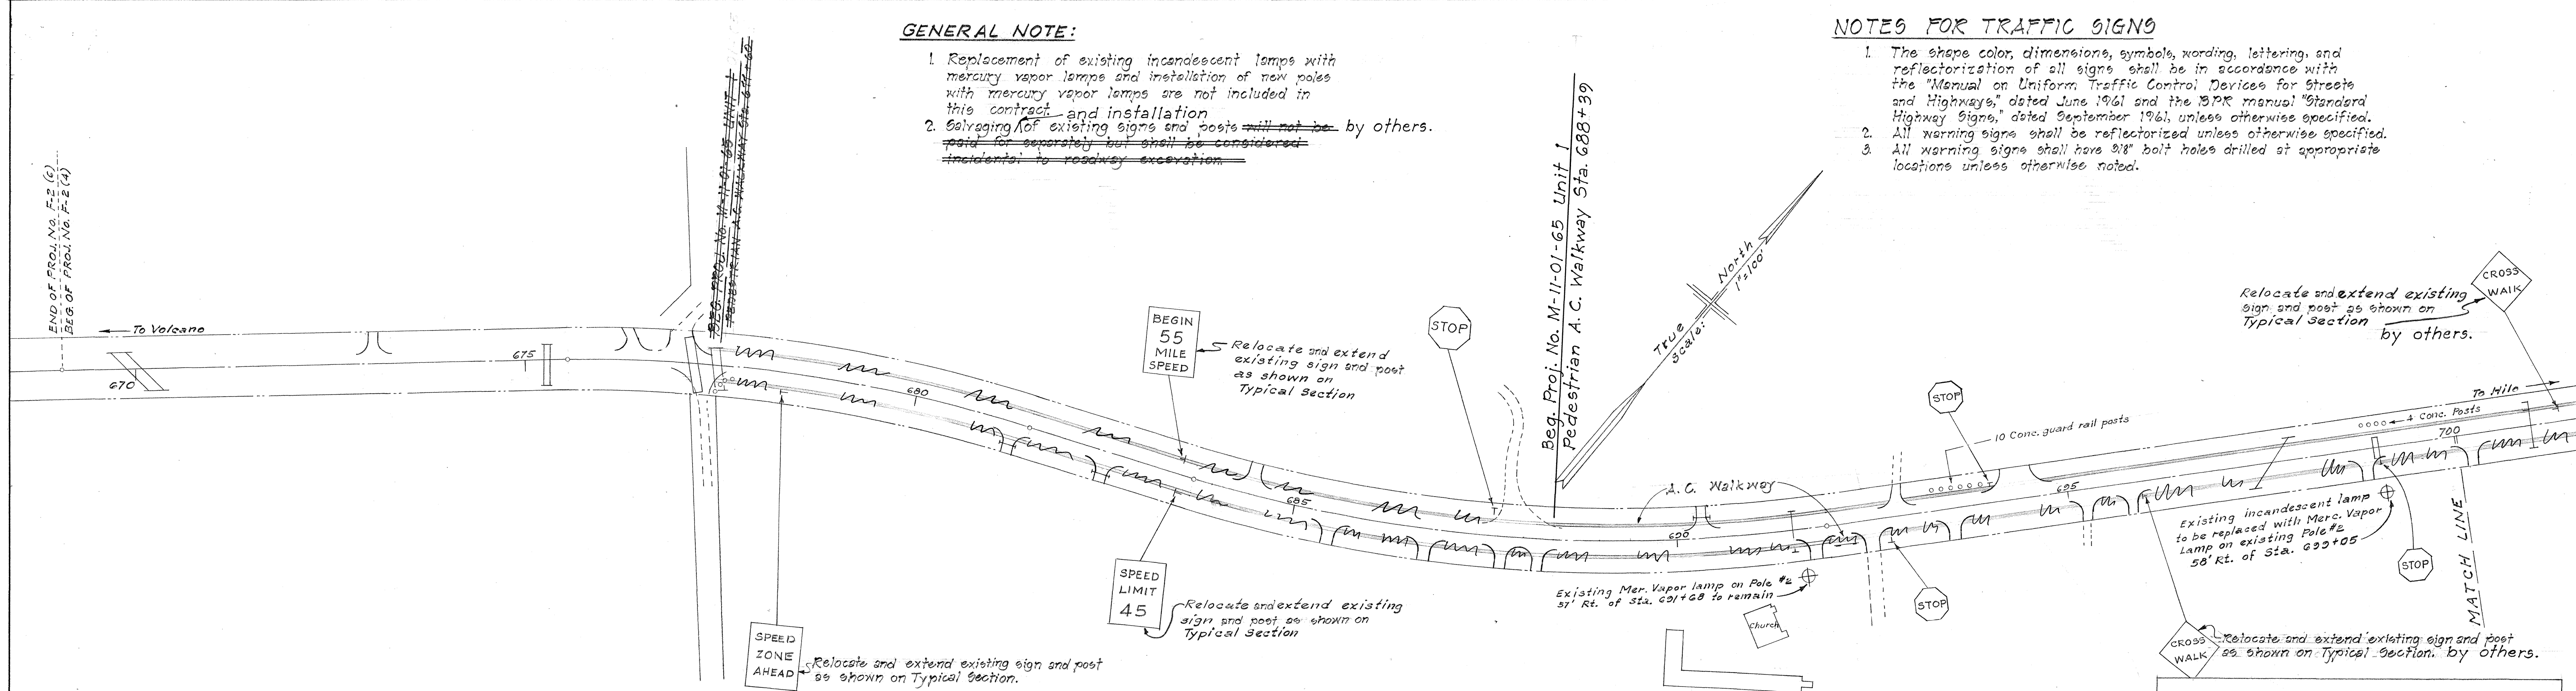


DEPARTMENT OF TRANSPORTATION
HIGHWAYS DIVISION
STATE OF HAWAII



SHOULDER IMPROVEMENTS
HAWAII BELT ROAD
PROJECT NO. M-11-01-65 UNIT 1
PUNA, HAWAII

Scale: As Noted April, 1965

Sheet 1 of 3 Sheets

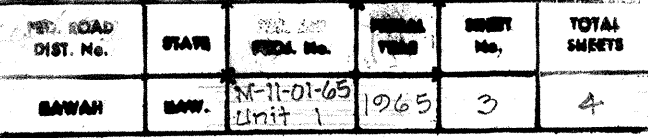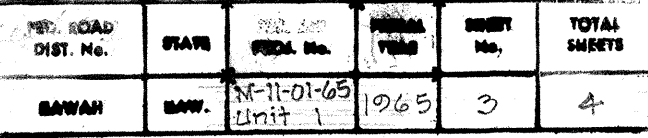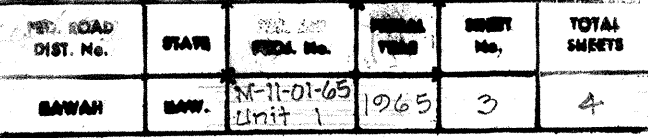

PROJ. ROAD DIST. NO.	STATE	PROJ. NO.	PROJ. YEAR	SHEET NO.	TOTAL SHEETS
HAWAII	HAW.	M-11-01-65 Unit 1	1965	4	4

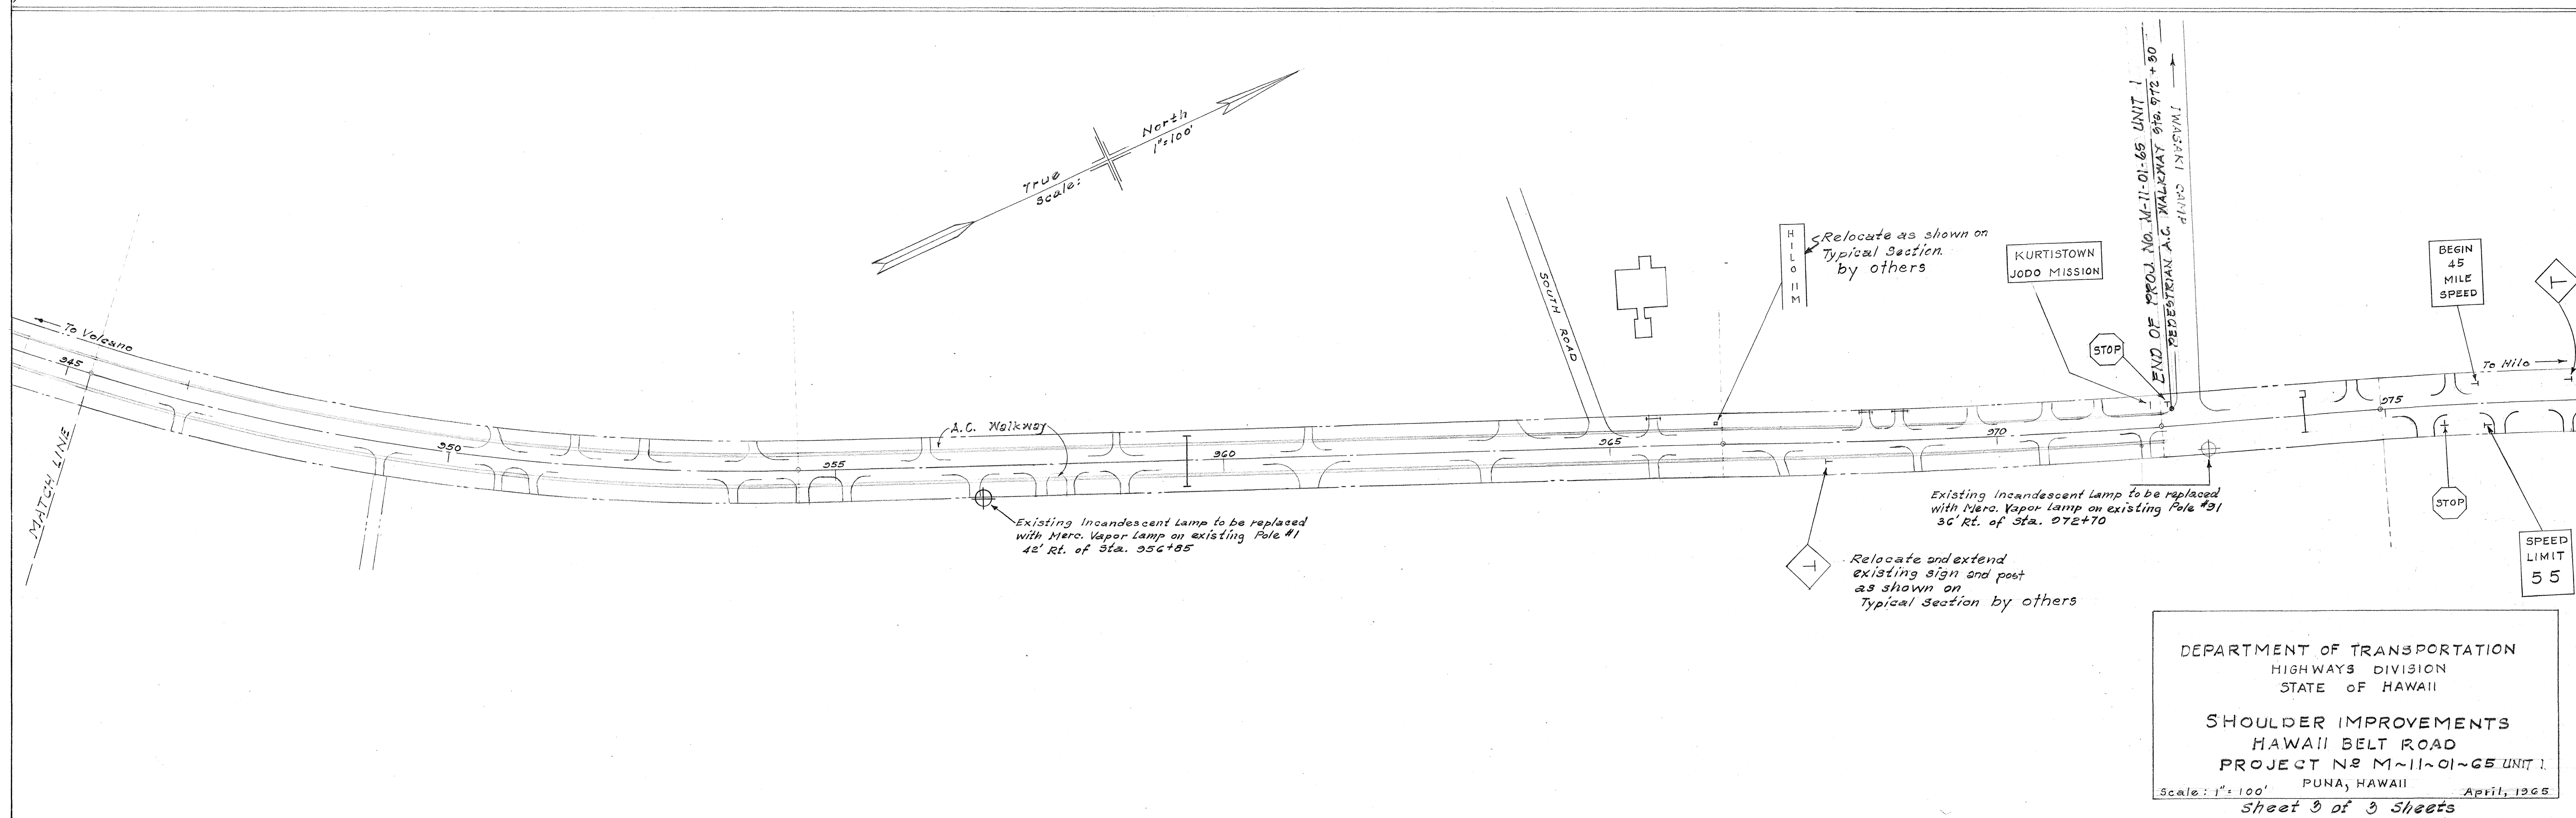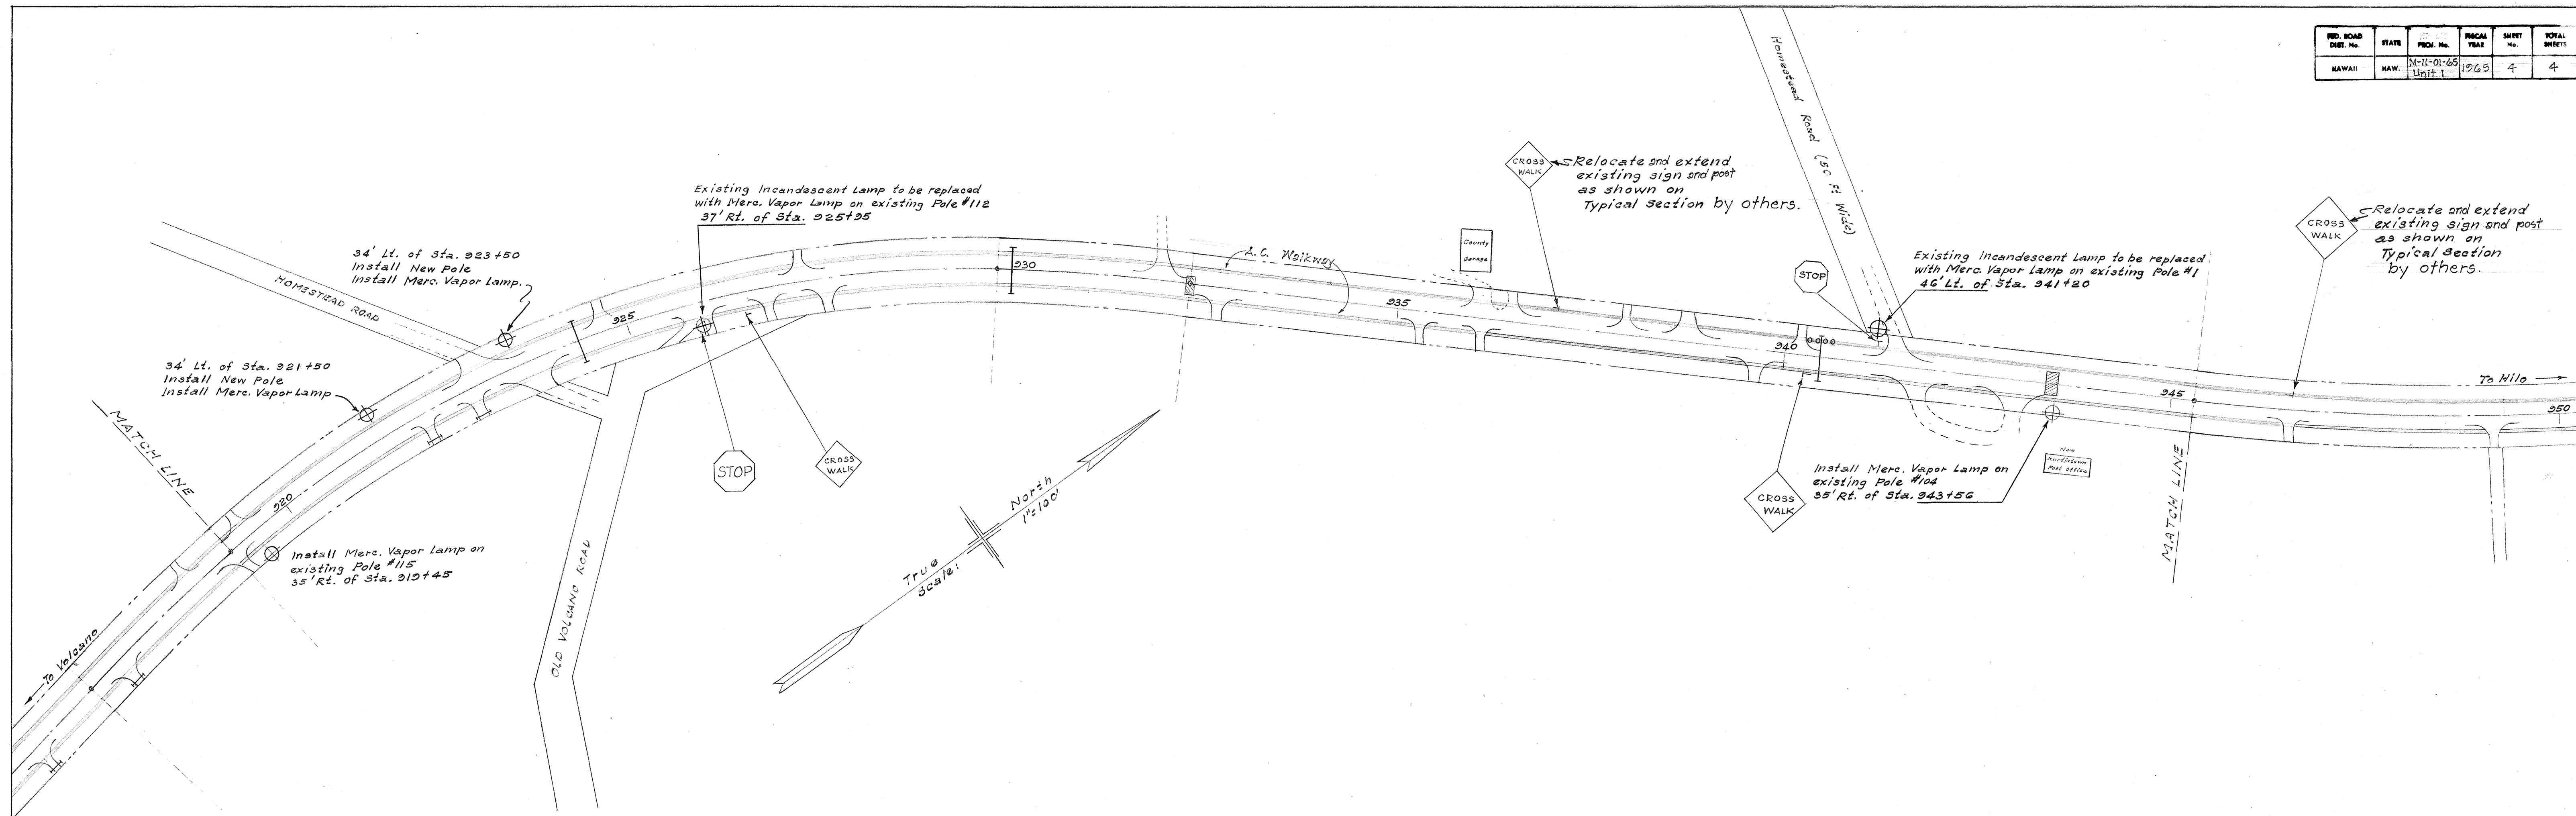

DEPARTMENT OF TRANSPORTATION
HIGHWAYS DIVISION
STATE OF HAWAII

SHOULDER IMPROVEMENTS
HAWAII BELT ROAD
PROJECT N2 M-11-01-65 UNIT 1
PUNA, HAWAII
April, 1965

Scale: 1"=100'

Sheet 3 of 3 Sheets