


INDEX TO DRAWINGS	
SHEET	DESCRIPTION
1	TITLE SHEET
2-4	TYPICAL SECTION & DETAIL PLAN OF ROADWAY

STATE OF HAWAII  
DEPARTMENT OF TRANSPORTATION  
HIGHWAYS DIVISION  
"AS BUILT" PLANS OF  
SHOULDER IMPROVEMENTS  
AT KEAAU AND MT. VIEW

HAWAII BELT ROAD  
PROJECT NO. IIM-01-67

DISTRICT OF PUNA  
ISLAND OF HAWAII

SCALE  
PLAN ----- 1 INCH = 100 FT.

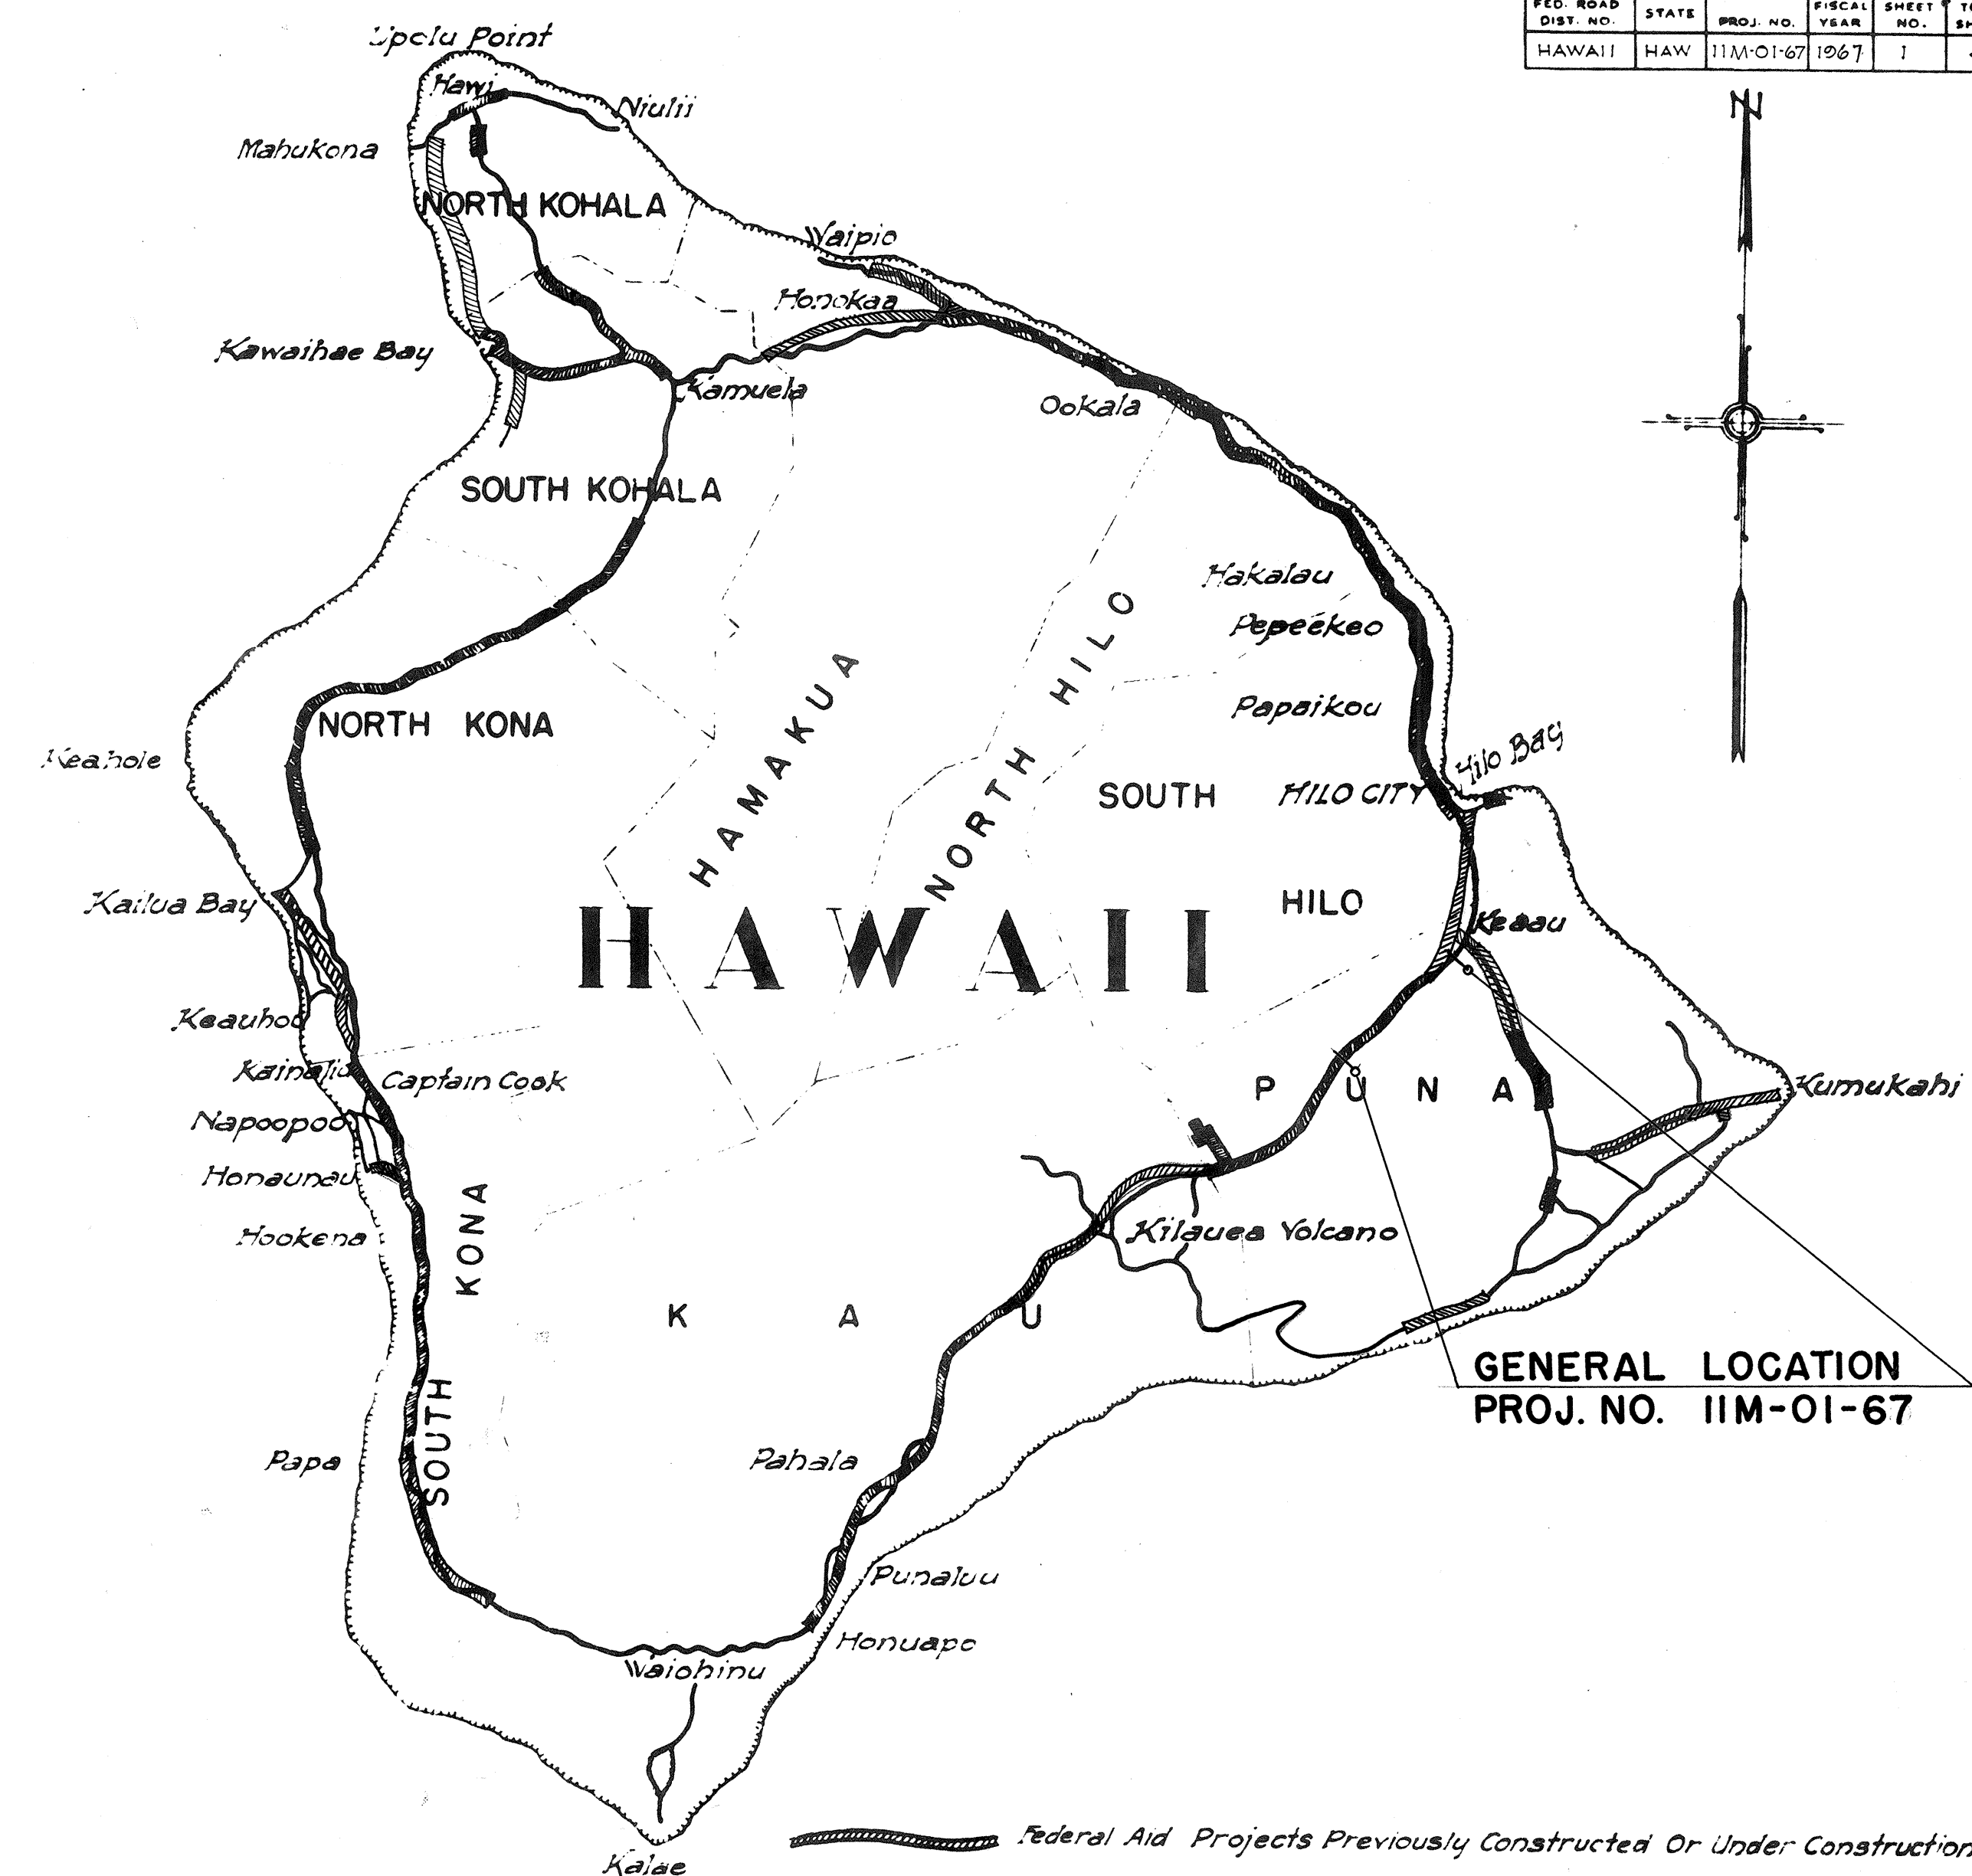


GENERAL LOCATION  
PROJ. NO. IIM-01-67

NOTE:  
ALL CHANGES MADE DURING CONSTRUCTION HAVE  
BEEN NOTED IN RED ON THESE TRACINGS AND CHECKED BY:

*Benjamin Kodani*  
PROJECT ENGINEER

DATE

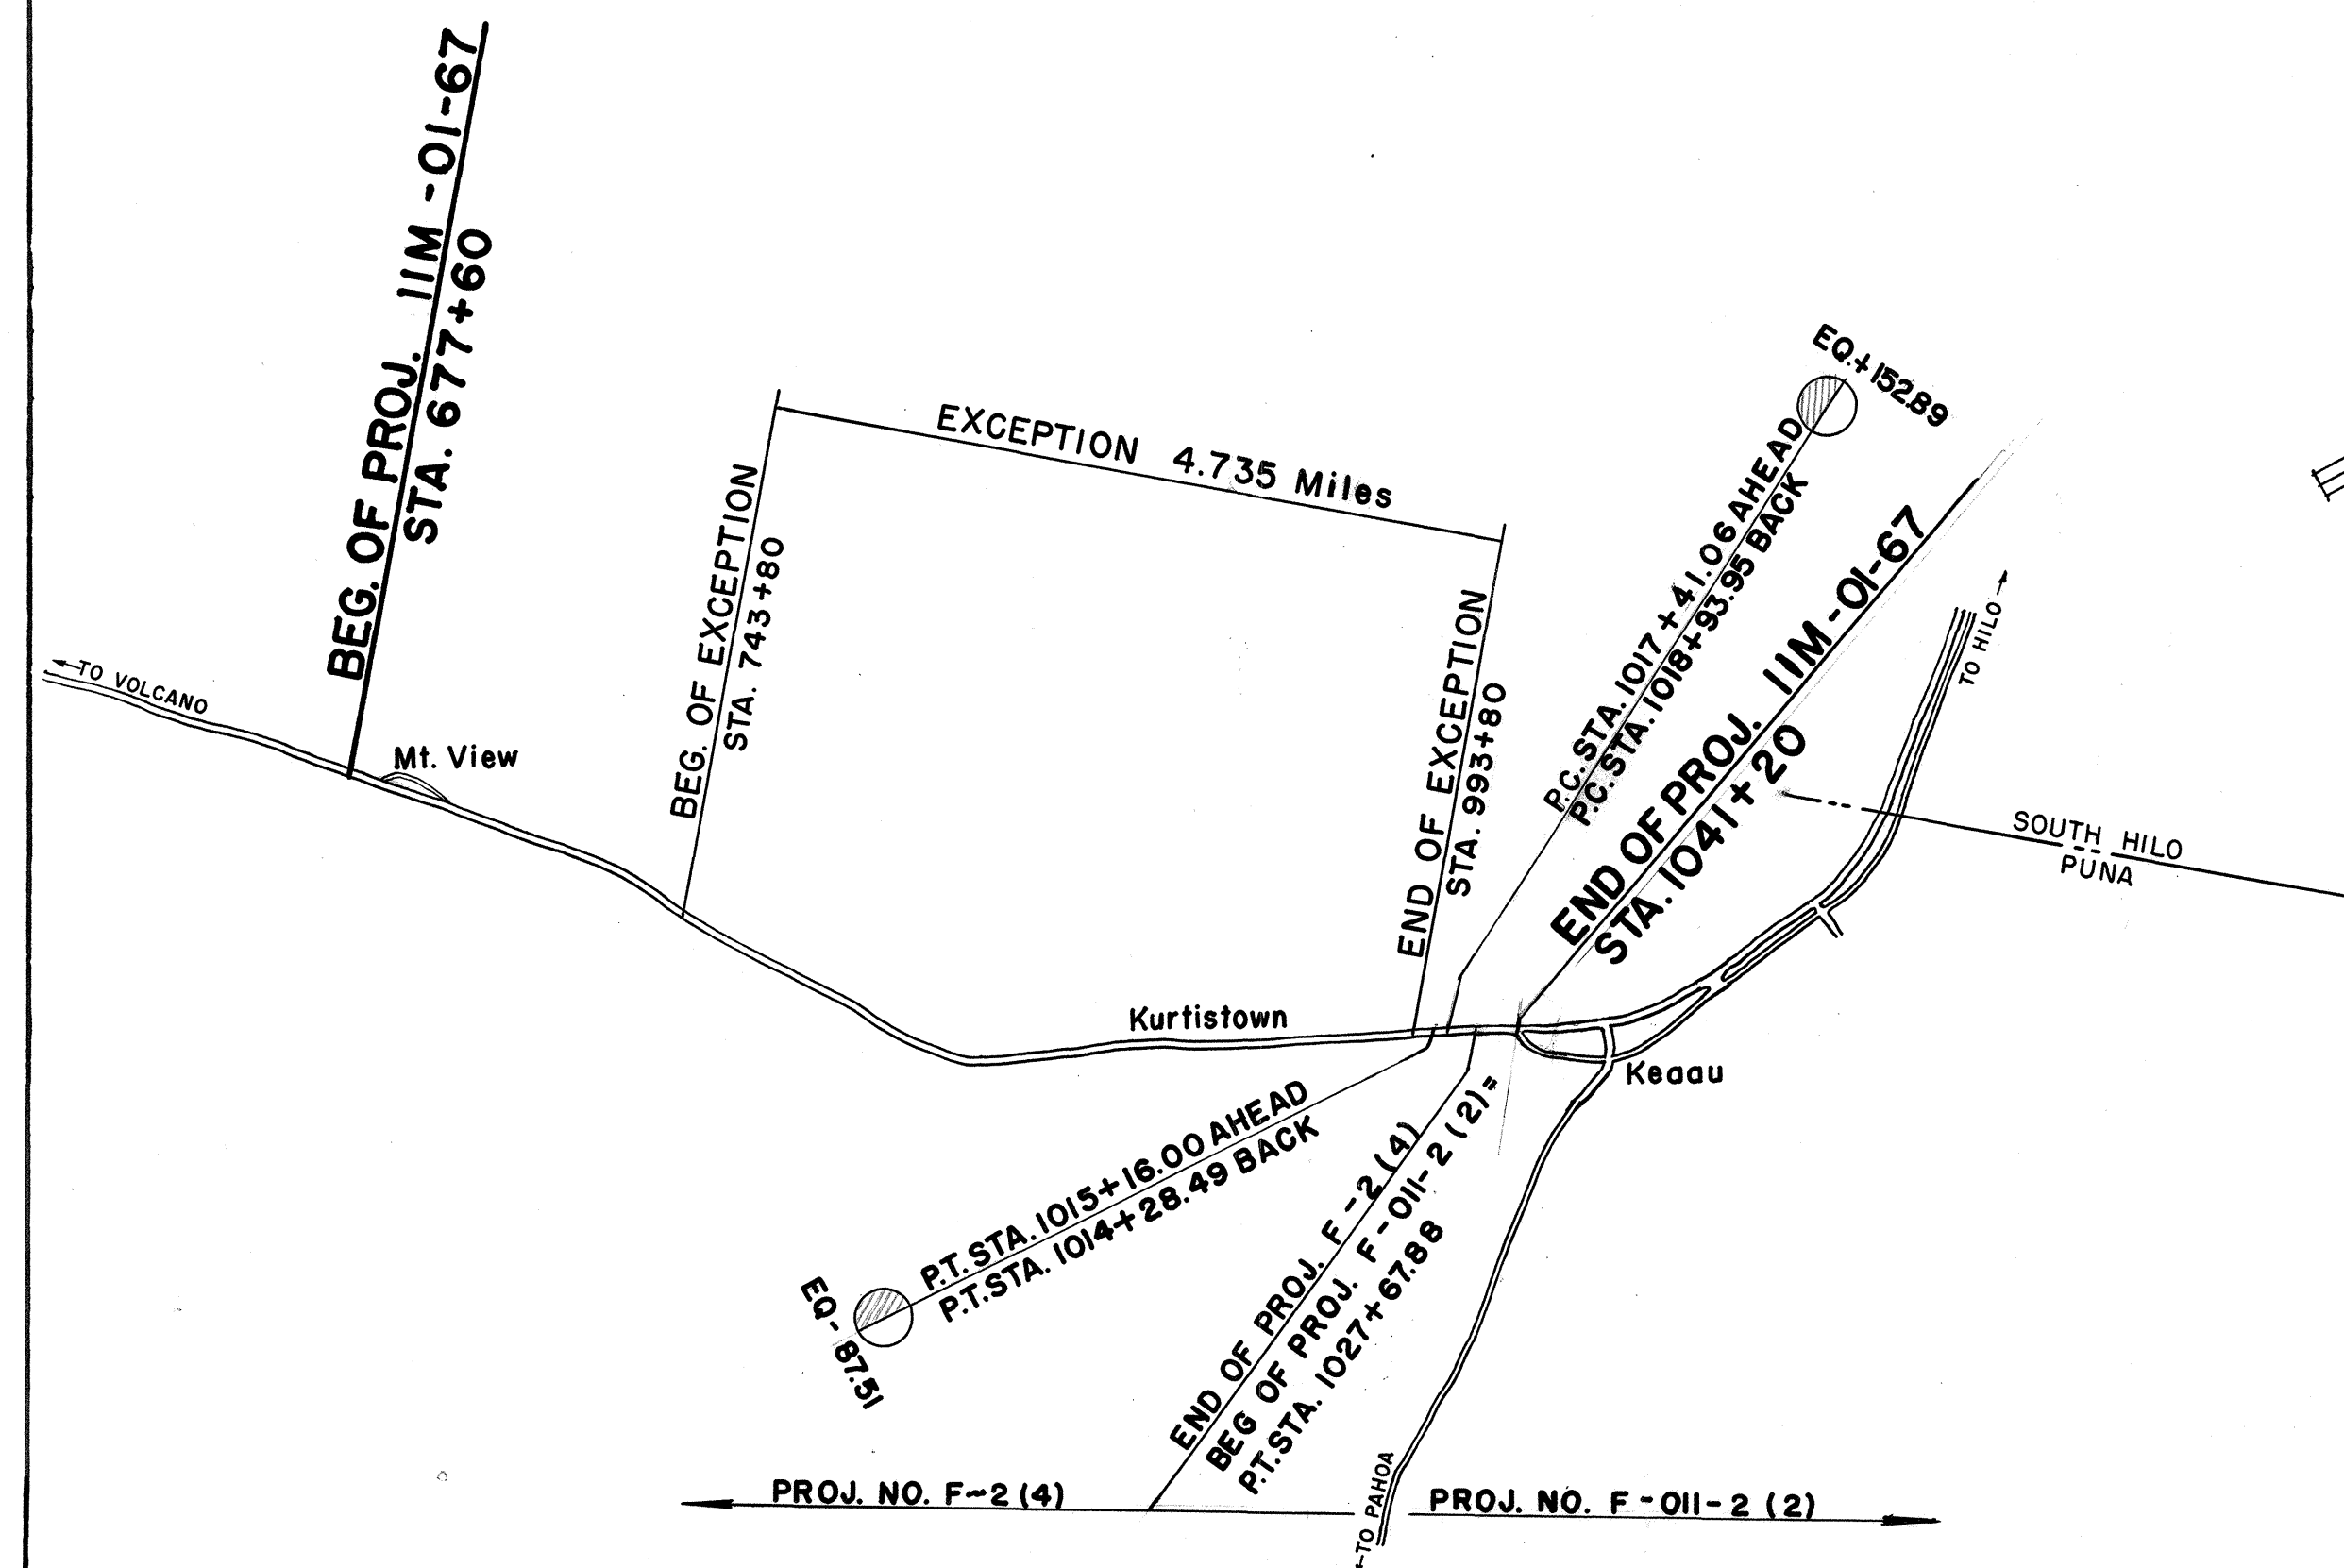

LAYOUT OF PROJECT

GROSS LENGTH OF PROJECT.....6.887 Miles  
EXCEPTION .....4.735 Miles  
NET LENGTH OF PROJECT.....2.152 Miles

APPROVED: *John M. Fum* DATE 12-9-66  
DIRECTOR OF TRANSPORTATION