


DIST. NO	STATE	PROJ. NO.	FISCAL YEAR	SHEET NO	TOTAL SHEETS
HAWAII	HAW	11M-01-67	1967	2	4


NOTE:

1. Sign posts shall be either 3" galv. std. pipe or 2 1/2" x 2 1/2" galv. square tube posts for signs larger than 24" in any dimension;
2" galv. std. pipe or 2" x 2" galv. square tube posts for signs 24" or less in any dimension.
2. Signs shall be attached to post with 5/16" galvanized bolts with nuts and 7/8" x 7/8" x .120" stainless steel washers with neoprene rubber gasket.

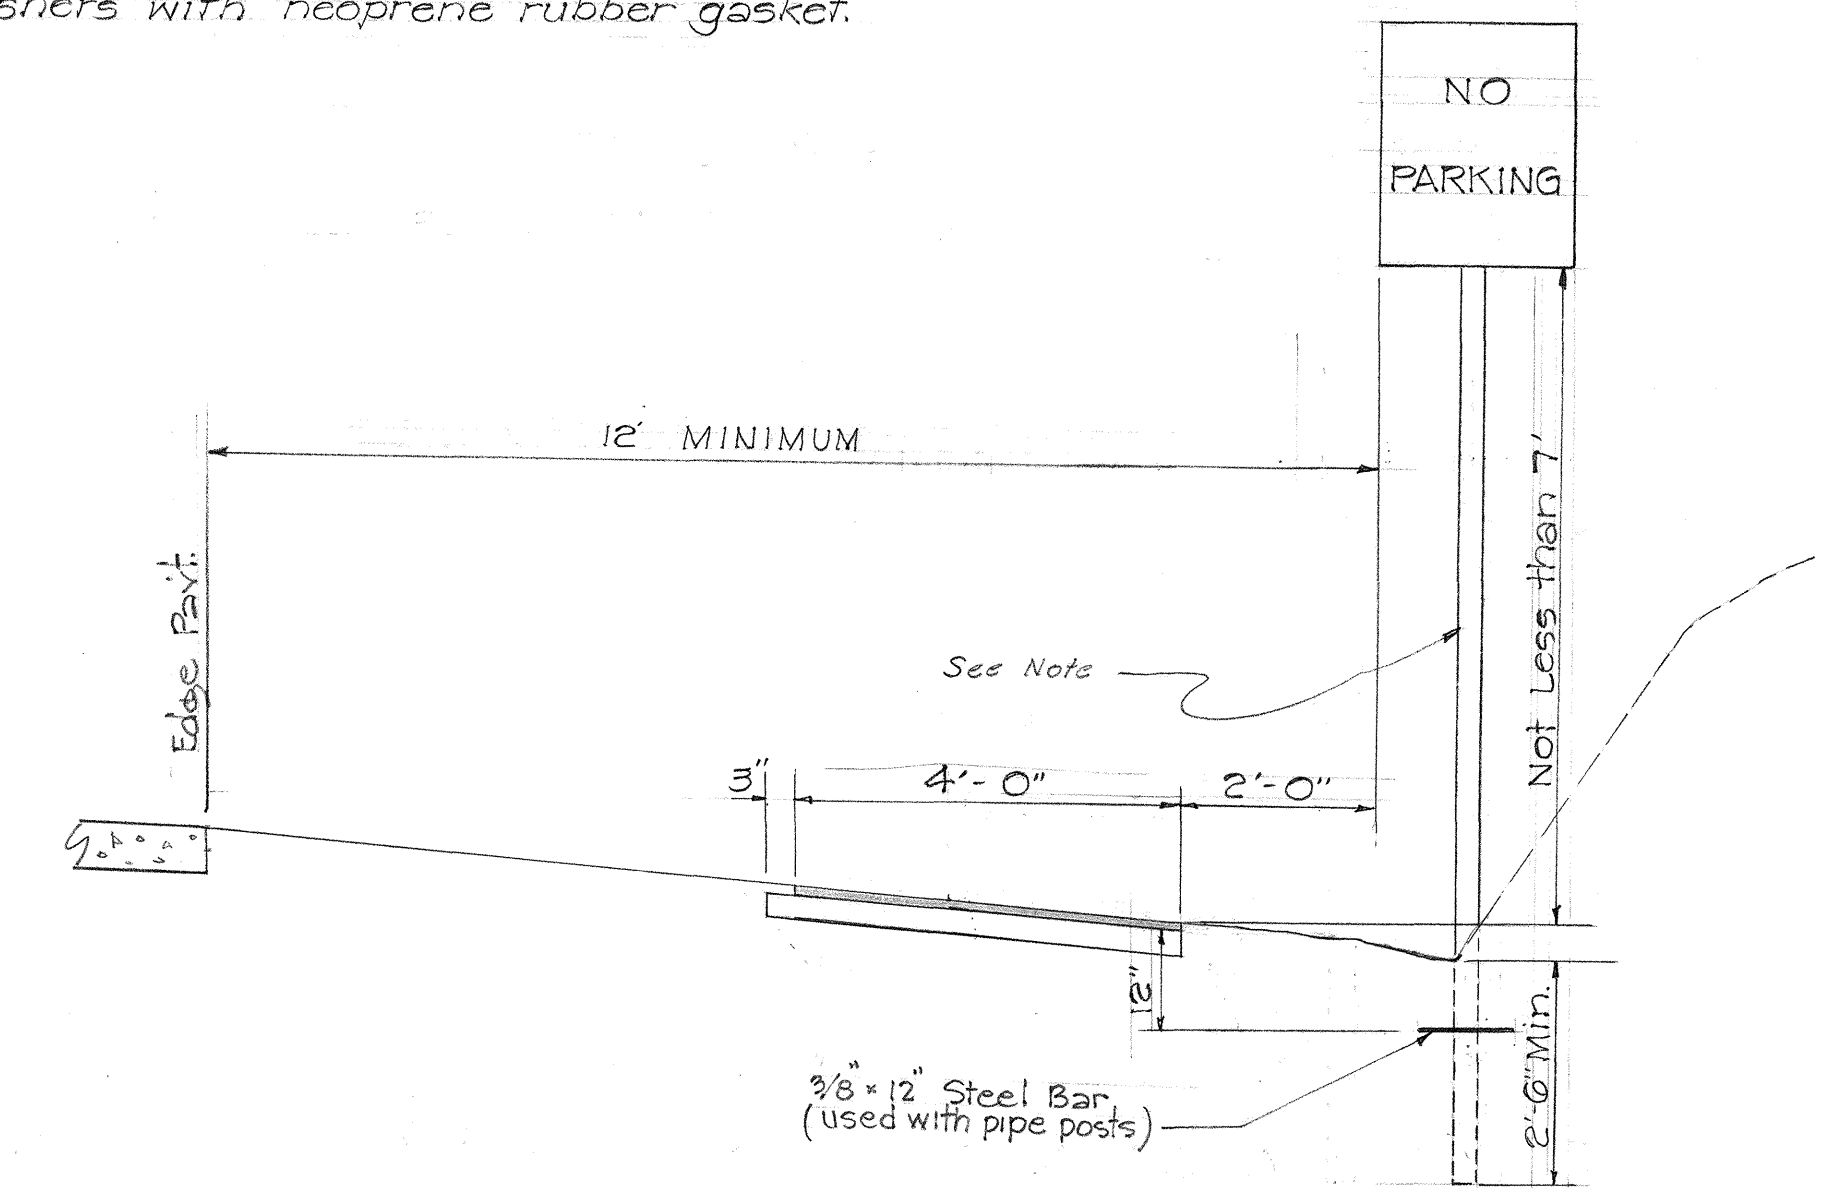

HEIGHT AND LATERAL LOCATION OF SIGNS-TYPICAL INSTALLATION

NOT DRAWN TO SCALE

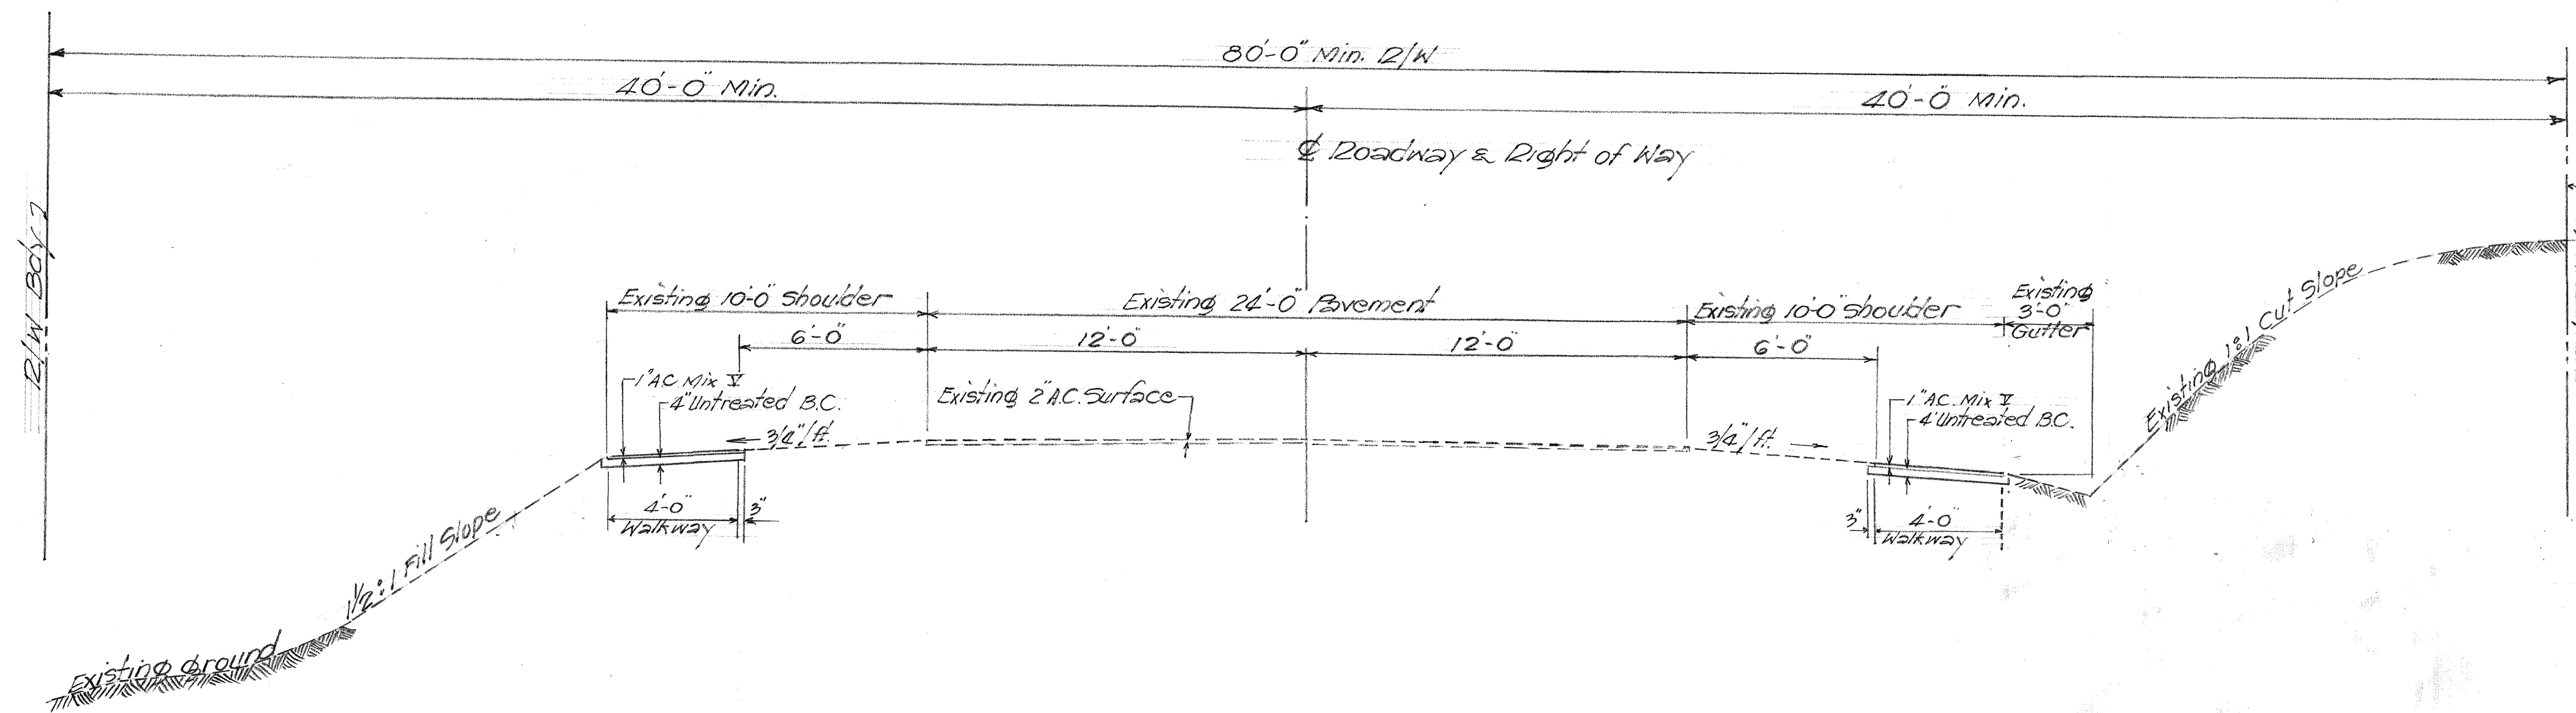

TYPICAL ROAD SECTION

Scale: $\frac{1}{4}'' = 1'-0''$

KEAALI AND MOUNTAIN VIEW

SHOULDER IMPROVEMENTS

PROJECT № 11M-01-67


NOTE: See plan for A.C. walkway locations

GENERAL NOTE:

The Contractor shall restore all existing highway facilities including pavement, embankment, drainage facilities, curbs, guard rails, signs, landscaping, etc., removed or damaged as a result of the operations, using material and workmanship in accordance with all applicable sections of the Standard Specs. for Road and Bridge Construction, dated May 1954, and the Specs. for Installation of Miscellaneous Improvements within Federal Aid Highways dated Feb. 18, 1964, of the State Highways Division. All work shall be considered incidental to the various contract items.

NOTE:

1. The shape, color, dimensions, symbols, wording, lettering and reflectorization of all signs shall be in accordance with the "Manual on Uniform Traffic Control Devices for Streets and Highways," dated June 1961 and the BPR Manual "Standard Highway Signs," dated September 1961 unless otherwise specified.
2. All regulatory signs shall be reflectorized unless otherwise specified.
3. All regulatory signs shall have 3/8" bolt holes drilled at appropriate locations unless otherwise noted.

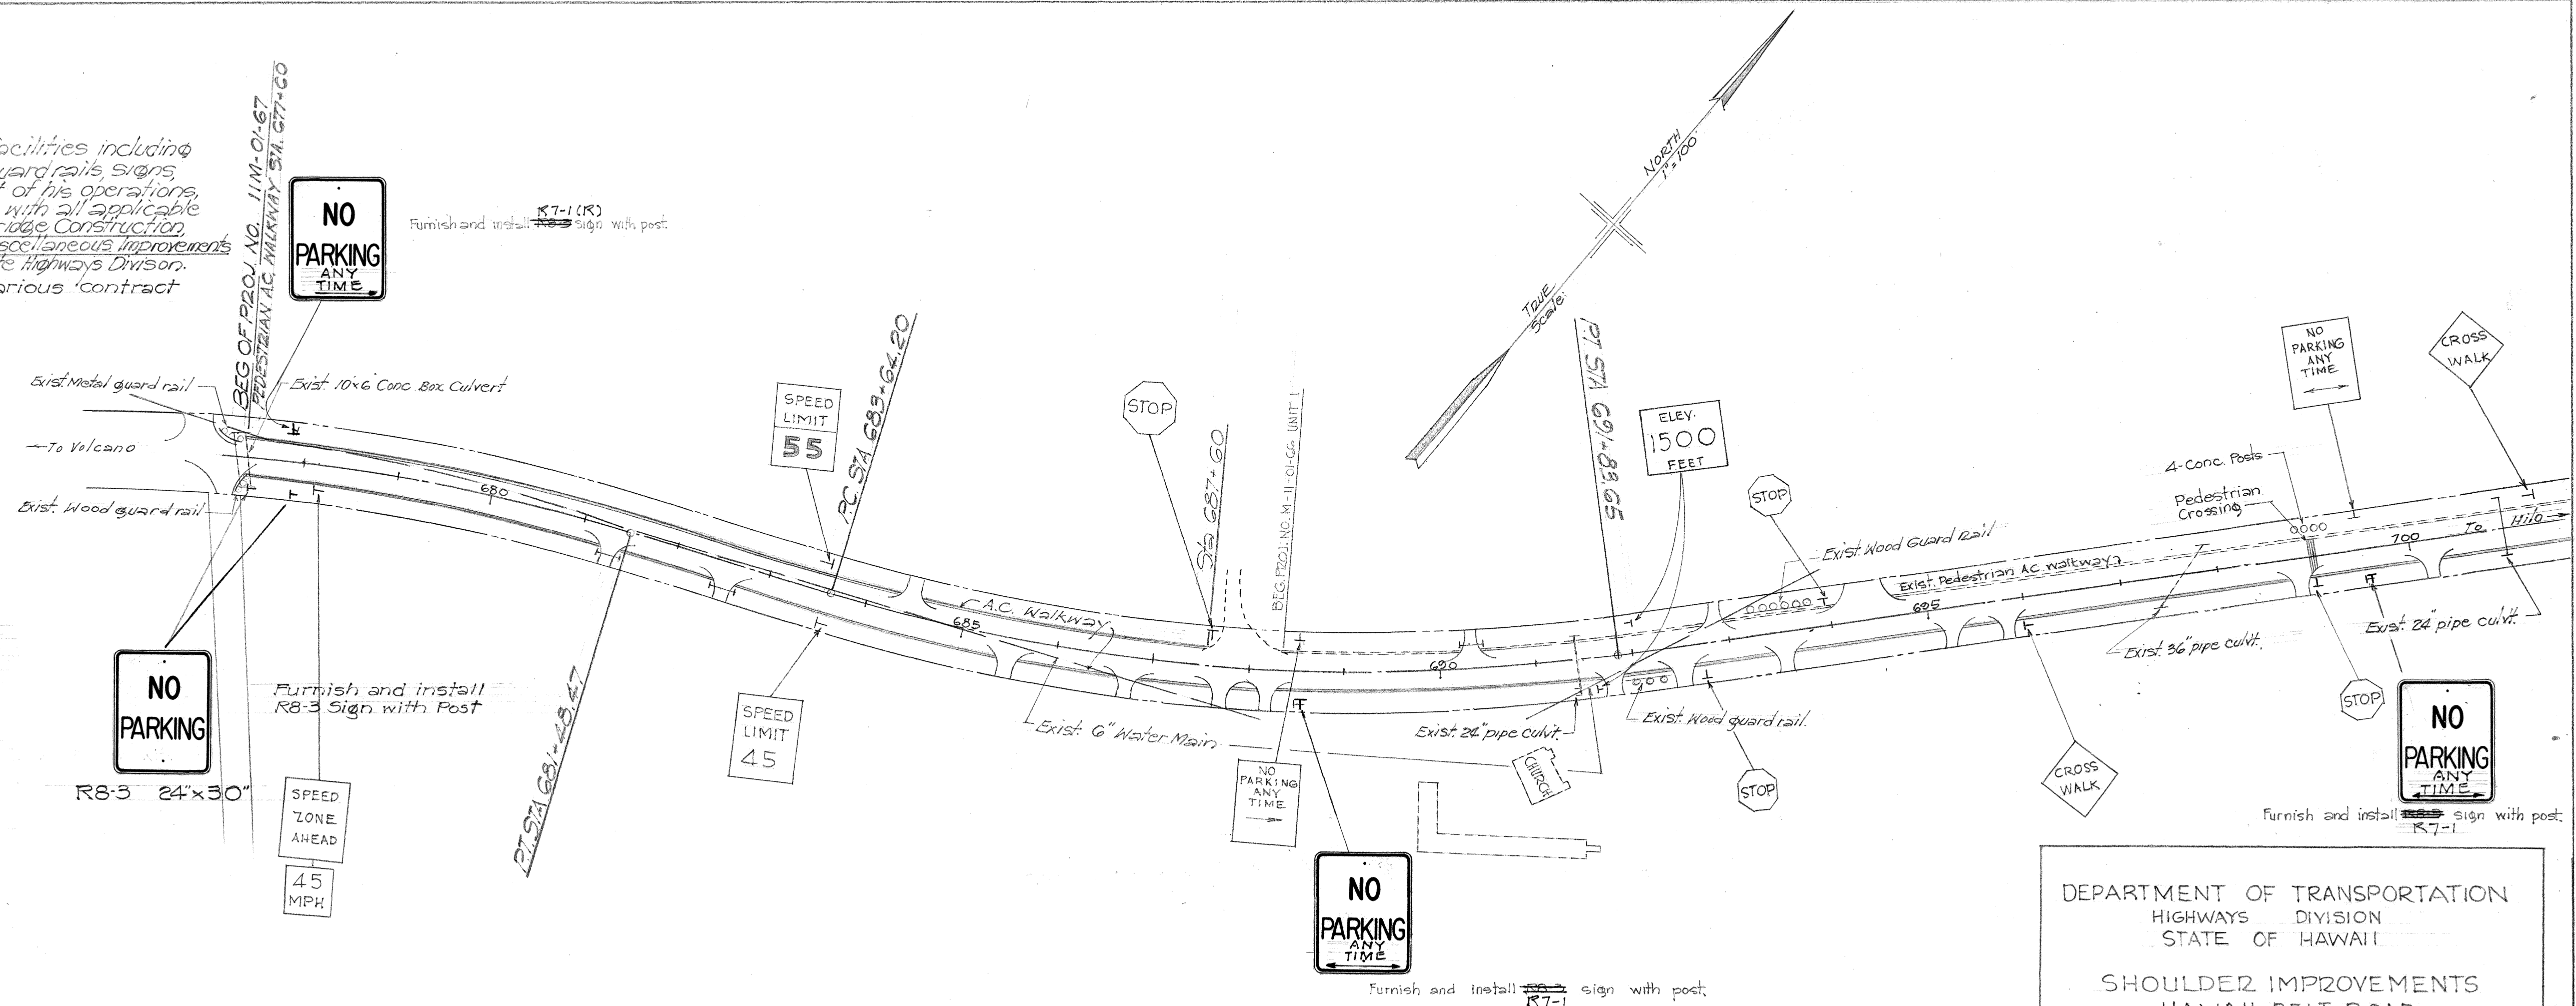

DEPARTMENT OF TRANSPORTATION
HIGHWAYS DIVISION
STATE OF HAWAII

SHOULDER IMPROVEMENTS
HAWAII BELT ROAD
PROJECT N^o 11M-01-67

Scale: 1" = 100' PUNA, HAWAII Date: OCT. 1966

Sheet 2 of 4 Sheets

DIST. NO.	STATE	PROJ. NO.	FISCAL YEAR	SHEET NO.	TOTAL SHEETS
HAWAII	HAW	11M-01-67	1967	4	4

