

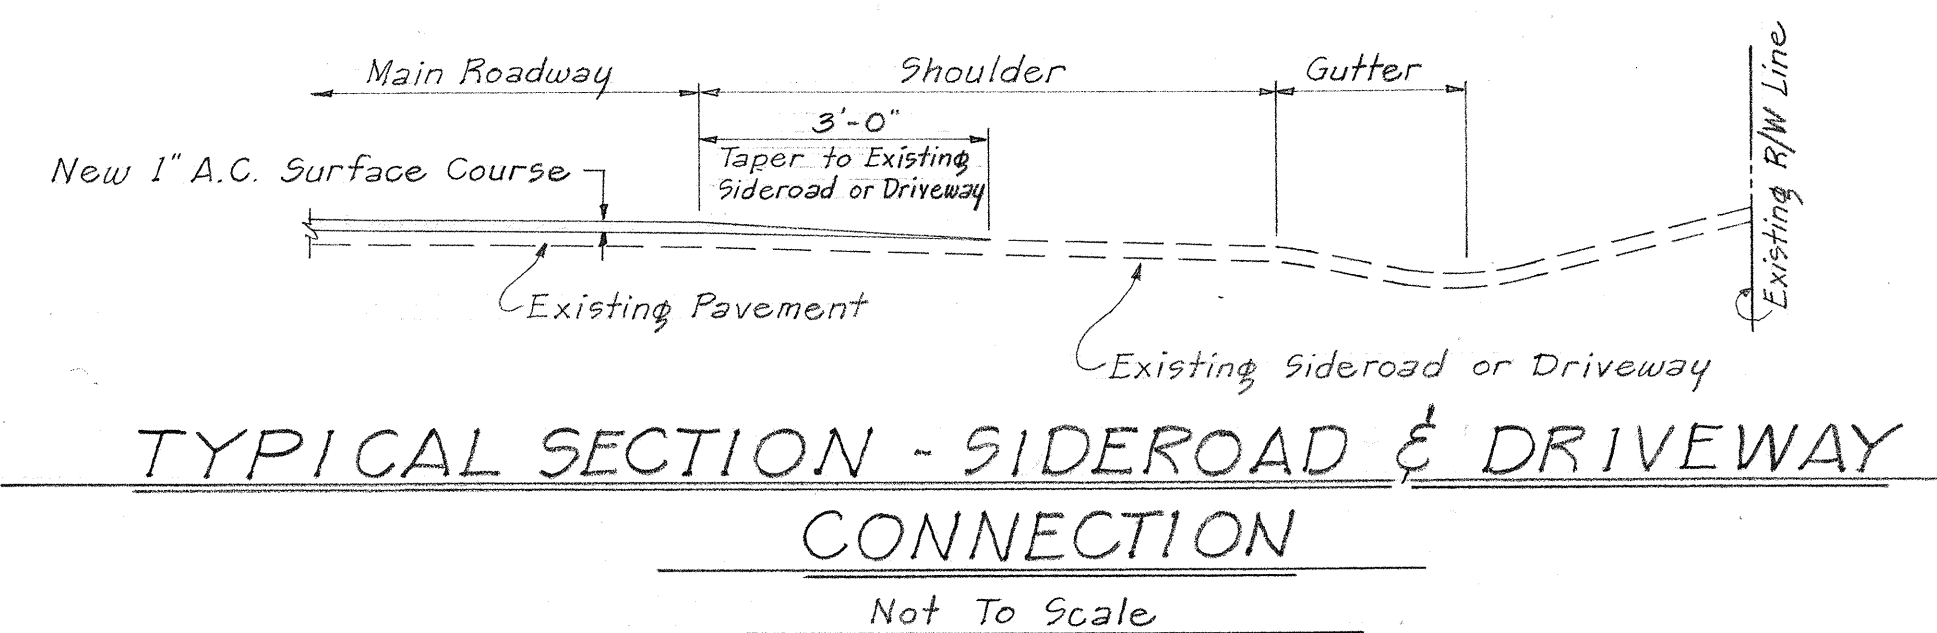
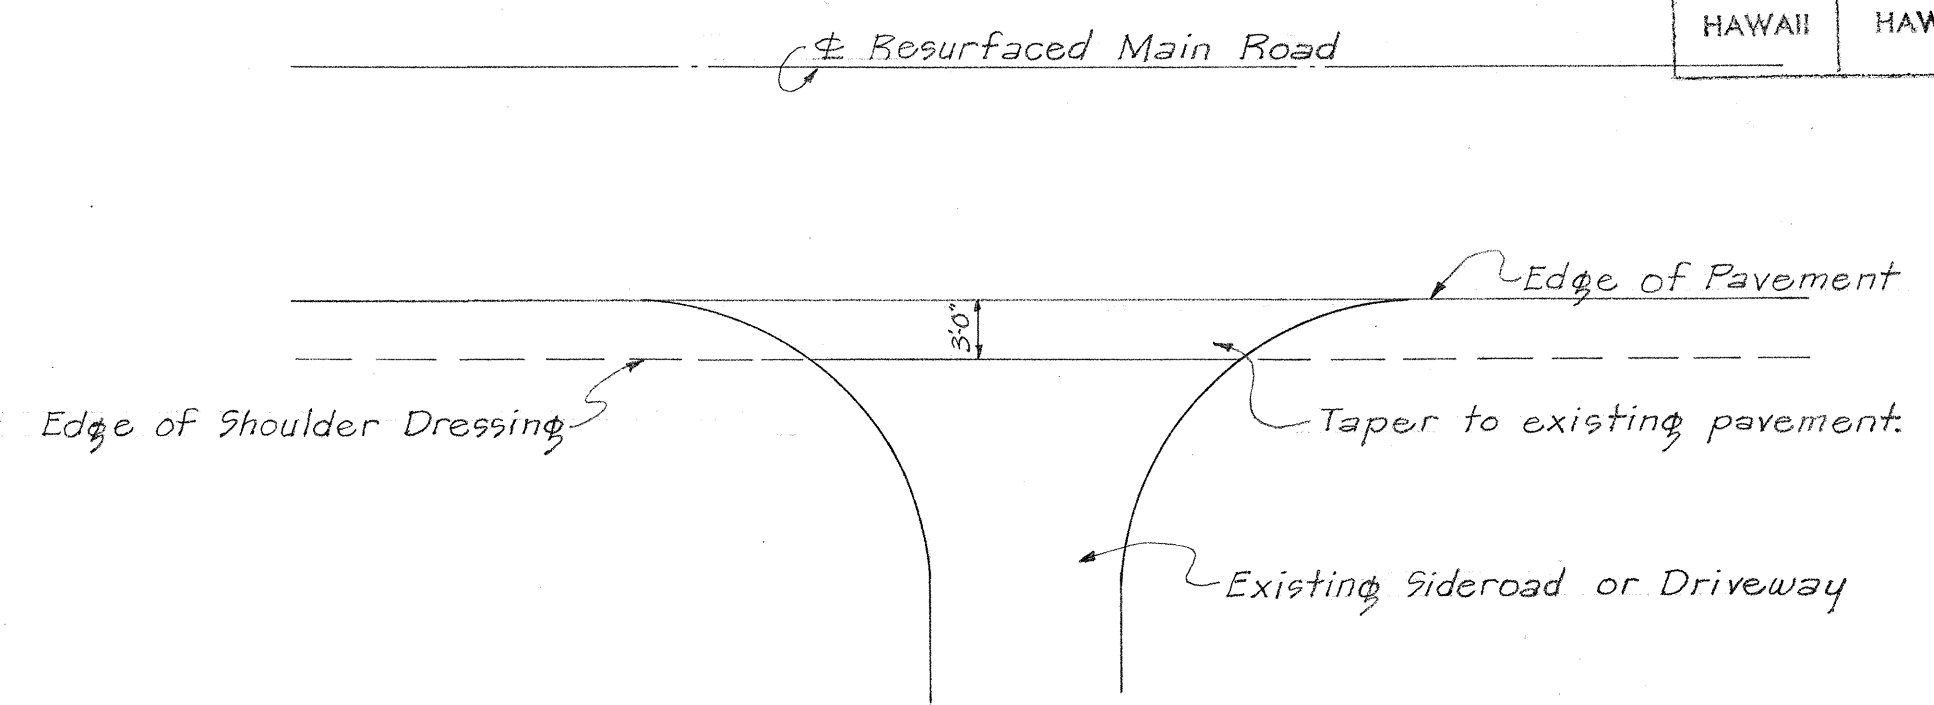
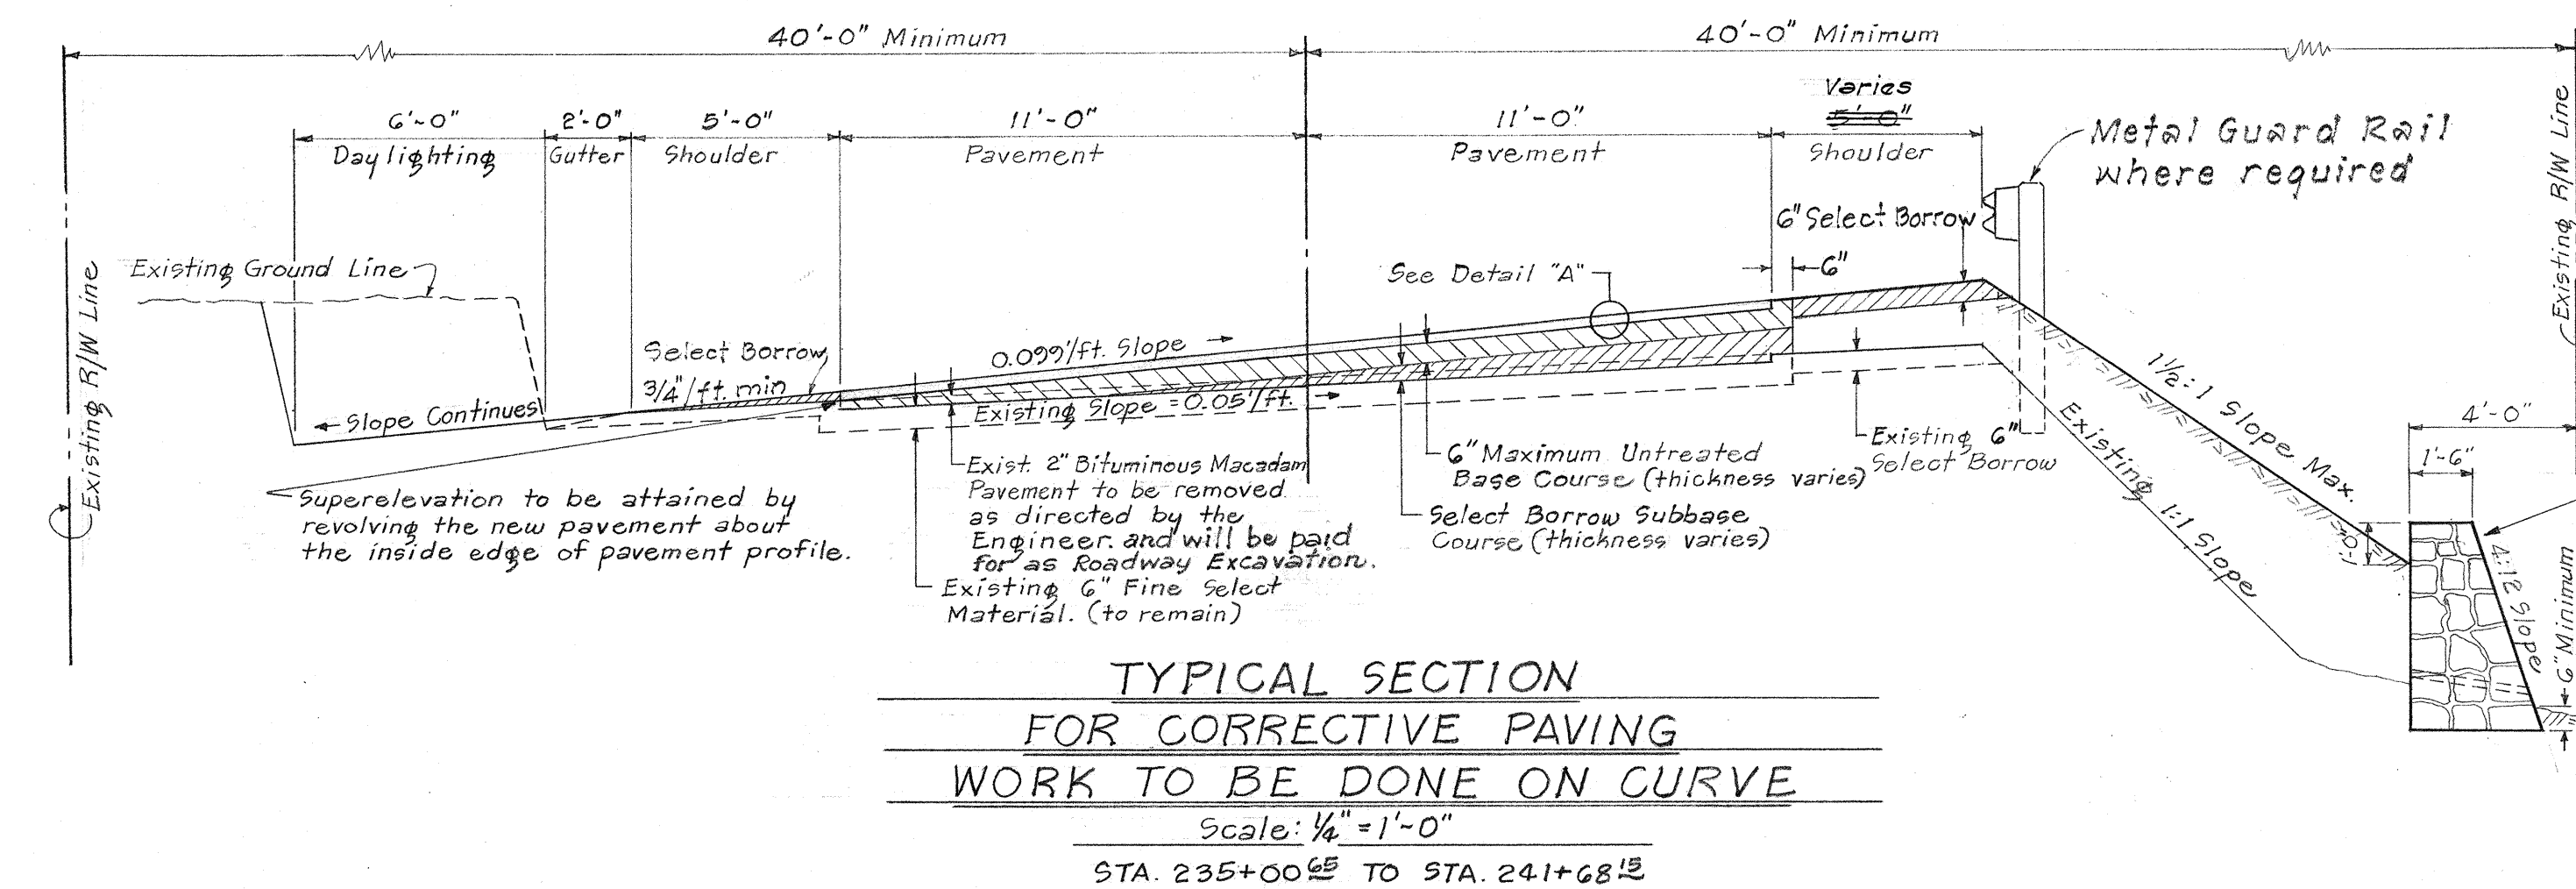
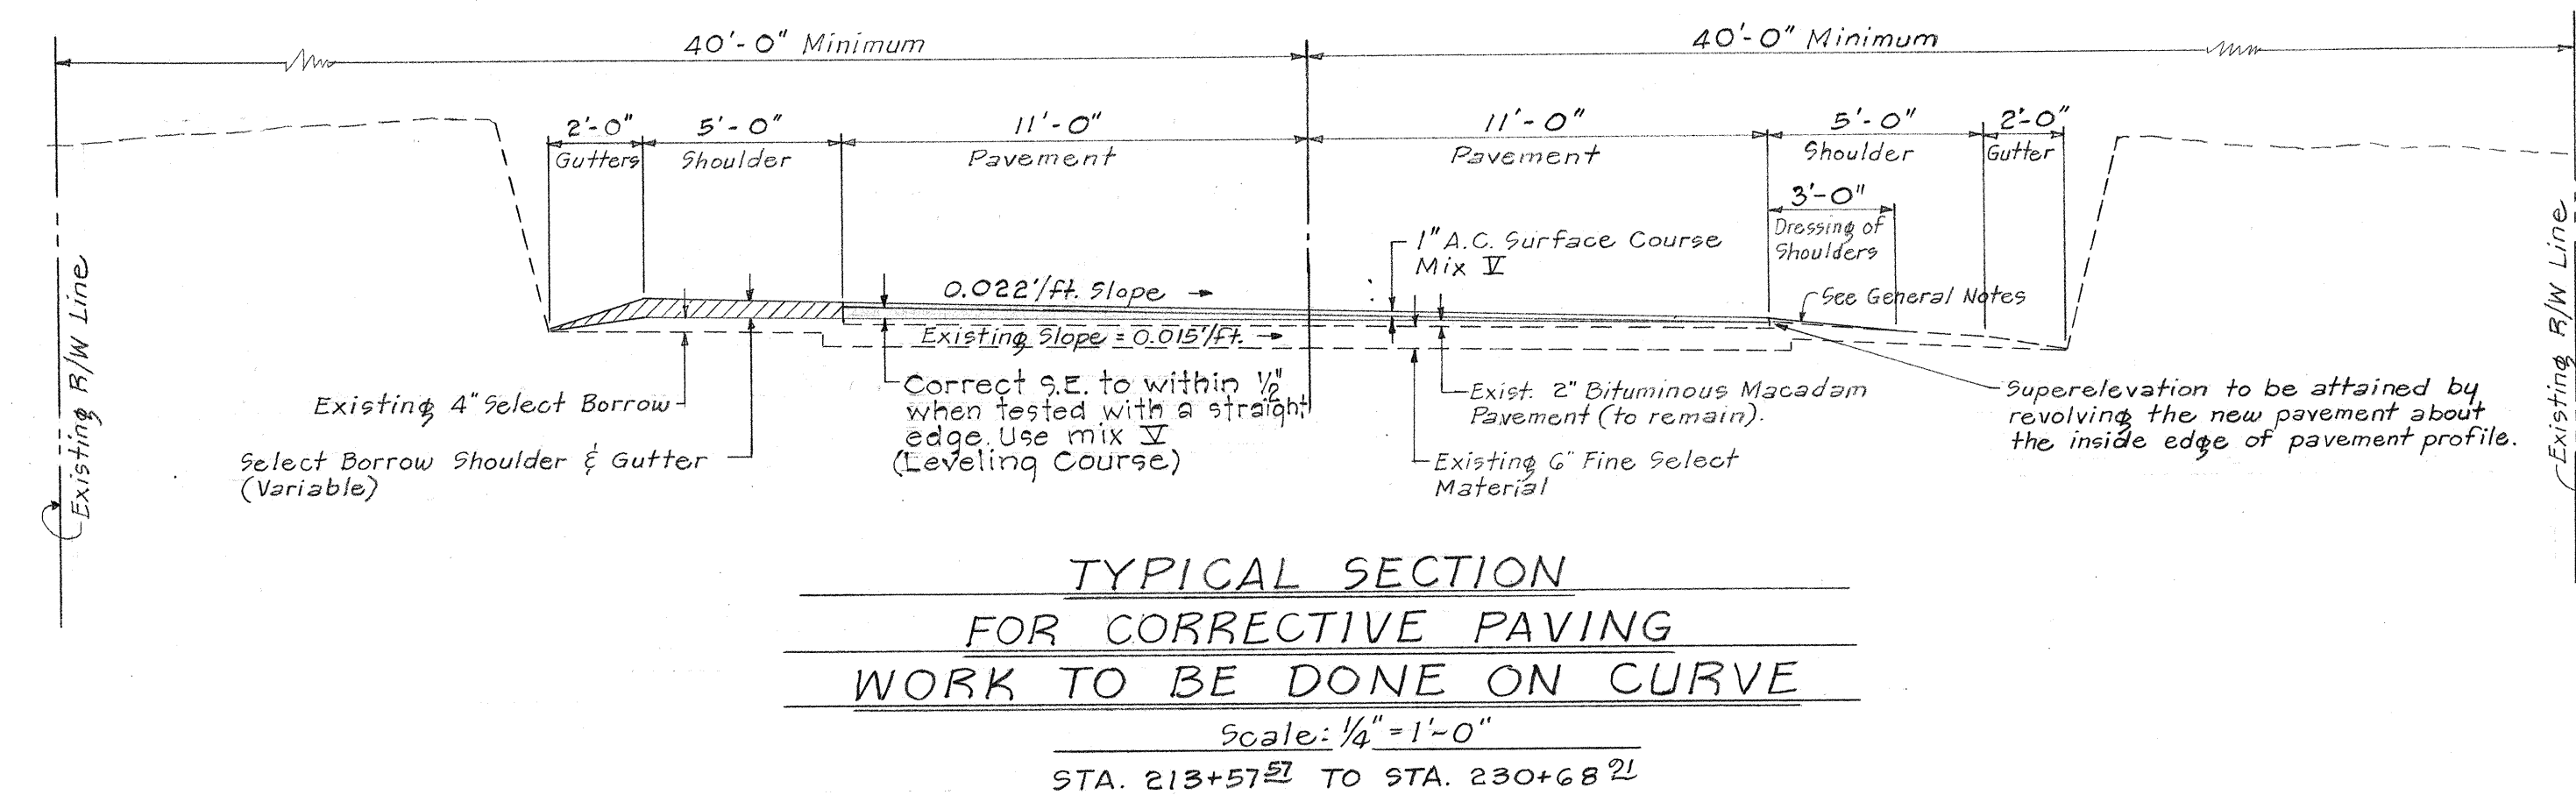
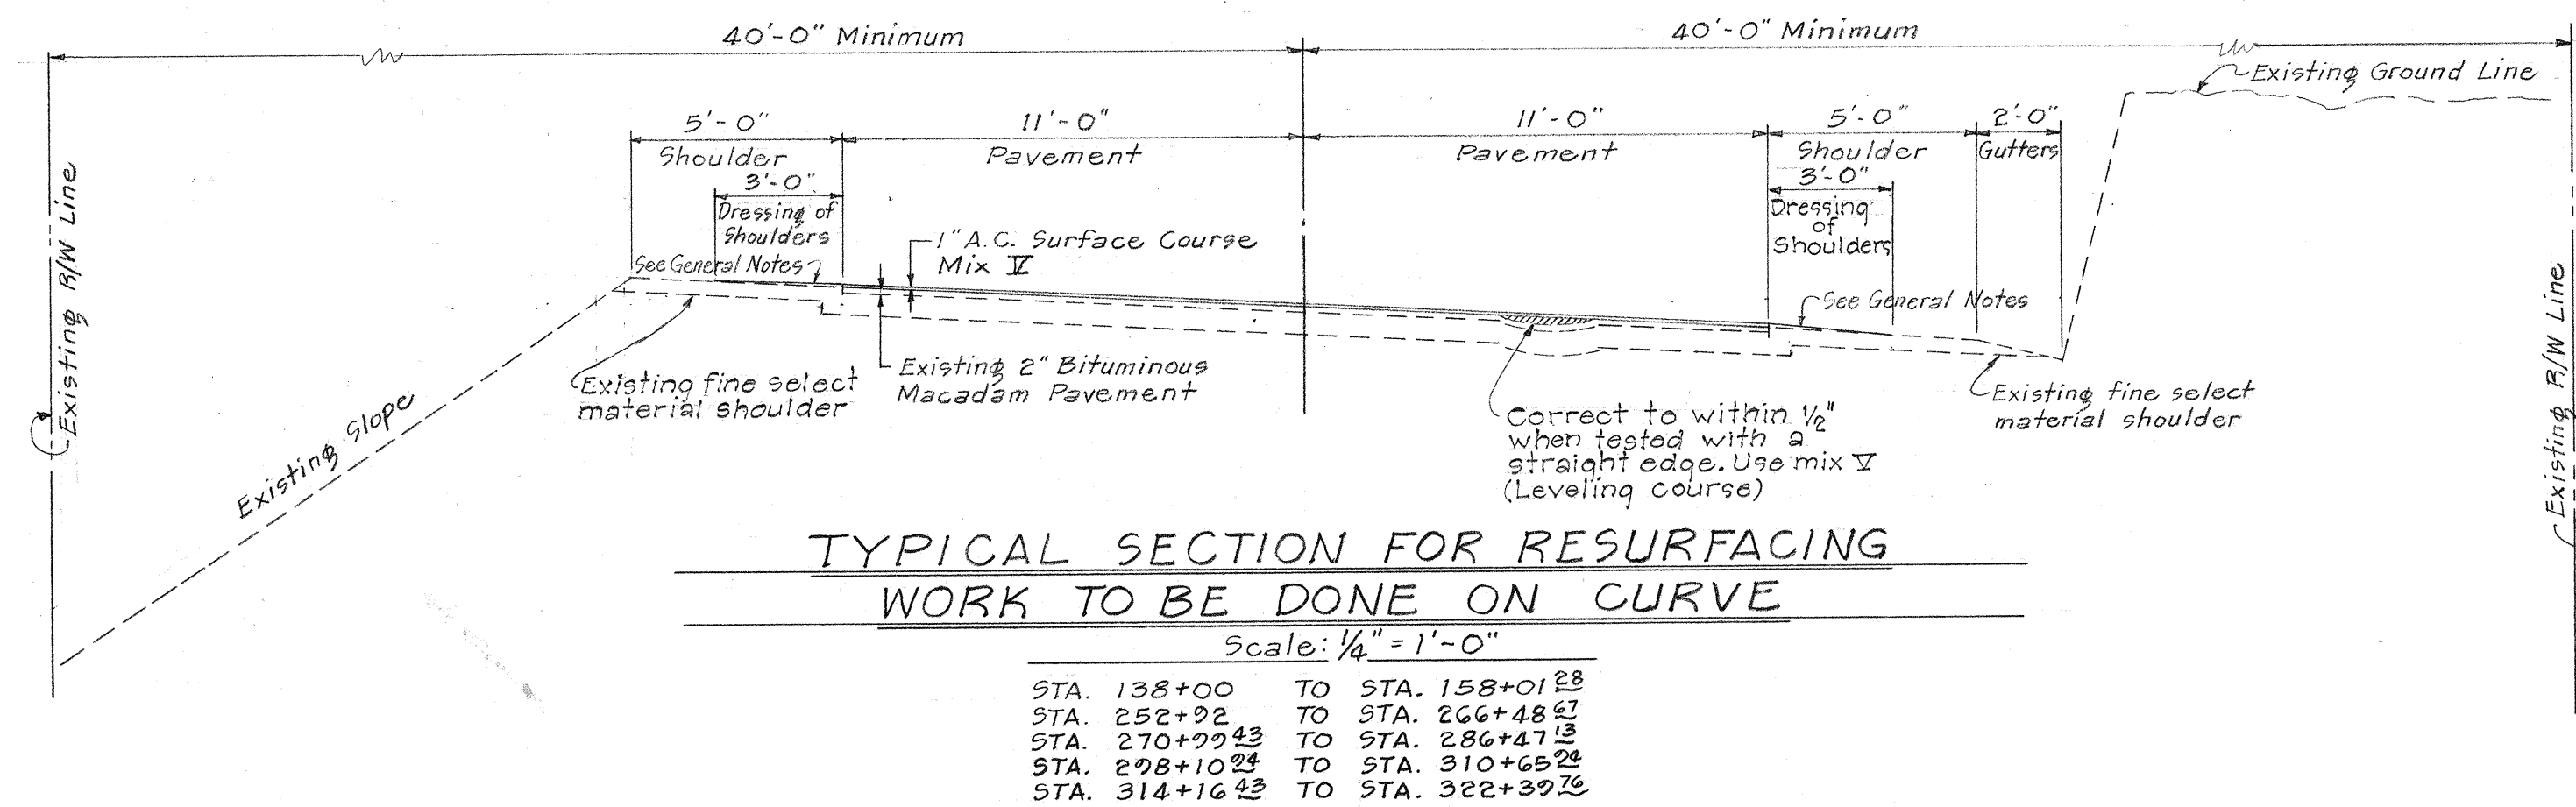


FED. ROAD DIST. NO.	STATE	FED. AID PROJ. NO.	FISCAL YEAR	SHEET NO.	TOTAL SHEETS
HAWAII	HAW.	11A-01-67	1967	2	5

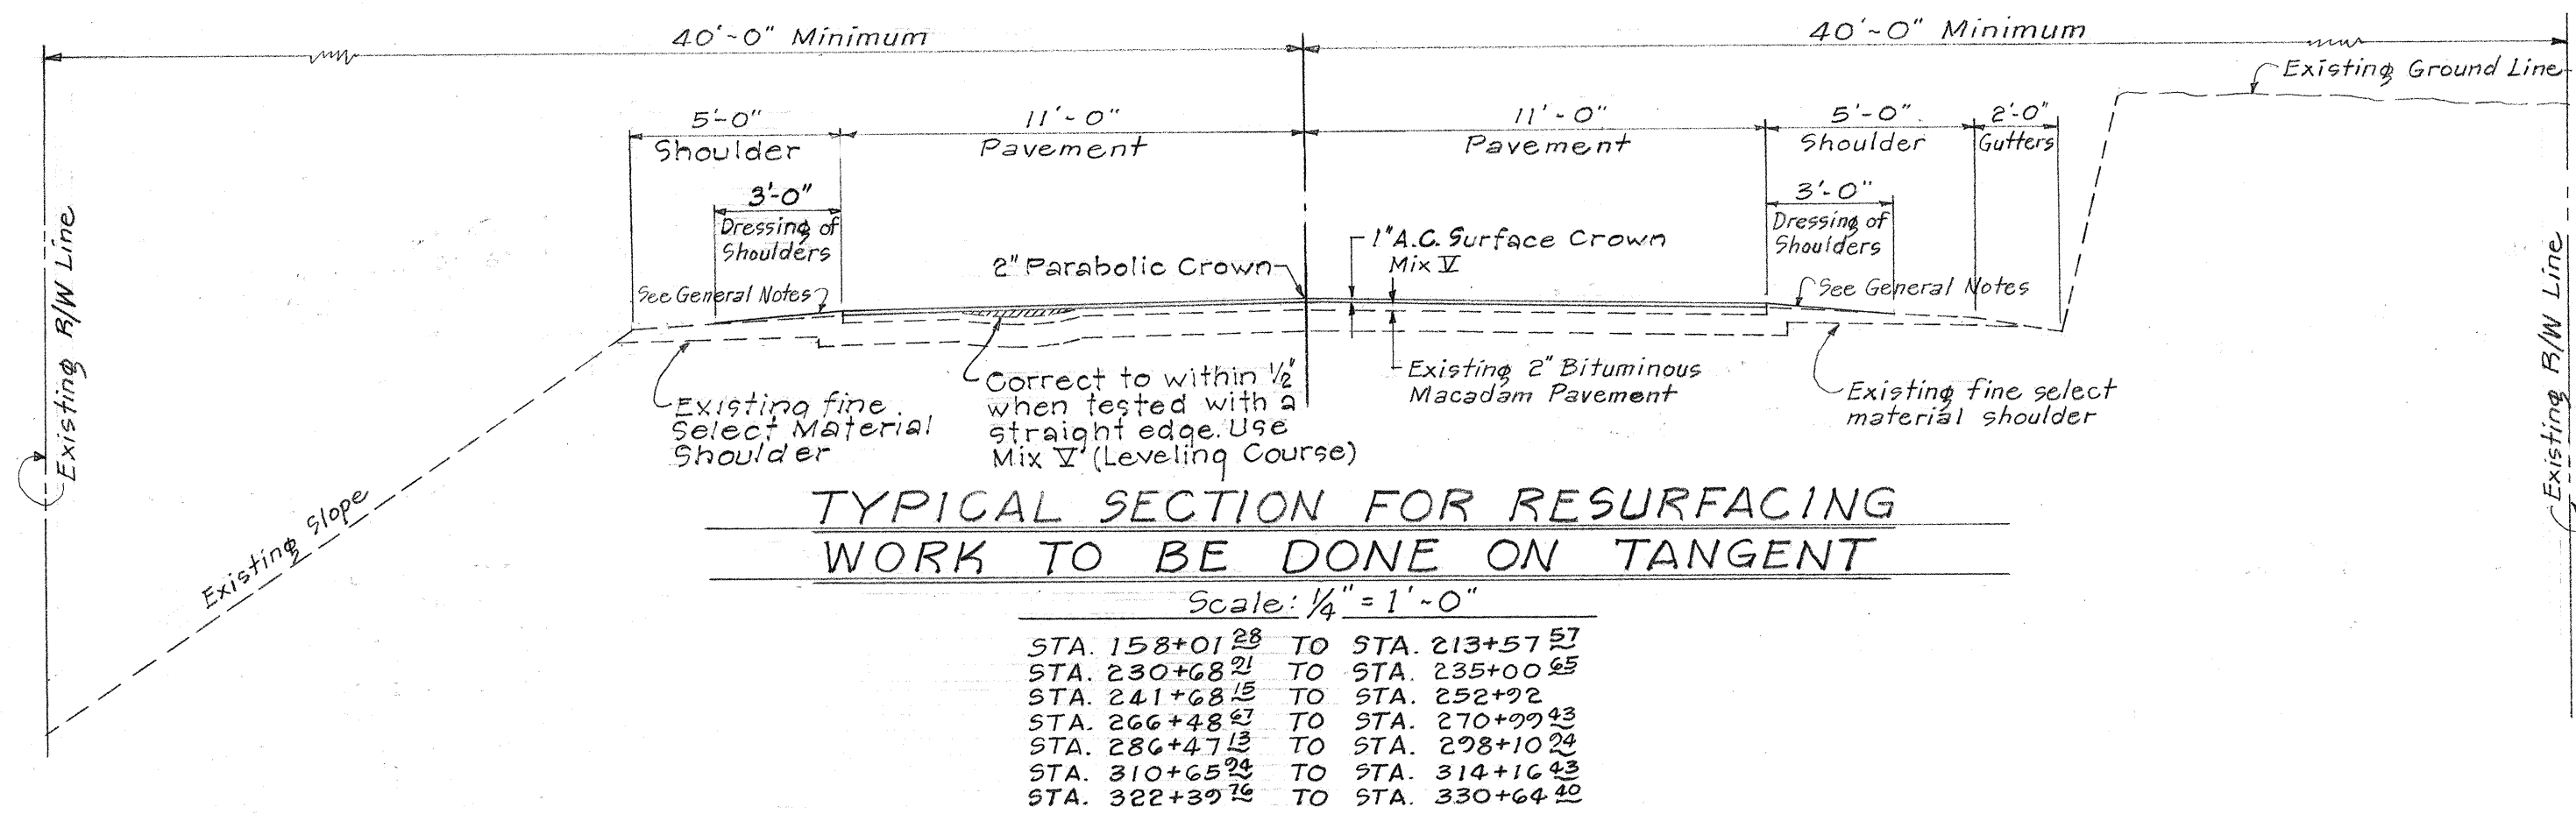



GENERAL NOTES

- Existing pavement surface variable. Surface indicated here is entirely imaginary and not intended to represent any specific place.
- Brooming off will not be measured or paid for directly, but shall be considered as incidental to and paid for under the various pay items.
- Existing pavement shall be broomed off and shall receive a tack coat of 0.15 gal. per sq. yd. of Emulsified Asphalt before placing A.C. pavement.
- Shape and dress shoulder with fine select material.
- Remove and stockpile 837 lin. ft. of existing wooden guard rail w/concrete posts from sta. 237+27 to sta. 245+64 right and install 840 lin. ft. of new metal guard rail w/concrete or metal posts. The removal and stockpiling of the existing wooden guard rail w/concrete posts will not be paid for directly but will be considered as incidental to and paid for under the various contract items of work and no additional compensation will be made.
- Install & Monument at sta. 235+00.65, sta. 237+00.65, sta. 239+68.15 and sta. 241+68.15 as directed by the Engineer.
- Reset existing Bi-directional RM-1 Reflector Markers Rt. of sta. 235+75, sta. 237+00, sta. 237+70, sta. 238+30, sta. 238+70, sta. 239+50 and sta. 240+70.
- Bituminous seal coat shall be applied to all shoulders.

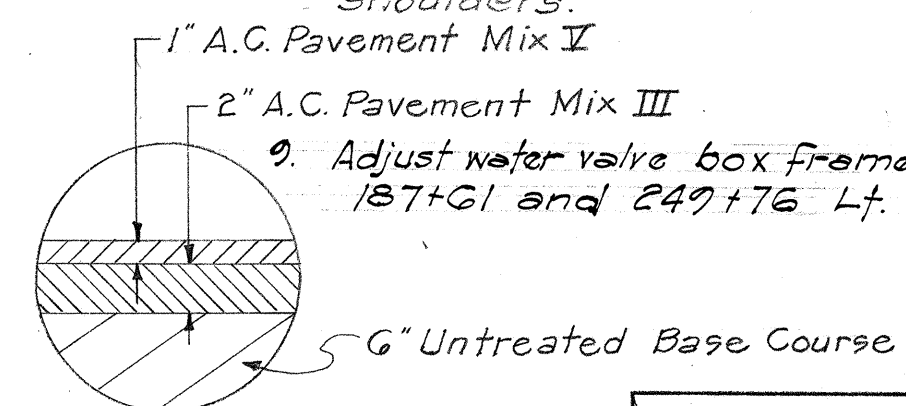

Sta. 238+25 to Sta. 239+43 right side
 Construct 125 Lin. Ft. C.R.M. Retaining Wall.

ESTIMATED QUANTITY

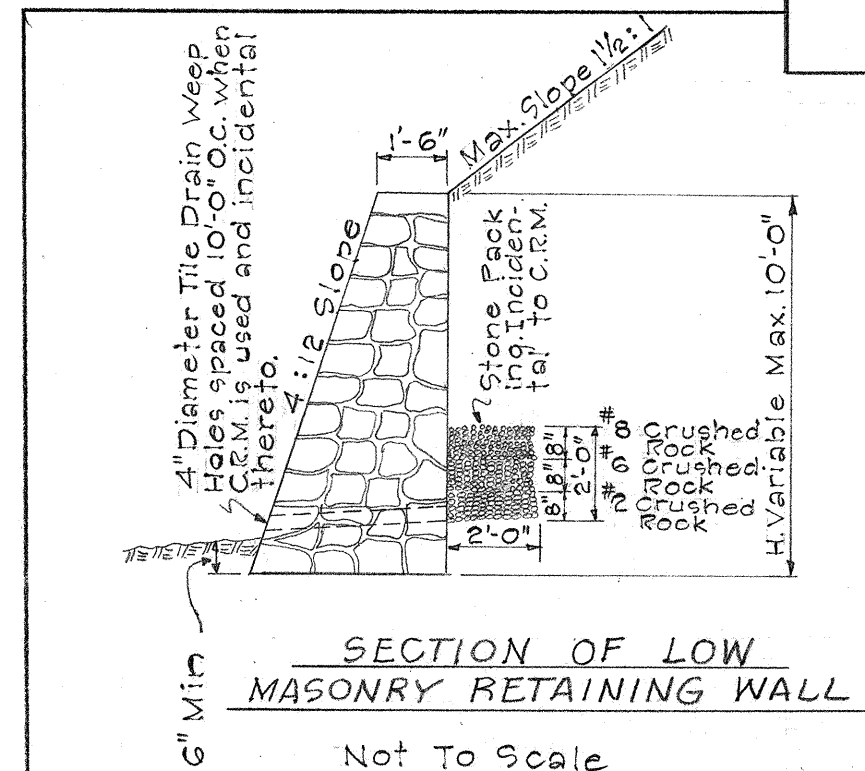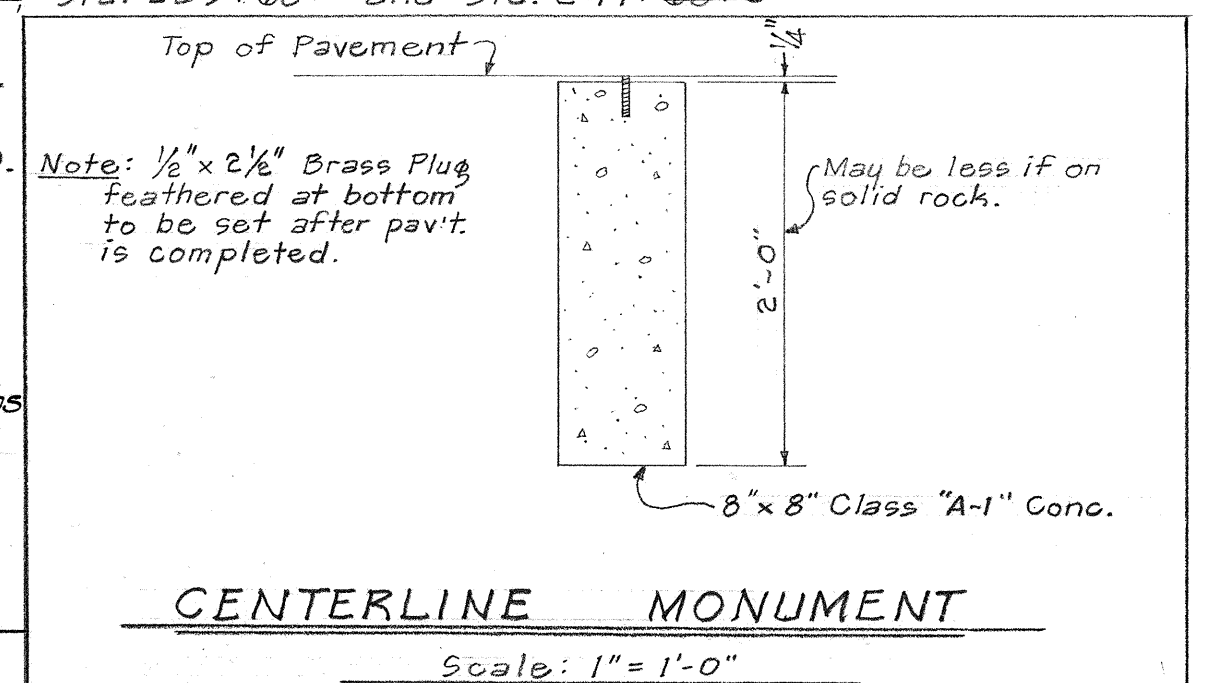

DEPARTMENT OF TRANSPORTATION
 HIGHWAYS DIVISION
 STATE OF HAWAII

TYPICAL SECTIONS

PROJECT NO. 11A-01-67
 KUAKINI HIGHWAY
 (Kailua - Keauhou Road)
 North Kona, Hawaii

Scale: As Shown Date: April 28, 1967