




Sta. 1251+00 to Sta. 1247+00
Provide smooth and easy riding
connection to existing pavement.

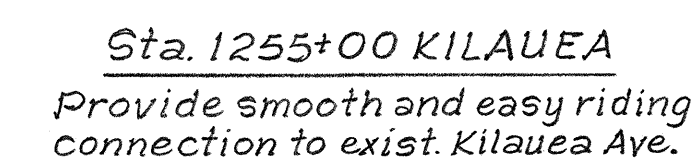

TYPE 2A CURB (145.8 Lin. Ft.)
Not To Scale

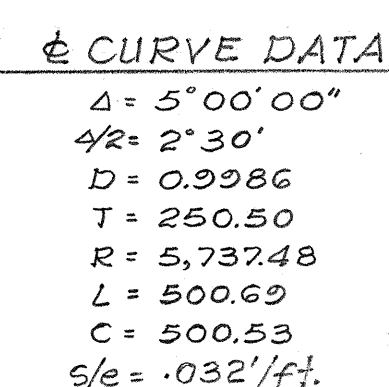

1. Removal of existing concrete curb and jiggle bars shall be incidental to roadway excavation and shall not be paid for separately.
2. Existing centerline monument shall be replaced with new centerline monuments.
3. Elevation shown are new finish elevation.
4. For Profile See Sheet No. 8.
5. All Conc. Curbs shall be of Class "A-1" Conc. and Cast-in-Place.
6. Existing Valve Frames and Covers shall be adjusted as directed and staked out by the Engineer. 800.

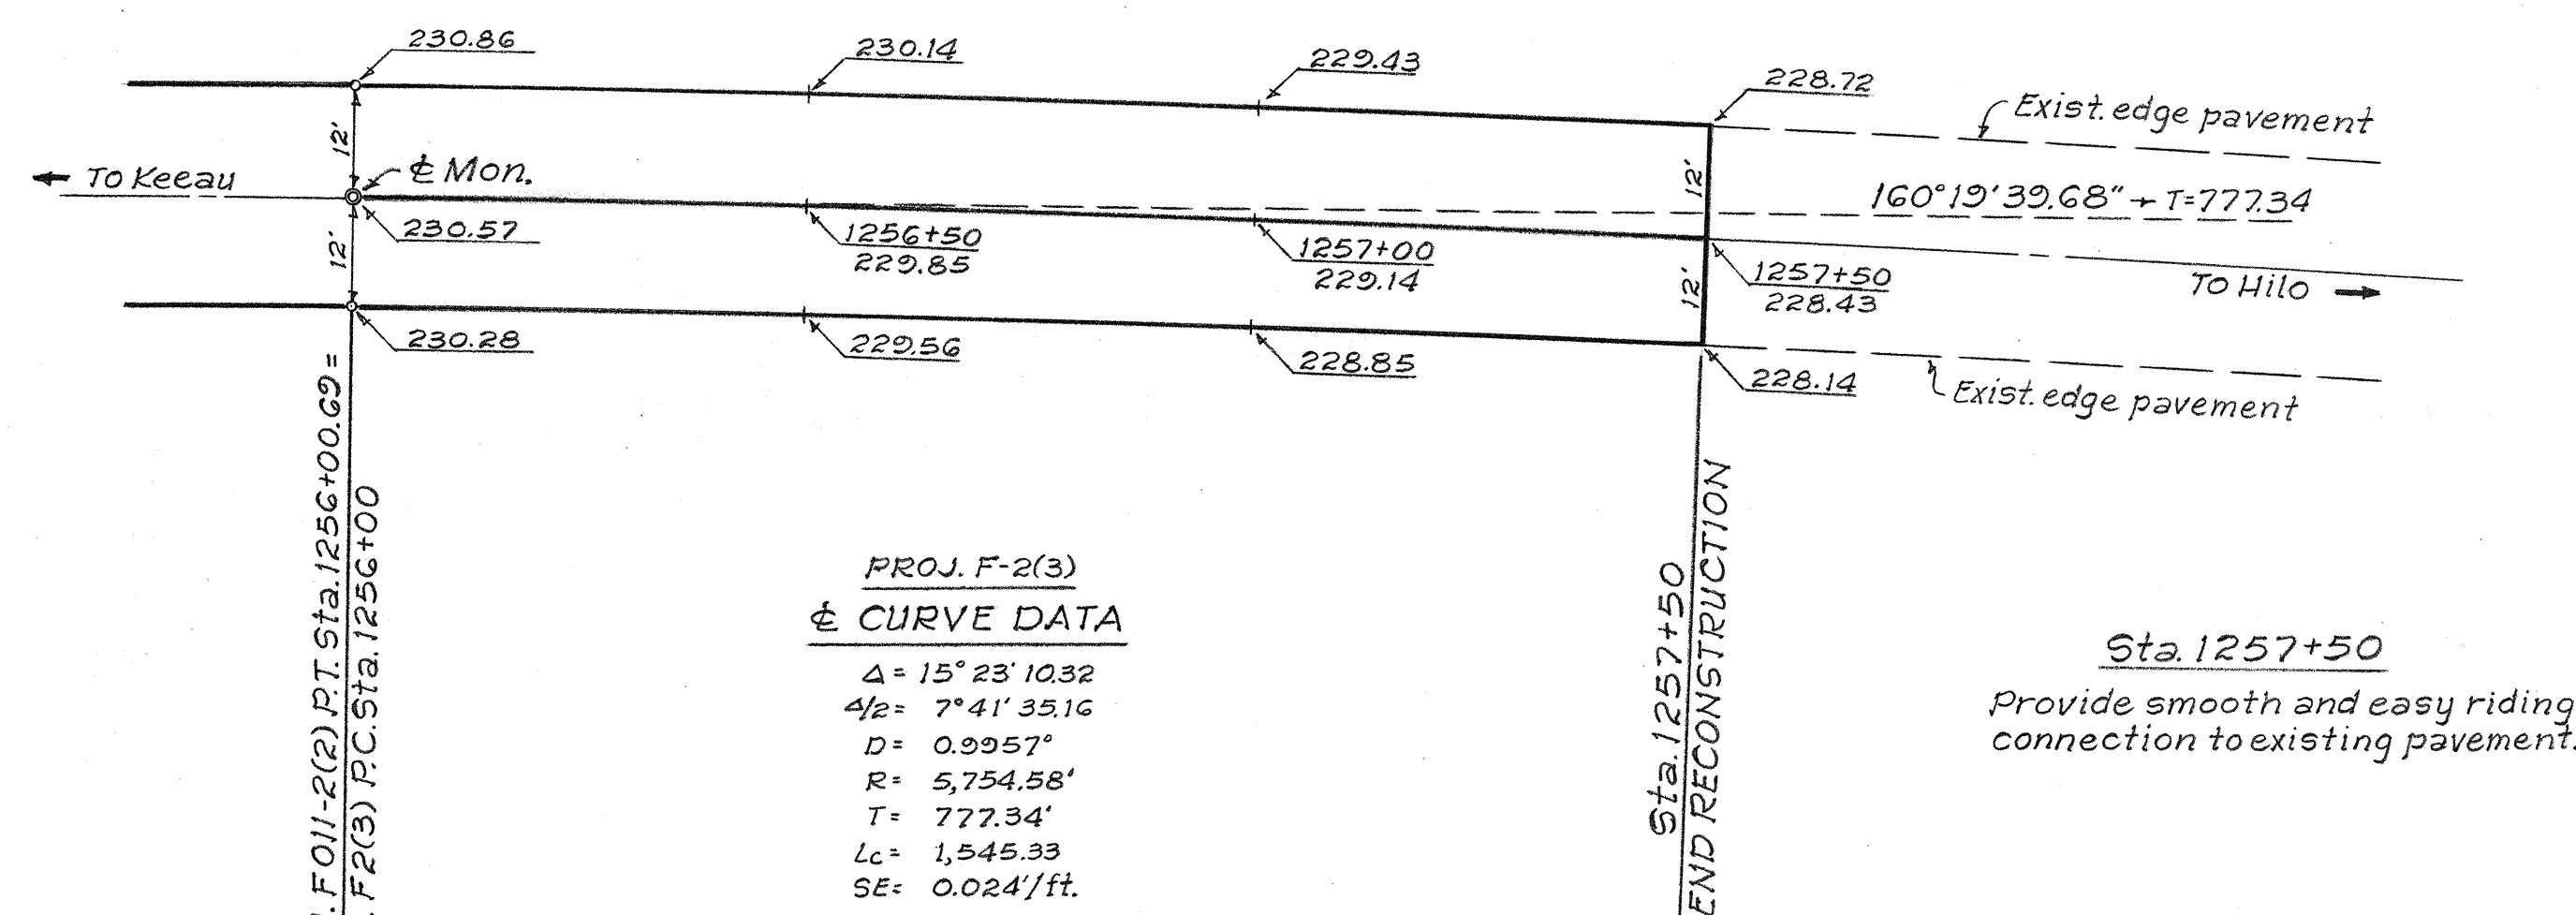

Sta. 1257+50
Provide smooth and easy riding
connection to existing pavement.

SHEET 1 OF 1 SHEETS