

STATE OF HAWAII

DEPARTMENT OF TRANSPORTATION

HIGHWAYS DIVISION

"AS BUILT" PLANS OF

VOLCANO ROAD

SLAUGHTER HOUSE ROAD TO MAKALIKA STREET

PROJECT NO. F-011-2(9)

DISTRICT OF PUNA & SOUTH HILO ISLAND OF HAWAII

SCALES

PLAN_____ | INCH = 100 FT.


PROFILE_____ HOR. | INCH = 100 FT.

VER. | INCH = 10 FT.


CROSS SECTION____ HOR. | INCH = 10 FT.

VER. | INCH = 10 FT.

12/17/71

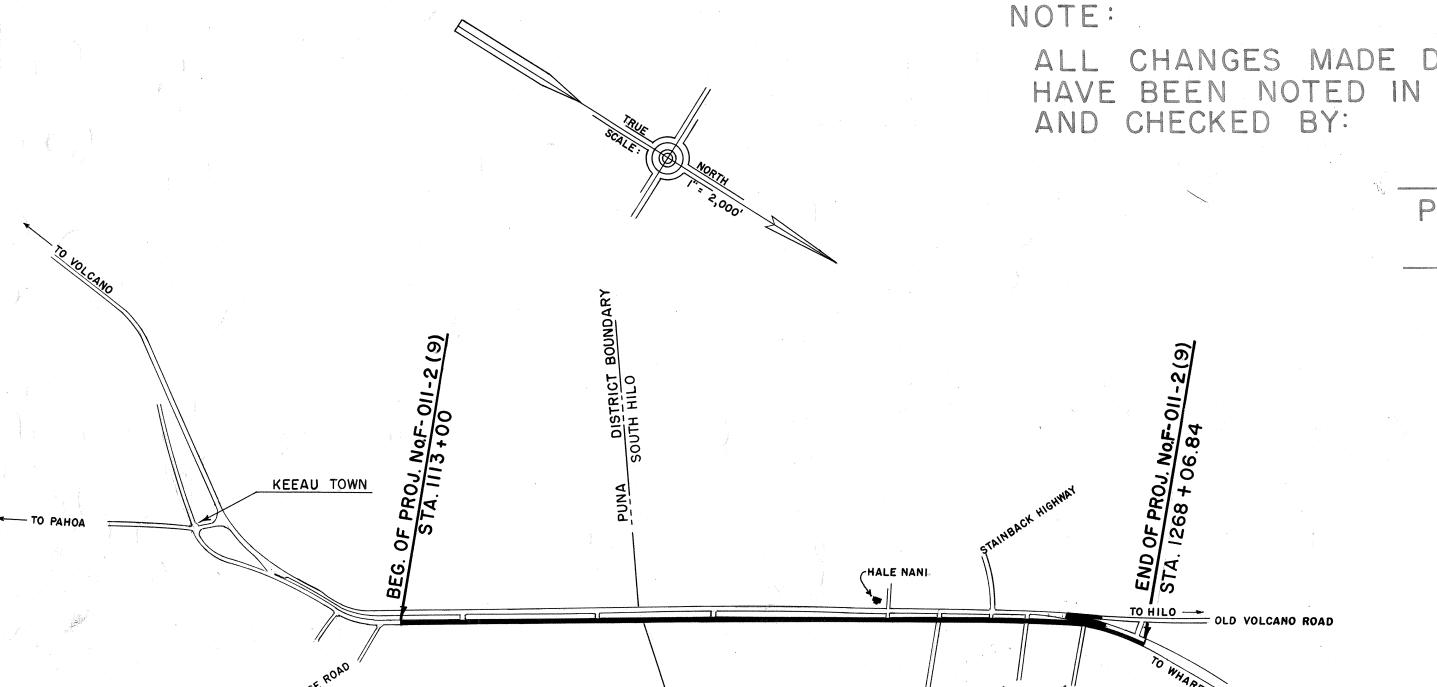

LAYOUT OF PROJECT
LENGTH OF PROJECT 2.937 Miles

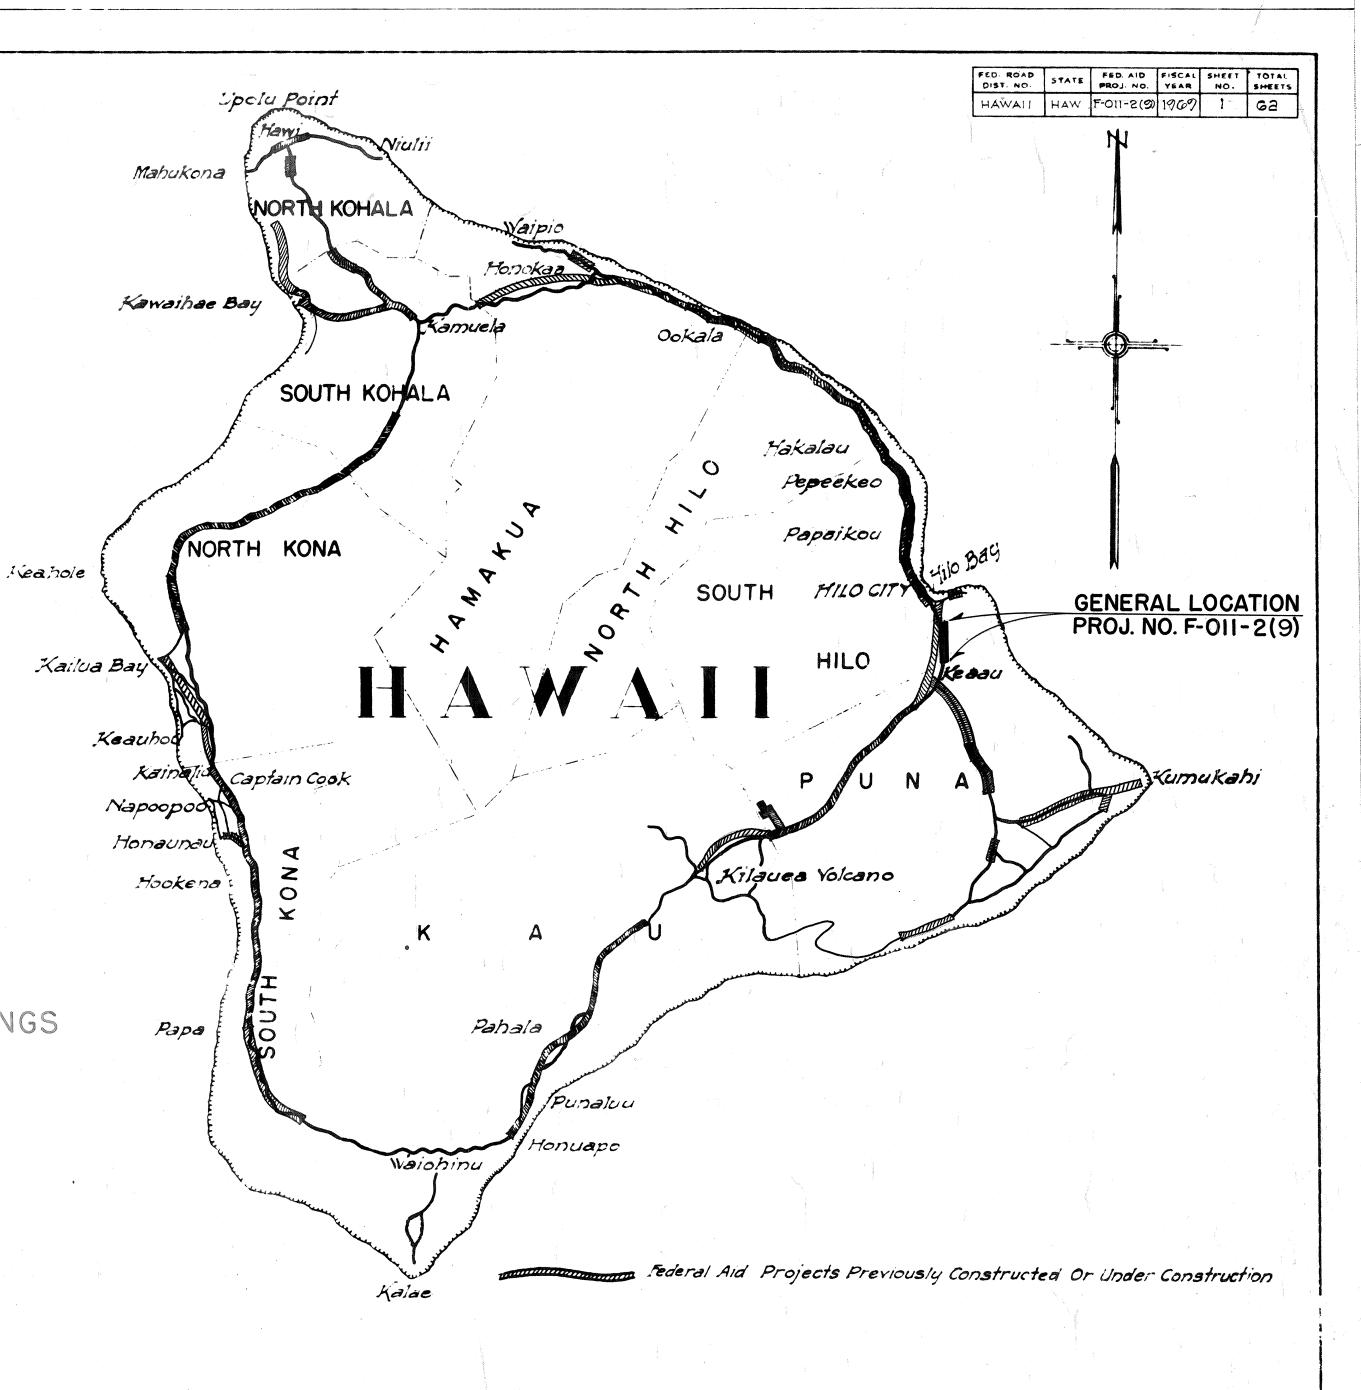

DESIGN CLASSIFICATION

ADT (1968).....5,100
Design ADT (1988).13,200
DHV.......10%
D......65/35
T......8%

APPROVED:

DATE

DATE

DIRECTOR OF TRANSPORTATION

DE		NT OF TRANSPORUU OF PUBLIC RO	
APPRO	OVED:		
1C	تال	Deanu.	9/19/6
FOR	DIVISION	ENGINEER	DATE

SERVEY PLOTTED BY R. TERADA WOY. 68
DESIGNED-BY R. TERADA WOY. 68
DRAWN BY
NOR TRACED BY
OF ANTIFIES CHECKED BY