

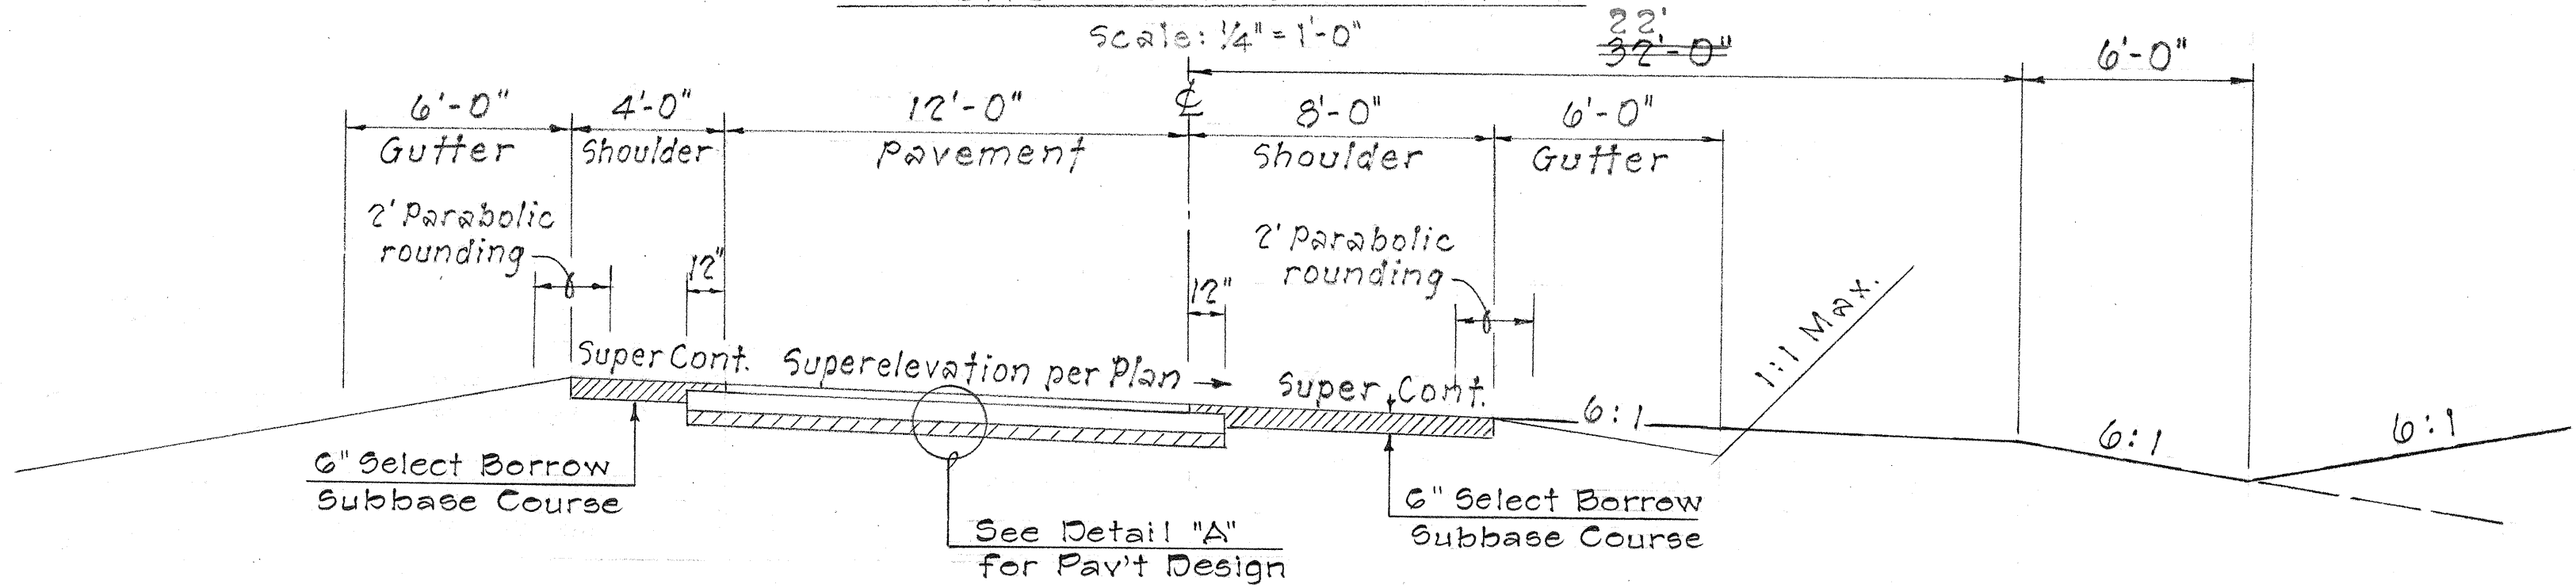
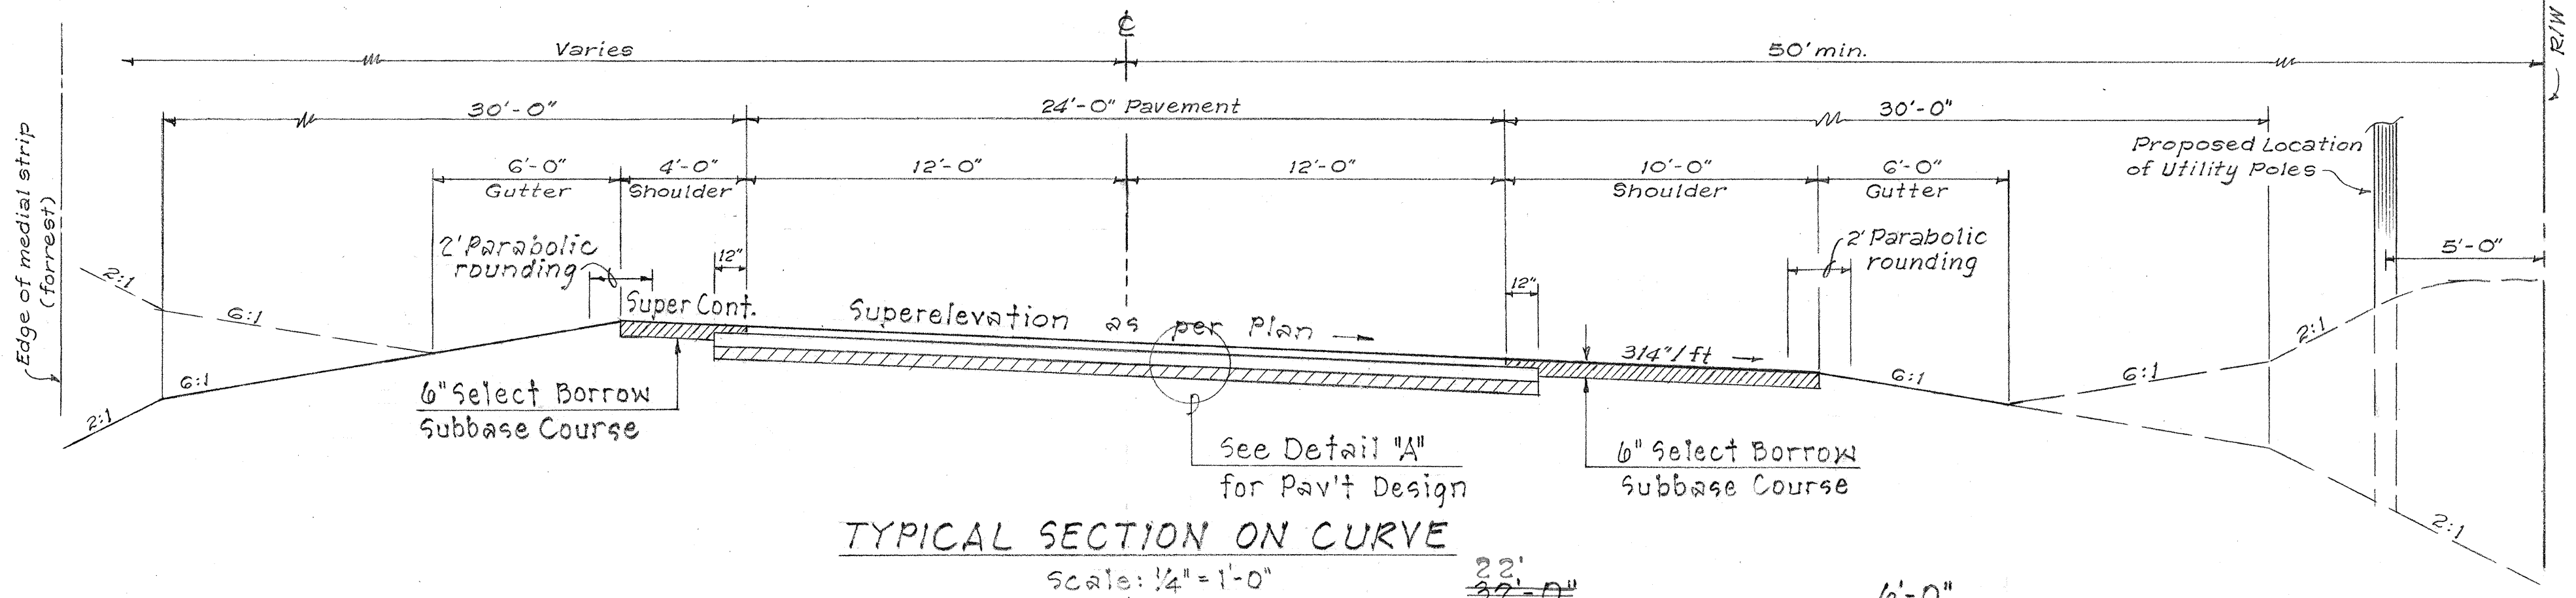
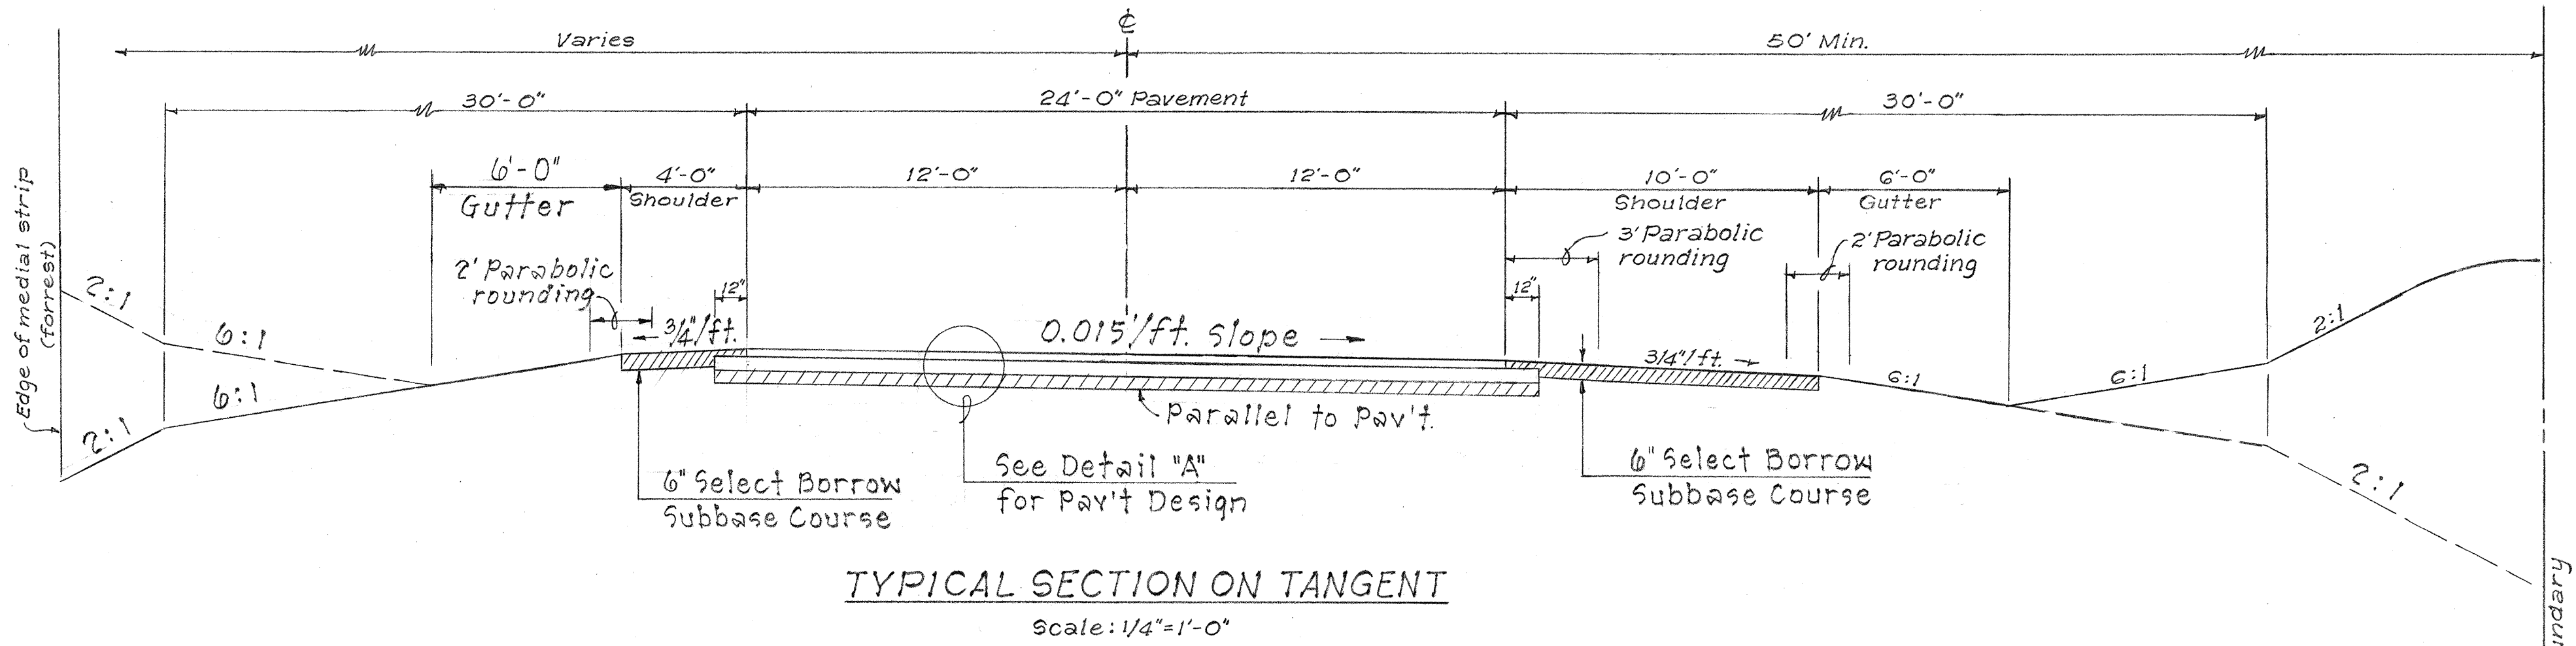




FED. ROAD DIST. NO.	STATE	FED. AID PROJ. NO.	FISCAL YEAR	SHEET NO.	TOTAL SHEETS
HAWAII	HAW.	F-011-2(9)	1969	2	62

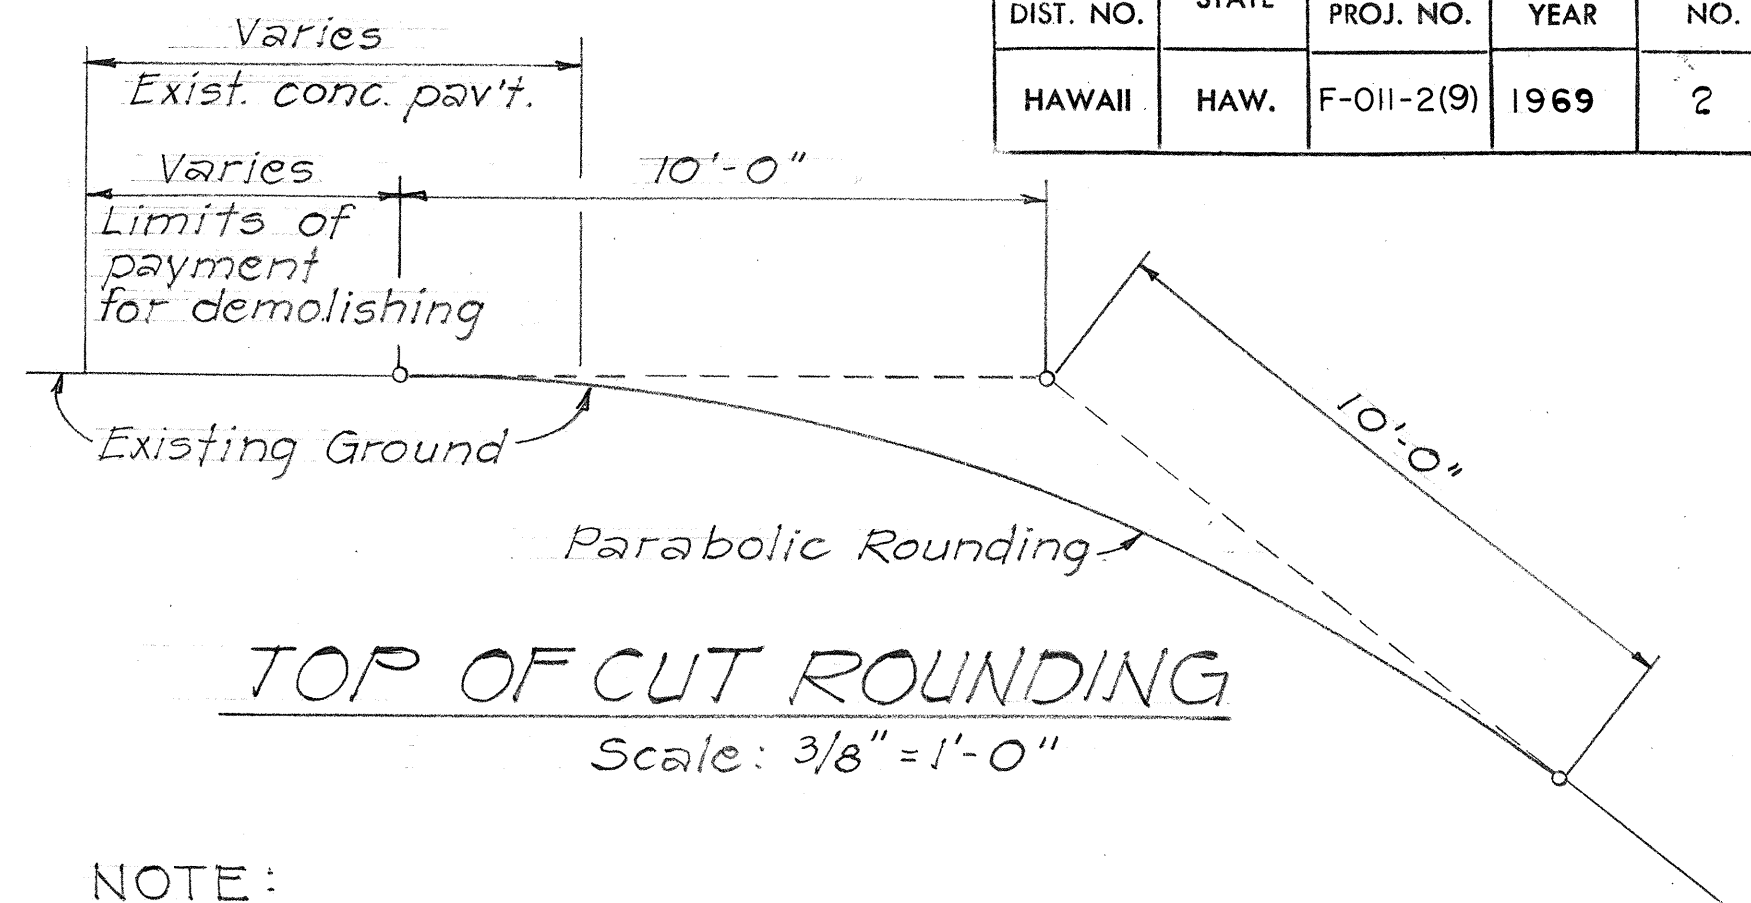

TYPICAL SECTION
STA. 1260+00 TO END OF PROJECT (TWO LANE PRISM)
END OF PROJECT TO END OF TEMPORARY CONNECT. (ONE LANE PRISM)
Scale: 1/4"=1'-0"

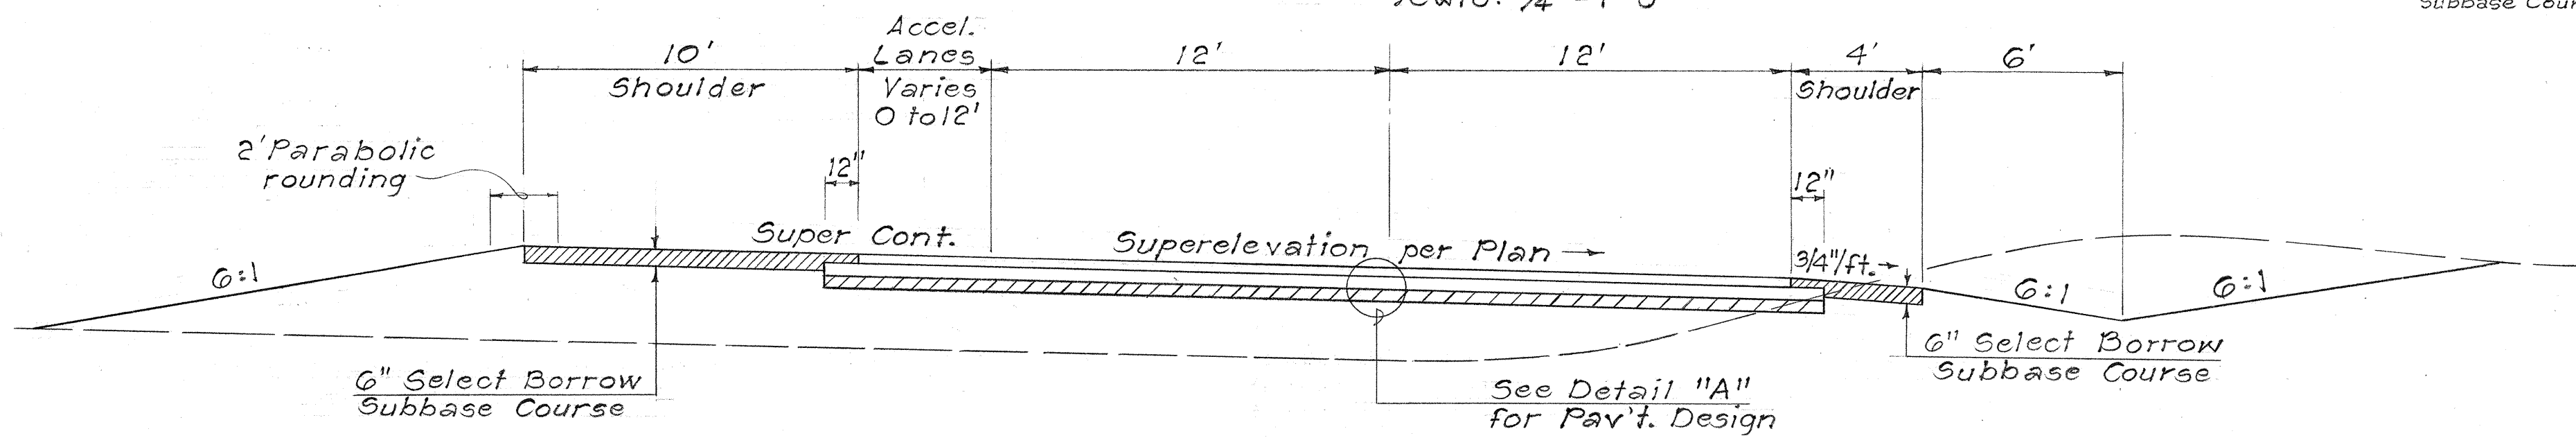

- NOTE:
1. All top of Cut Slopes shall be provided with 20 feet rounding except in rock.
 2. For location of water pipe, See Cross Section.
 3. All shoulders shall be treated with ~~MC-800~~ Seal Coat with chip seal. #8

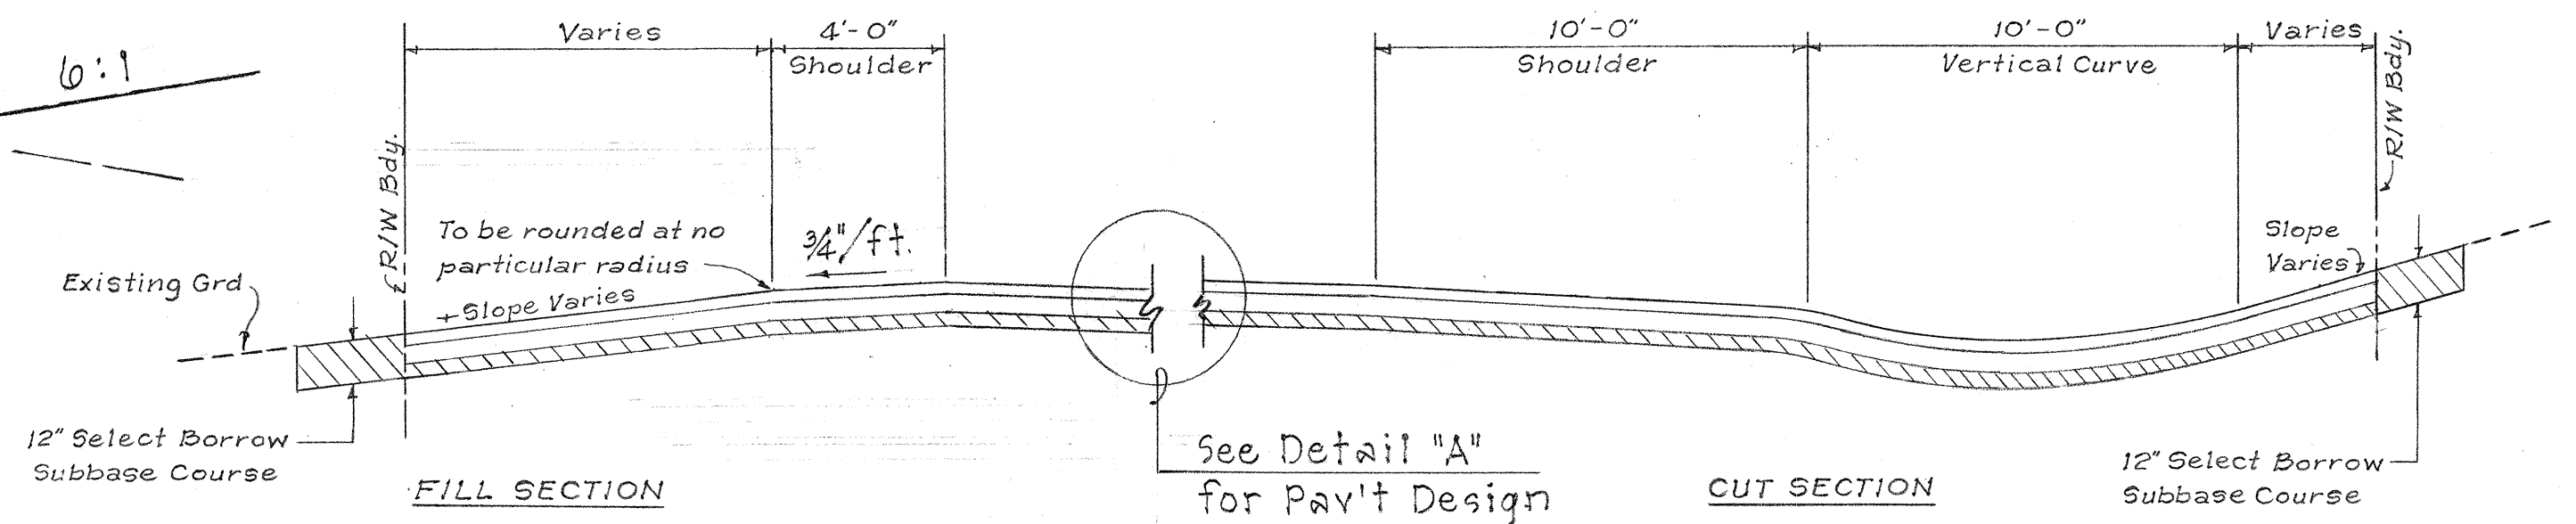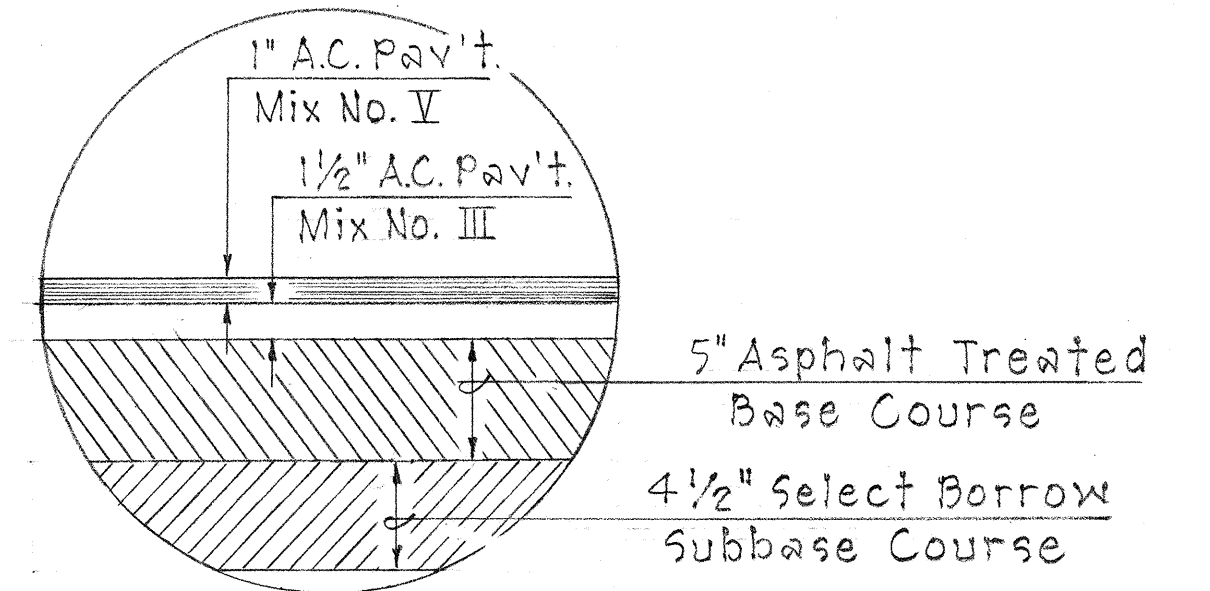

- NOTE: Through cut sections, gutters shall be constructed on a continuous grade to provide for drainage.

DEPARTMENT OF TRANSPORTATION
HIGHWAYS DIVISION
STATE OF HAWAII

TYPICAL SECTIONS

VOLCANO ROAD
PROJECT No. F-011-2(9)
SLAUGHTER HOUSE ROAD TO MAKALIKA STREET
Scale: As Noted Date: AUG. 1969