



INDEX TO DRAWINGS	
SHEET NO.	DESCRIPTION
1	TITLE SHEET
2	TYPICAL SECTIONS
3-7	LOCATION PLANS
8-11	STANDARD DETAILS
12-22	CROSS SECTIONS
*C07S-1 & C07S-2	LOCATION PLANS
*C022S-1 - C022S-7	CROSS SECTIONS

* These tracings added to original Contract Plans to accompany Contract Change Order No. 1.

STATE OF HAWAII
DEPARTMENT OF TRANSPORTATION
HIGHWAYS DIVISION
"AS BUILT"
PLANS FOR

**SAFETY IMPROVEMENTS ALONG
HAWAII BELT ROAD
HOOKENA TO MILOLII**
PROJECT NO. 11C-02-70
DISTRICT OF SOUTH KONA
ISLAND OF HAWAII

FED. ROAD DIST. NO.	STATE	PROJ. NO.	FISCAL YEAR	SHEET NO.	TOTAL SHEETS
HAWAII	HAW.	11C-02-70	1969	1	22

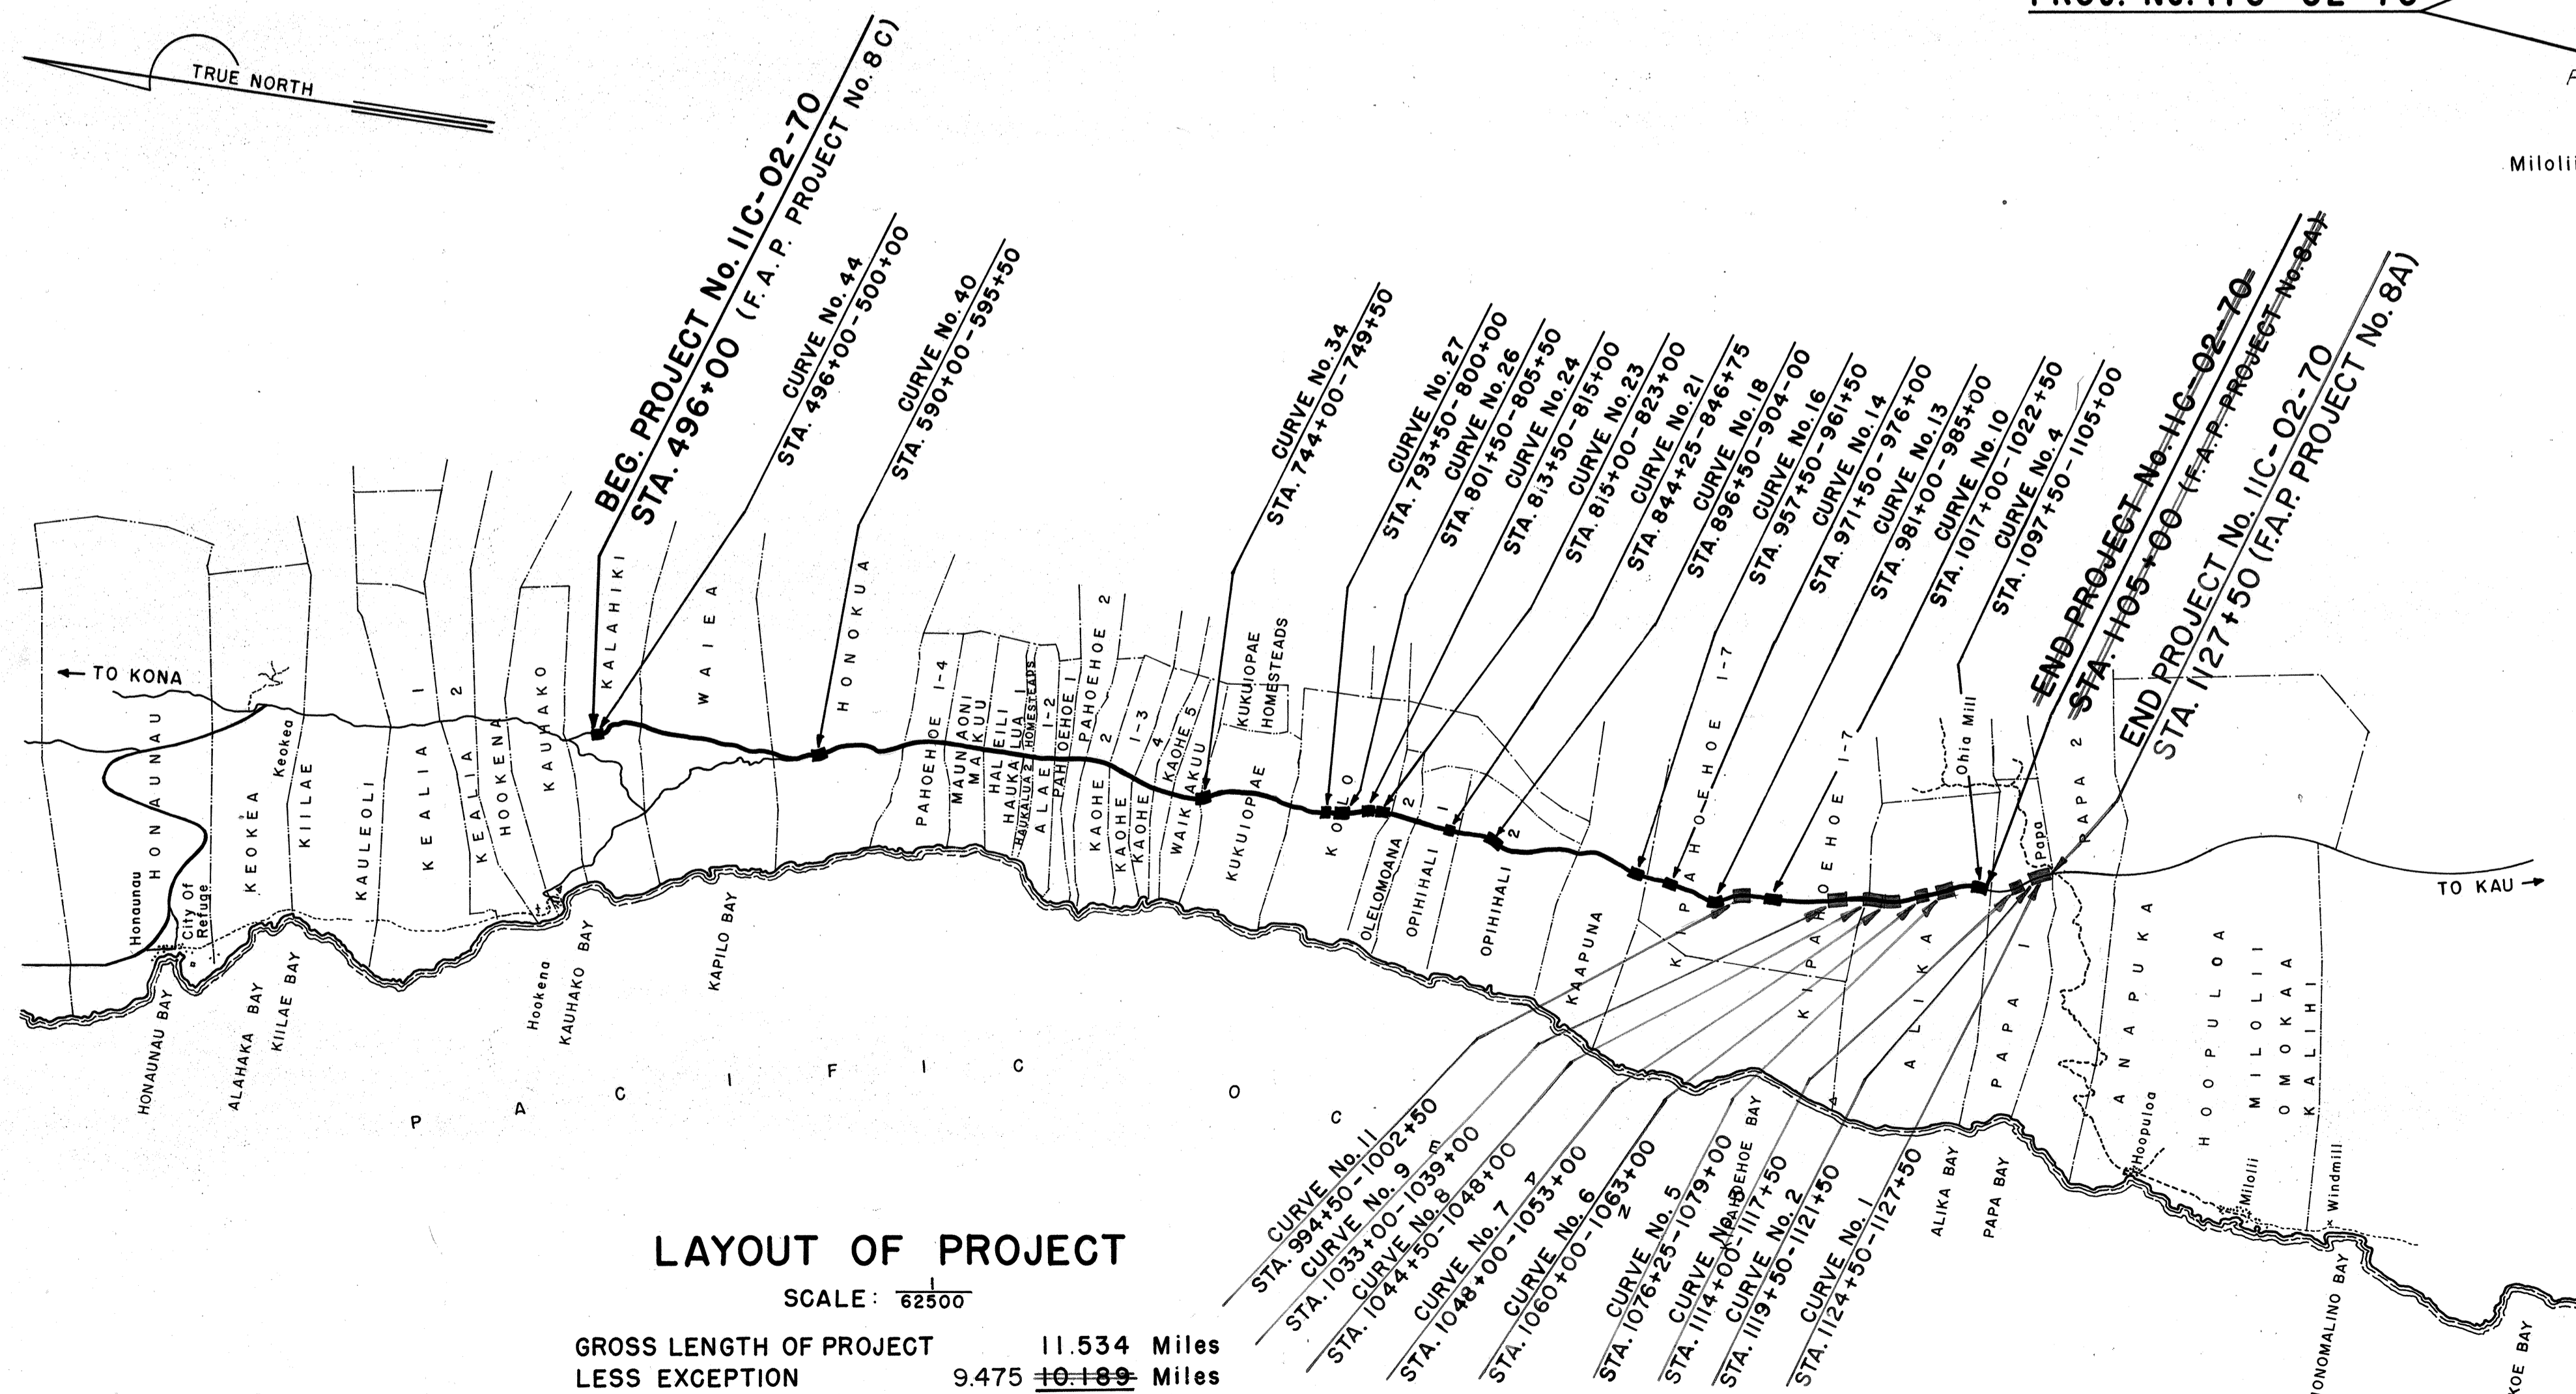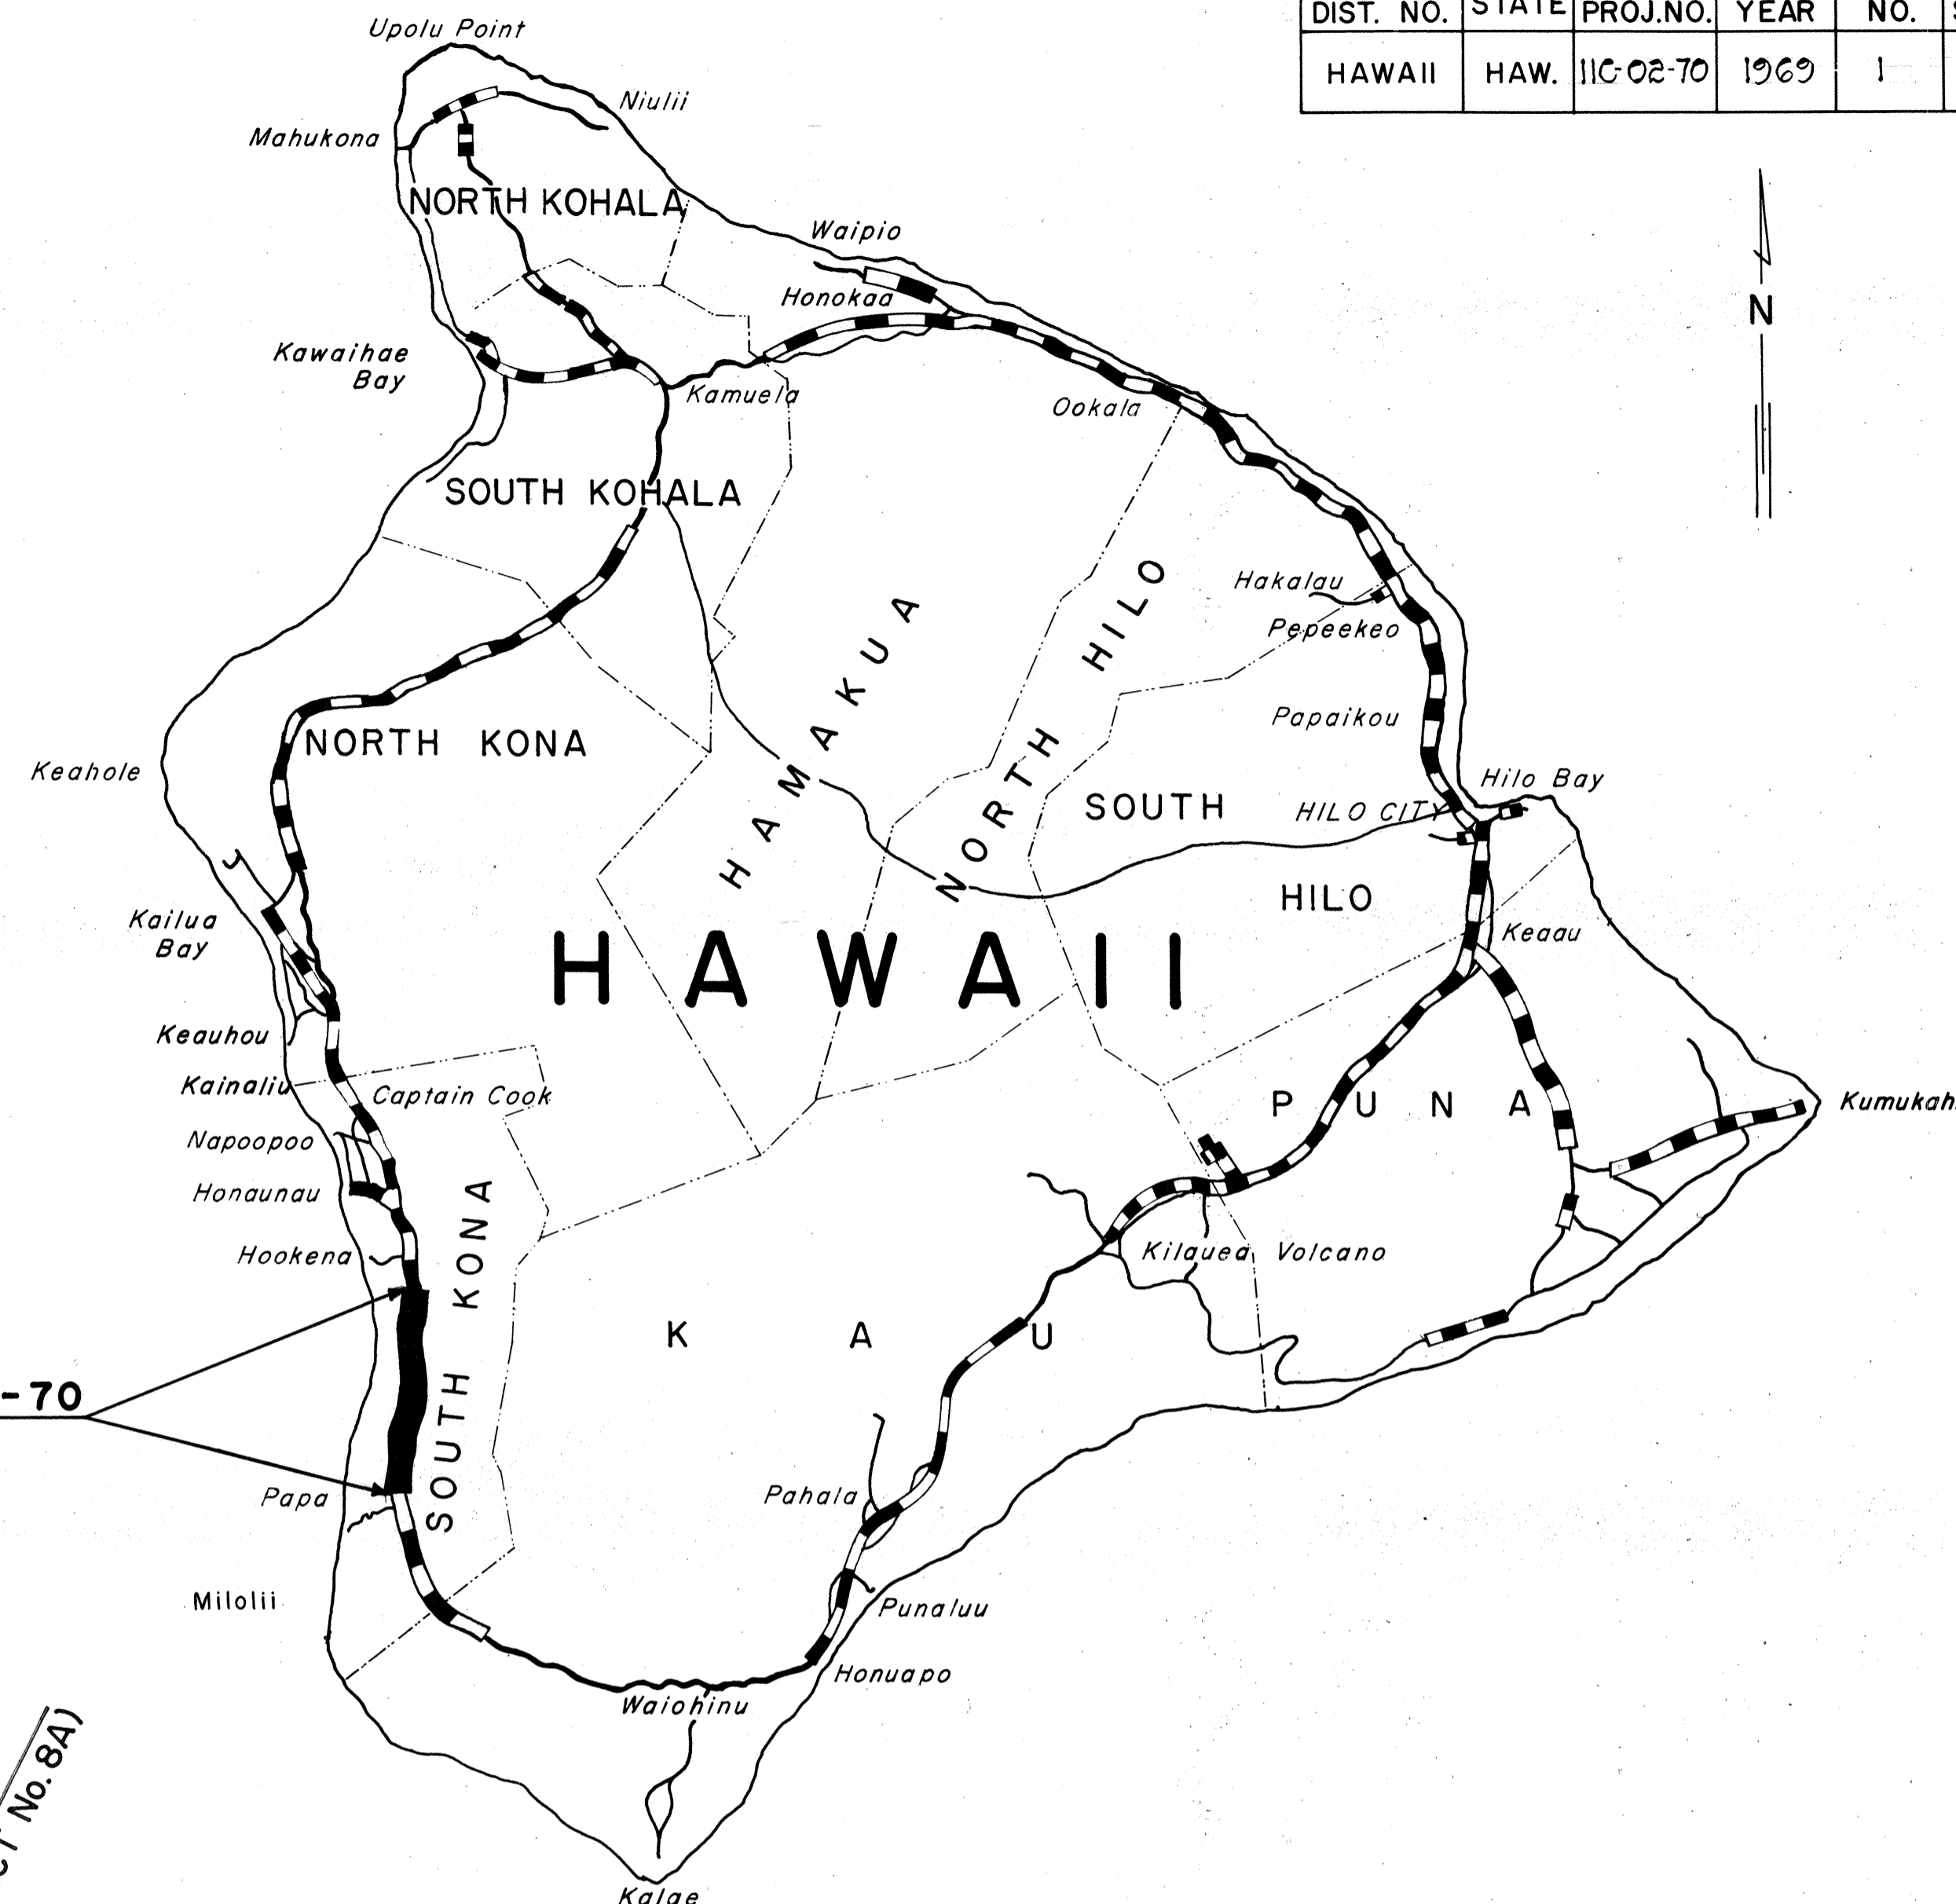

LAYOUT OF PROJECT
SCALE: 62500'

GROSS LENGTH OF PROJECT	11.534 Miles
LESS EXCEPTION	9.475 Miles
NET LENGTH OF PROJECT	2.059 Miles

DESIGNED BY: HAWAII DISTRICT
PS&E
Ronald Tsuguki
DESIGN ENGINEER
5475-301
PHONE
Feb. 1970
DATE

Federal Aid Projects Previously Constructed Or Under Construction

NOTE:
All changes made during construction have been noted in these tracings in red and checked by:
Kasui Higuchi
for RESIDENT ENGINEER
1-21-71
DATE

DEPARTMENT OF TRANSPORTATION
STATE OF HAWAII
APPROVED:
E. Alvey Knight 2/9/70
for DIR. OF TRANSPORTATION DATE