

FINAL
SURVEY
2/24/70
1003

ORIGINAL
SURVEY
2/24/70
1003

Exc. 1.9
Emb. 0.5
~~S.M. 4.6~~

Exc. 3.2
Emb. 0
~~S.M. 3.7~~

Exc. 1.9
Emb. 0.5
~~S.M. 3.6~~

Exc. 2.3
Emb. 0.5
~~S.M. 2.8~~

Exc. 1.1
Emb. 0
~~S.M. 1.0~~

Exc. 2.3
Emb. 0
~~S.M. 2.3~~

Exc. 1.0
Emb. 0

CURVE No.41
[N.I.C.]

Cut 0
Fill 1
~~S.M. 6.0~~

Cut 4
Fill 0
~~S.M. 4.0~~

Cut 3
Fill 0
~~S.M. 4.0~~

Cut 1
Fill 1
~~S.M. 3.0~~

Cut 4
Fill 0
~~S.M. 3.0~~

Cut 3
Fill 0
~~S.M. 3.0~~

Cut 0
Fill 0
~~S.M. 0~~

Cut 0
Fill 0

Exc. 0
Emb. 0
~~S.M. 0~~

Exc. 0.4
Emb. 12.4
~~S.M. 2.4~~

Exc. 0.8
Emb. 14.9
~~S.M. 2.7~~

Exc. 0.9
Emb. 6.9
~~S.M. 3.7~~

Exc. 0.5
Emb. 2.8
~~S.M. 3.4~~

Cut 0
Fill 0

Cut 0
Fill 0
~~S.M. 0~~

Cut 1
Fill 2.8
~~S.M. 4.0~~

Cut 1
Fill 10
~~S.M. 3.0~~

Cut 1
Fill 5
~~S.M. 5.0~~

Exc. 0
Emb. 15.3
~~S.M. 3.2~~

Exc. 0
Emb. 0
~~S.M. 1.9~~

Exc. 0
Emb. 0

Exc. 0
Emb. 0

623+75

623+50

623+25

623+00

P.C. 622+73.30

622+50

622+00

621+50

CURVE No.38

Cut 0
Fill 3.9
~~S.M. 4.0~~

Cut 0
Fill 0

Cut 0
Fill 0

FINAL SURVEY
DATE: 8/24/70
BY: J.S.
1003


ORIGINAL SURVEY
DATE: 8/24/70
BY: J.S.
1003

Exc. 5.6
Emb. 0.5
S.M. 5.1

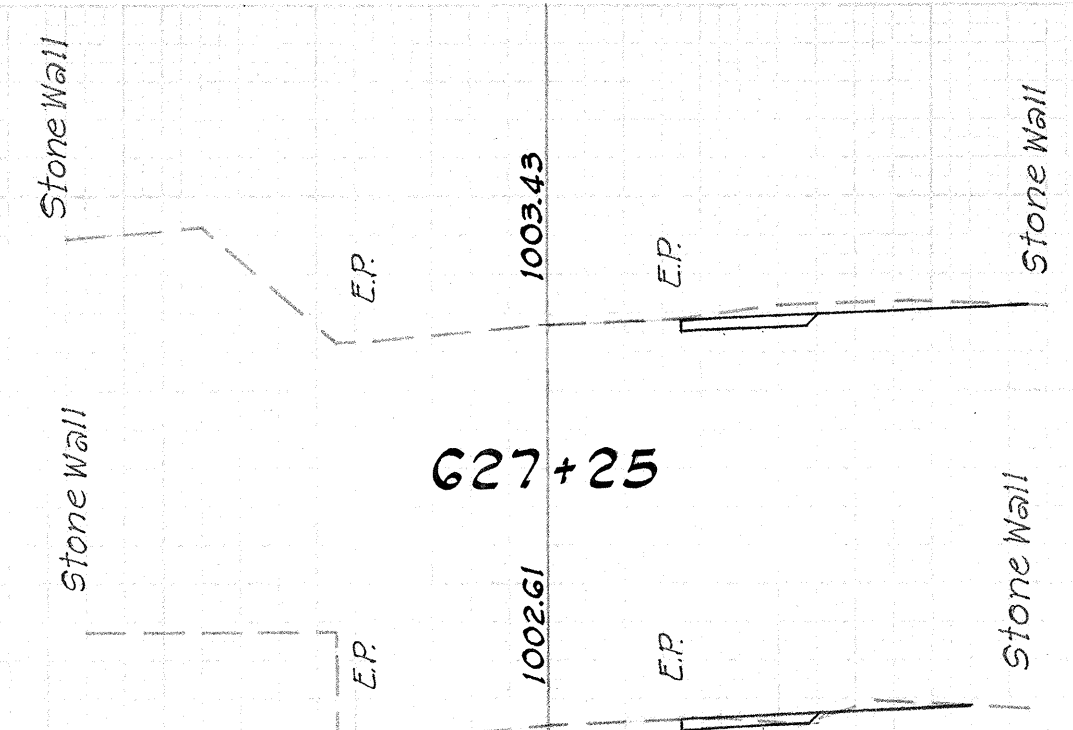


Cut 10
Fill 0
S.M. 4.0

Exc. 1.9
Emb. 0.2
S.M. 3.2

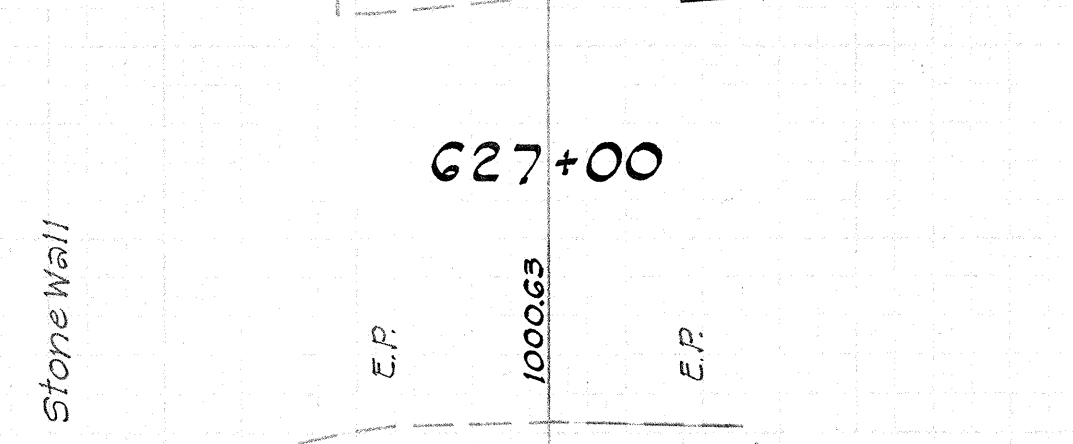


Cut 2
Fill 1
S.M. 3.0

Exc. 0.9
Emb. 20.4
S.M. 2.8

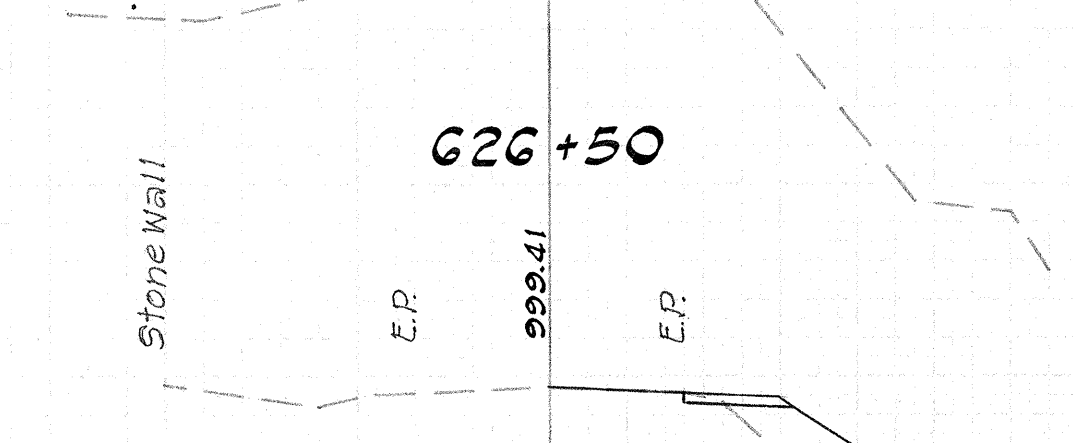


Cut 0
Fill 0
S.M. 0

Exc. 1.9
Emb. 21.3
S.M. 2.8

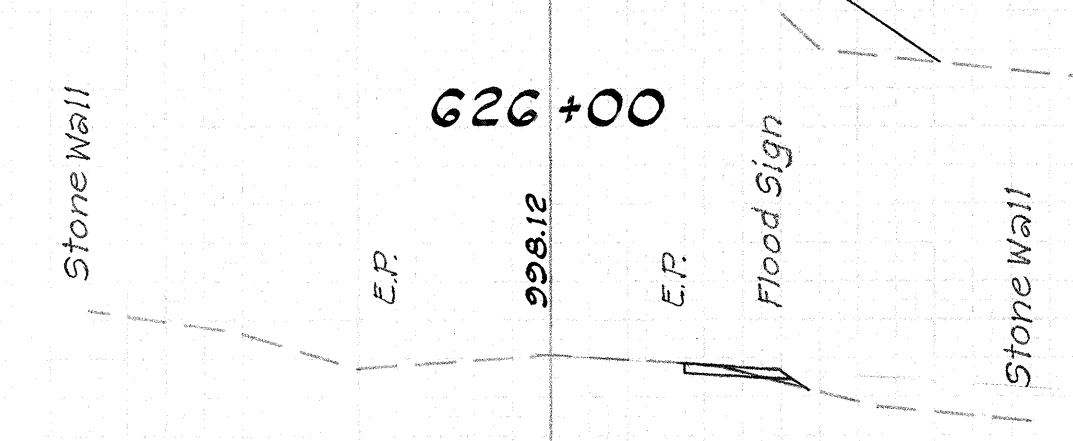


Cut 1
Fill 22
S.M. 3.0

Exc. 2.8
Emb. 3.7
S.M. 4.6

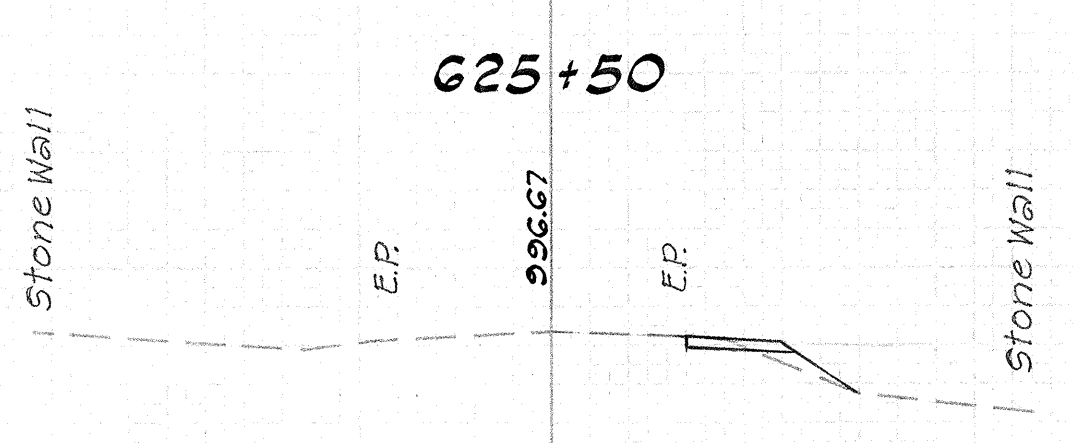


Cut 1
Fill 1
S.M. 2.0

Exc. 3.2
Emb. 30.7
S.M. 3.7

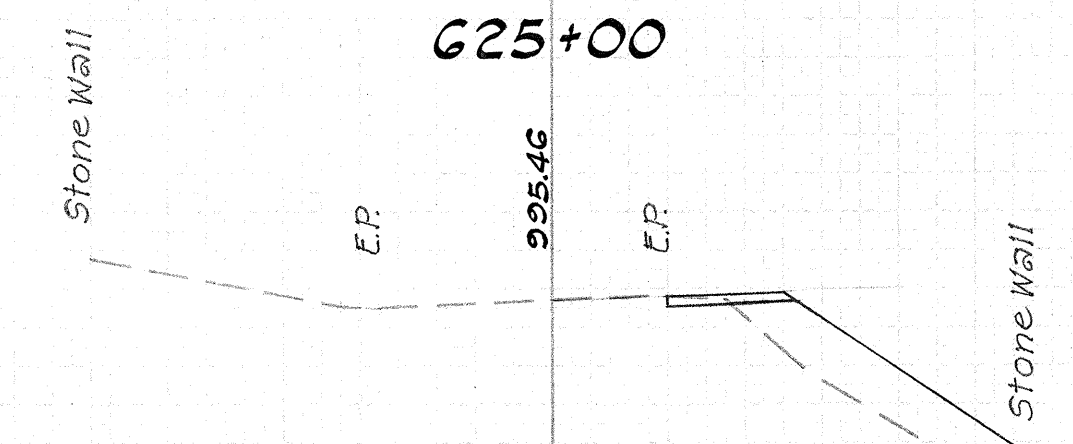


Cut 2
Fill 3
S.M. 2.0

Exc. 3.1
Emb. 63.7
S.M. 4.0

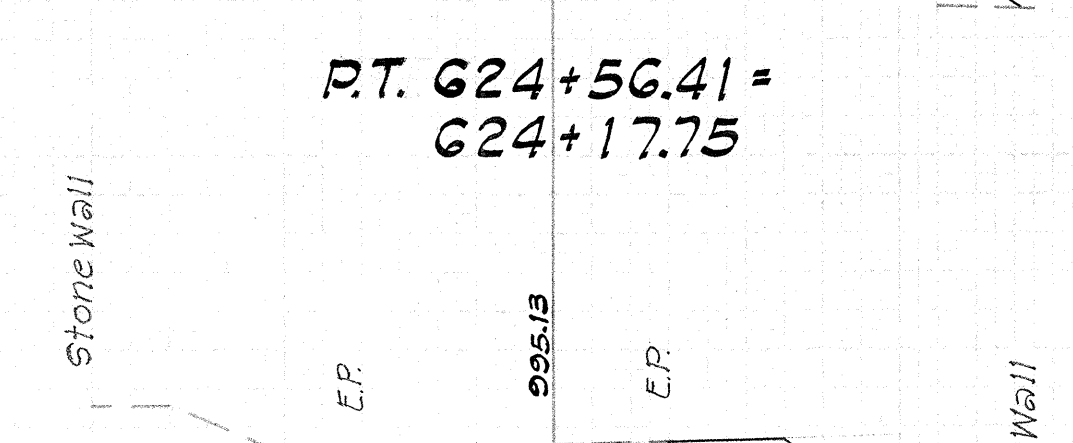

Cut 2
Fill 35
S.M. 3.0


Exc. 0.5
Emb. 27.3
S.M. 6.2

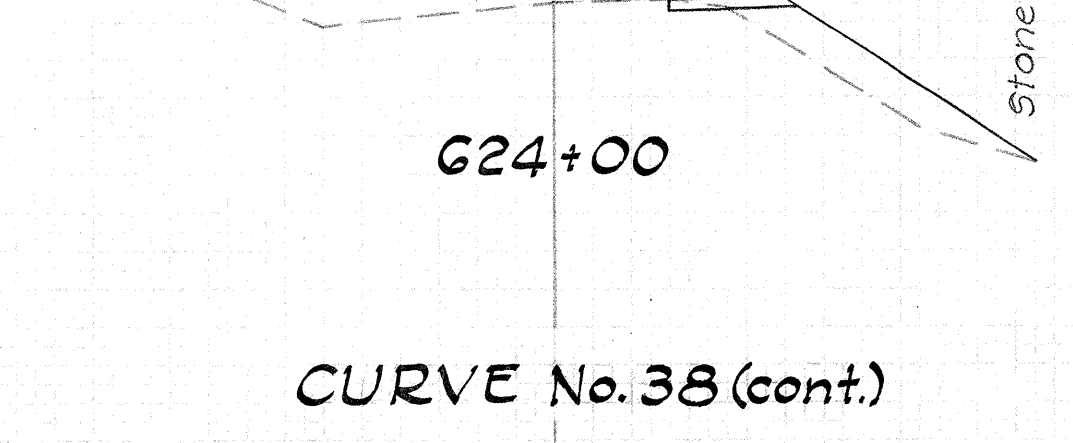

Cut 1
Fill 26
S.M. 3.0


CURVE No. 38 (cont.)

Exc. 0
Emb. 0

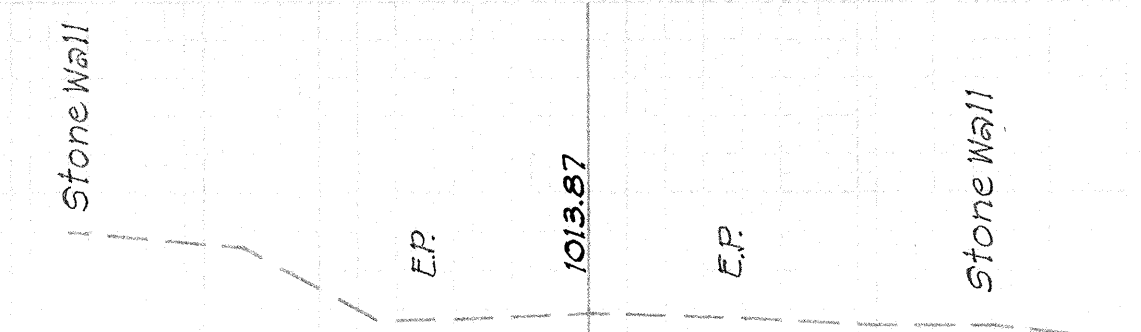


Cut 0
Fill 0

Exc. 0
Emb. 0

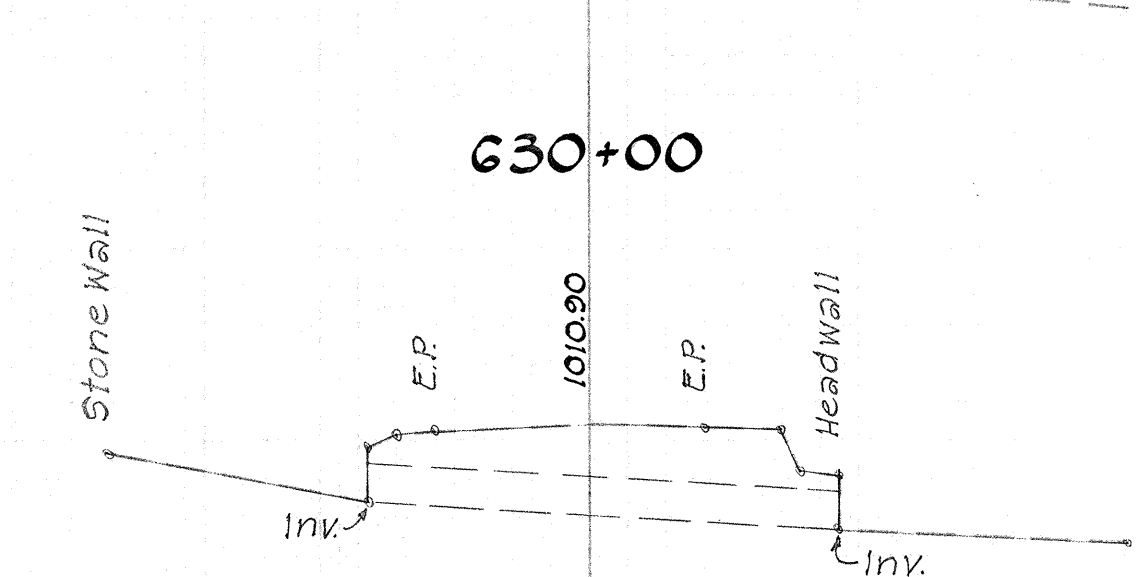


Cut 0
Fill 0

Exc. 0.5
Emb. 15.3
S.M. 0

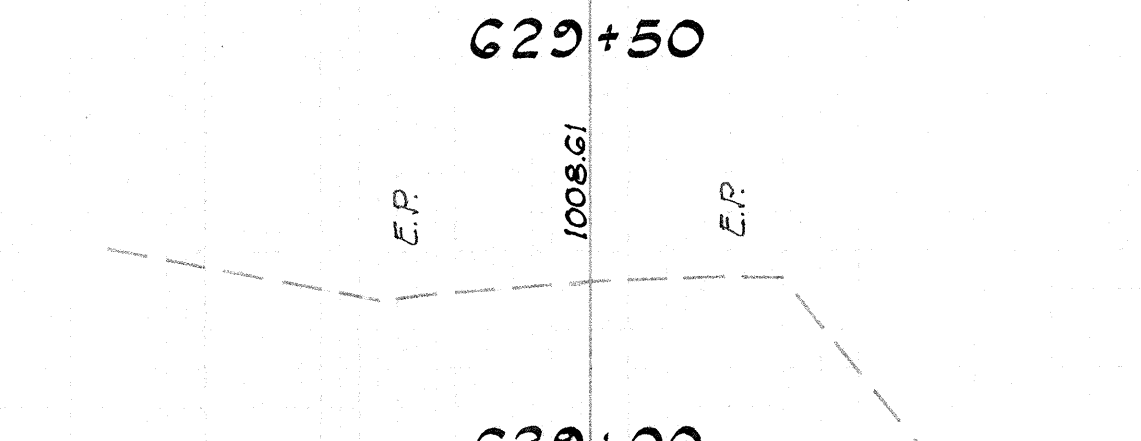


Cut 0
Fill 0
S.M. 0

Exc. 0.9
Emb. 24.5
S.M. 0.9

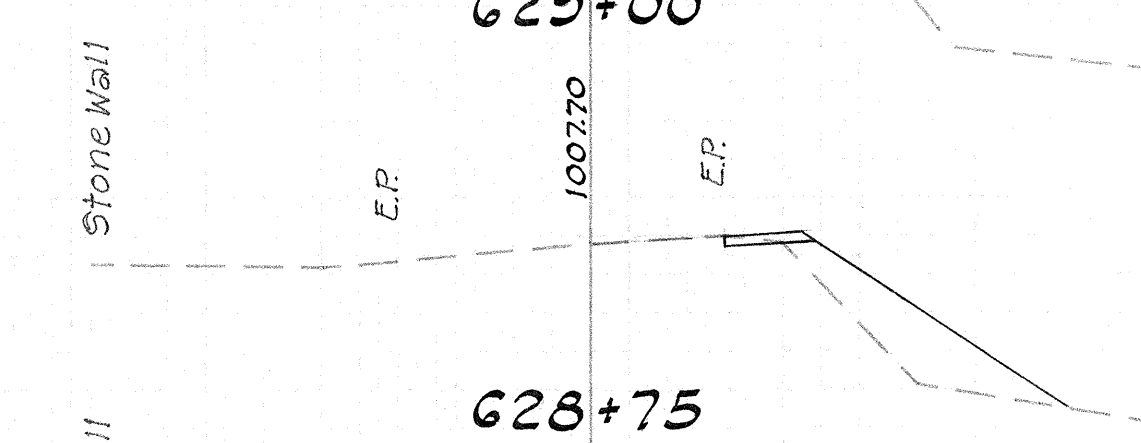


Cut 1
Fill 33
S.M. 2.0

Exc. 0.9
Emb. 13.0
S.M. 2.3

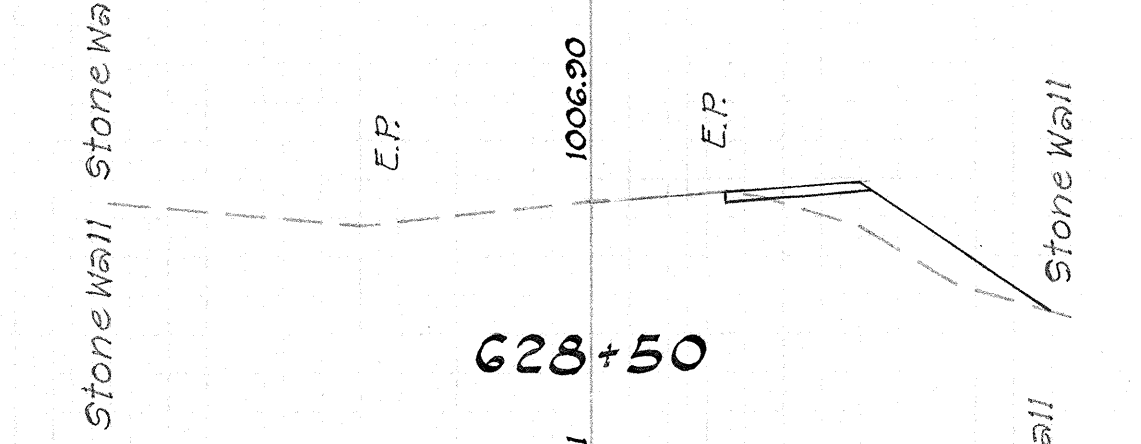


Cut 1
Fill 20
S.M. 3.0

Exc. 1.4
Emb. 6.0
S.M. 3.7

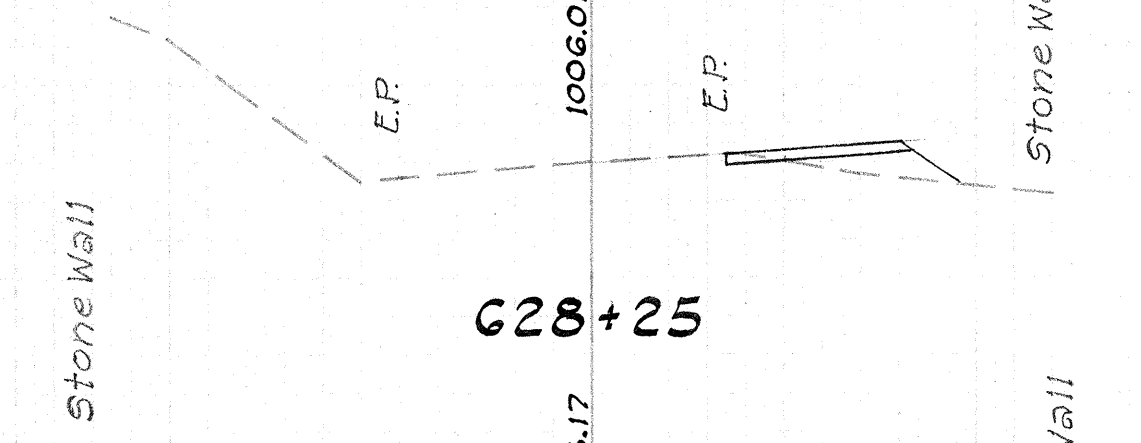


Cut 1
Fill 8
S.M. 5.0

Exc. 1.9
Emb. 3.7
S.M. 5.1

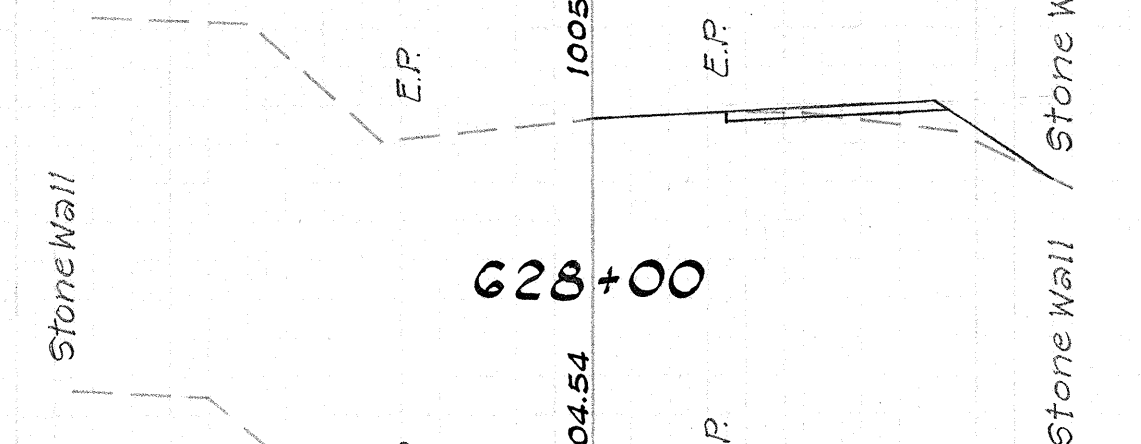


Cut 2
Fill 5
S.M. 6.0

Exc. 1.4
Emb. 2.8
S.M. 6.0

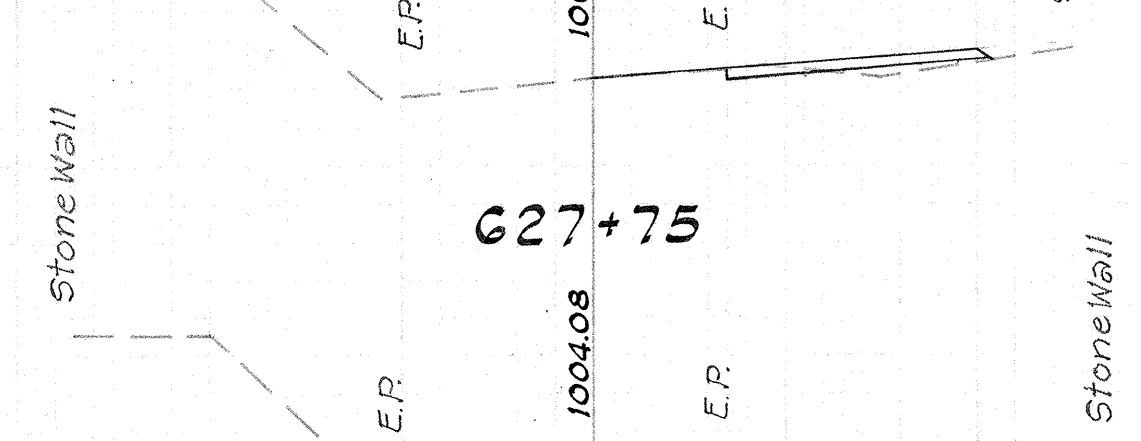


Cut 2
Fill 3
S.M. 7.0

Exc. 5.1
Emb. 1.4
S.M. 6.5

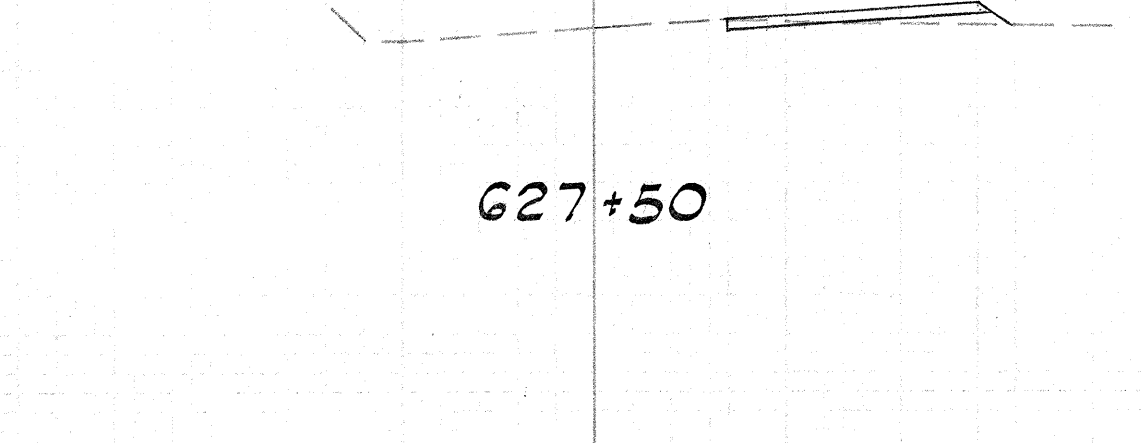


Cut 1
Fill 3
S.M. 7.0

Exc. 18.4
Emb. 0
S.M. 5.1

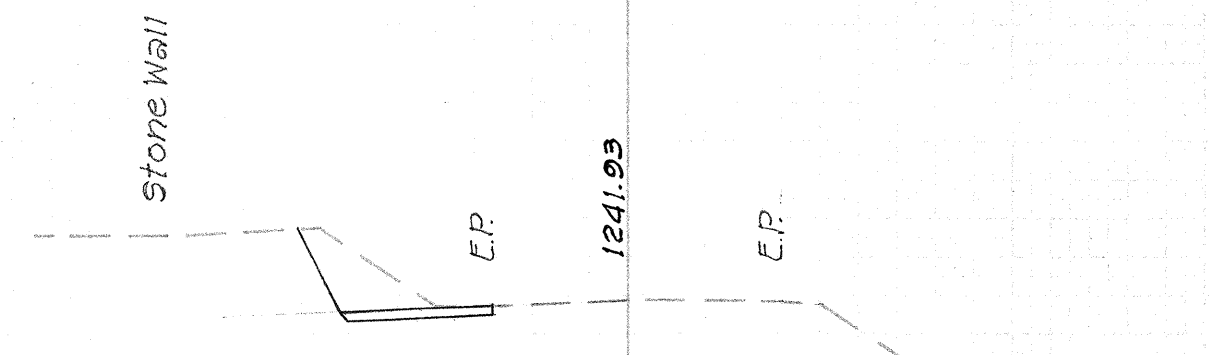


Cut 19
Fill 0
S.M. 4.0

Exc. 0.9
Emb. 11.2
S.M. 6.5

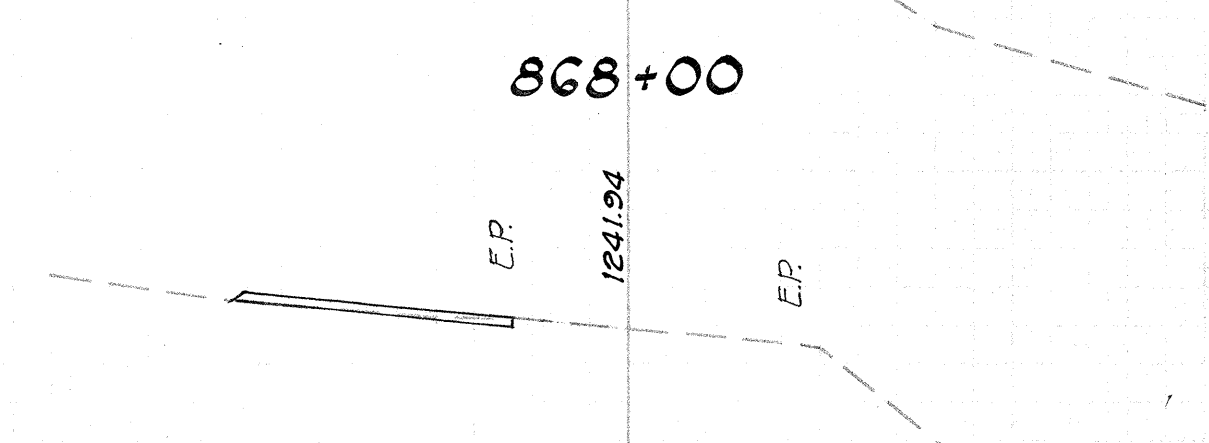


Cut 1
Fill 0
S.M. 7.0

Exc. 0.9
Emb. 20.4
S.M. 6.5

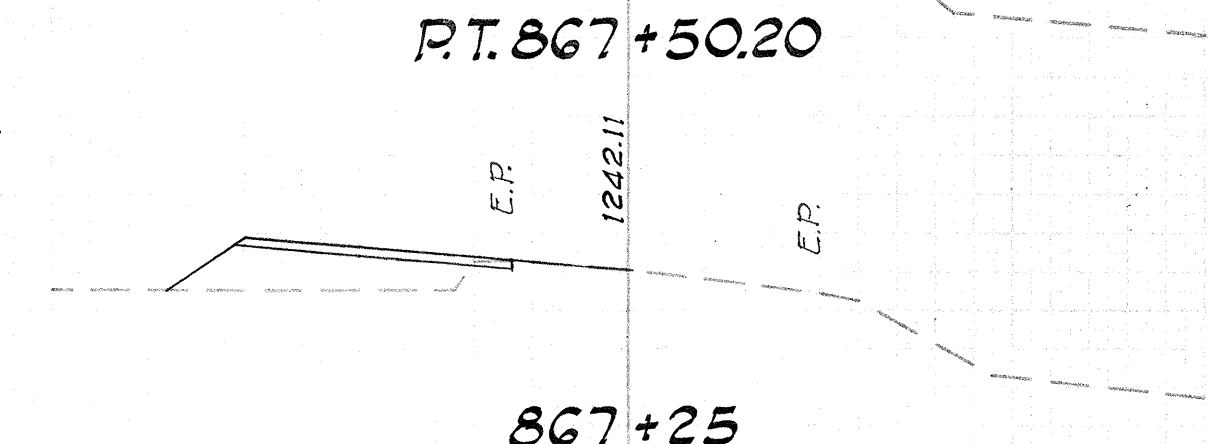


Cut 1
Fill 24
S.M. 7.0

Exc. 0.9
Emb. 16.2
S.M. 6.5

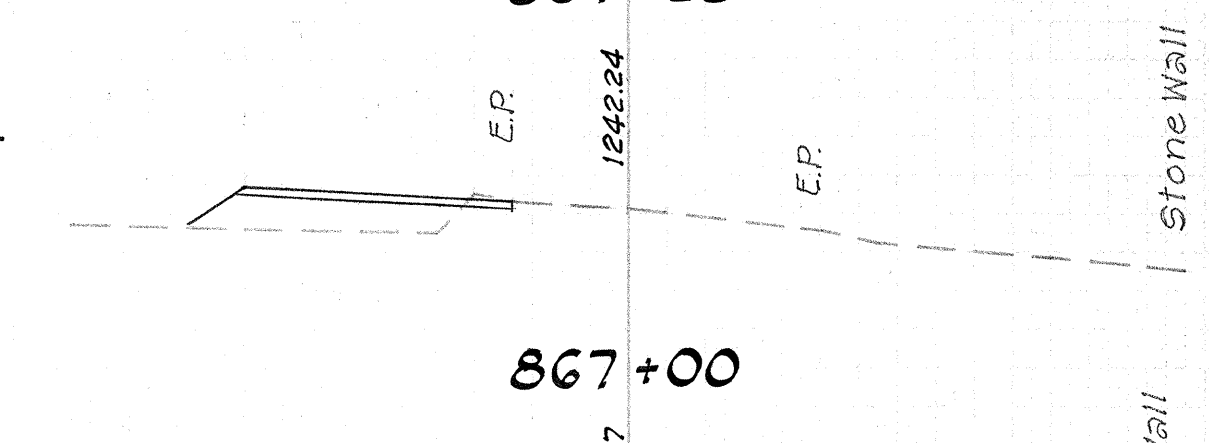


Cut 1
Fill 20
S.M. 7.0

Exc. 0.9
Emb. 8.8
S.M. 6.5

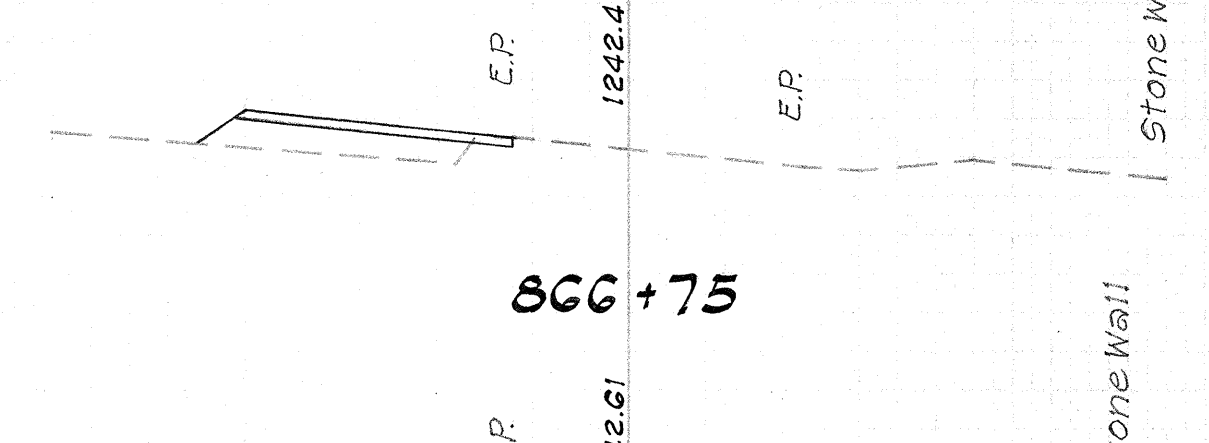


Cut 1
Fill 15
S.M. 7.0

Exc. 7.4
Emb. 3.8
S.M. 11.1

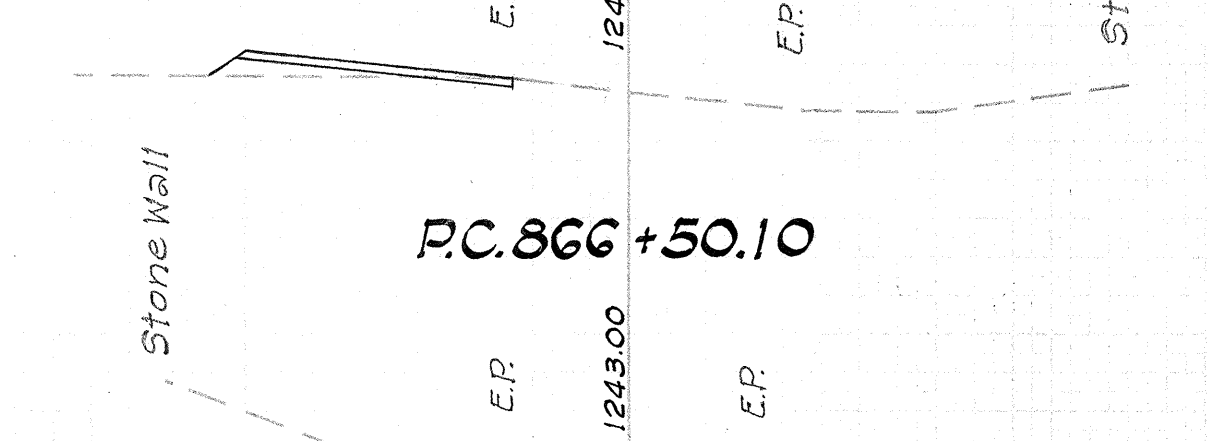

Cut 1
Fill 4
S.M. 7.0

Exc. 6.5
Emb. 0
S.M. 4.6

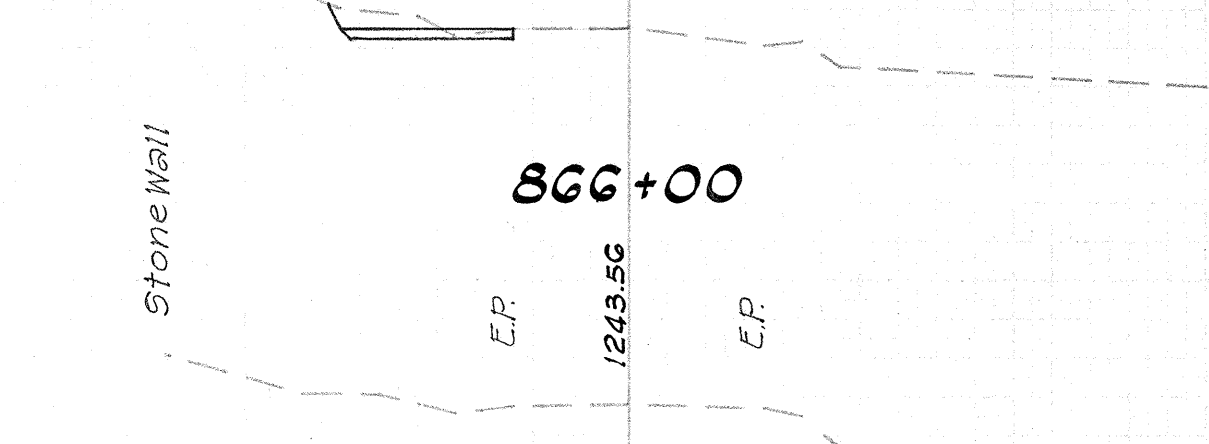

Cut 7
Fill 0
S.M. 5.0


865+50

CURVE No. 20


NOTE: S.M. = Aggregate Subbase

FINAL SURVEY
1002 &
1003



ORIGINAL SURVEY
1002 &
1003

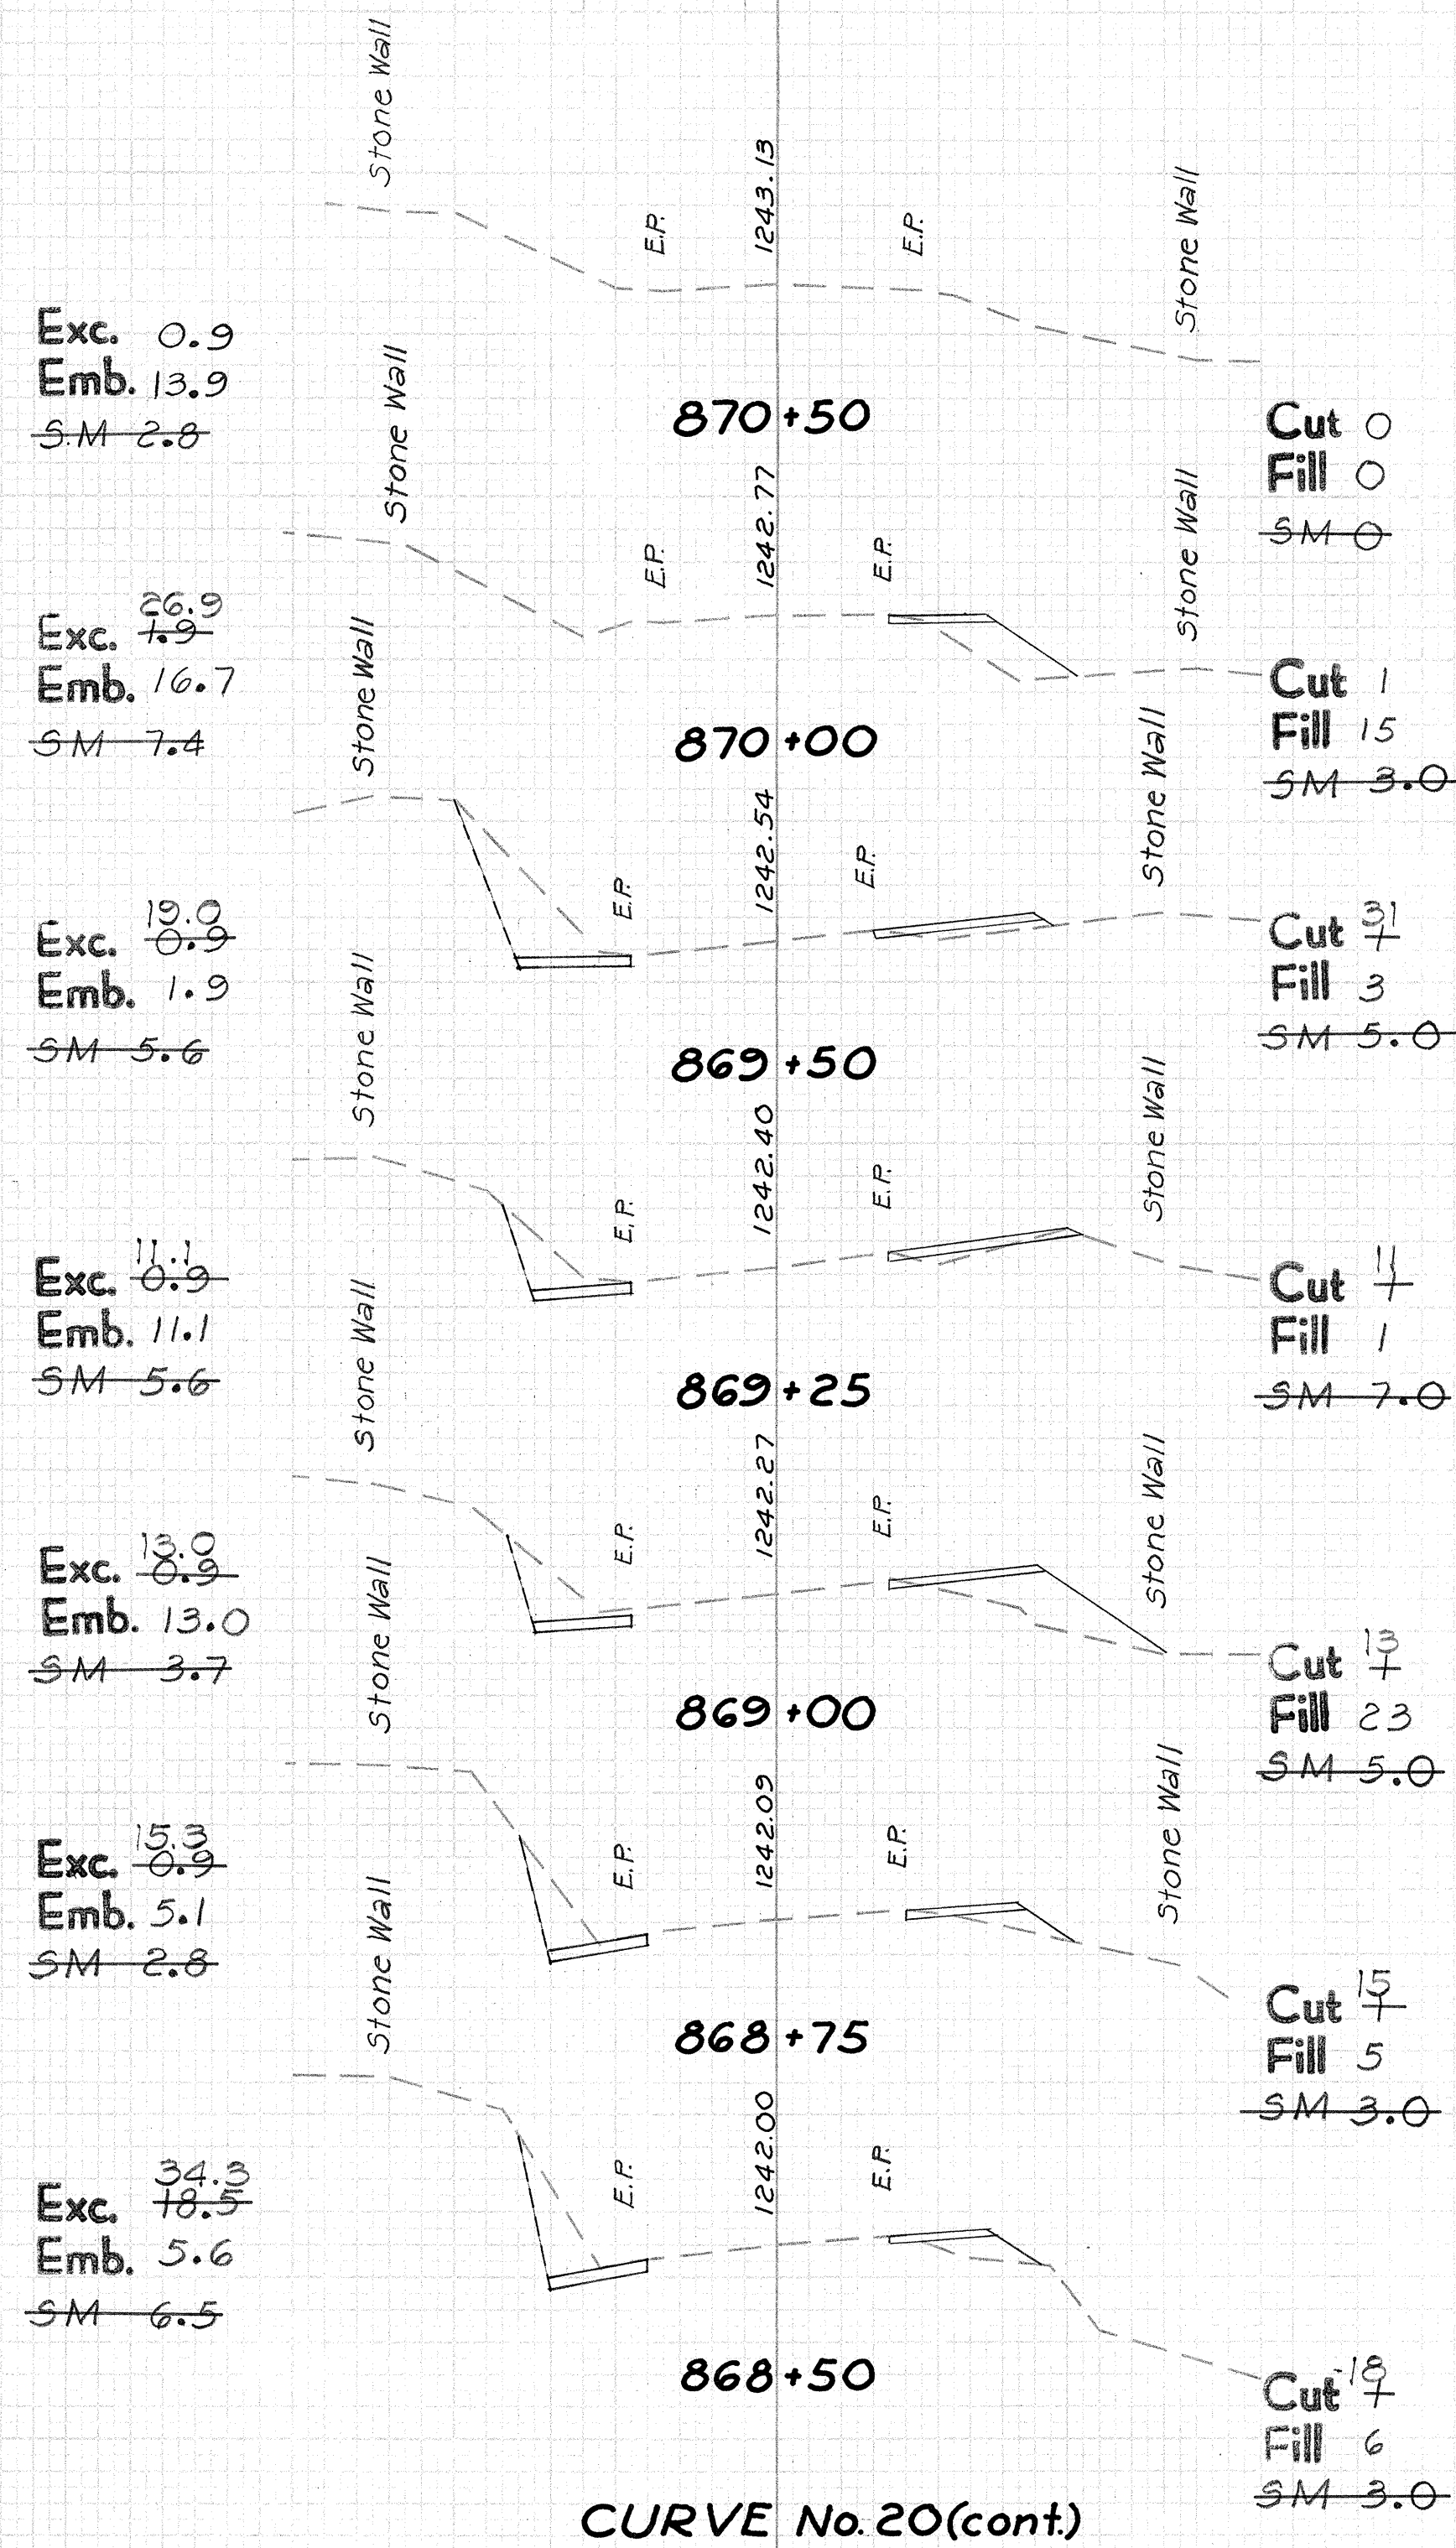

NOTE: SM = Aggregate Subbase



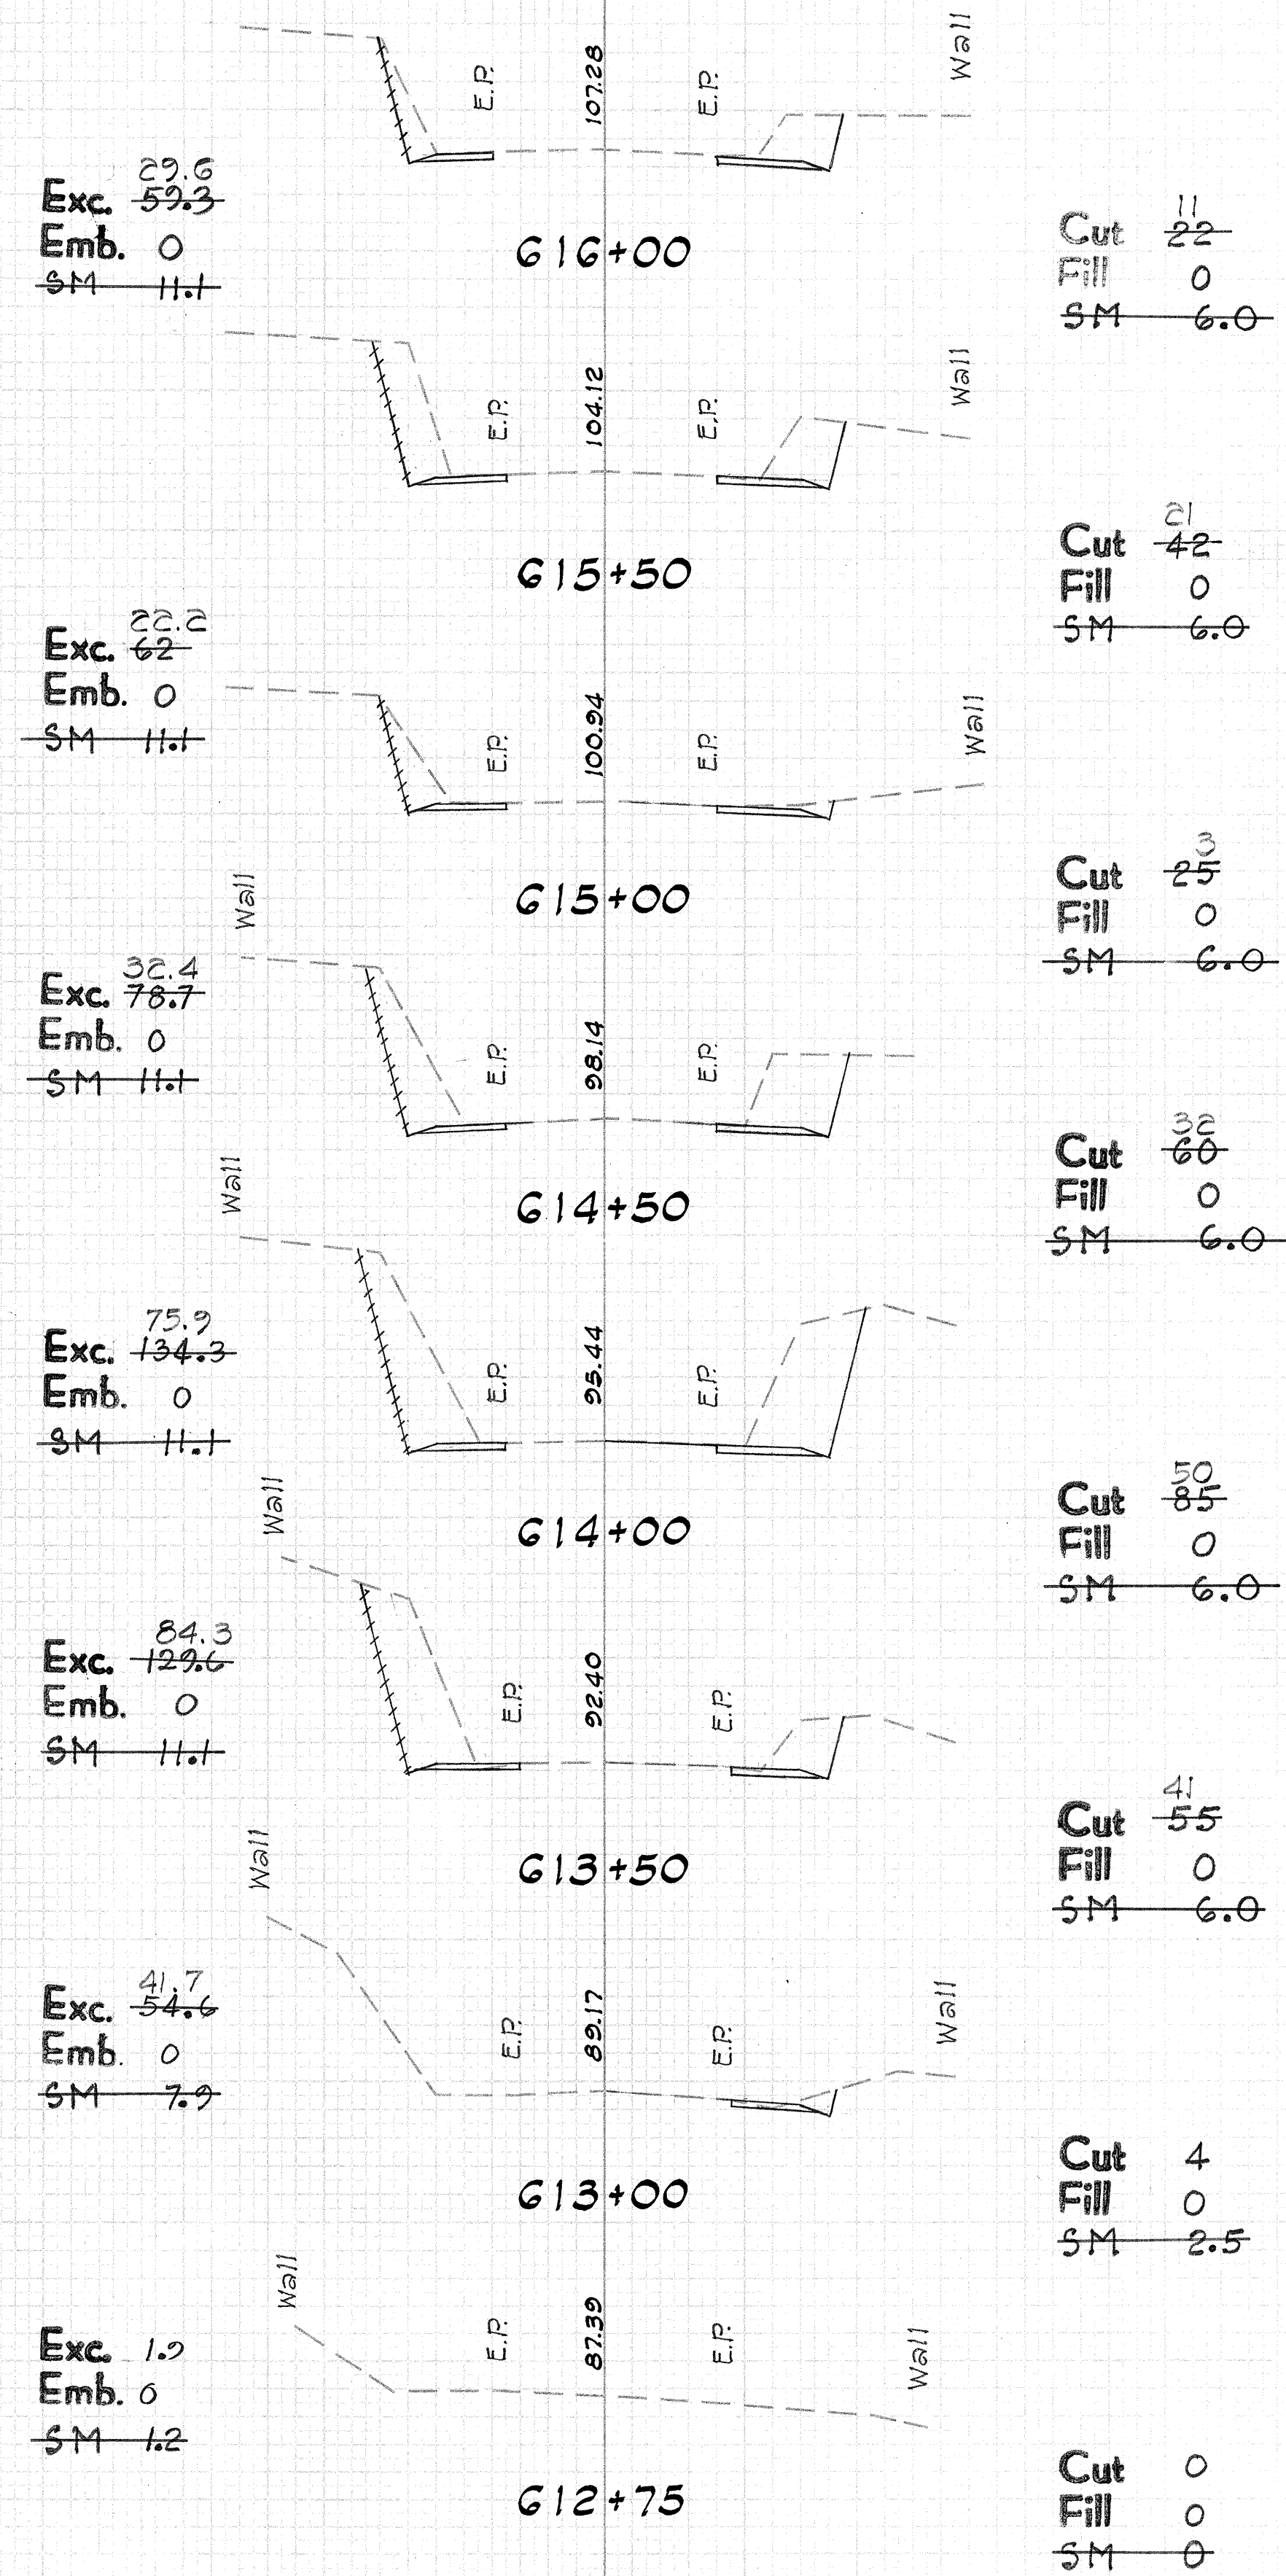


CURVE No. 39
[N.I.C.]

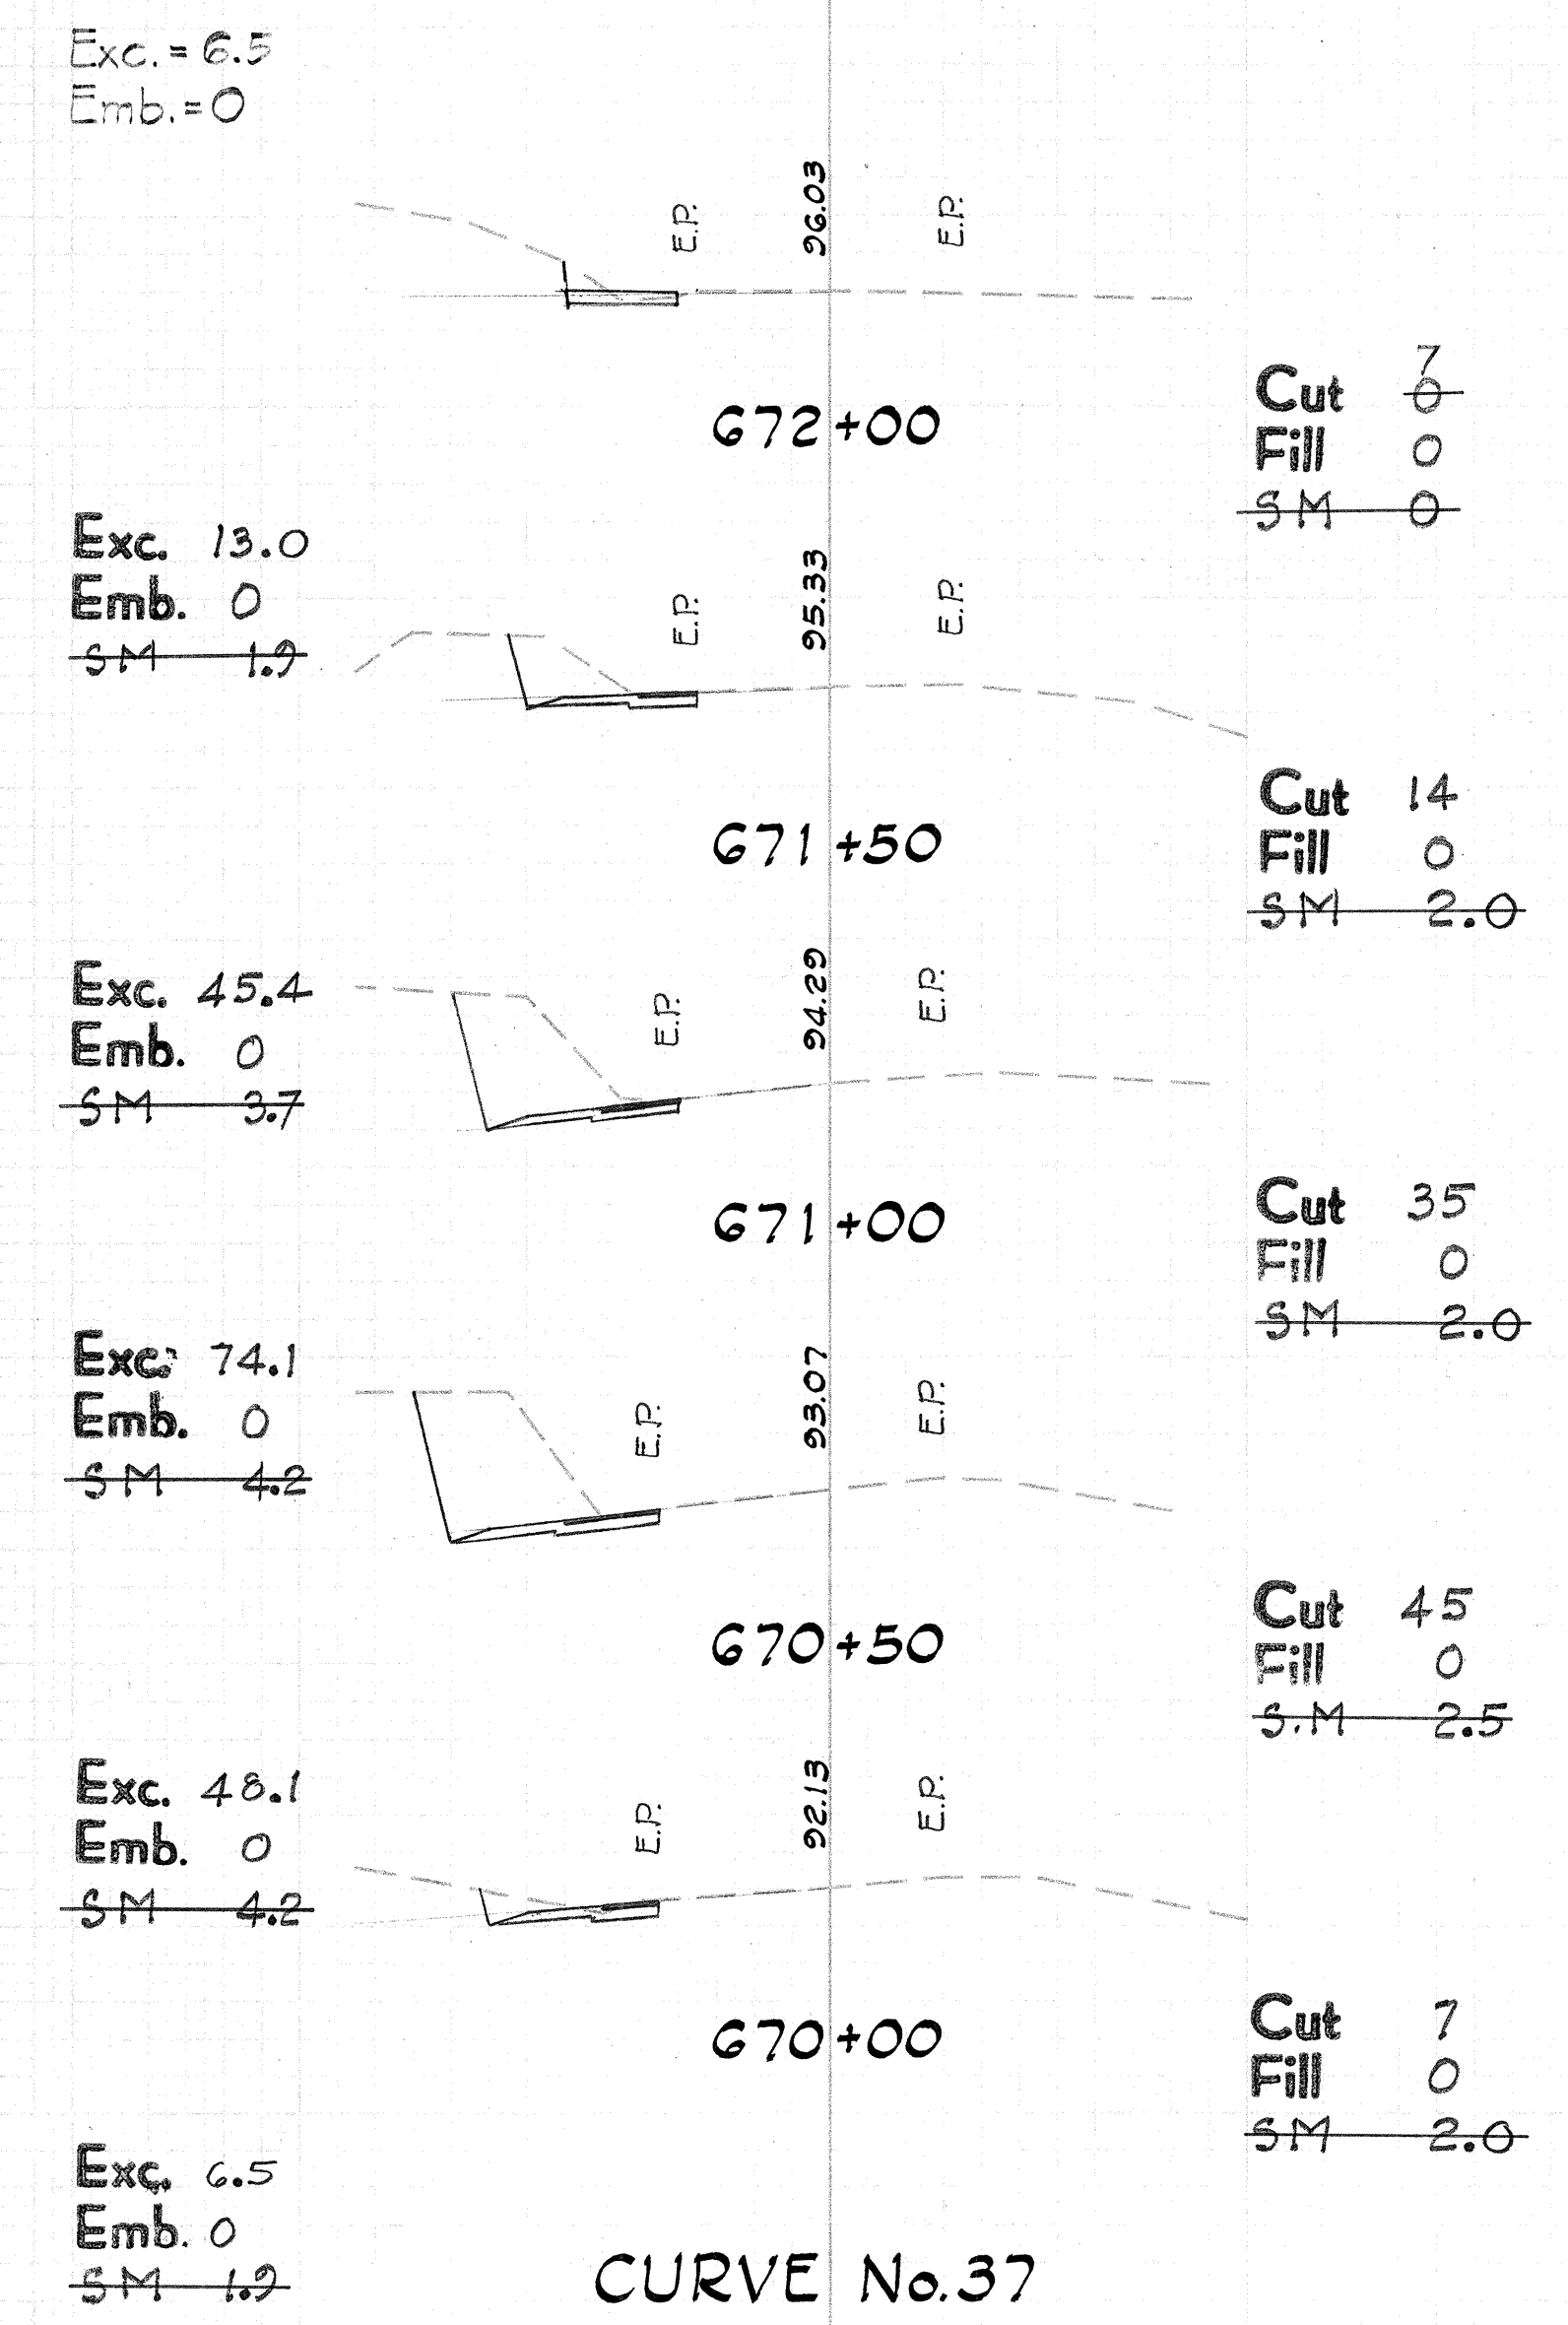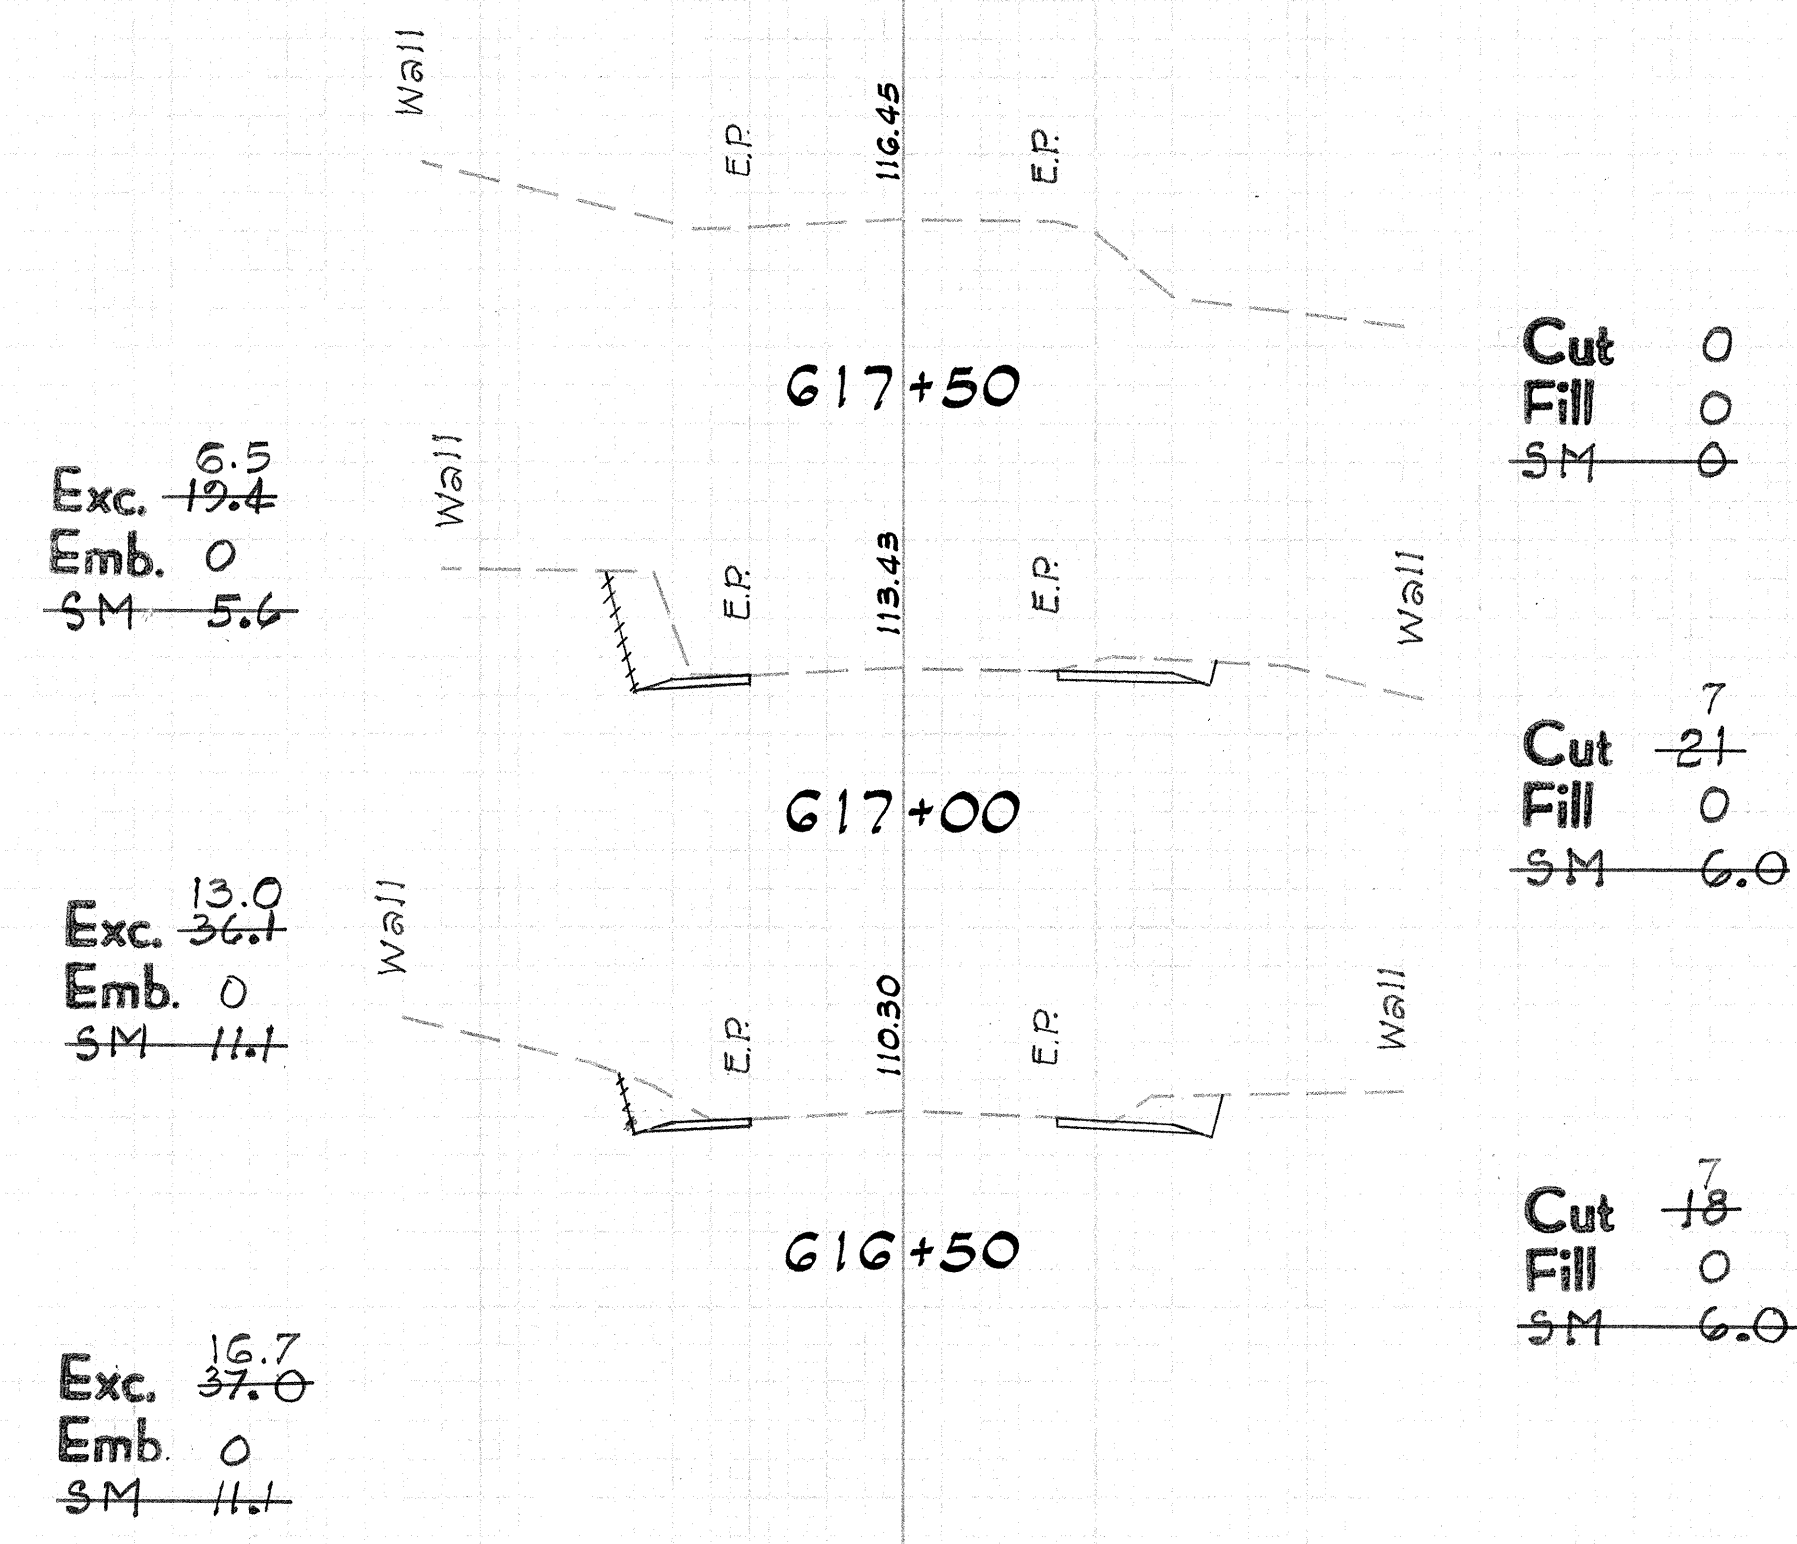


CURVE No. 37


NOTE: SM = Aggregate Subbase

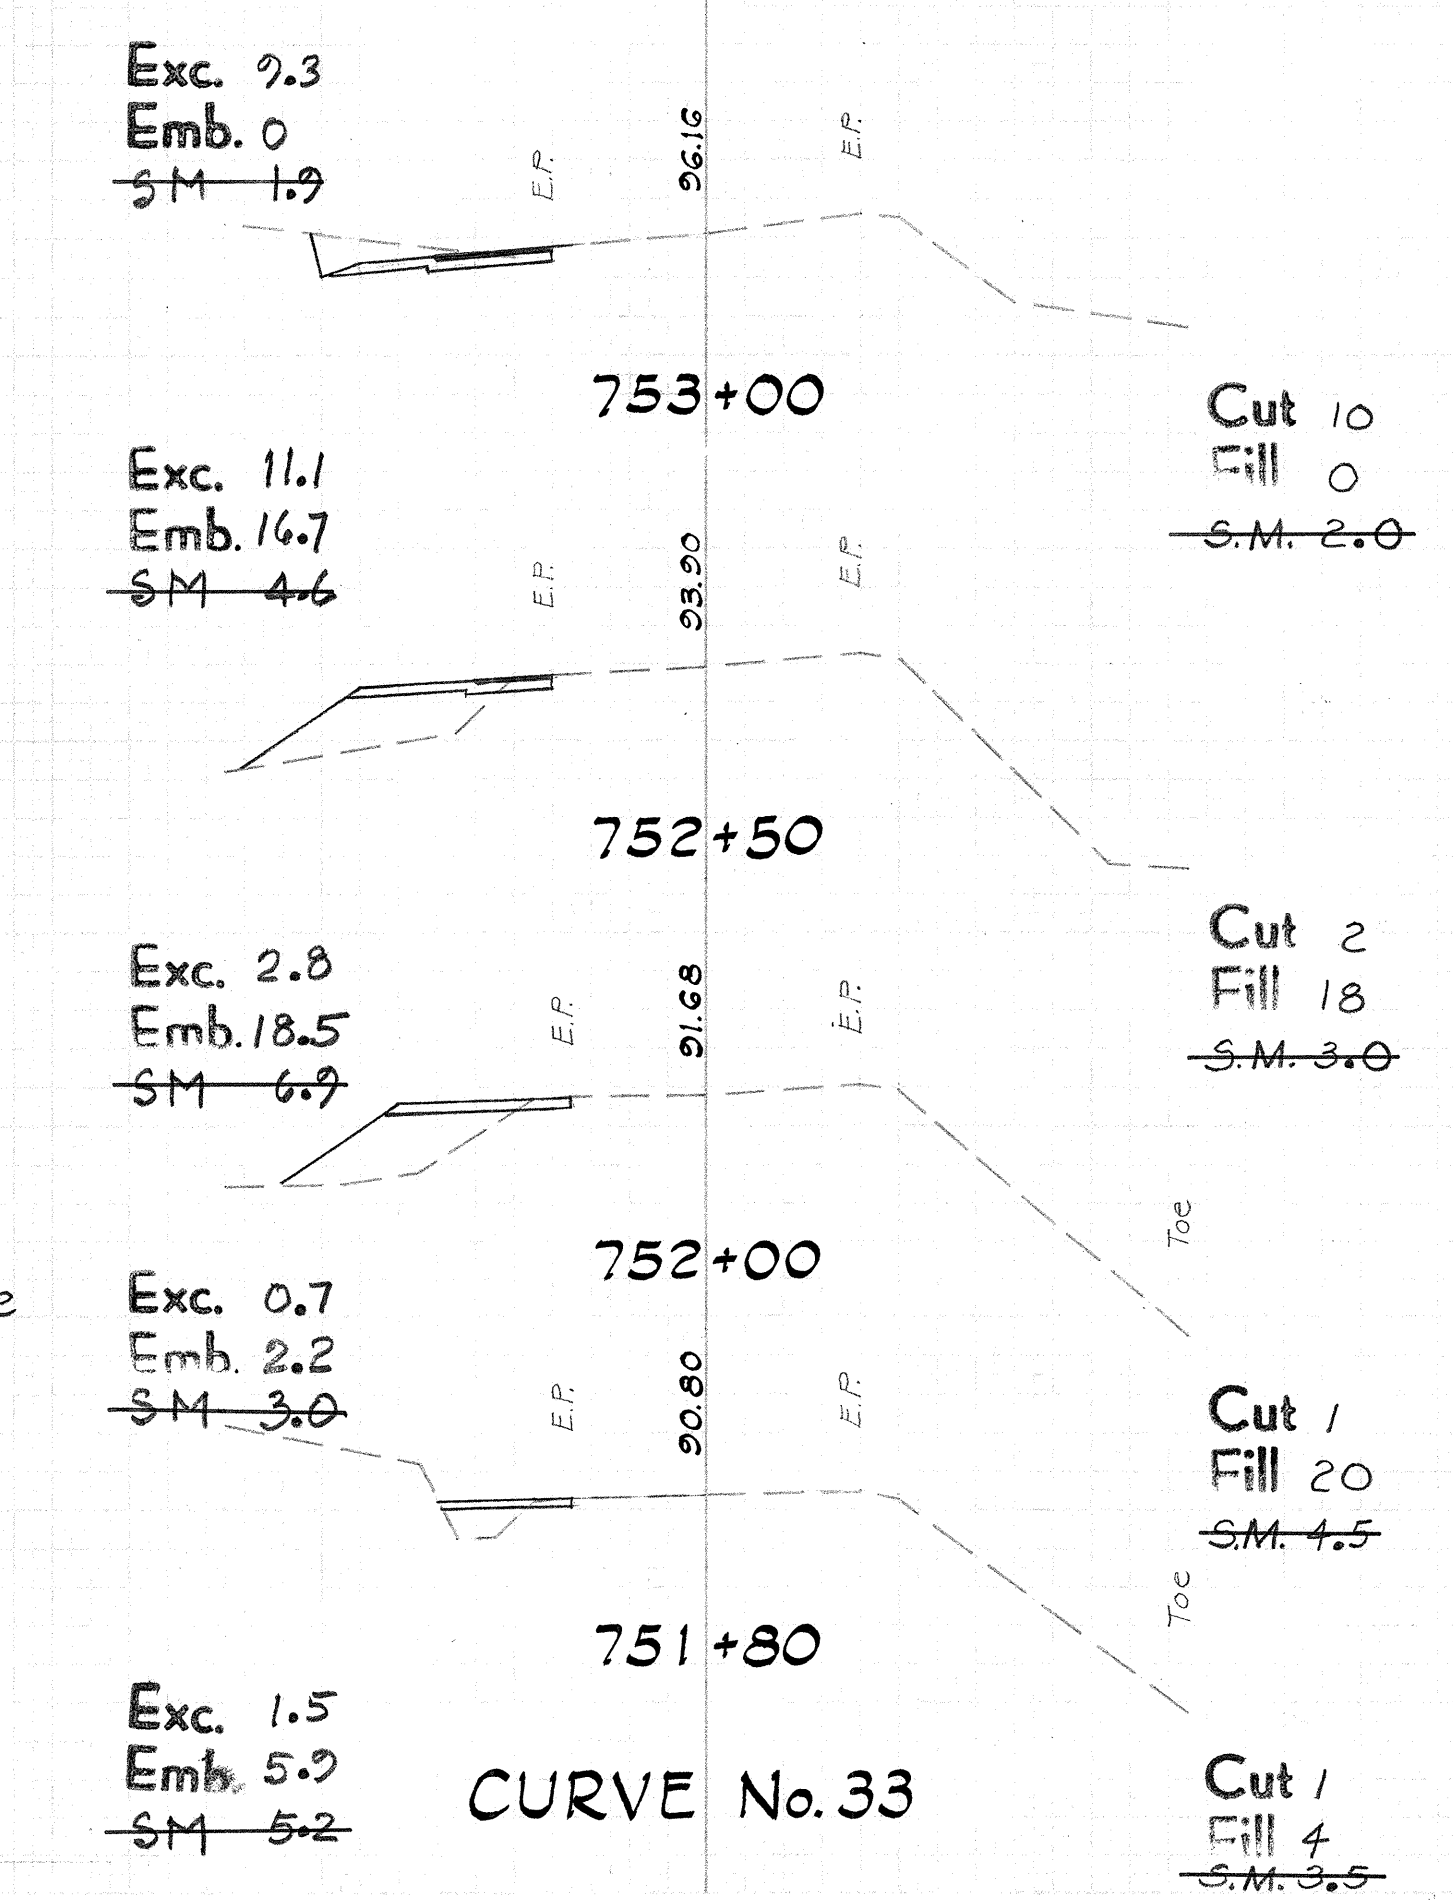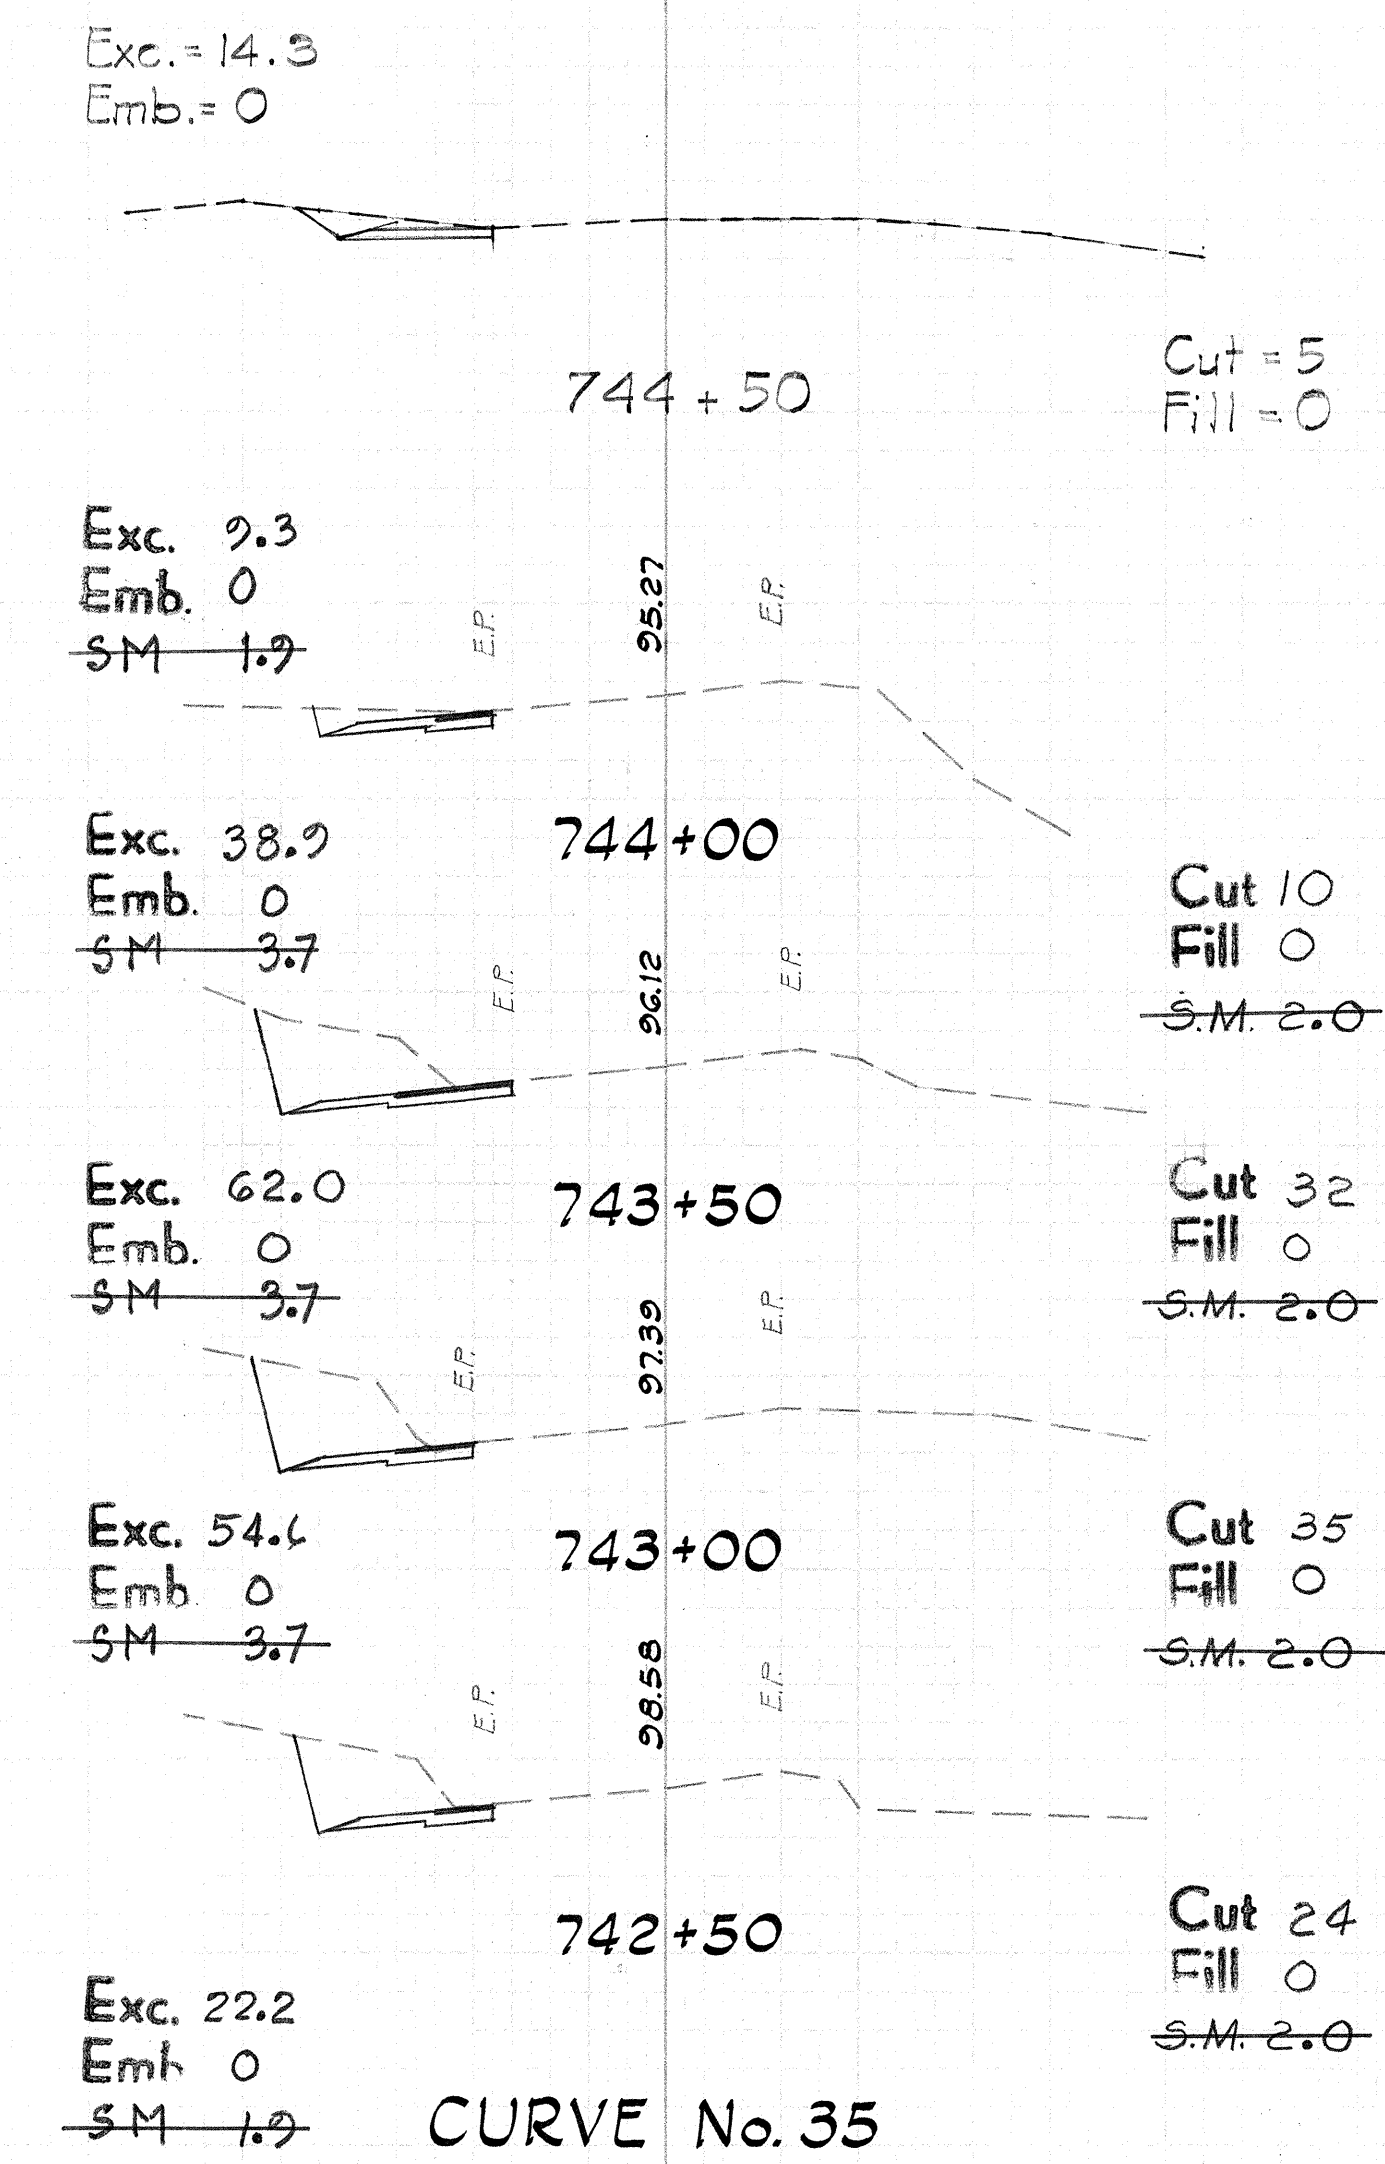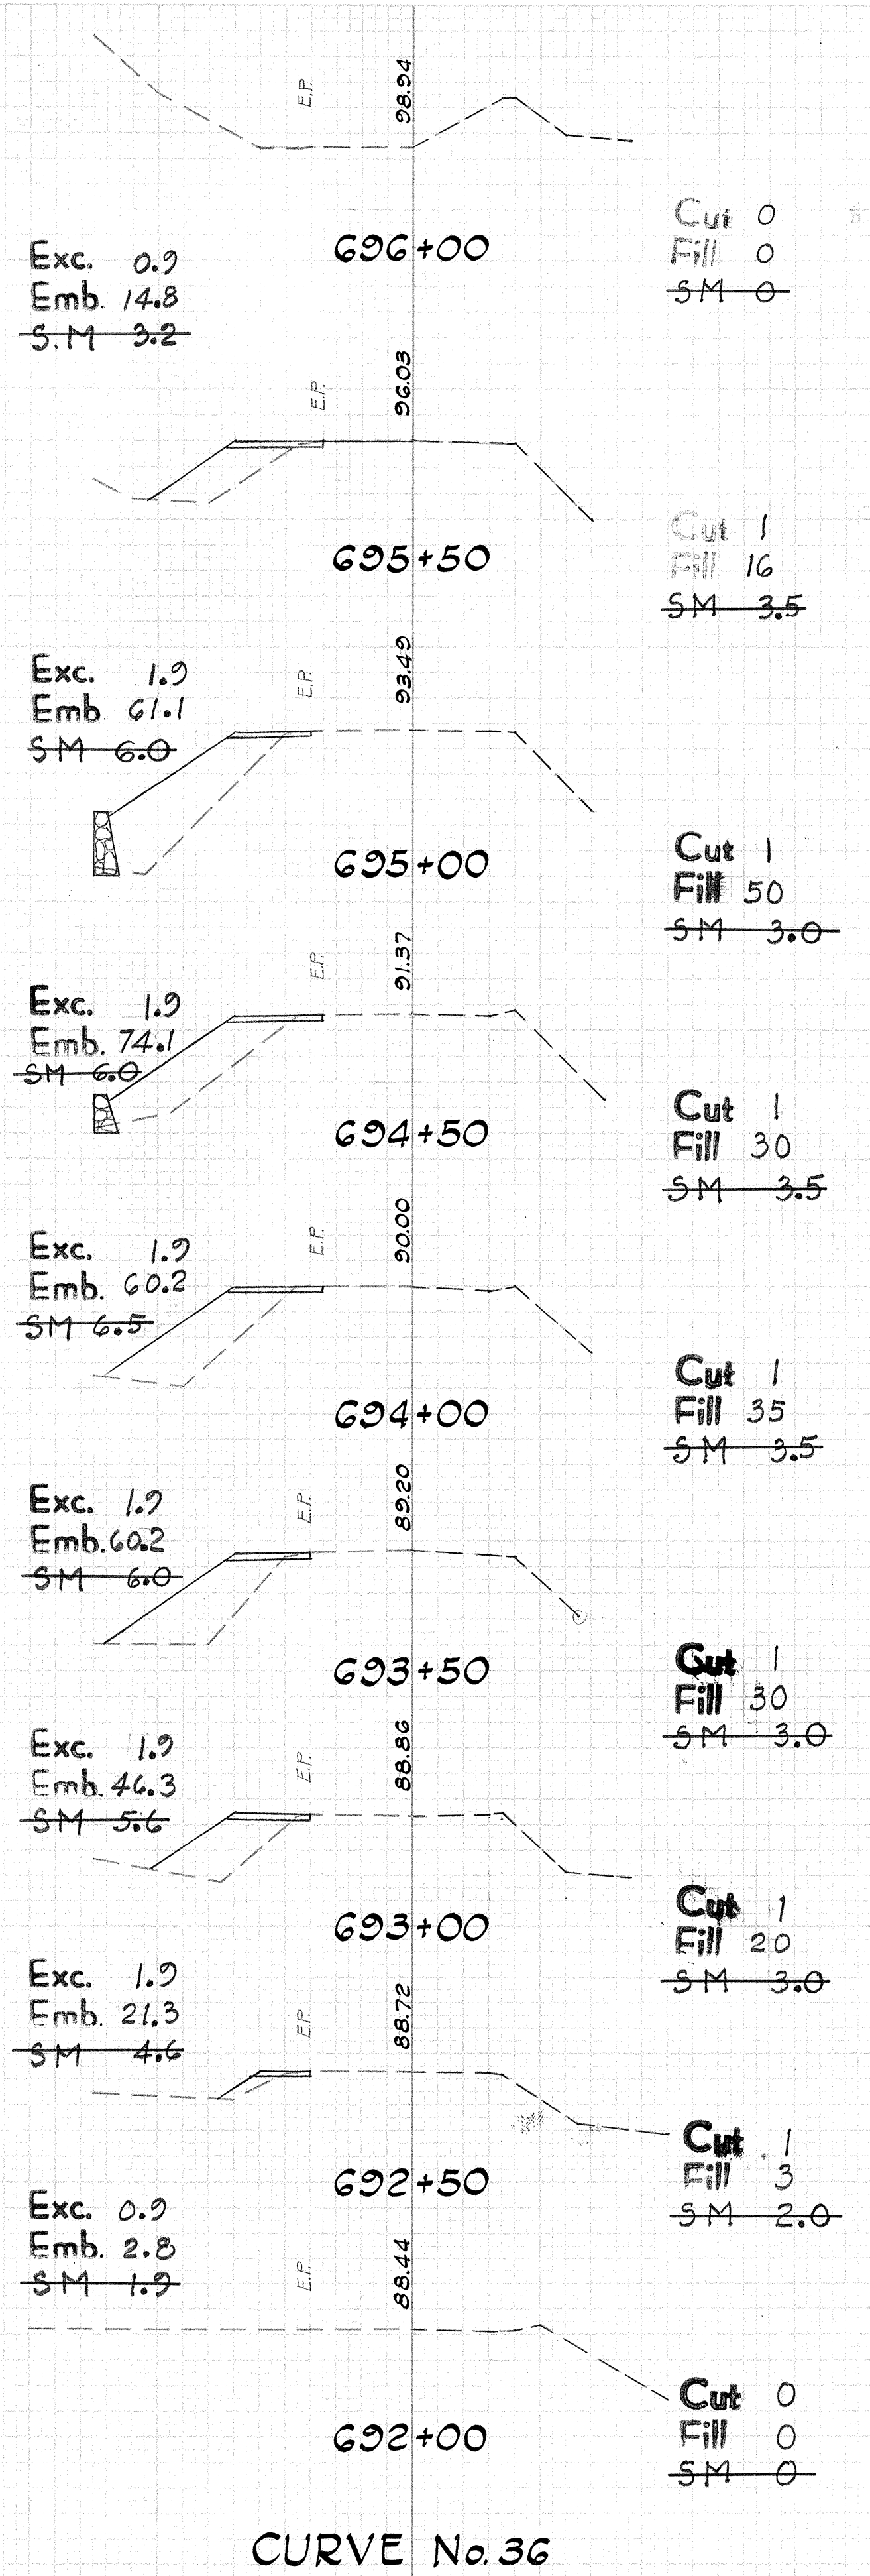


NOTE: SM = Aggregate Subbase

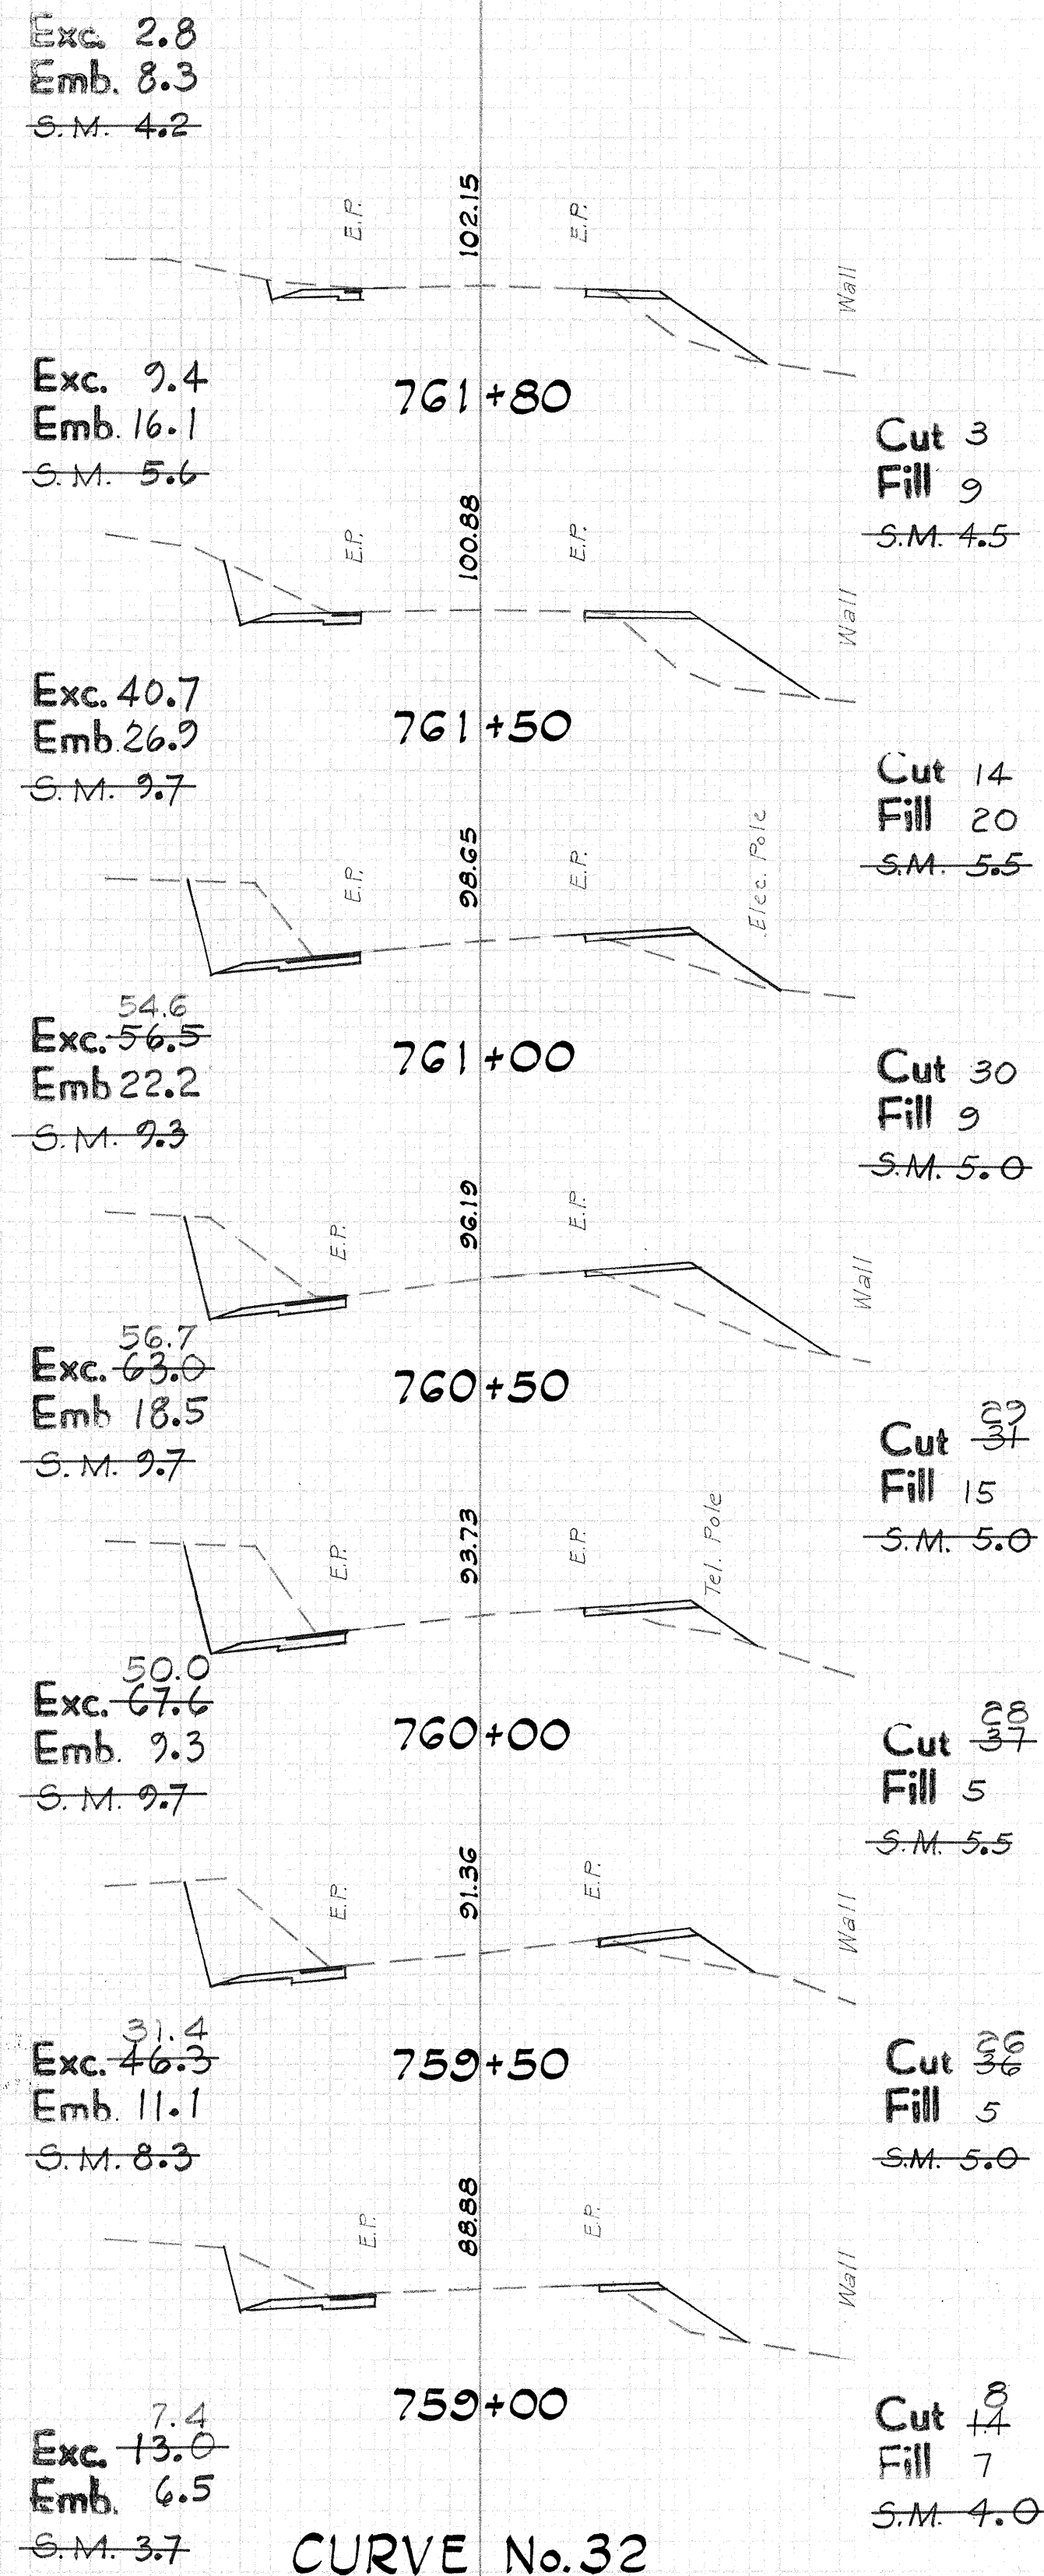

CURVE No.32



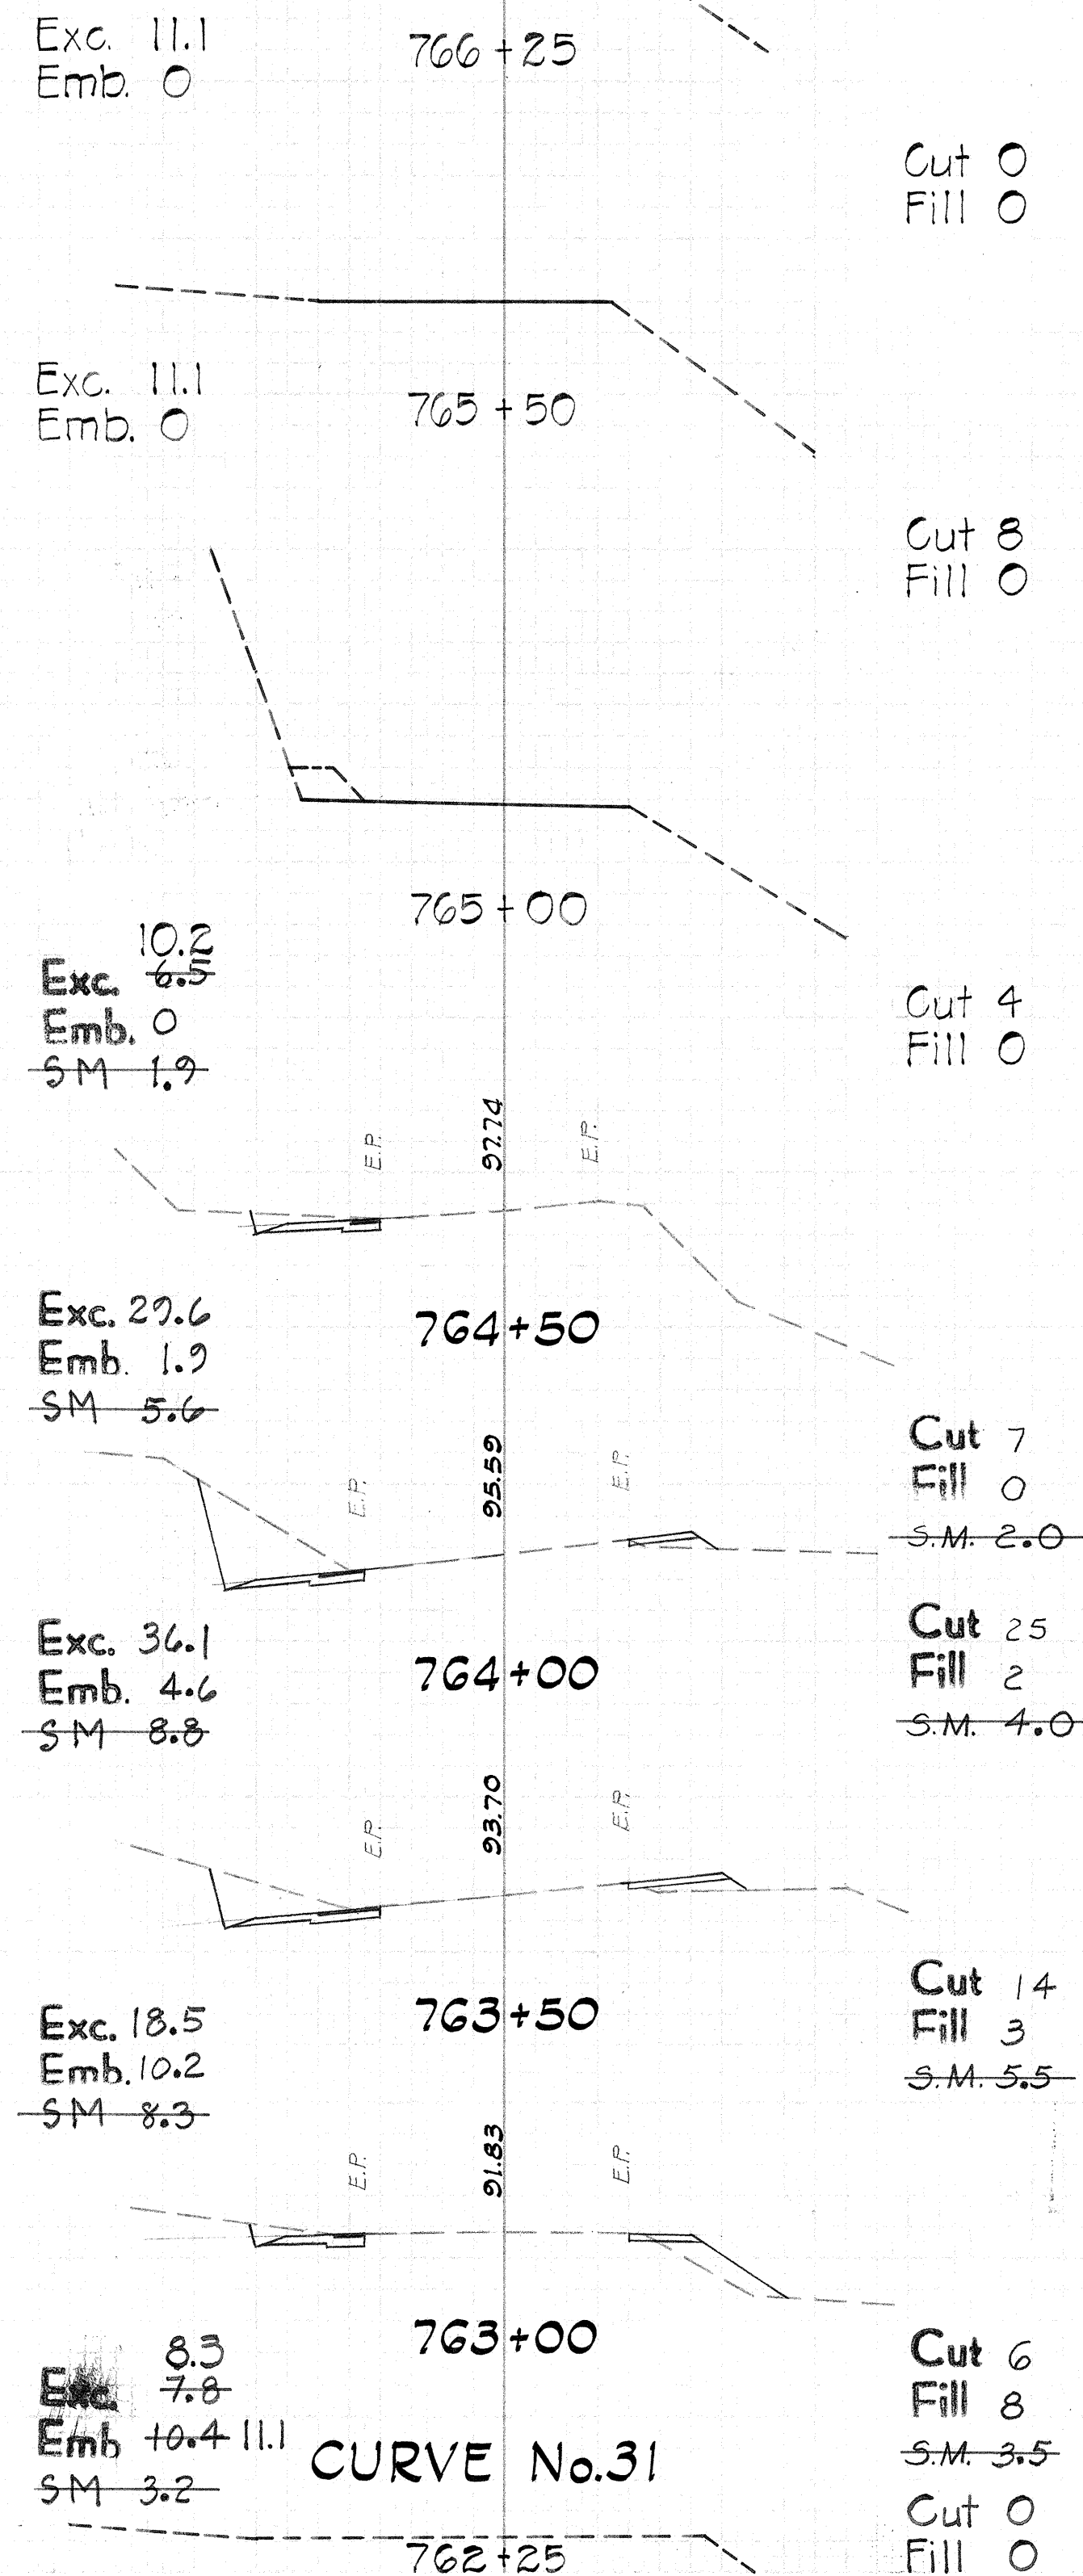





CURVE No.31

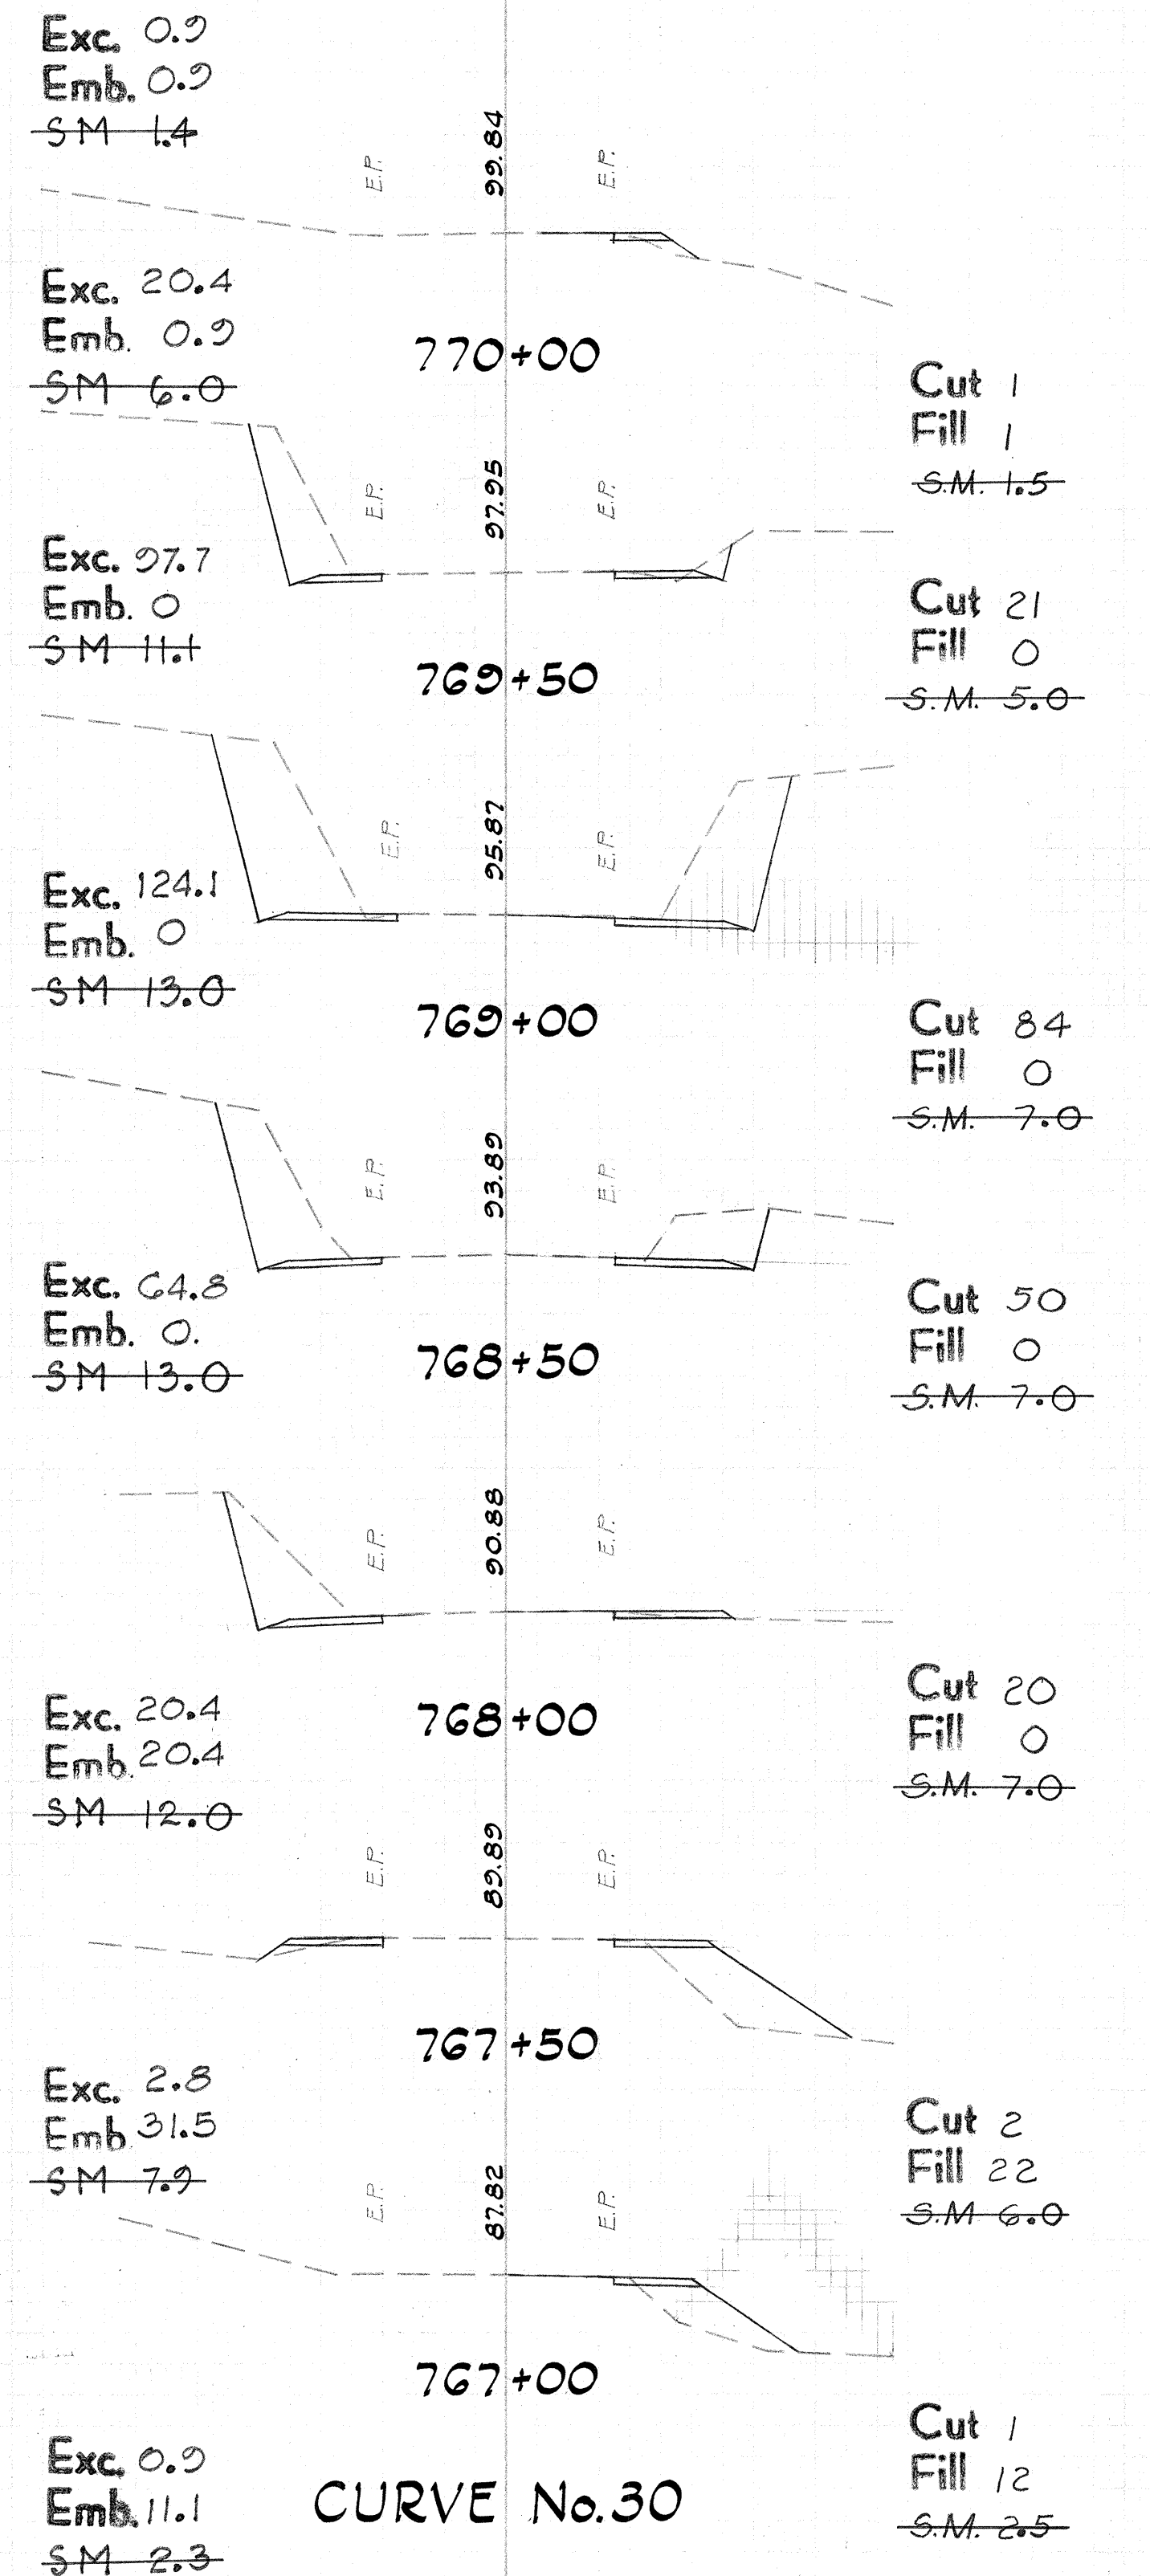

CURVE No.30

FINAL
SURVEY
DATE
JULY 70
SHEET
1003

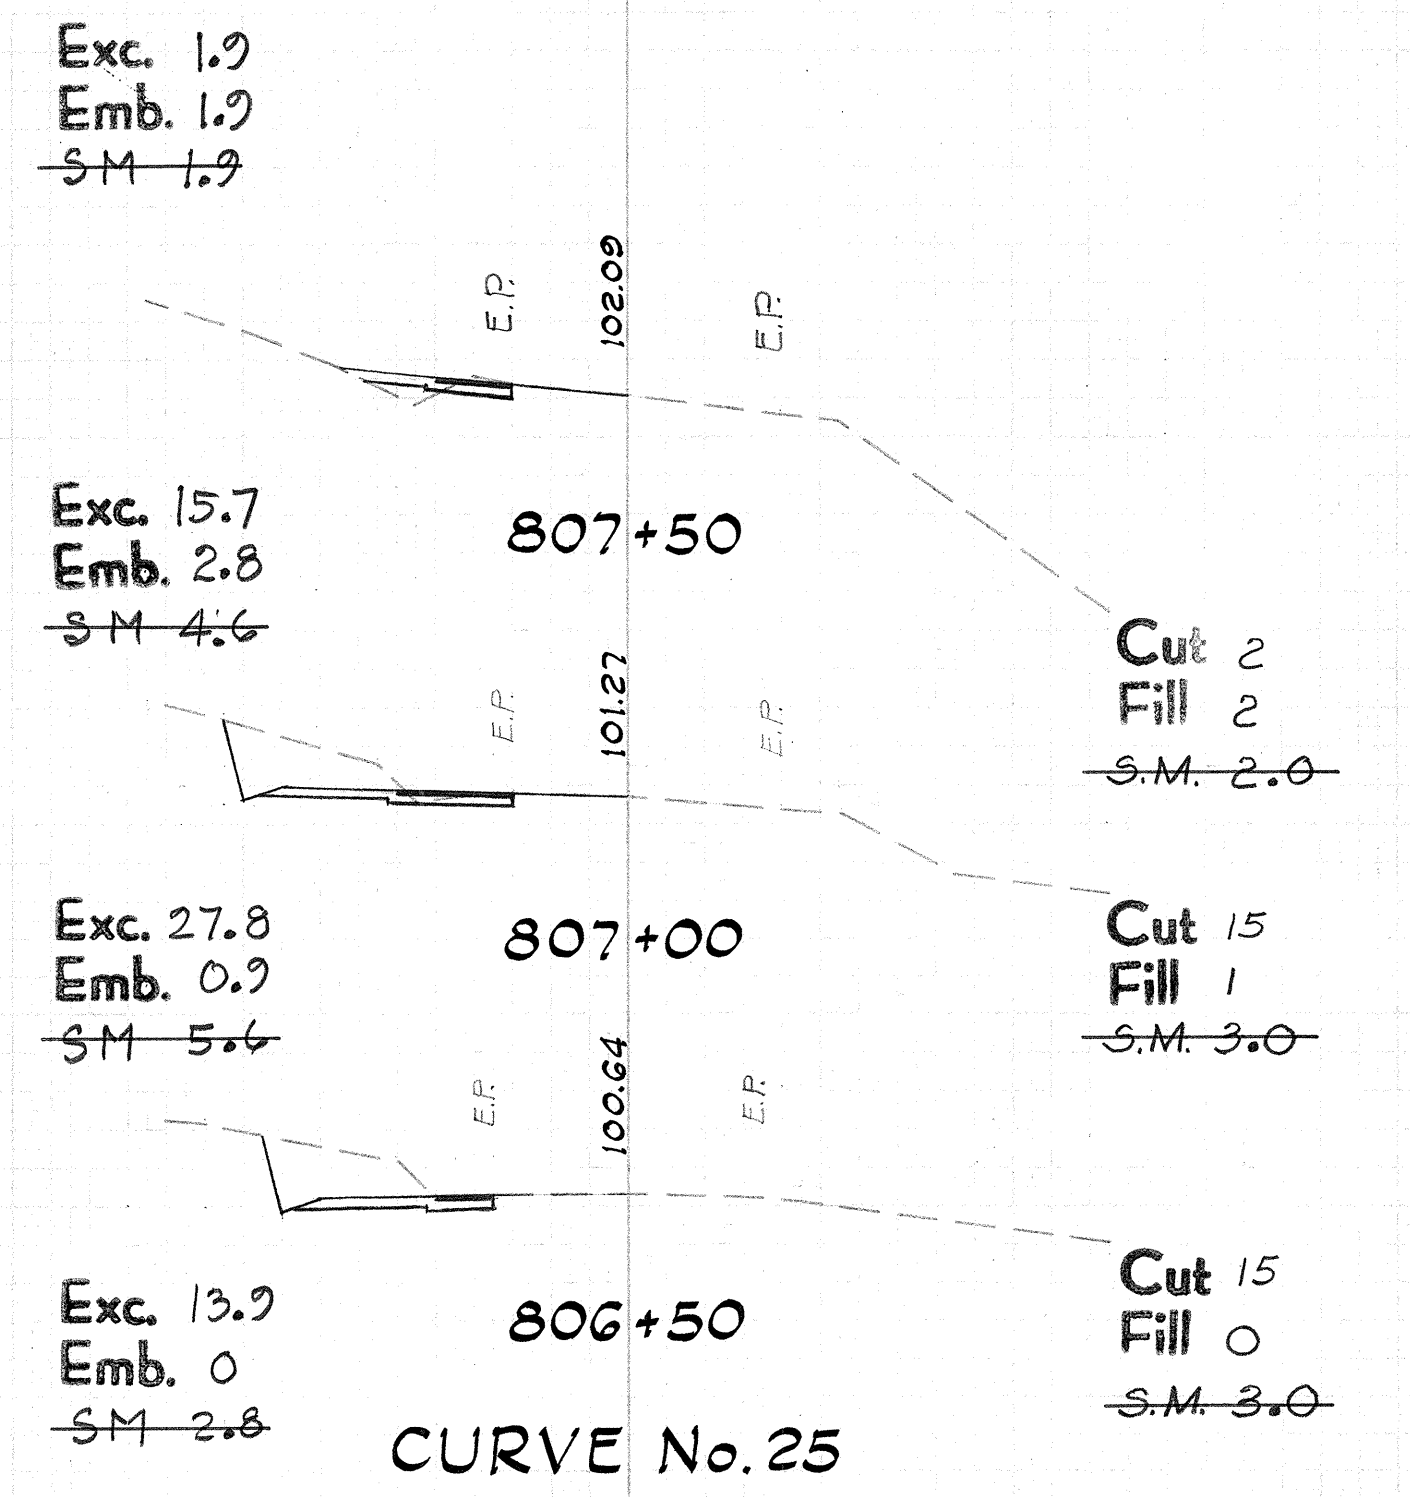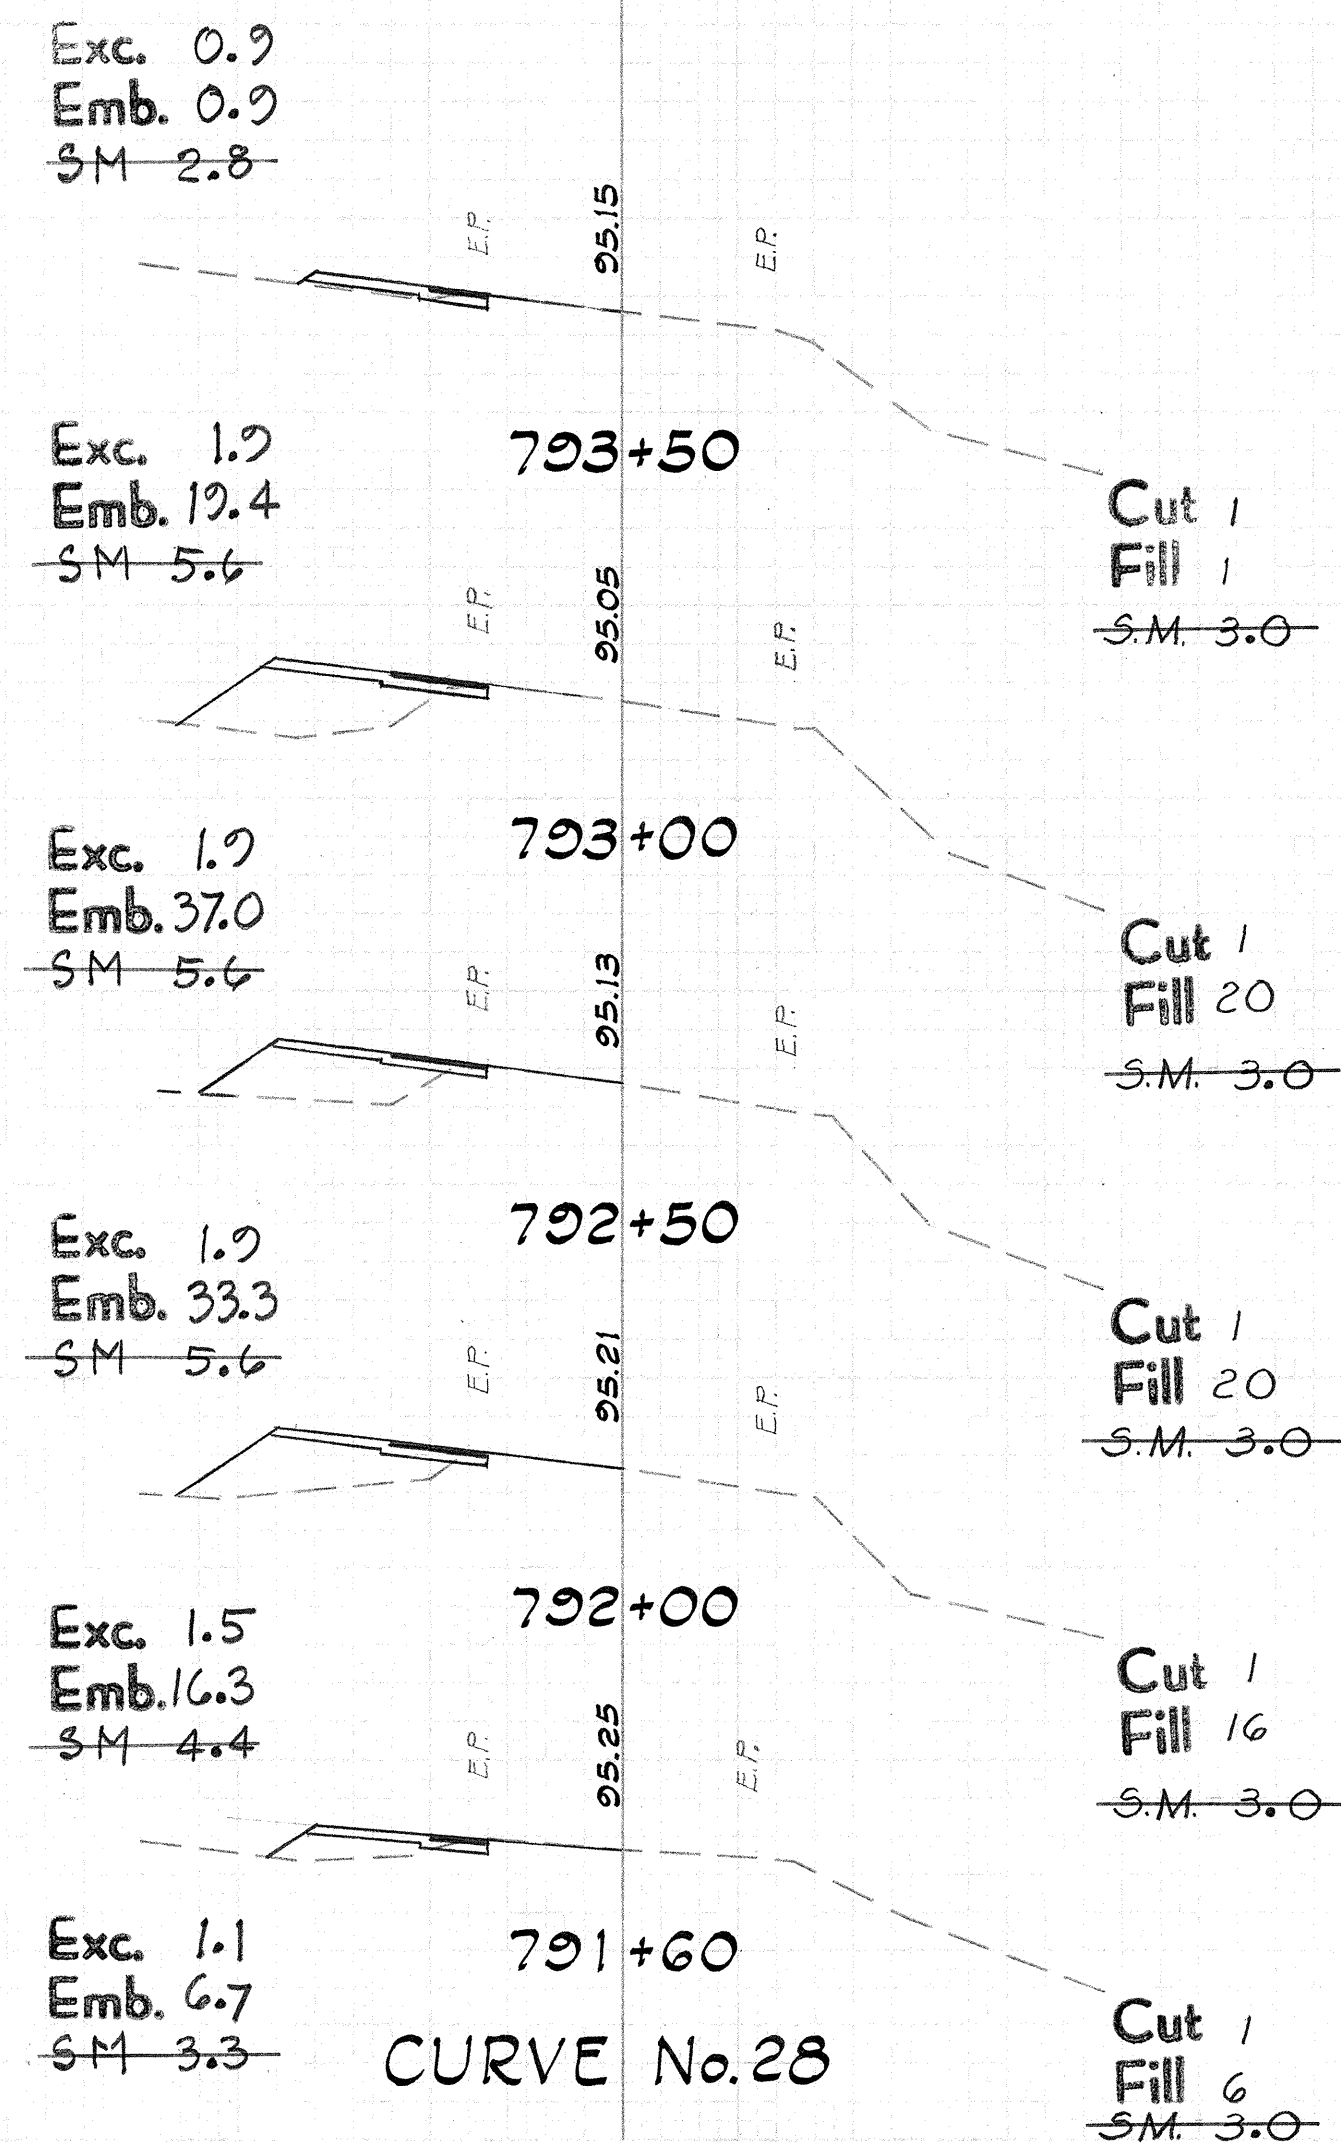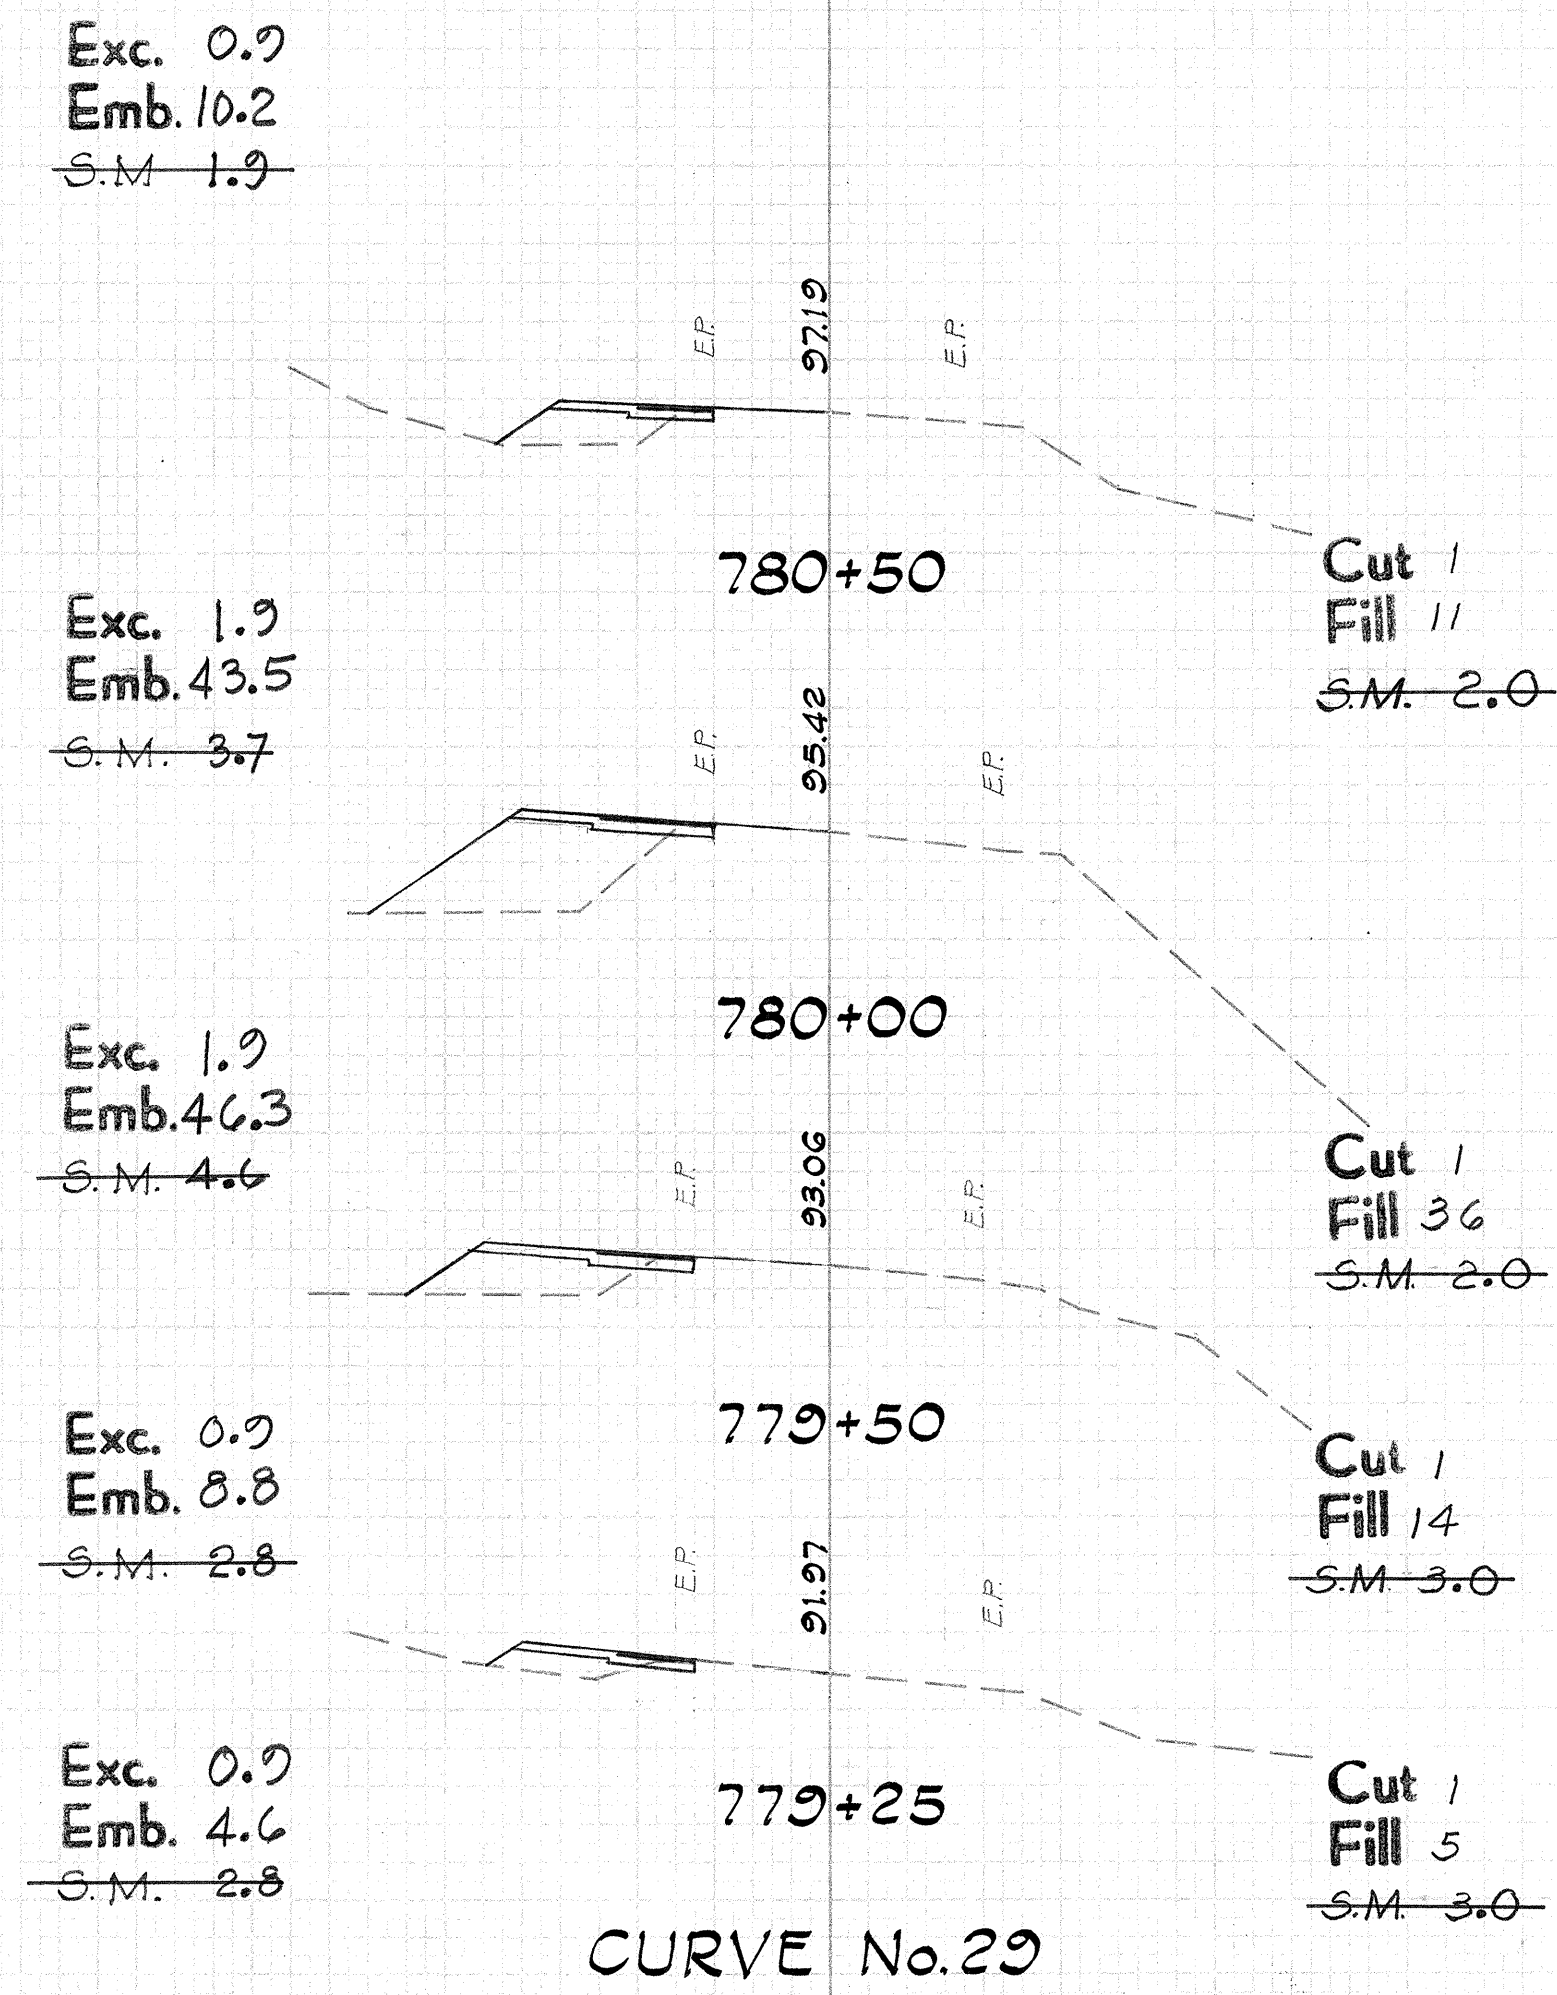

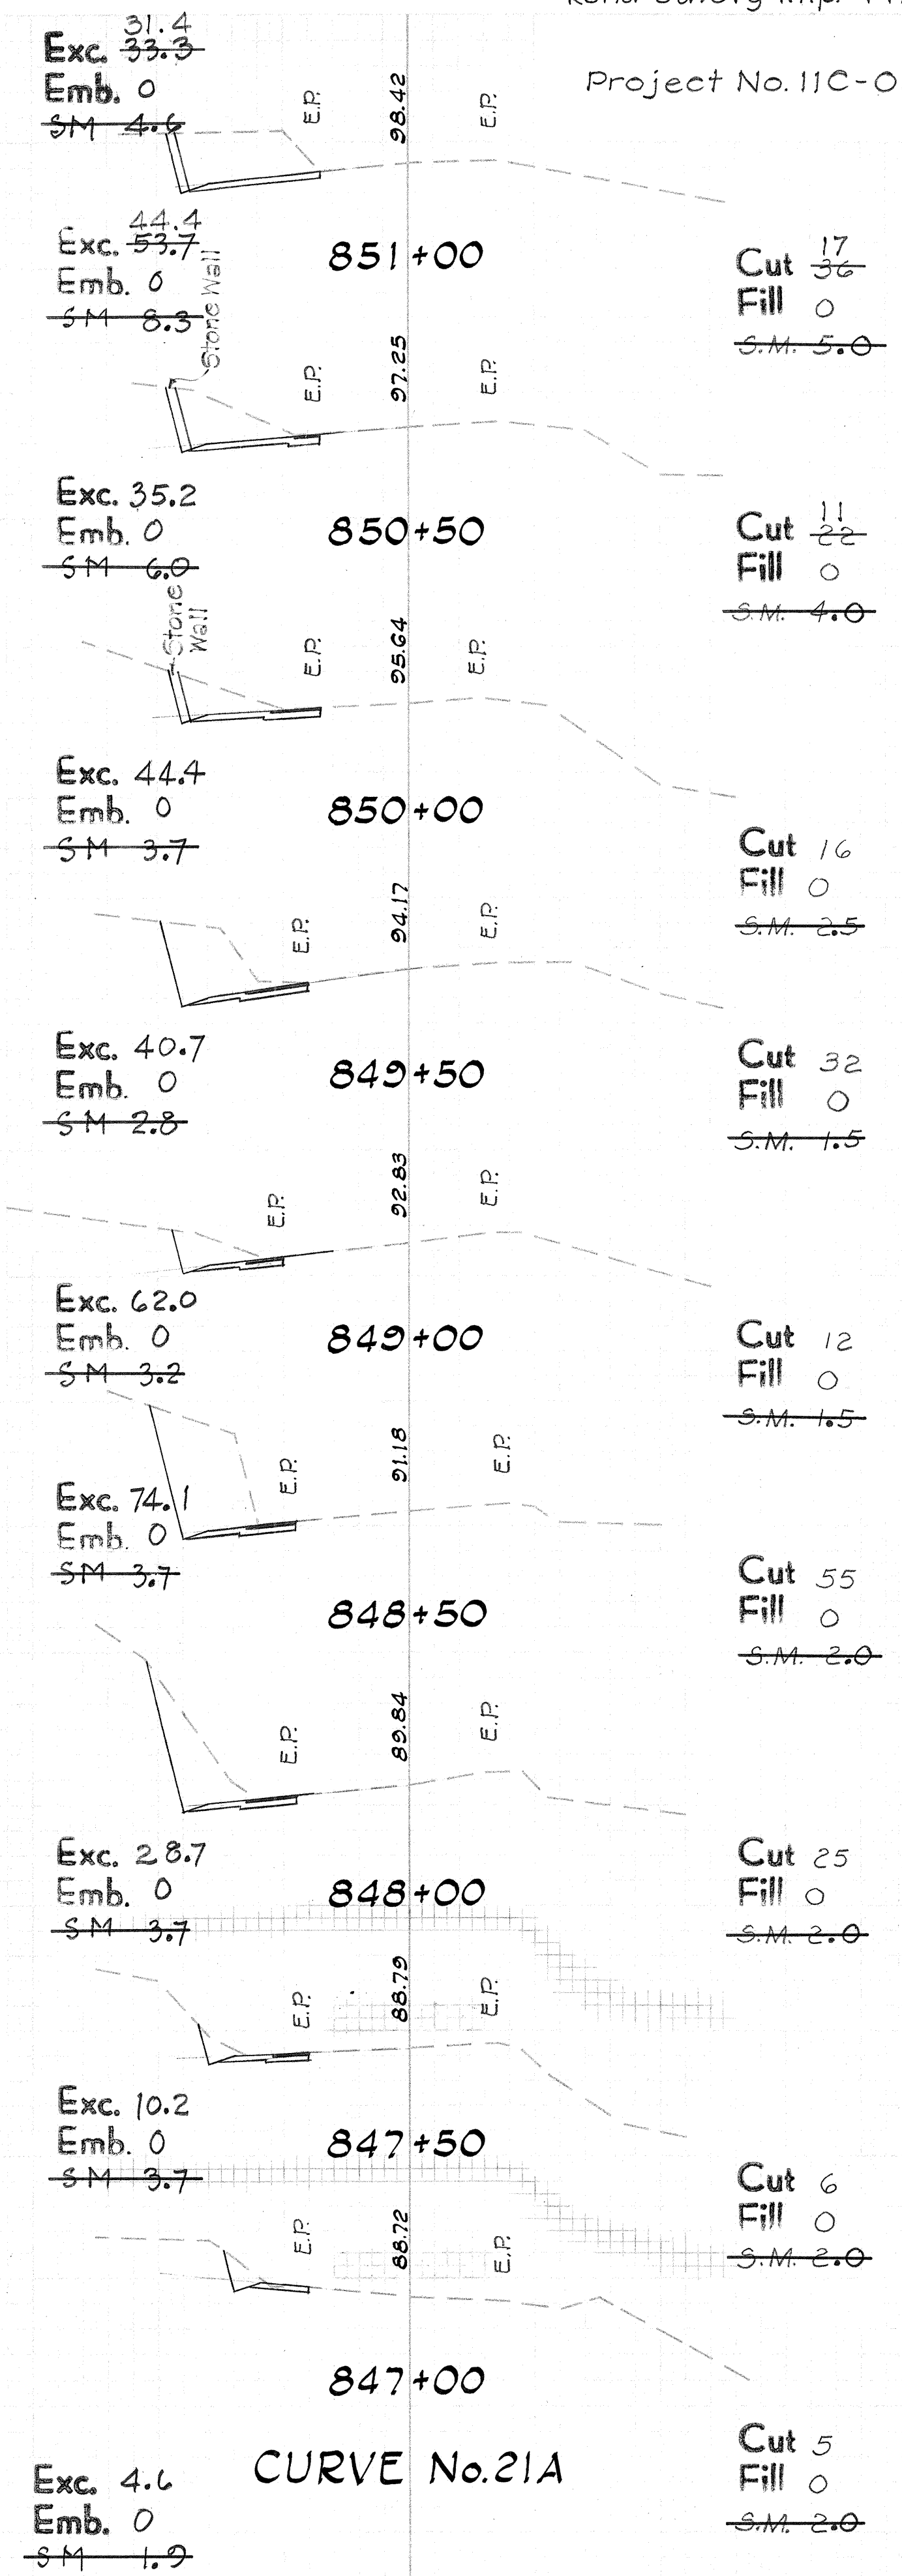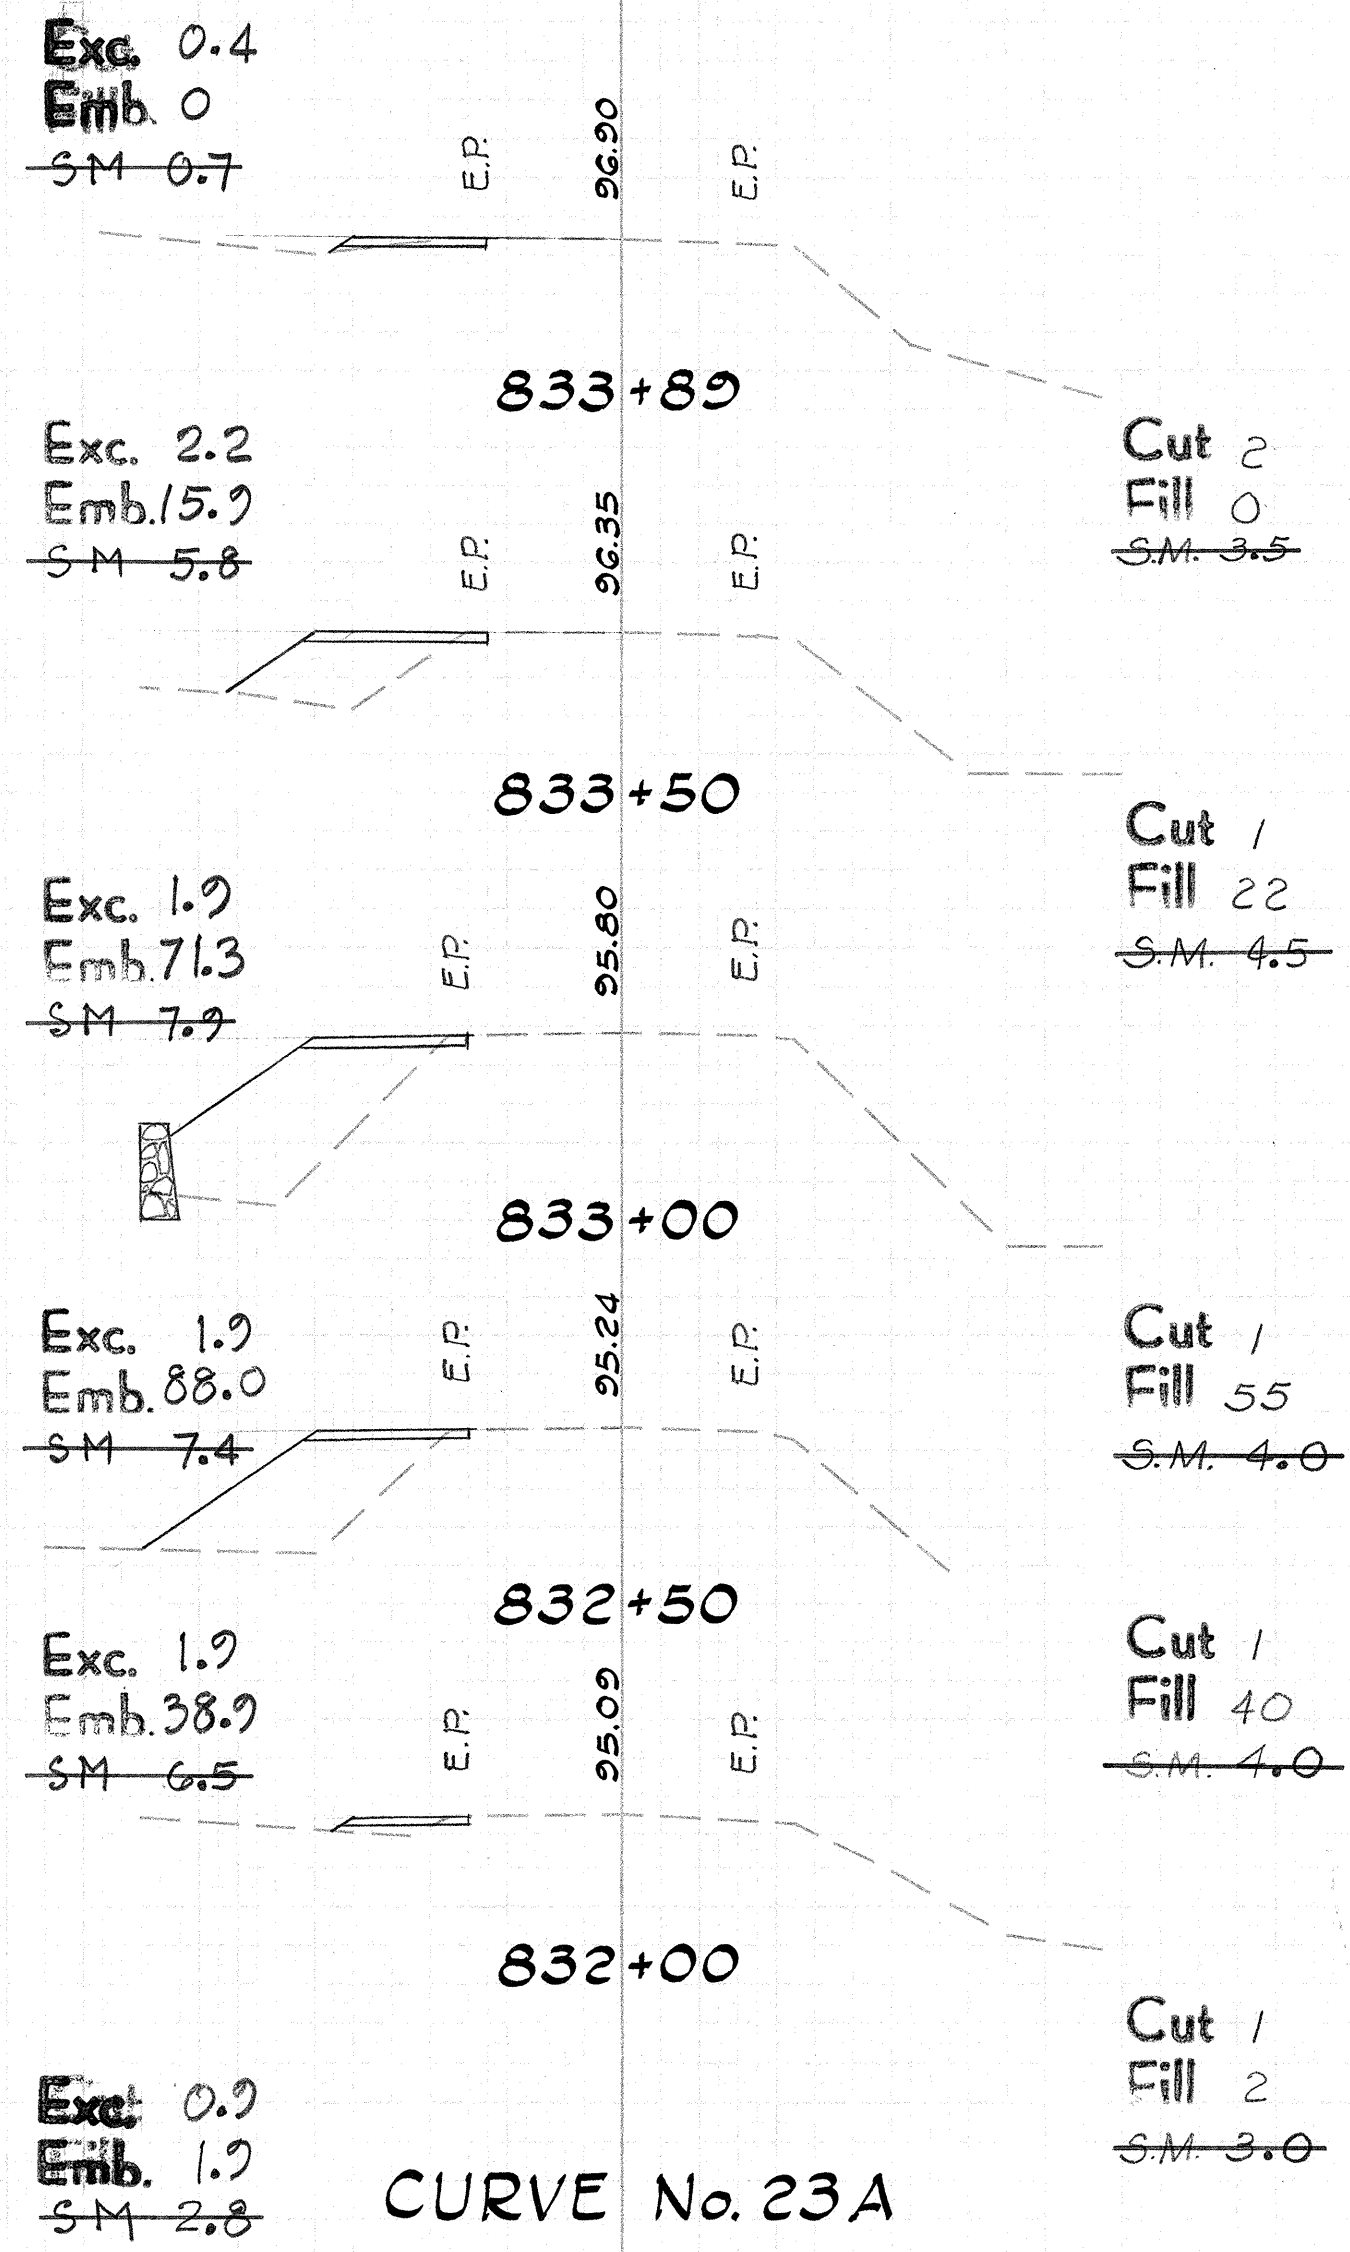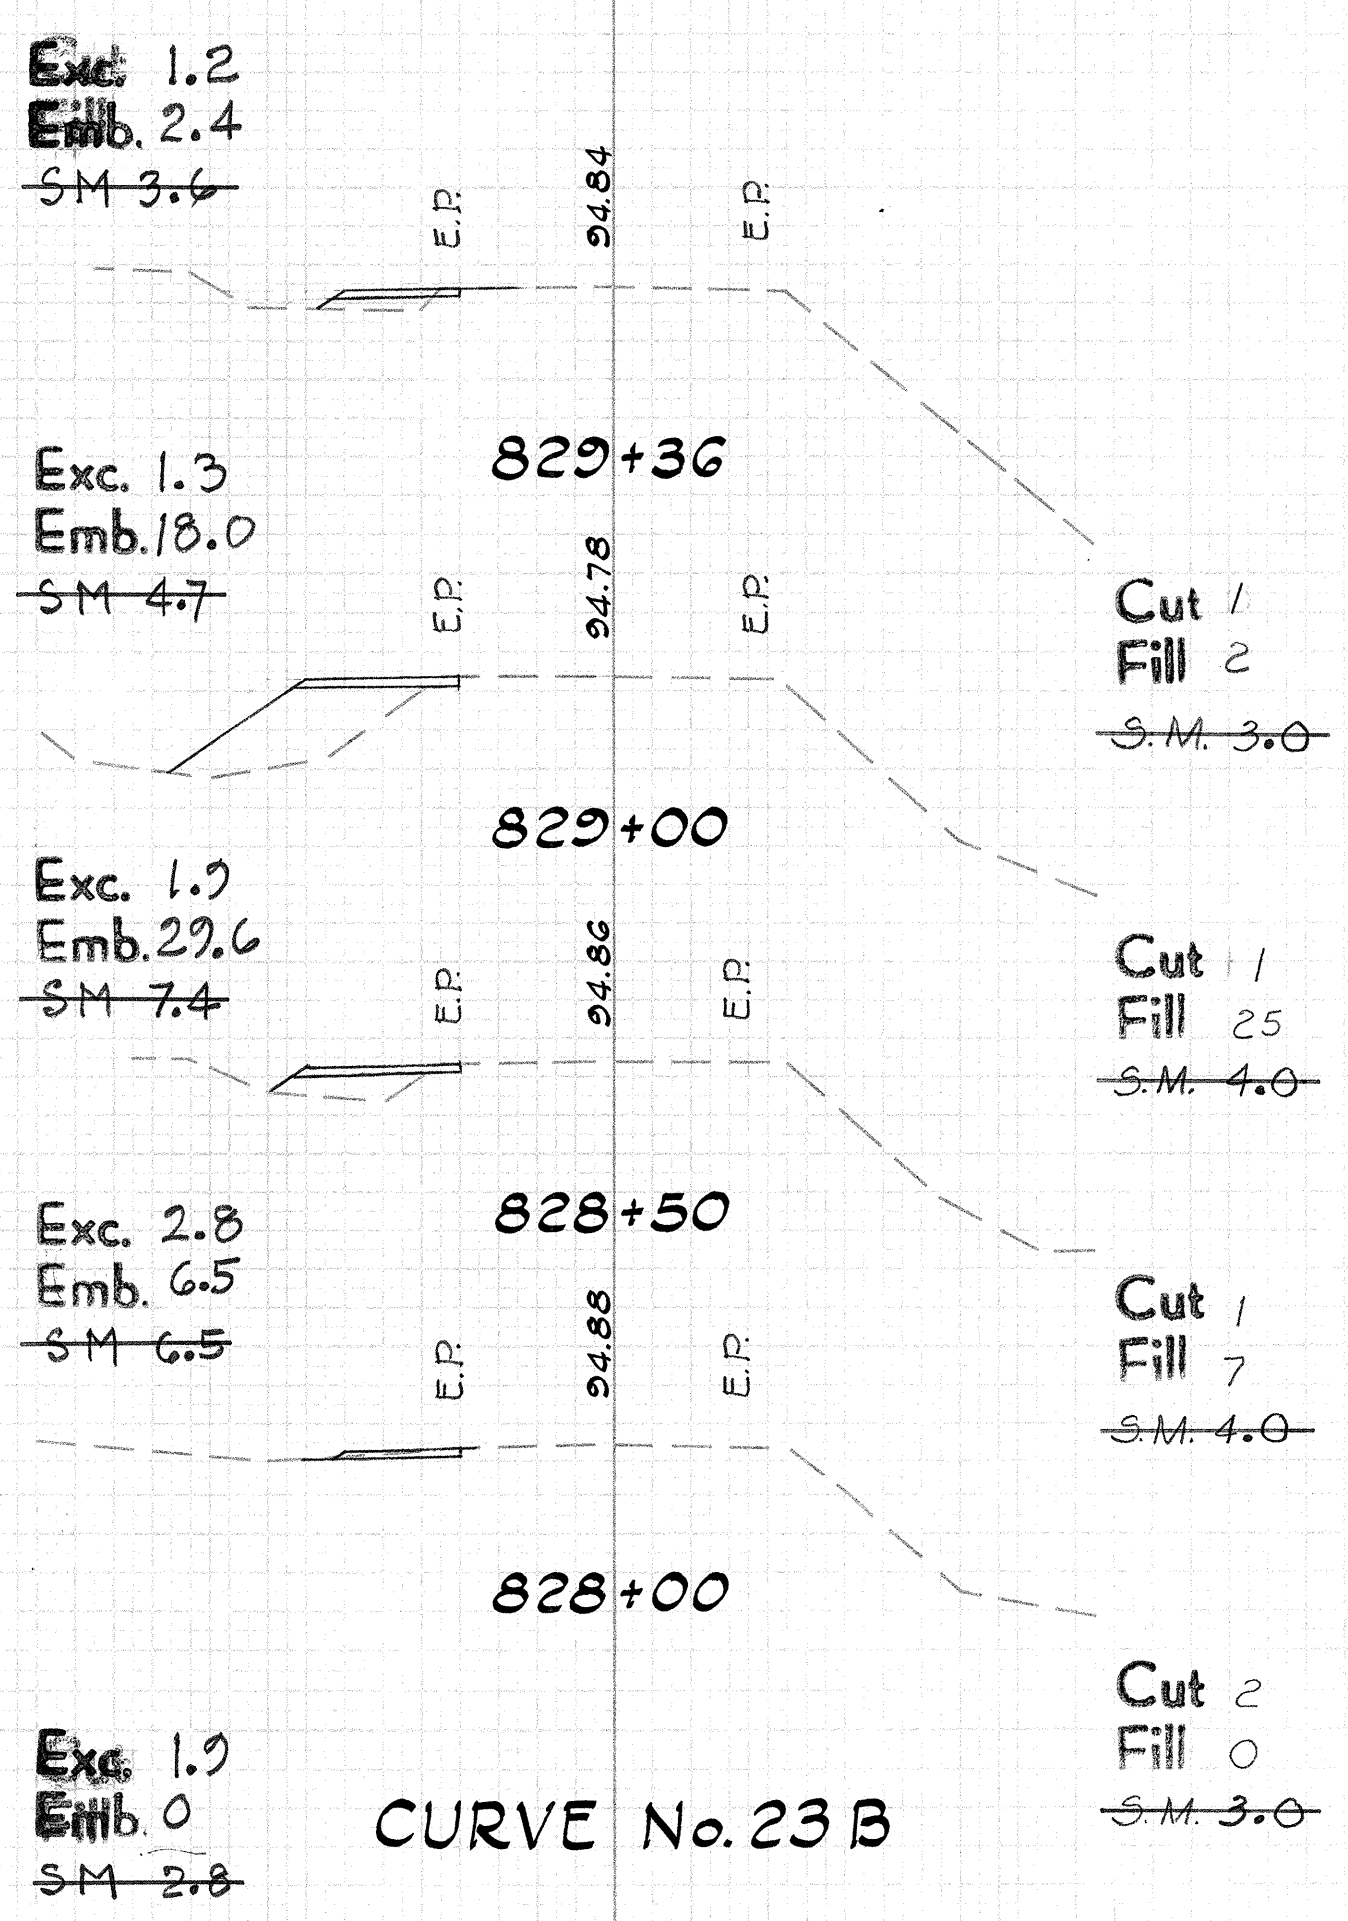



SHEET No. 9 of 10 SHEETS

7/3/70
90
FINAL SURVEY
1003

