

INDEX TO DRAWINGS	
SHEET NO.	DESCRIPTION
1	TITLE SHEET
2	TYPICAL SECTIONS
3-7	LOCATION PLANS
8-17	CROSS SECTIONS

STATE OF HAWAII
DEPARTMENT OF TRANSPORTATION
HIGHWAYS DIVISION



"AS BUILT" PLANS FOR
SAFETY IMPROVEMENTS ALONG
HAWAII BELT ROAD
HOOKENA TO MILOLII
PHASE II

PROJECT NO. 11 C-03-70

DISTRICT OF SOUTH KONA
ISLAND OF HAWAII

PROJ. No. 11 C-03-70

FED. ROAD DIST. NO.	STATE	FED. AID PROJ. NO.	FISCAL YEAR	SHEET NO.	TOTAL SHEETS
HAWAII	HAW.	11C-03-70	1970	1	17

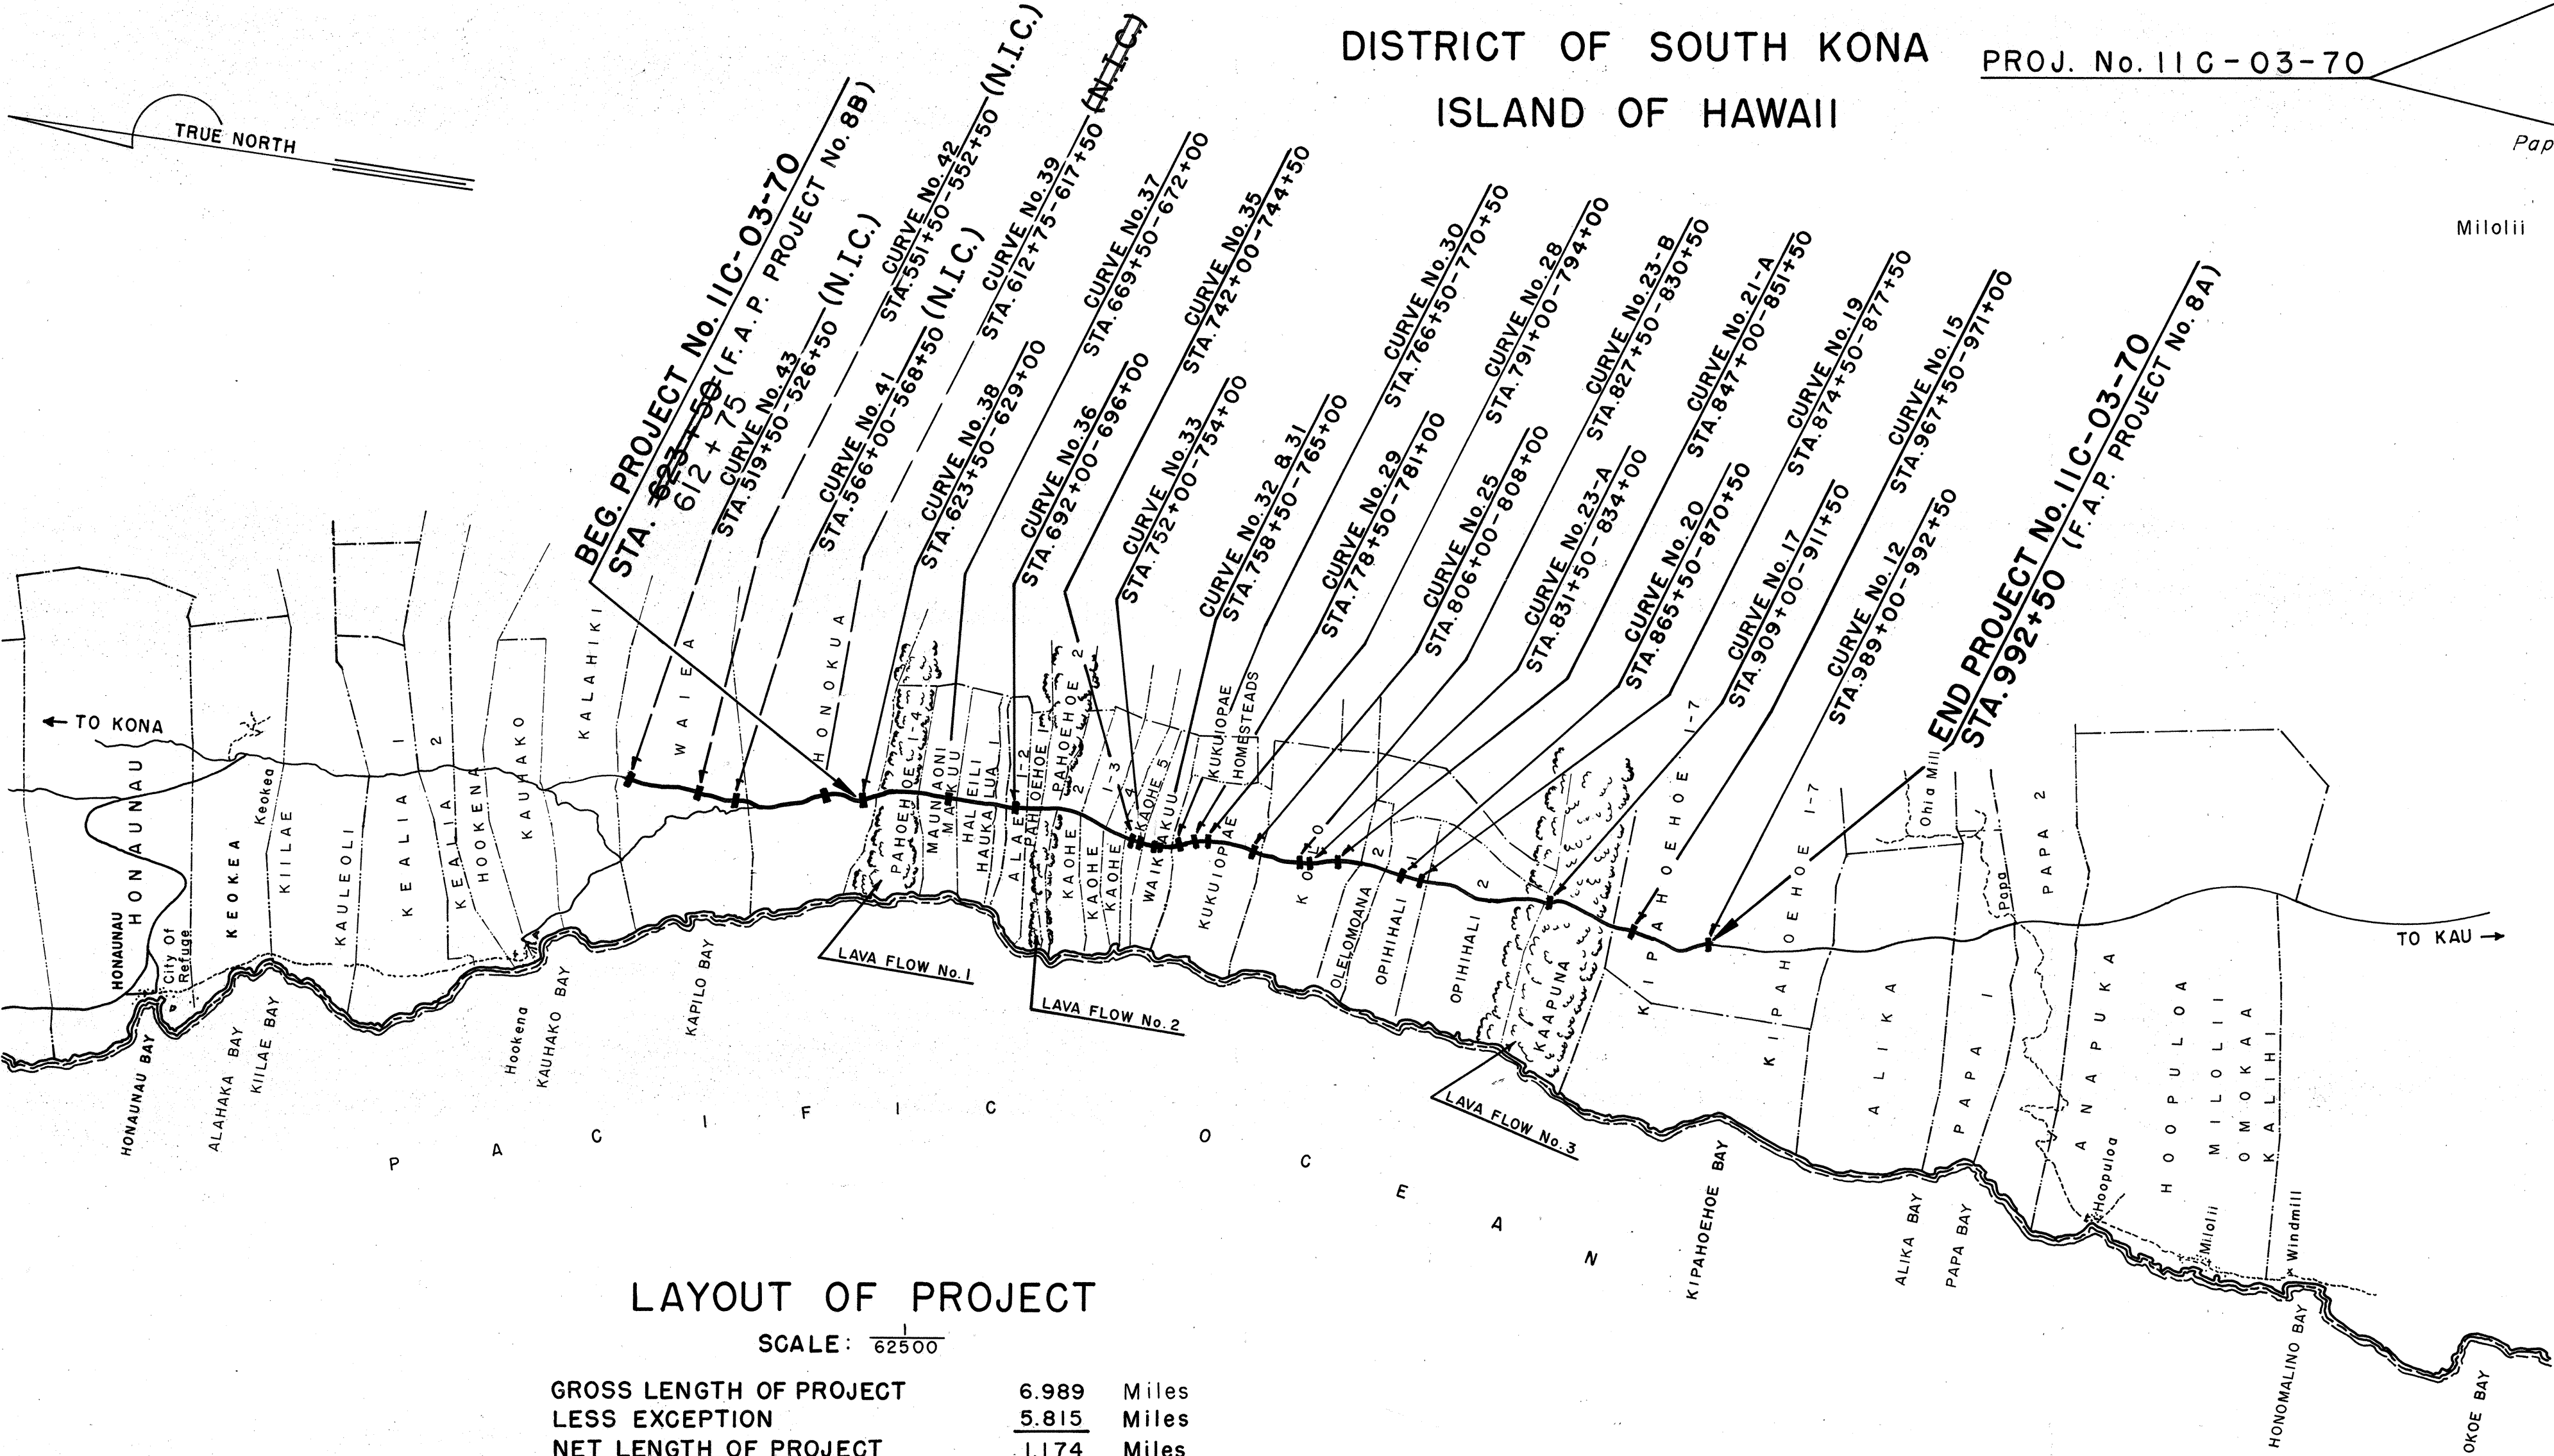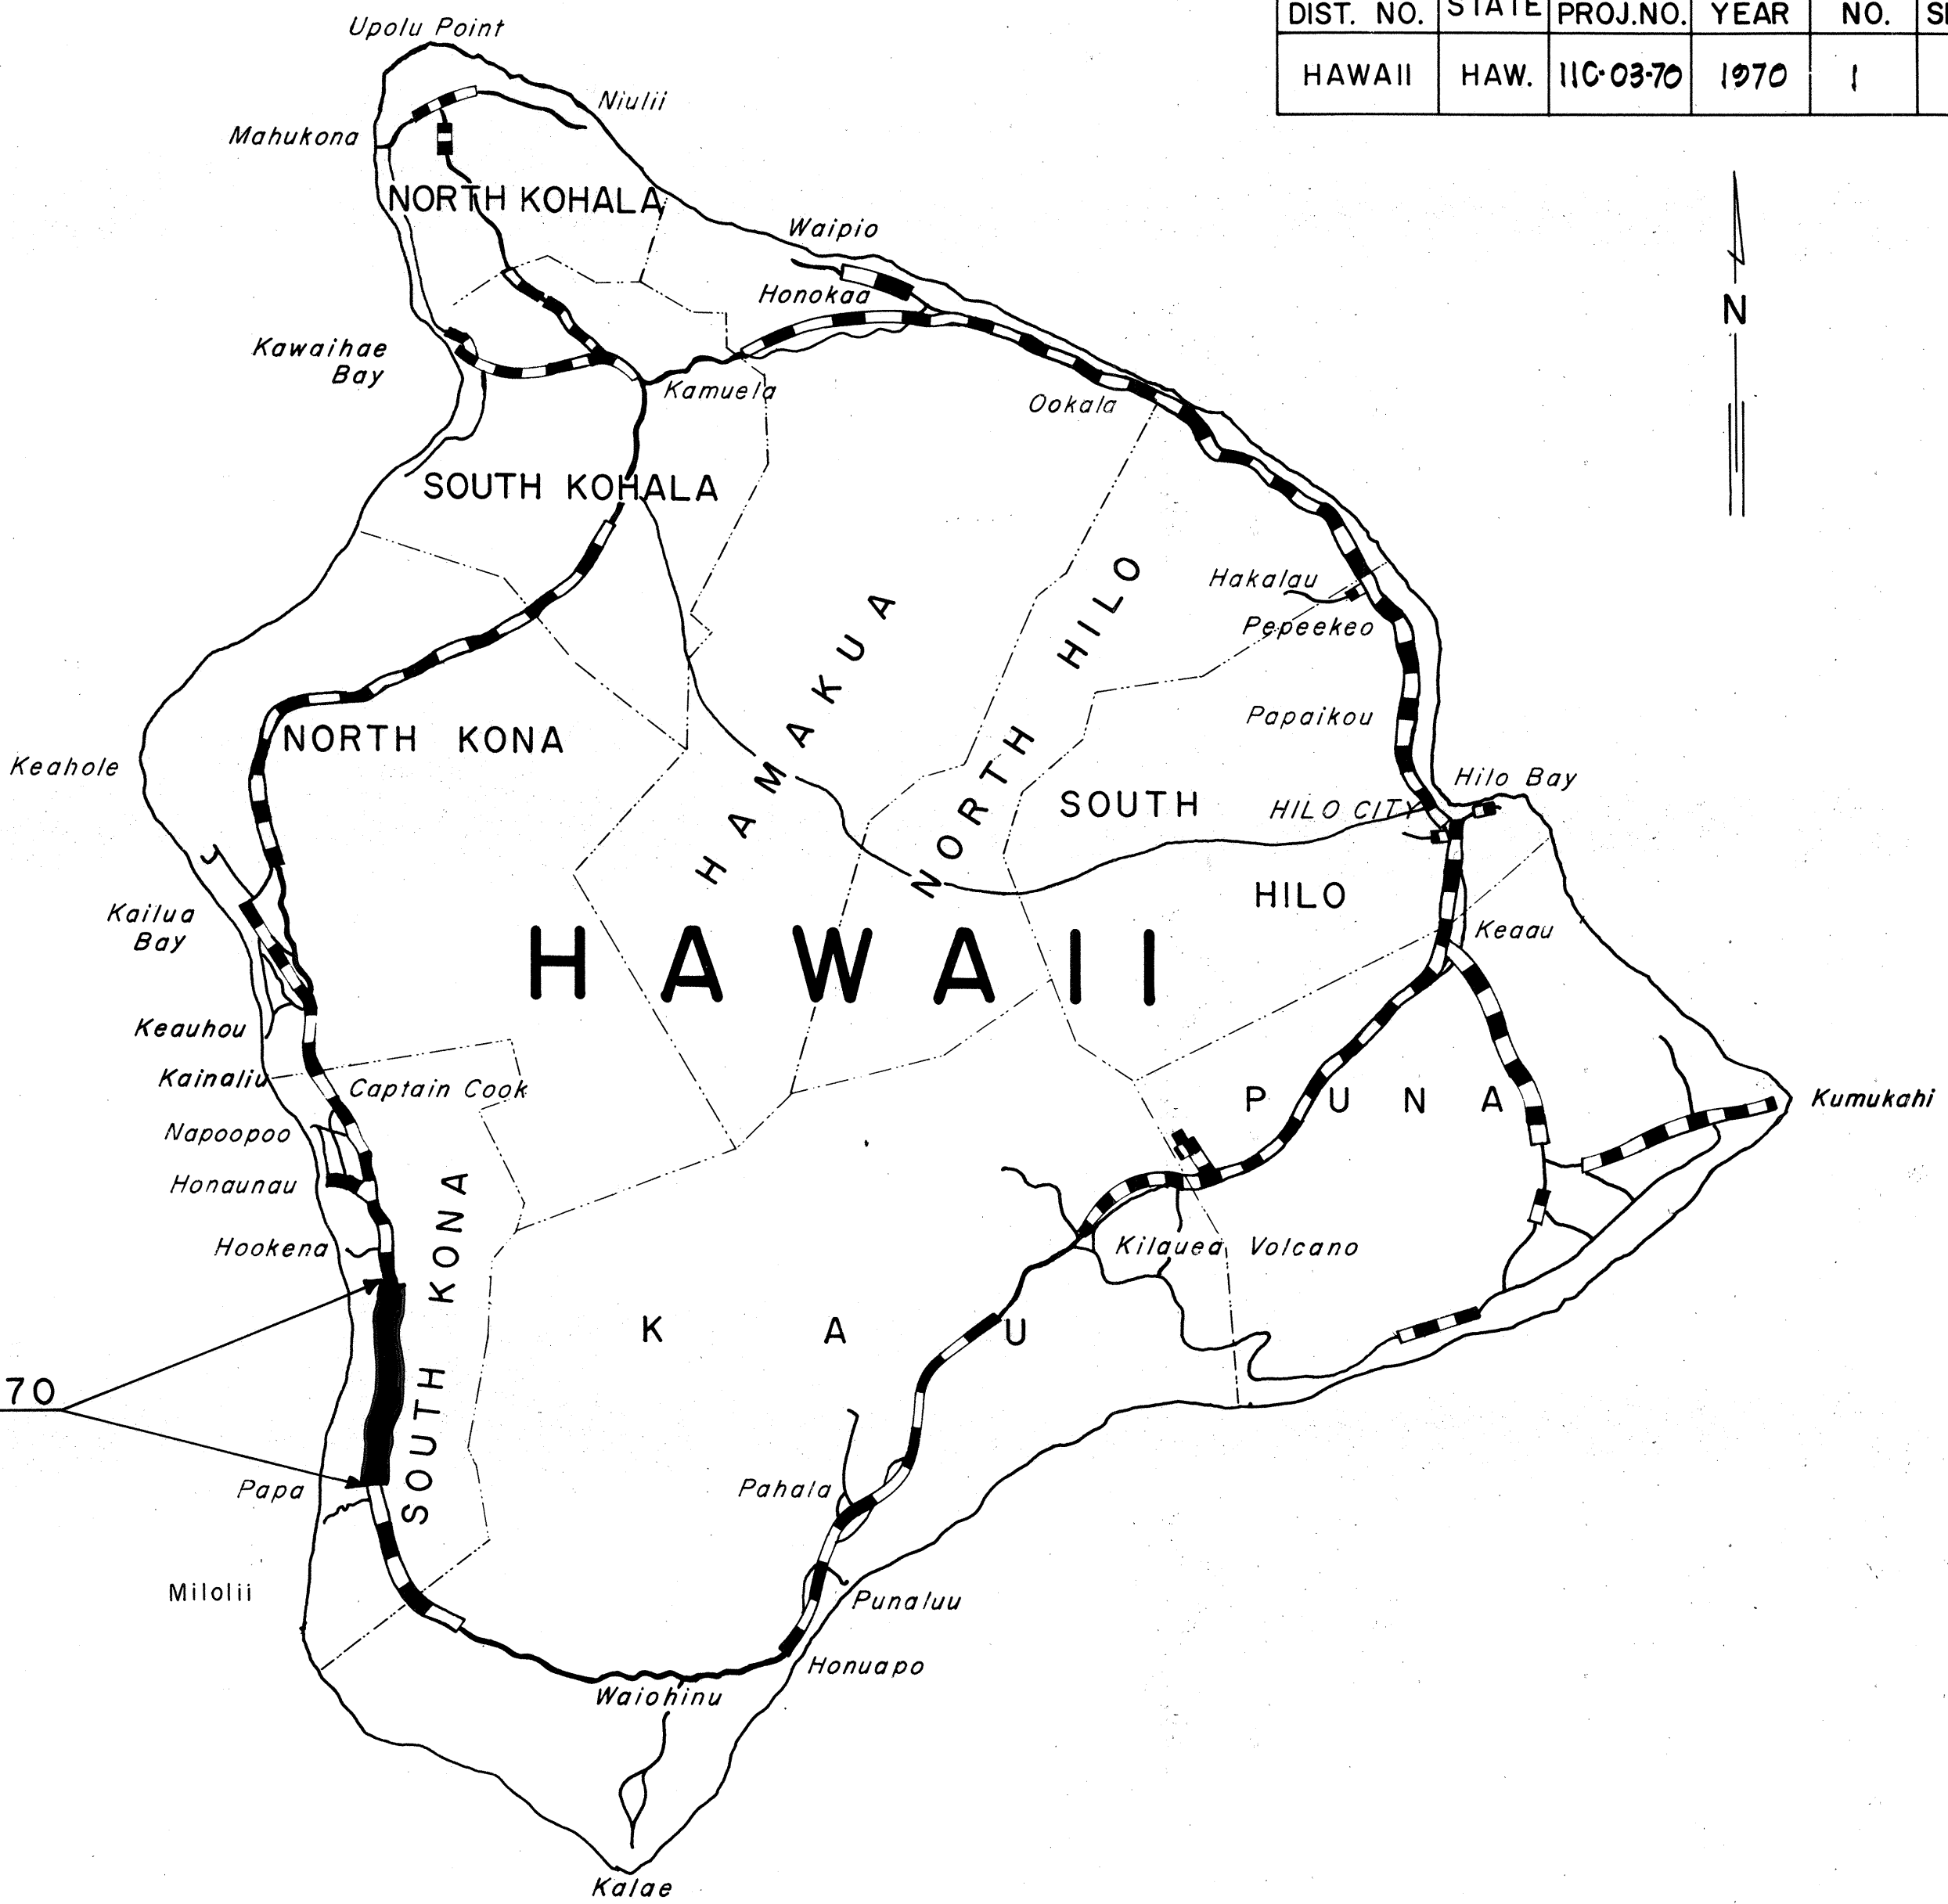

LAYOUT OF PROJECT

SCALE: 1"=250'

GROSS LENGTH OF PROJECT	6.989	Miles
LESS EXCEPTION	5.815	Miles
NET LENGTH OF PROJECT	1.174	Miles

NOTE:
ALL CHANGES MADE DURING CONSTRUCTION HAVE
BEEN NOTED IN RED ON THESE TRACINGS AND
CHECKED BY

for PROJECT ENGINEER *E. Alvey Wright* 7/2/71 DATE

DEPARTMENT OF TRANSPORTATION STATE OF HAWAII	
APPROVED:	
<i>E. Alvey Wright</i>	8/4/70
for DIR. OF TRANSPORTATION	DATE

DESIGNED BY: HAWAII DISTRICT
PS&E R.F. Tsuchioka 548-2211 Local 301 Aug. 3, 1970
DATE
PHONE
DESIGN ENGINEER