


5-A

JOB NO. P-1829

A map of the State of Hawaii showing county boundaries. The map is labeled with the following locations: KAMUELA, HILO, KILAUEA VOLCANO, HONUAPO, KA LAE, KAILUA-KONA, and the PROJECT SITE. The PROJECT SITE is located on the island of Kauai, near the coast. A scale bar indicates distances in miles (0, 5, 10, 15), and a north arrow is present.

T.M.K. 3rd Div: 9-3-04, 9-4-03, 04 & 05, 9-5-02 & 05
DANIEL, MANN, JOHNSON AND MENDENHALL OF HAWAII
CONSULTING ENGINEERS
210 WARD AVENUE HONOLULU HAWAII 96814

<u>SHEET NO.</u>	<u>DESCRIPTION</u>
*	TITLE SHEET
I	TYPICAL SECTIONS
2 - 16	PLAN & PROFILE
17 - 18	DETAILS
19 - 31	CROSS SECTIONS

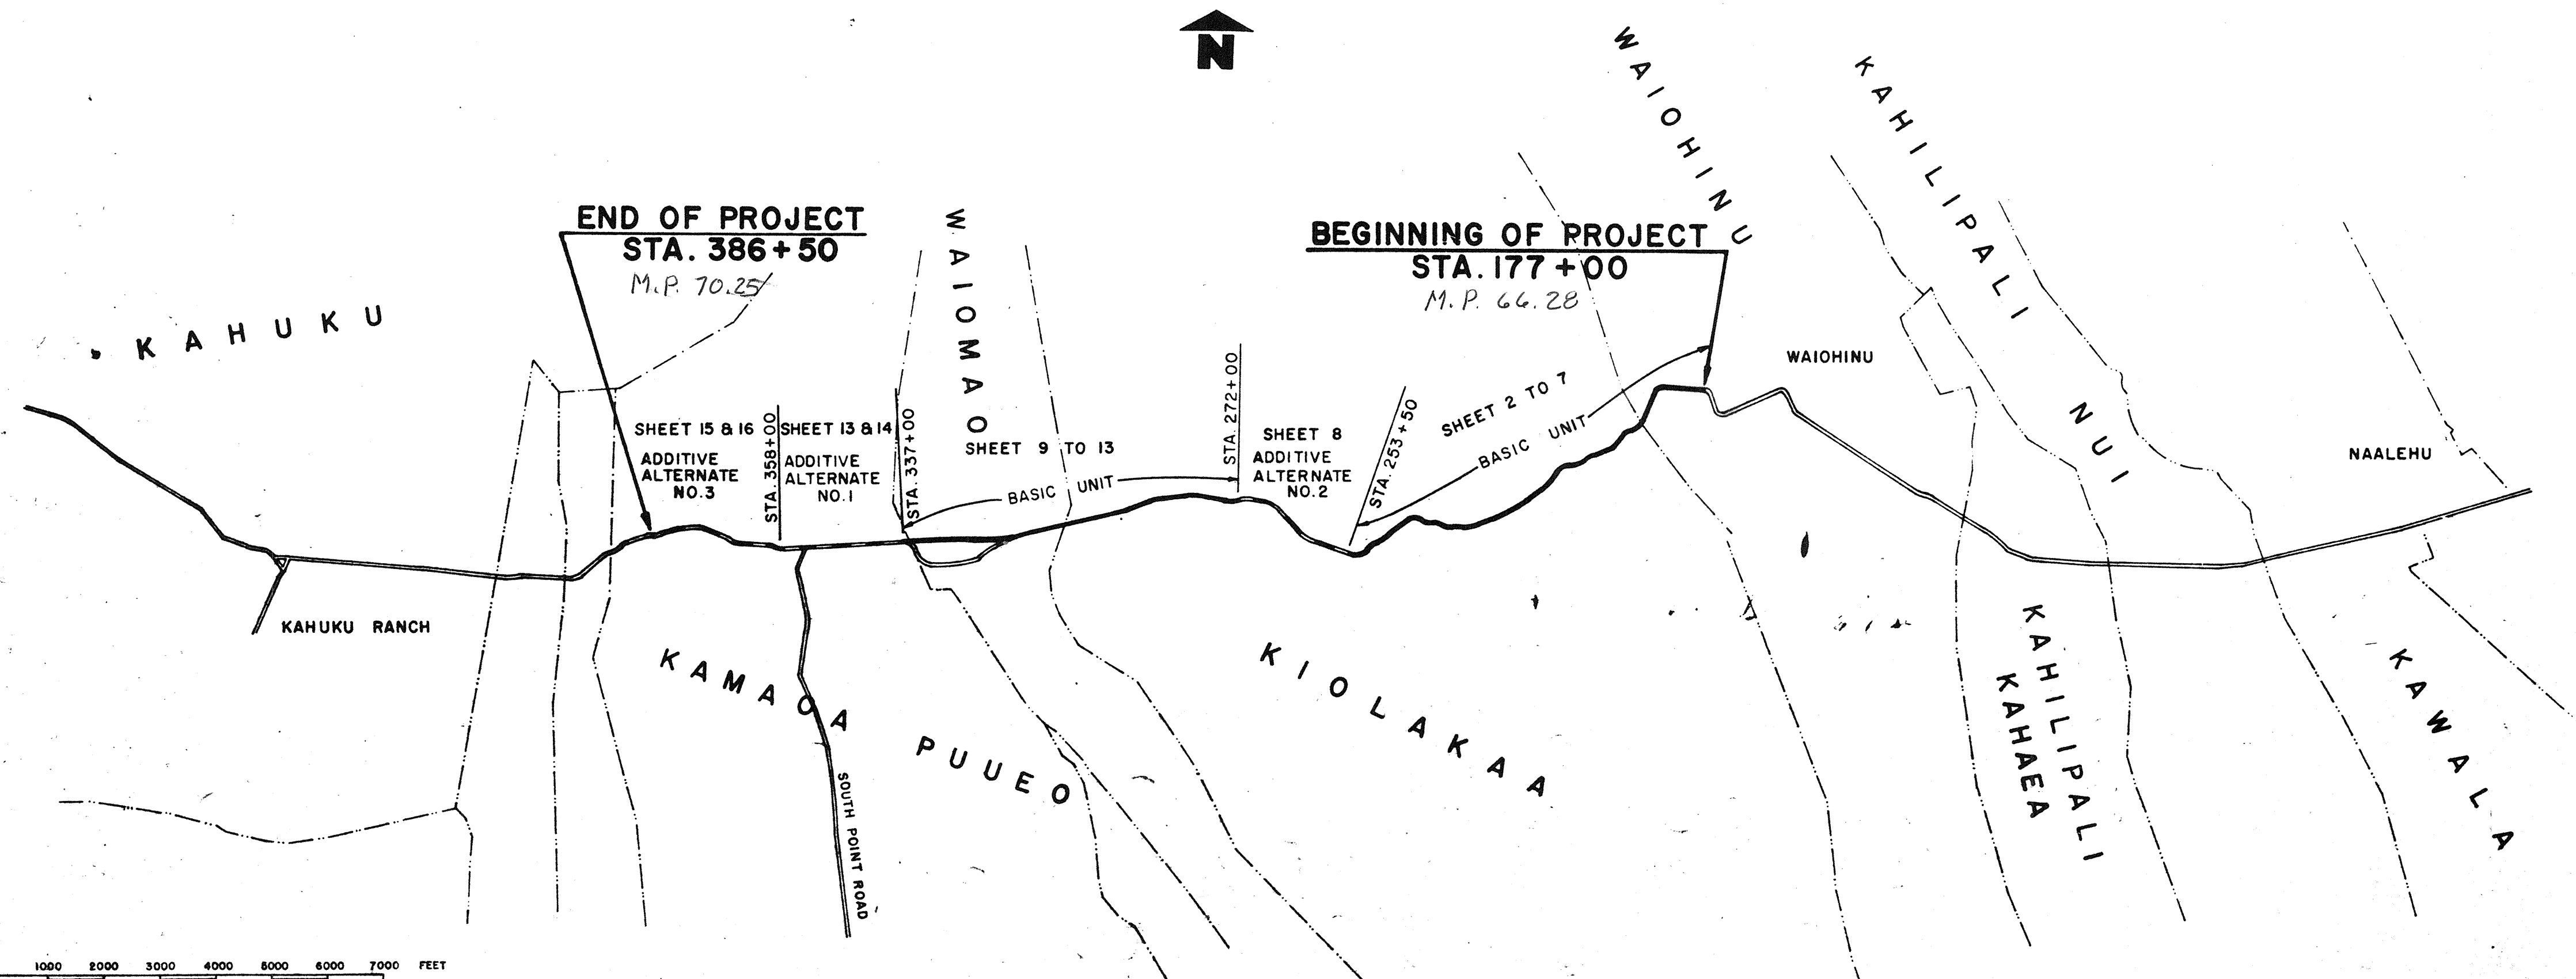

M. P. 70. 25

Raymond J. Nelson
PLANNING DIRECTOR, COUNTY OF HAWAII

DATE _____

DD-A-4-1