



FED. ROAD DIST. NO.	STATE	PROJ. NO.	FISCAL YEAR	SHEET NO.	TOTAL SHEETS
HAWAII	HAW.	11P-01-71	1971	11	12

FINAL SURVEY
DATE: 11/1/71
BY: [Signature]
NOTE BOOK: [Number]
AREA: [Area]
NO. [Number]



ORIGINAL SURVEY
DATE: 11/1/71
BY: [Signature]
NOTE BOOK: [Number]
AREA: [Area]
NO. [Number]

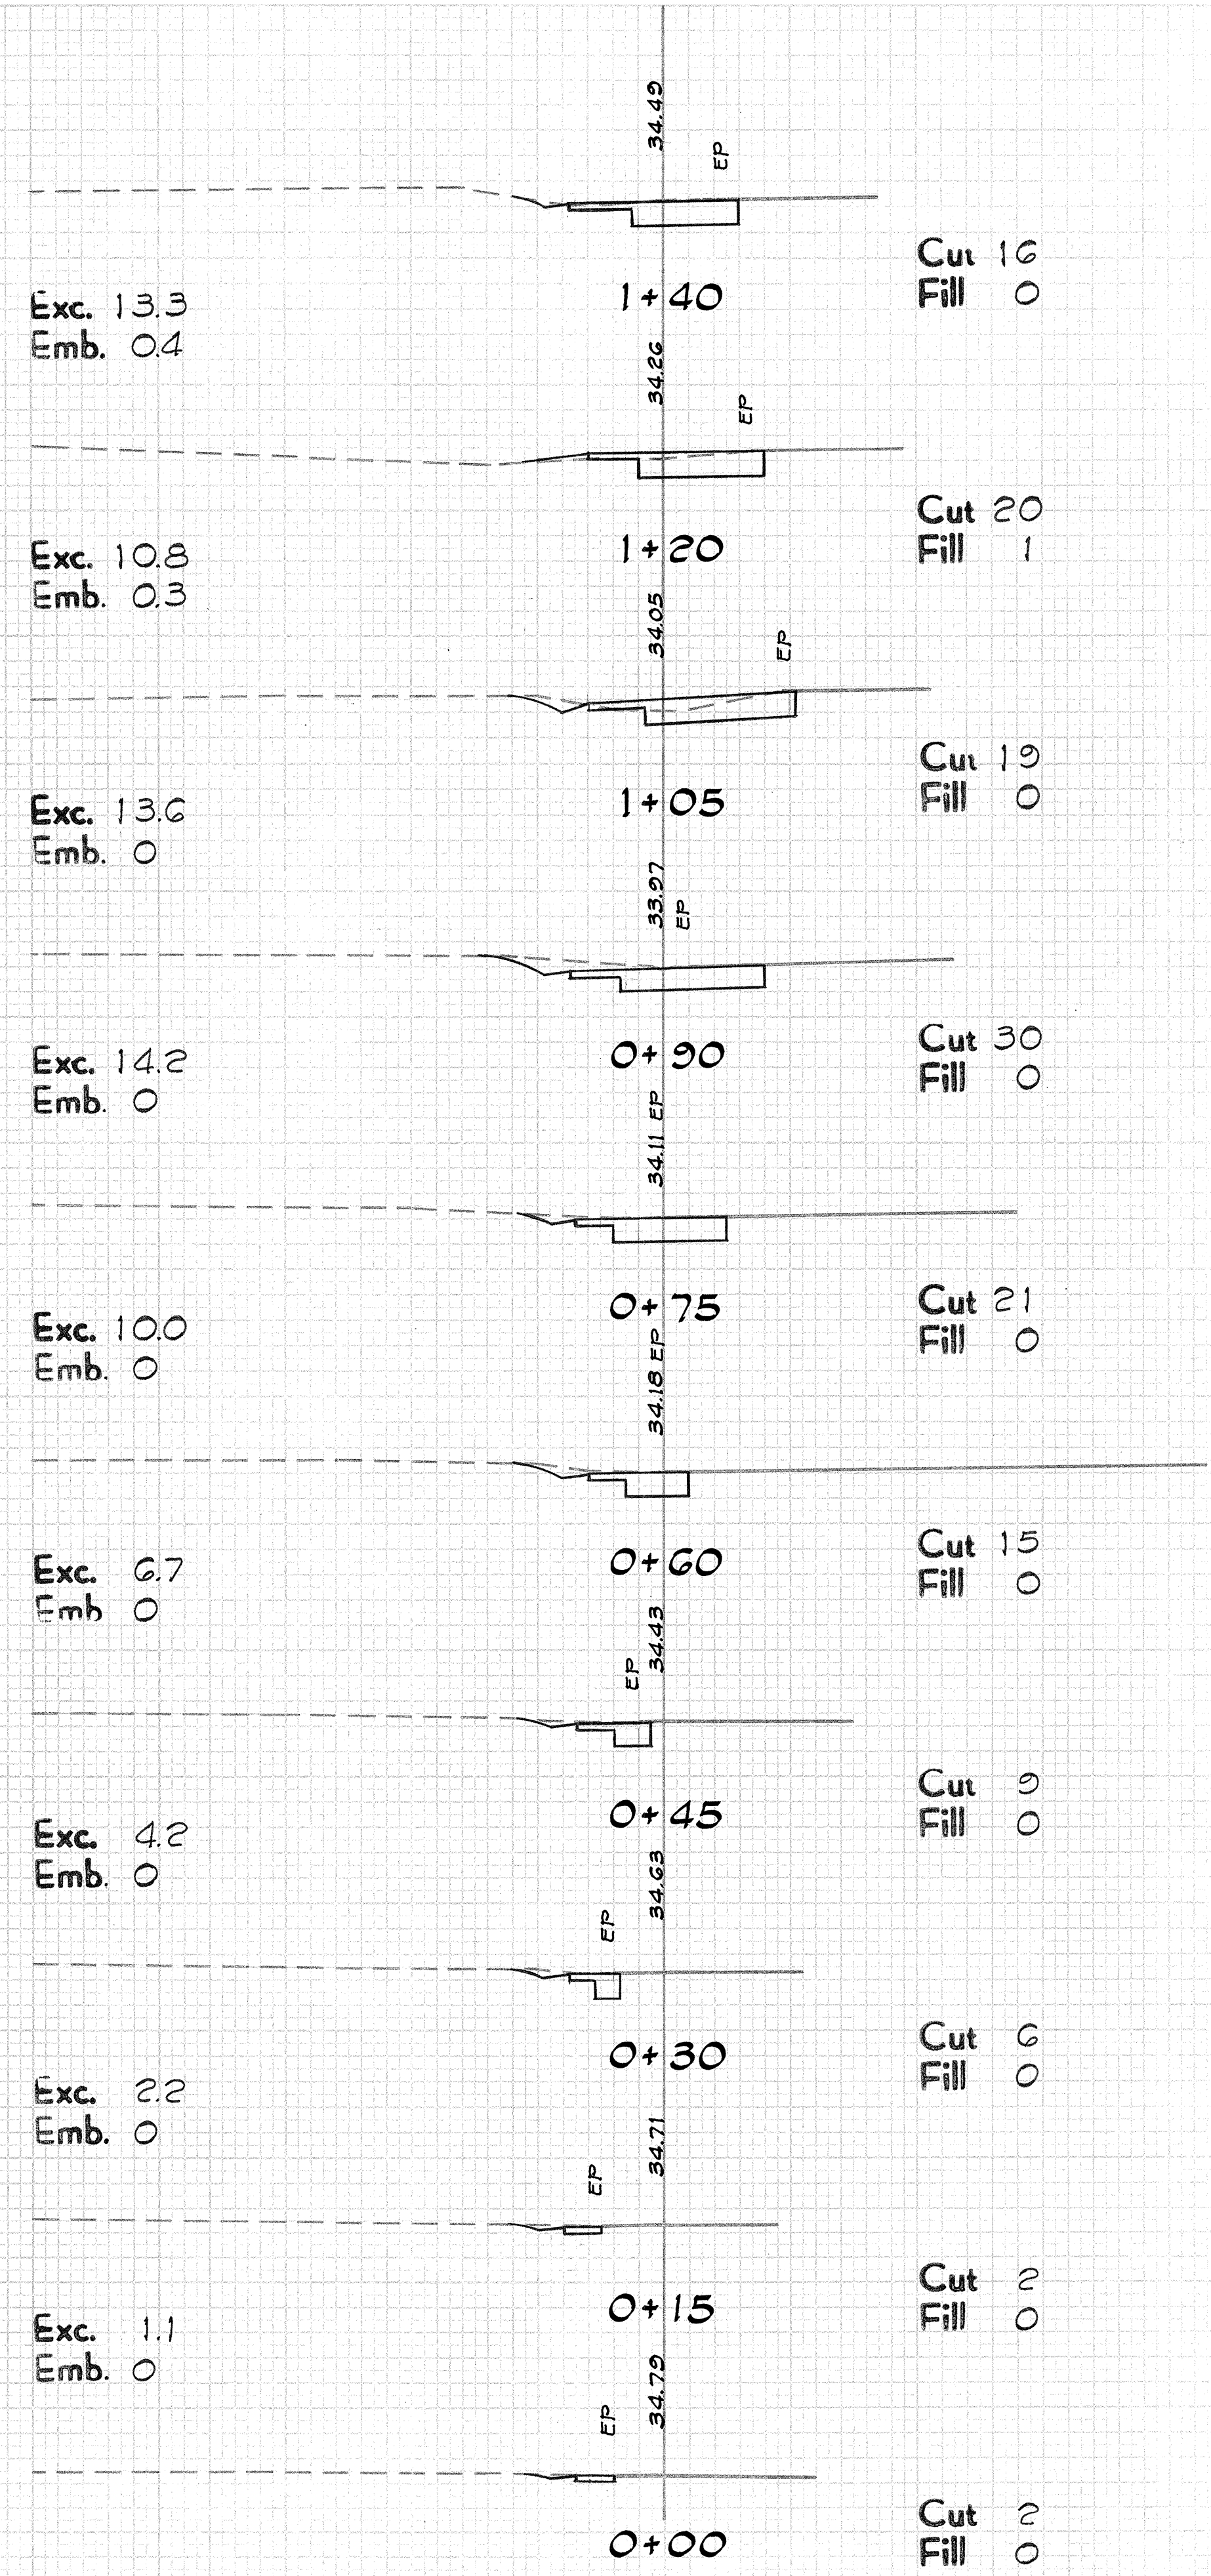


LANIKAULA INTERSECTION (LEFT SIDE)

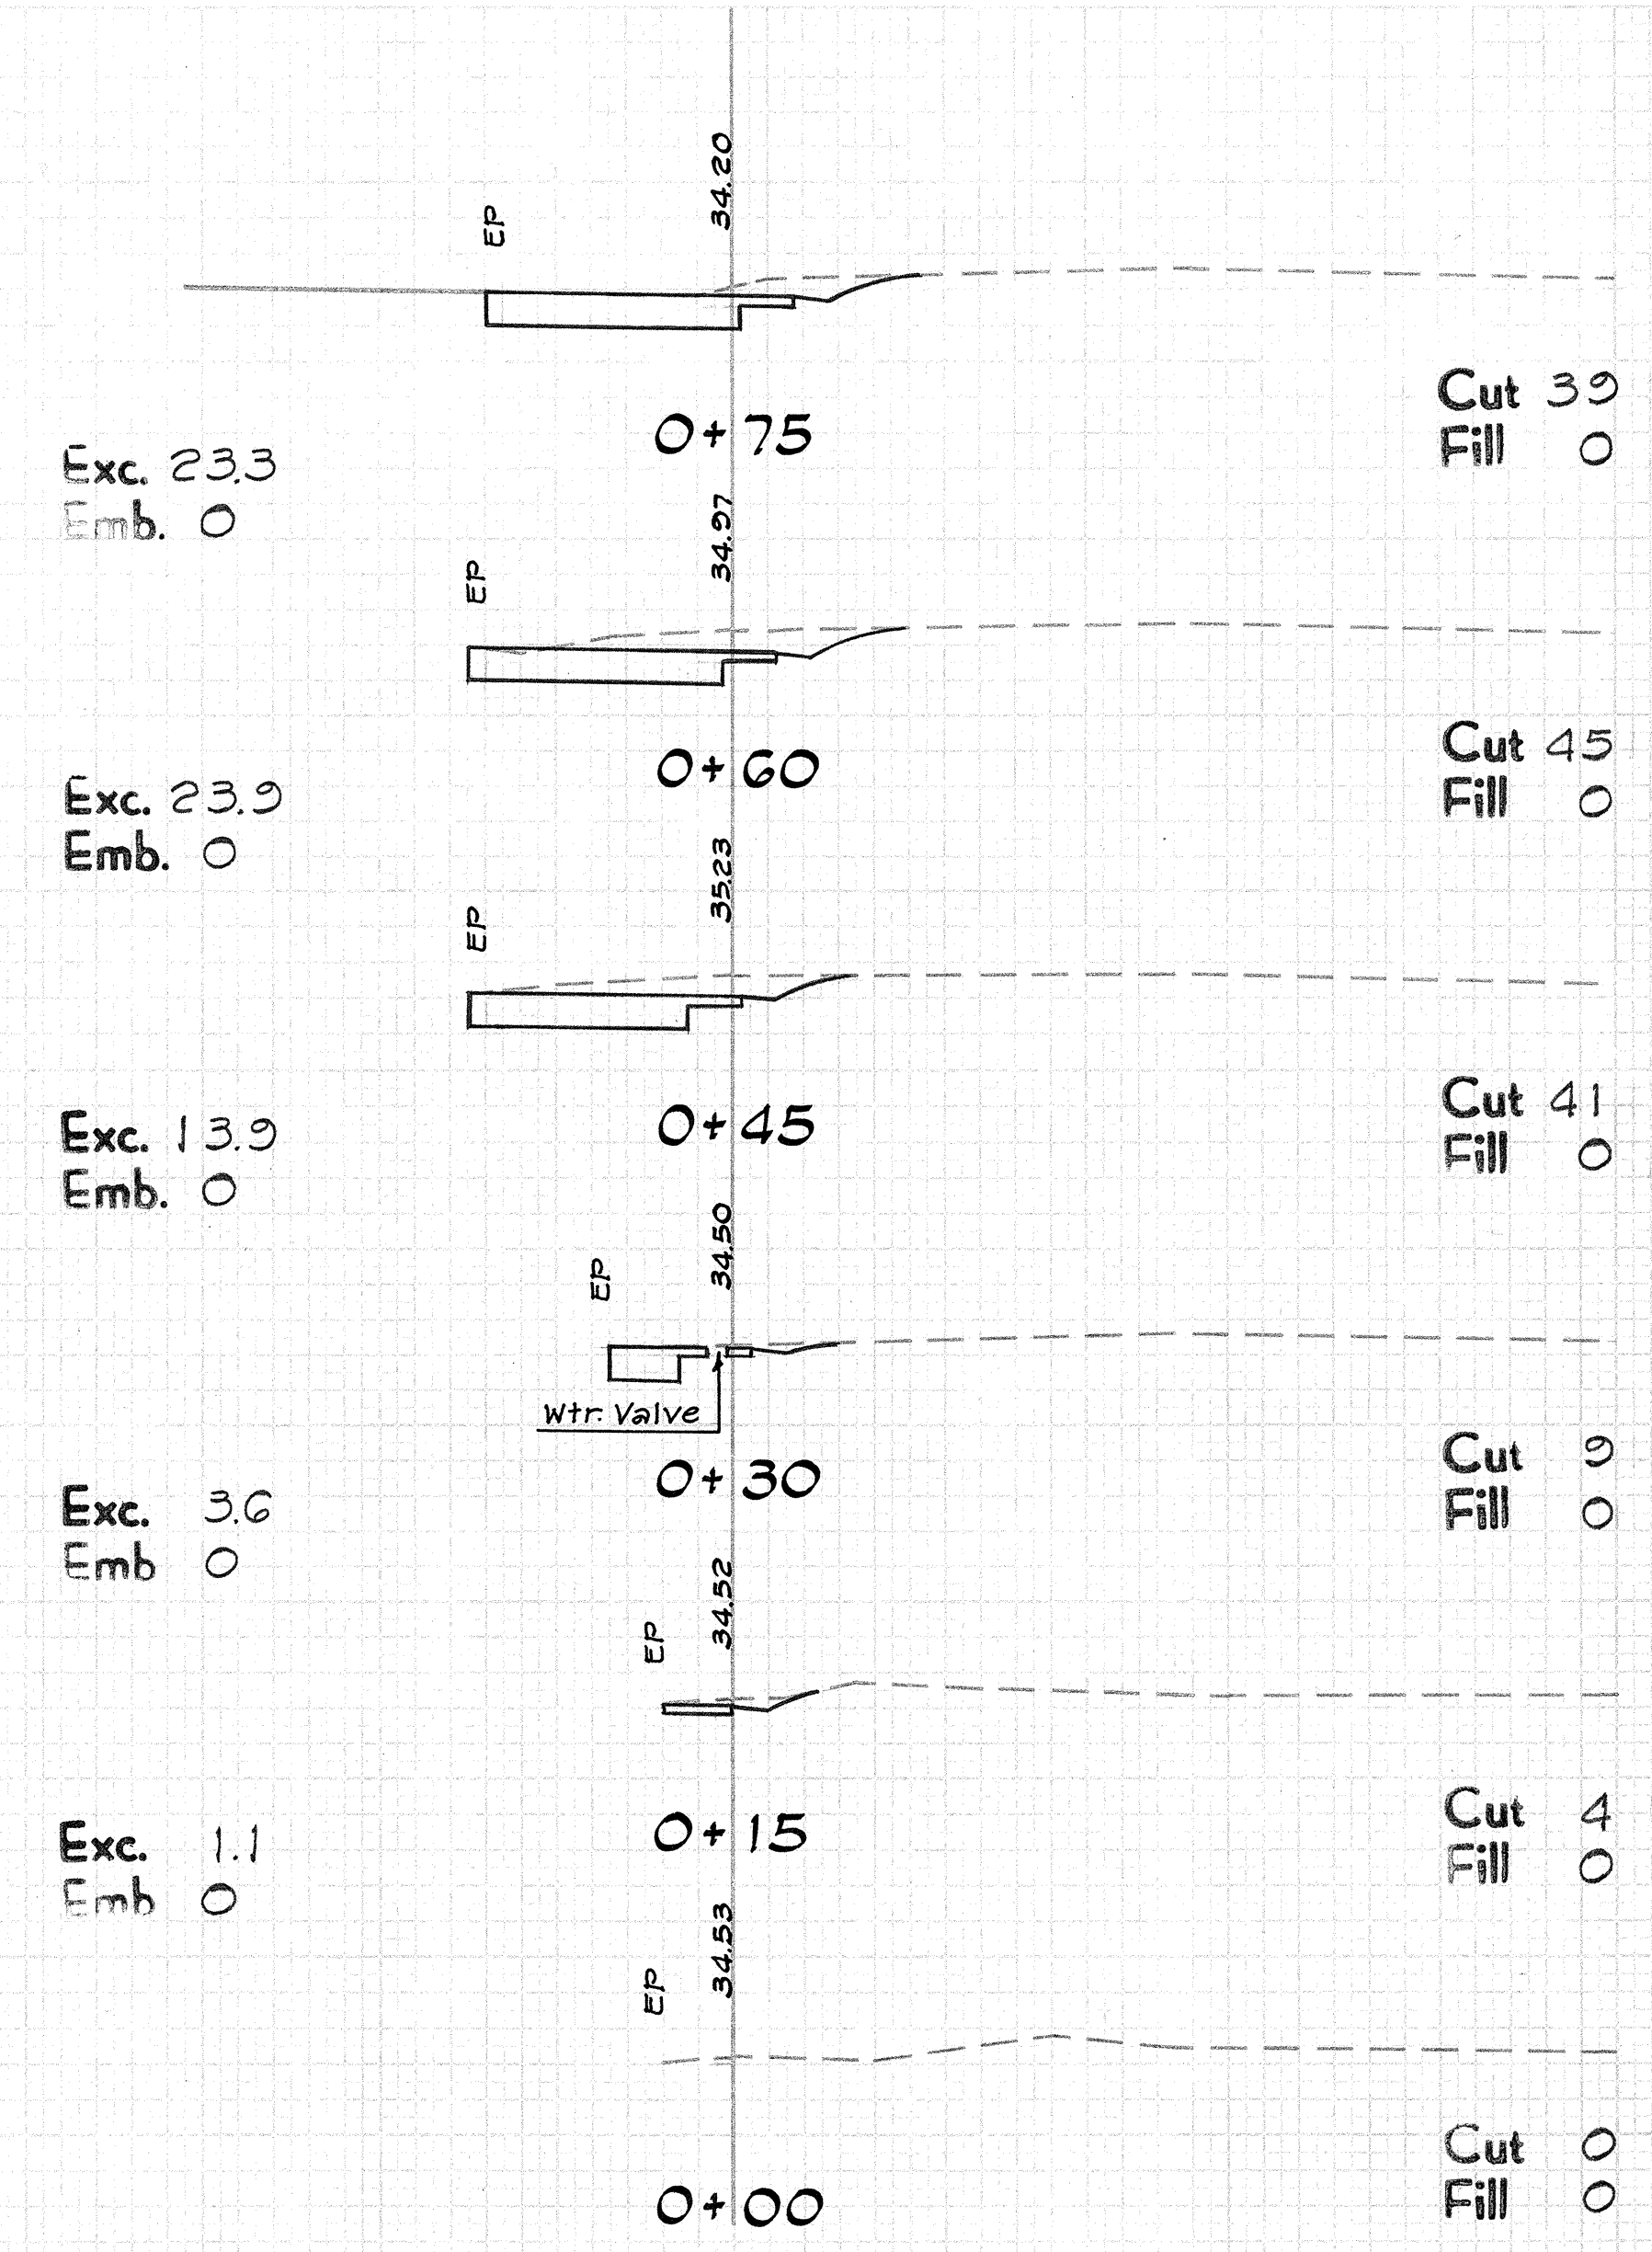


(RIGHT SIDE)

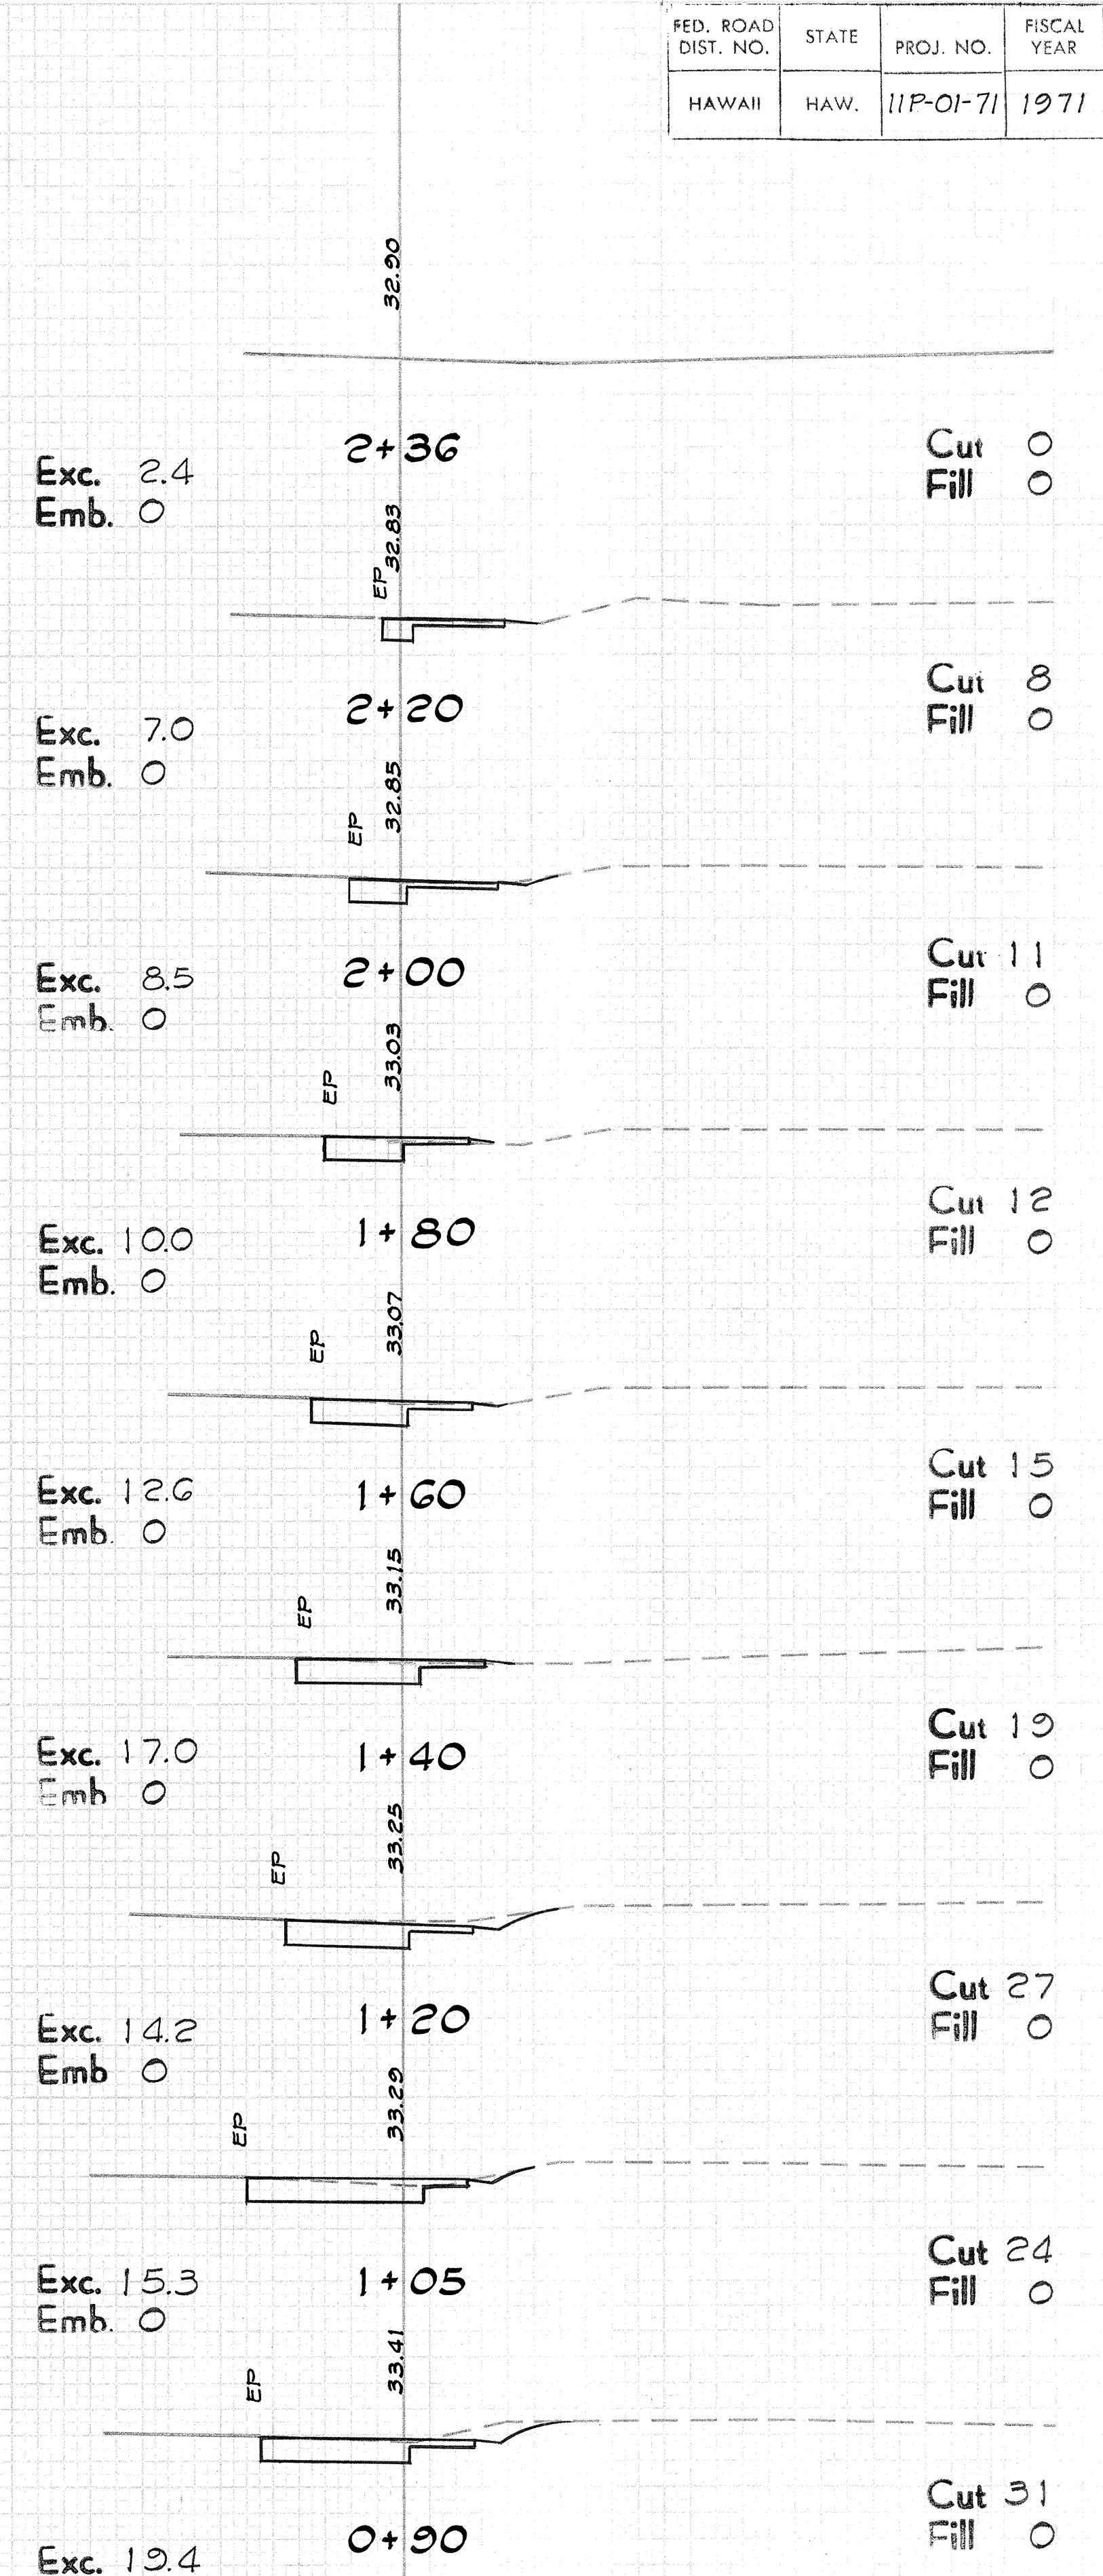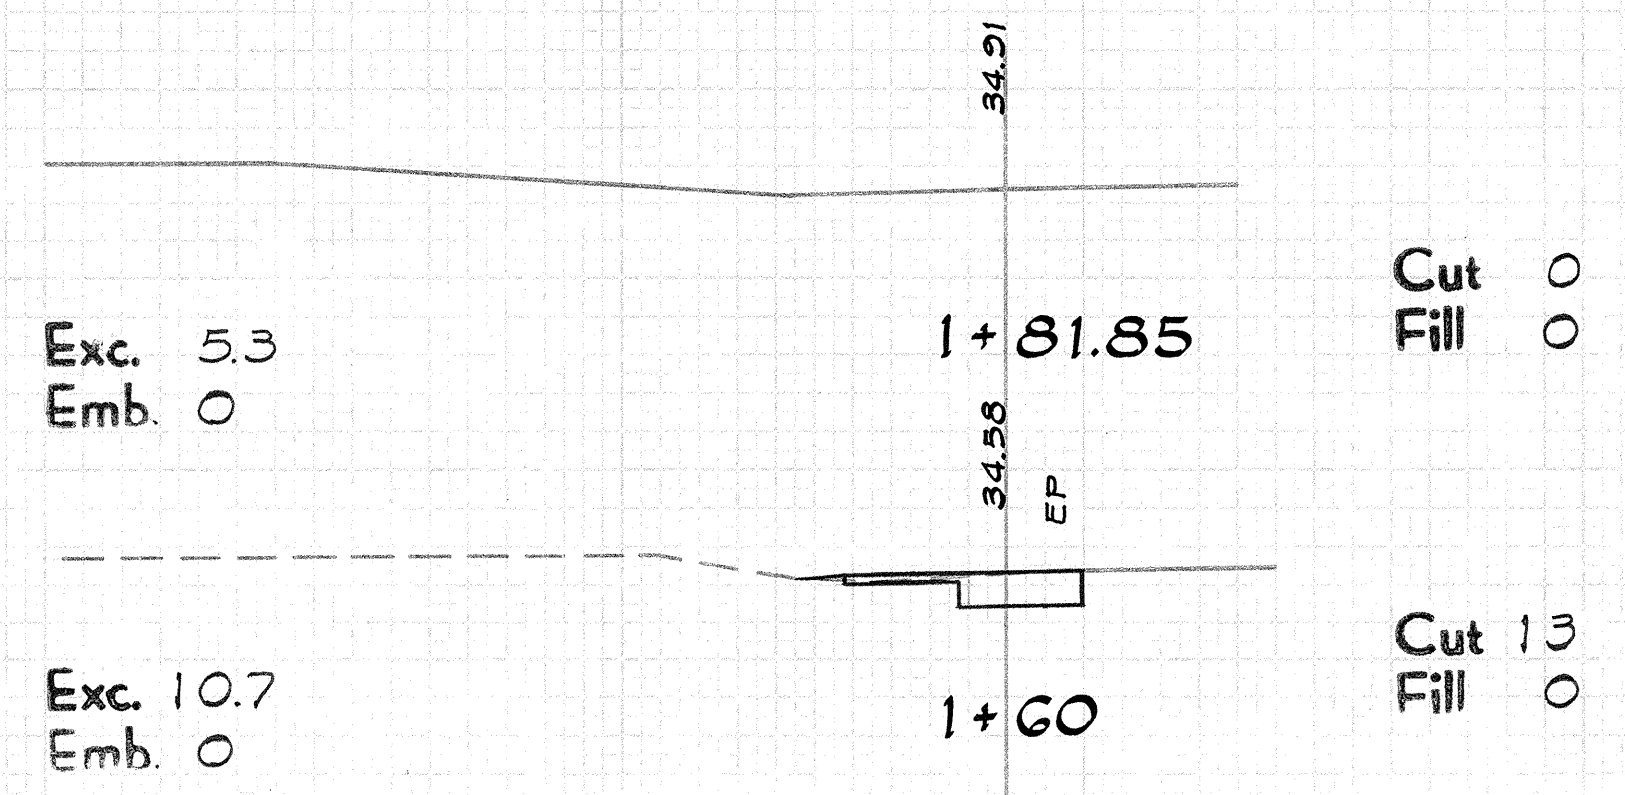

FED. ROAD DIST. NO.	STATE	PROJ. NO.	FISCAL YEAR	SHEET NO.	TOTAL SHEETS
HAWAII	HAW.	11P-01-71	1971	12	12

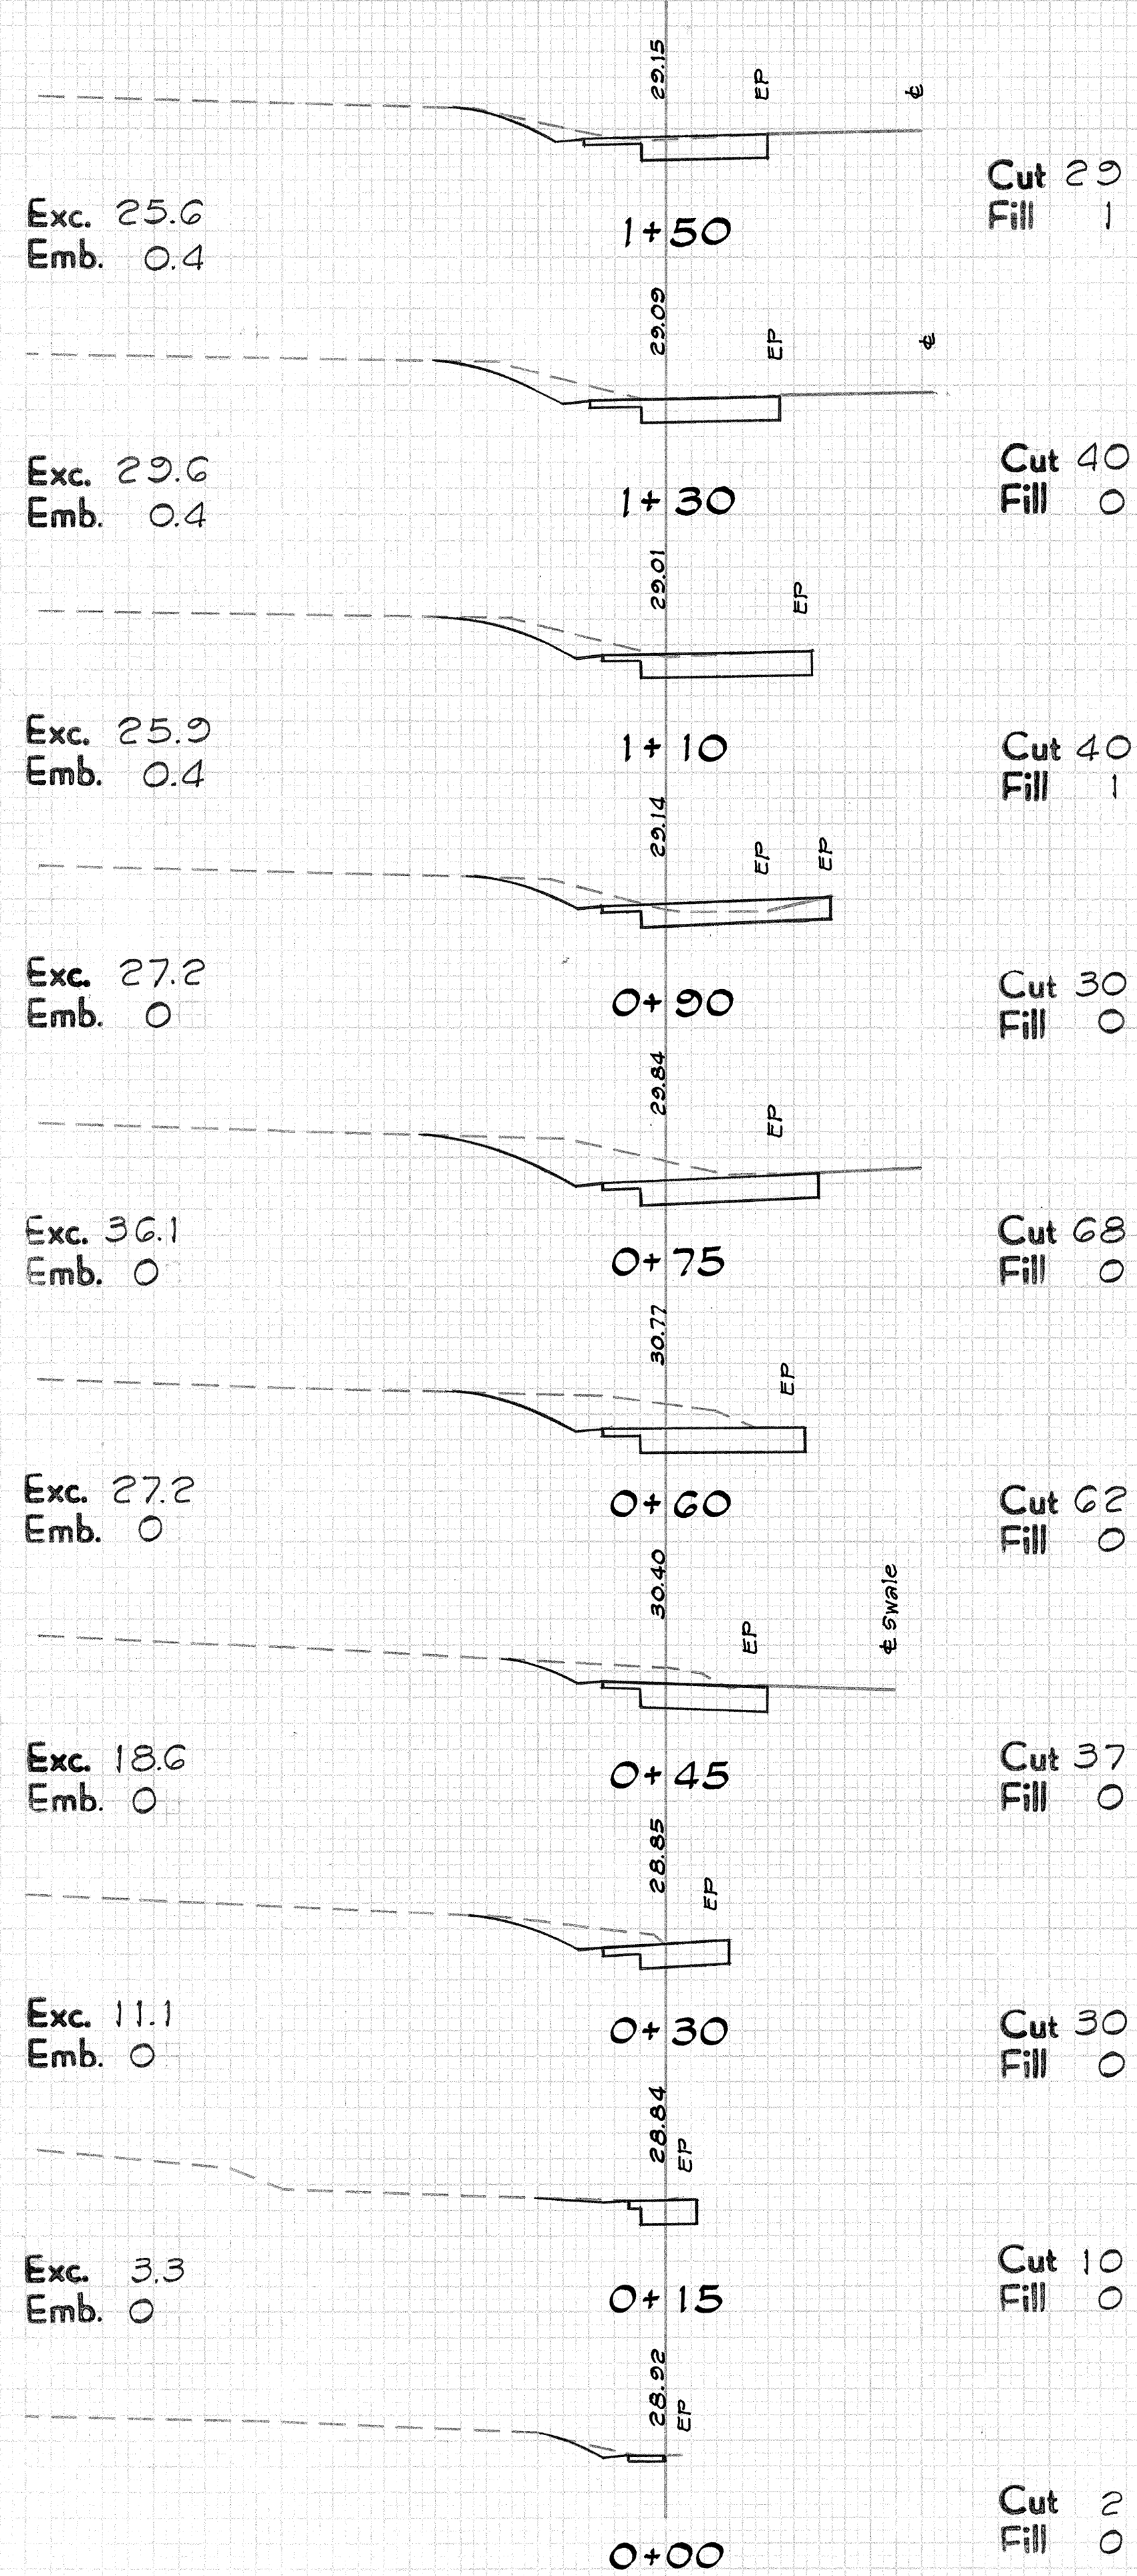

LEILANI INTERSECTION (LEFT SIDE)

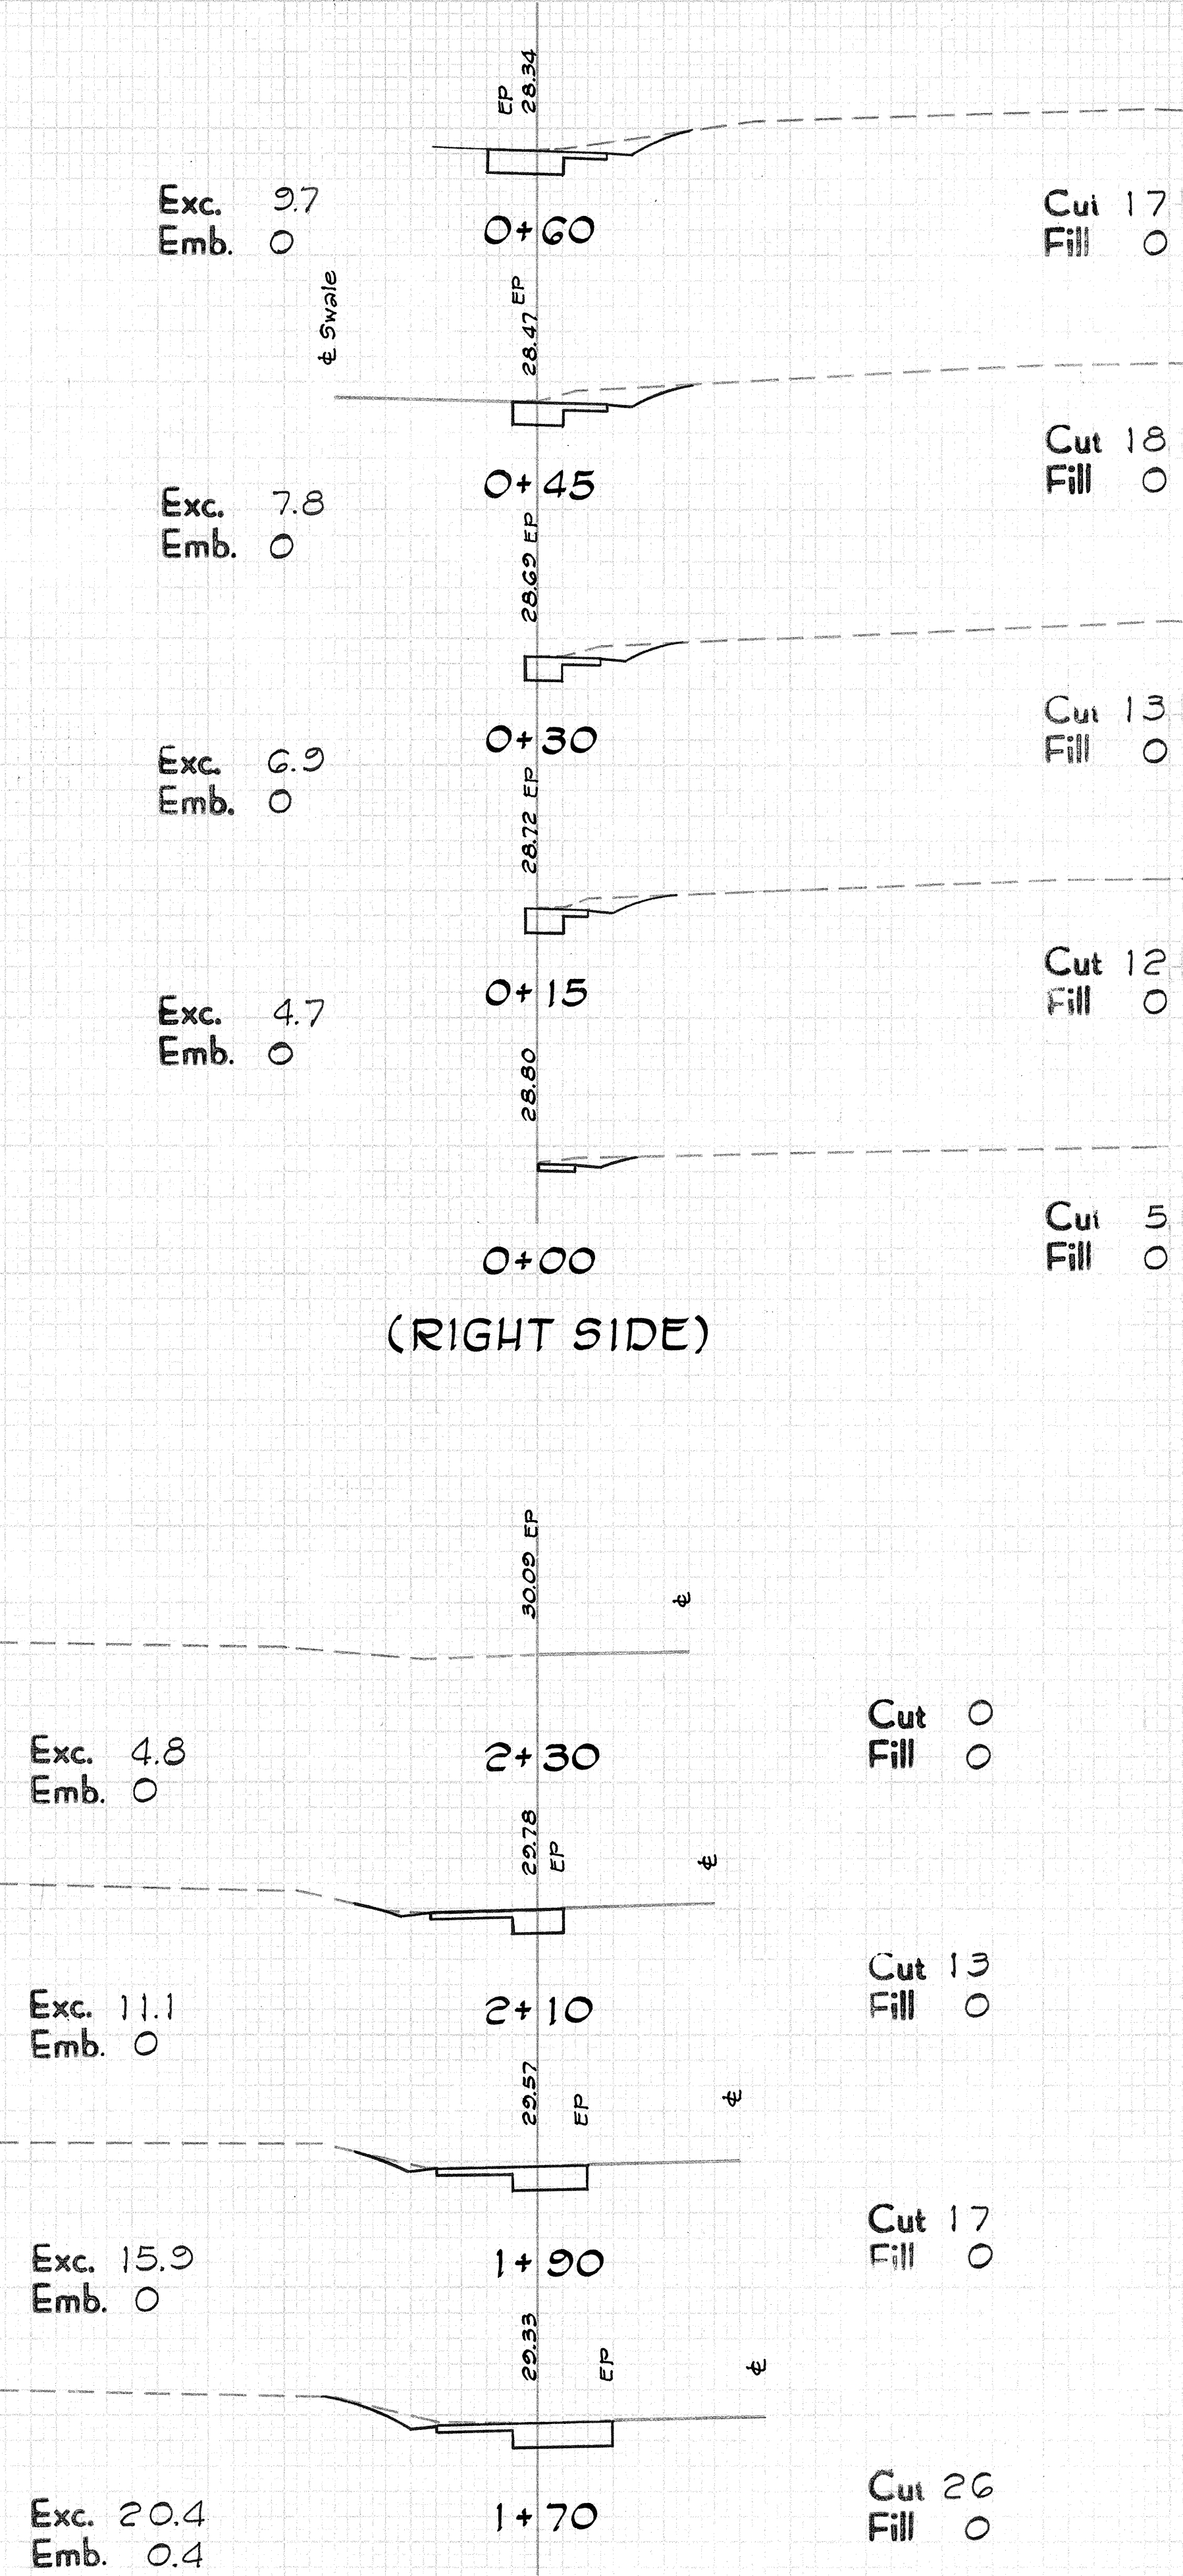

(RIGHT SIDE)

