
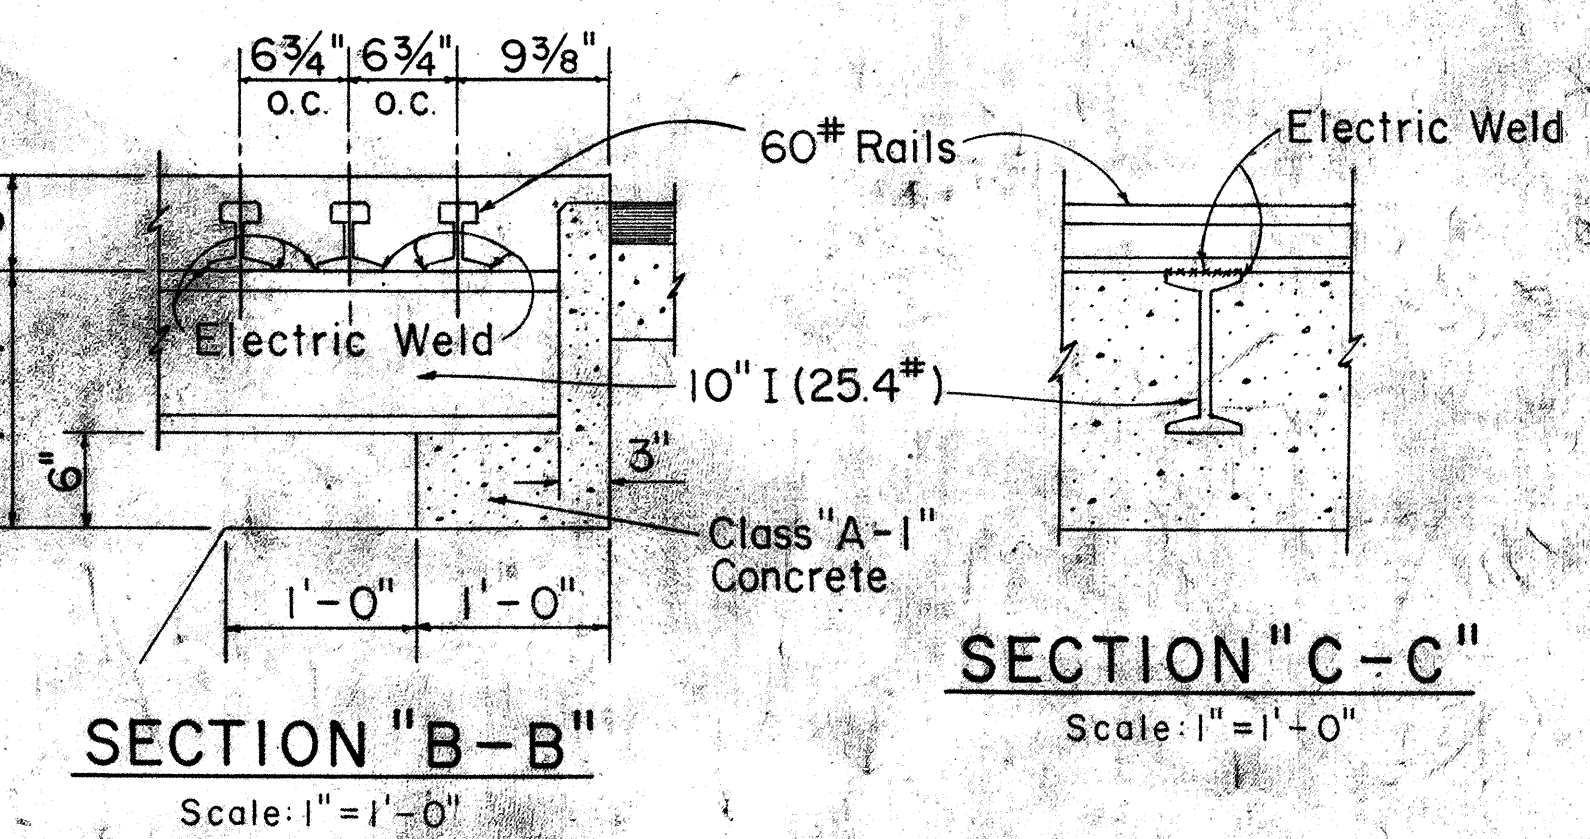
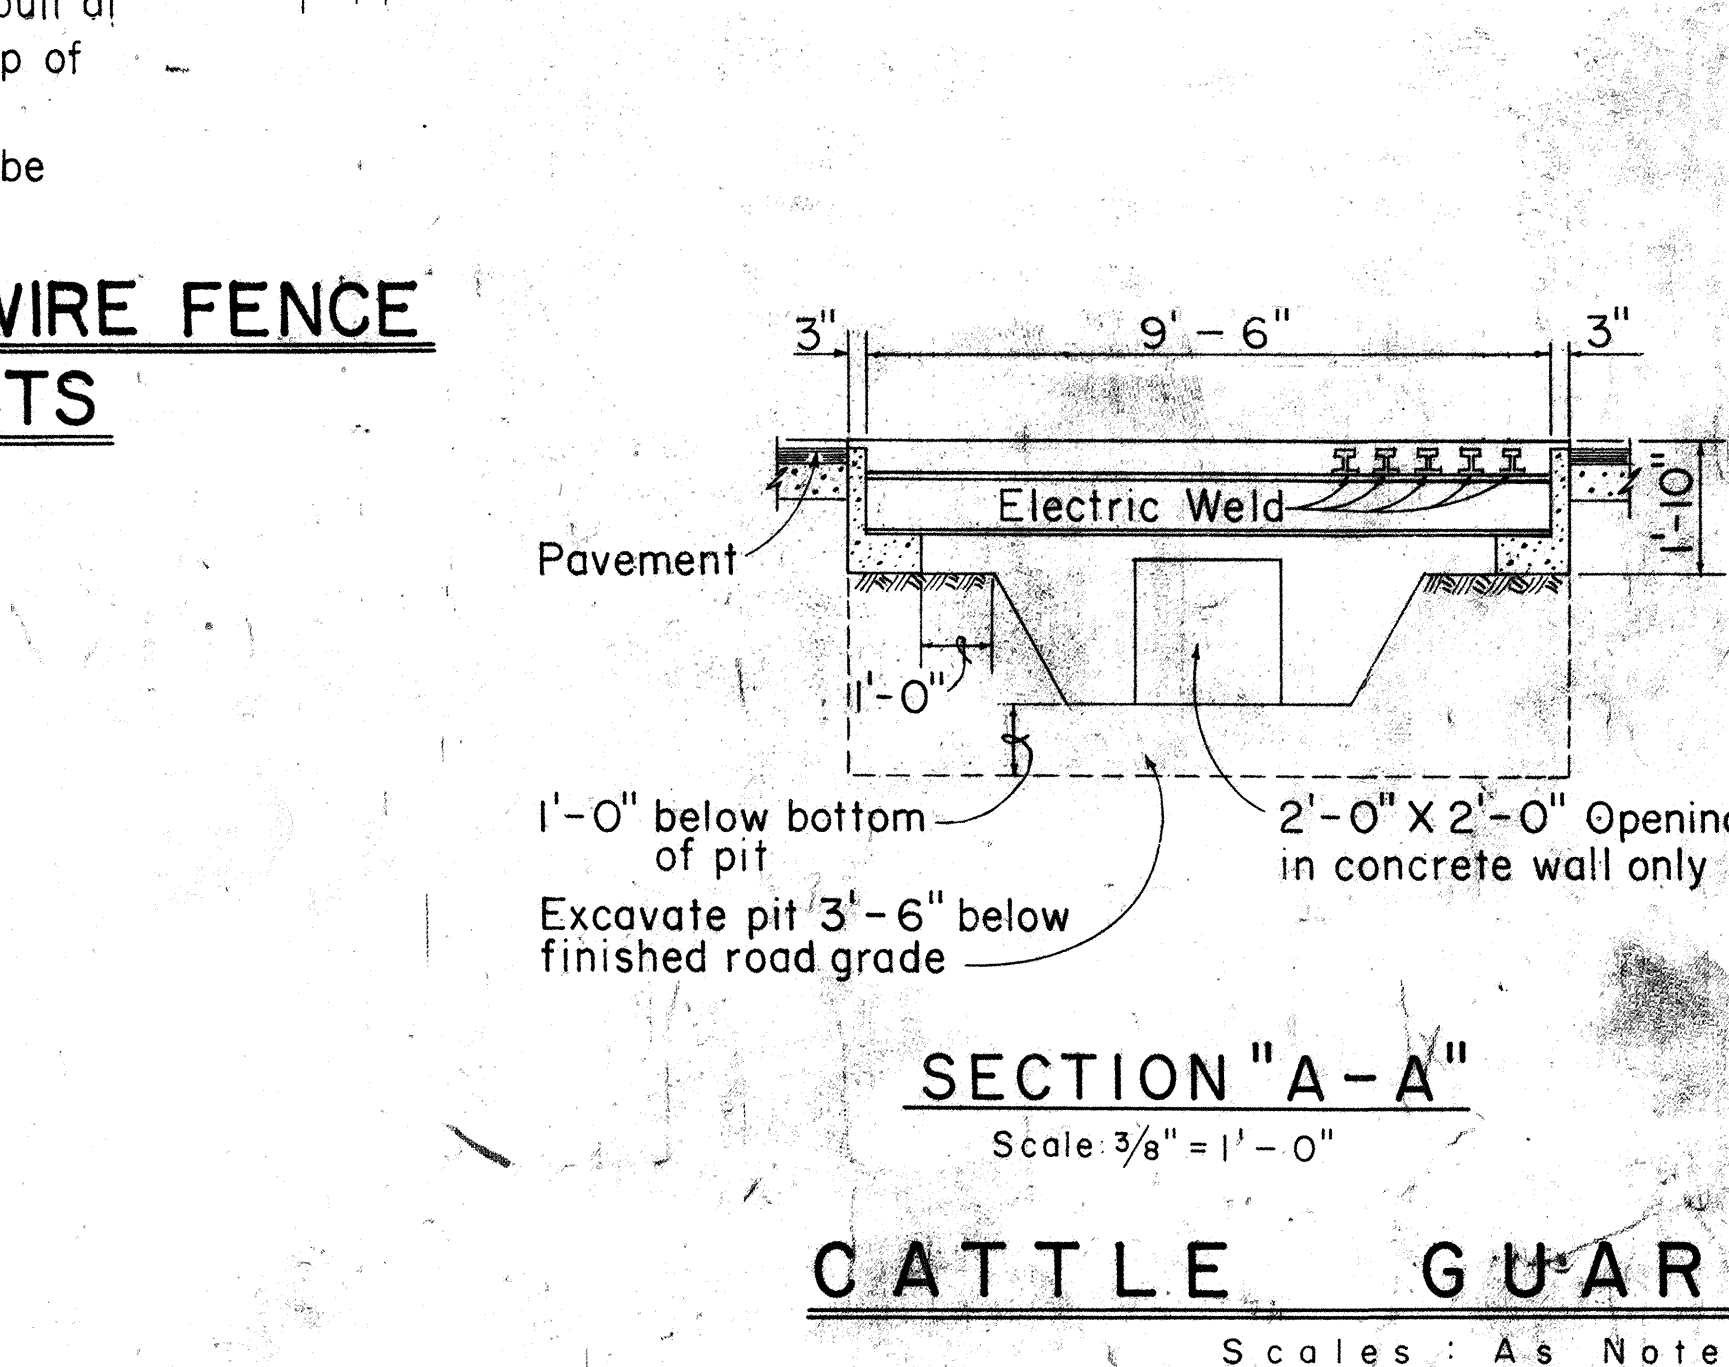
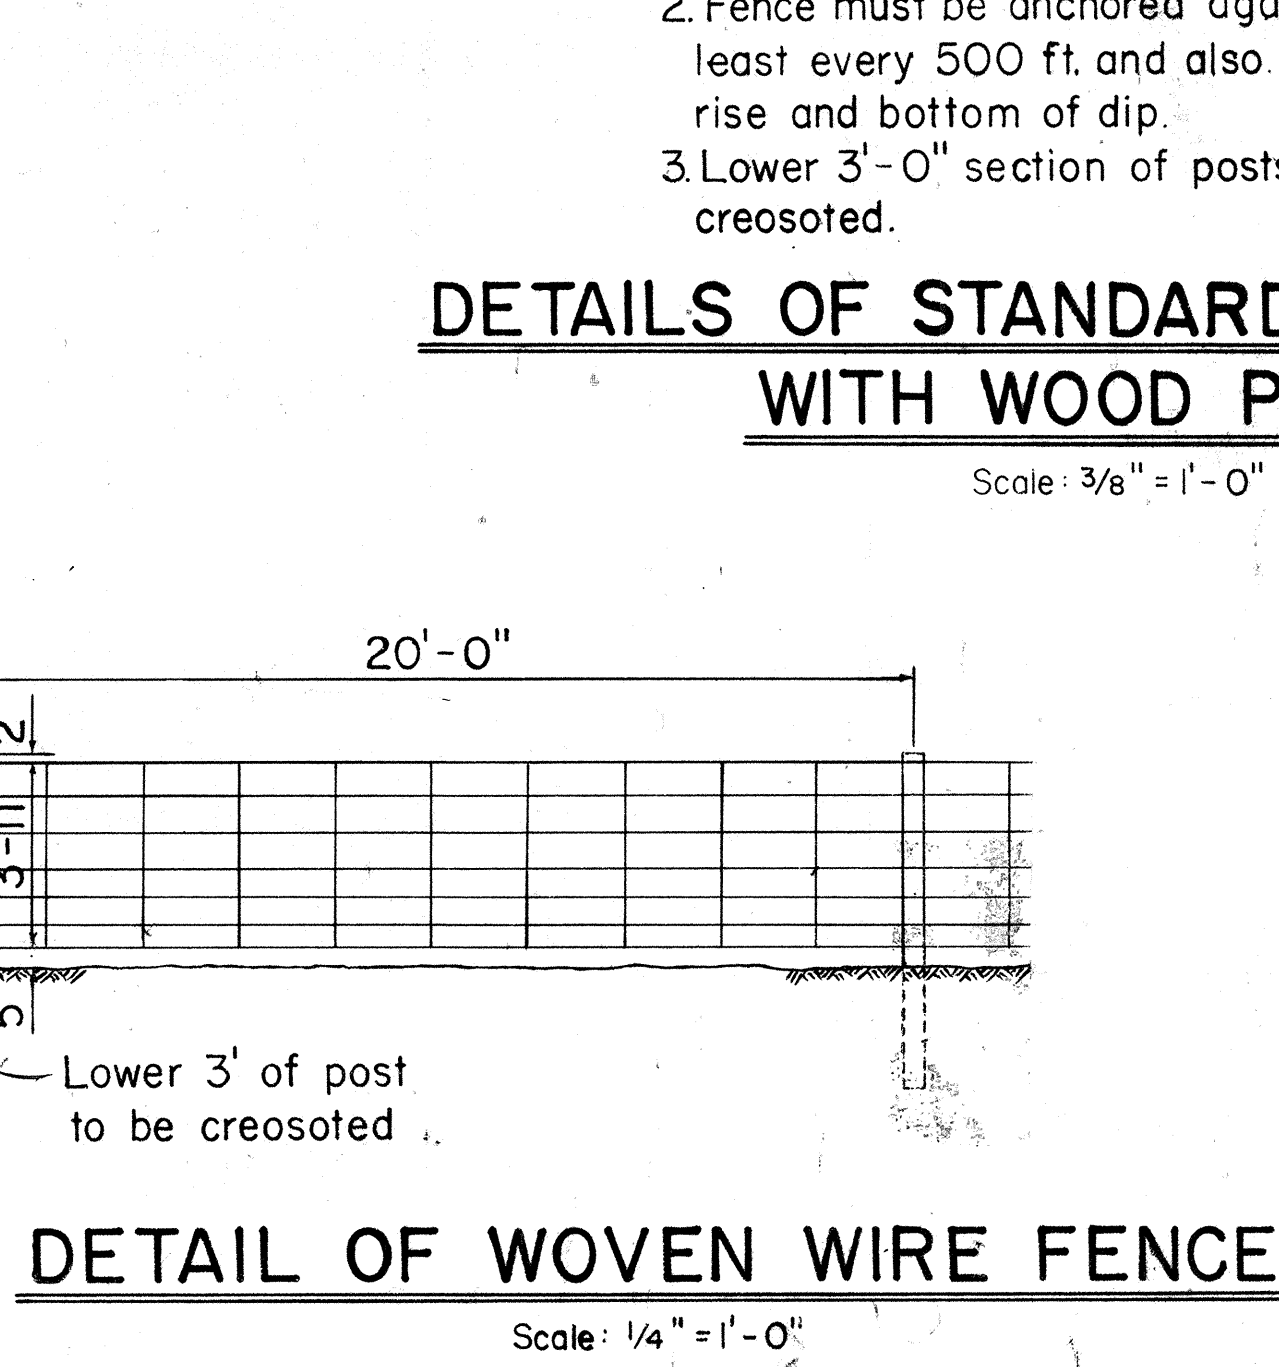
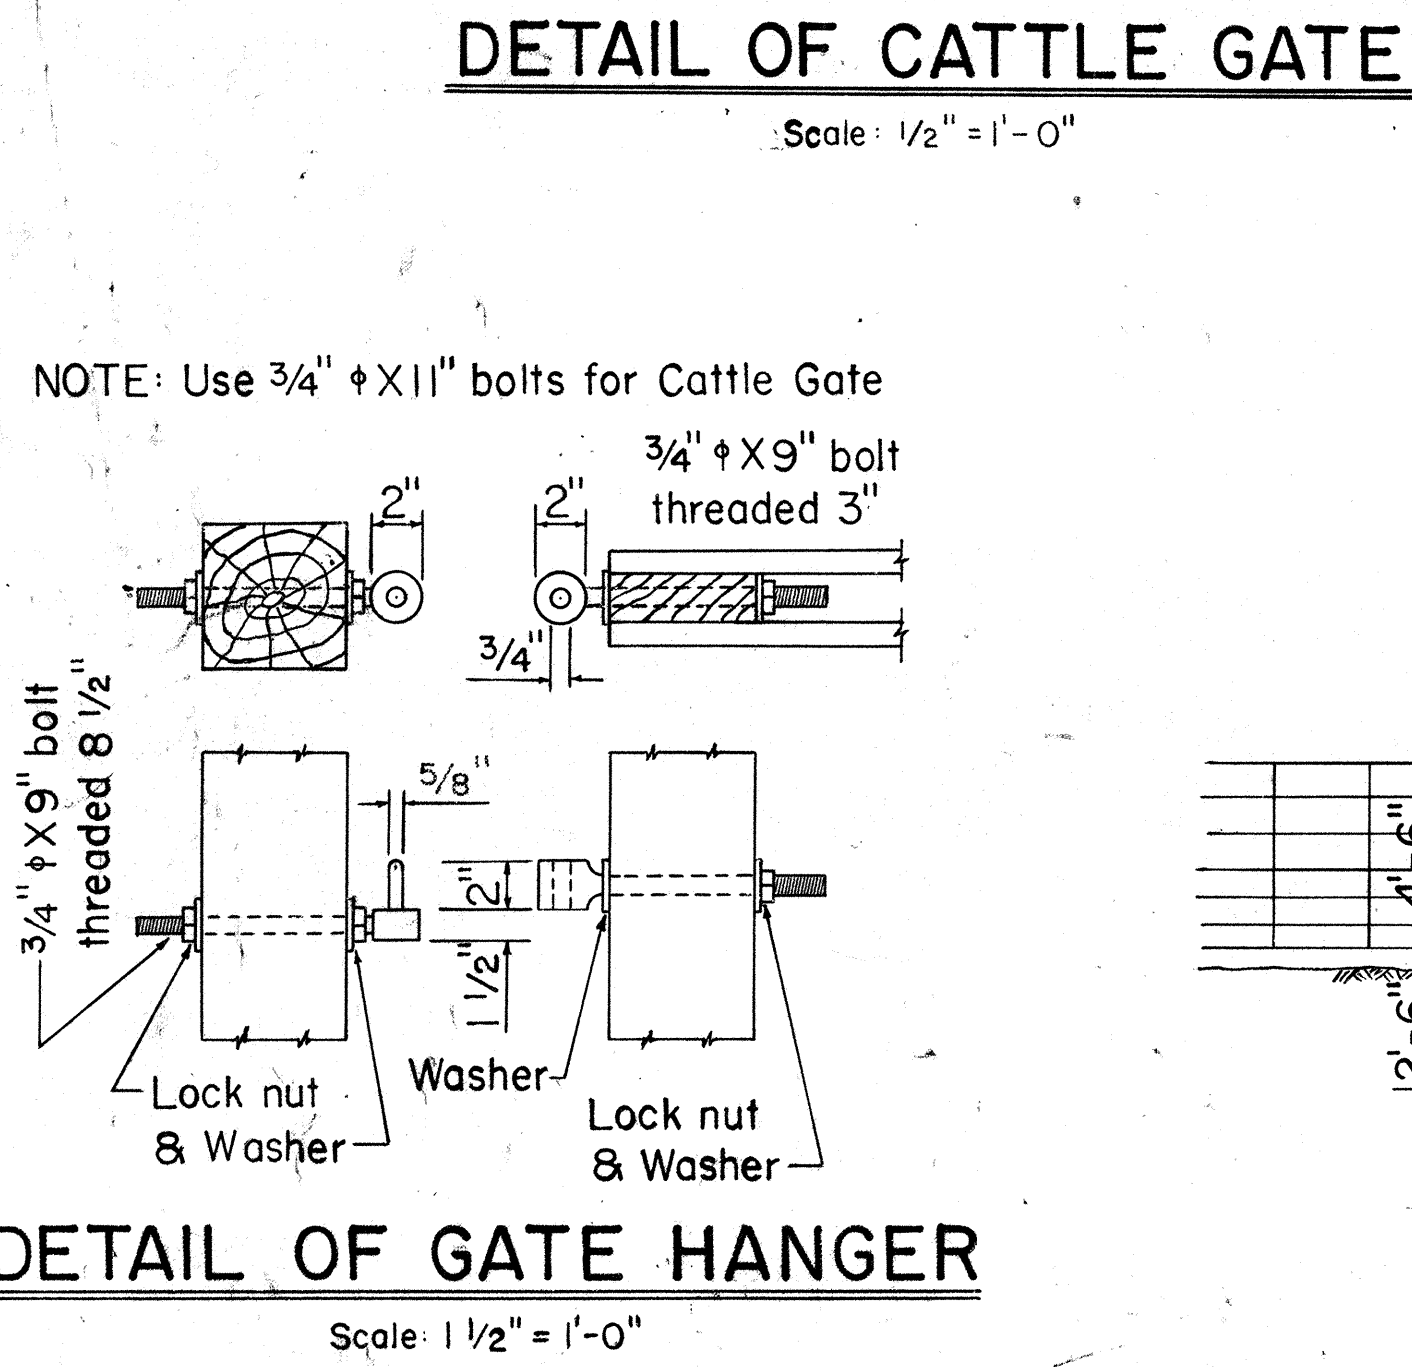
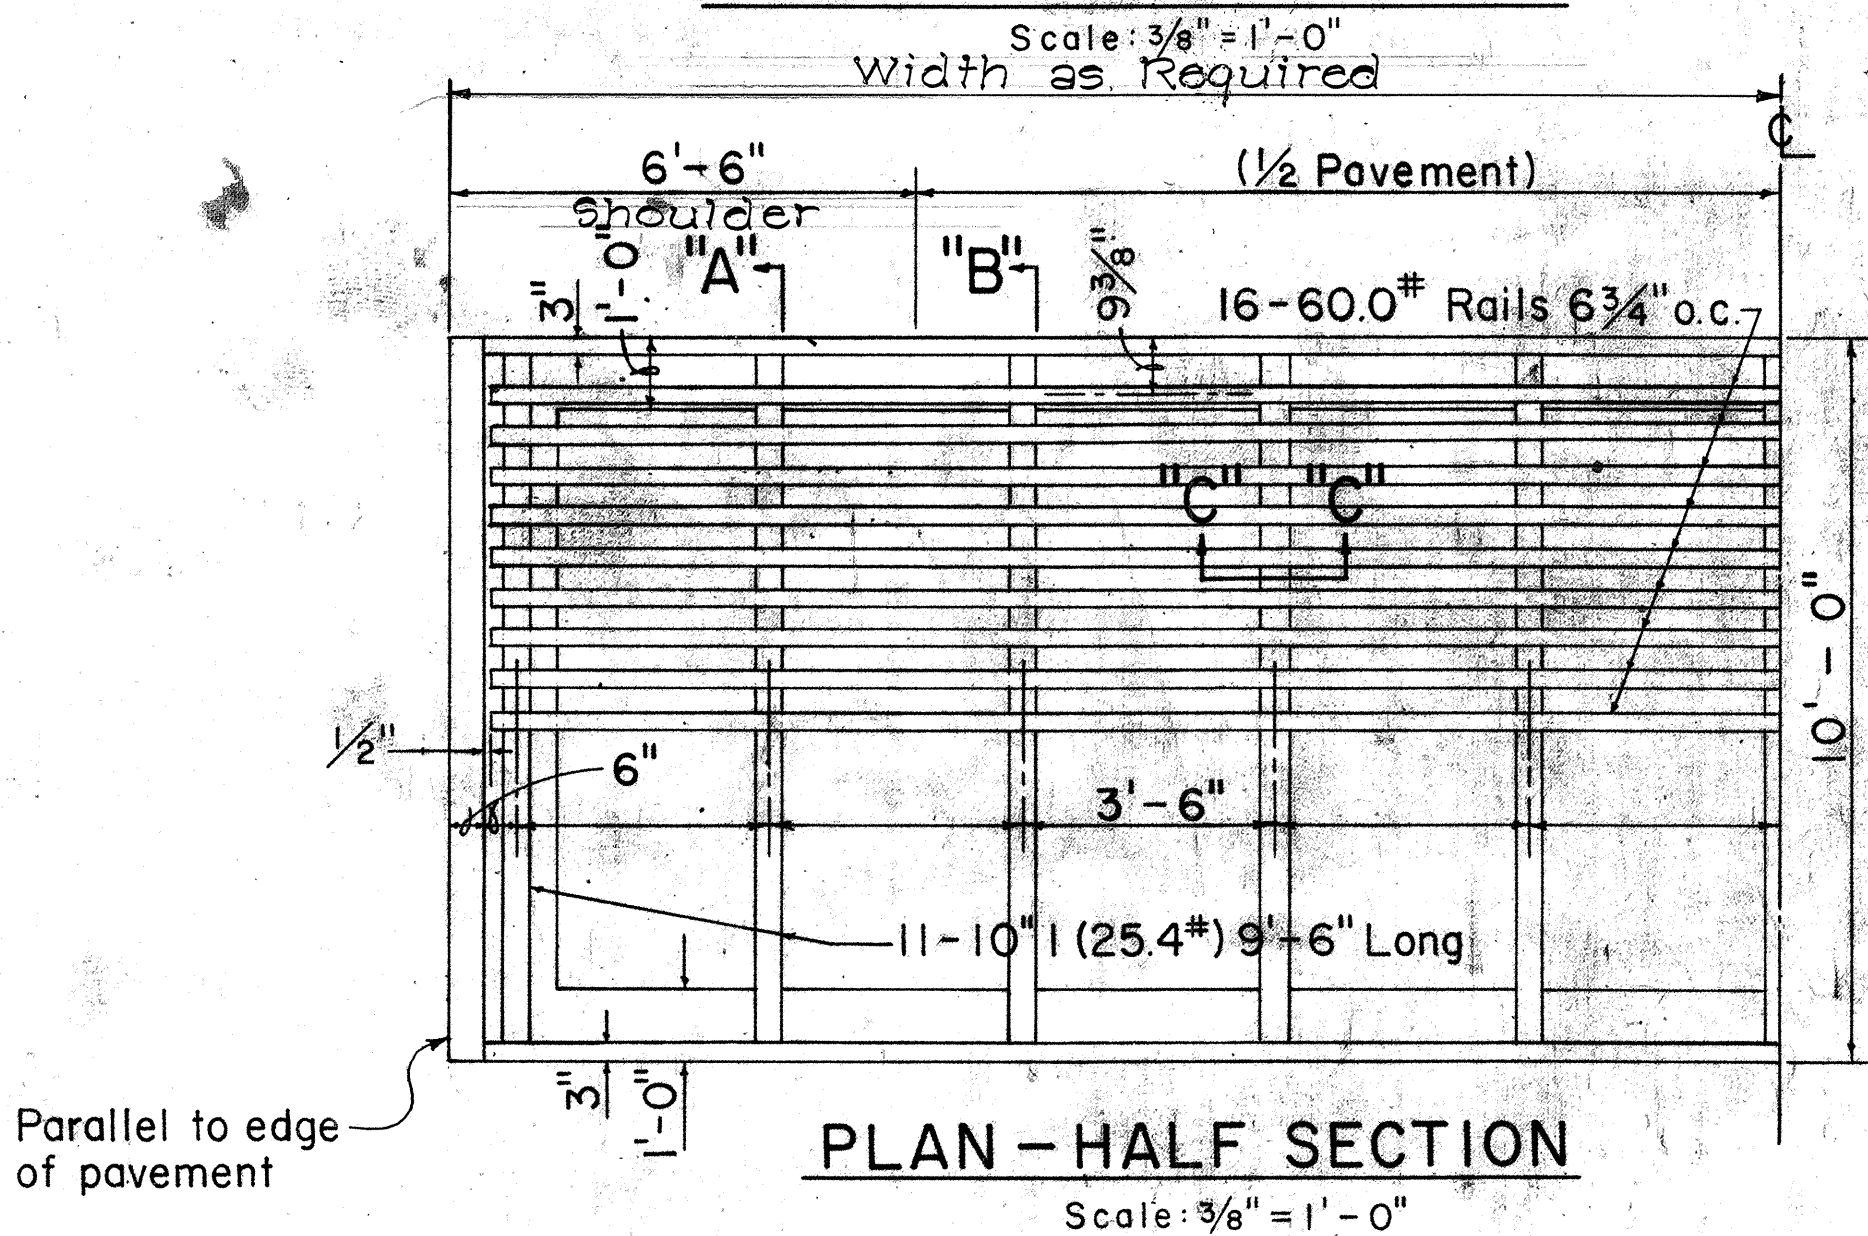
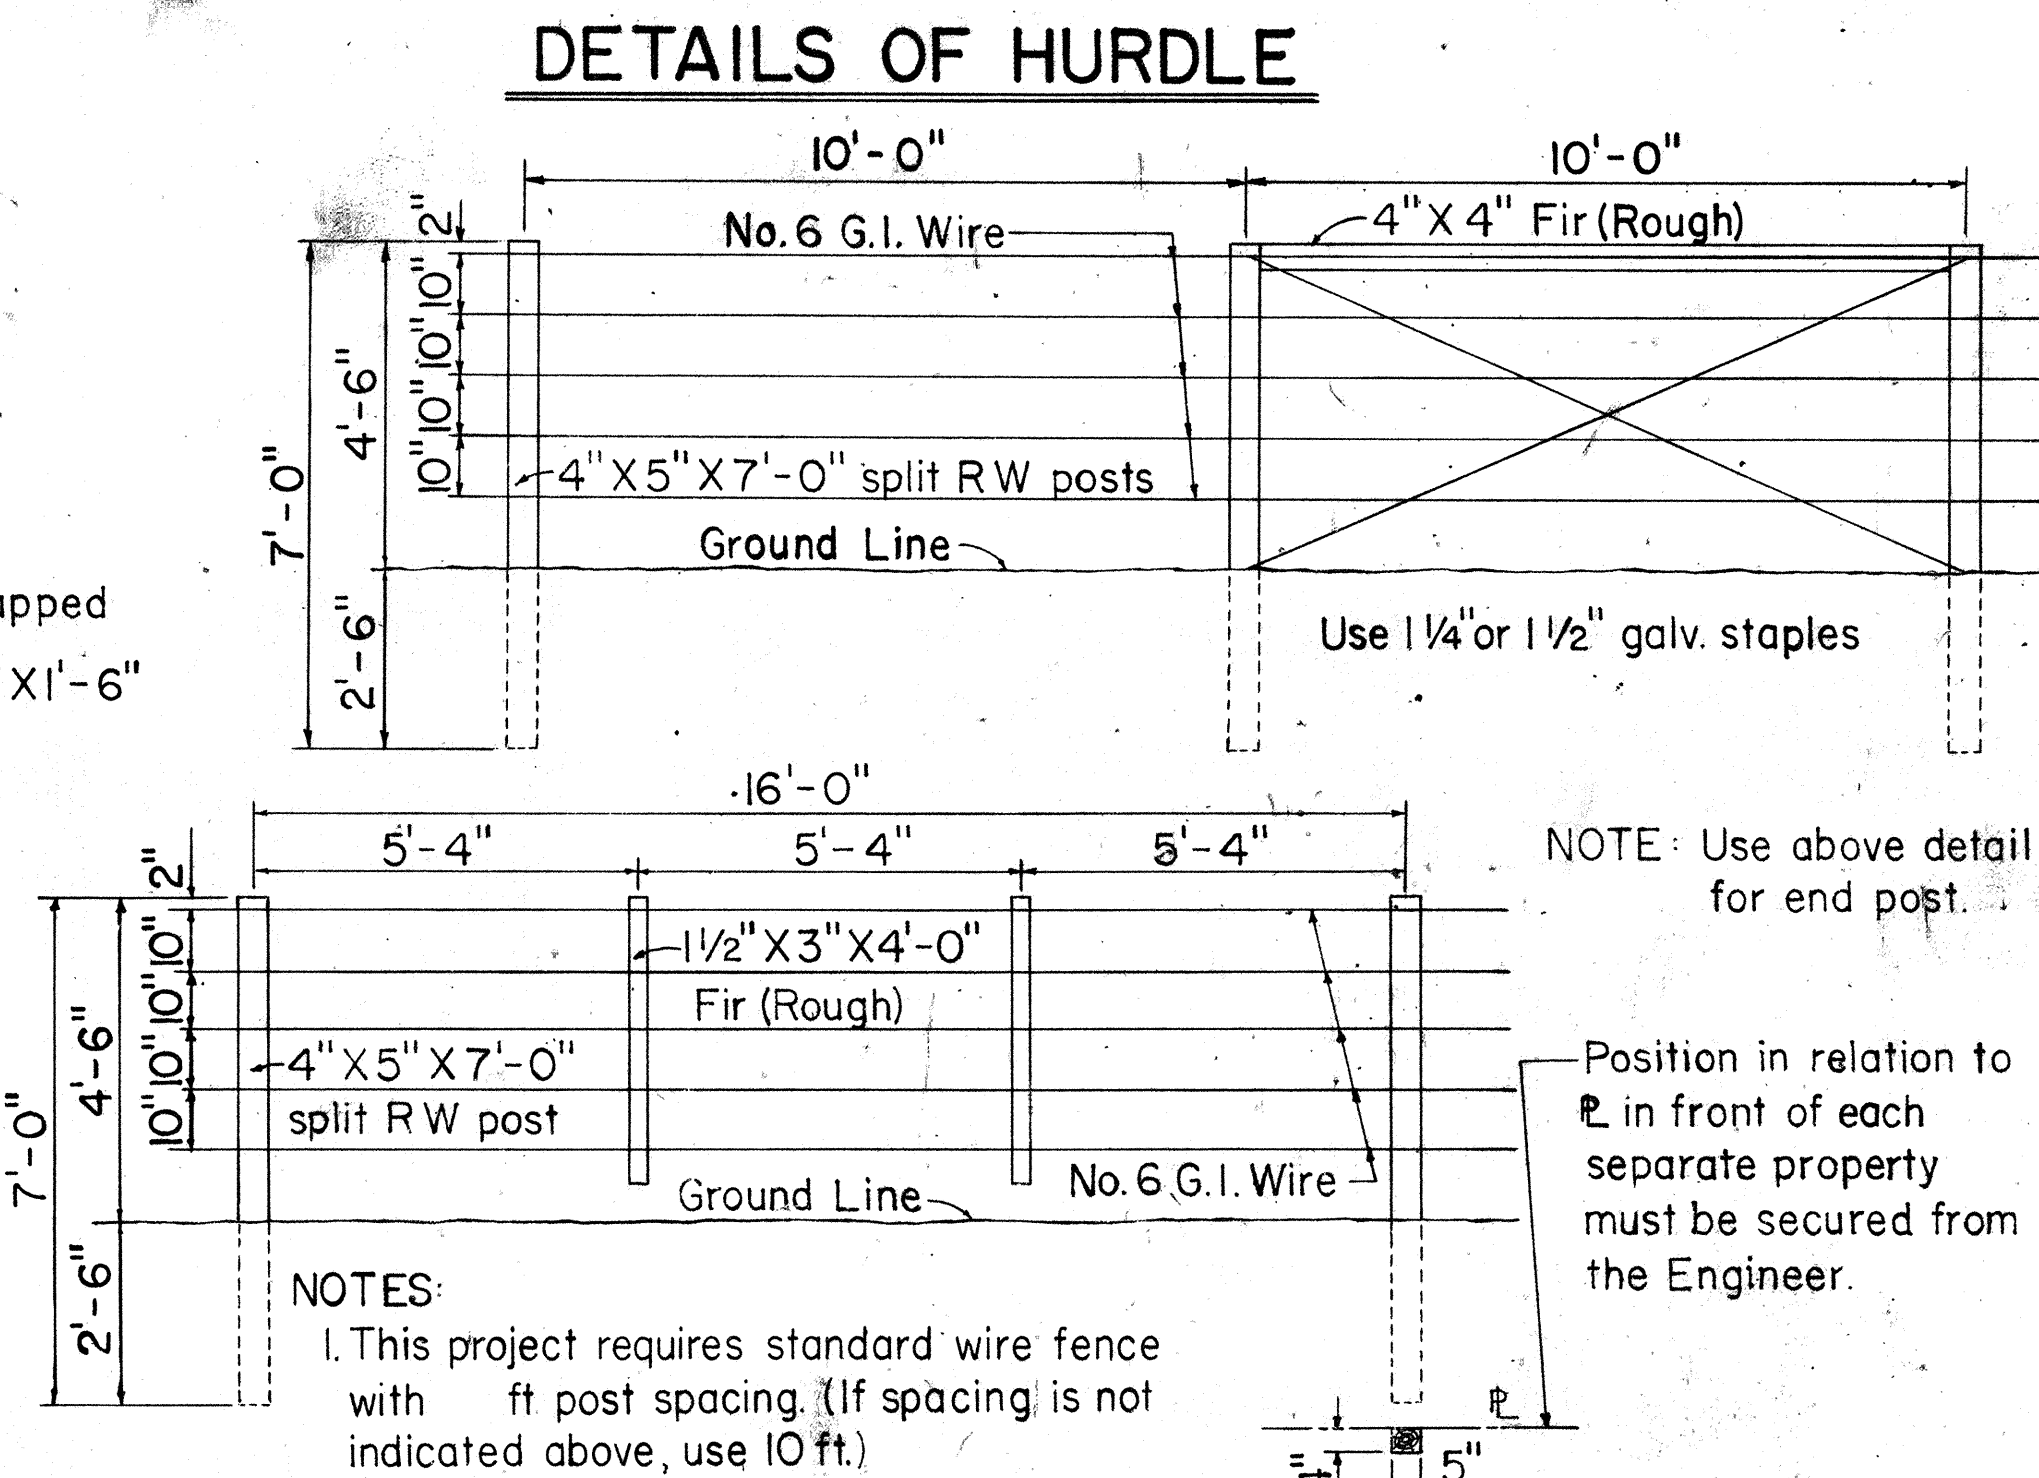
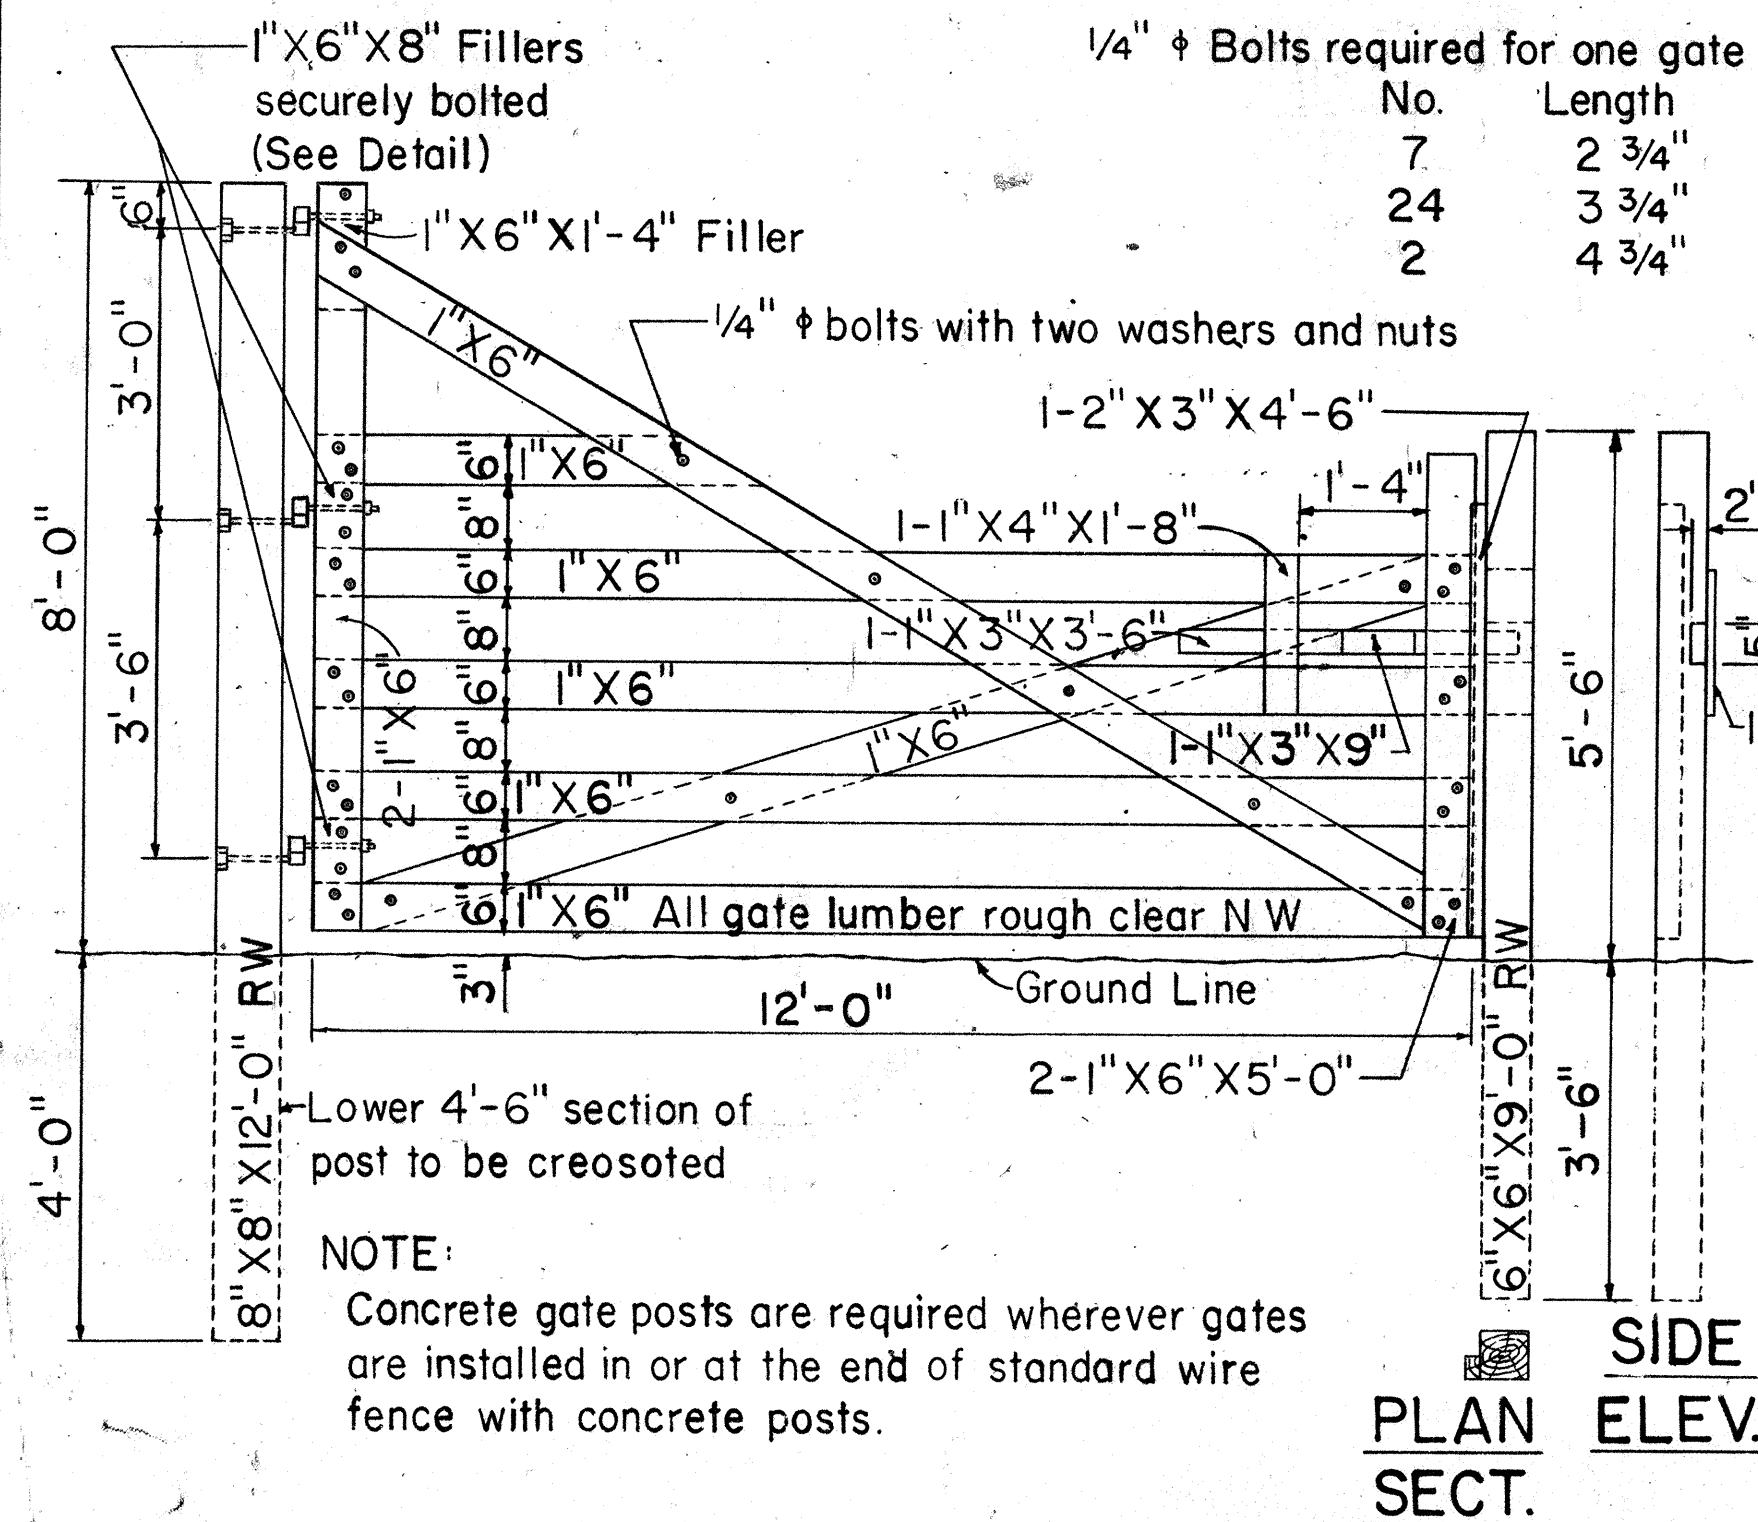
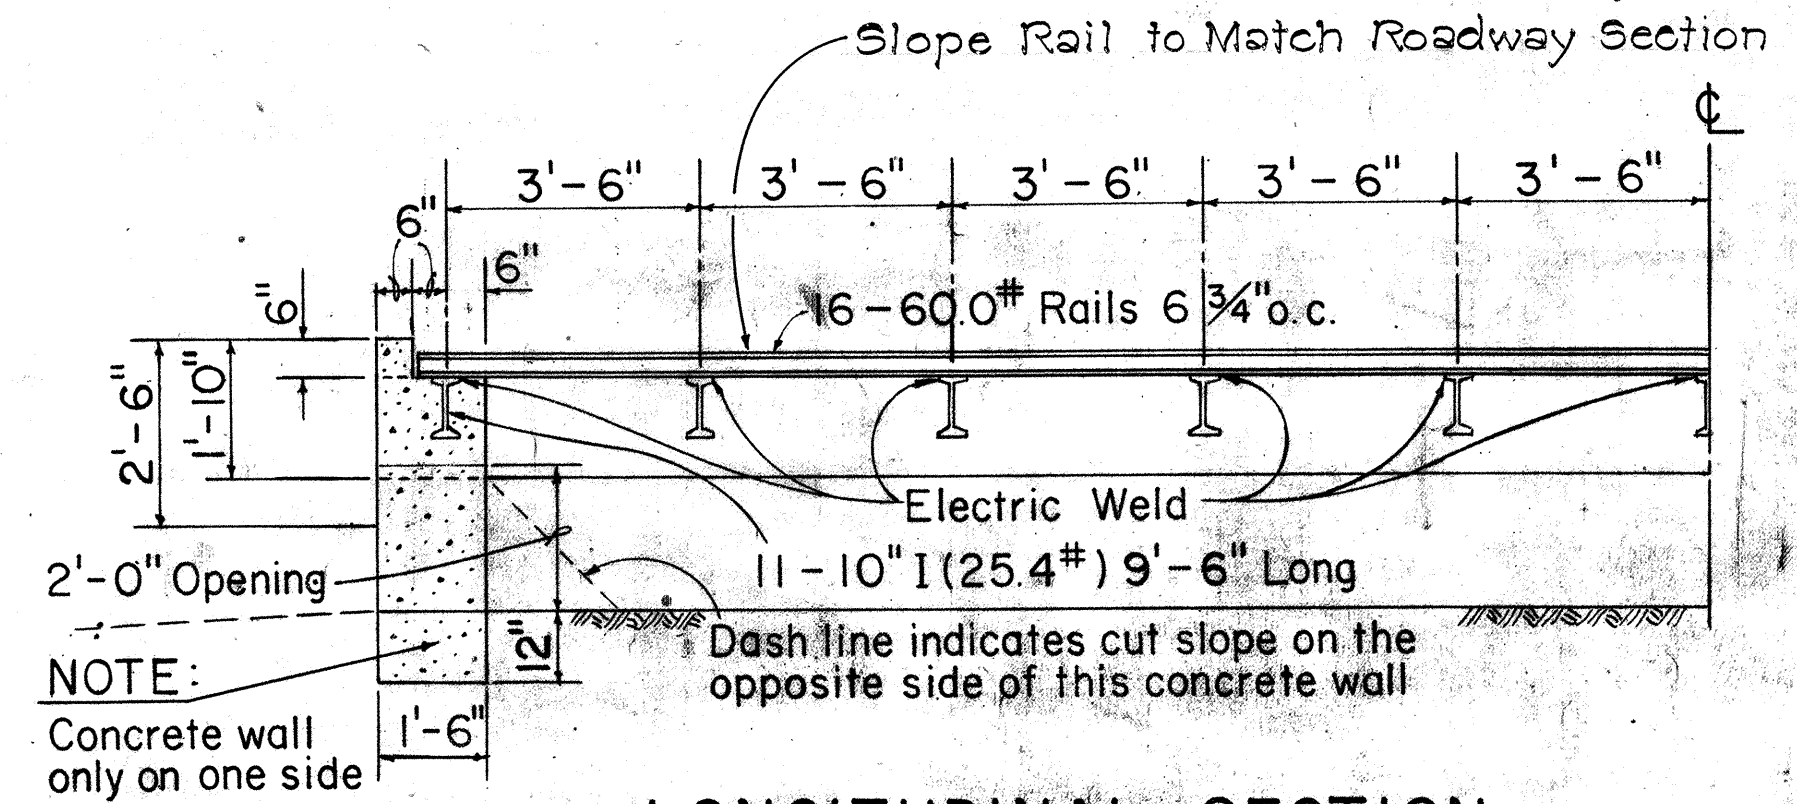
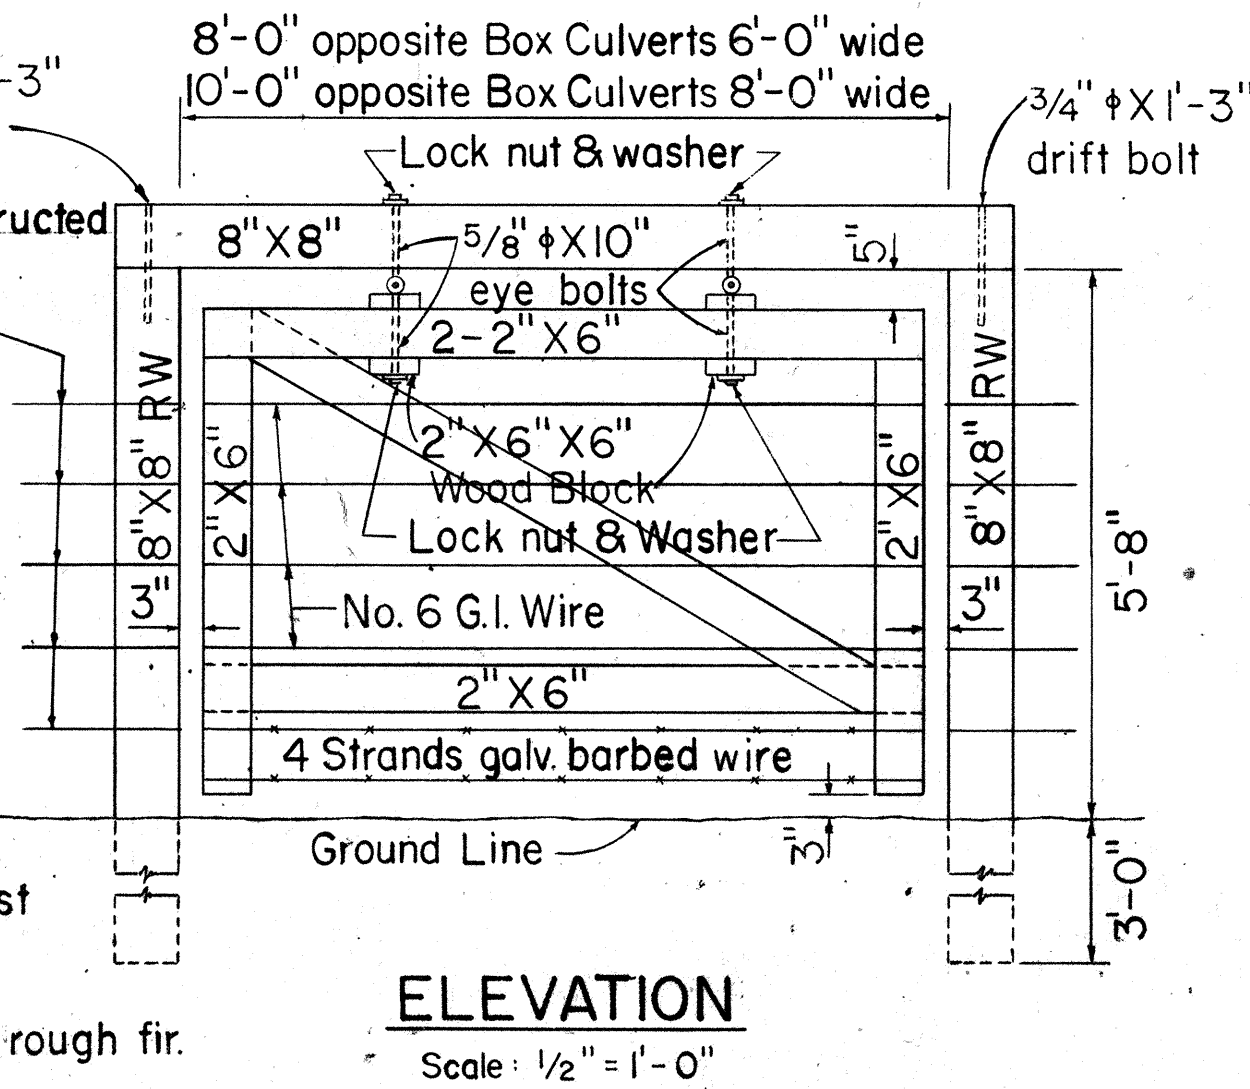
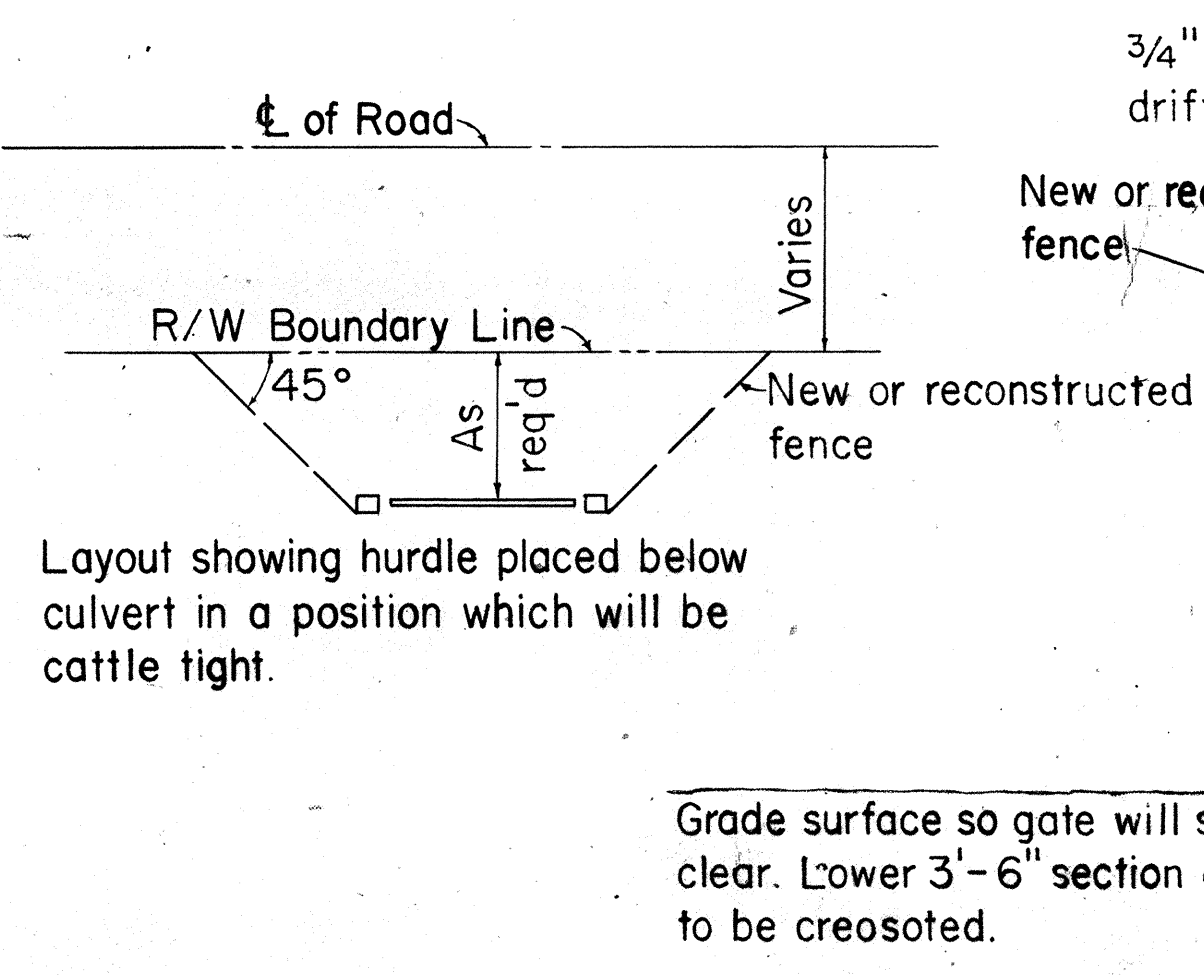


FED. ROAD DIST. NO.	STATE	FED. AID PROJ. NO.	FISCAL YEAR	SHEET NO.	TOTAL SHEETS
HAWAII	HAW.	F-011-2(11)	1973	15	87

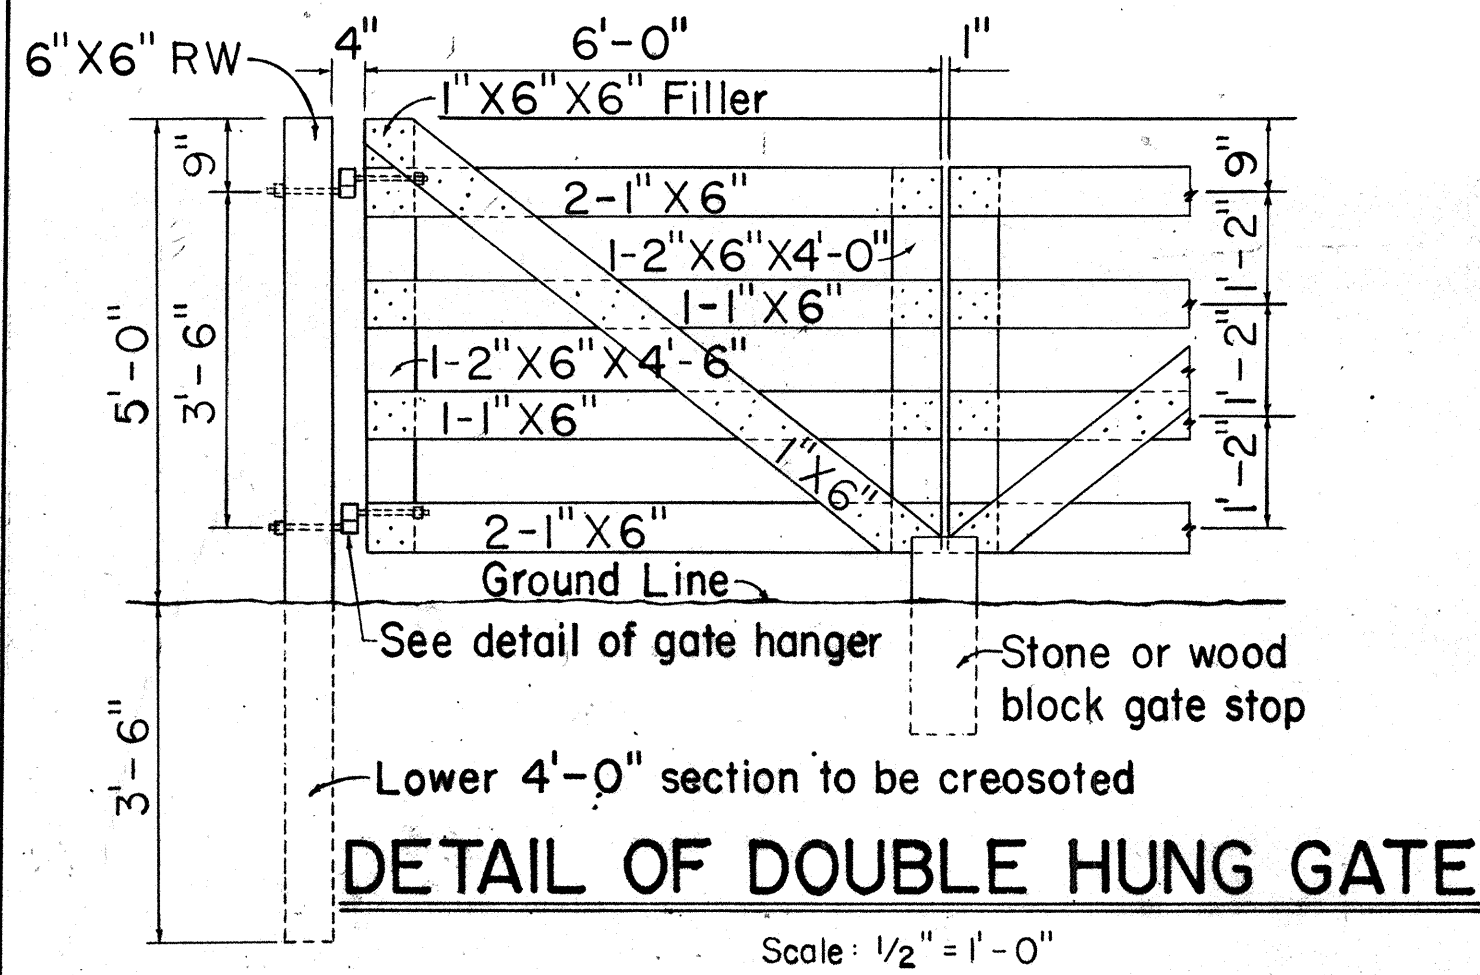

STATE OF HAWAII
DEPARTMENT OF TRANSPORTATION
HIGHWAYS DIVISION



MISCELLANEOUS DETAILS

VOLCANO ROAD
29 MILE POST TO 26 MILE POST
F.A.P. PROJ. NO. F-011-2(11)

Scales: As Noted Date:

SHEET No. 1 OF 1 SHEETS

FED. ROAD DIST. NO.	STATE	FED. AID PROJ. NO.	FISCAL YEAR	SHEET NO.	TOTAL SHEETS
HAWAII	HAW.	F-011-2(11)	1973		

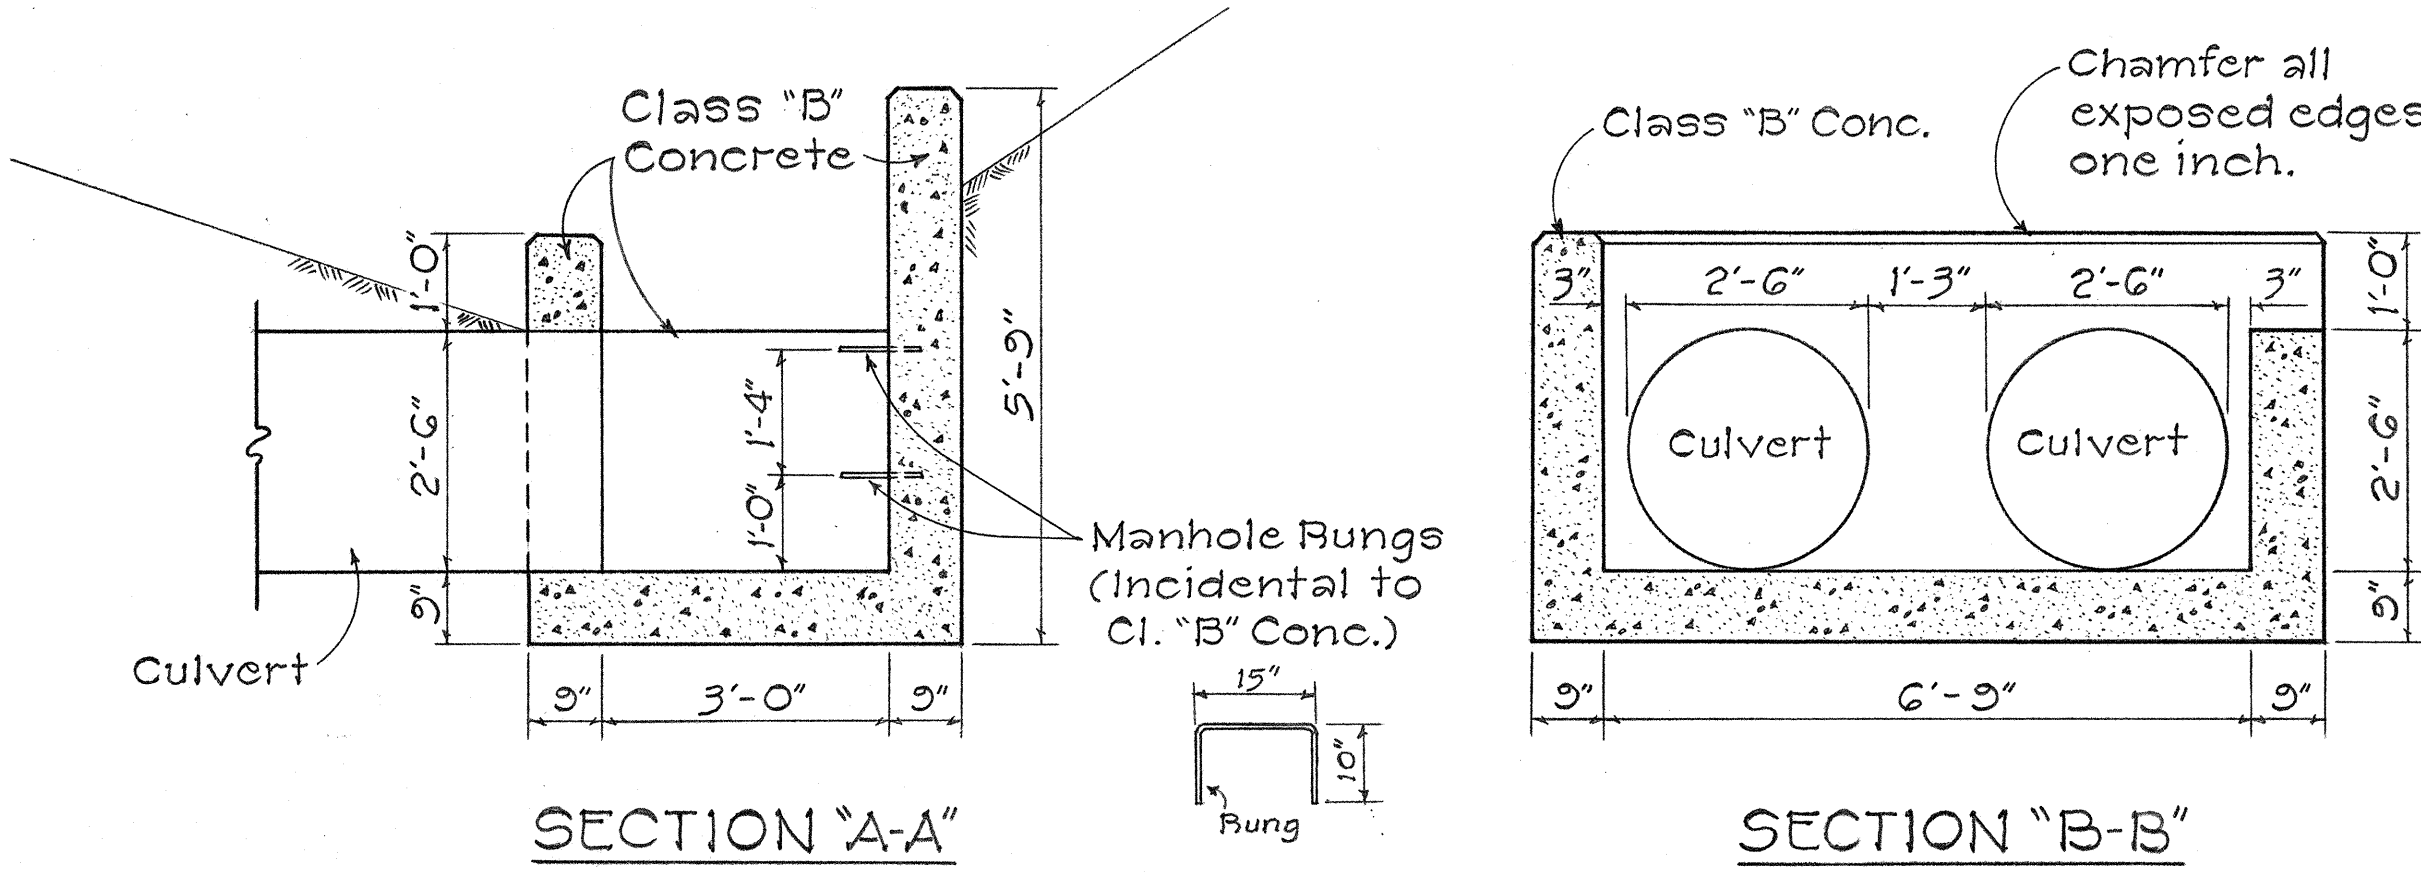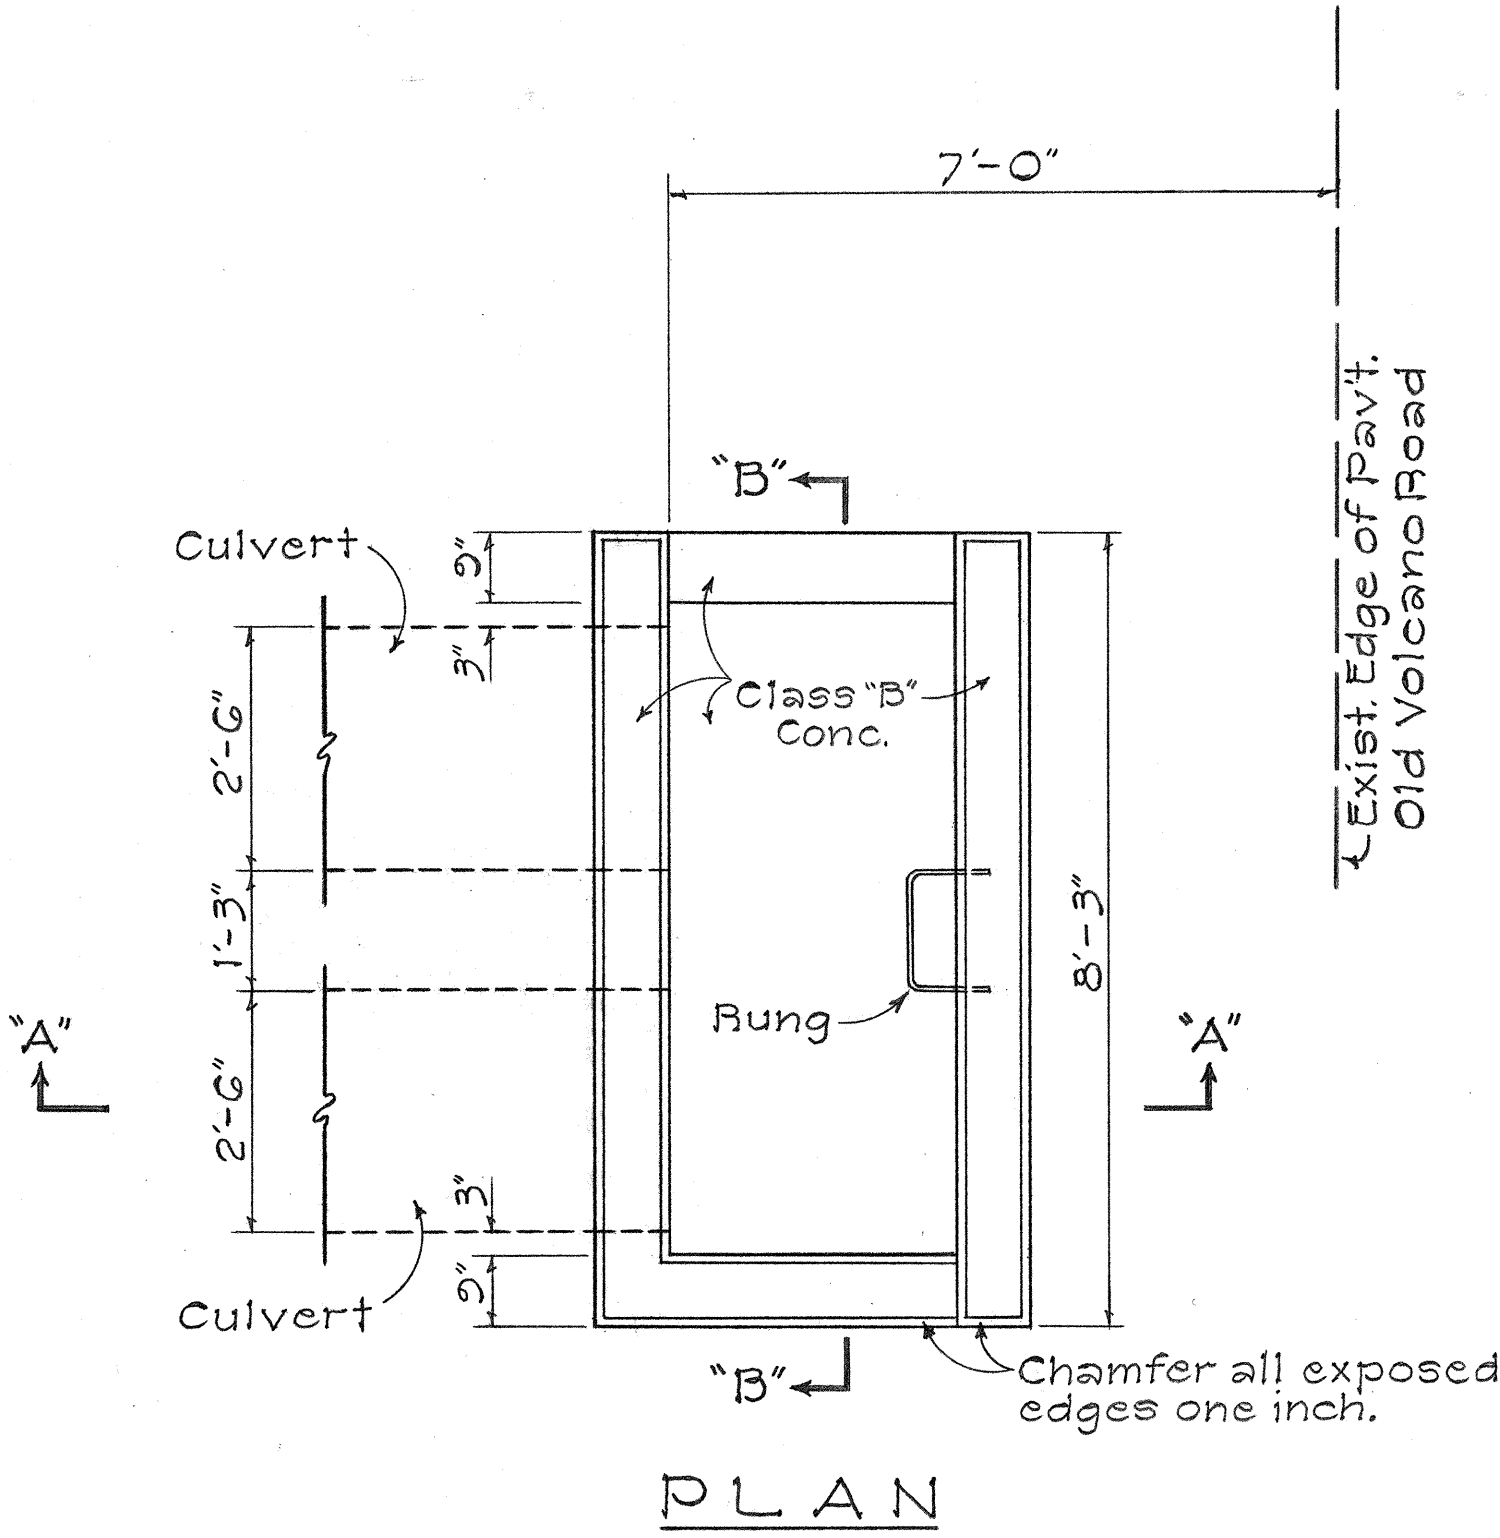

DETAIL OF CONCRETE DROP INTAKE AT STA. 188+00 Lt.
 Scale: 1/2" = 1'-0"

ORIGINAL PLAN	DATE
DESIGNED BY	
NOTED BY	
CHECKED BY	
IN CHARGE	

CONTRACT CHANGE ORDER No. 6

STATE OF HAWAII
 DEPARTMENT OF TRANSPORTATION
 HIGHWAYS DIVISION

MISCELLANEOUS DETAILS
 VOLCANO ROAD
 29 Mile Post to 26 Mile Post
 FAP Project No. F-011-2(11)

Scale: As Noted Date: July 1974

SHEET No. OF SHEETS

15A

7/24/74 16 pages 3 prints