



| FED. ROAD DIST. NO. | STATE | FED. AID PROJ. NO. | FISCAL YEAR | SHEET NO. | TOTAL SHEETS |
|---------------------|-------|--------------------|-------------|-----------|--------------|
| HAWAII              | HAW.  | F-R-E-011-2(13)    | 1975        | 56a       | 126          |

NOTE:  
The Contractor shall verify the locations and depths of the existing 8" fuel line where connections and/or lowering are required.

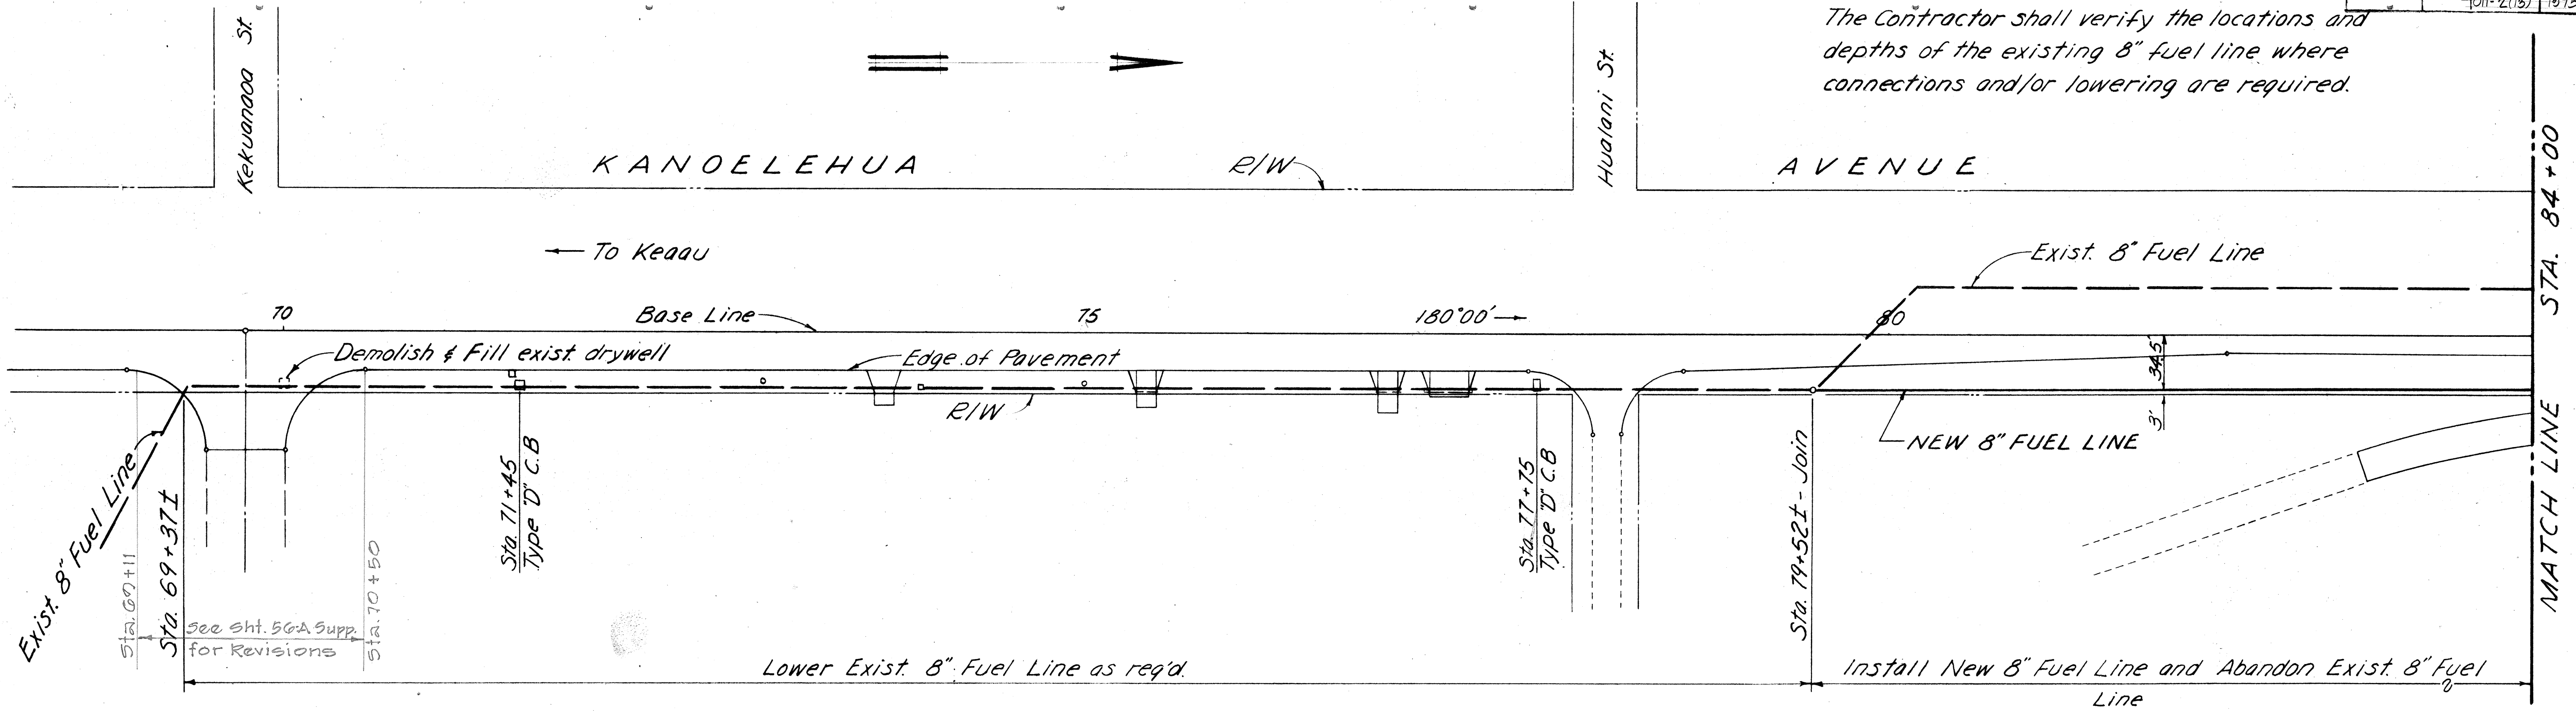


PLAN  
Scale: 1" = 50'

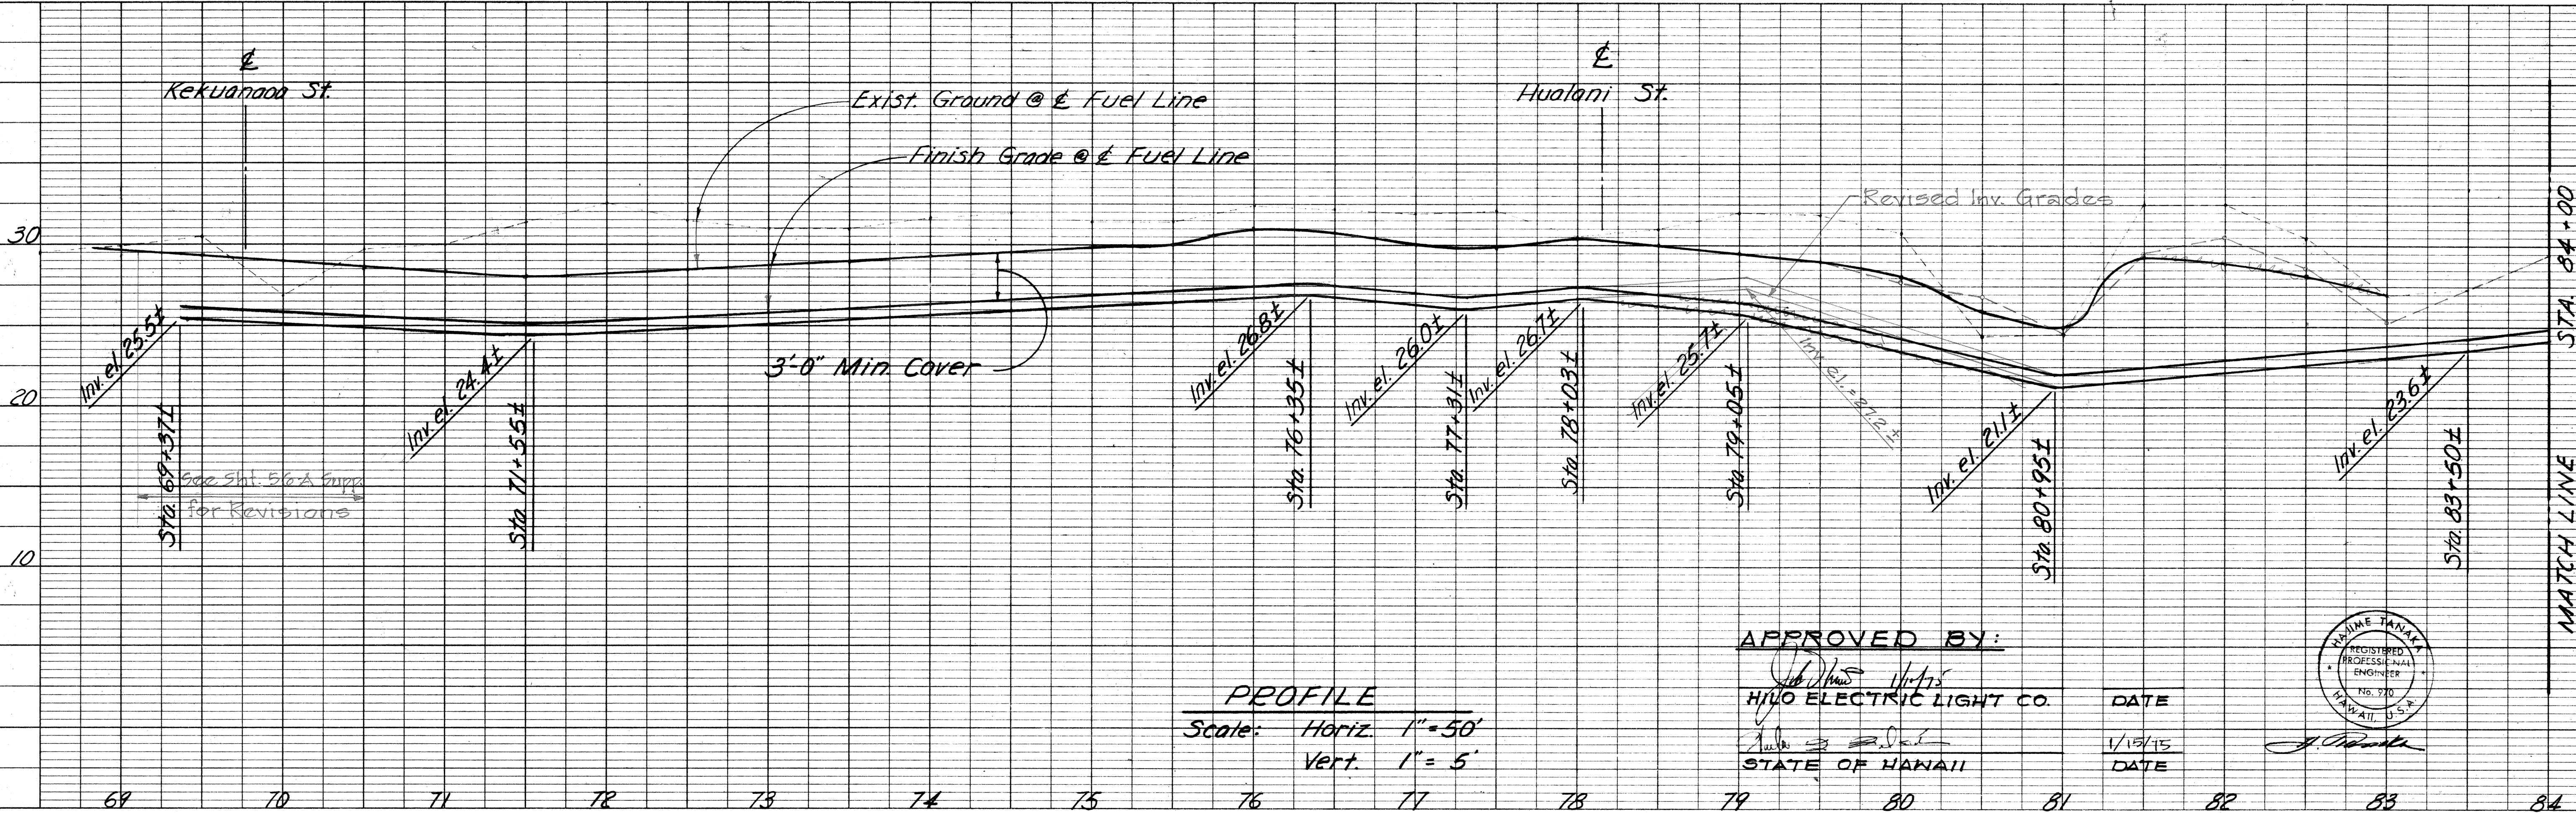

PROFILE  
Scale: Horiz. 1" = 50'  
Vert. 1" = 5'

APPROVED BY:  
*[Signature]*  
HILO ELECTRIC LIGHT CO.  
STATE OF HAWAII


DATE  
1/15/15  
DATE

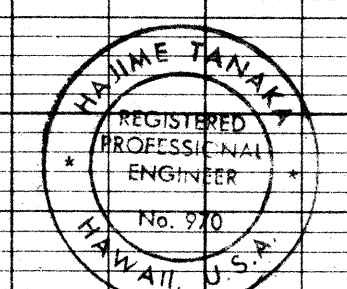



|      |                                         |                           |                 |
|------|-----------------------------------------|---------------------------|-----------------|
| PLAN | SURVEYED<br>PLOTTED<br>NOTE BOOK<br>NO. | BY<br>A. MARIAMUEL (CHGO) | DATE<br>1/22/71 |
|      | NOTED<br>CHECKED<br>FIT. OF WAY CHECKED |                           |                 |


NOTE:  
 1) In the area of the exposing the existing fuel line, the lower limit of structure excavation shall be the bottom of the existing pipe.  
 2) The Contractor shall coordinate their backfilling operation with HELCO, and the State.

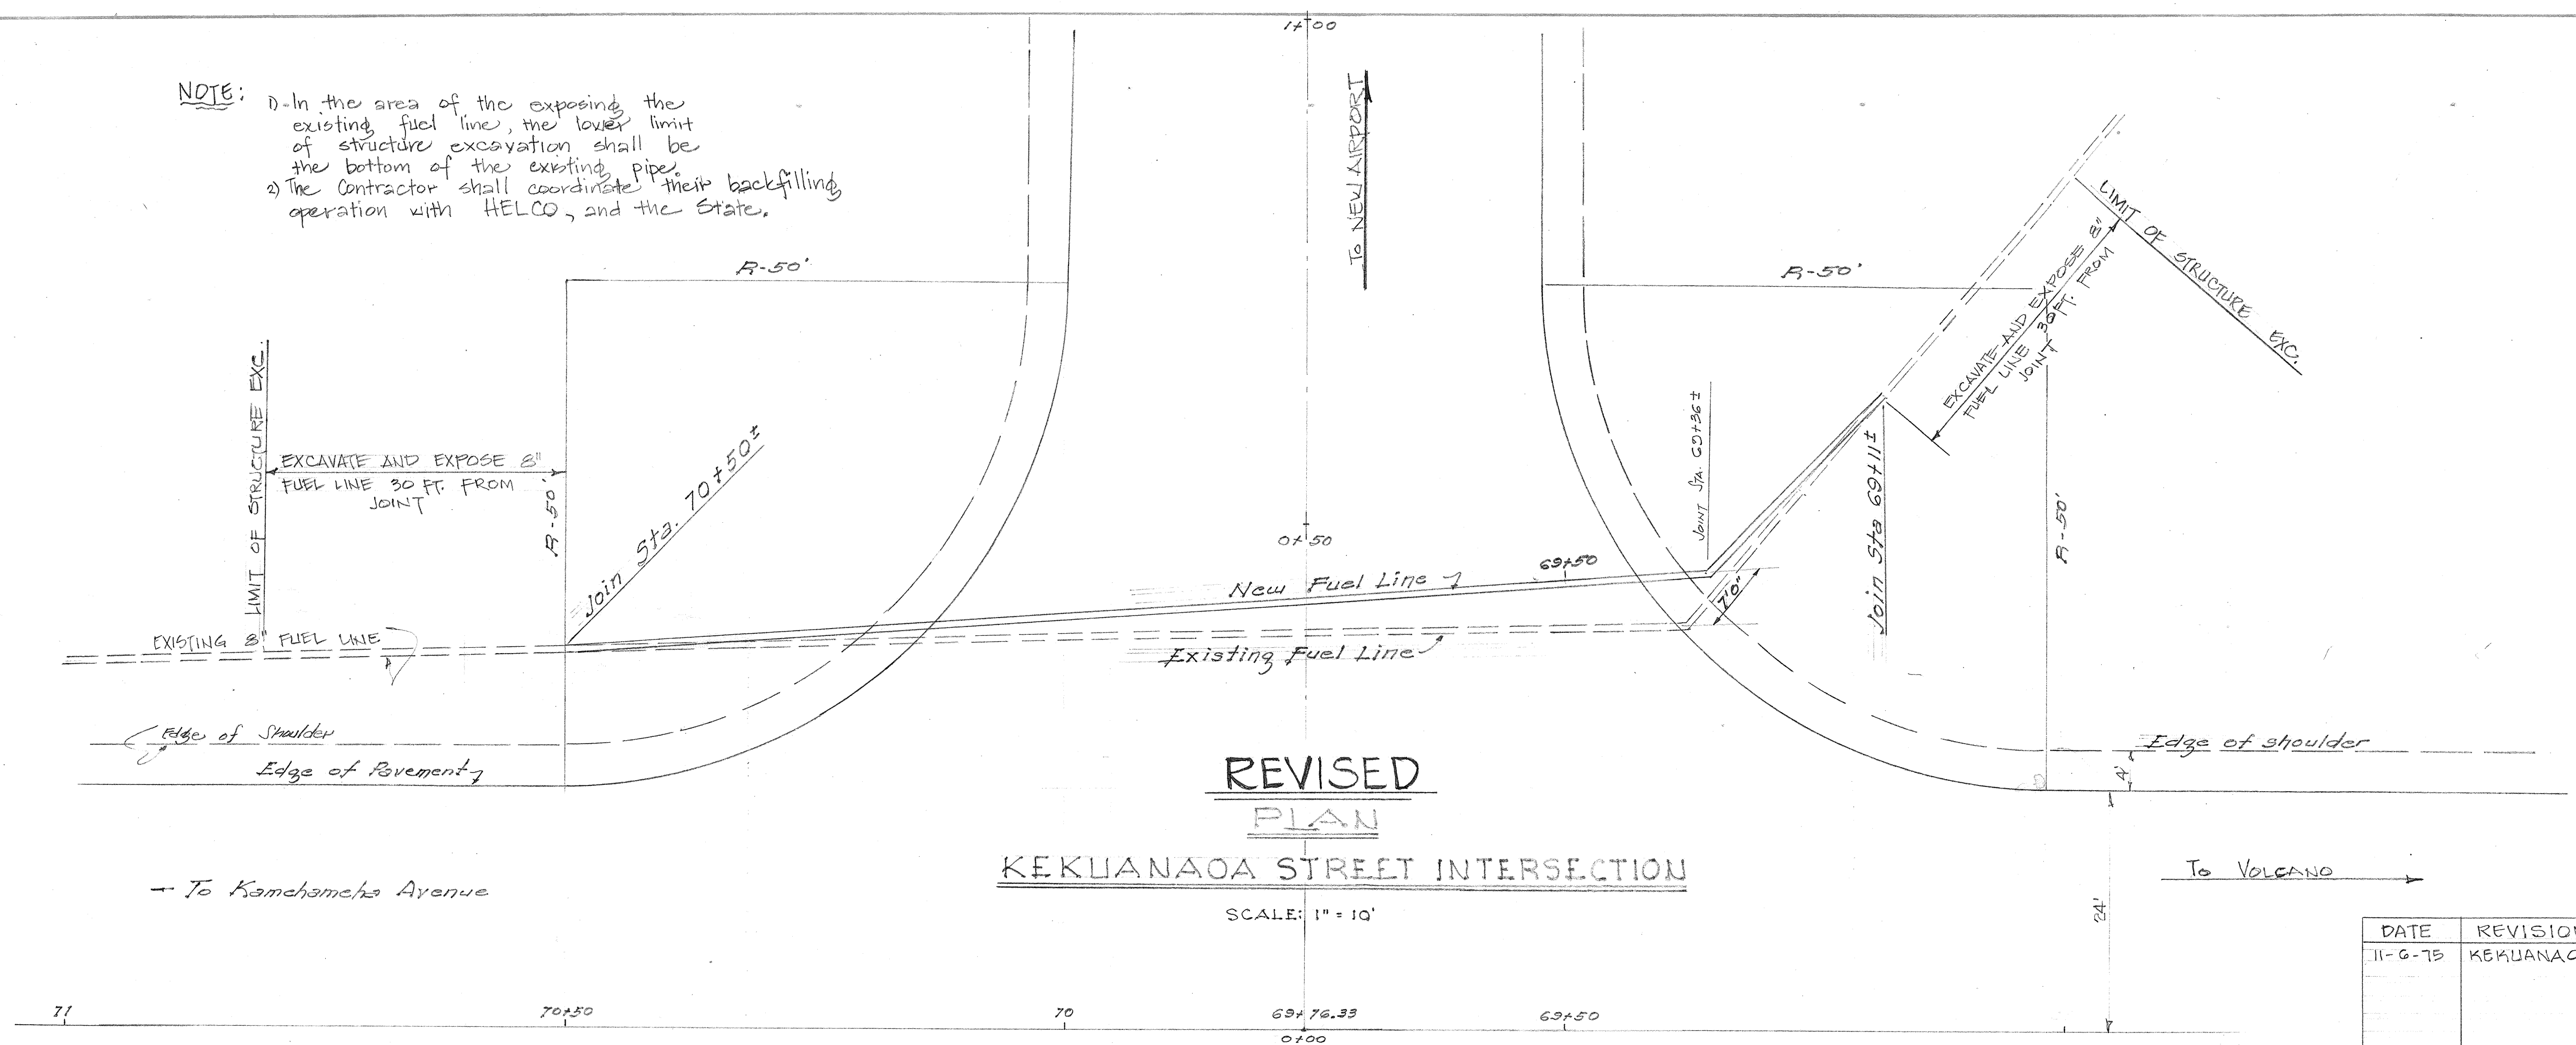

**REVISED PLAN**  
 KEKUANAOA STREET INTERSECTION  
 SCALE: 1" = 10'

| DATE    | REVISION           | REMARKS           |
|---------|--------------------|-------------------|
| 11-6-75 | KEKUANAOA ST. INT. | SUPP TO SHEET 56A |

|         |                                              |                           |                 |
|---------|----------------------------------------------|---------------------------|-----------------|
| PROFILE | SURVEYED<br>PLOTTED<br>NOTE BOOK<br>NO.      | BY<br>A. MARIAMUEL (CHGO) | DATE<br>11-4-75 |
|         | NOTED<br>CHECKED<br>STRUCTURE NOTATIONS CHKO |                           |                 |

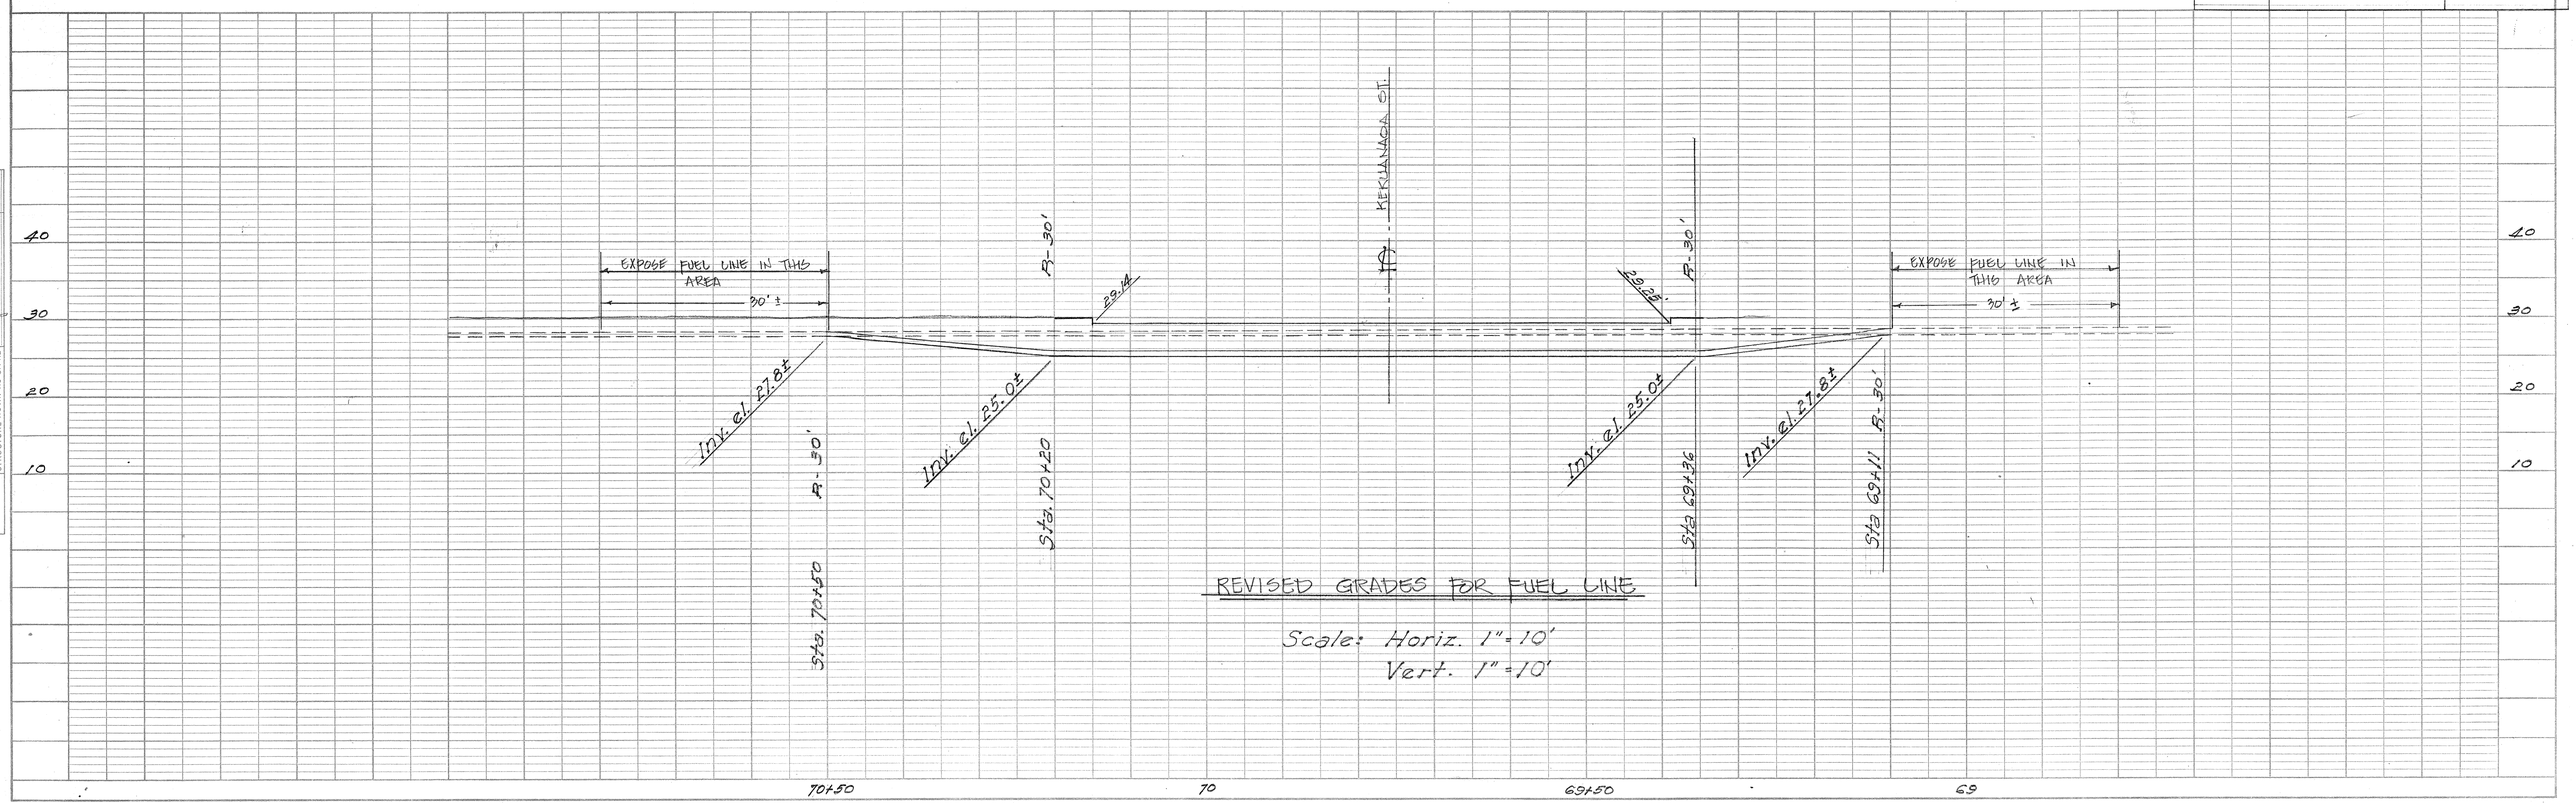


**REVISED GRADES FOR FUEL LINE**  
 Scale: Horiz. 1" = 10'  
 Vert. 1" = 10'




| FED. ROAD DIST. NO. | STATE | FED. AID PROJ. NO. | FISCAL YEAR | SHEET NO. | TOTAL SHEETS |
|---------------------|-------|--------------------|-------------|-----------|--------------|
| HAWAII              | HAW.  | F-188-011-2(13)    | 1975        | 56B       | 120          |

| PLAN    | DATE | BY |
|---------|------|----|
| NO. 1   |      |    |
| NO. 2   |      |    |
| NO. 3   |      |    |
| NO. 4   |      |    |
| NO. 5   |      |    |
| NO. 6   |      |    |
| NO. 7   |      |    |
| NO. 8   |      |    |
| NO. 9   |      |    |
| NO. 10  |      |    |
| NO. 11  |      |    |
| NO. 12  |      |    |
| NO. 99  |      |    |
| NO. 100 |      |    |
| NO. 101 |      |    |
| NO. 102 |      |    |
| NO. 103 |      |    |
| NO. 104 |      |    |
| NO. 105 |      |    |
| NO. 106 |      |    |
| NO. 107 |      |    |
| NO. 108 |      |    |
| NO. 109 |      |    |
| NO. 110 |      |    |
| NO. 111 |      |    |
| NO. 112 |      |    |
| NO. 113 |      |    |
| NO. 114 |      |    |
| NO. 115 |      |    |
| NO. 116 |      |    |
| NO. 117 |      |    |
| NO. 118 |      |    |
| NO. 119 |      |    |
| NO. 120 |      |    |

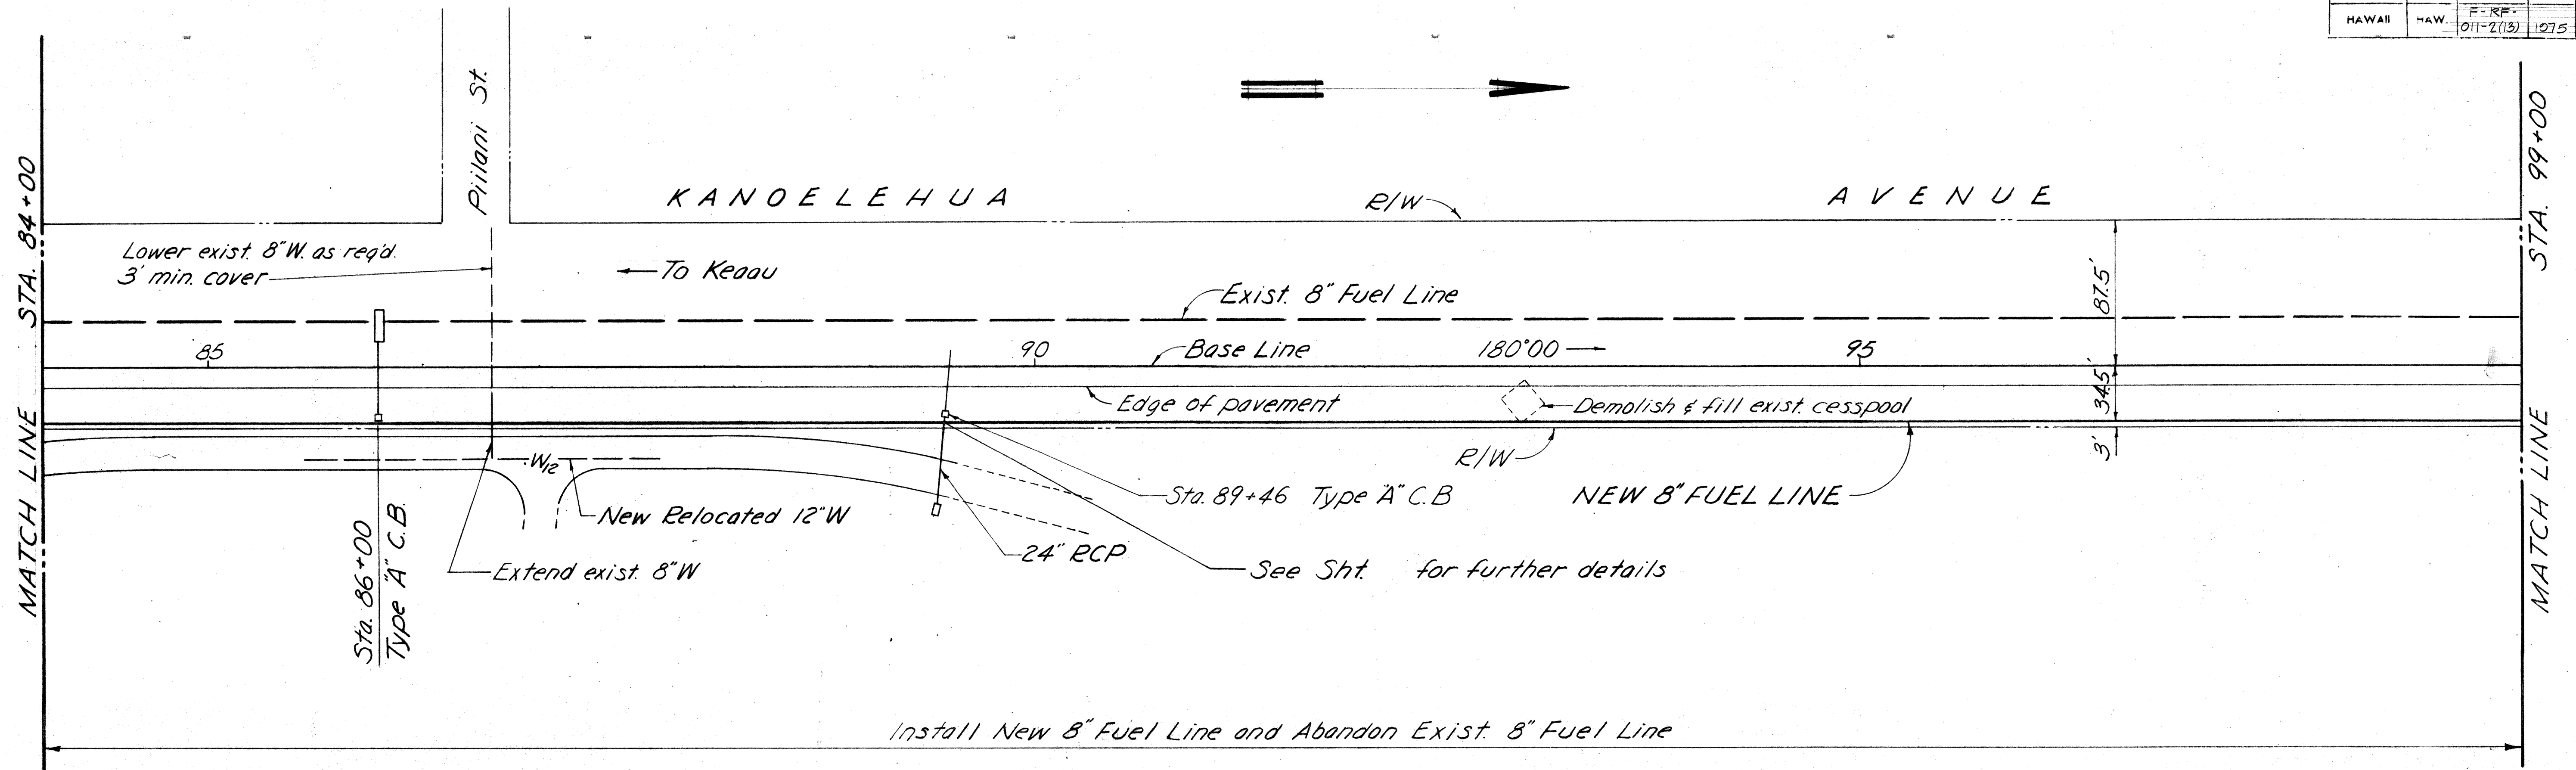


| PROFILE | DATE | BY |
|---------|------|----|
| NO. 1   |      |    |
| NO. 2   |      |    |
| NO. 3   |      |    |
| NO. 4   |      |    |
| NO. 5   |      |    |
| NO. 6   |      |    |
| NO. 7   |      |    |
| NO. 8   |      |    |
| NO. 9   |      |    |
| NO. 10  |      |    |
| NO. 11  |      |    |
| NO. 12  |      |    |
| NO. 99  |      |    |
| NO. 100 |      |    |
| NO. 101 |      |    |
| NO. 102 |      |    |
| NO. 103 |      |    |
| NO. 104 |      |    |
| NO. 105 |      |    |
| NO. 106 |      |    |
| NO. 107 |      |    |
| NO. 108 |      |    |
| NO. 109 |      |    |
| NO. 110 |      |    |
| NO. 111 |      |    |
| NO. 112 |      |    |
| NO. 113 |      |    |
| NO. 114 |      |    |
| NO. 115 |      |    |
| NO. 116 |      |    |
| NO. 117 |      |    |
| NO. 118 |      |    |
| NO. 119 |      |    |
| NO. 120 |      |    |

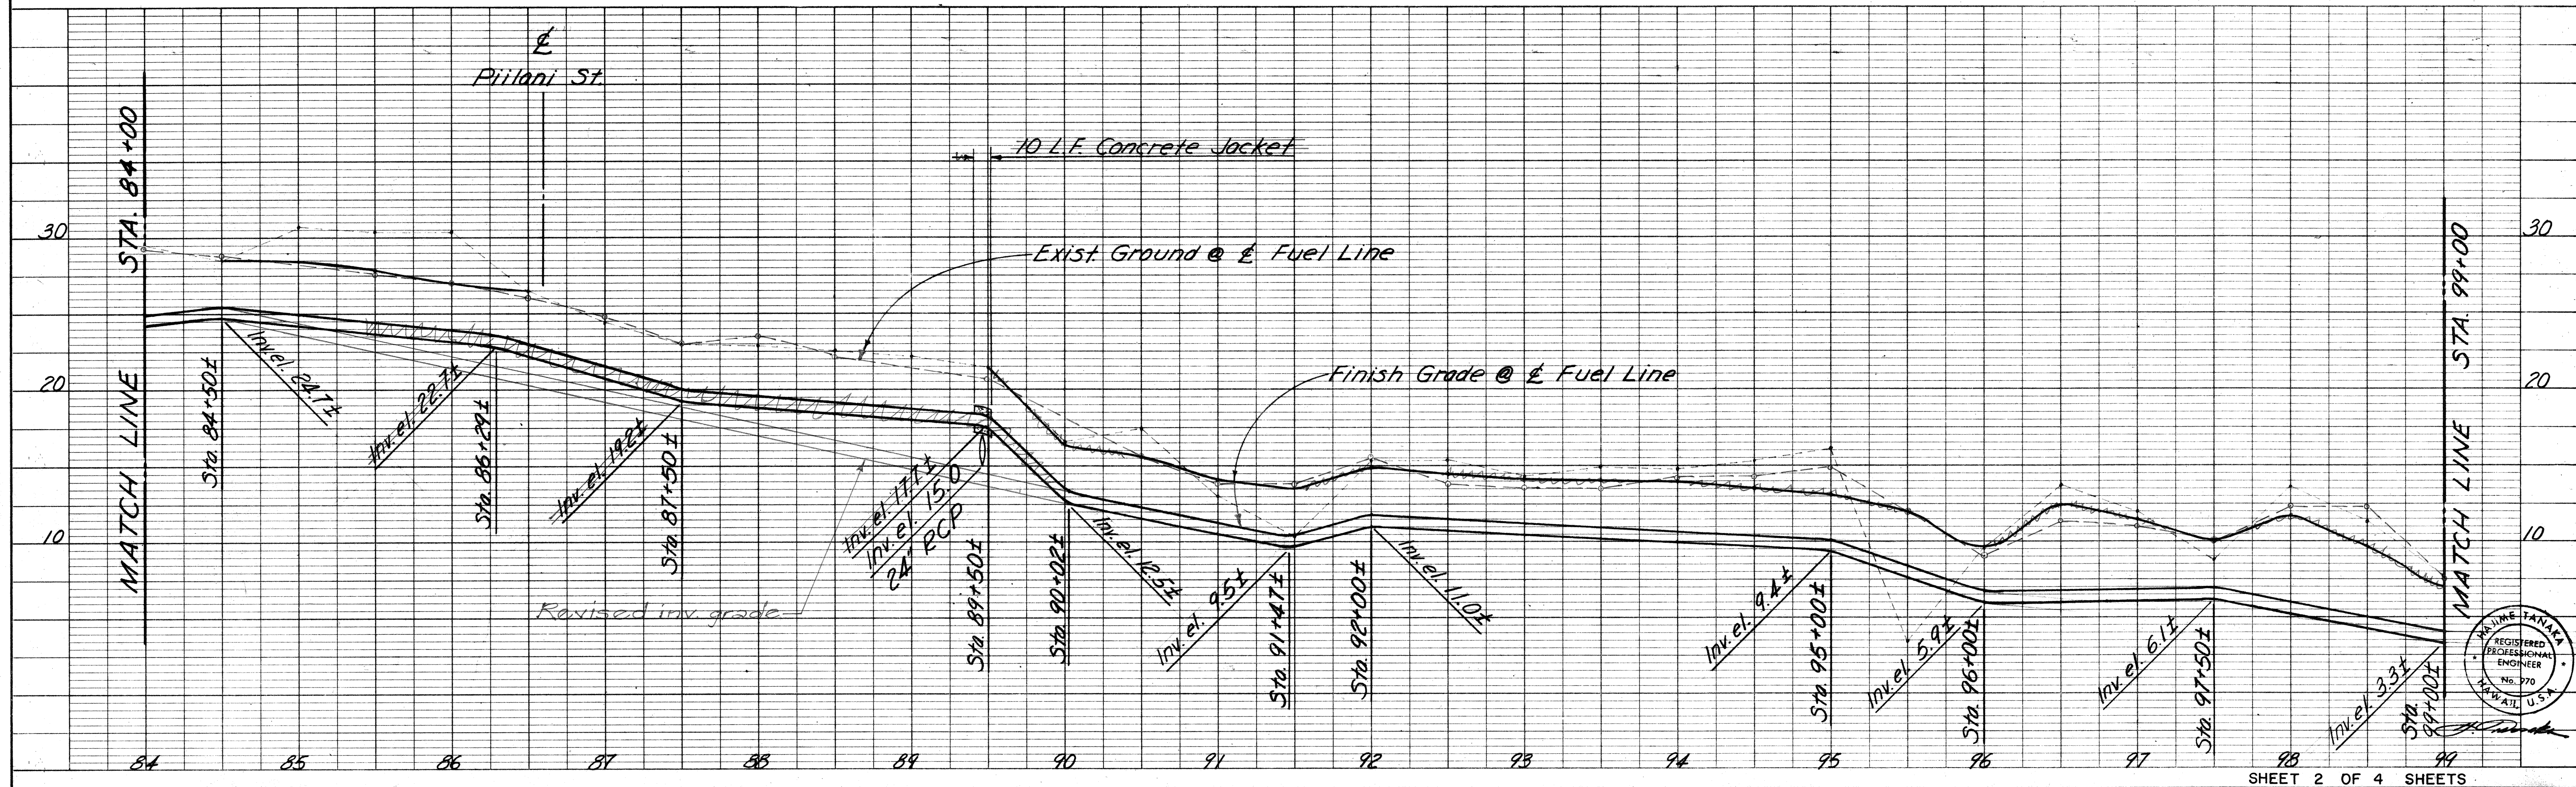




| FED. ROAD DIST. NO. | STATE | FED. AID PROJ. NO. | FISCAL YEAR | SHEET NO. | TOTAL SHEETS |
|---------------------|-------|--------------------|-------------|-----------|--------------|
| HAWAII              | HAW.  | E-RF-011-2(13)     | 1975        | 56C       | 126          |

| PLAN    | DATE | BY |
|---------|------|----|
| NO. 1   |      |    |
| NO. 2   |      |    |
| NO. 3   |      |    |
| NO. 4   |      |    |
| NO. 5   |      |    |
| NO. 6   |      |    |
| NO. 7   |      |    |
| NO. 8   |      |    |
| NO. 9   |      |    |
| NO. 10  |      |    |
| NO. 11  |      |    |
| NO. 12  |      |    |
| NO. 99  |      |    |
| NO. 100 |      |    |
| NO. 101 |      |    |
| NO. 102 |      |    |
| NO. 103 |      |    |
| NO. 104 |      |    |
| NO. 105 |      |    |
| NO. 106 |      |    |
| NO. 107 |      |    |
| NO. 108 |      |    |
| NO. 109 |      |    |
| NO. 110 |      |    |
| NO. 111 |      |    |
| NO. 112 |      |    |
| NO. 113 |      |    |
| NO. 114 |      |    |
| NO. 115 |      |    |
| NO. 116 |      |    |
| NO. 117 |      |    |
| NO. 118 |      |    |
| NO. 119 |      |    |
| NO. 120 |      |    |
| NO. 121 |      |    |
| NO. 122 |      |    |
| NO. 123 |      |    |
| NO. 124 |      |    |
| NO. 125 |      |    |
| NO. 126 |      |    |

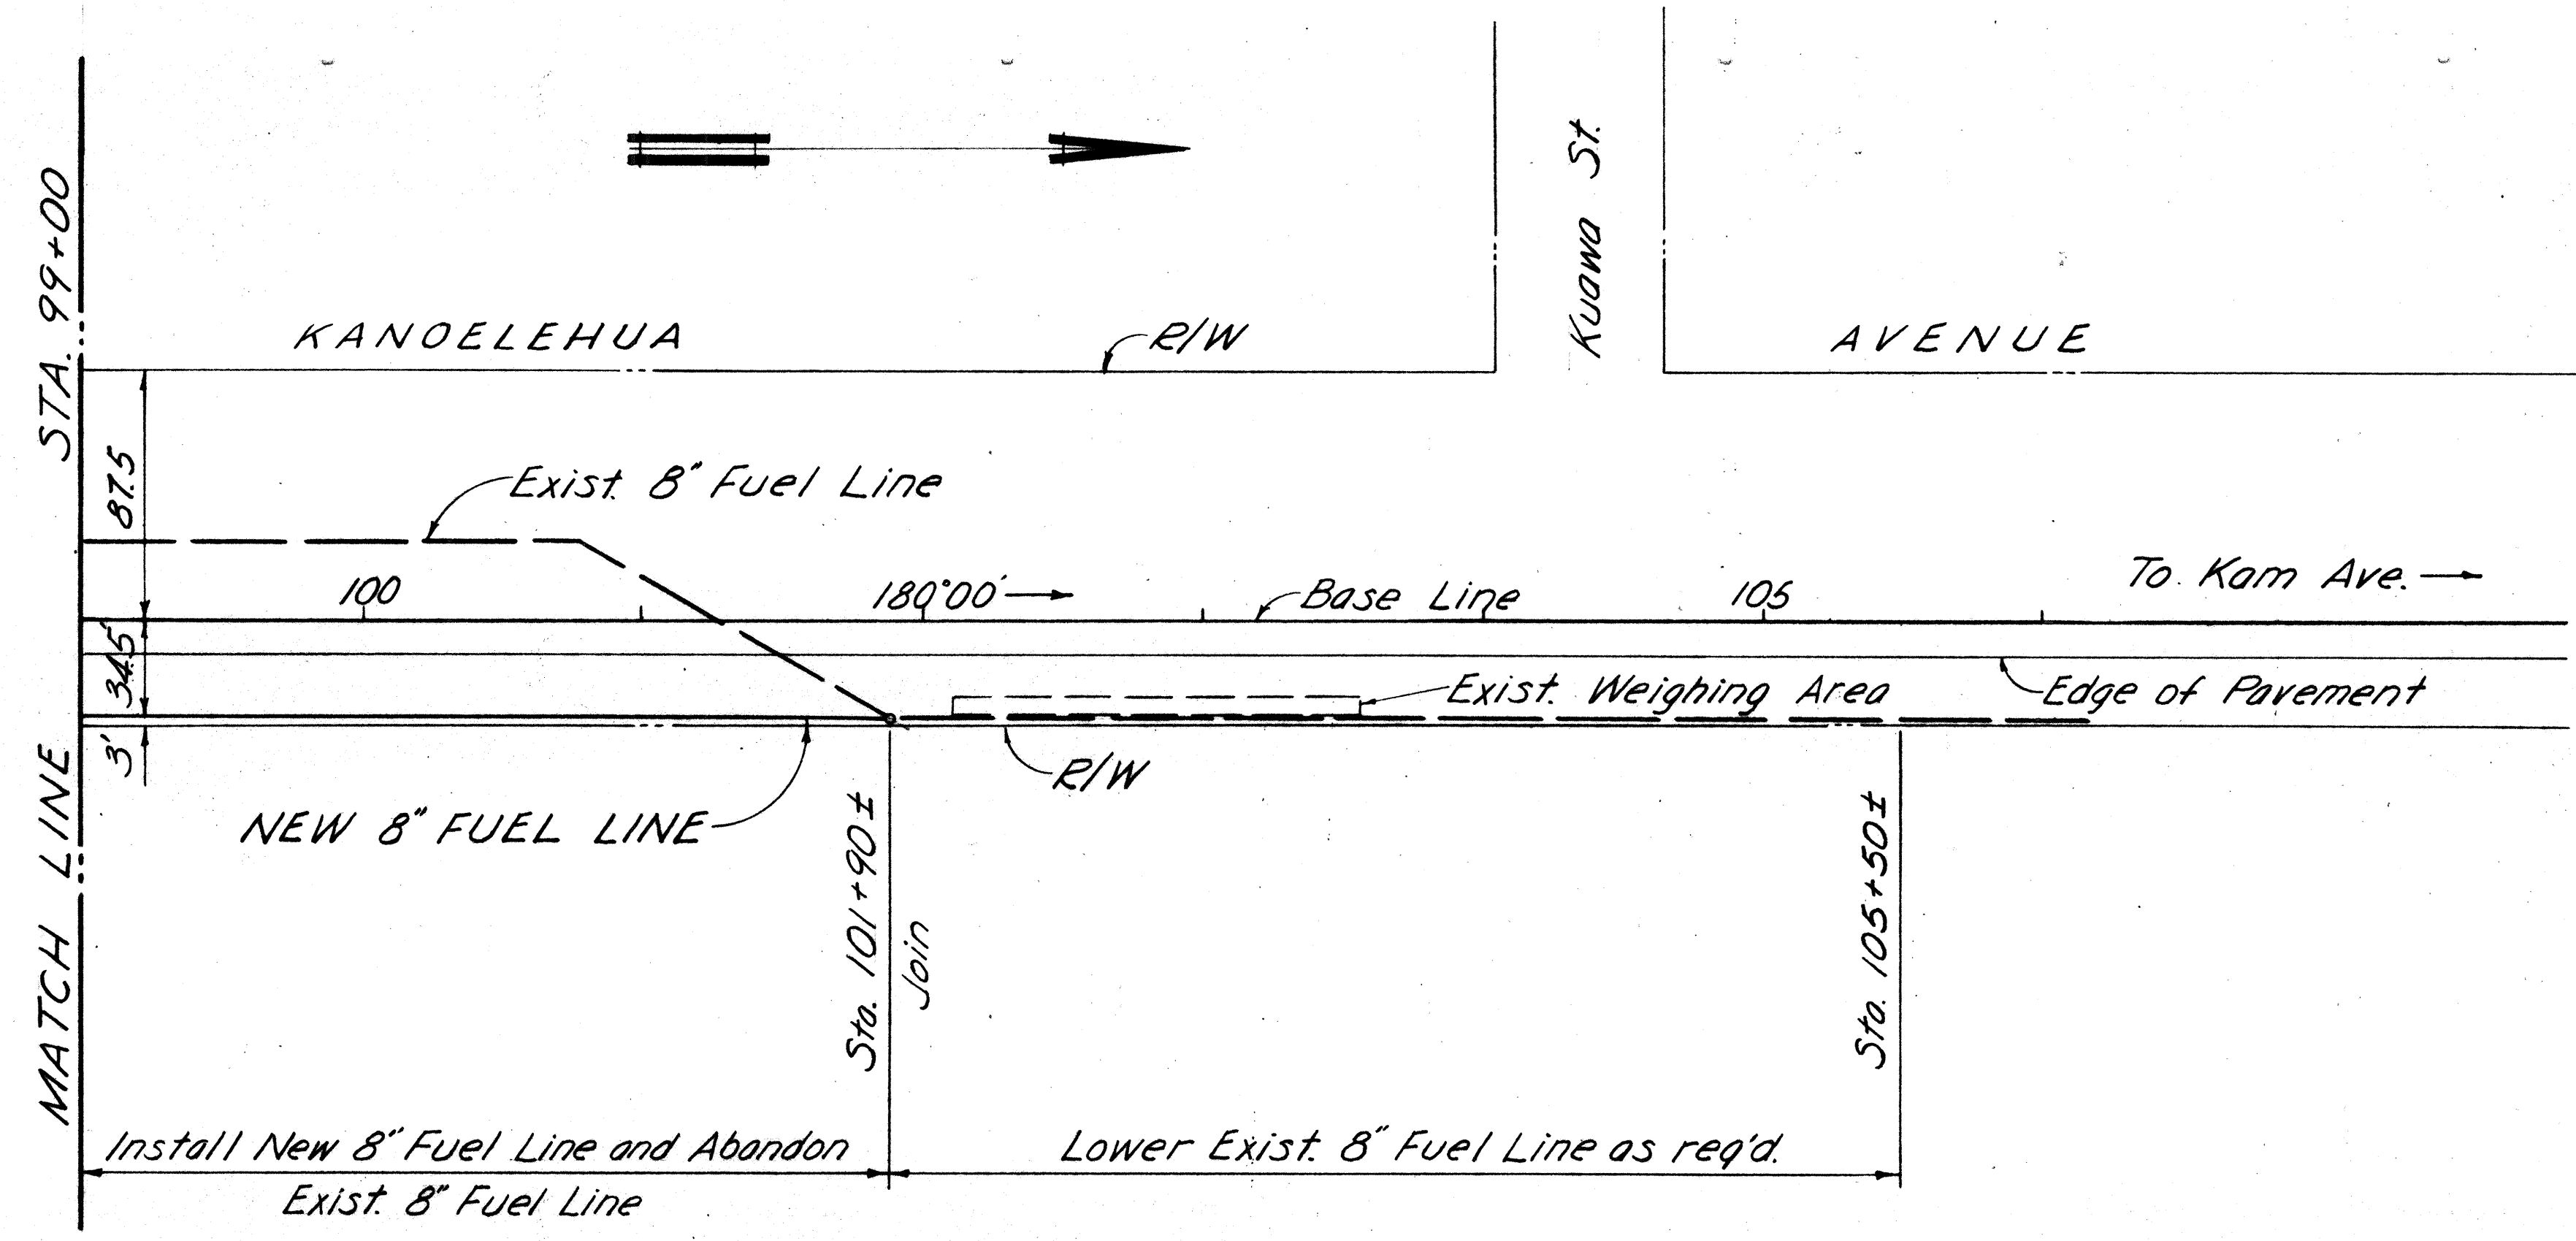


PLAN  
Scale: 1" = 50'

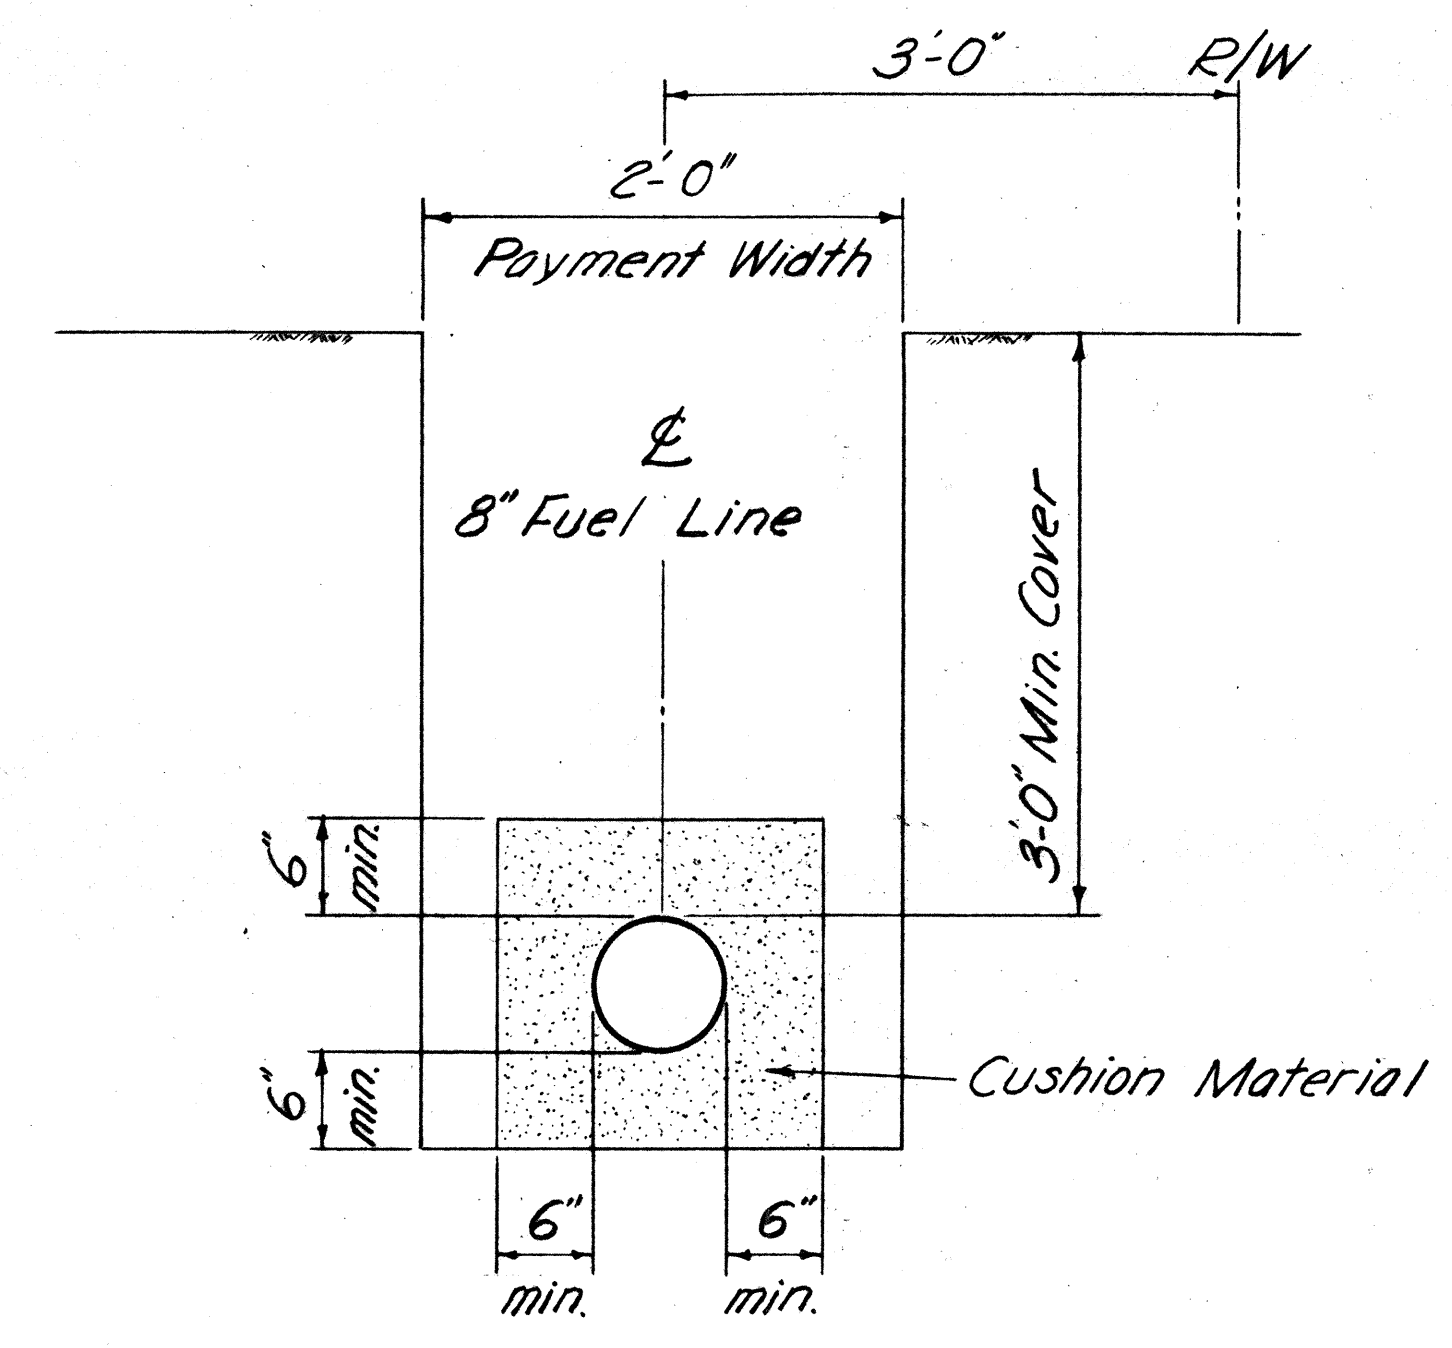


TYPICAL TRENCH SECTION  
No Scale


| PROFILE | DATE | BY |
|---------|------|----|
| NO. 1   |      |    |
| NO. 2   |      |    |
| NO. 3   |      |    |
| NO. 4   |      |    |
| NO. 5   |      |    |
| NO. 6   |      |    |
| NO. 7   |      |    |
| NO. 8   |      |    |
| NO. 9   |      |    |
| NO. 10  |      |    |
| NO. 11  |      |    |
| NO. 12  |      |    |
| NO. 99  |      |    |
| NO. 100 |      |    |
| NO. 101 |      |    |
| NO. 102 |      |    |
| NO. 103 |      |    |
| NO. 104 |      |    |
| NO. 105 |      |    |
| NO. 106 |      |    |
| NO. 107 |      |    |
| NO. 108 |      |    |
| NO. 109 |      |    |
| NO. 110 |      |    |
| NO. 111 |      |    |
| NO. 112 |      |    |
| NO. 113 |      |    |
| NO. 114 |      |    |
| NO. 115 |      |    |
| NO. 116 |      |    |
| NO. 117 |      |    |
| NO. 118 |      |    |
| NO. 119 |      |    |
| NO. 120 |      |    |
| NO. 121 |      |    |
| NO. 122 |      |    |
| NO. 123 |      |    |
| NO. 124 |      |    |
| NO. 125 |      |    |
| NO. 126 |      |    |

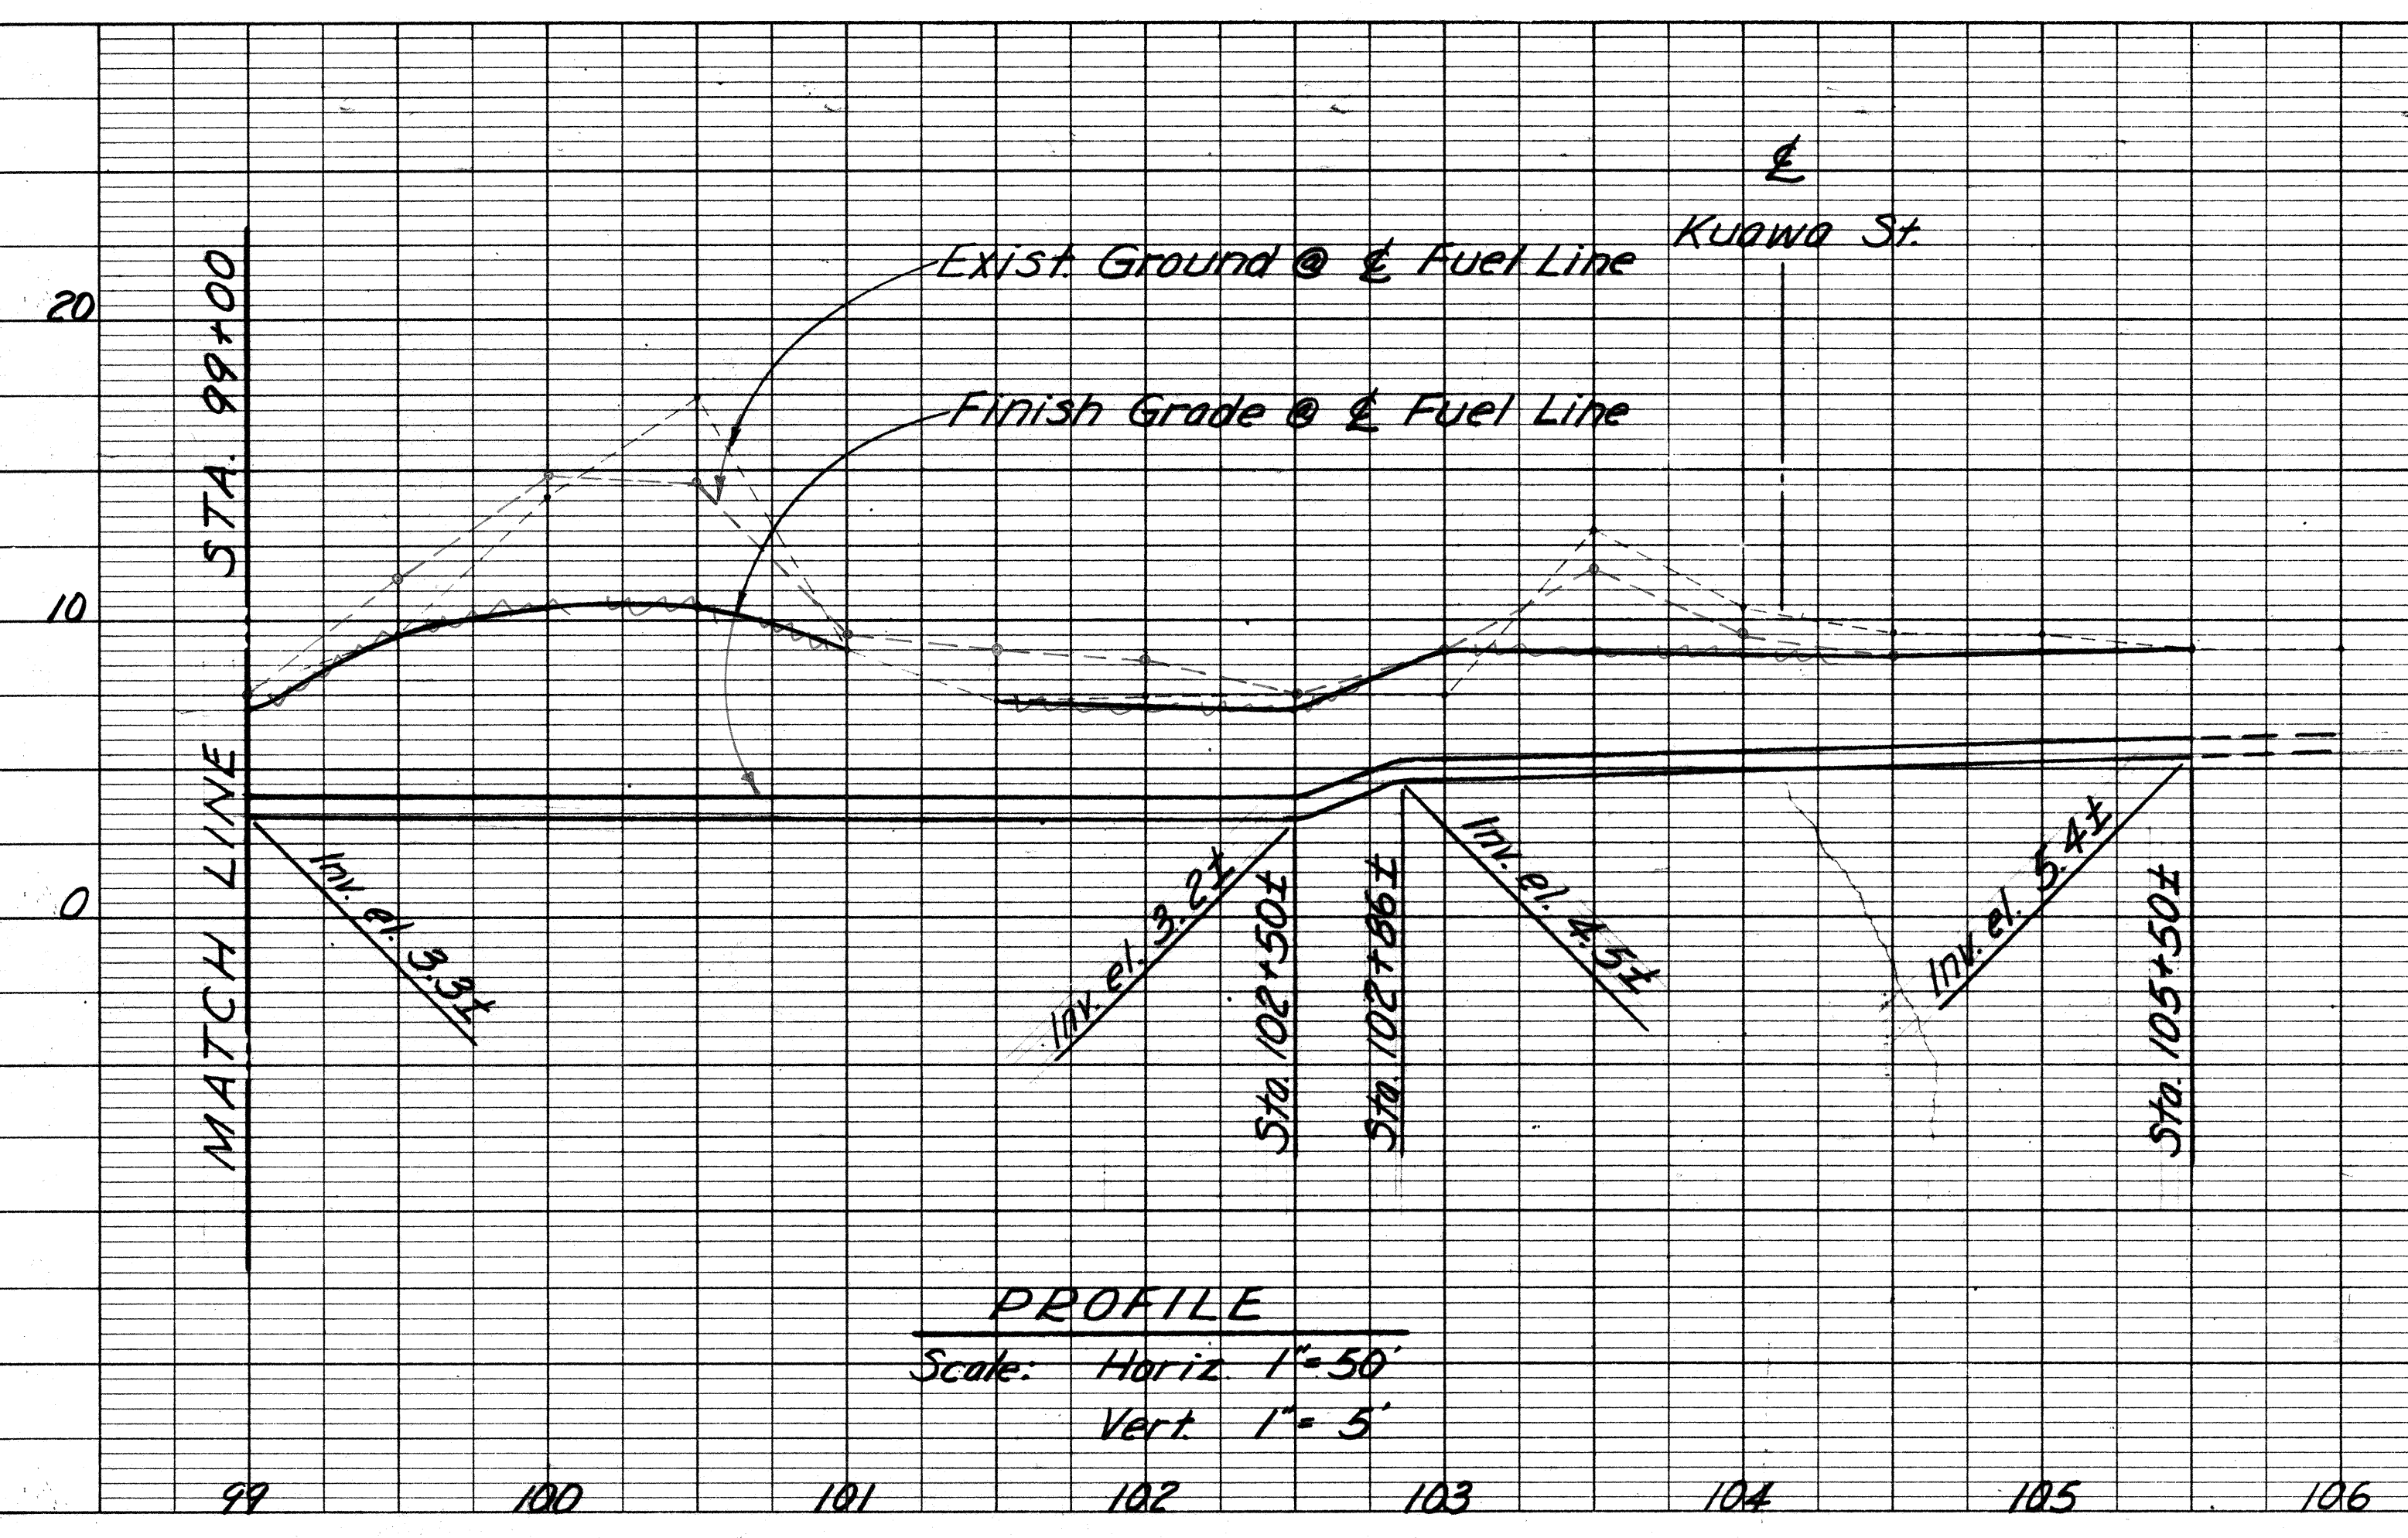

PROFILE  
Scale: Horiz 1" = 50'  
Vert 1" = 5'

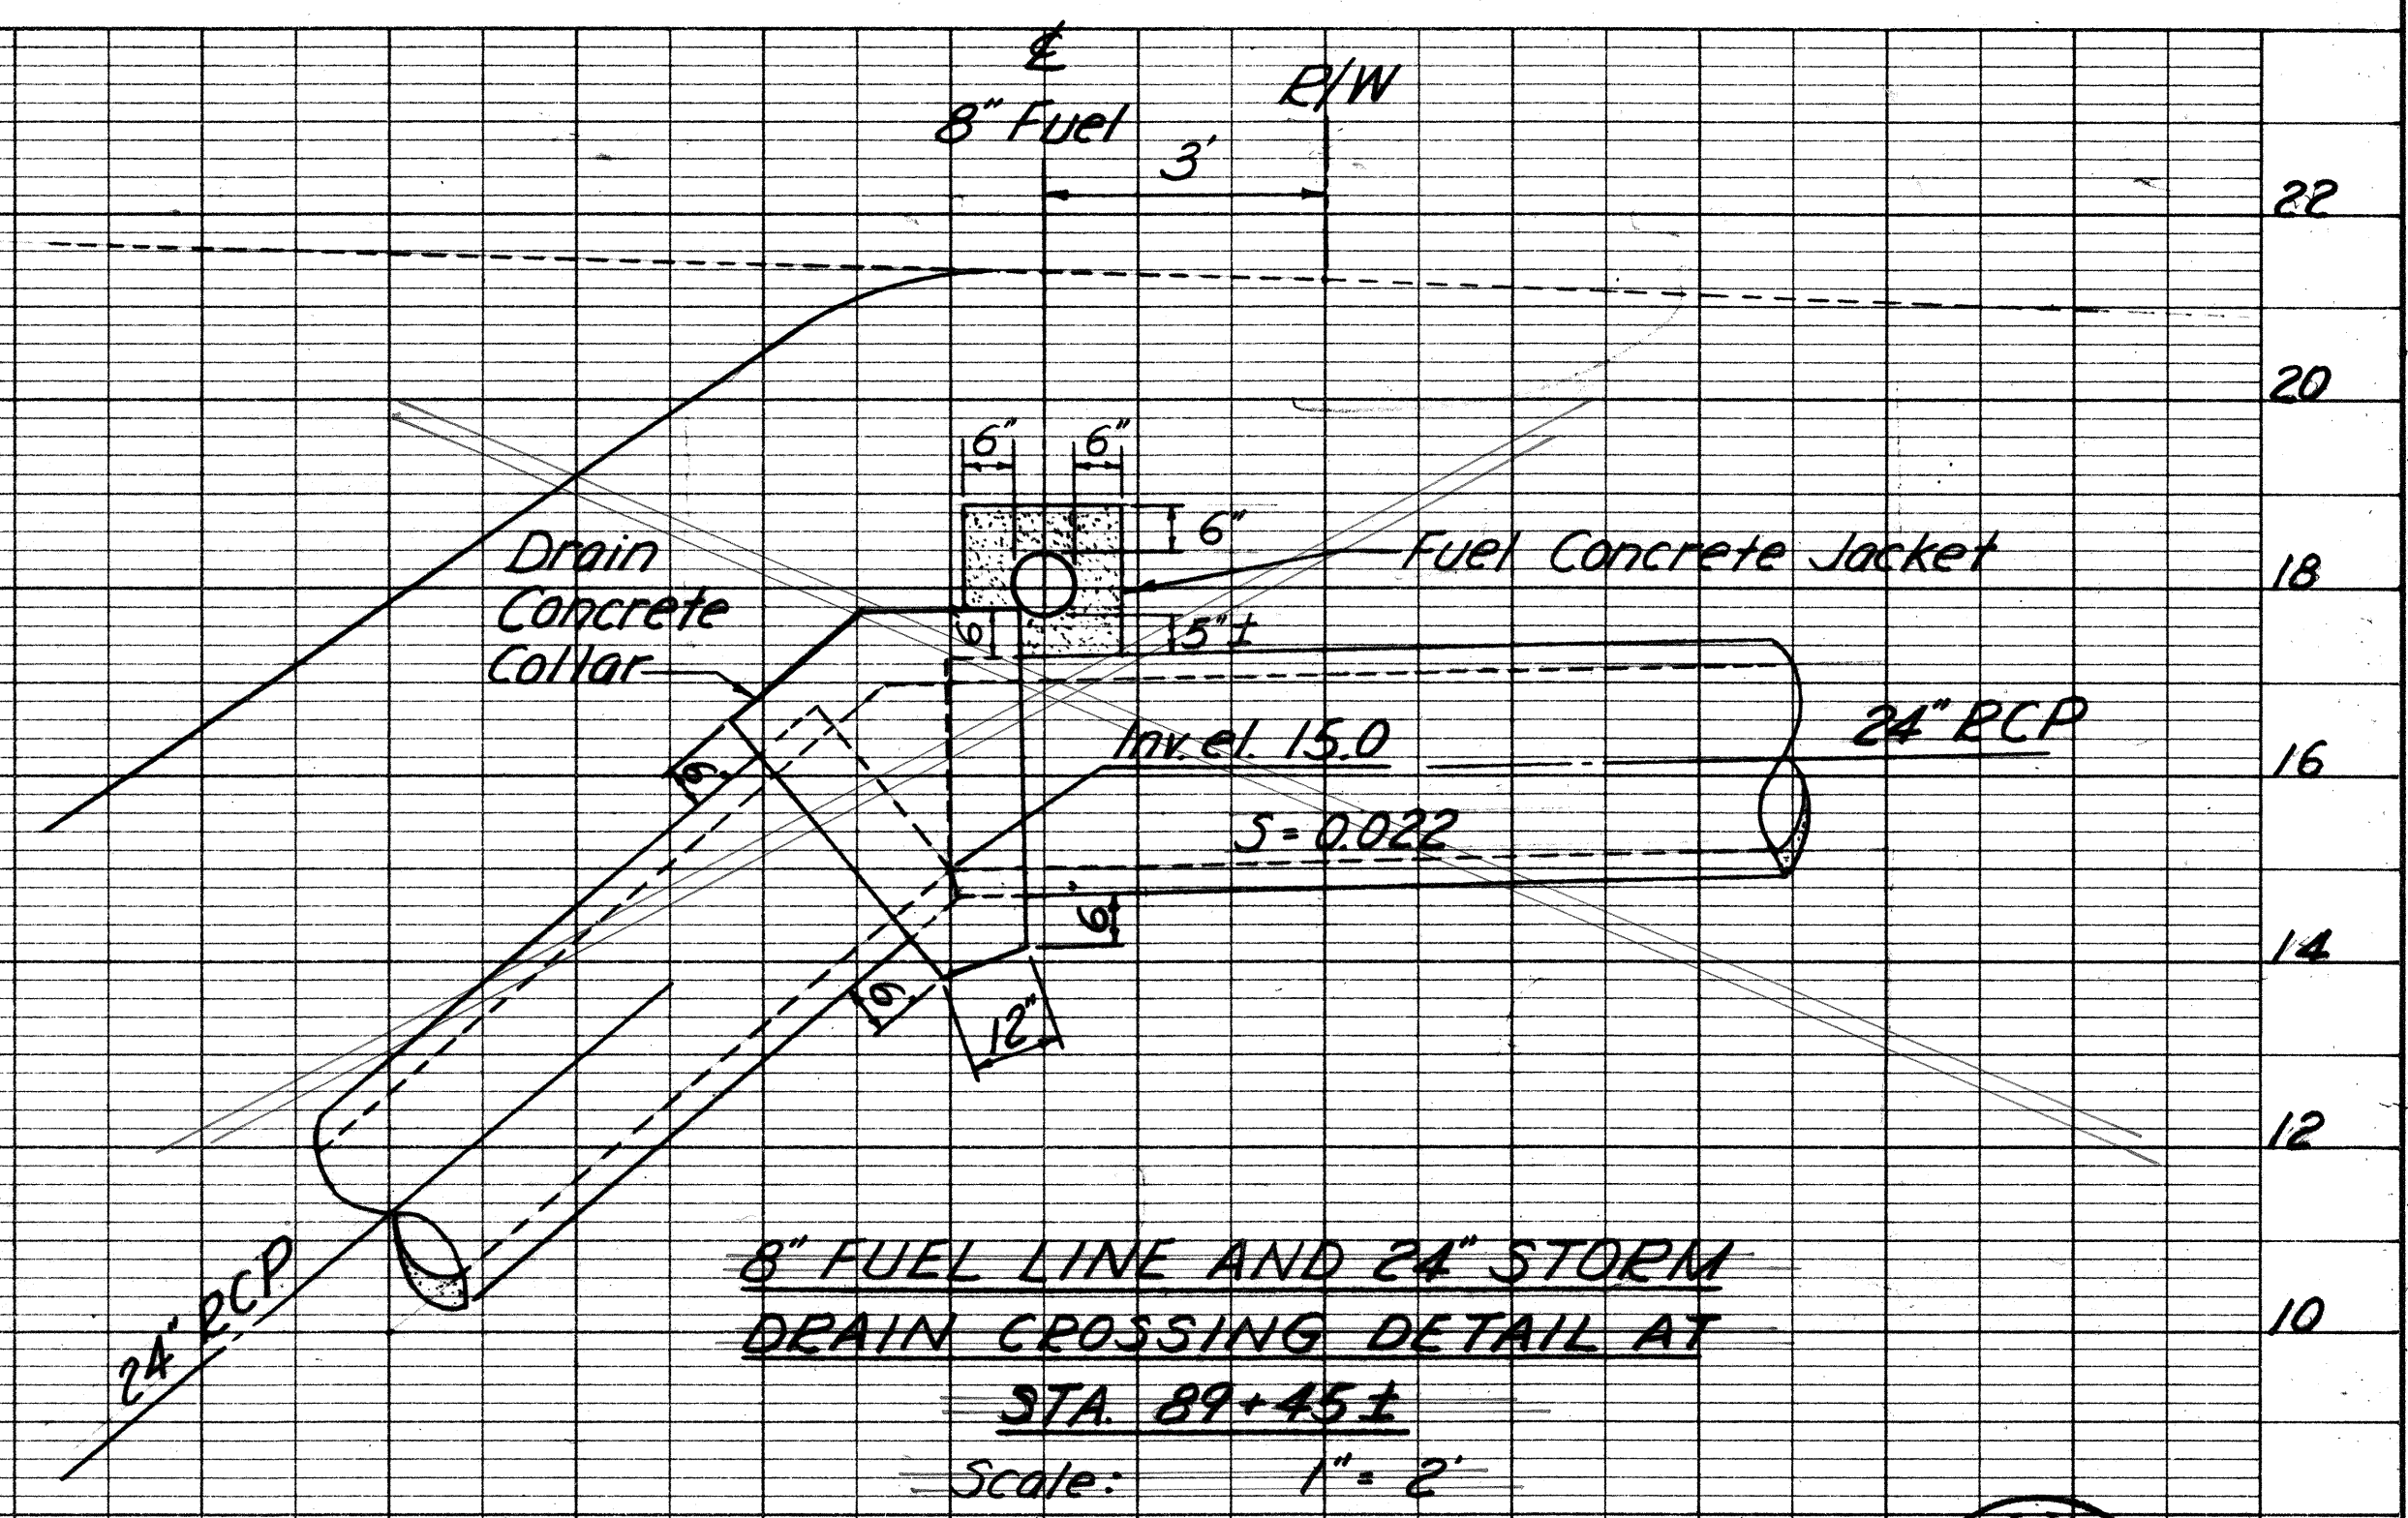


8" FUEL LINE AND 24" STORM DRAIN CROSSING DETAIL AT  
STA. 89+45±  
Scale: 1" = 2'

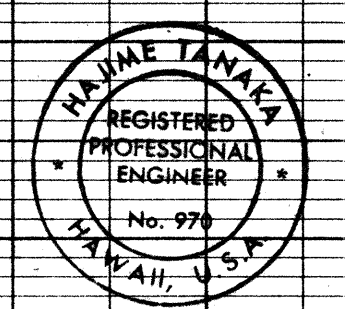




| FED. ROAD DIST. NO. | STATE | FED. AID PROJ. NO. | FISCAL YEAR | SHEET NO. | TOTAL SHEETS |
|---------------------|-------|--------------------|-------------|-----------|--------------|
| HAWAII              | HAW.  | F-RF-011-2(13)     | 1975        | 36d       | 12C          |

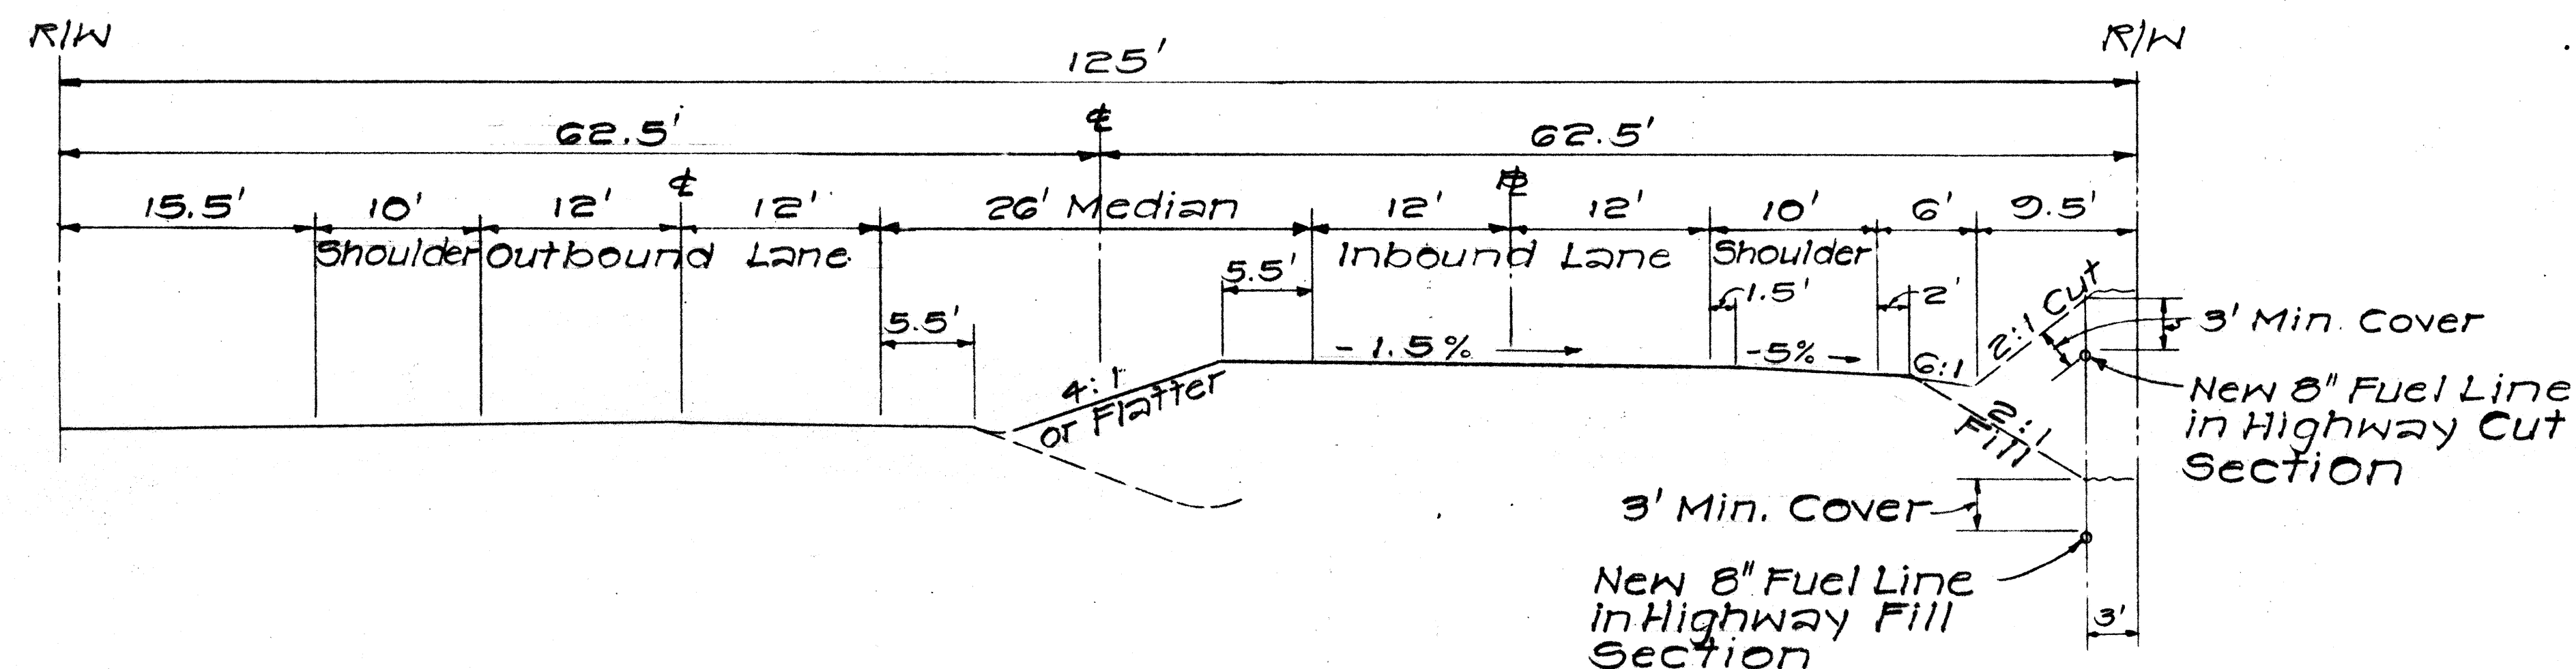


**TYPICAL KANOELEHUHUA AVE. SECTION**

Scale:  $\frac{1}{8}" = 1'-0"$

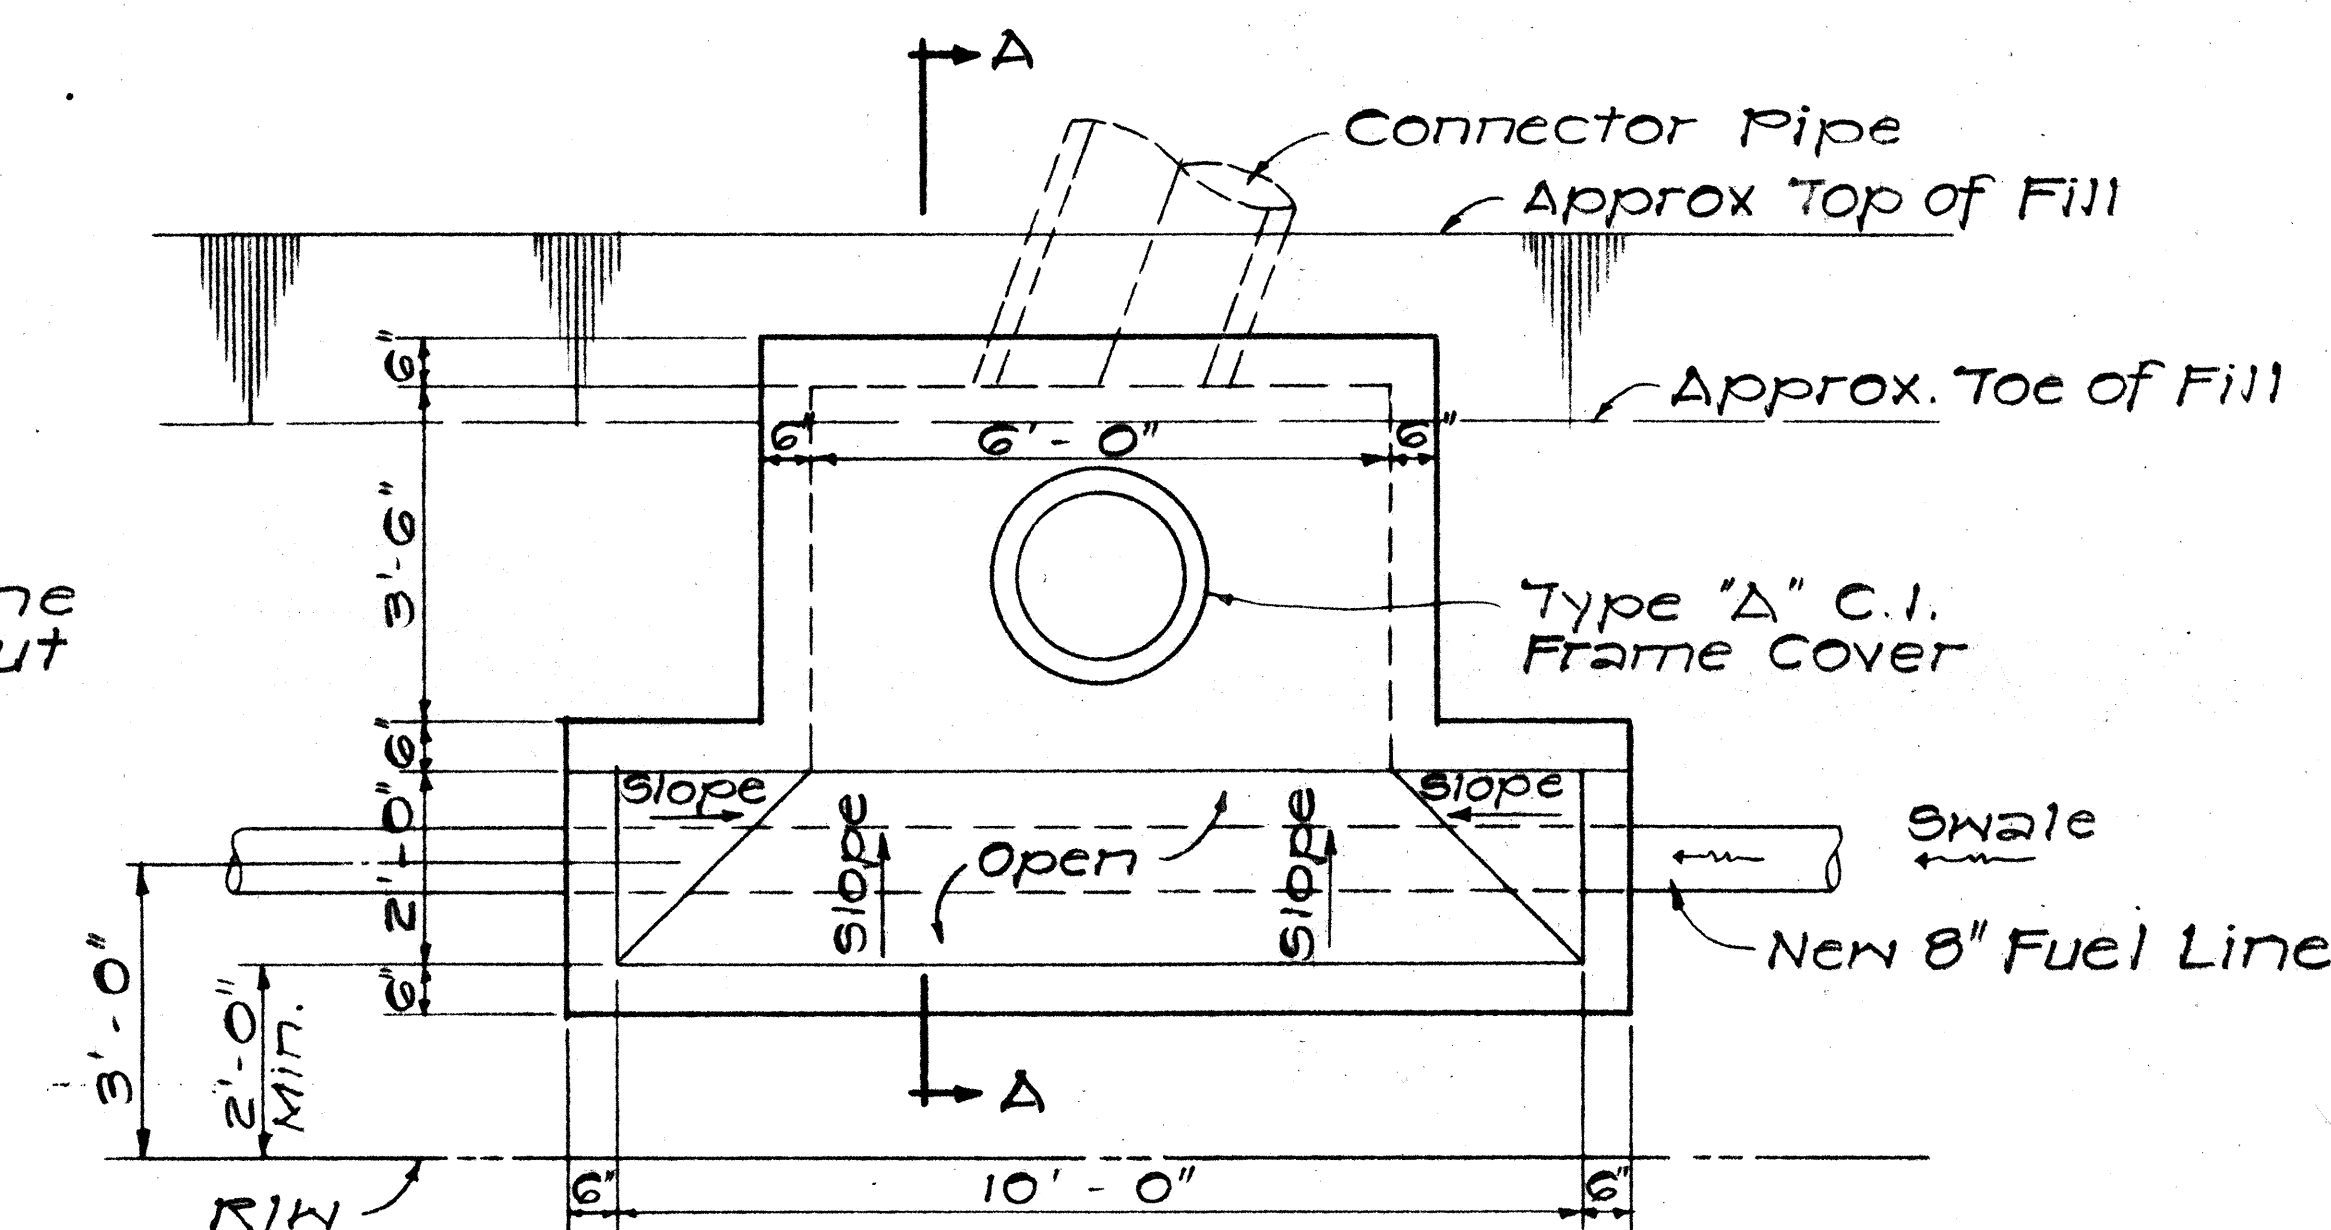

**PLAN**


Scale:  $\frac{1}{2}" = 1'-0"$

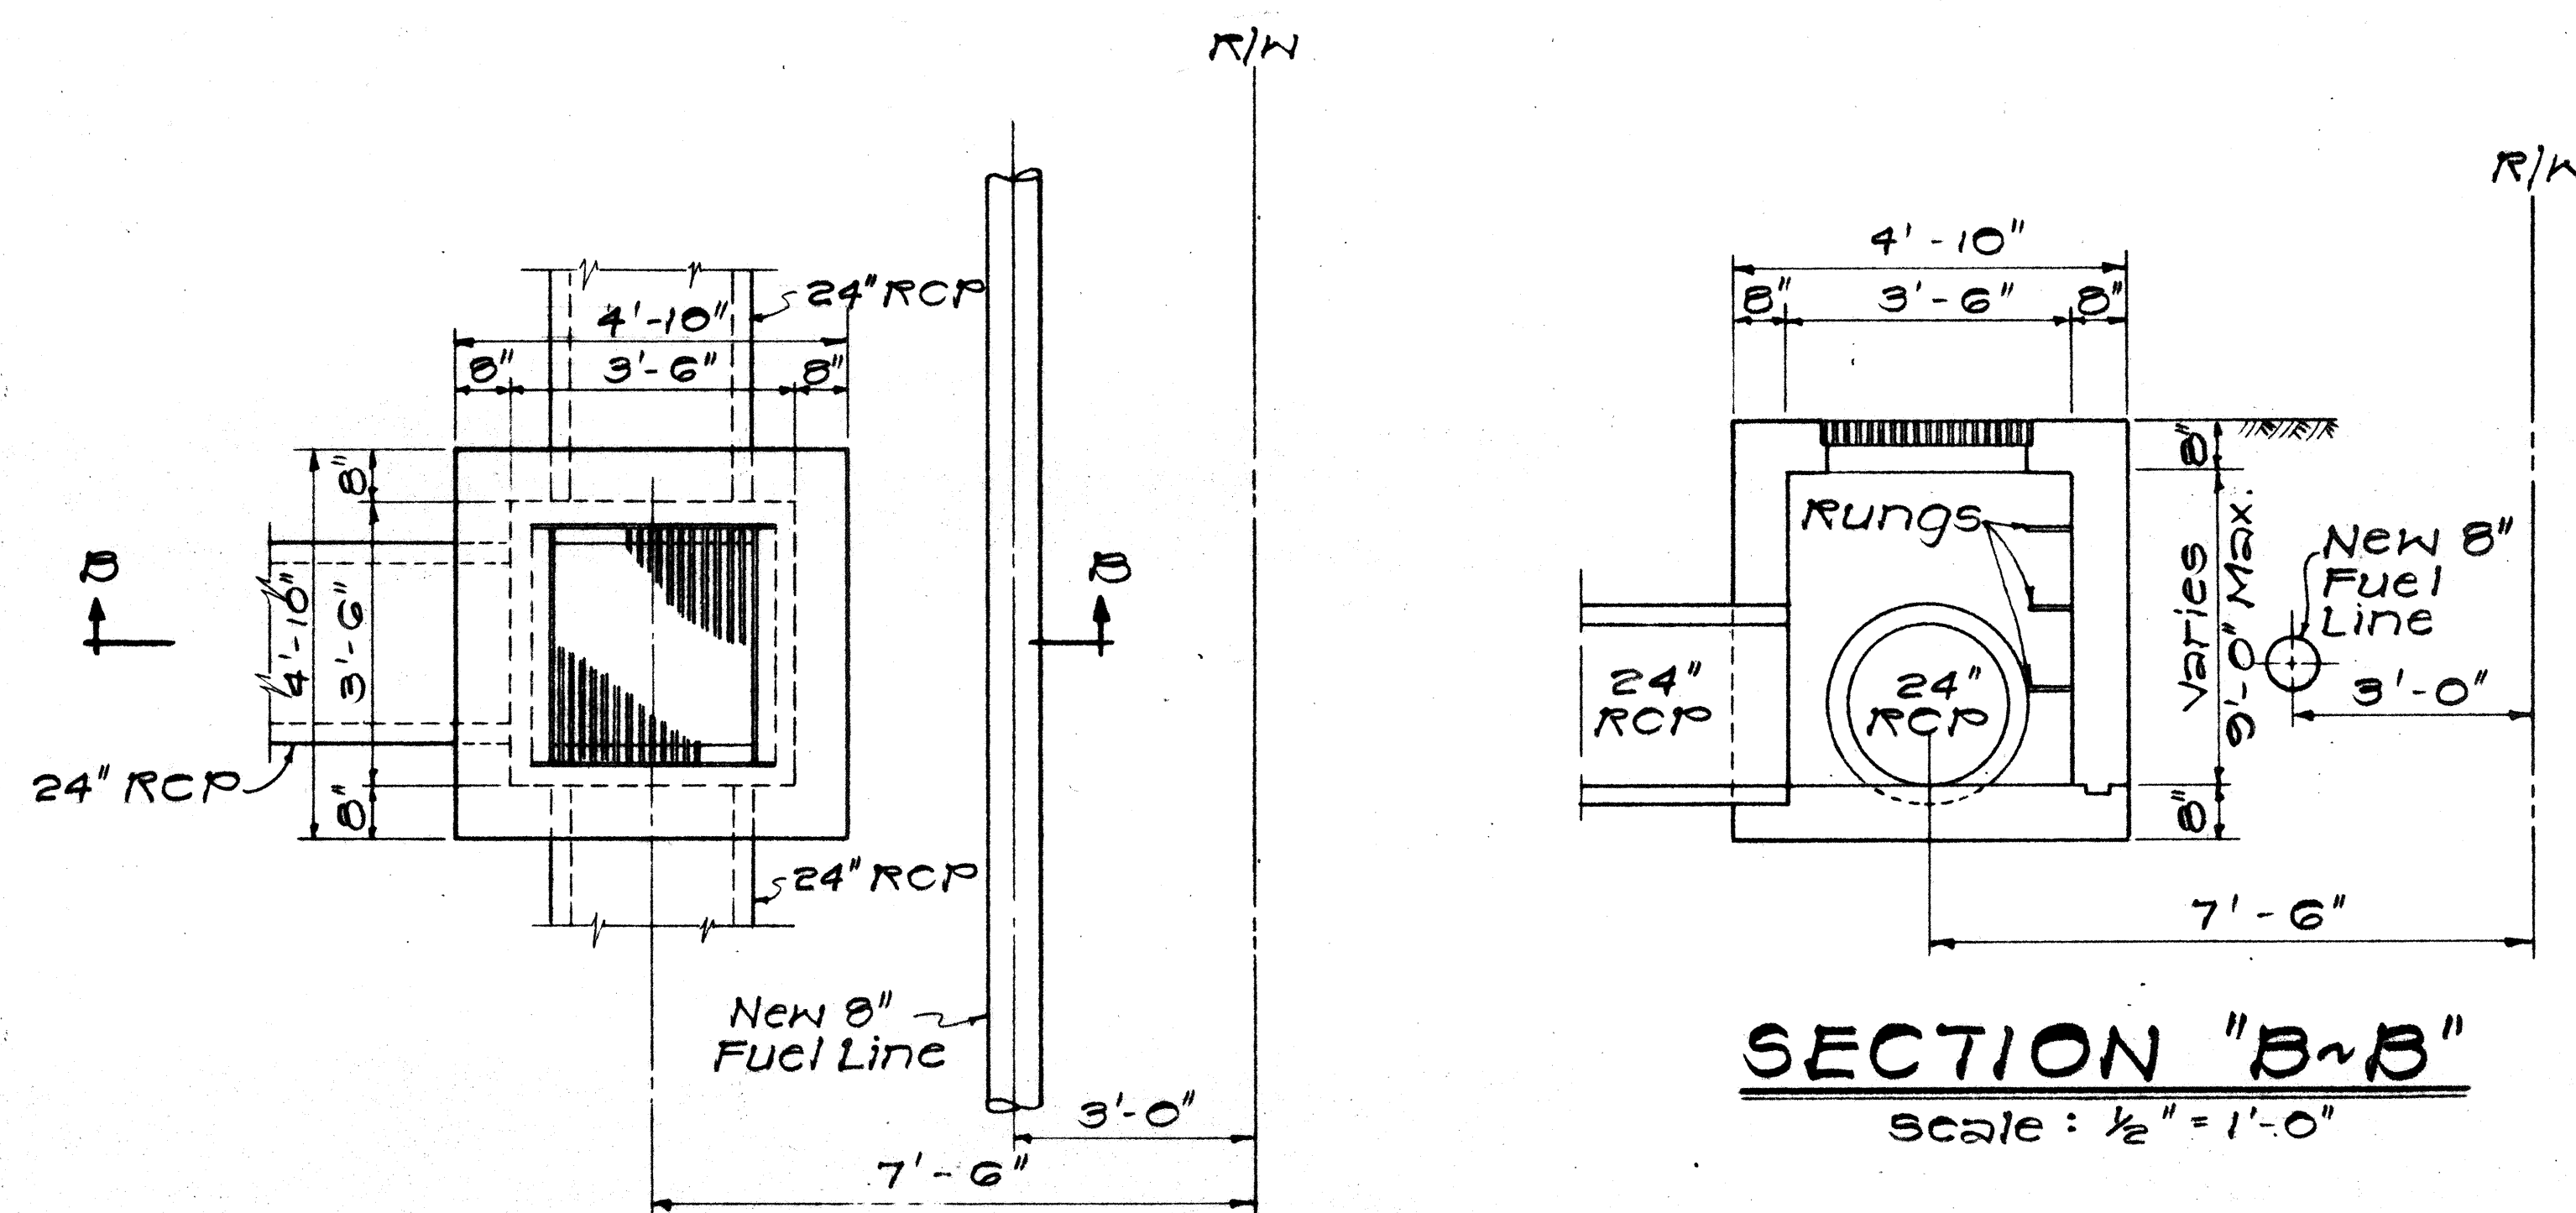

**PLAN**

Scale:  $\frac{1}{2}" = 1'-0"$

**TYPE "A" CATCH BASIN**

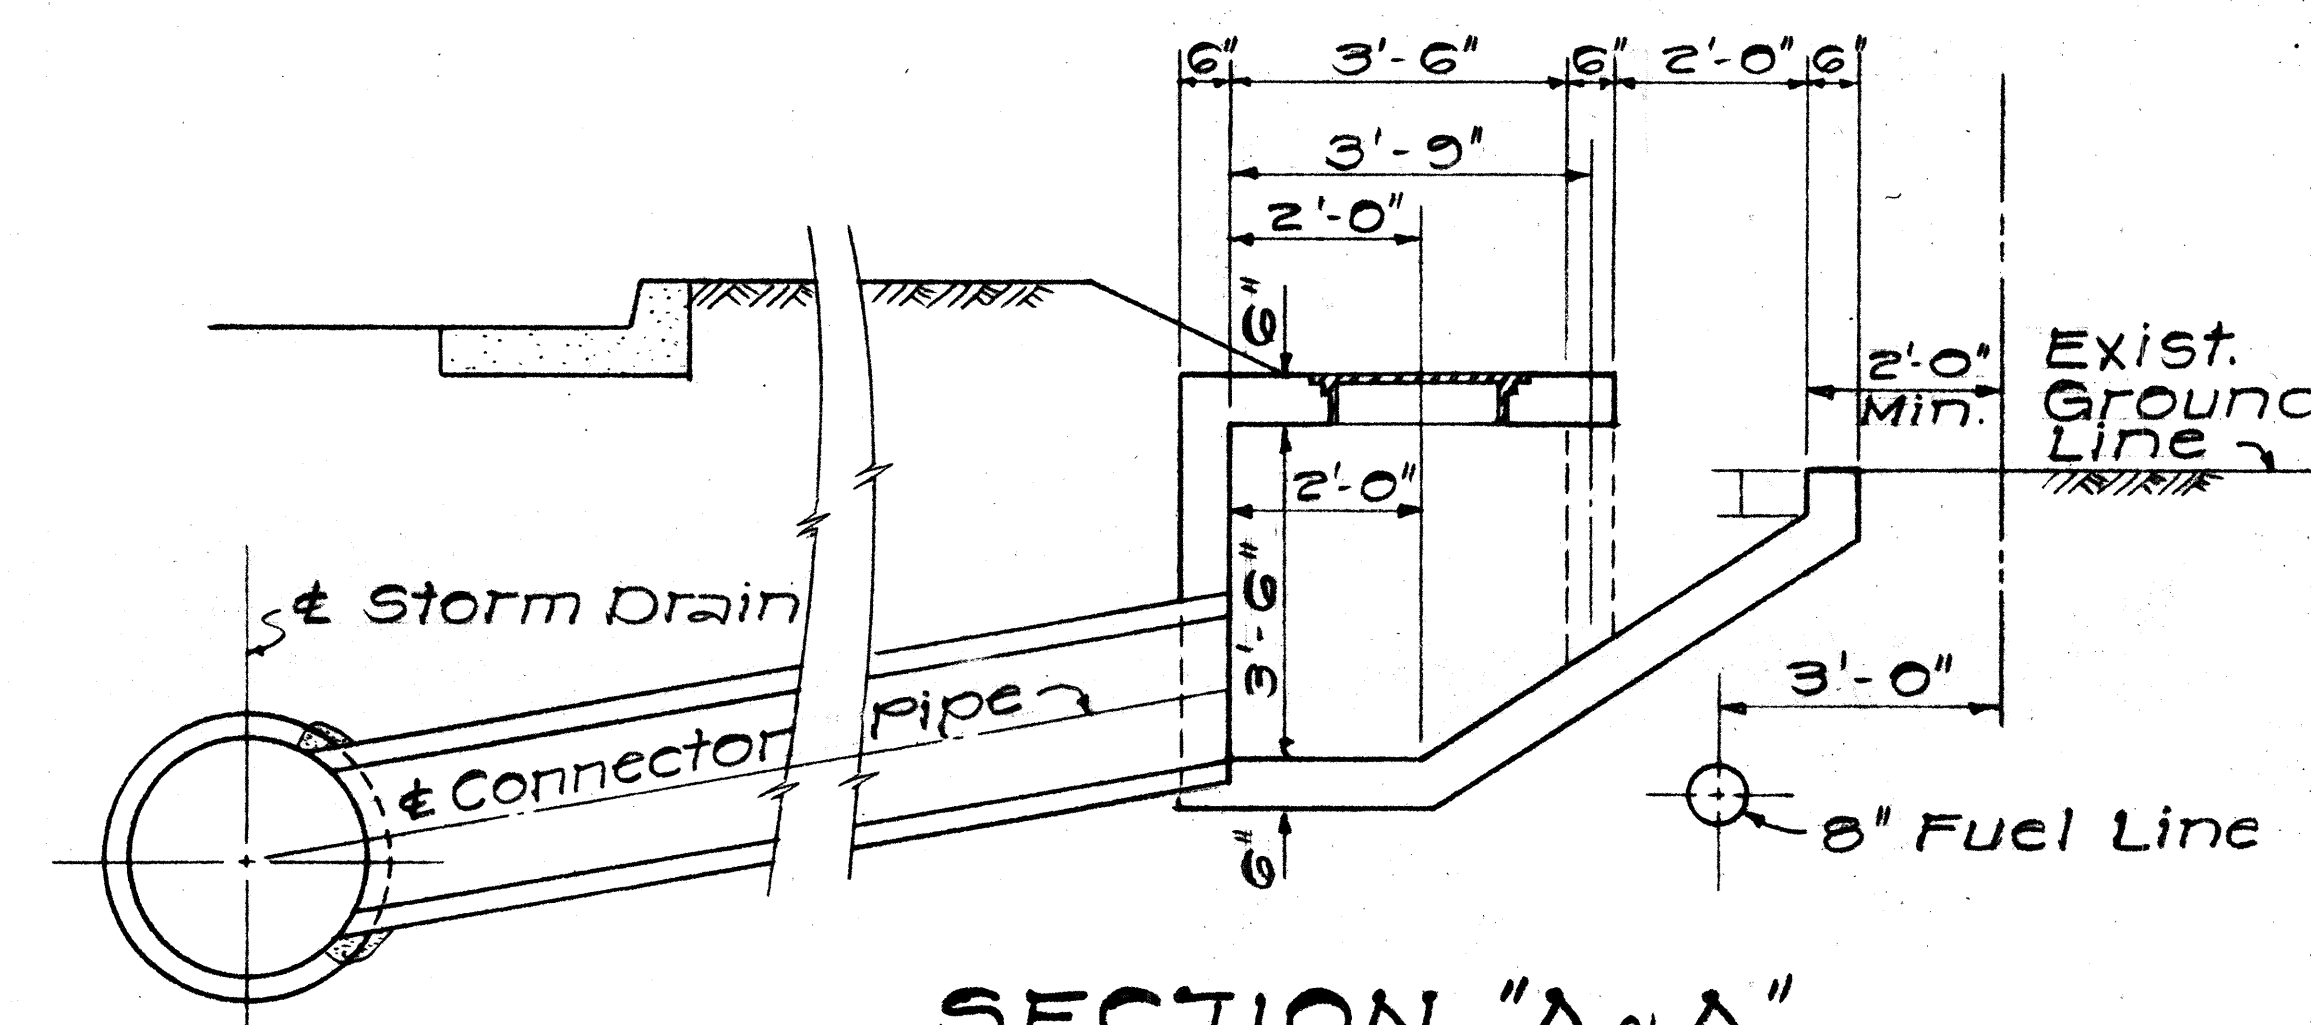


**SECTION "A-A"**

Scale:  $\frac{1}{2}" = 1'-0"$

**TYPE "D" CATCH BASIN**

|             |    |
|-------------|----|
| DATE        | BY |
| DESIGNED BY | BY |
| CHECKED BY  | BY |
| NOTED BY    | BY |
| ORIGINAL    | BY |

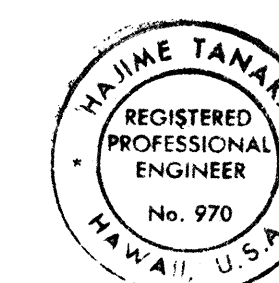

STATE OF HAWAII  
DEPARTMENT OF TRANSPORTATION  
HIGHWAYS DIVISION

HELCO 8" FUEL LINE

KANOELEHUHUA AVE.  
MAKALIKA ST. TO KAMEHAMEHA AVE.  
FEDERAL AID PROJECT NO. F-RF-011-2(13)  
SCALE: AS SHOWN

SHEET No. 4 OF 4 SHEETS