

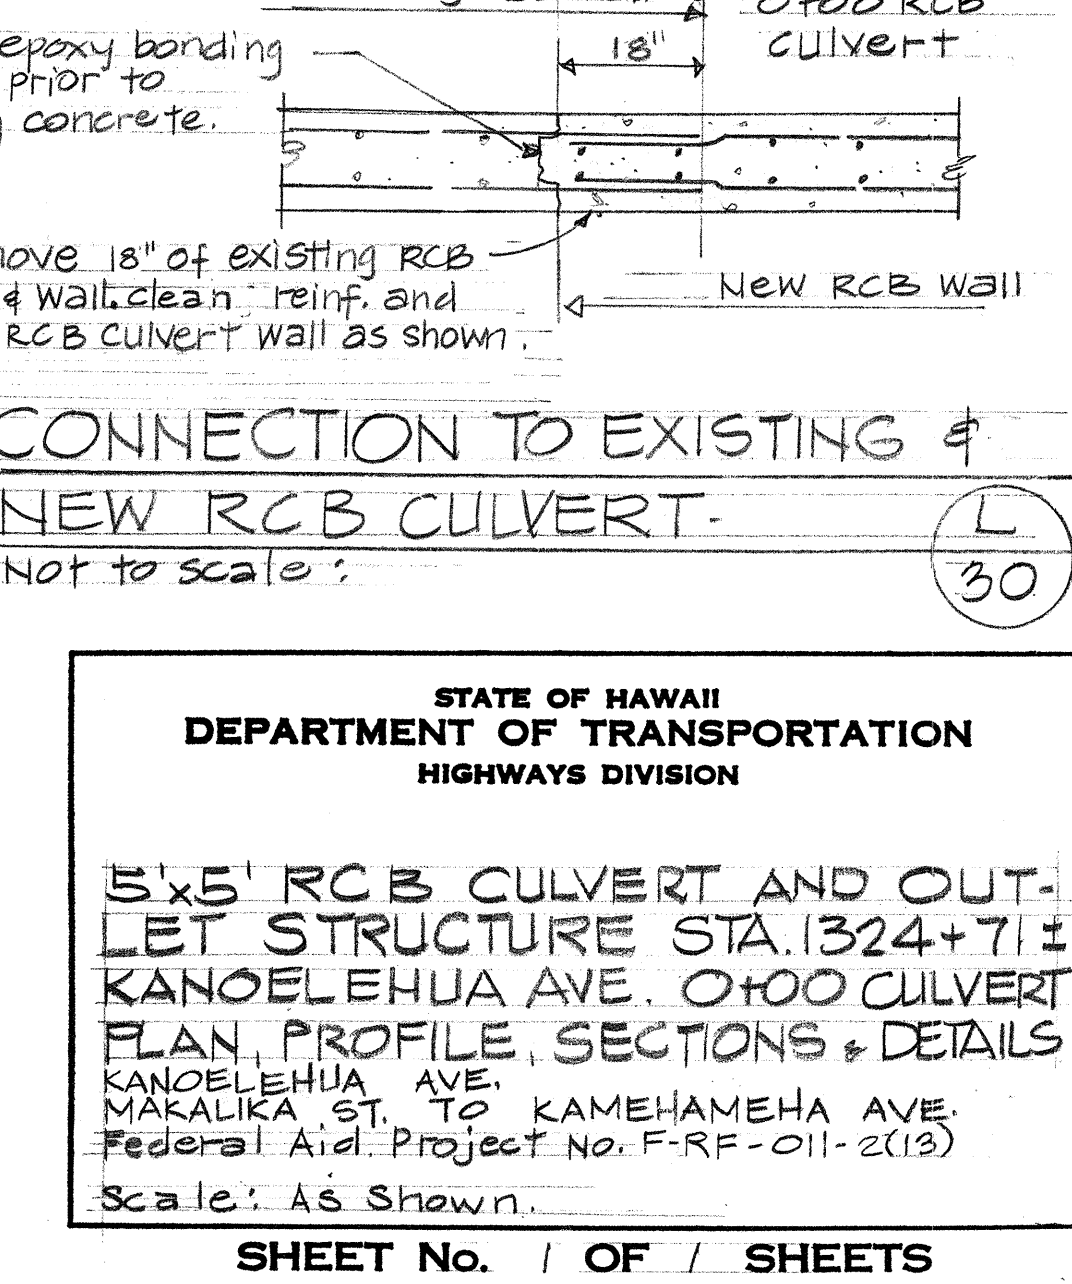
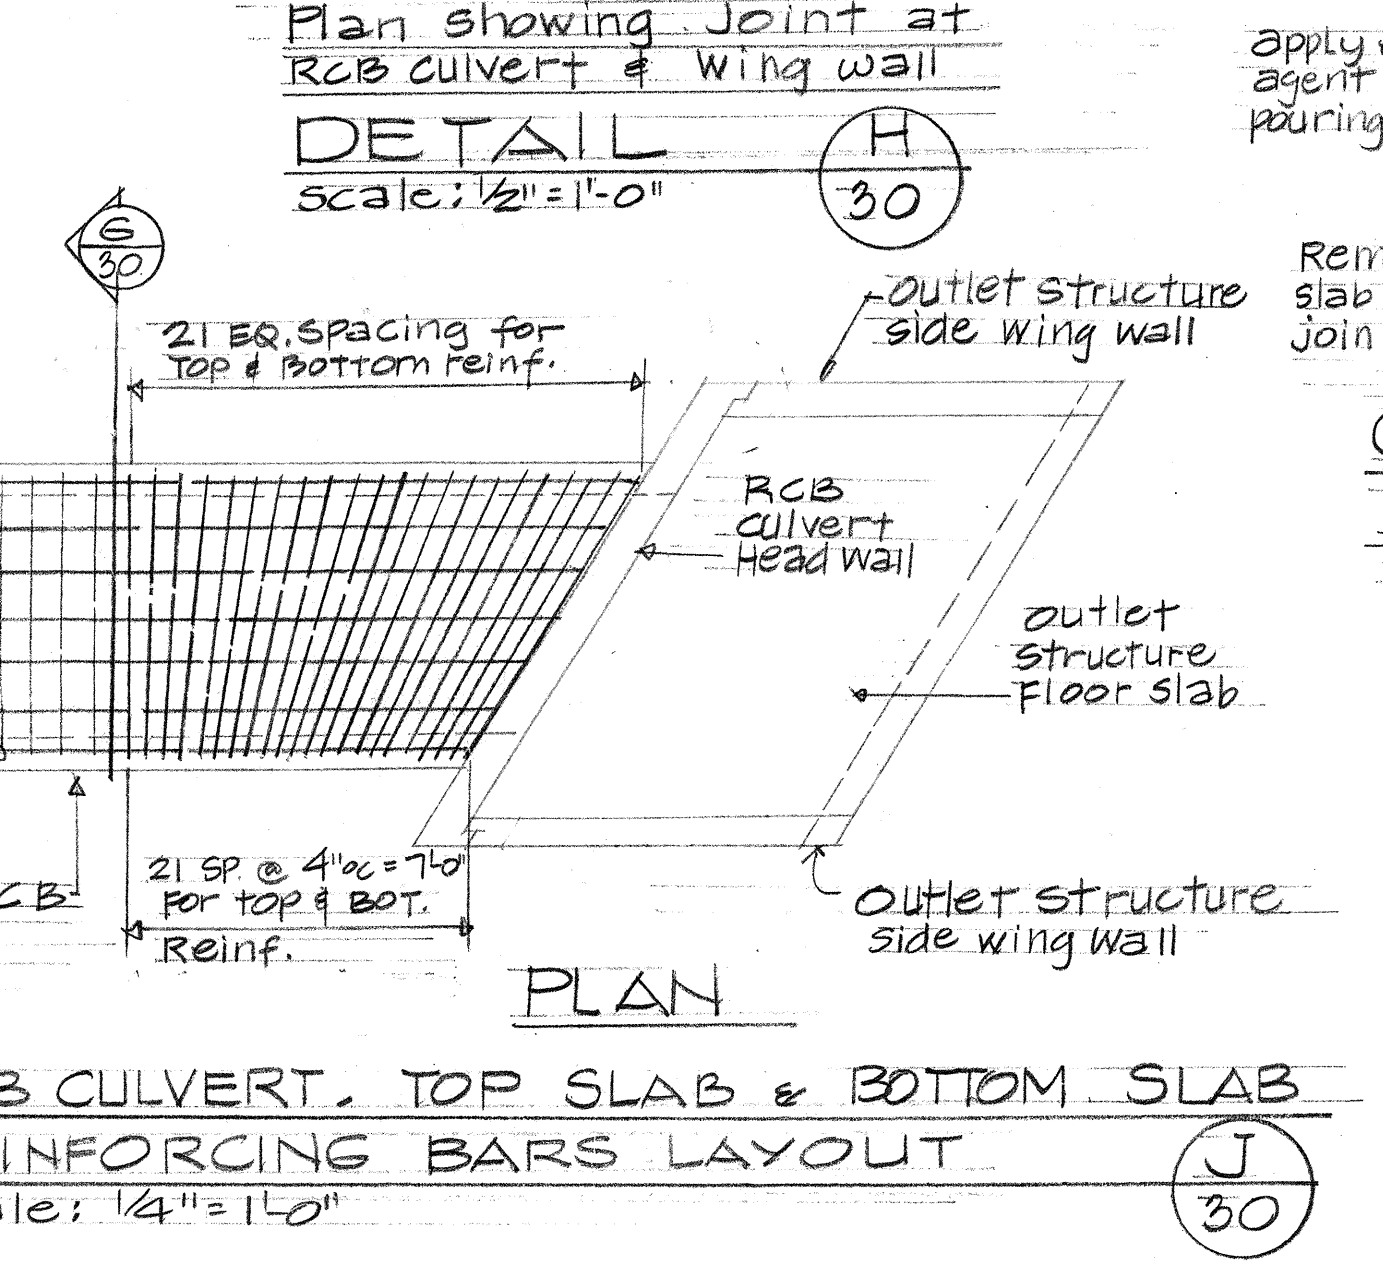
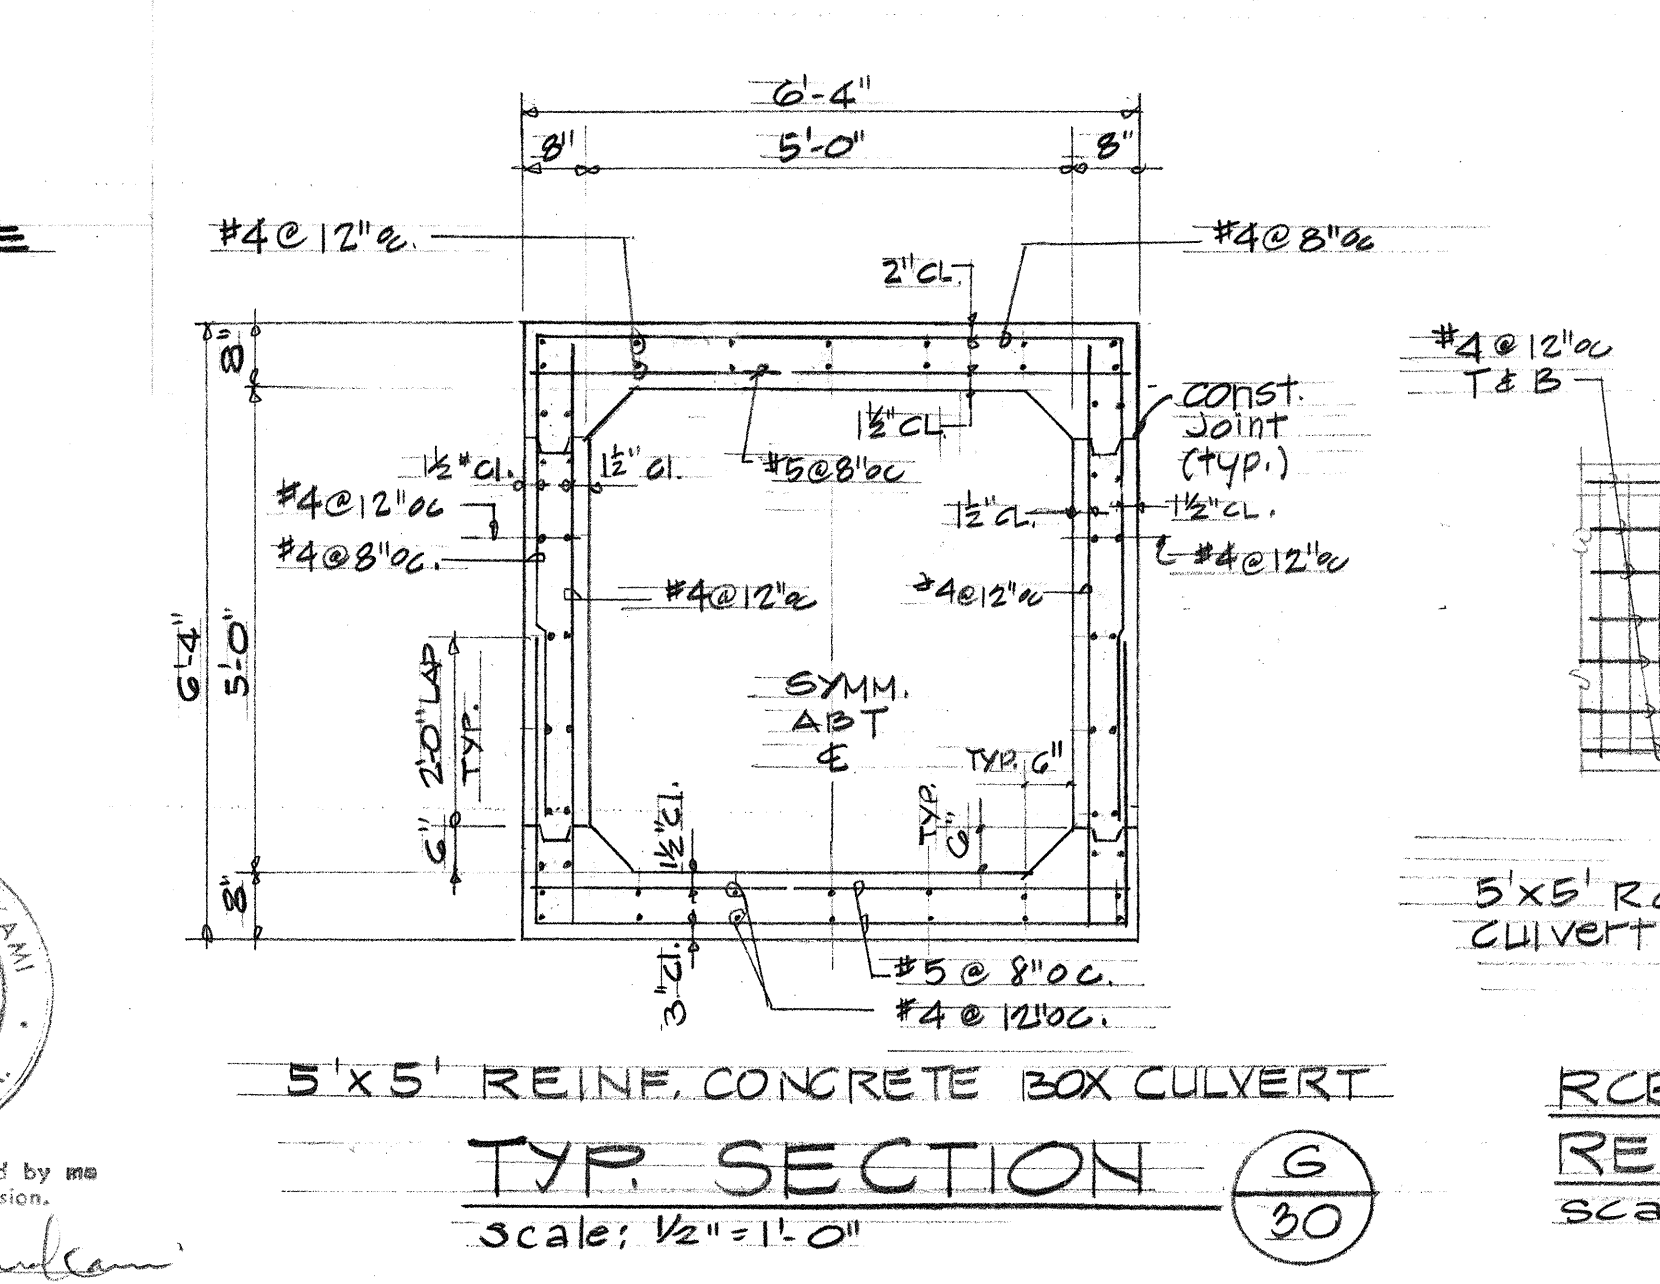
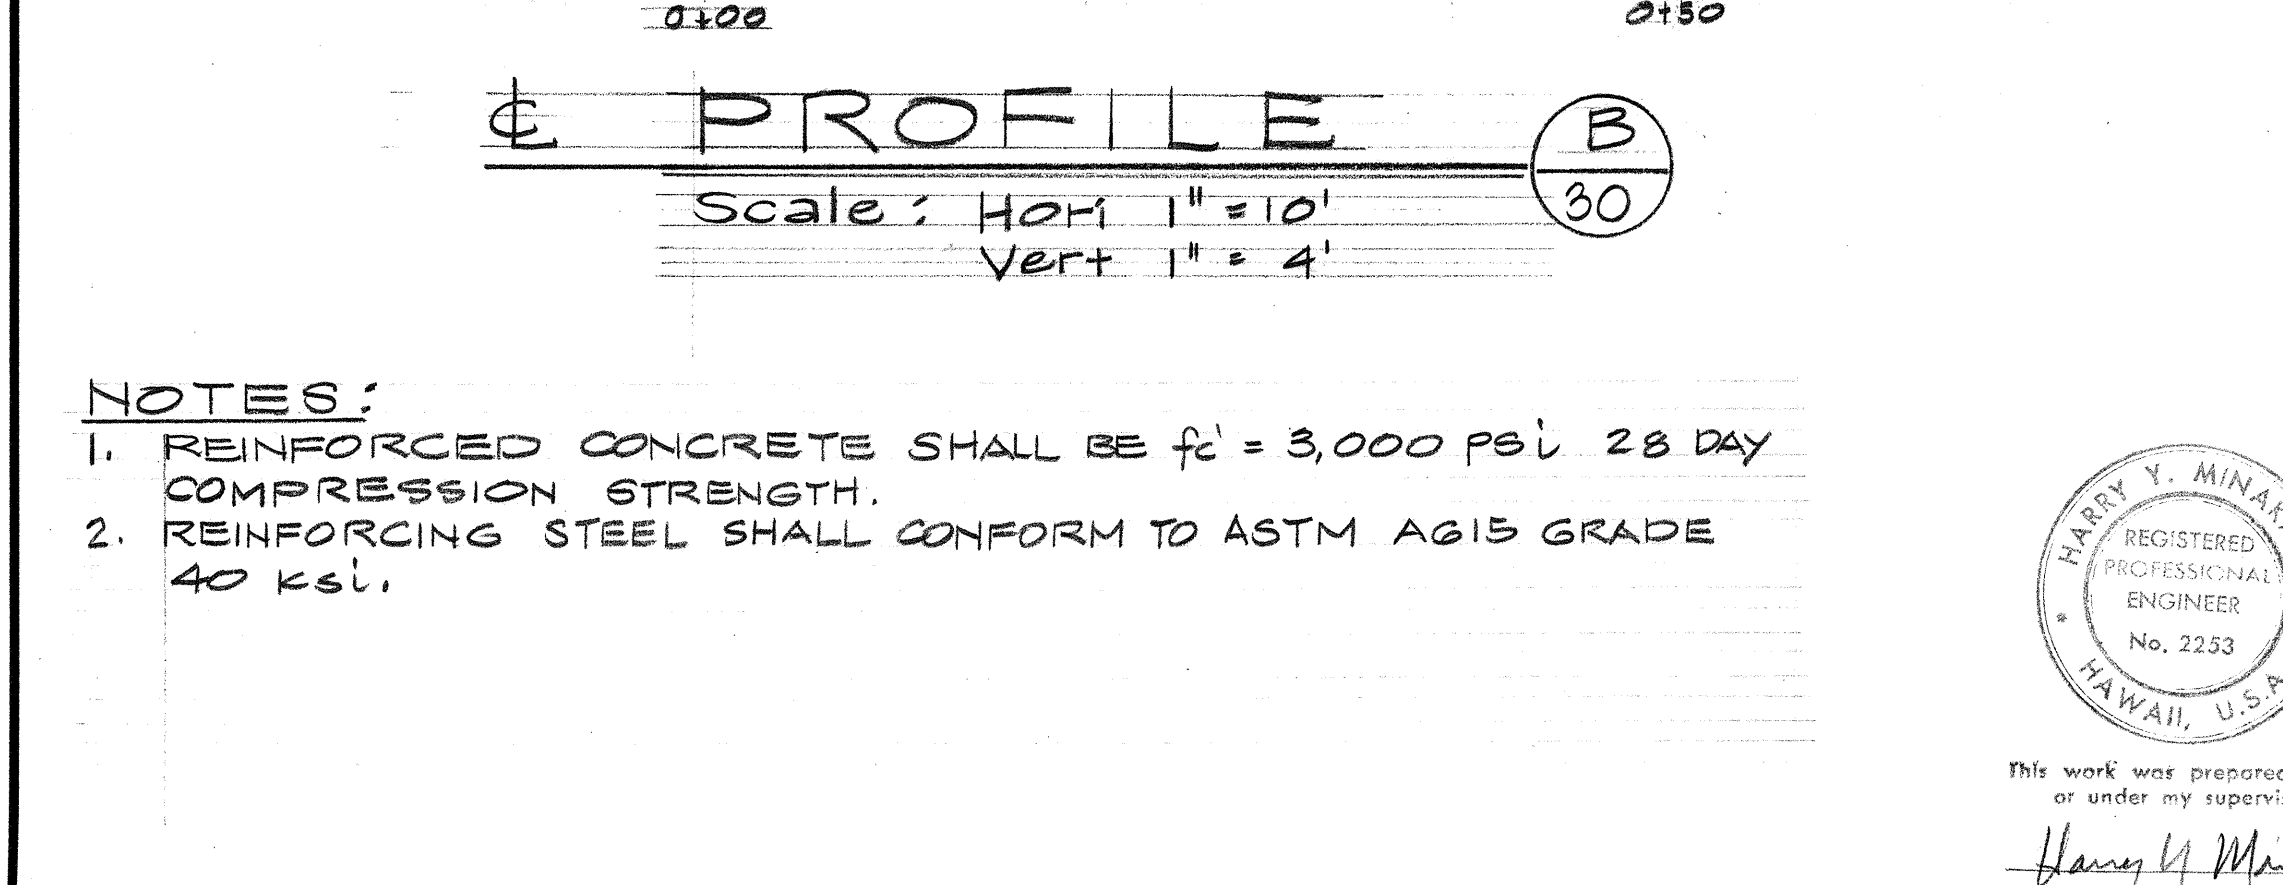
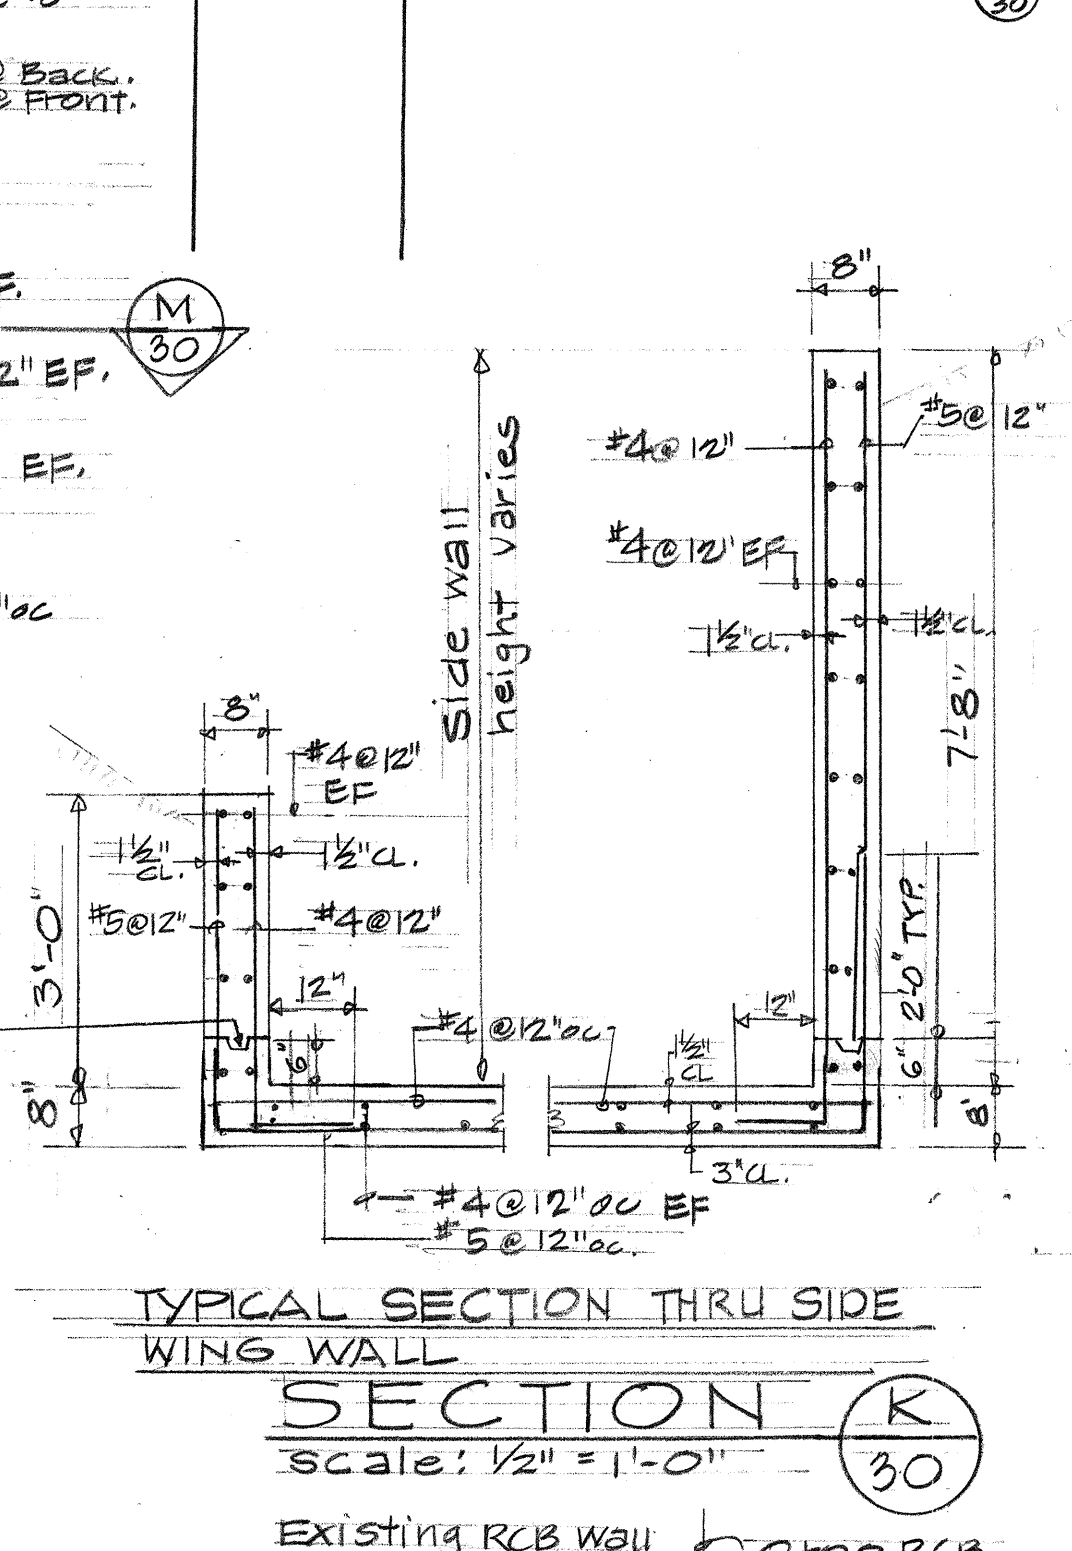
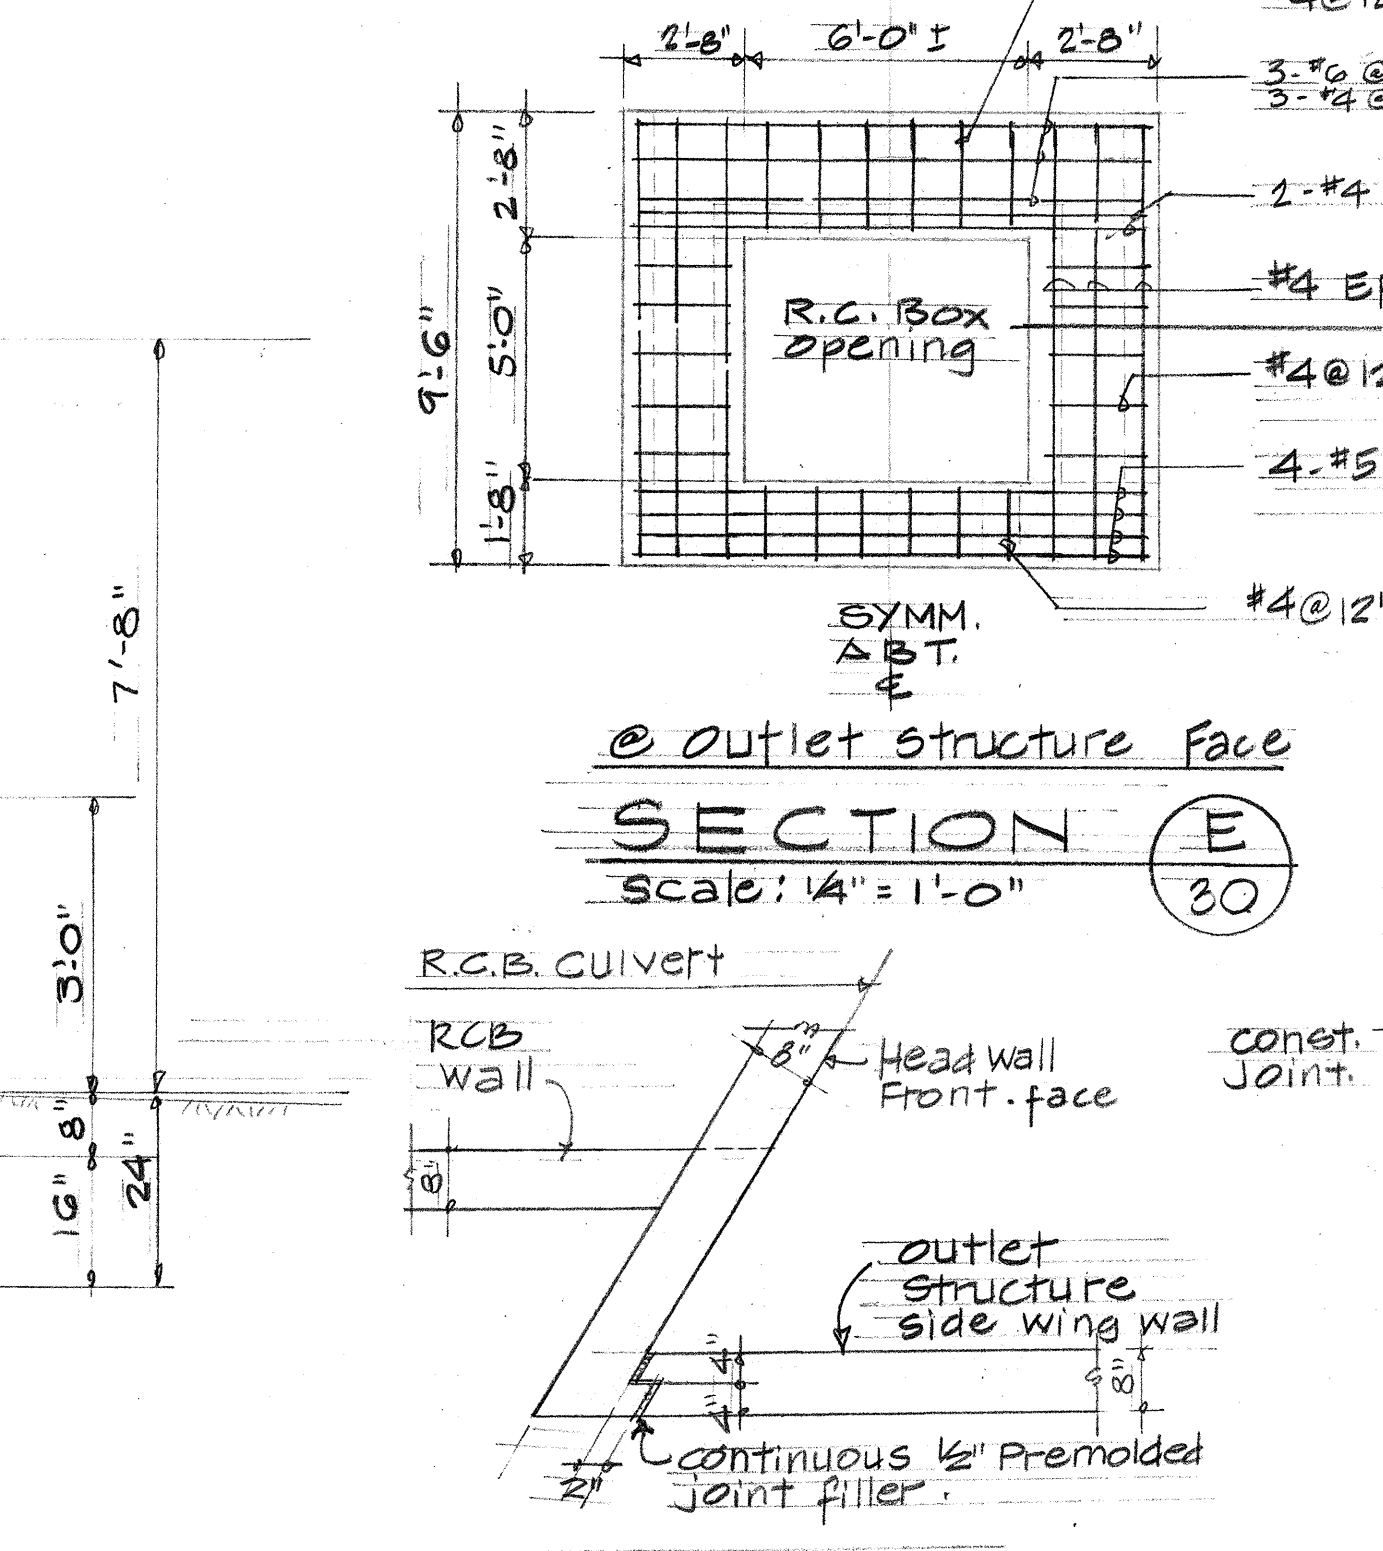
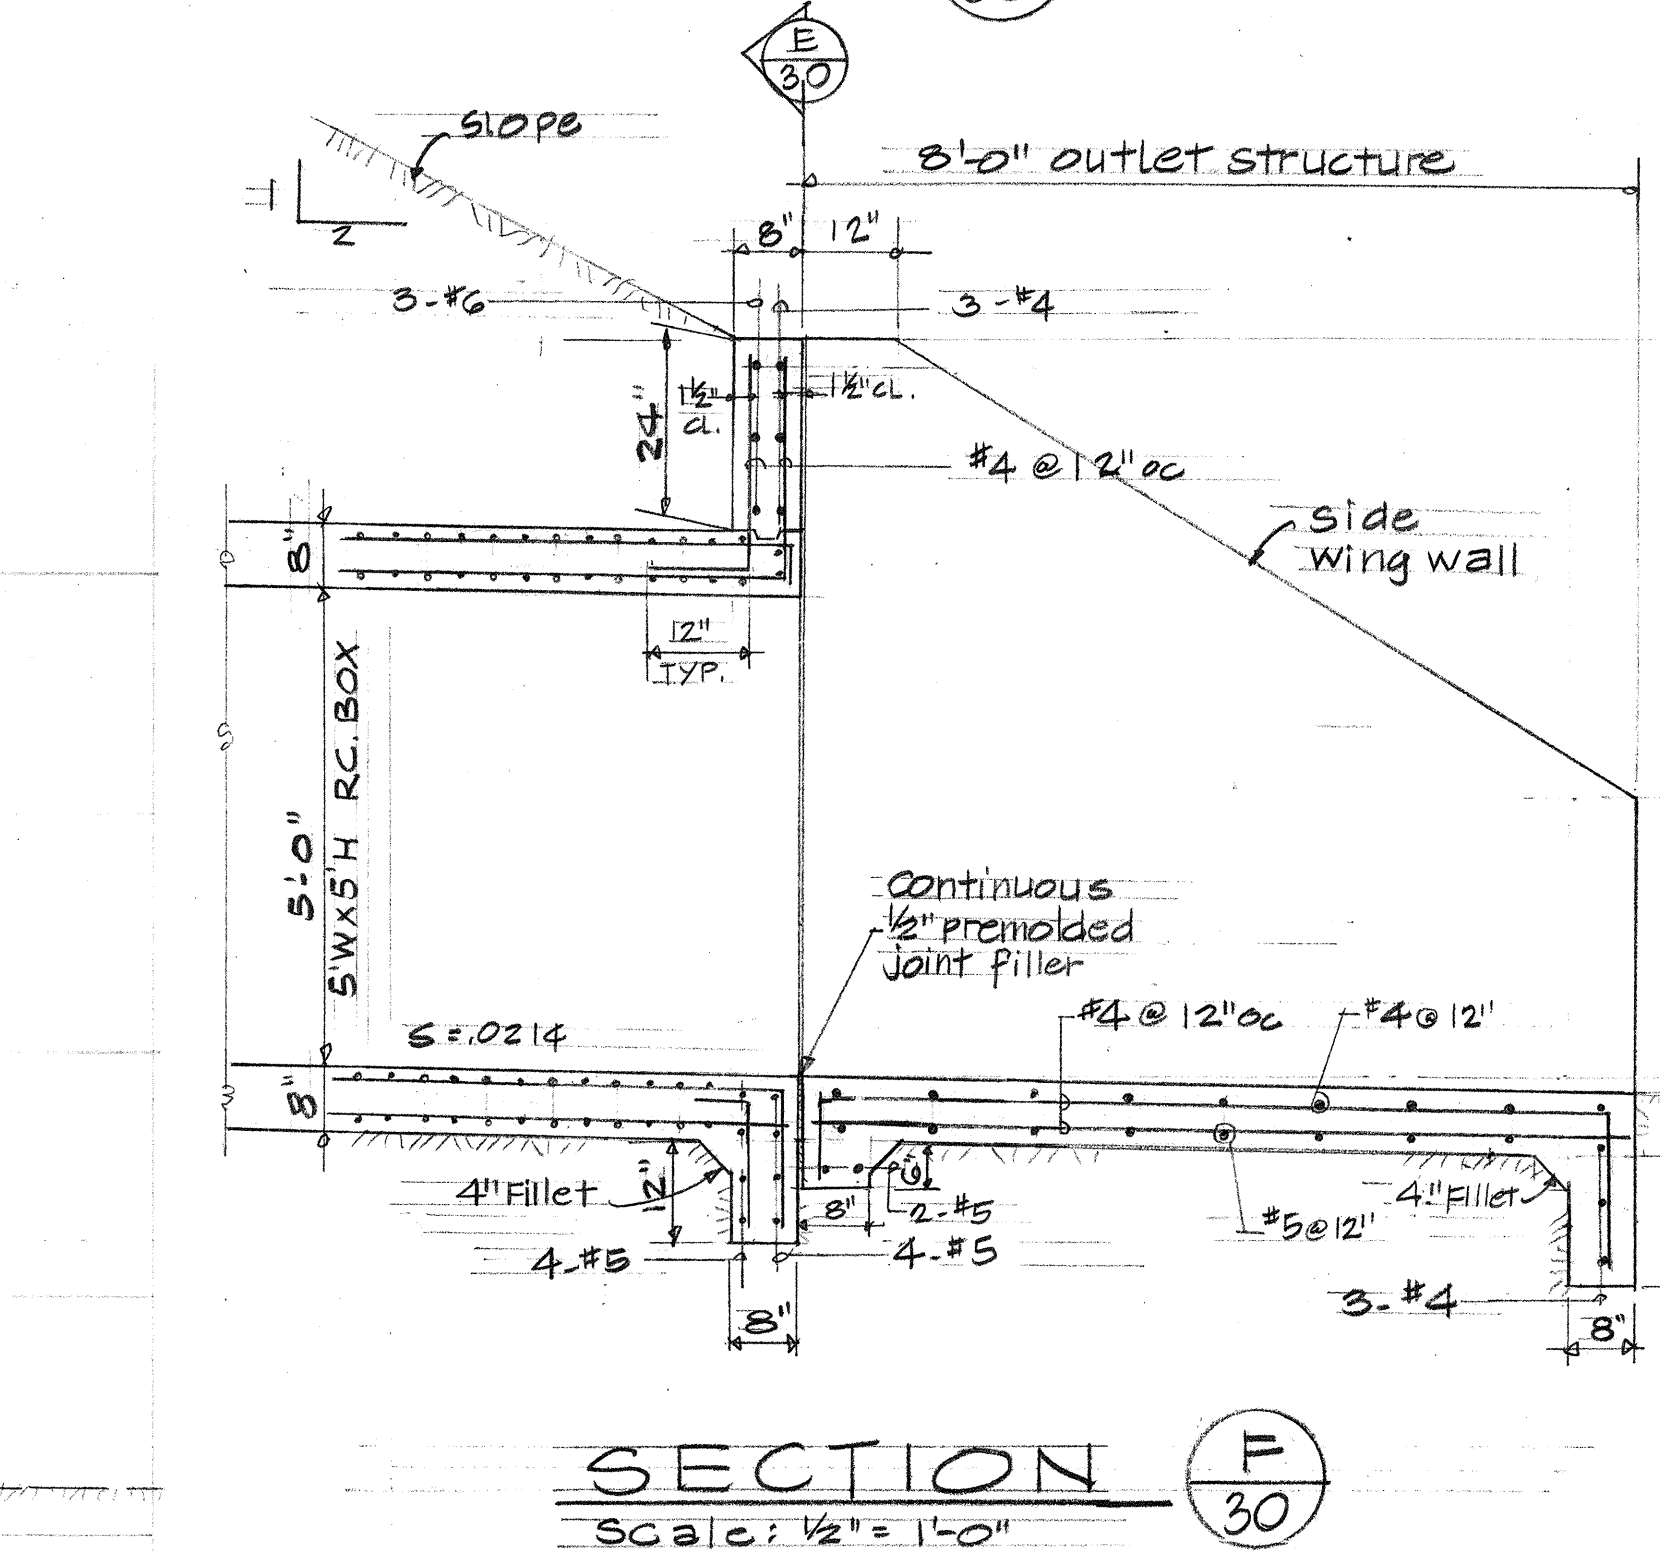
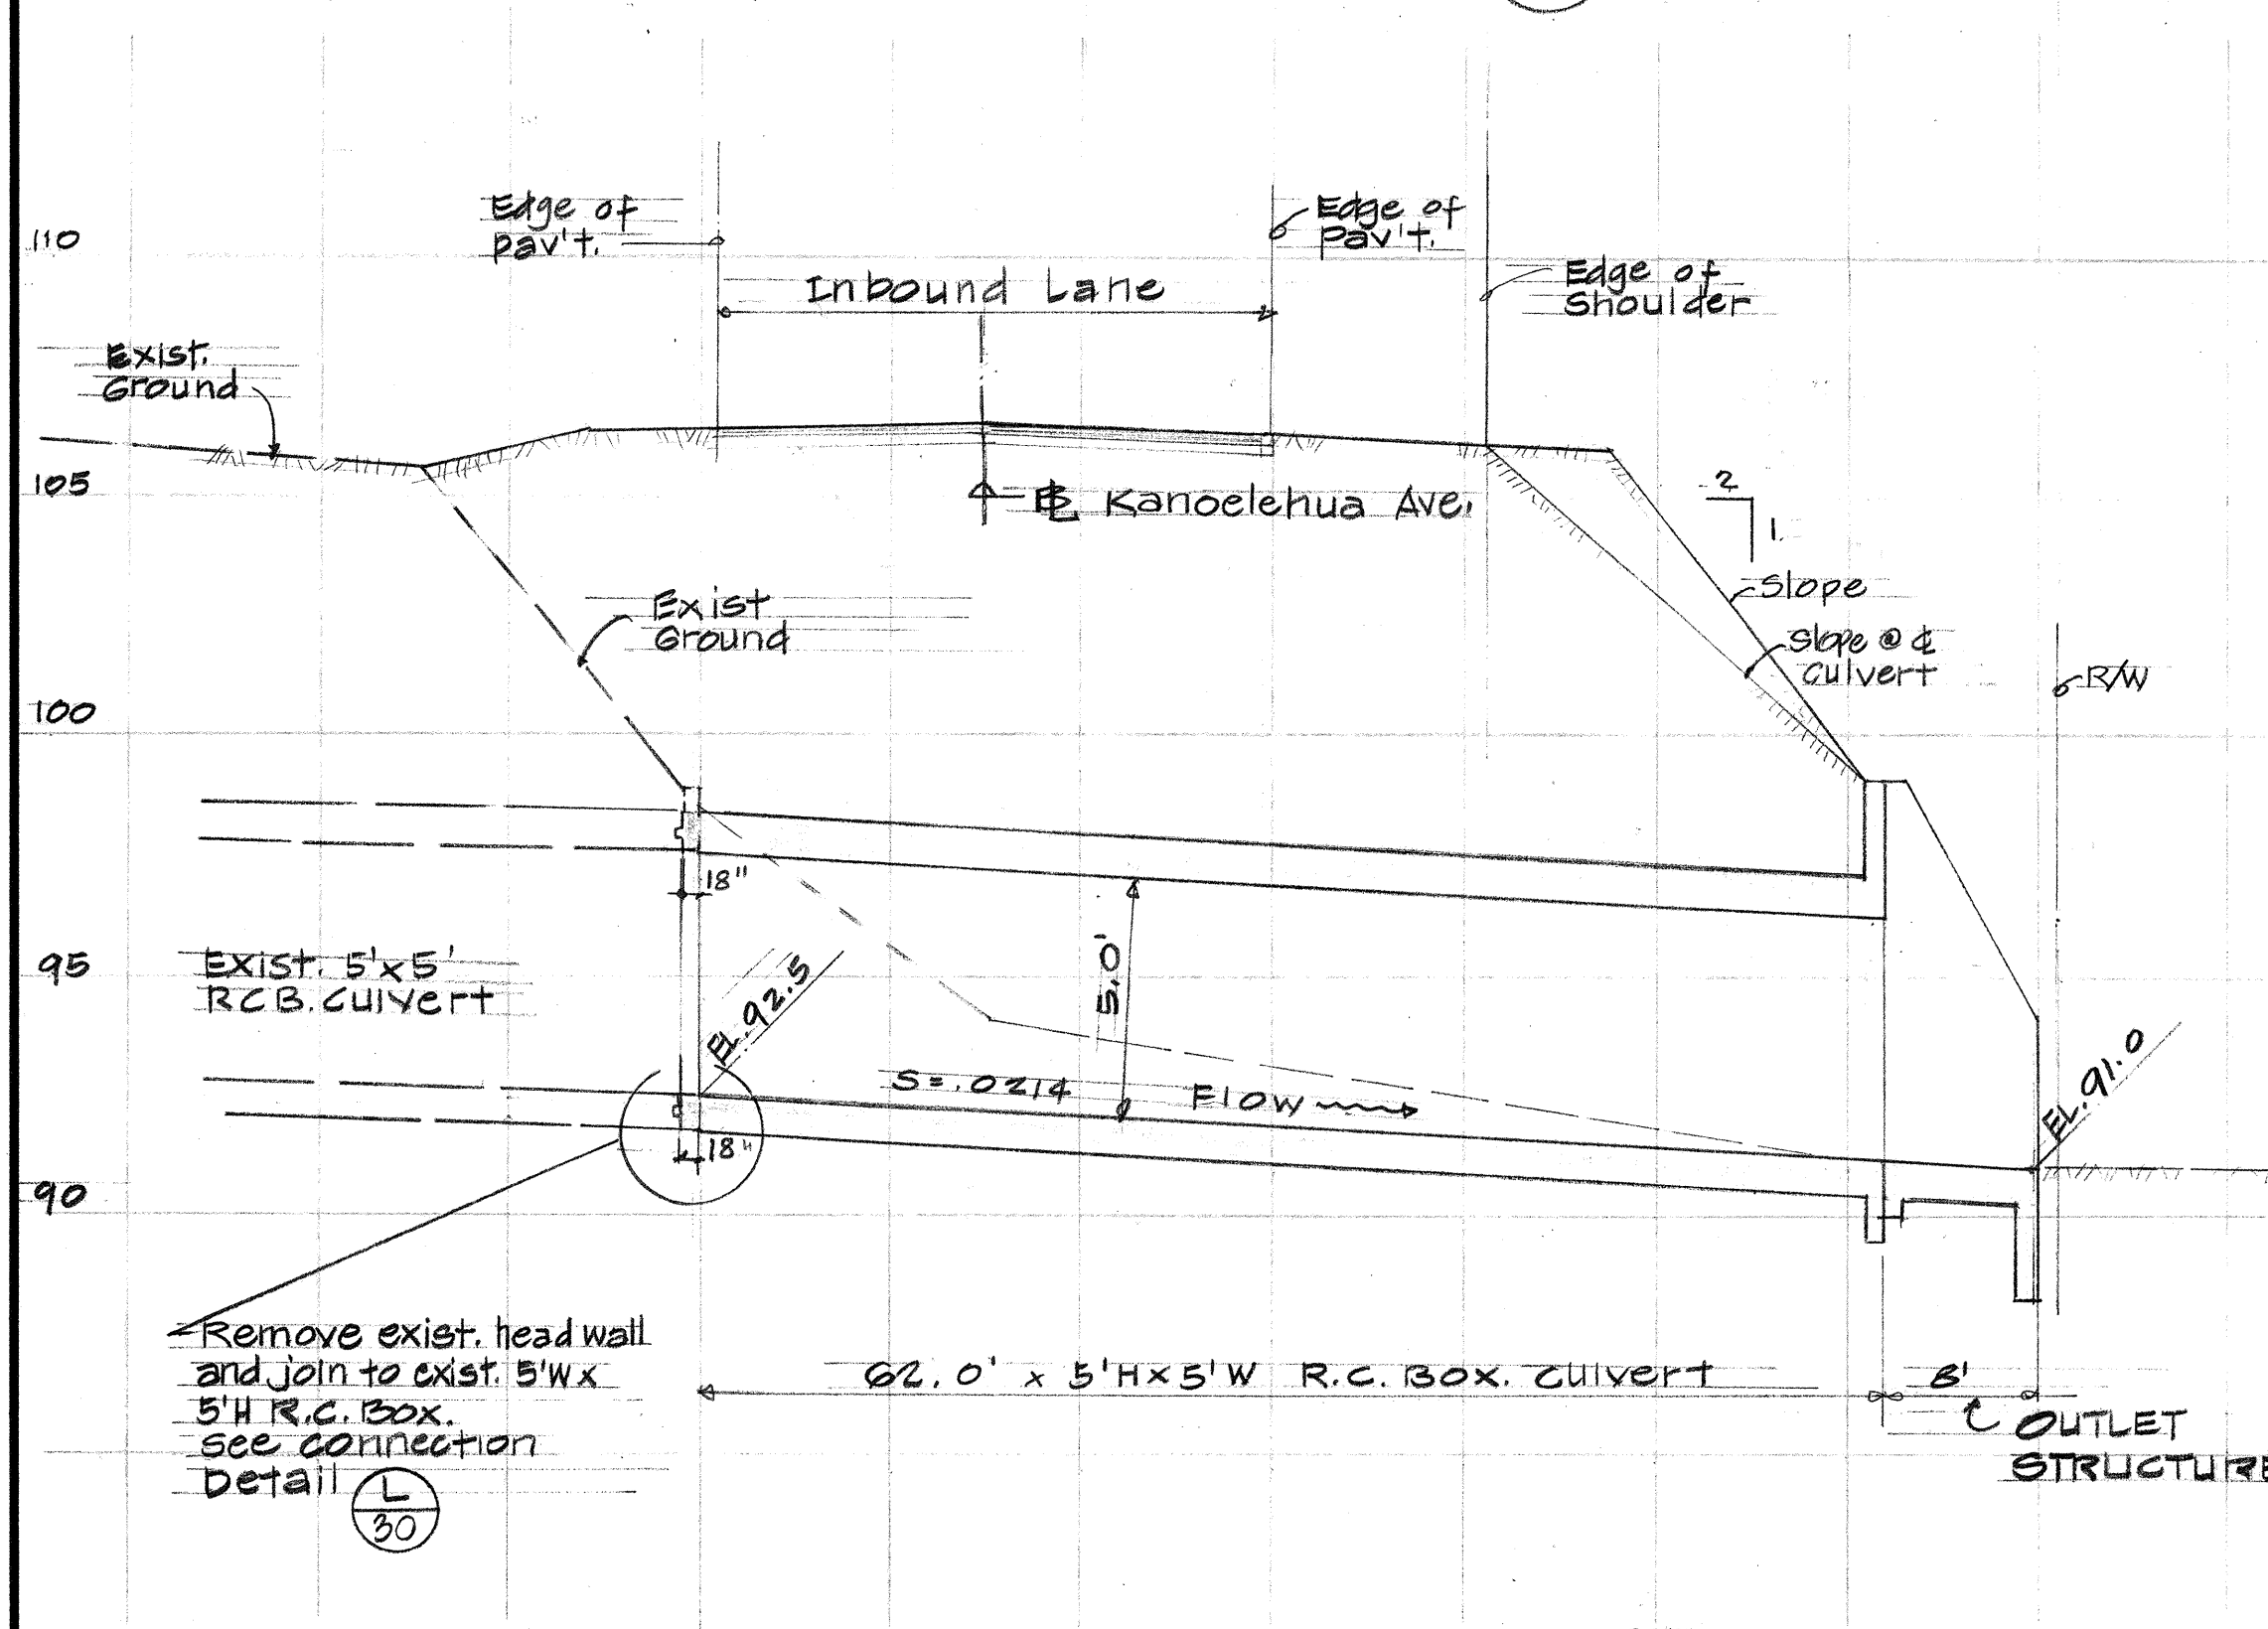
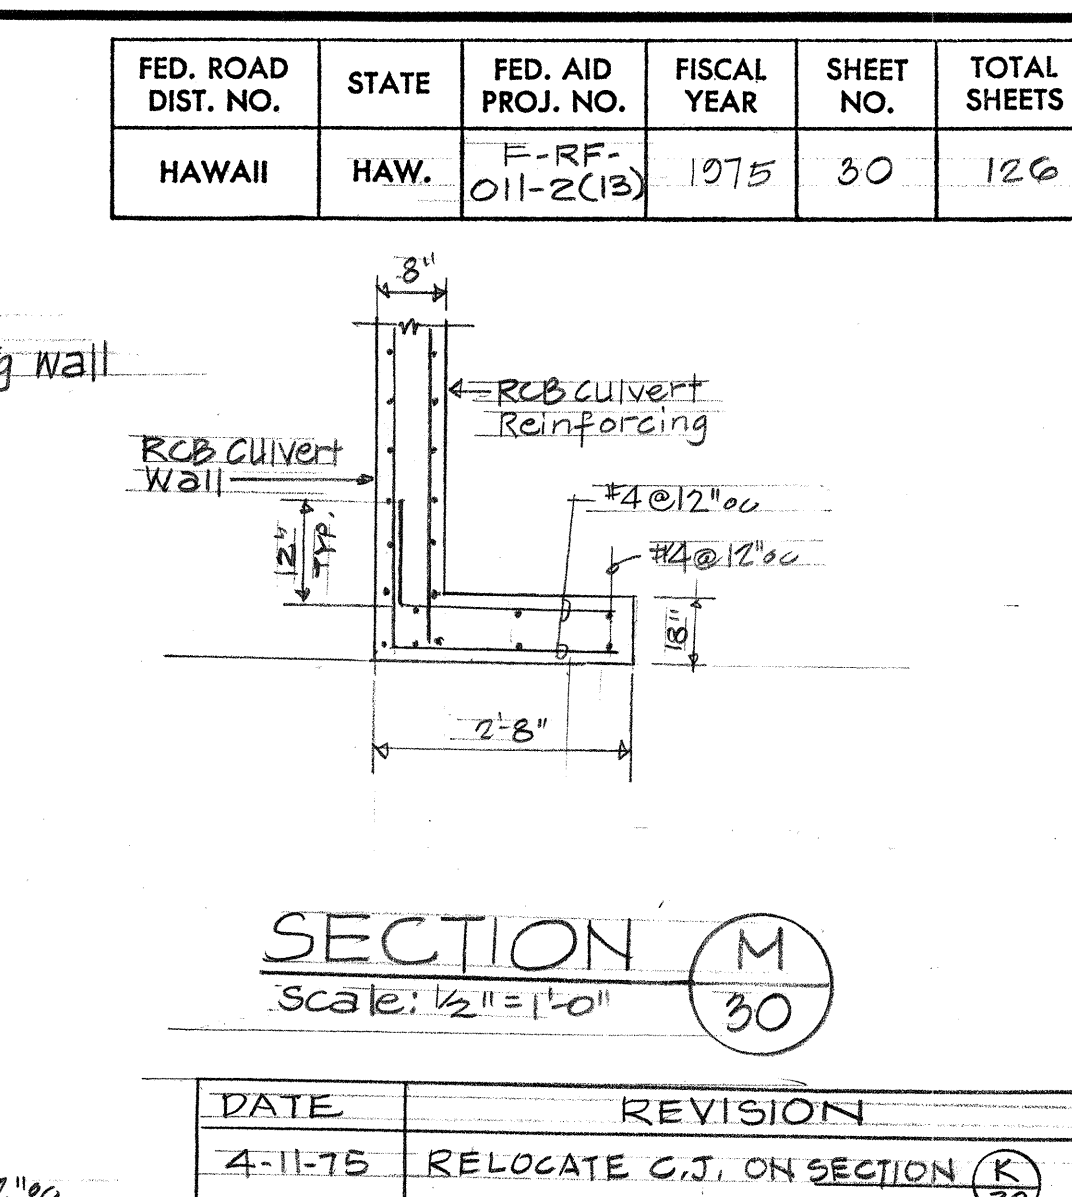
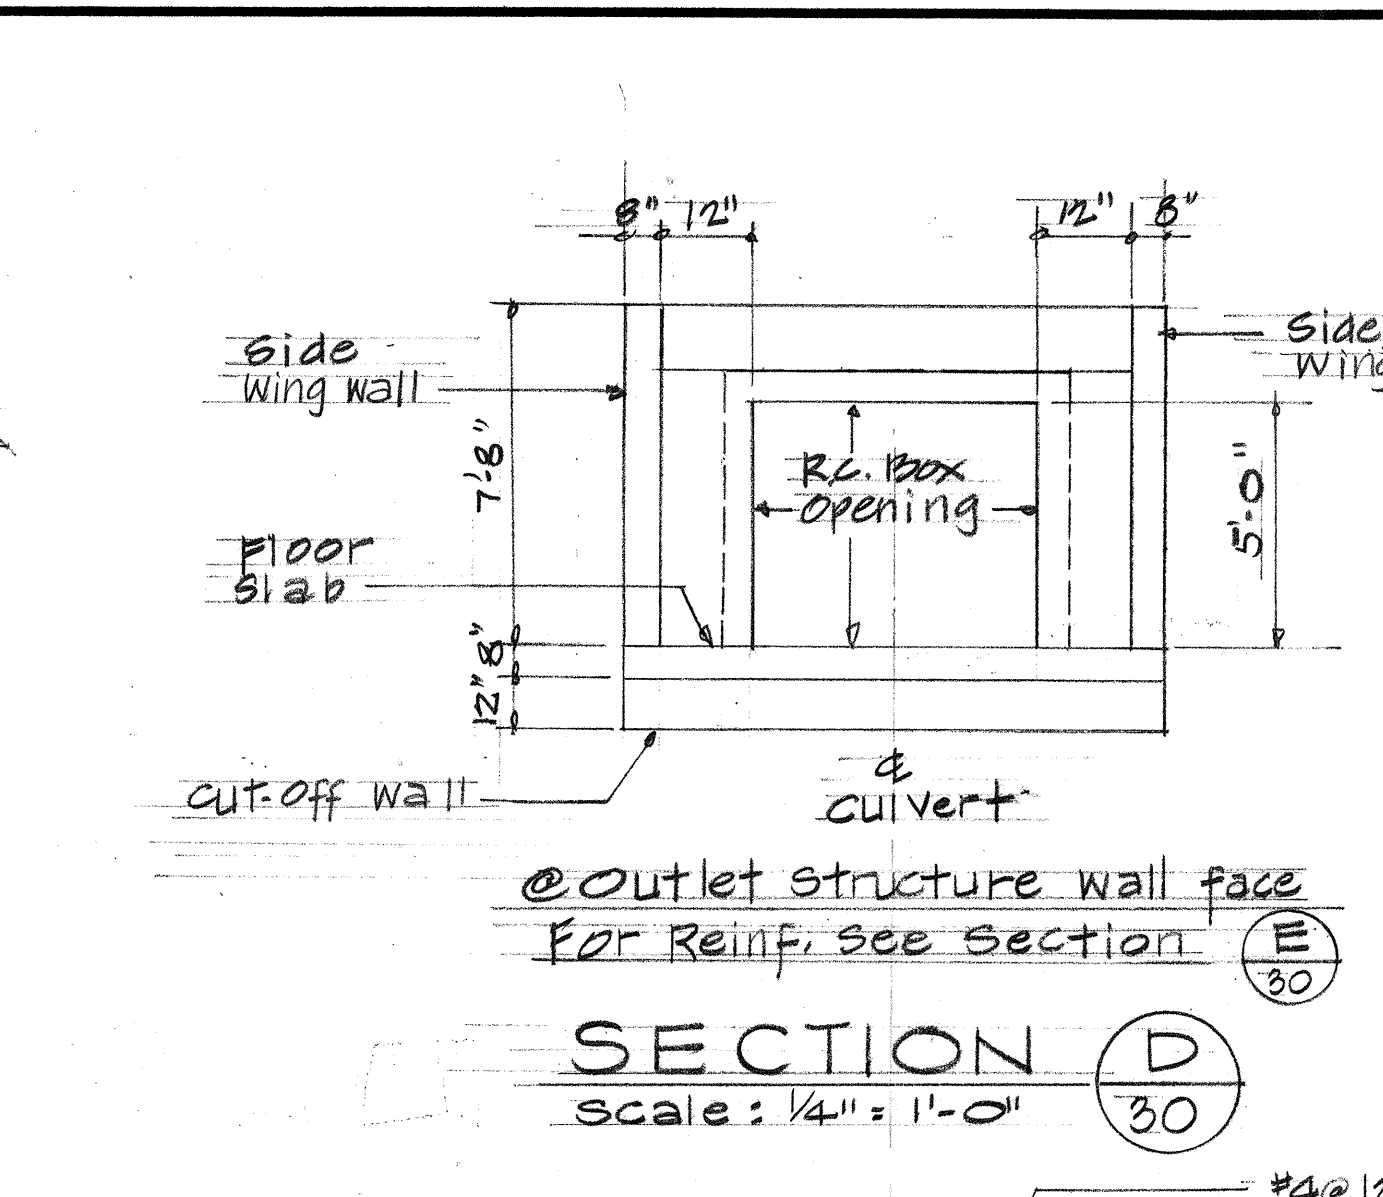
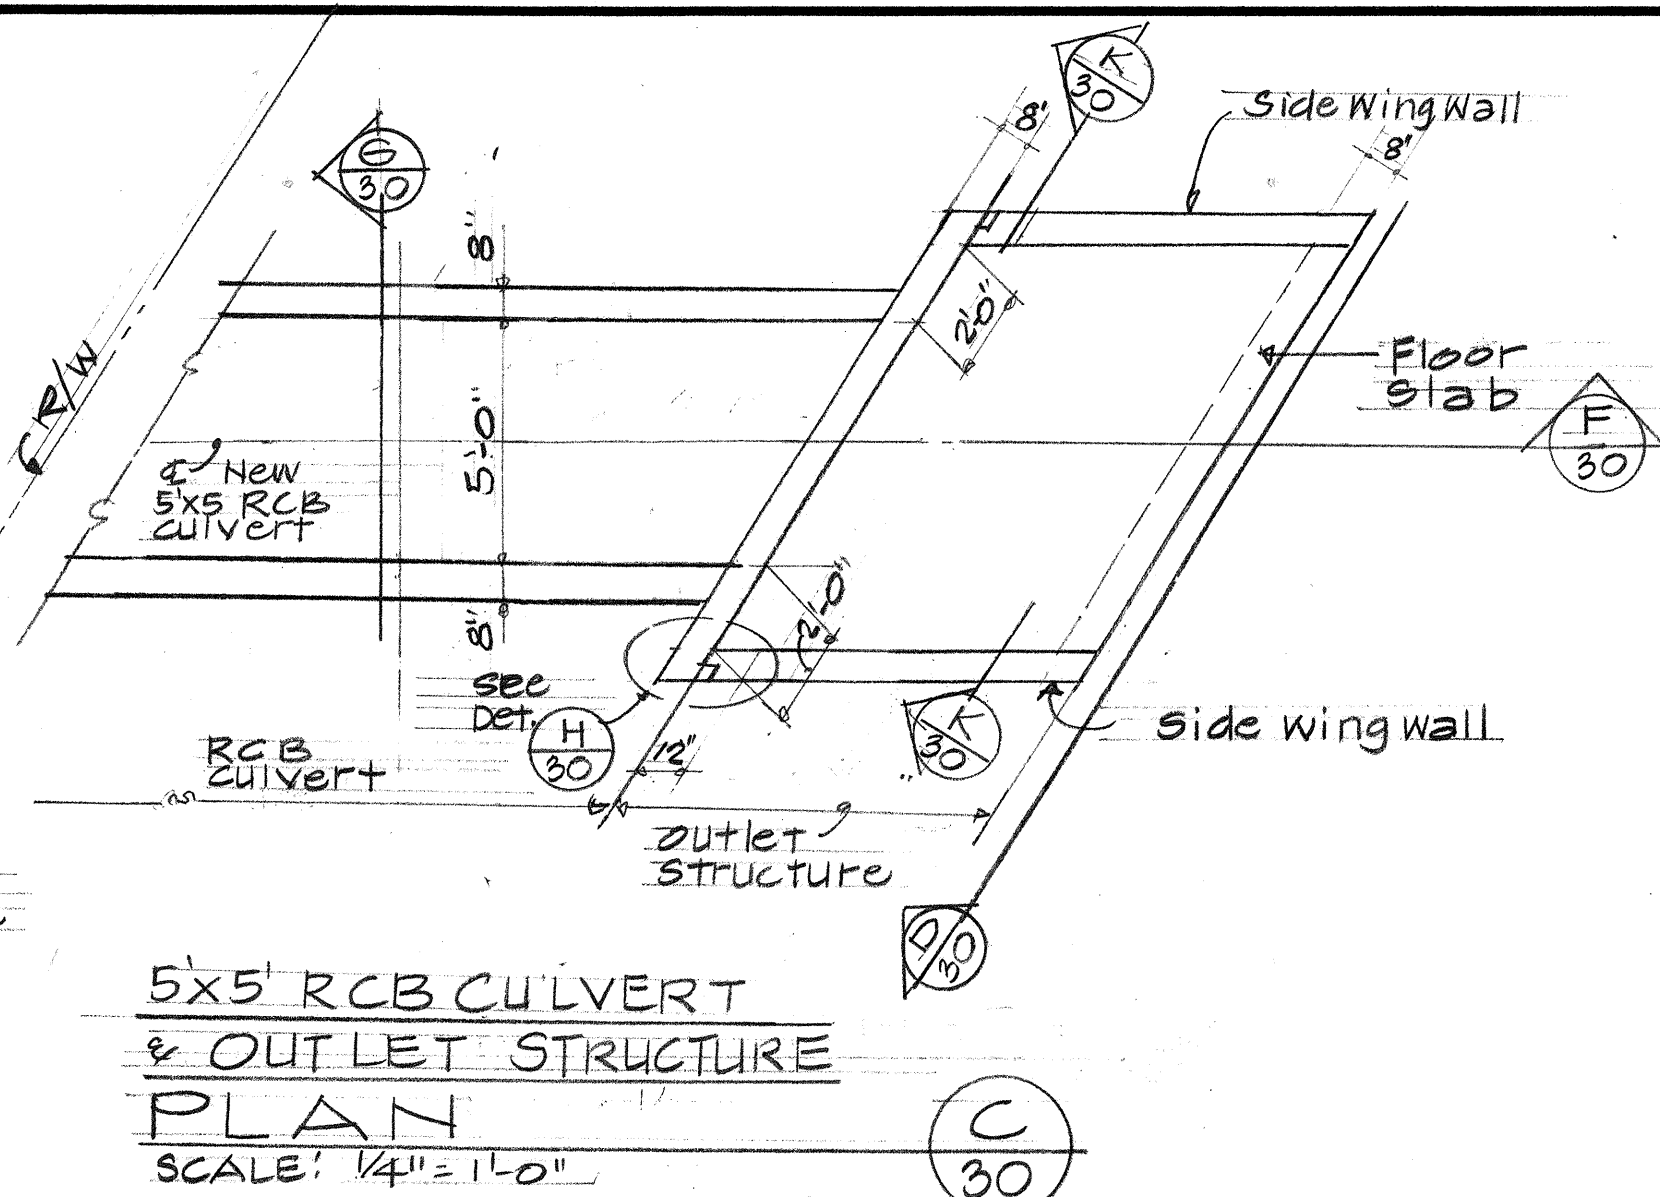


FED. ROAD DIST. NO.	STATE	FED. AID PROJ. NO.	FISCAL YEAR	SHEET NO.	TOTAL SHEETS
HAWAII	HAW.	F-RF-011-2(13)	1975	30	126

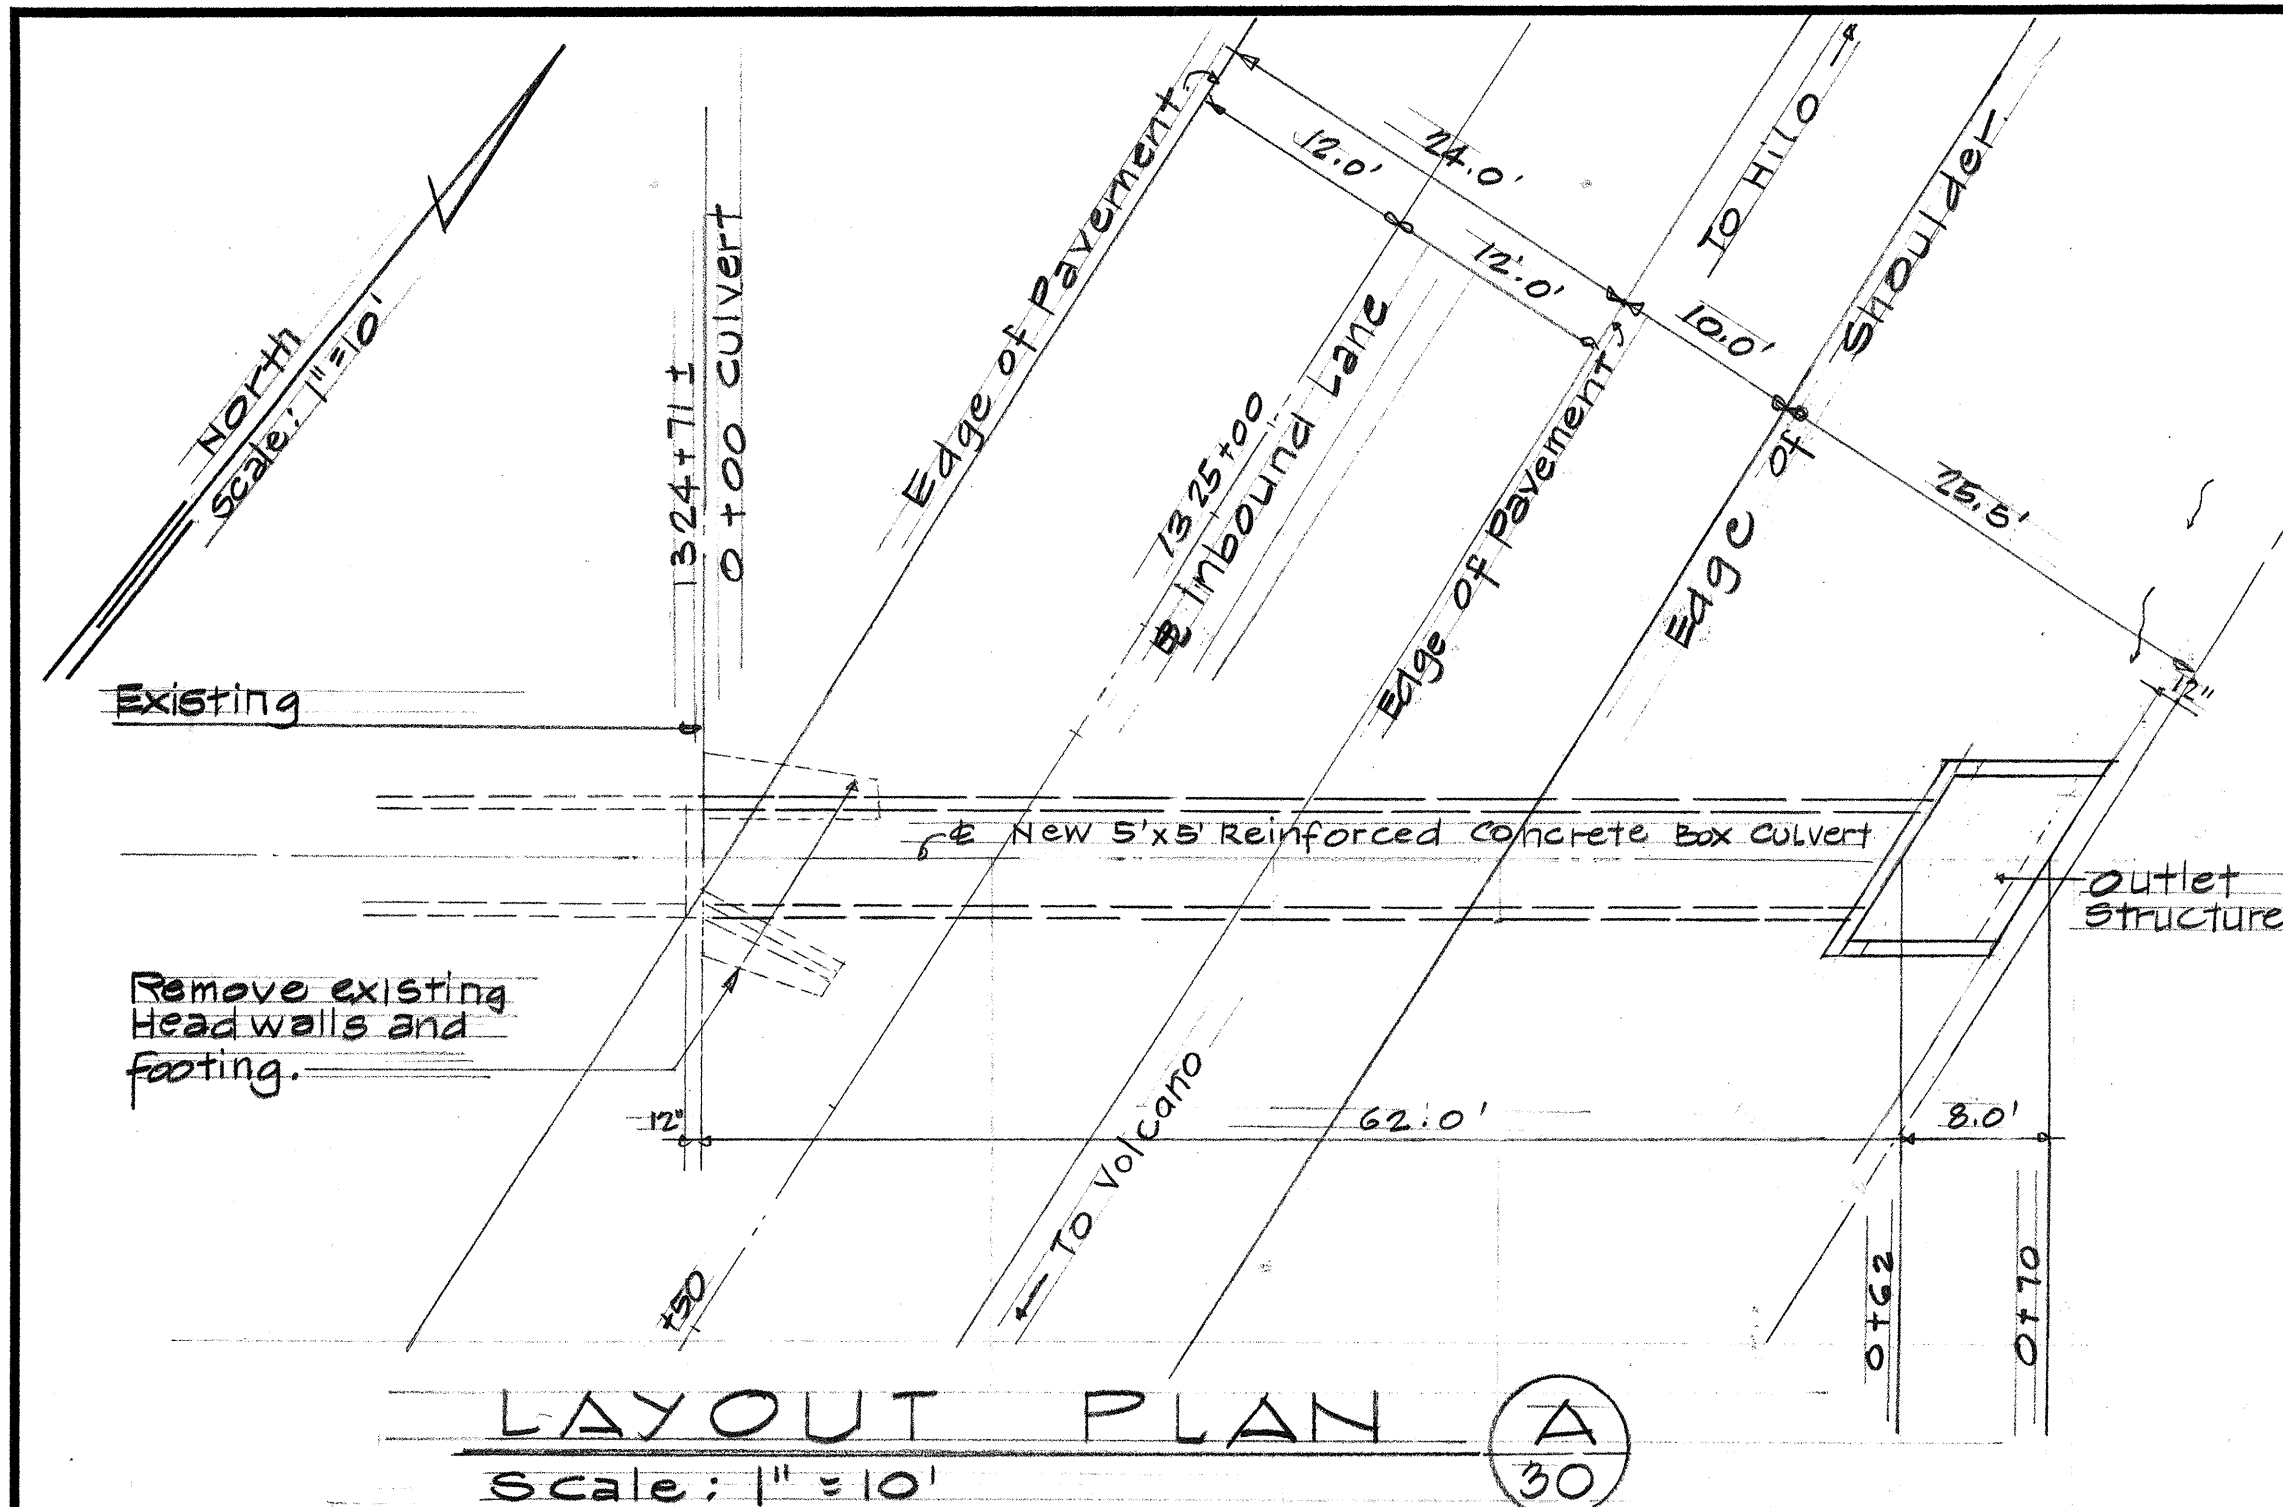

DATE	
DESIGNED BY	
CHECKED BY	
IN CHARGE	
NOTED BY	
ORIGINAL	

- NOTES:
1. REINFORCED CONCRETE SHALL BE $f'_c = 3,000$ PSI 28 DAY COMPRESSION STRENGTH.
 2. REINFORCING STEEL SHALL CONFORM TO ASTM A615 GRADE 40 KSI.

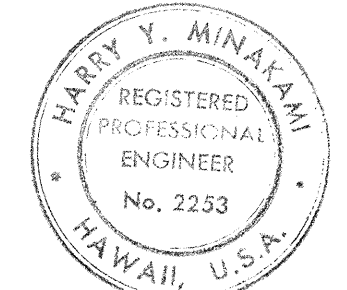

This work was prepared by me or under my supervision.
Harry Y. Minikami

STATE OF HAWAII
DEPARTMENT OF TRANSPORTATION
HIGHWAYS DIVISION

5'x5' RCB CULVERT AND OUTLET STRUCTURE STA. 1324+71.1 KANOELEHUA AVE. O'HOO CULVERT PLAN, PROFILE, SECTIONS & DETAILS KANOELEHUA AVE. KAKALEKA ST. TO KAMEHAMEHA AVE. Federal Aid Project No. F-RF-011-2(13) Scale: As Shown.

SHEET No. 1 OF 1 SHEETS