
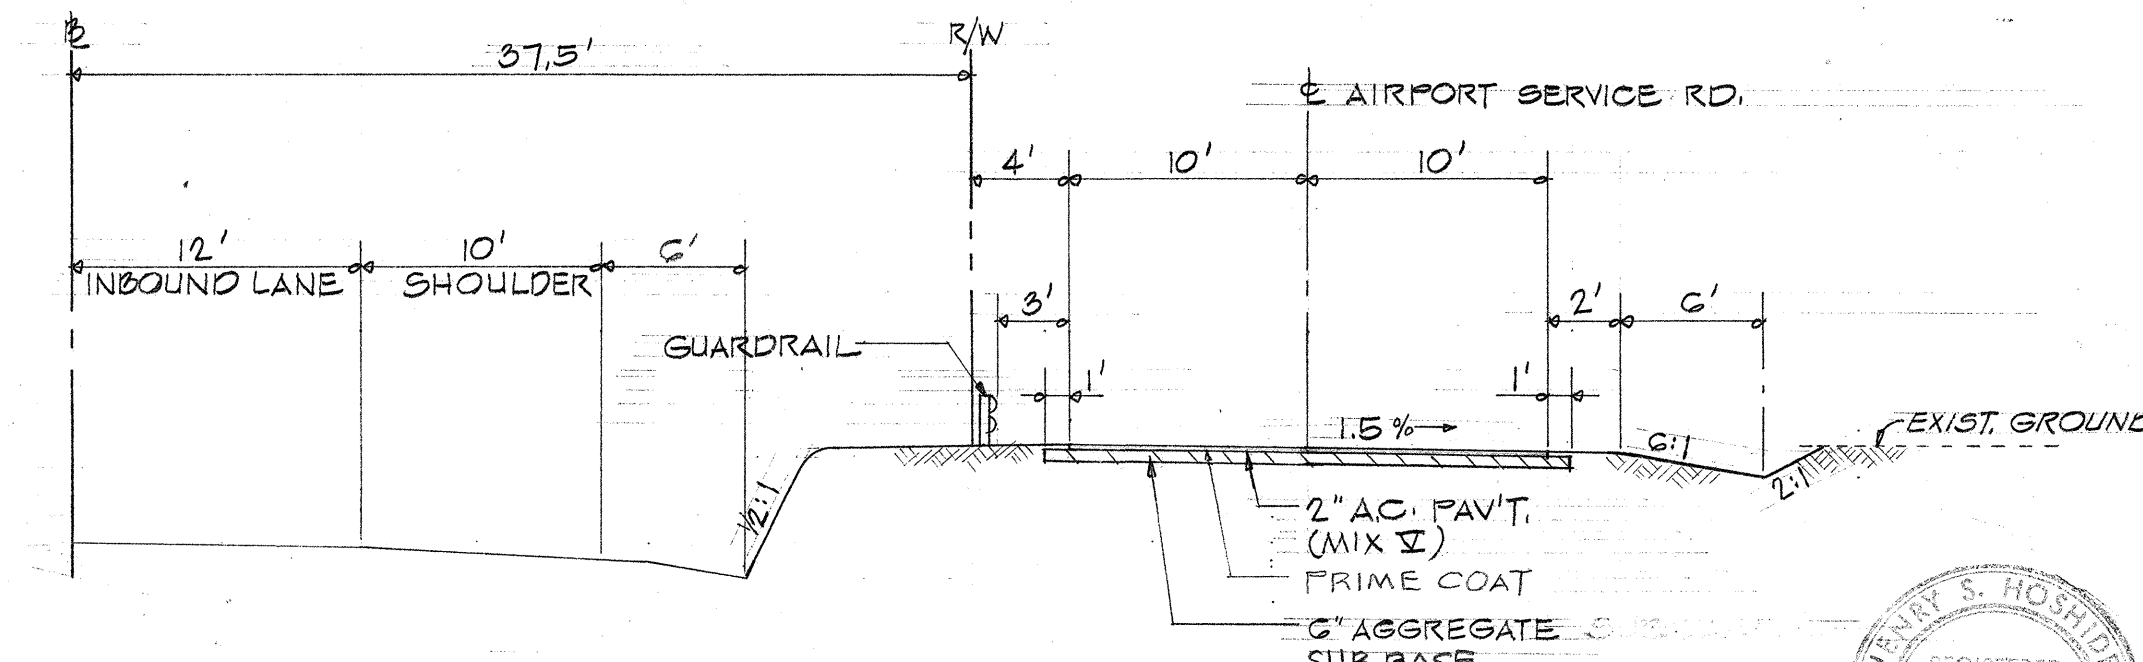
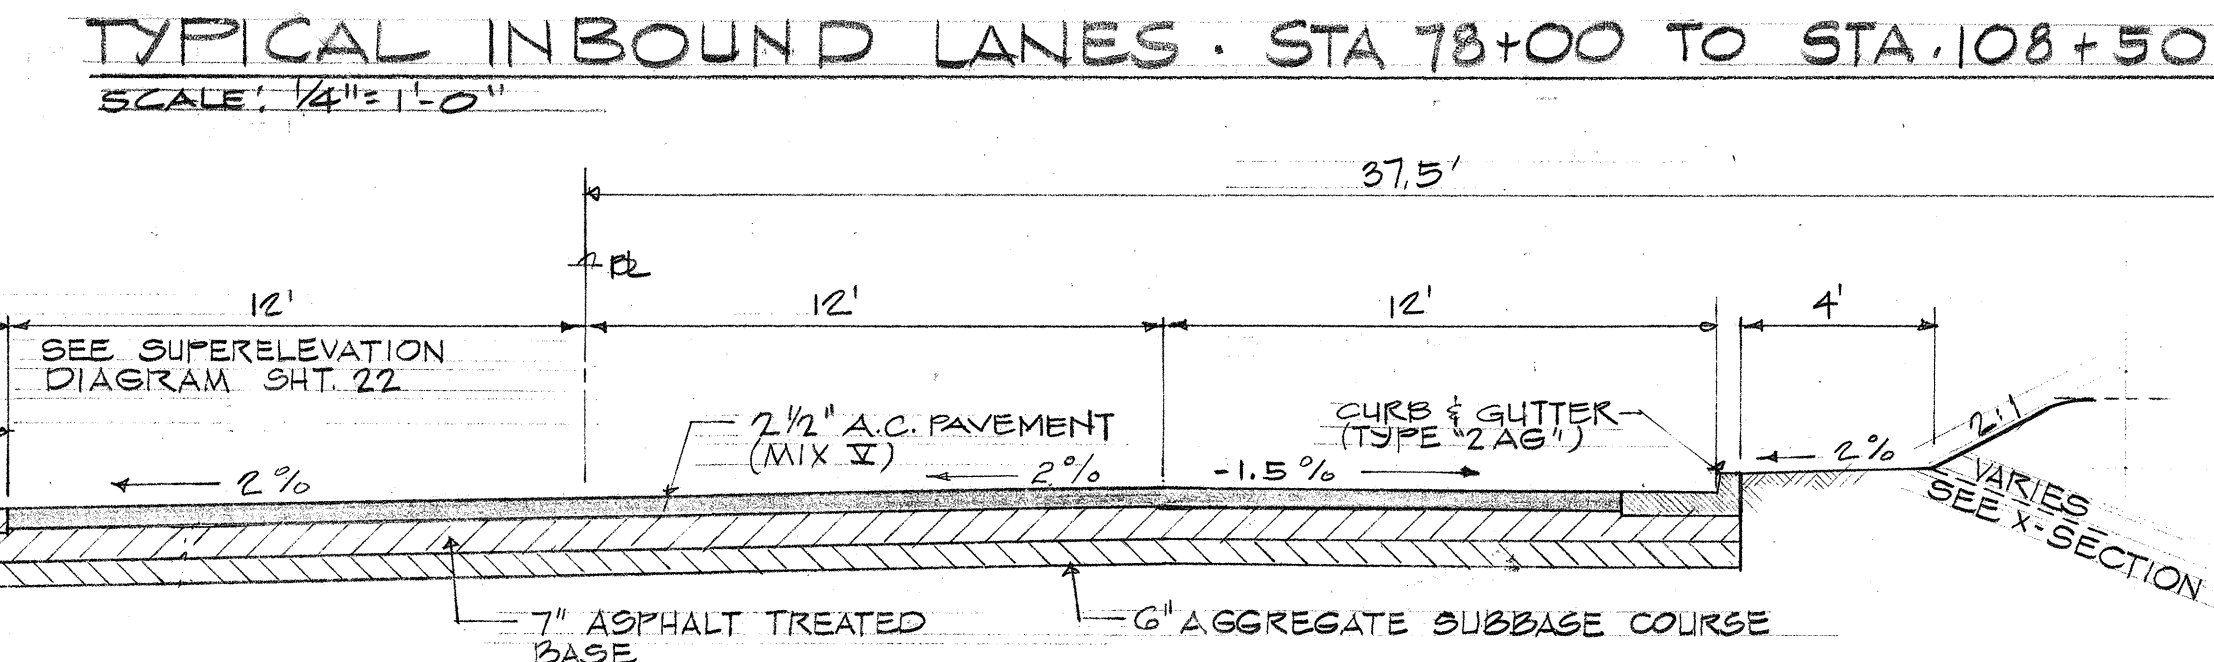
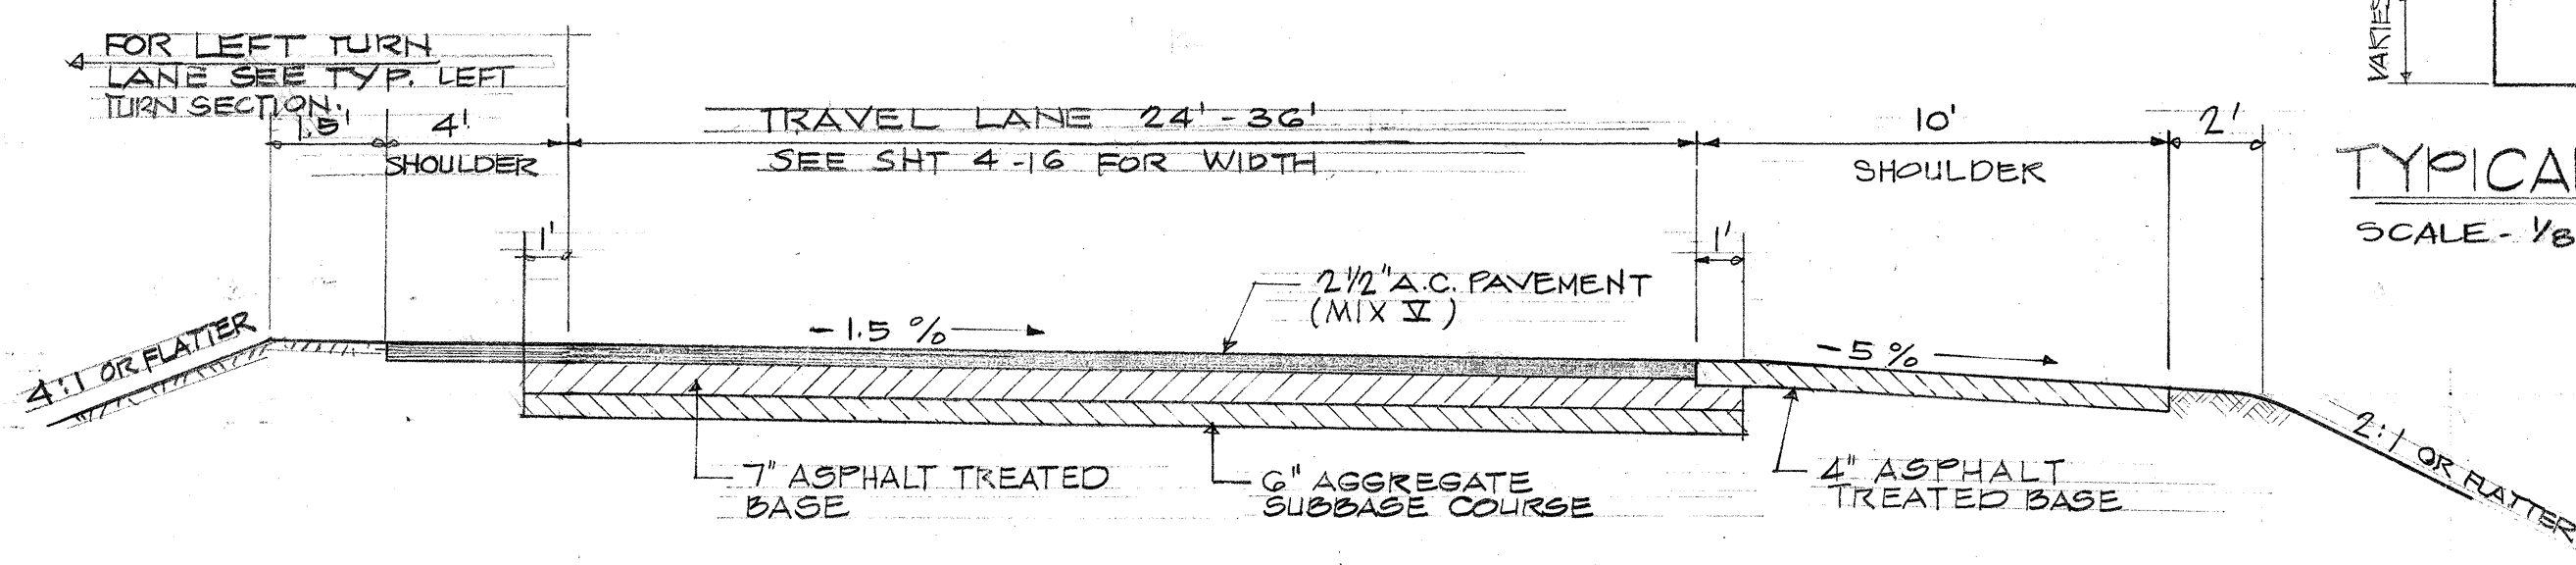
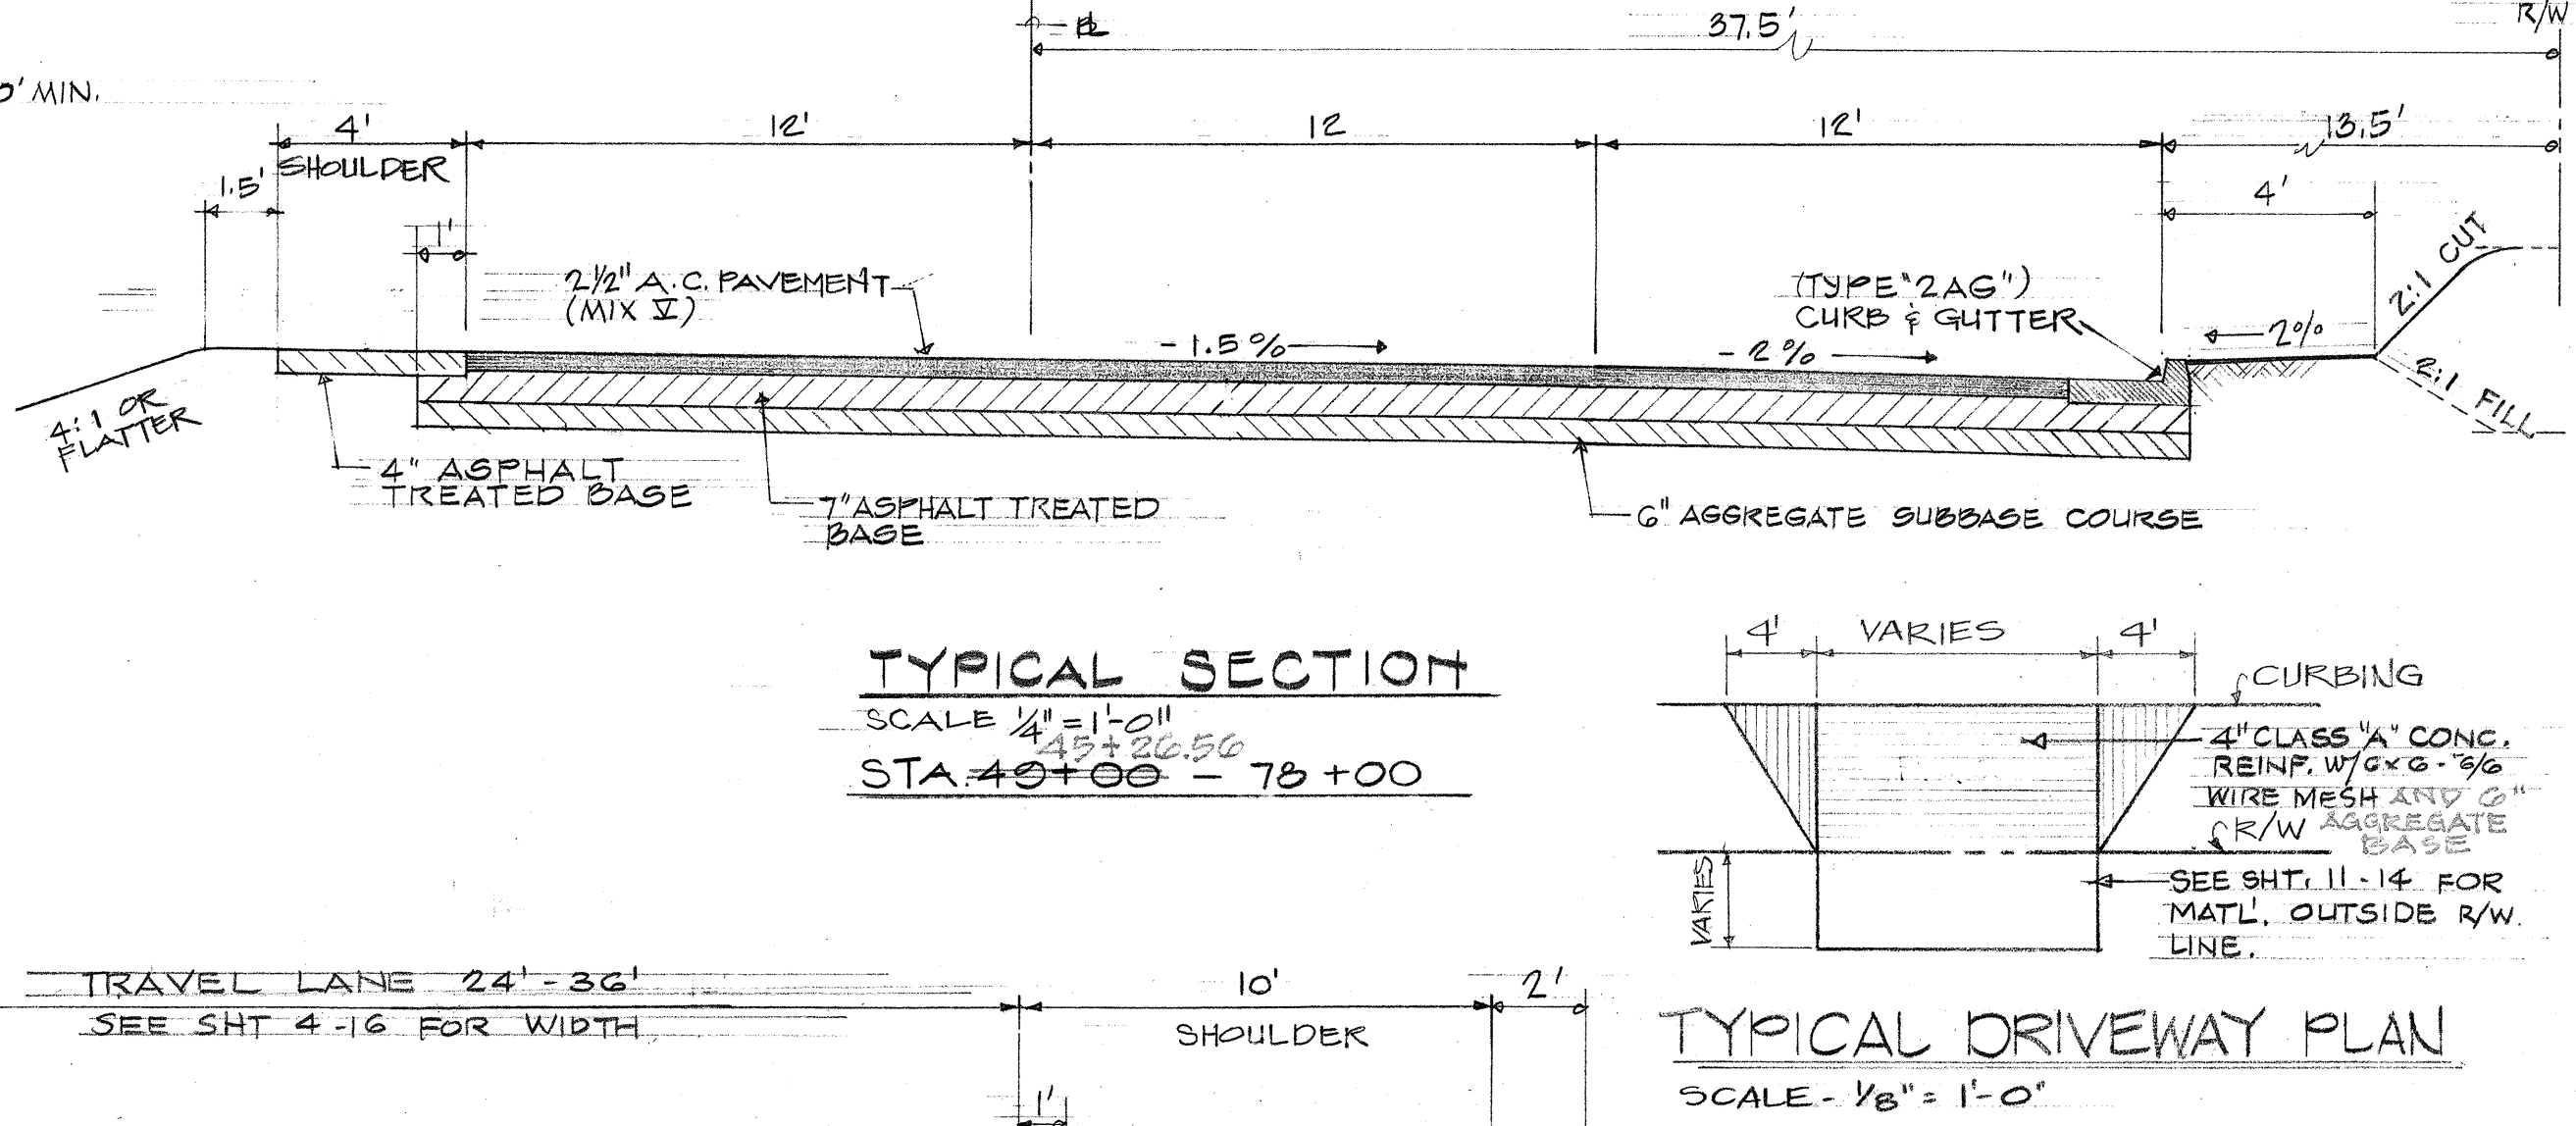
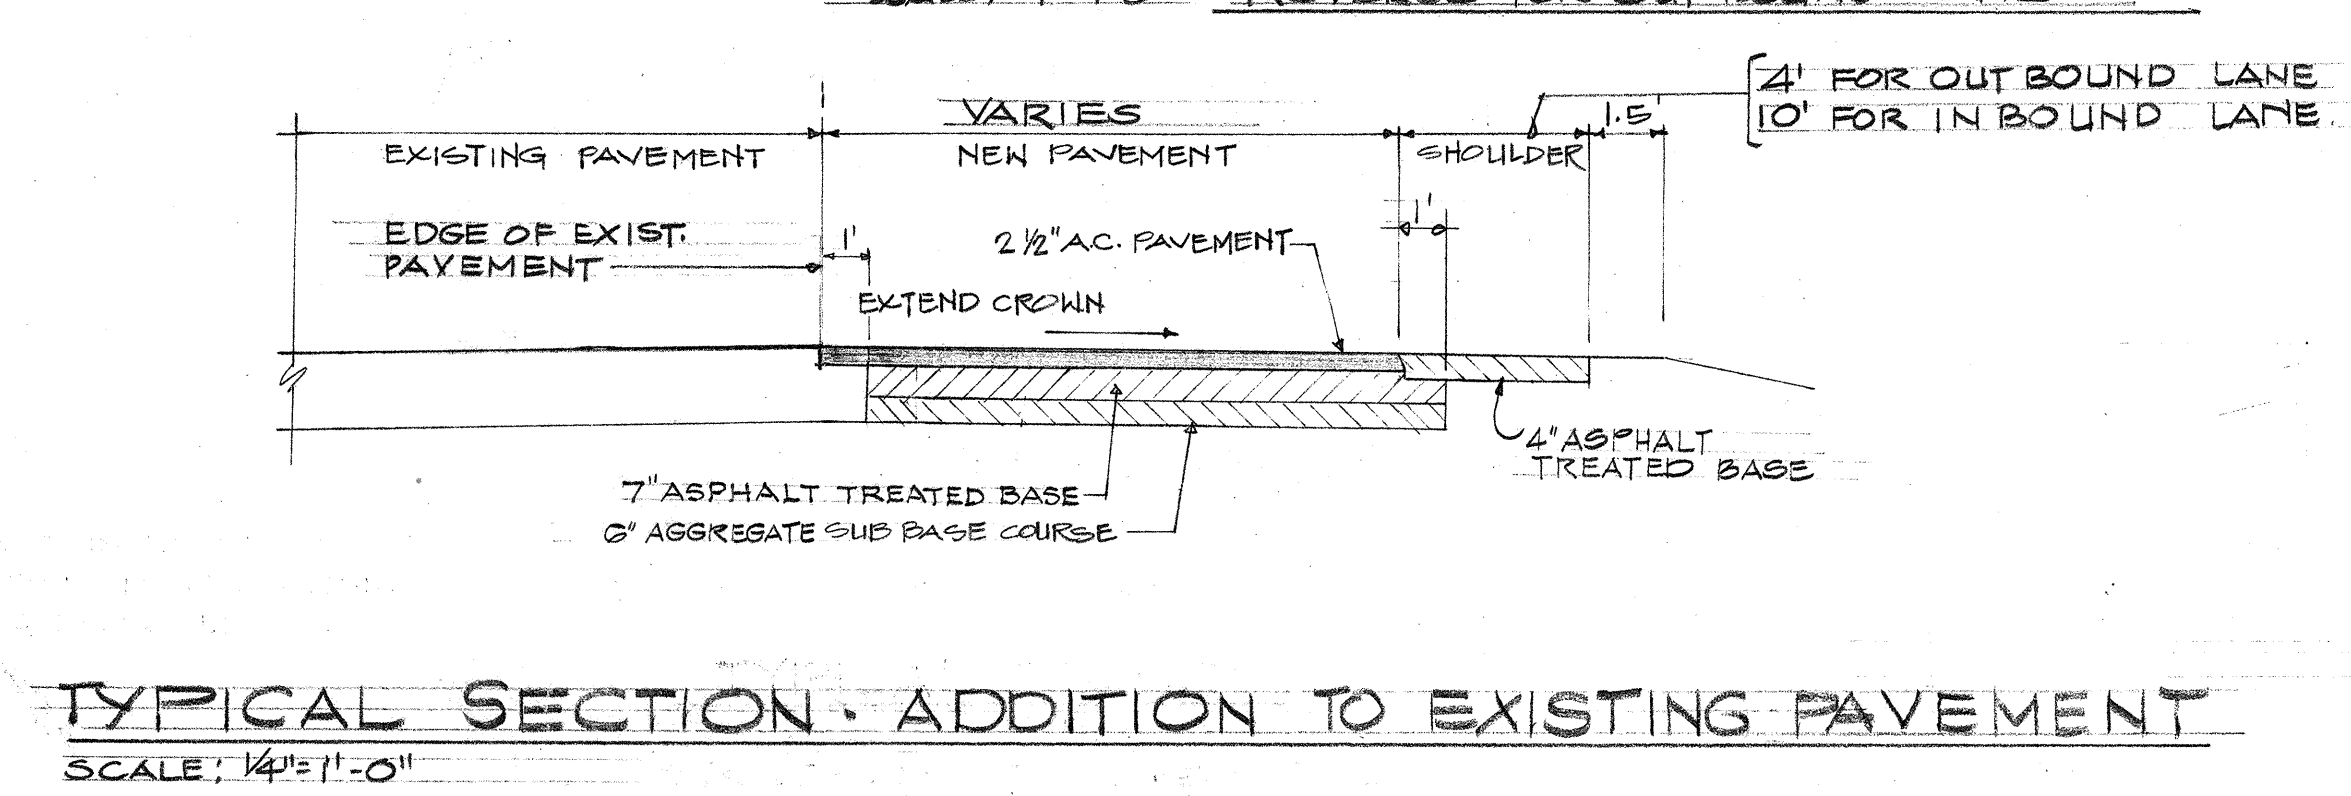
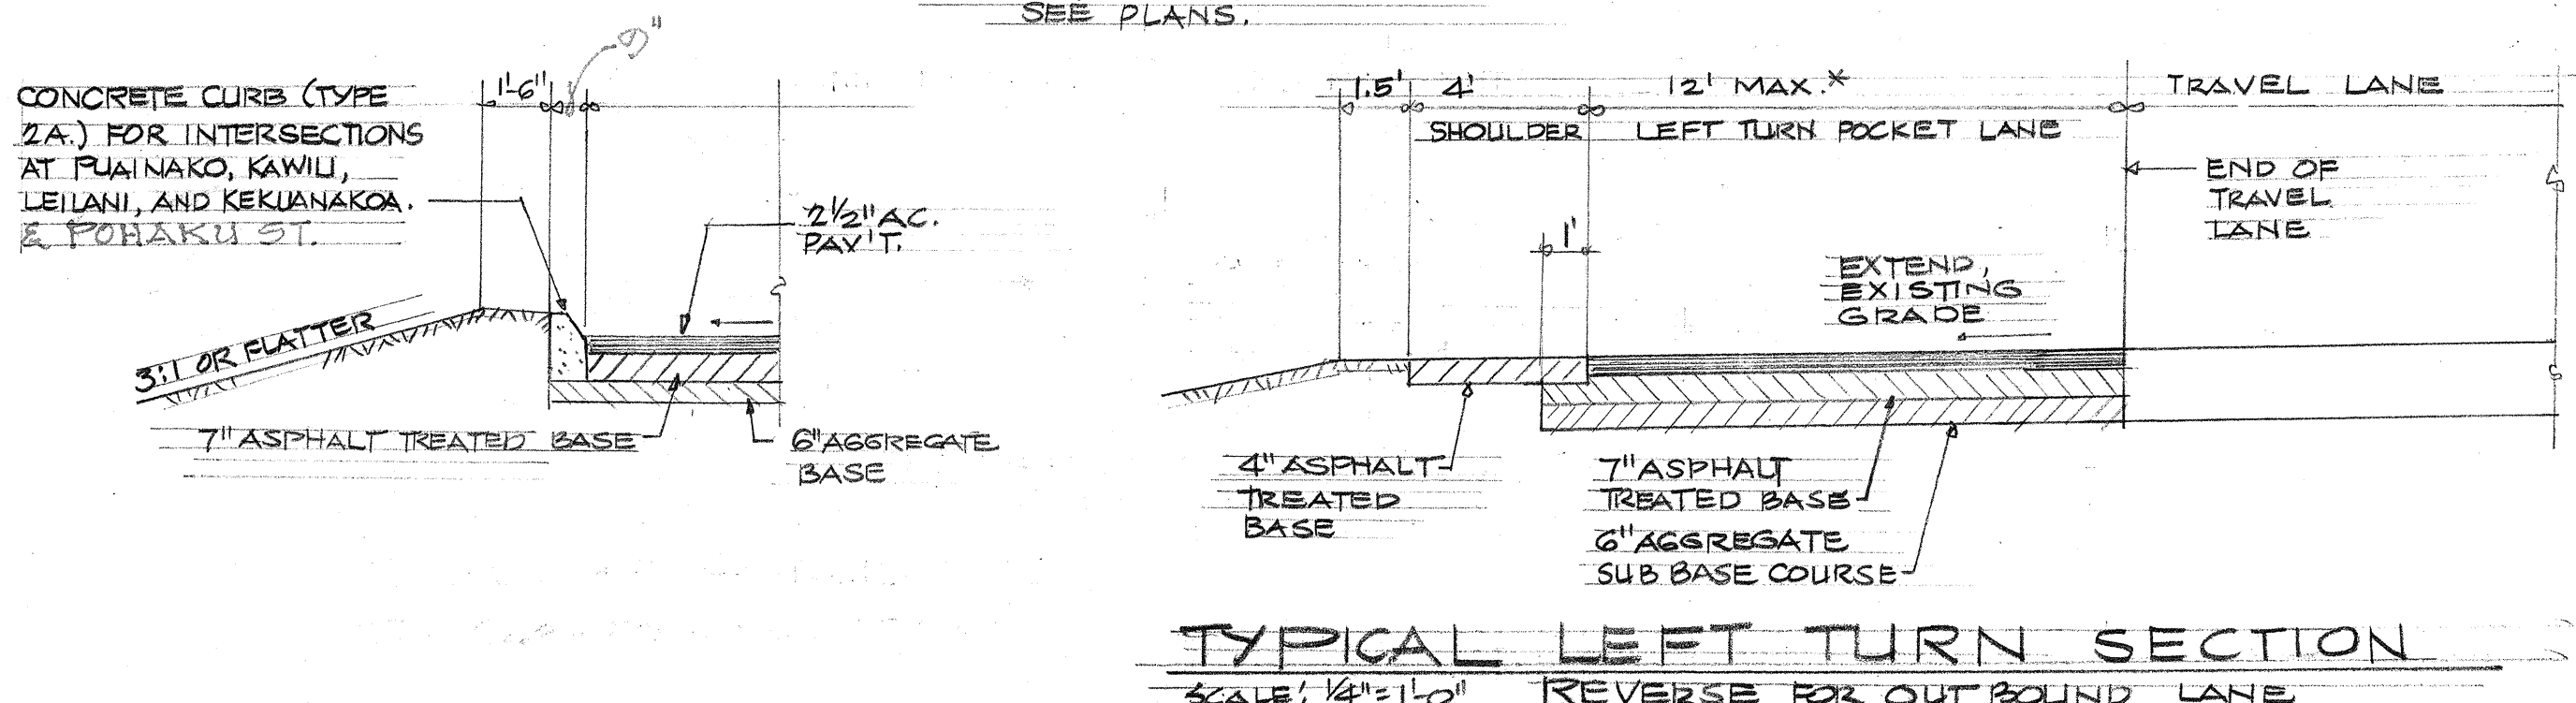
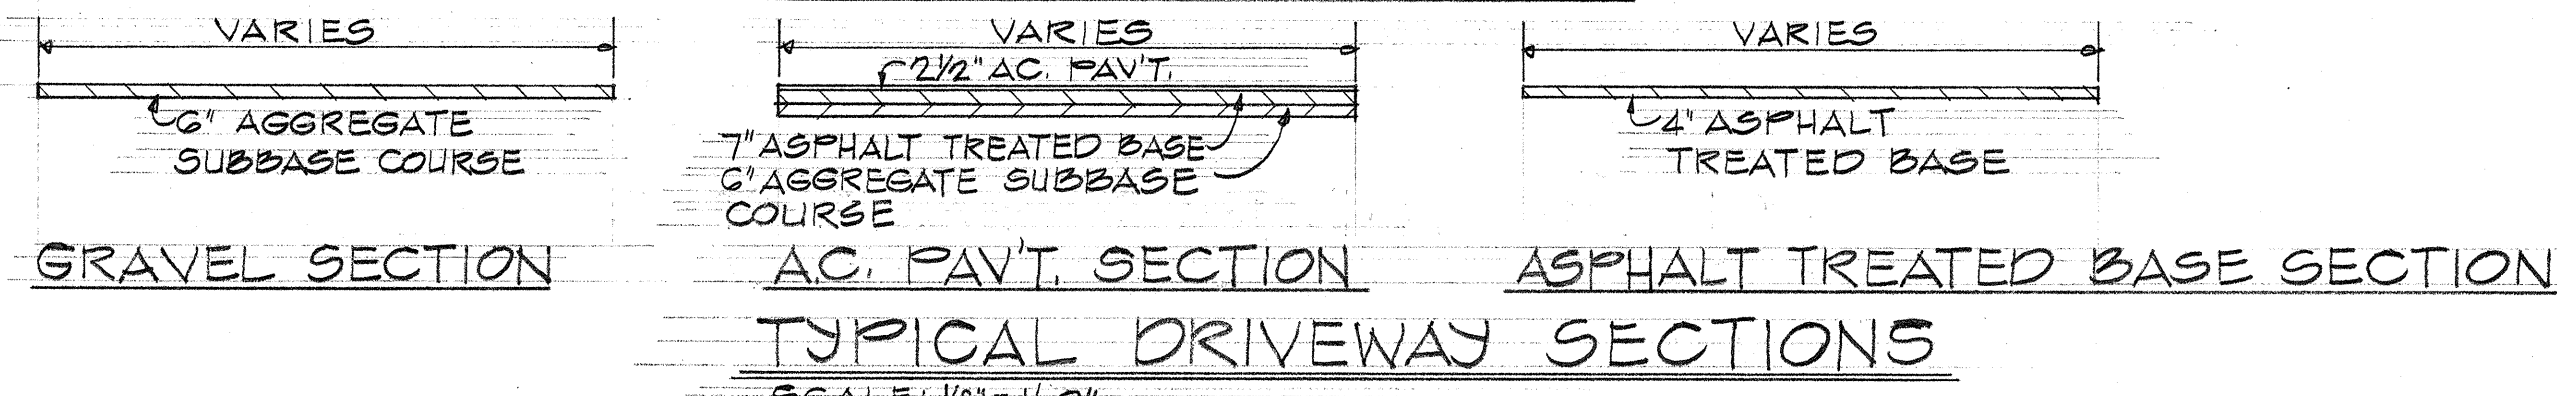


FED. ROAD DIST. NO.	STATE	FED. AID PROJ. NO.	FISCAL YEAR	SHEET NO.	TOTAL SHEETS
HAWAII	HAW.	F-RF-011-2(13)	1975	2	126

NOTE
TRANSITION SECTION
FROM STA. 1256+00 TO
STA. 1274+00

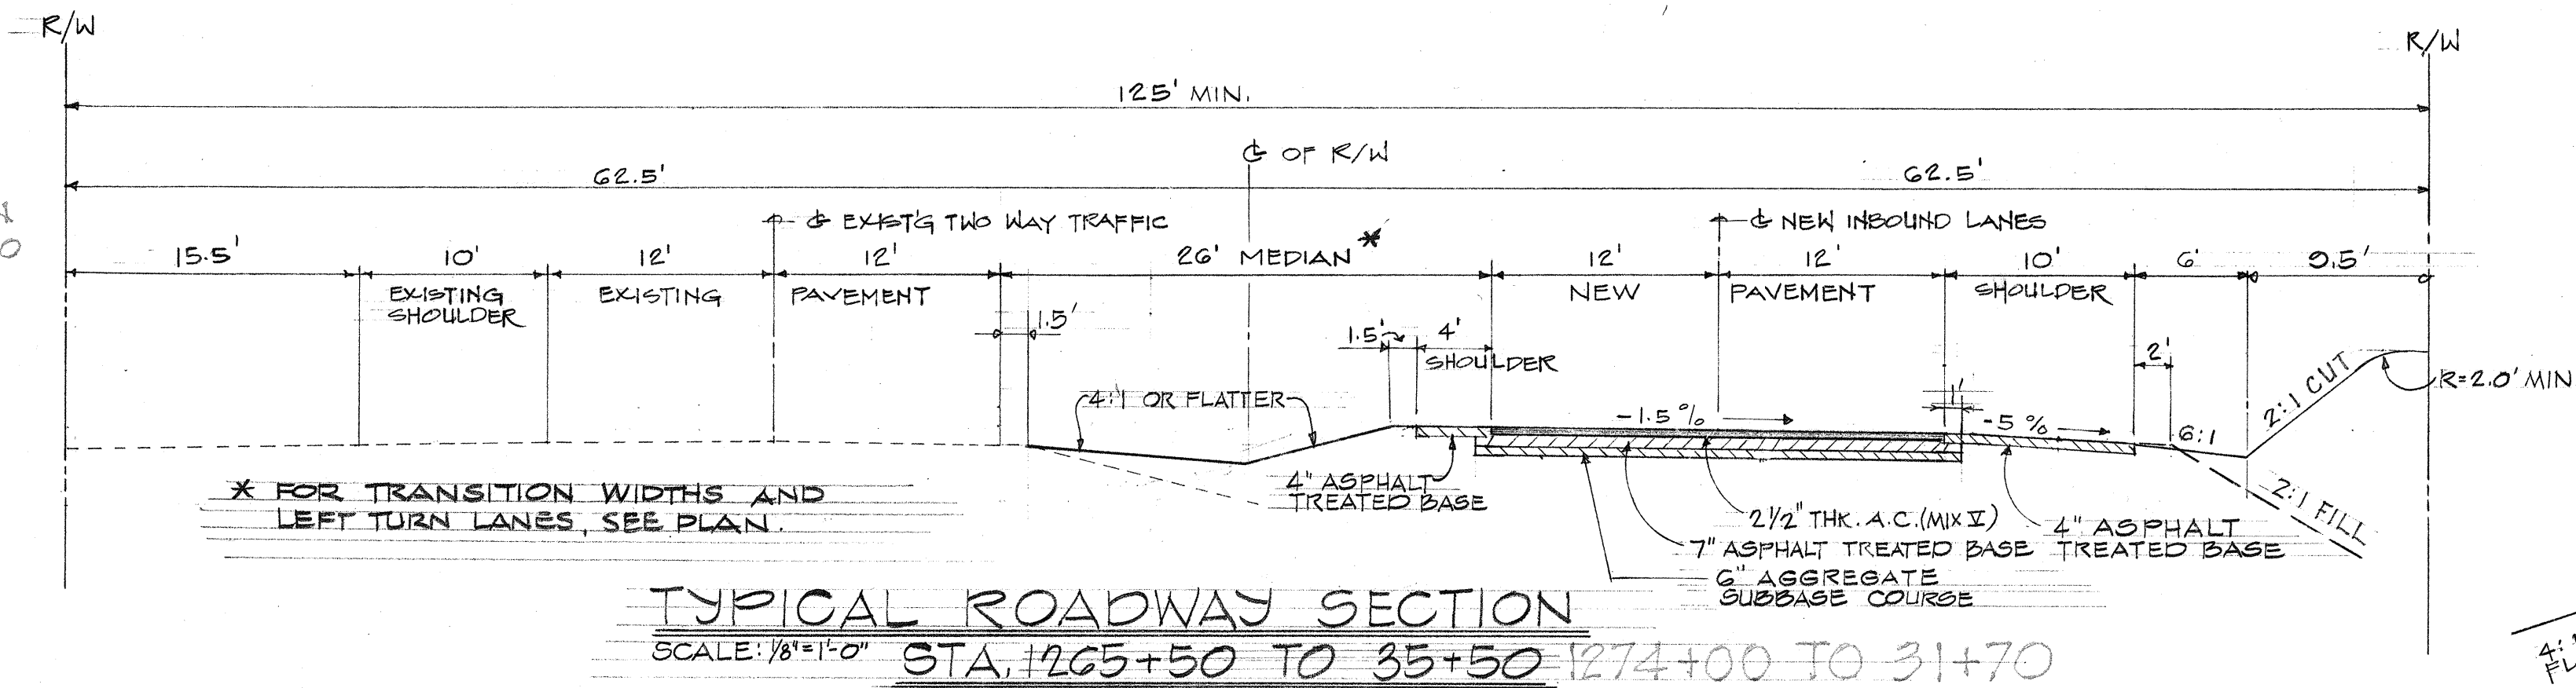

NOTE:
ROUND OFF ALL HINGE POINTS - 20 FEET
DESIRABLE FOR TOP OF CUTS.

4-11-75 1. REVISED ROADWAY SECTIONS.
2. REVISED TYP. DRIVEWAY PLAN.

DATE REVISION


STATE OF HAWAII
DEPARTMENT OF TRANSPORTATION
HIGHWAYS DIVISION

TYPICAL ROADWAY SECTIONS

KANOELEHUA AVE
MAKALIKA ST. TO KAMEHAMEHA AVE.
Federal Aid Project No. F-RF-011-2(13)

Scale: As Shown

SHEET No. 1 OF 1 SHEETS

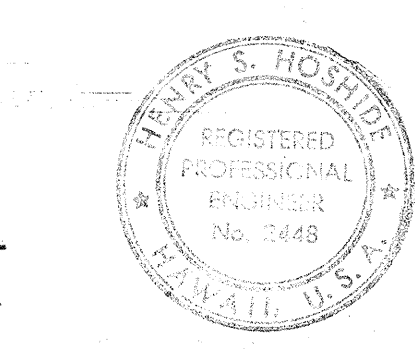

THIS WORK WAS PREPARED BY ME OR
UNDER MY SUPERVISION.

Henry S. Hoshida

DESIGNED BY	DATE
DRAWN BY	
CHECKED BY	
APPROVED BY	
ORIGINAL PLAN	
NOTE BOOK	
NO.	