
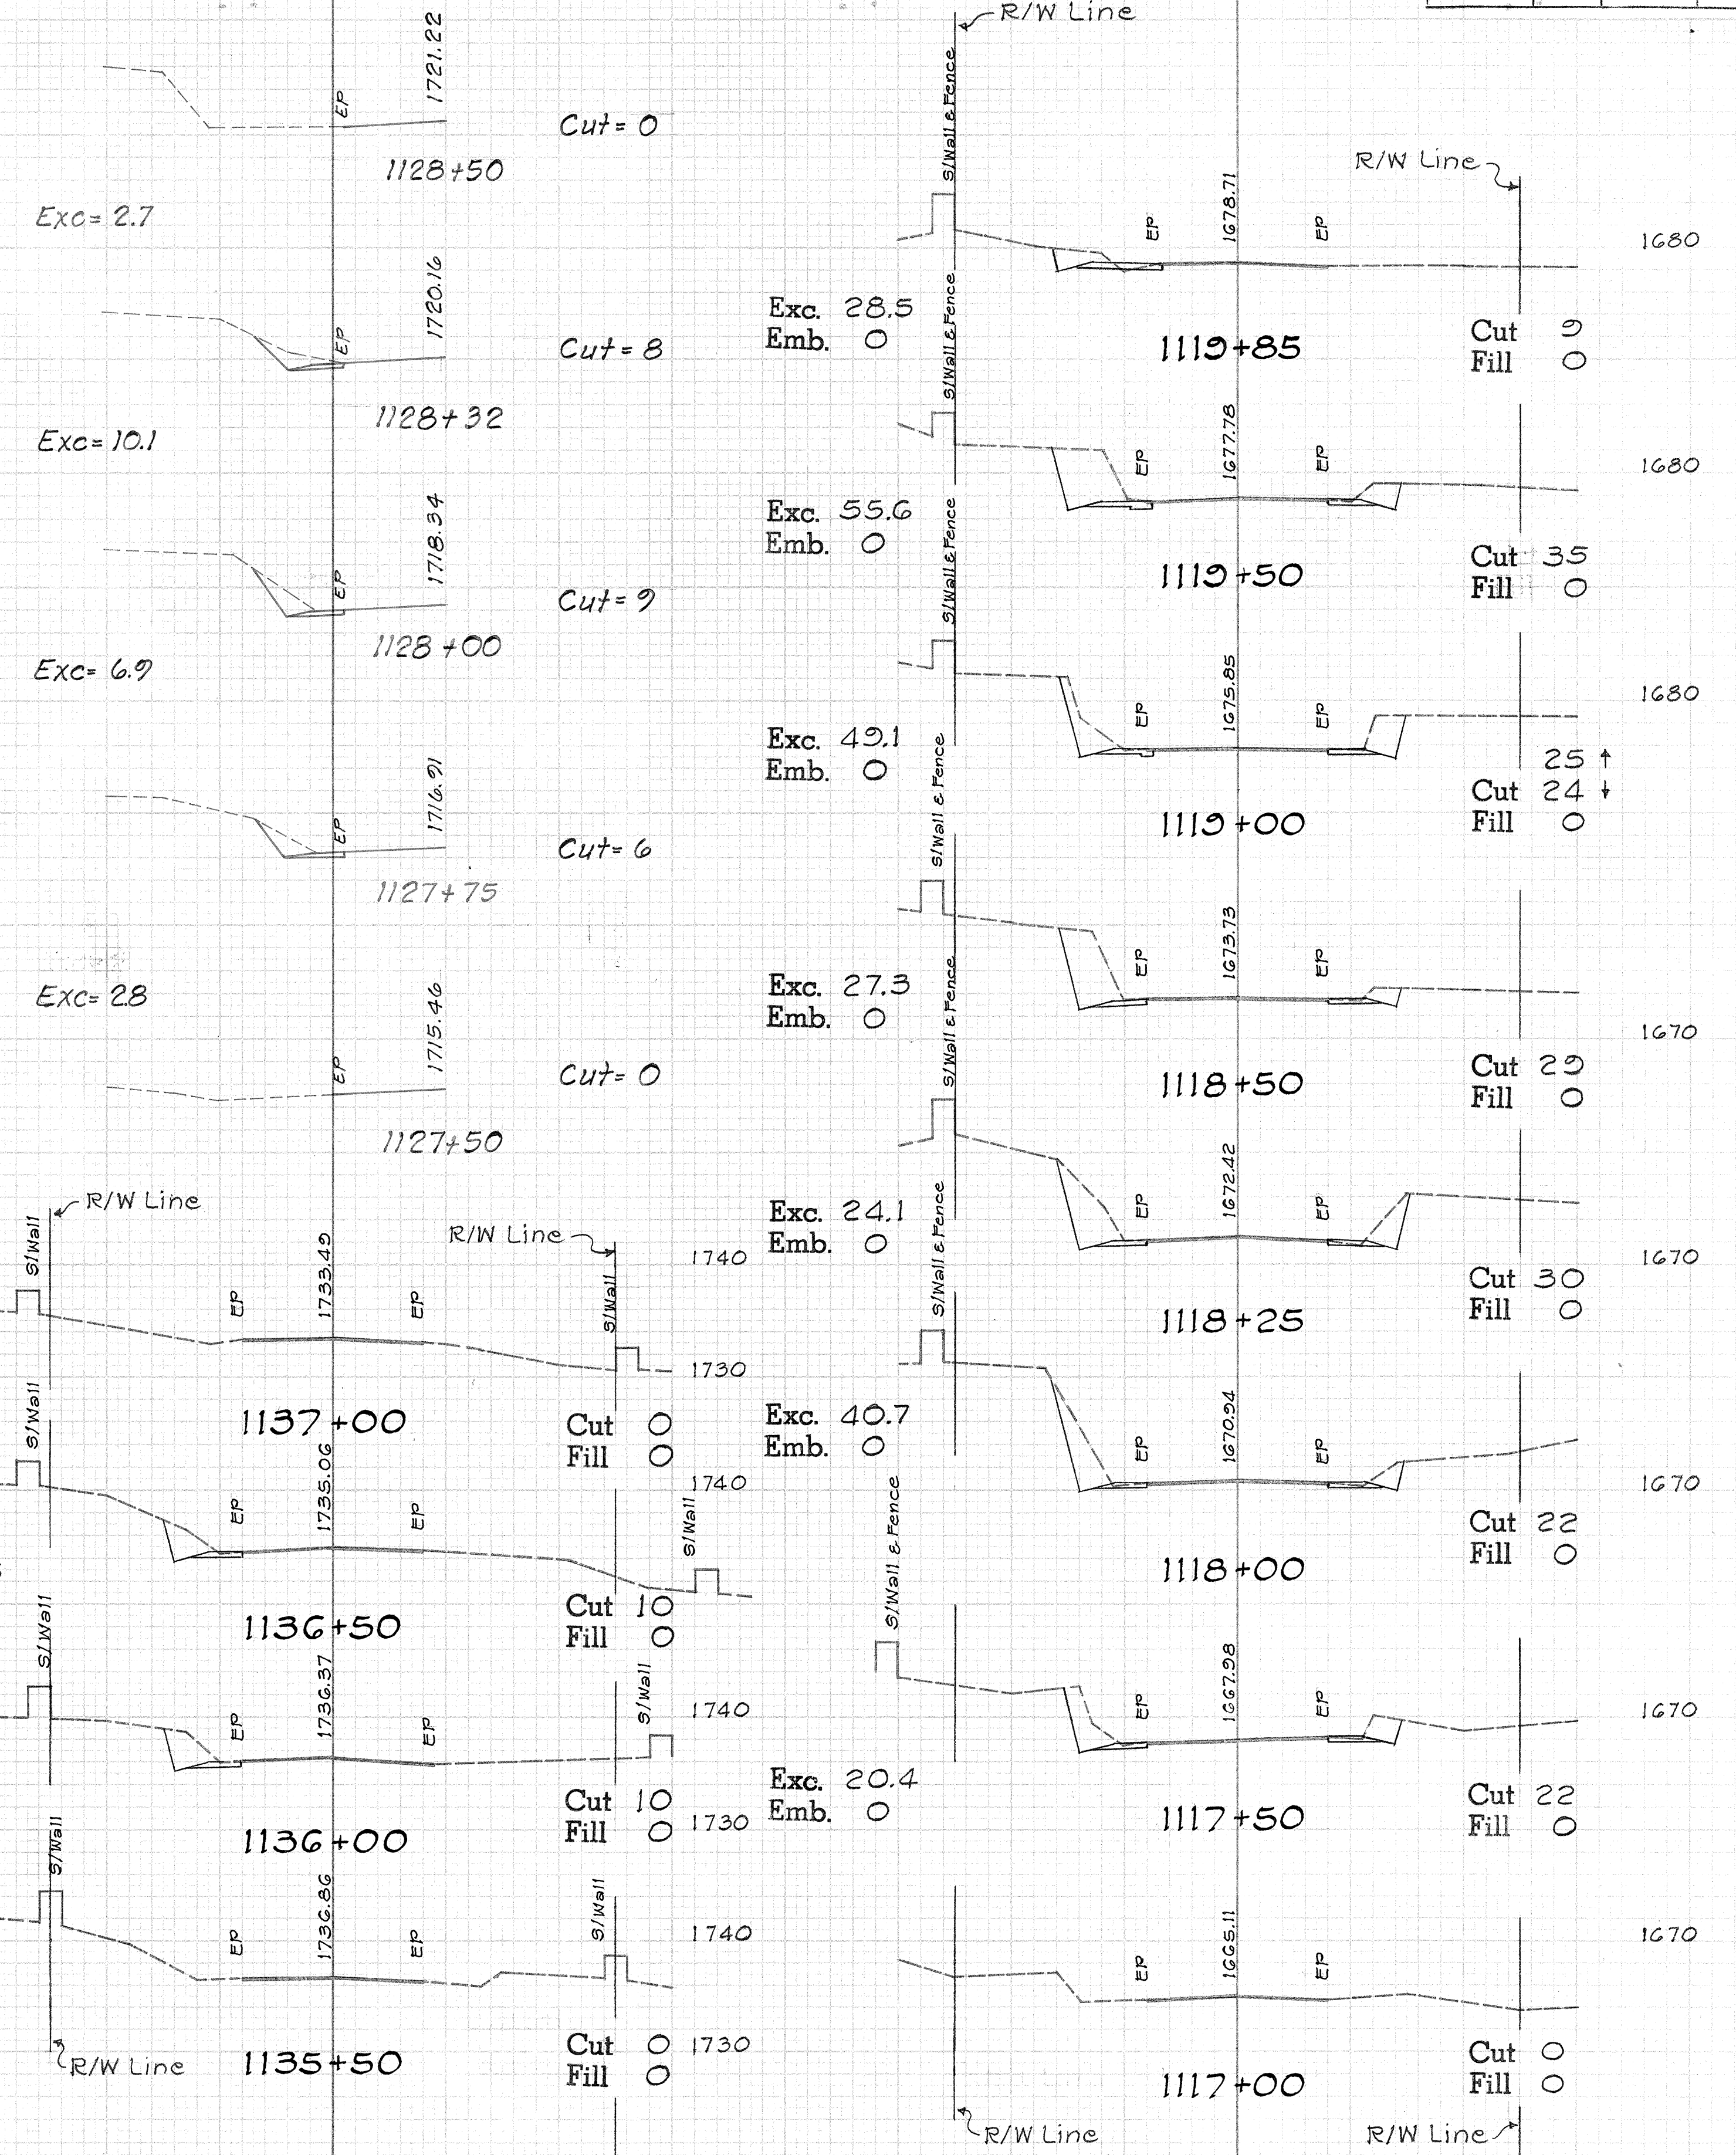


FED. ROAD DIST. NO.	STATE	PROJ. NO.	FISCAL YEAR	SHEET NO.	TOTAL SHEETS
HAWAII	HAW.	11BC-01-75	75	14	23

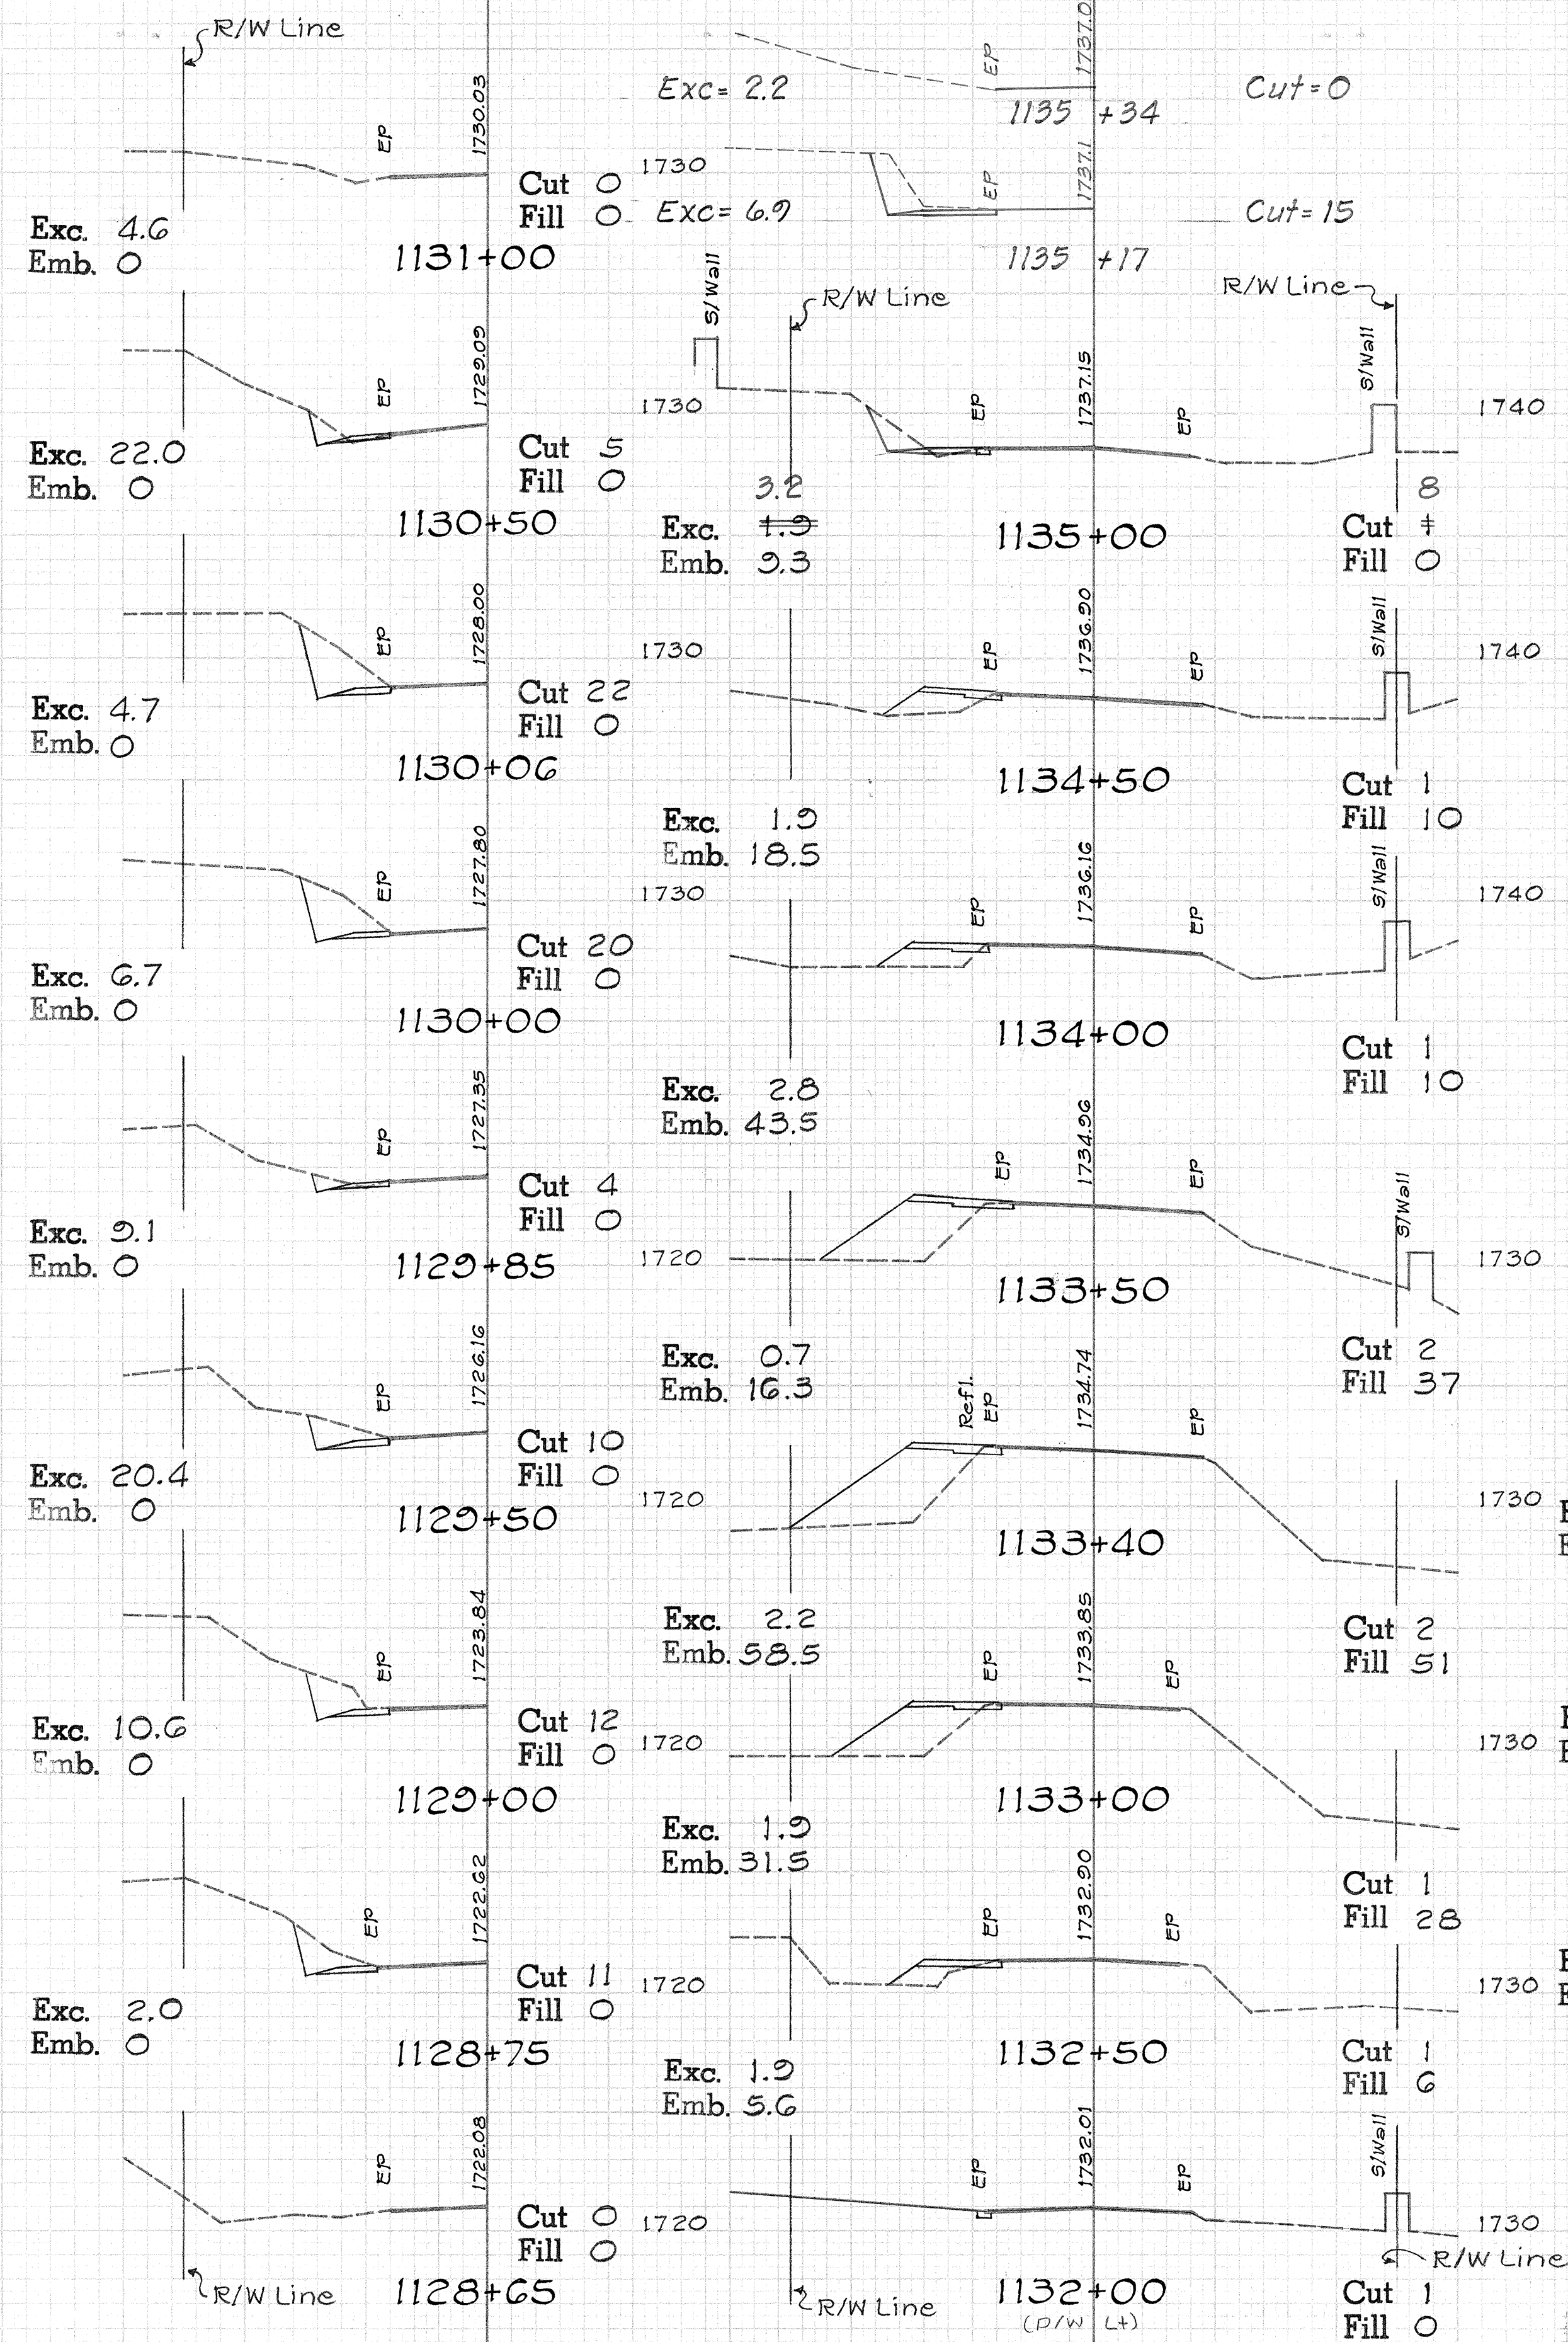




DATE	BY	FINAL SURVEY	NOTES

DATE	BY	ORIGINAL SURVEY	NOTES

FINAL SURVEY PLOTTED
DATE: _____ BY: _____
NOTE BOOK NO. _____
AREAS CHECKED: _____

ORIGINAL SURVEY PLOTTED
DATE: _____ BY: _____
NOTE BOOK NO. _____
AREAS CHECKED: _____





FED. ROAD DIST. NO.	STATE	PROJ. NO.	FISCAL YEAR	SHEET NO.	TOTAL SHEETS
HAWAII	HAW.	11BC-01-75	75	15	23

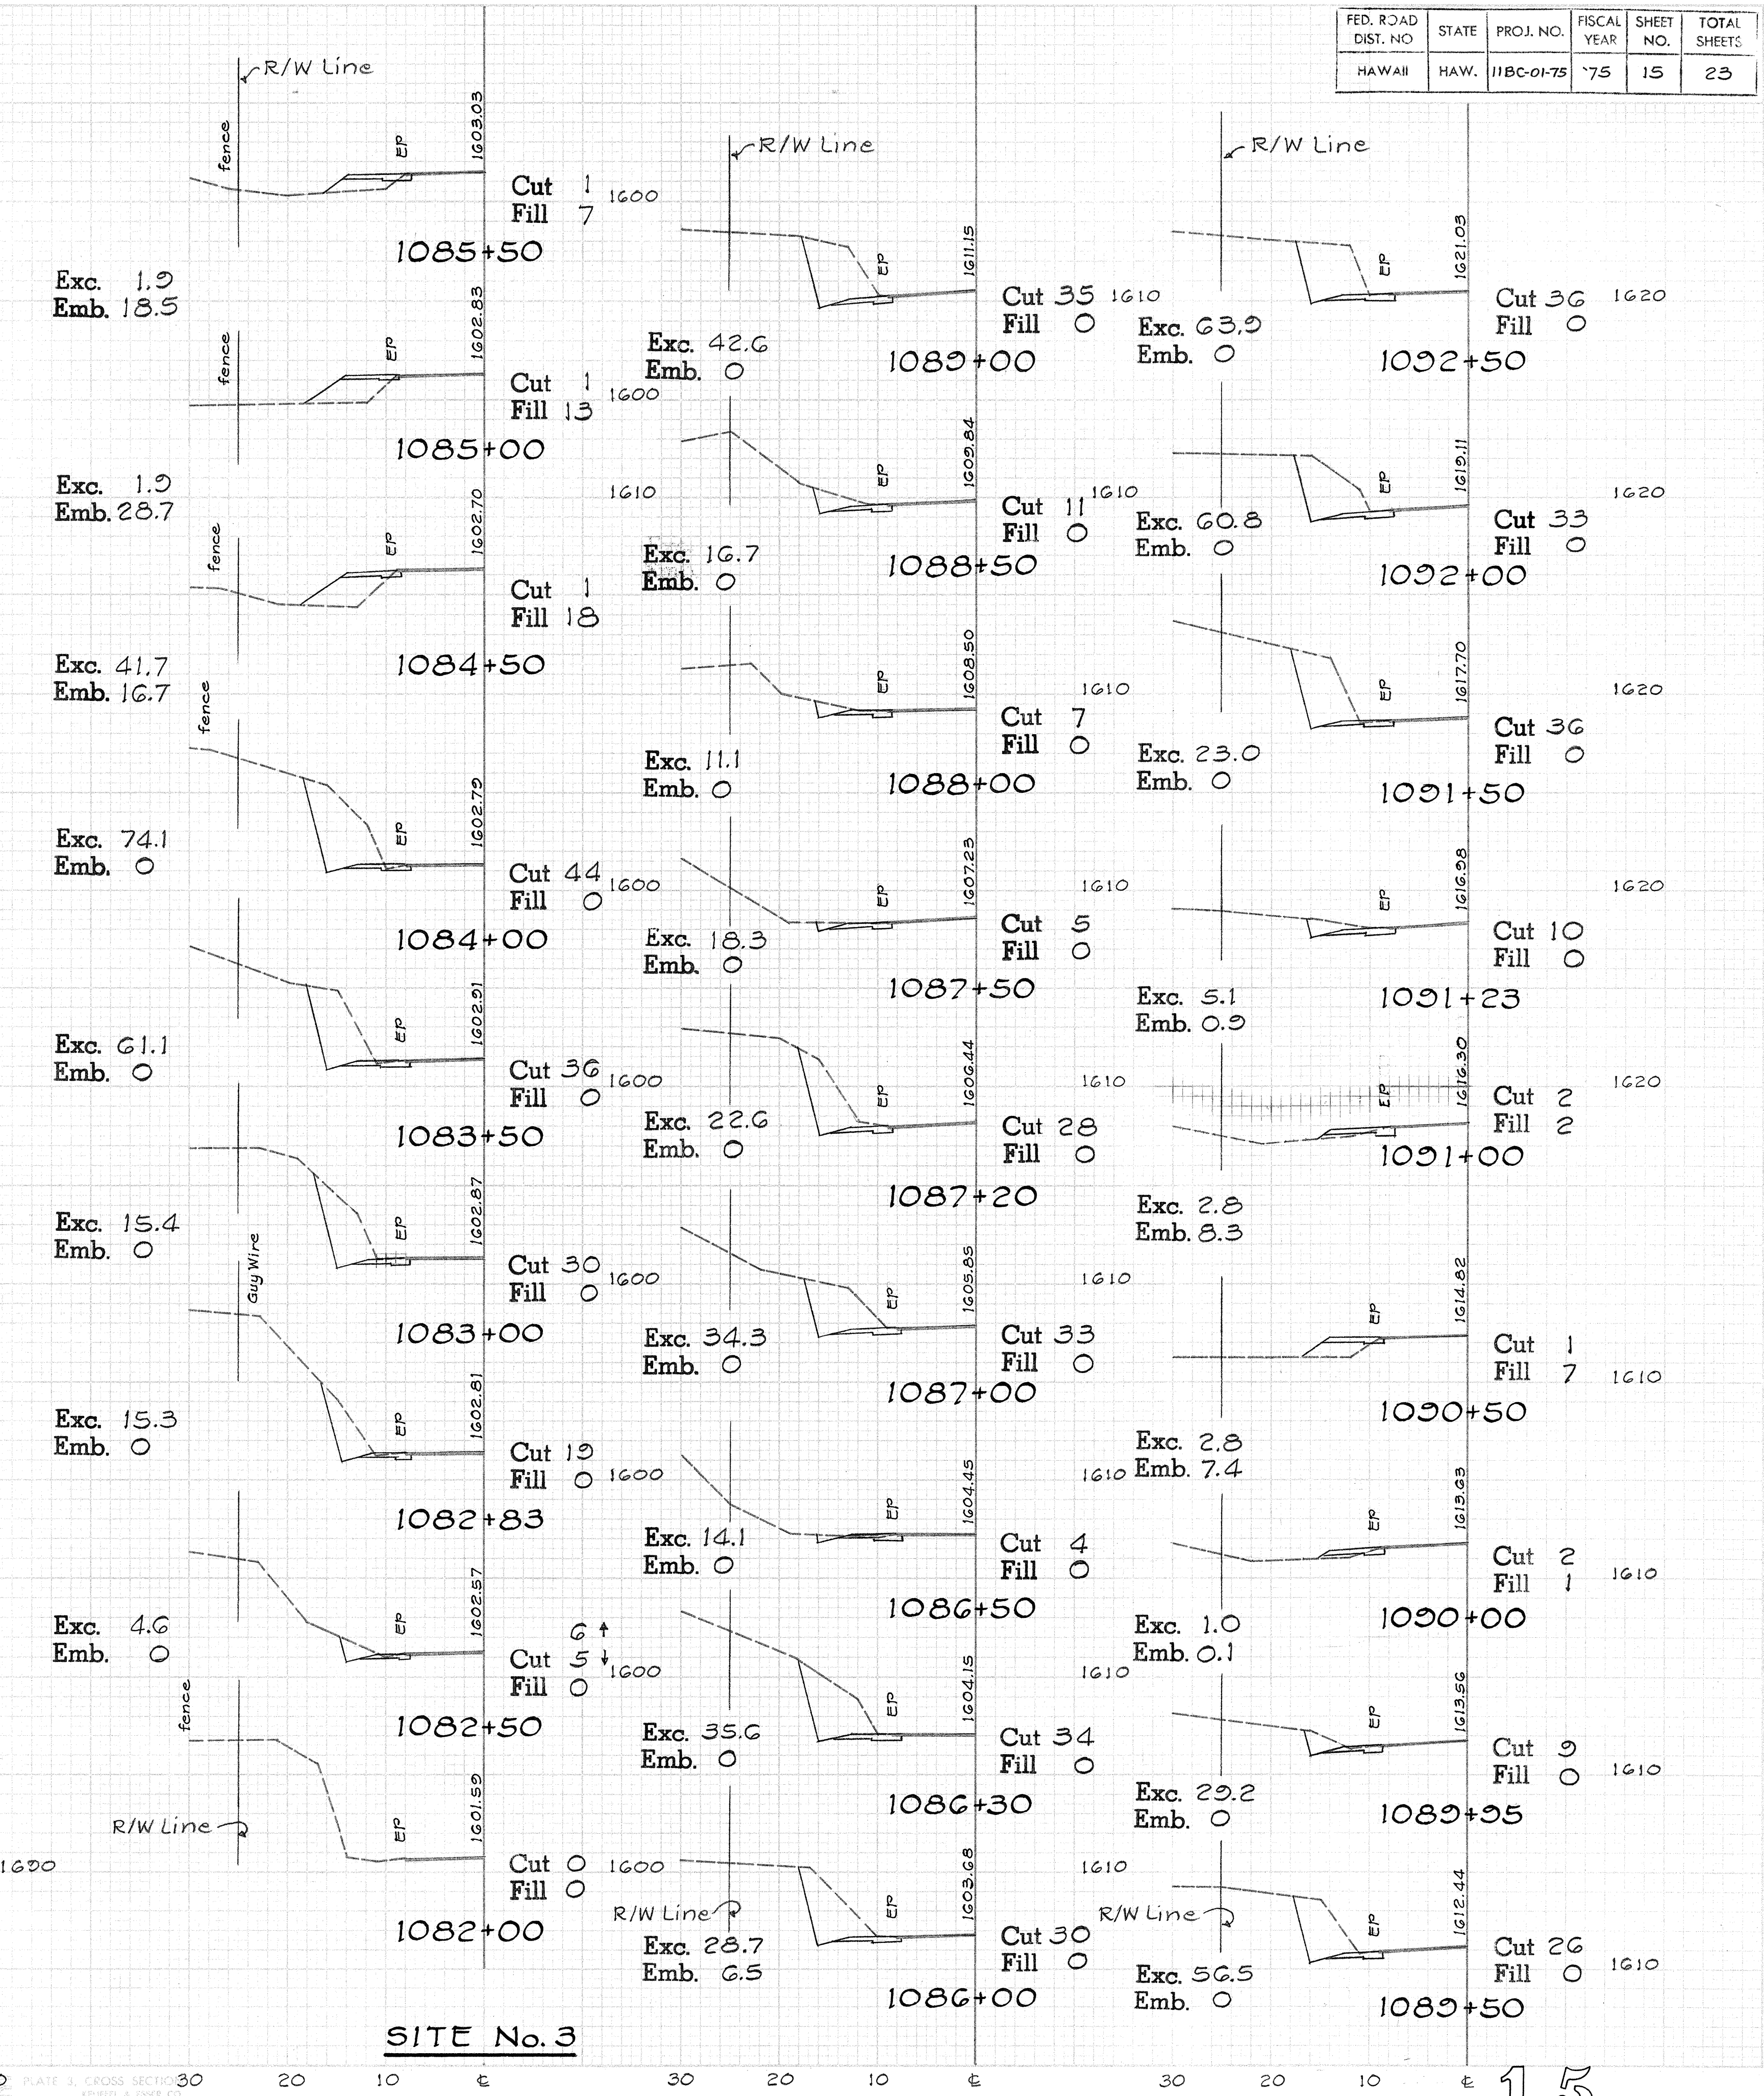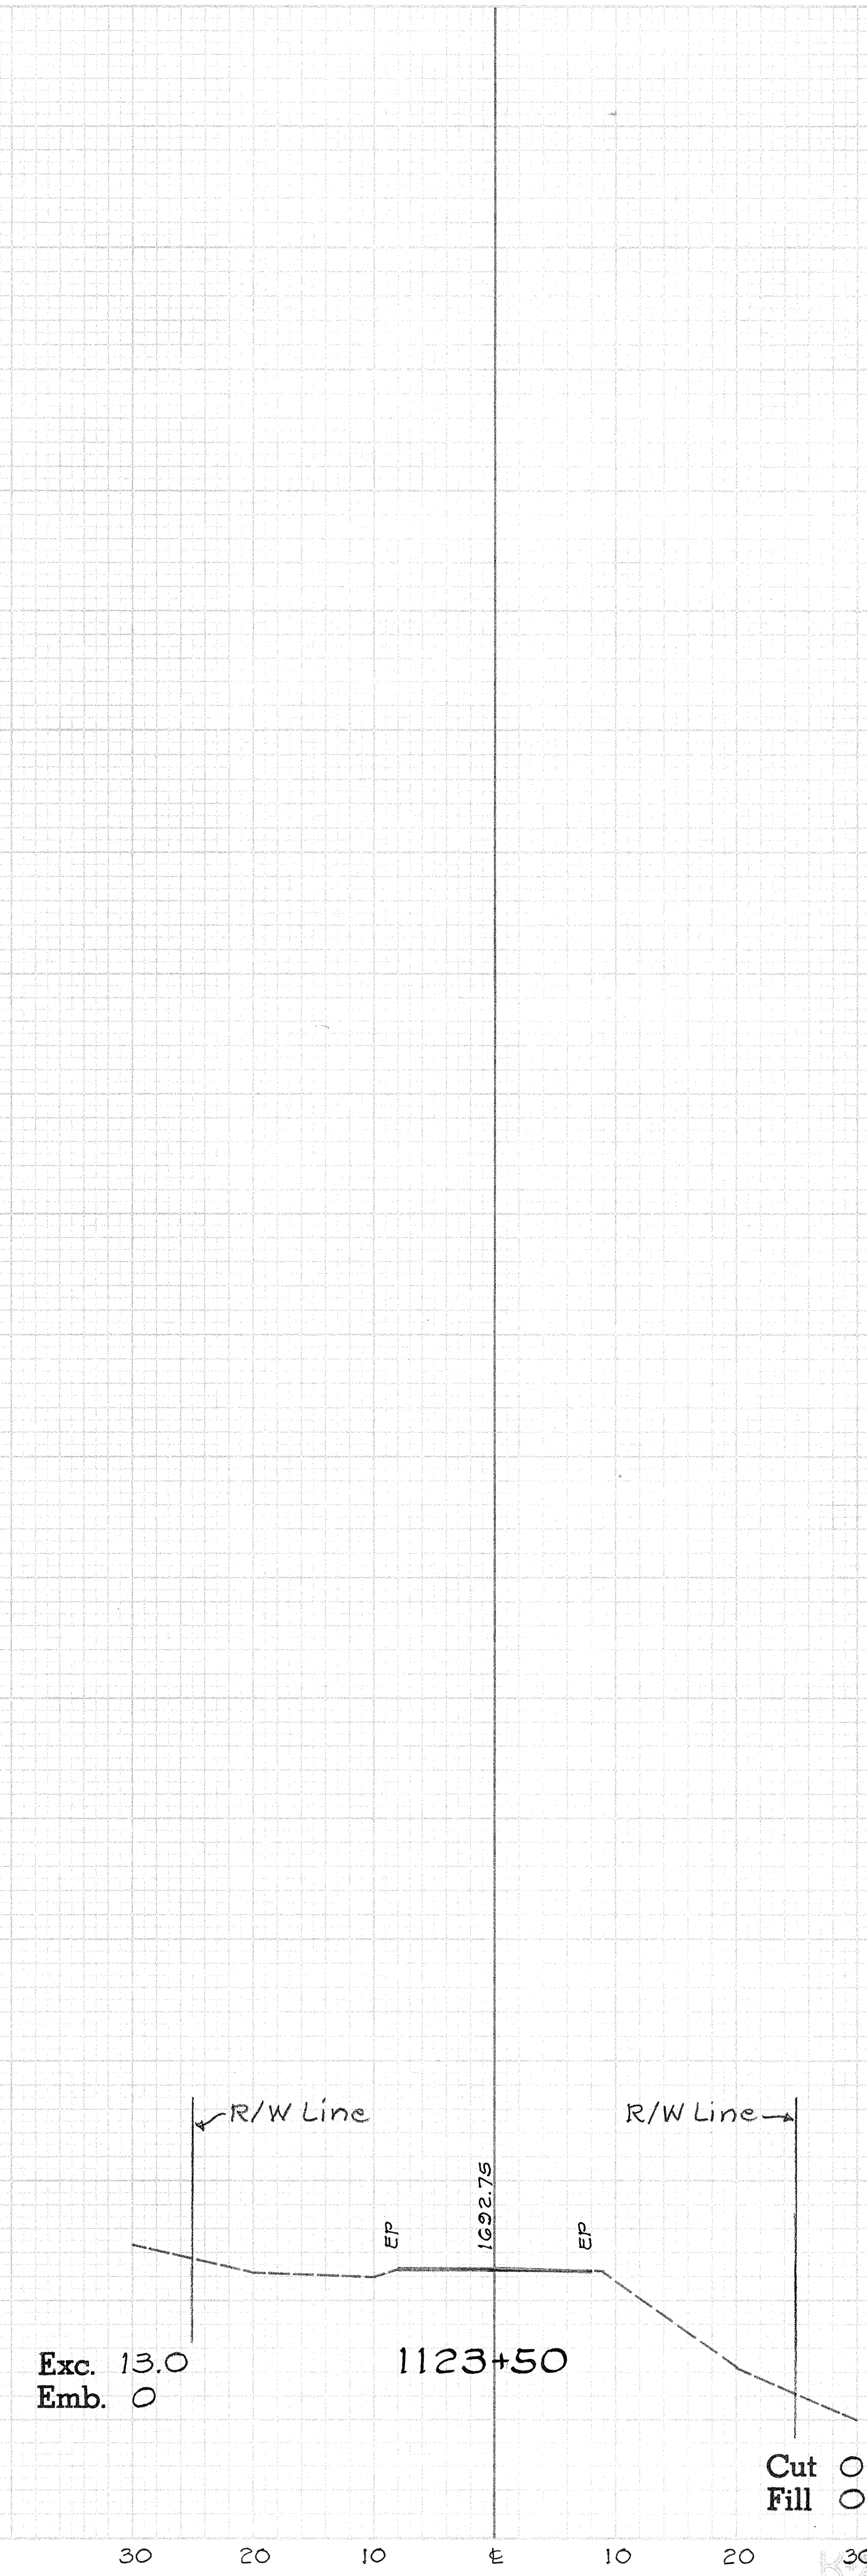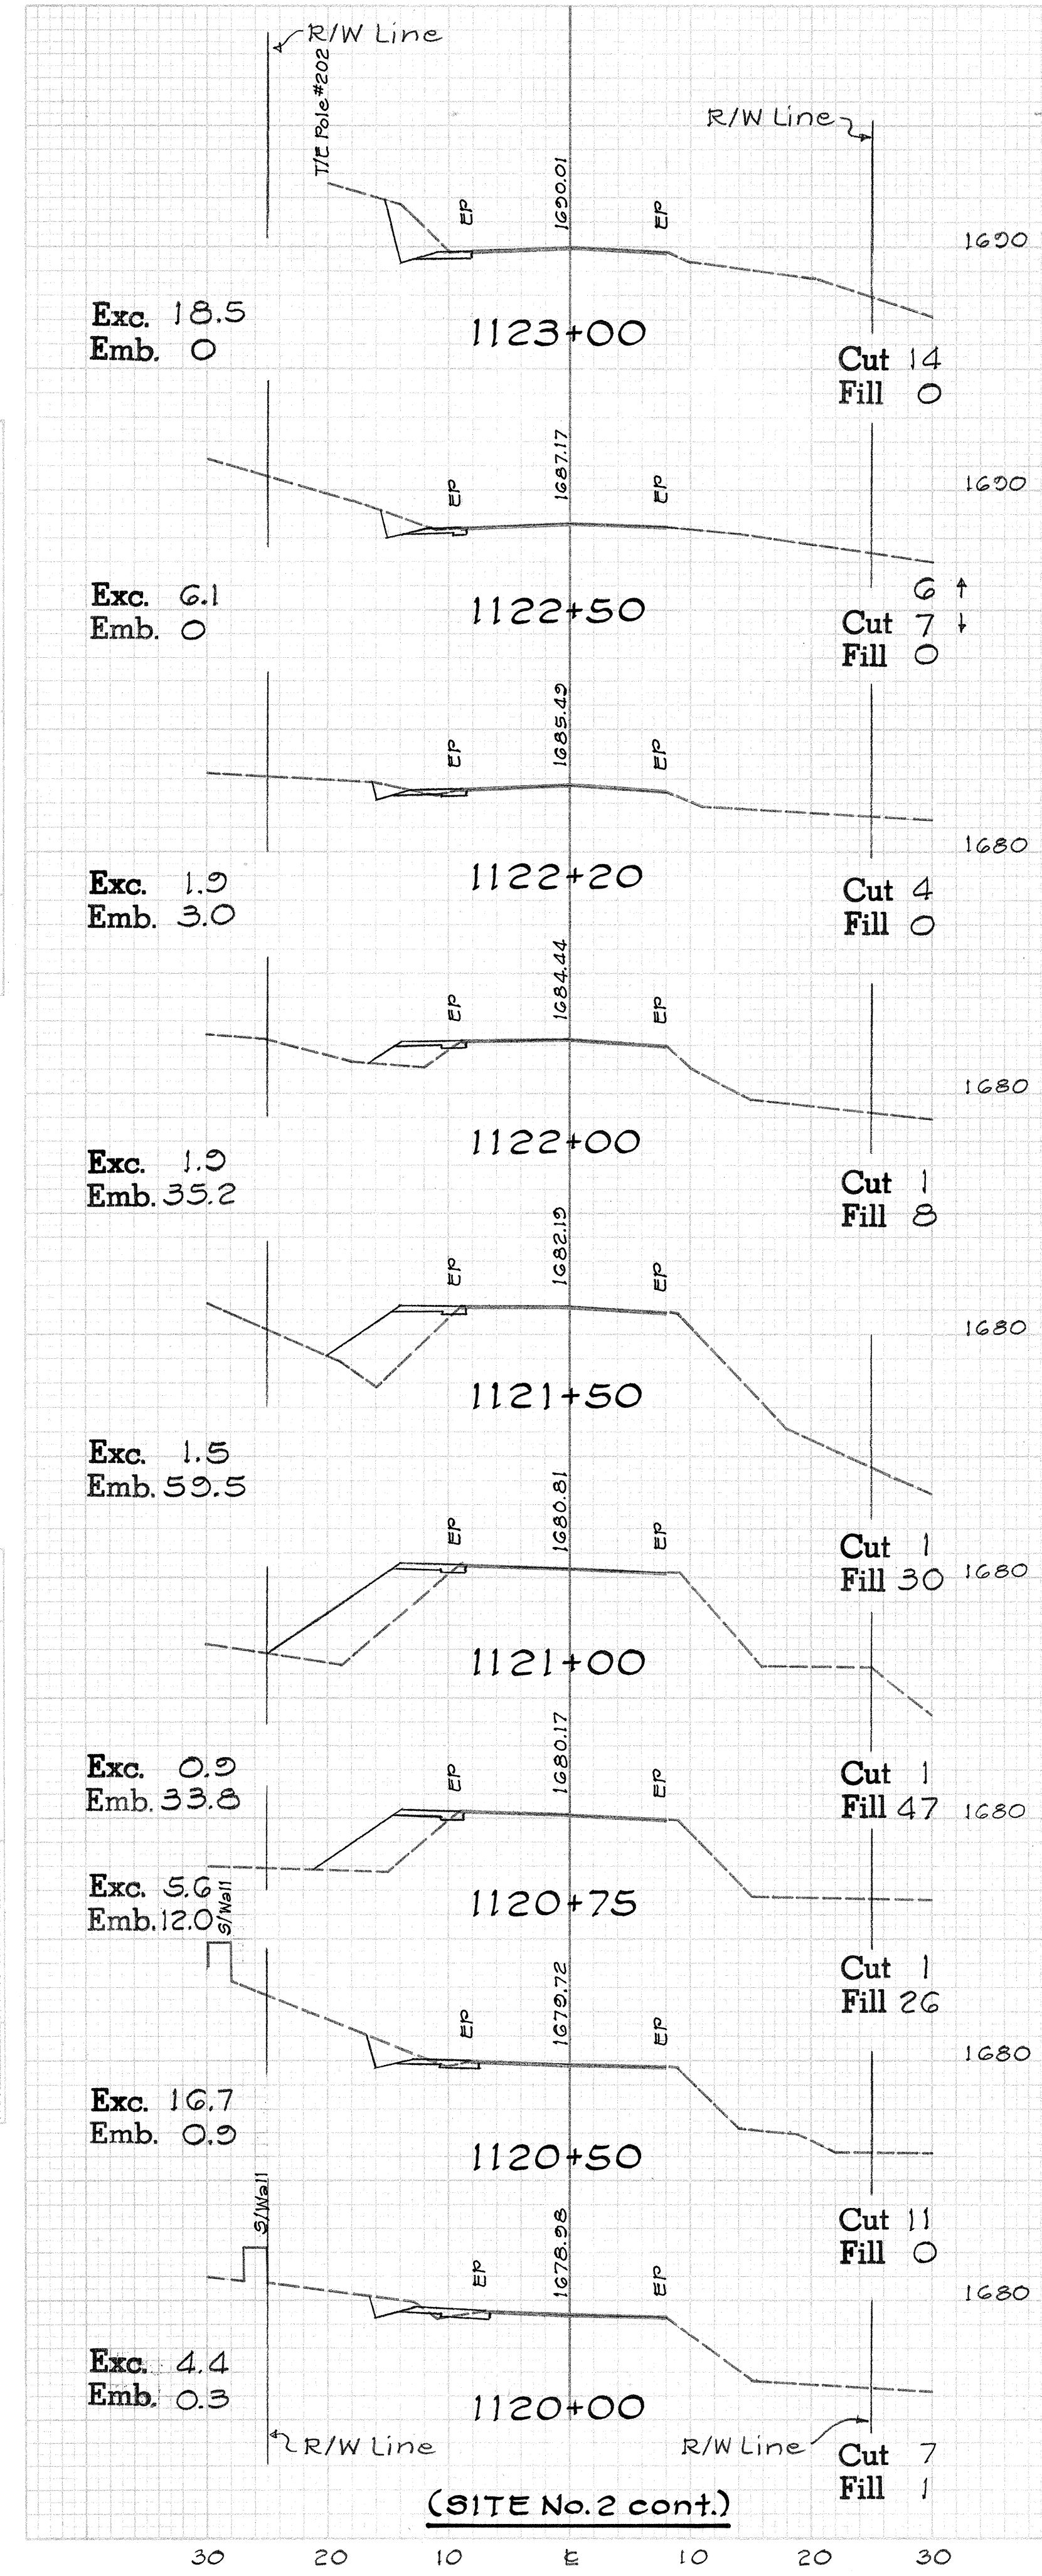

FED. ROAD DIST. NO.	STATE	PROJ. NO.	FISCAL YEAR	SHEET NO.	TOTAL SHEETS
HAWAII	HAW.	118C-01-75	'75	16	25

FINAL SURVEY
 SURVEY
 DATE
 BY


ORIGINALLY
 SURVEYED
 DATE
 BY

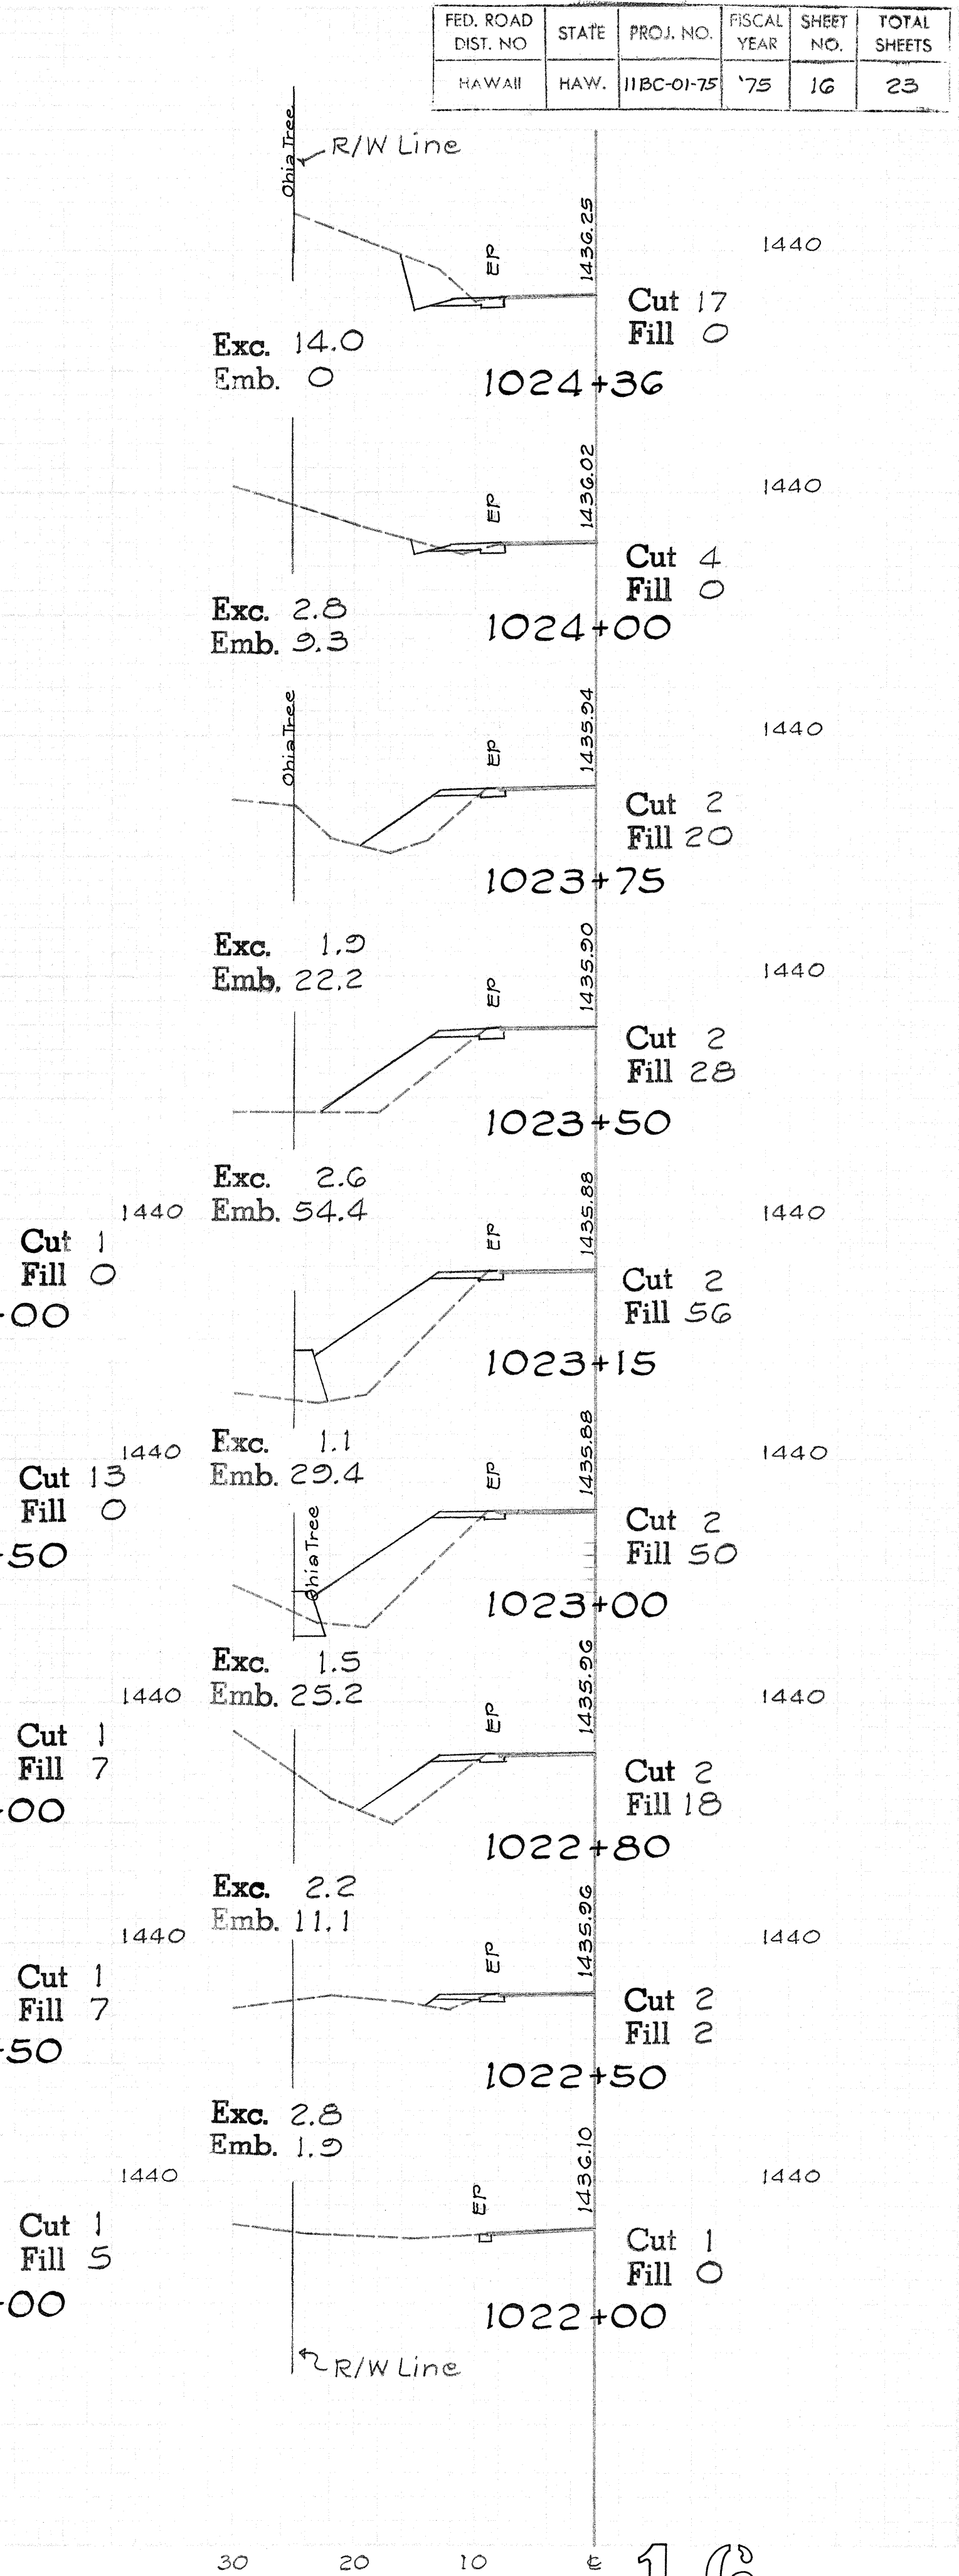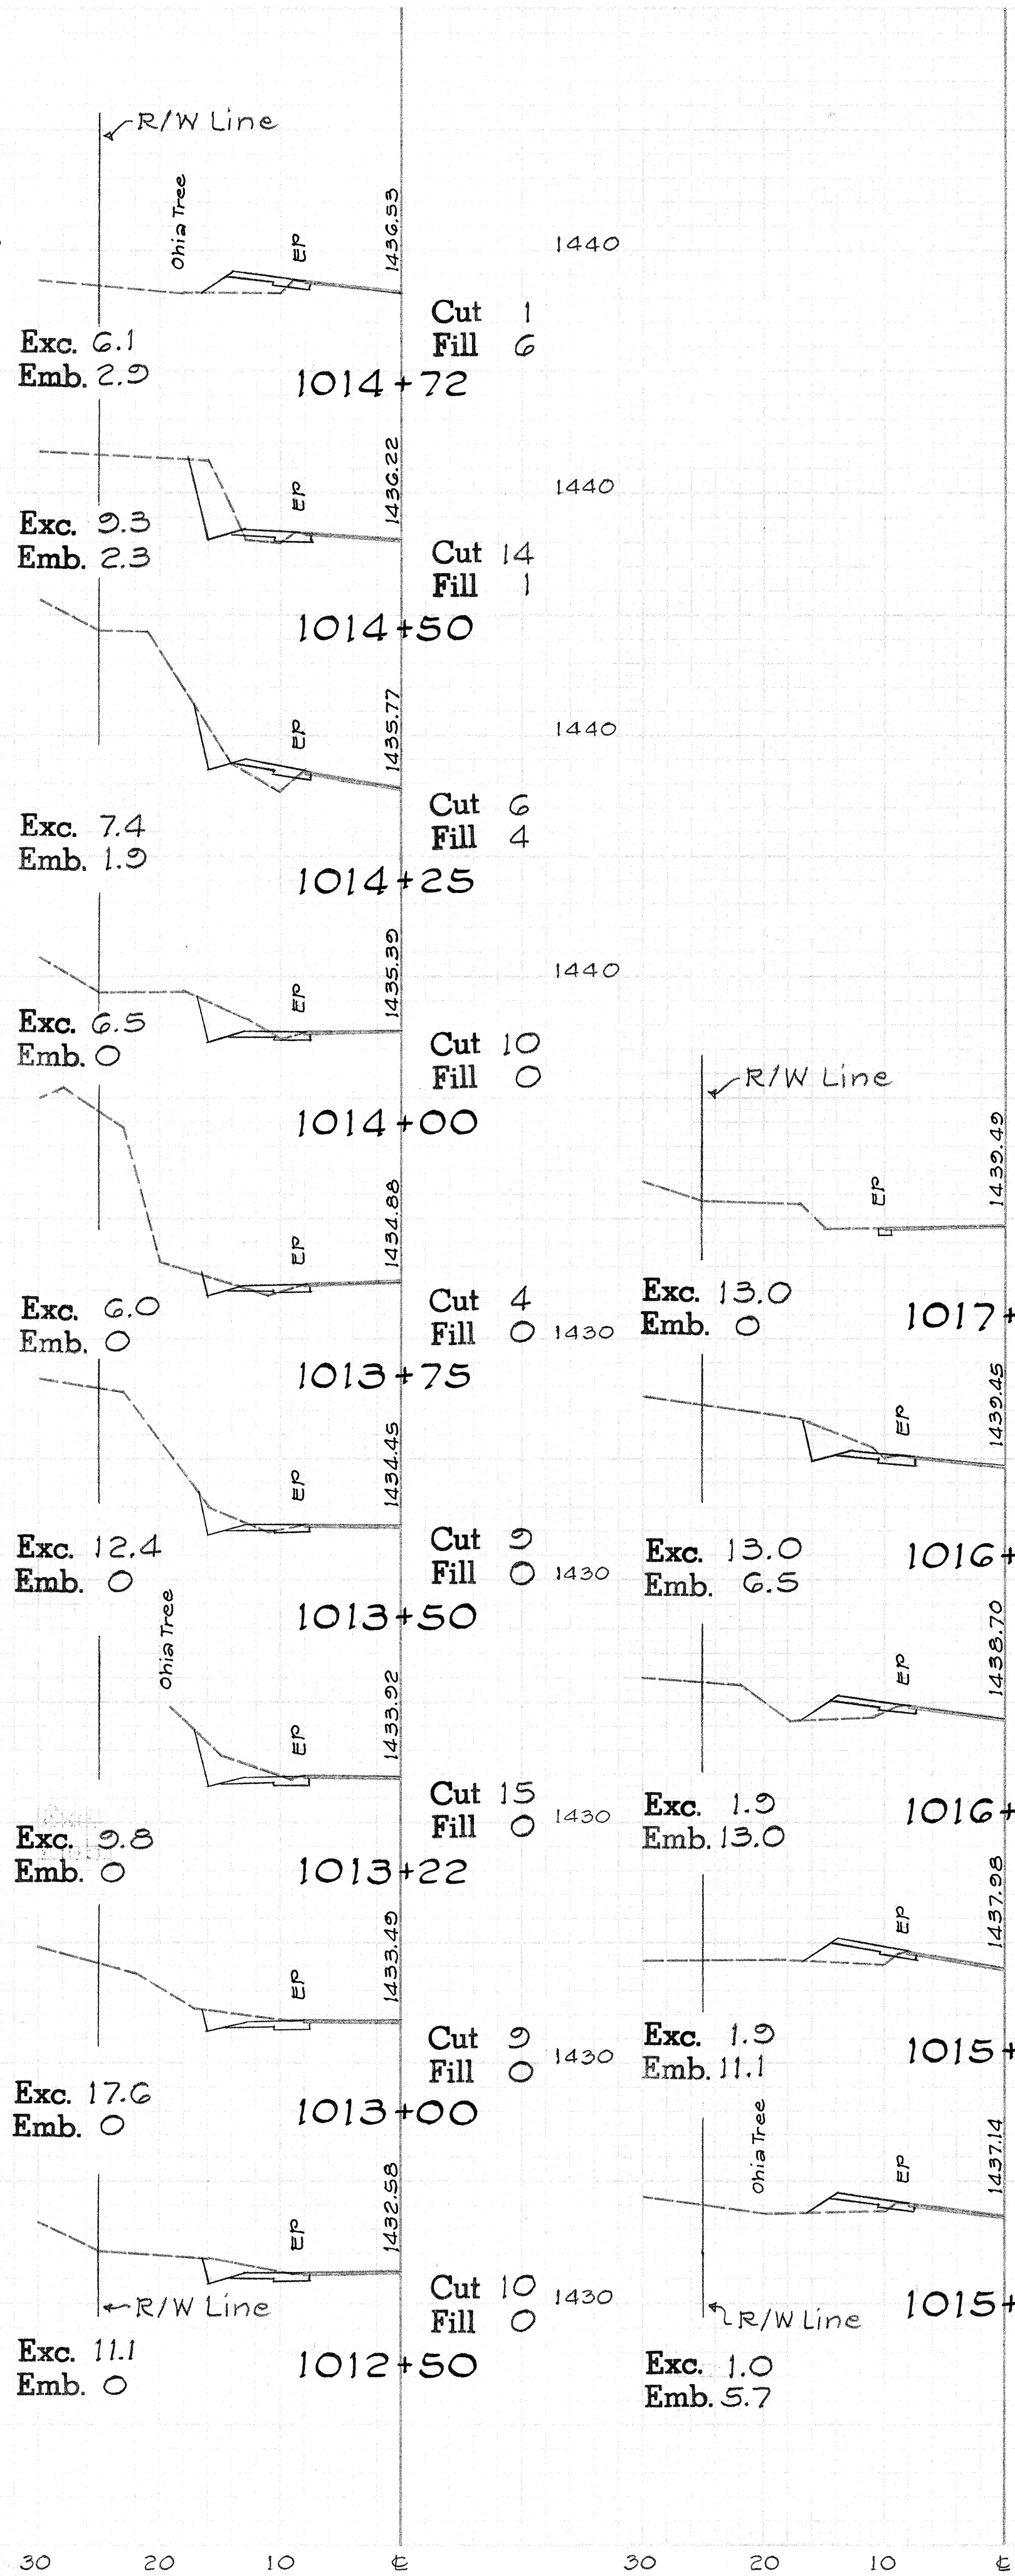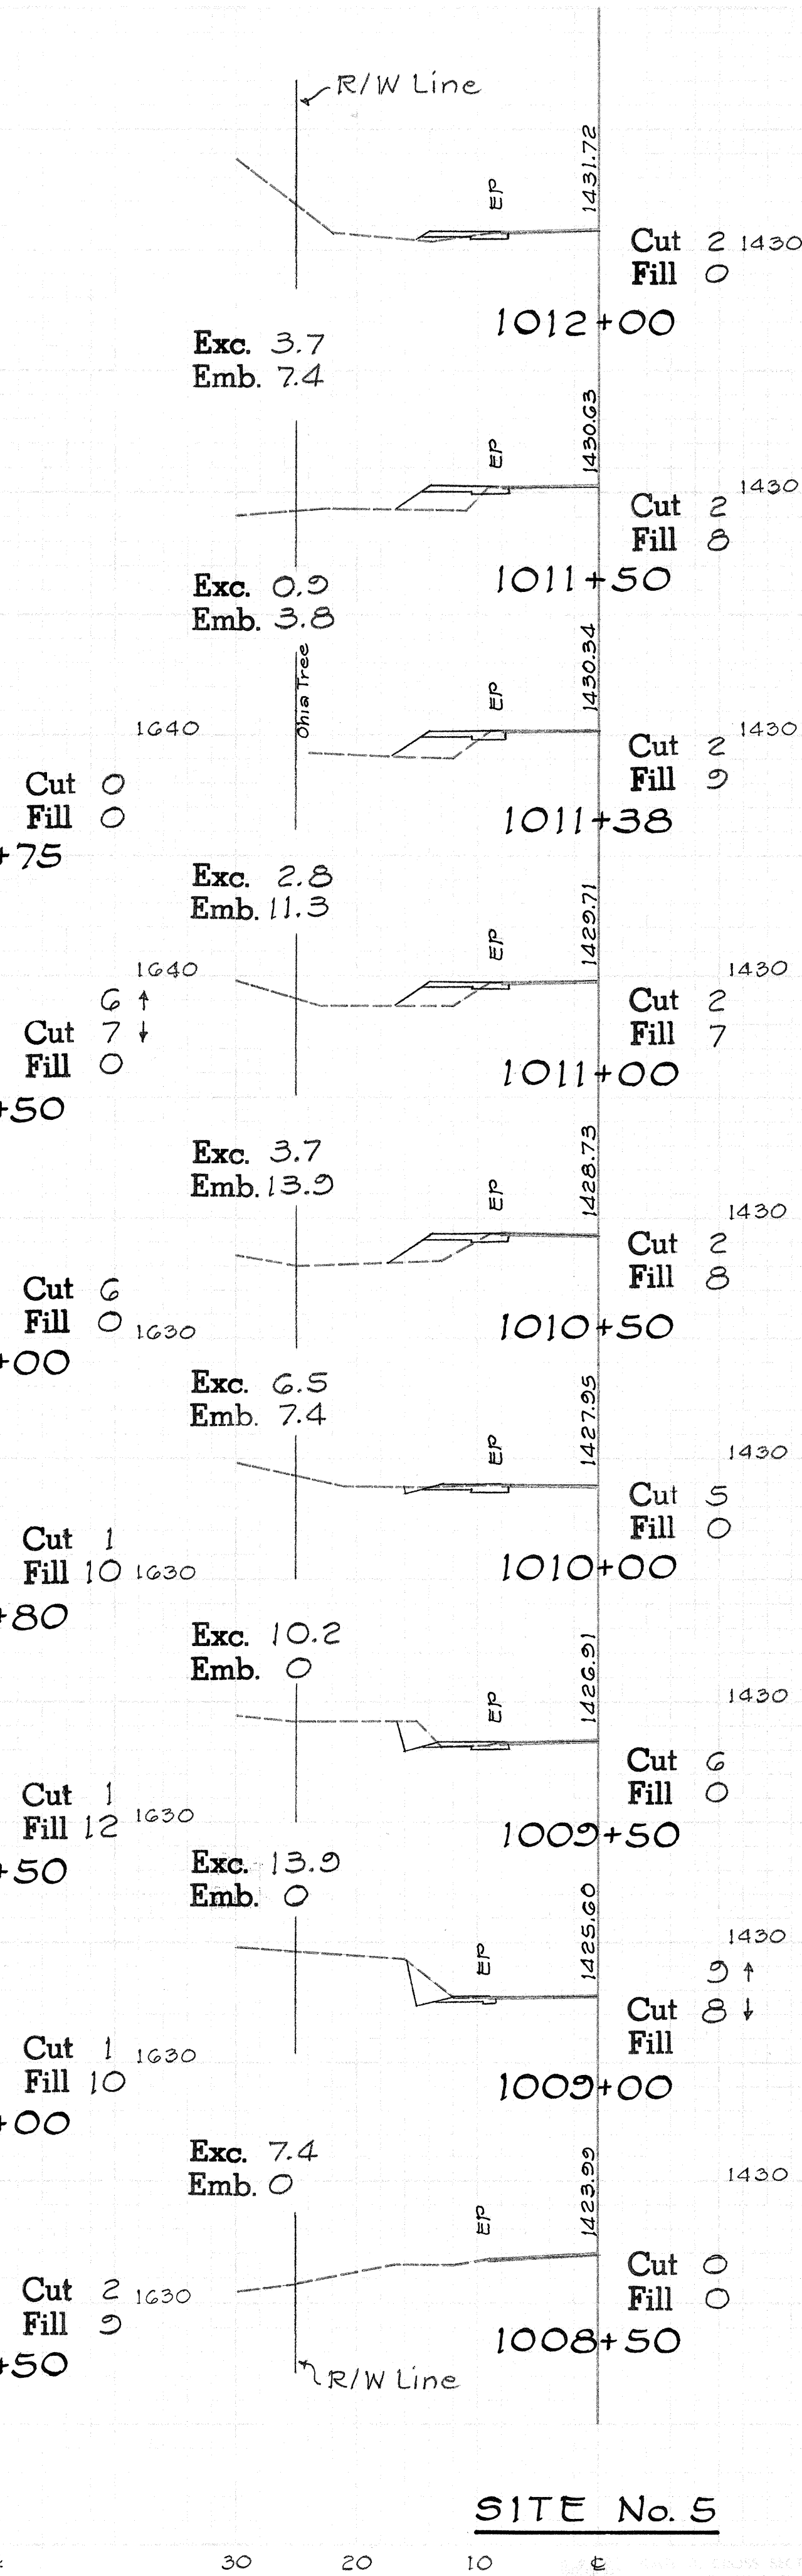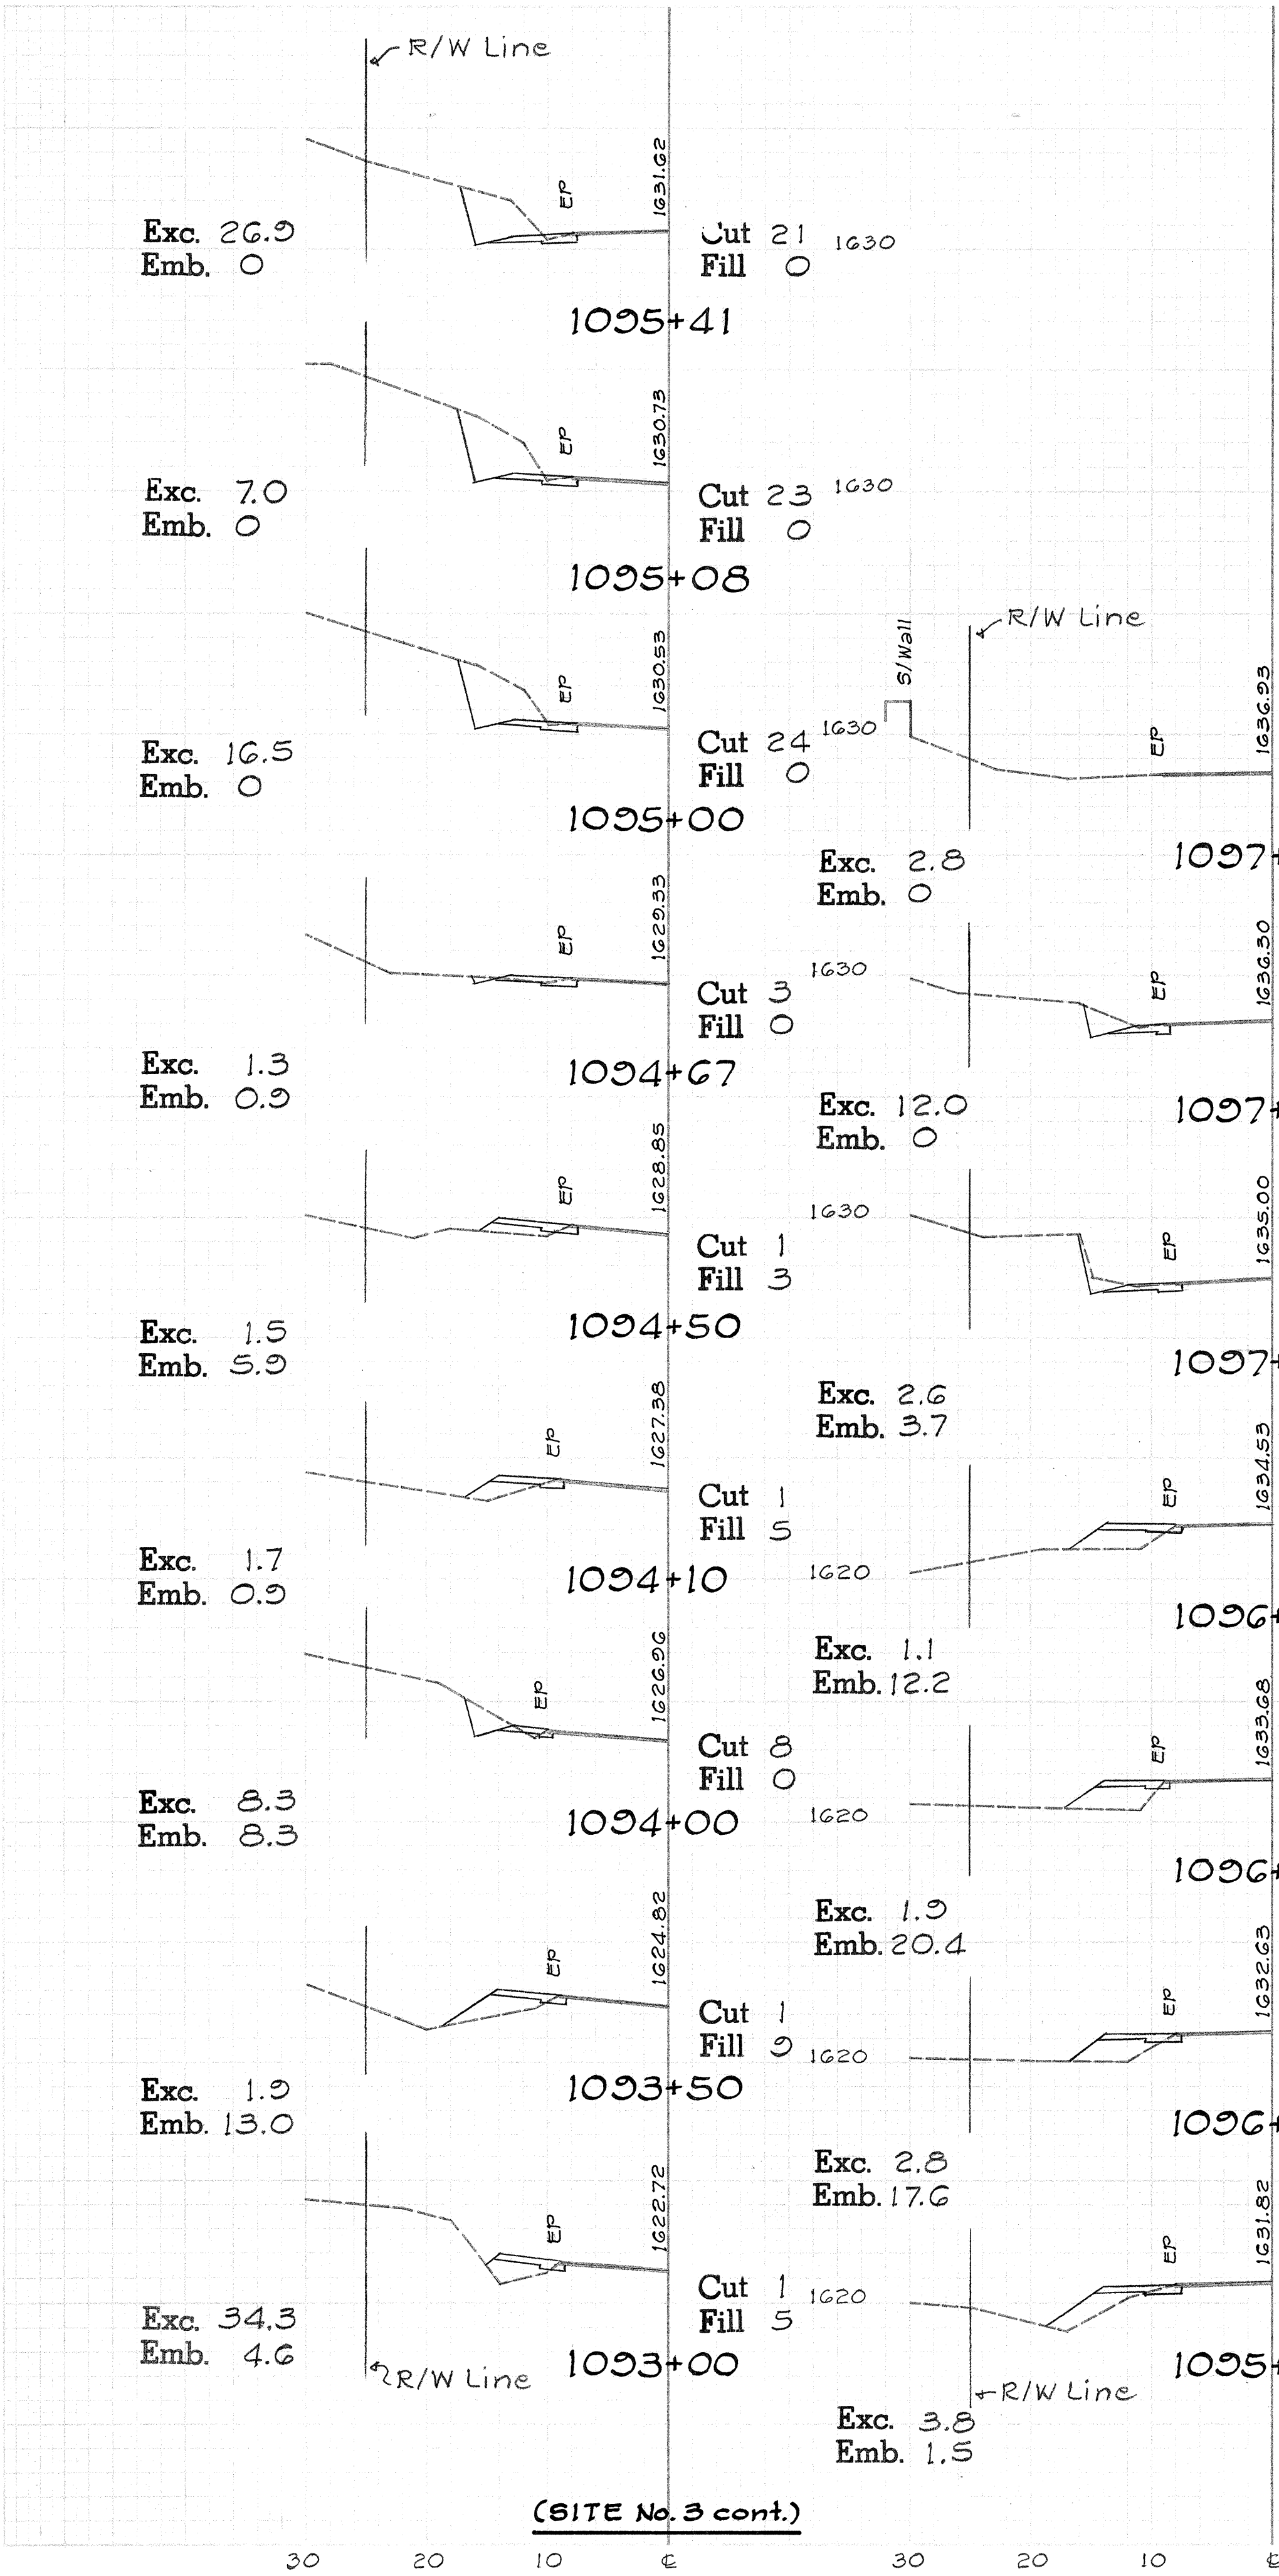


FED. ROAD DIST. NO.	STATE	PROJ. NO.	FISCAL YEAR	SHEET NO.	TOTAL SHEETS
HAWAII	HAW.	118C-01-75	75	17	23

ORIGINAL SURVEY PLAT
NOTED: 10/1/75
DATE: 10/1/75
BY: [Signature]


ORIGINAL SURVEY PLAT
NOTED: 10/1/75
DATE: 10/1/75
BY: [Signature]

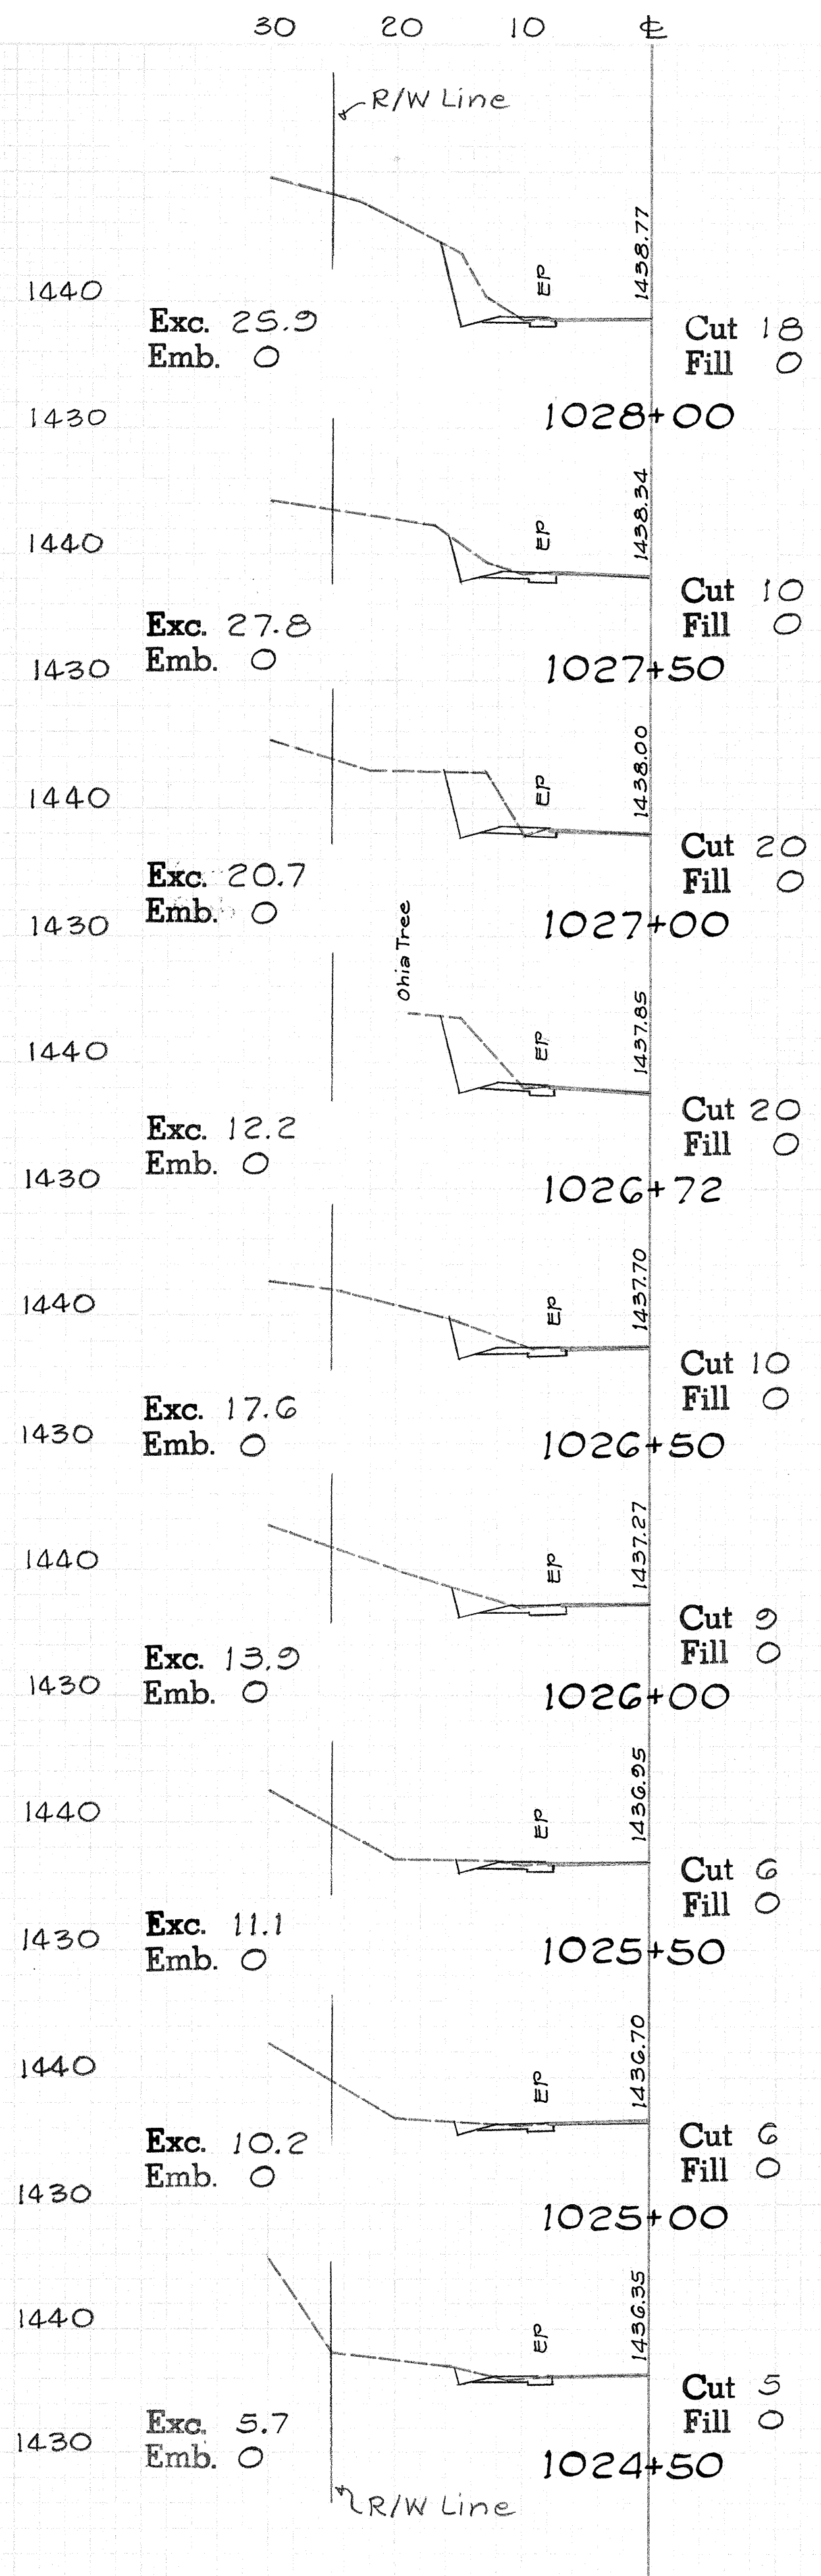

(SITE No. 5 cont.)

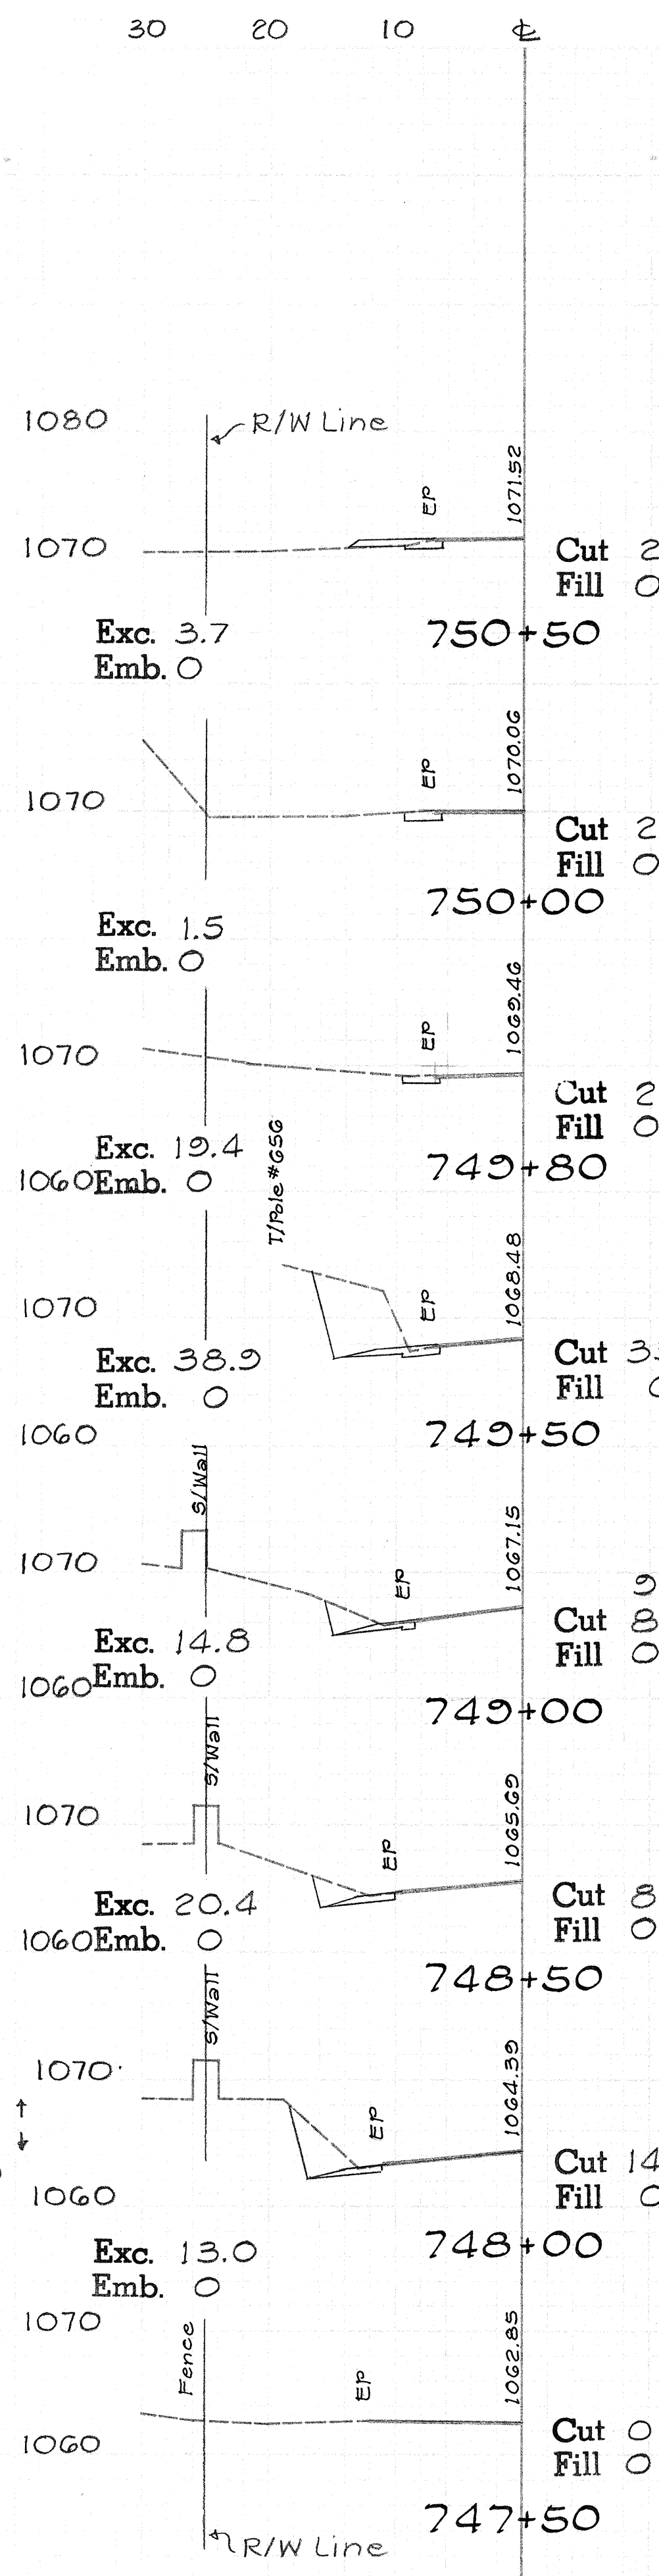


SITE No. 14

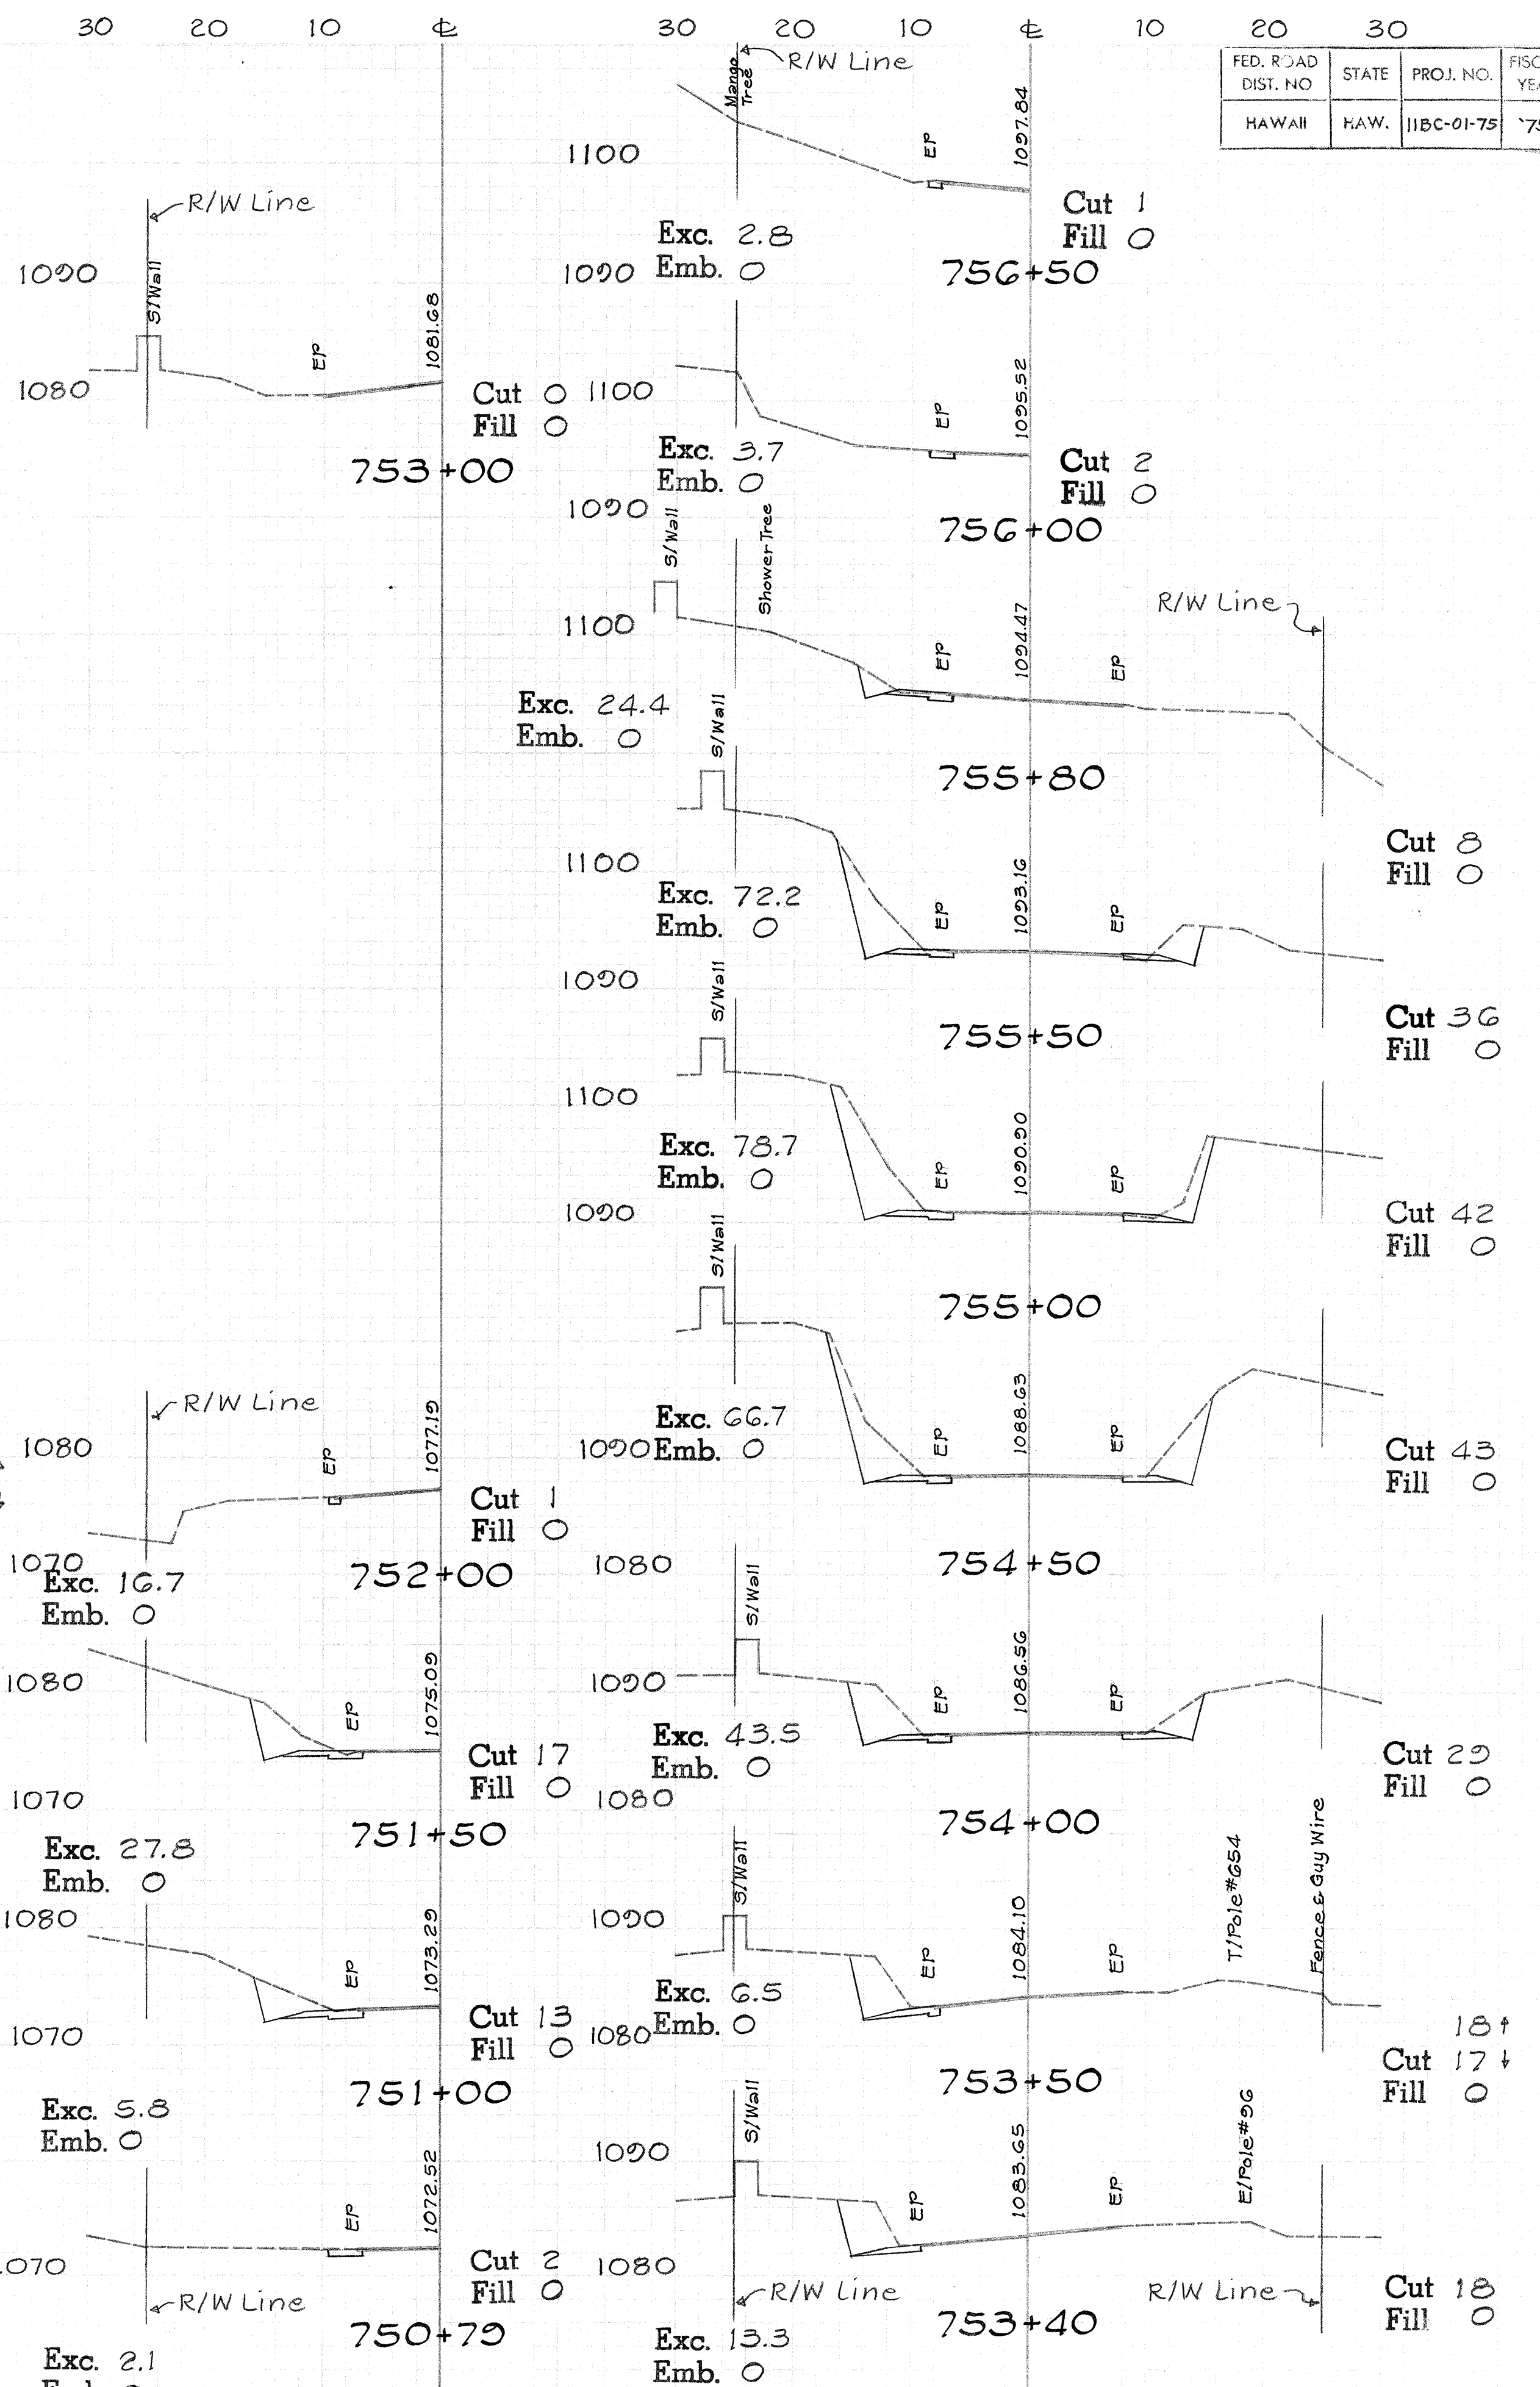

ORIGINAL SURVEY
DATE: 11/1/75
BY: J. L. HARRIS
CHECKED: J. L. HARRIS
DATE: 11/1/75


ORIGINAL SURVEY
DATE: 11/1/75
BY: J. L. HARRIS
CHECKED: J. L. HARRIS
DATE: 11/1/75


AD	STATE	PROJ. NO.	FISCAL YEAR	SHEET NO.	TOTAL SHEETS
11Bc-01-75	PAW.	11Bc-01-75	75	18	23

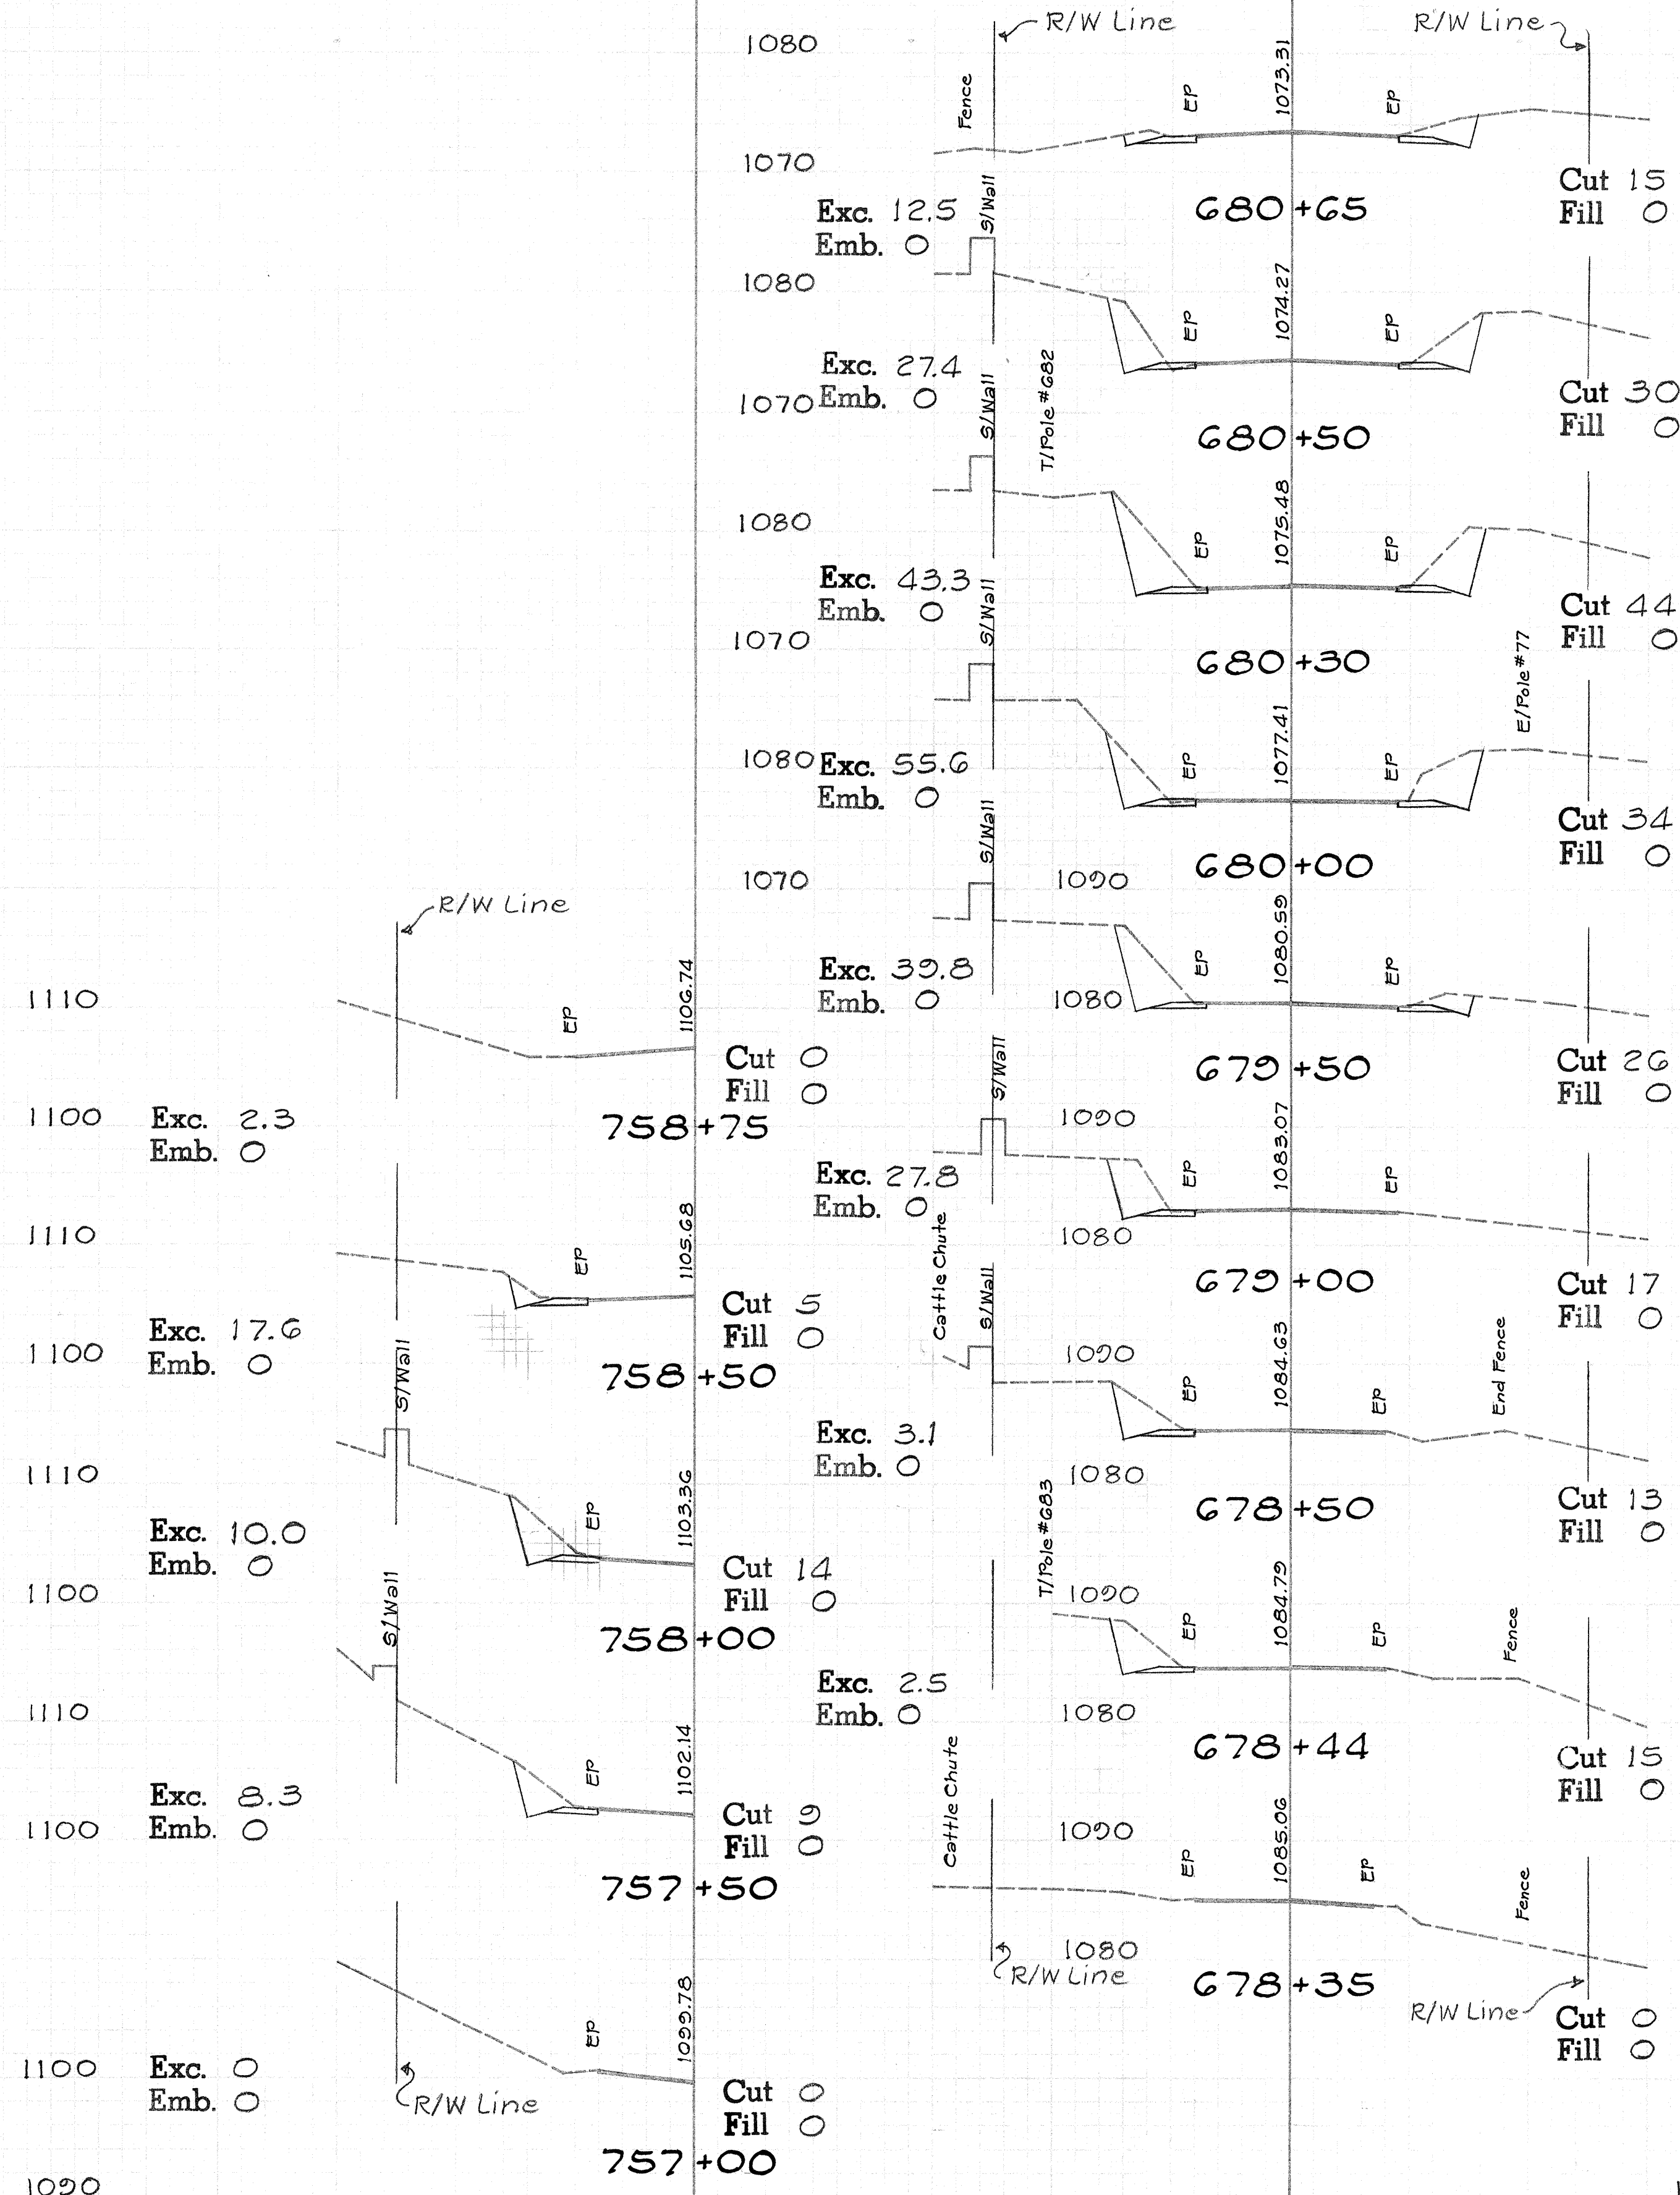

Exc = 2.8
Exc = 19.4
Exc = 14.8
Exc = 3.7

Note: See Sheet 21 For Continuation Of Site No. 16.


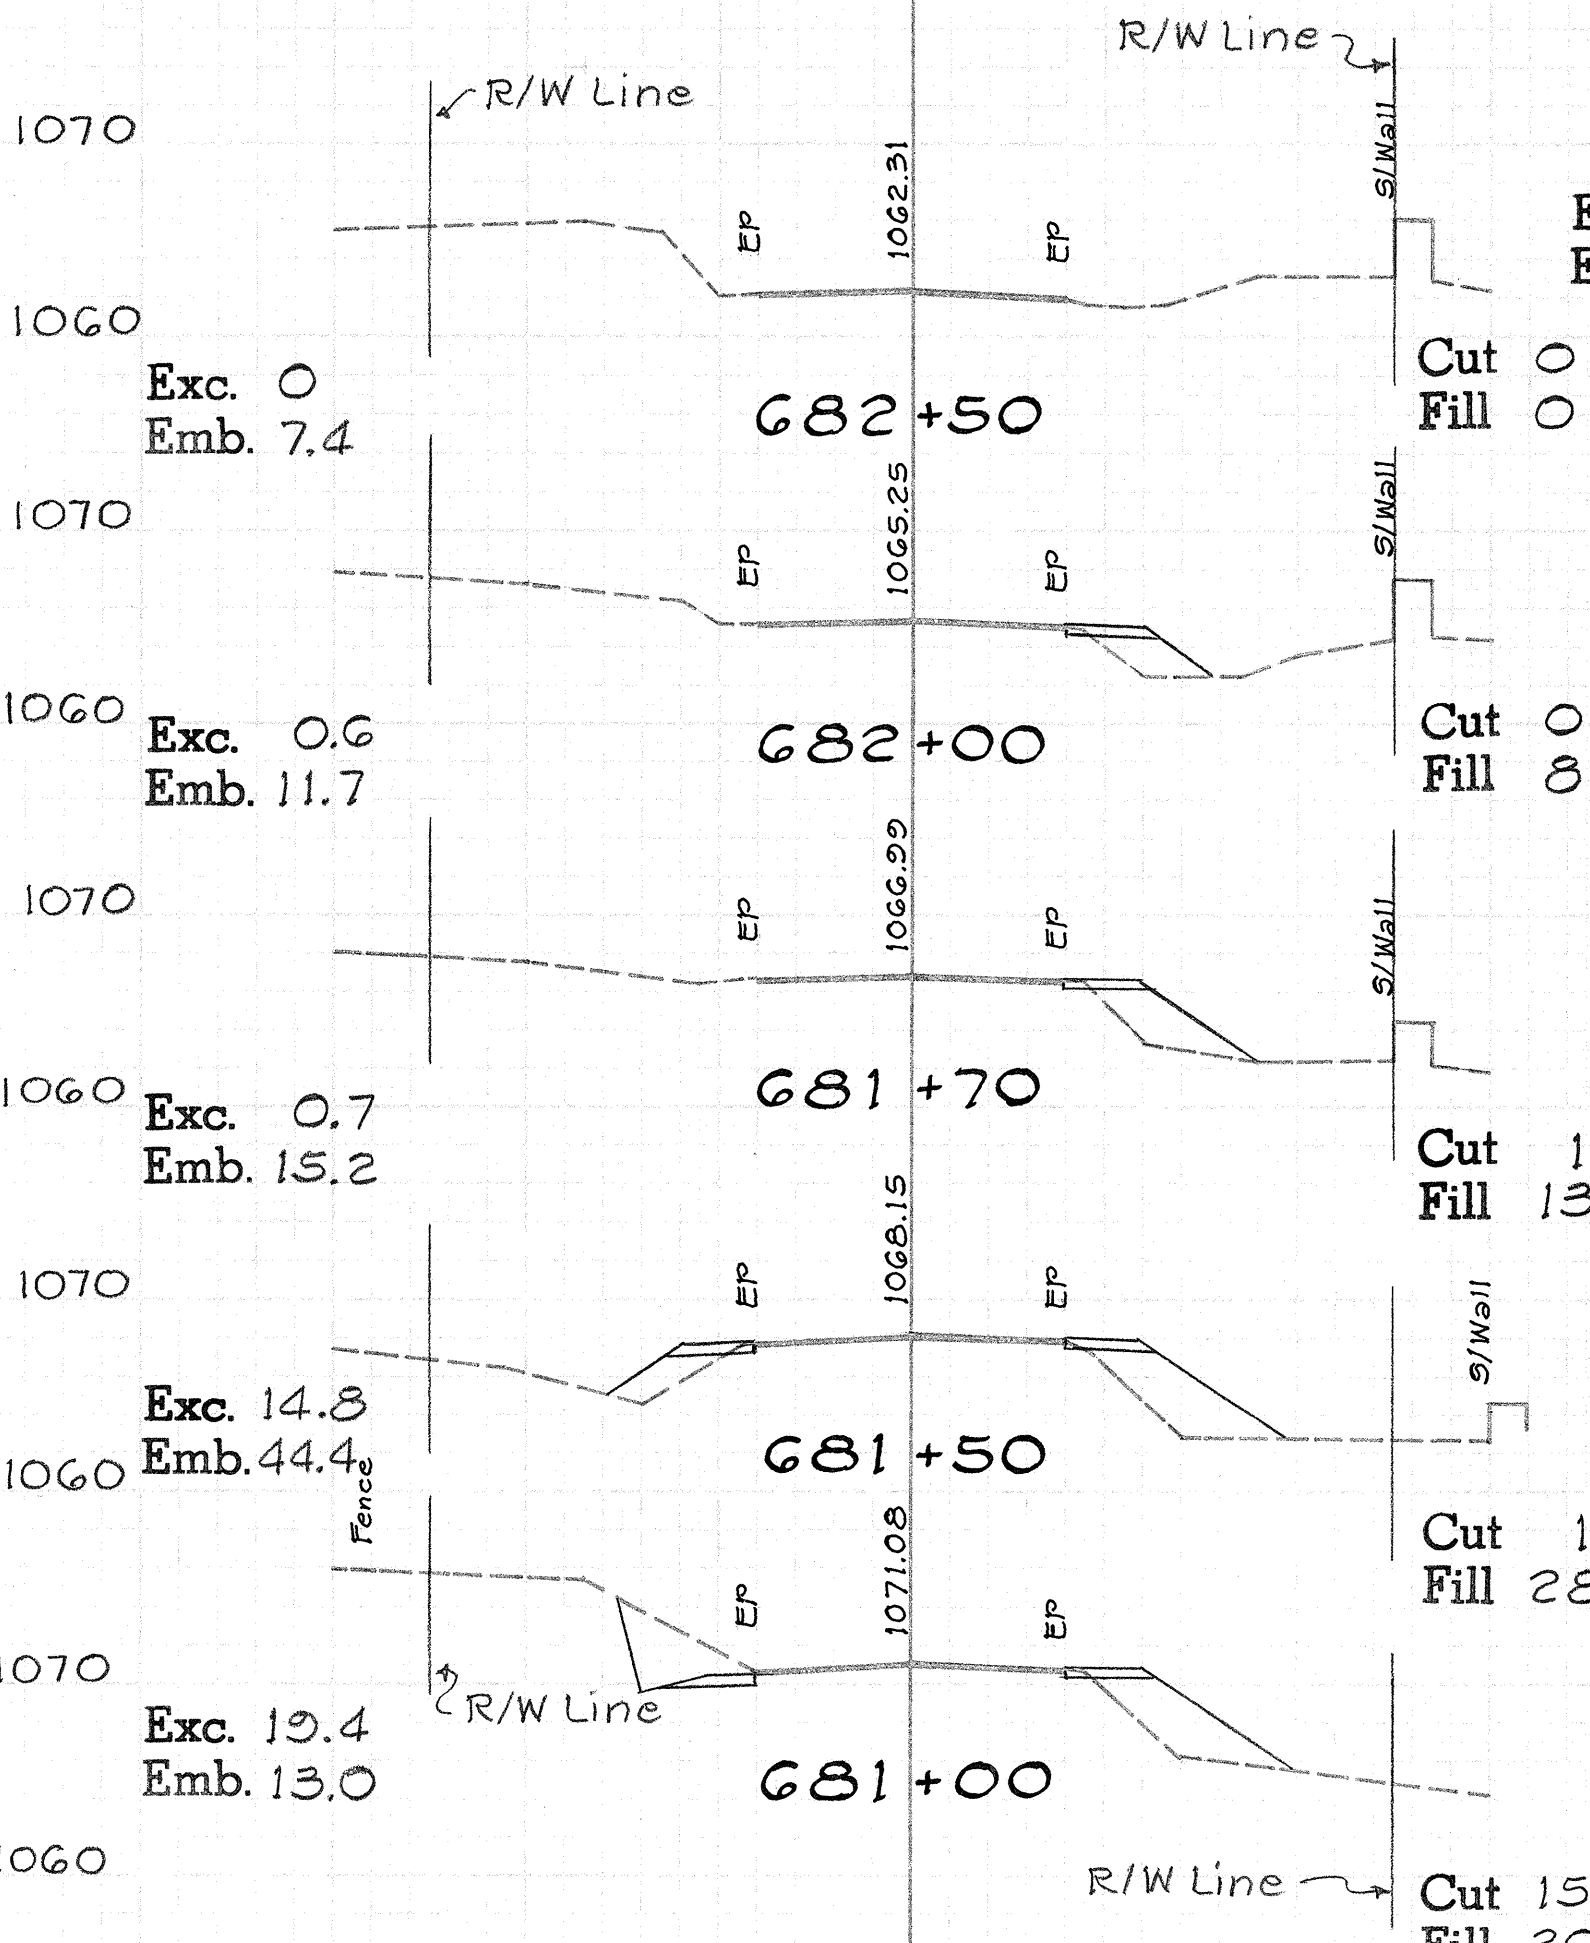


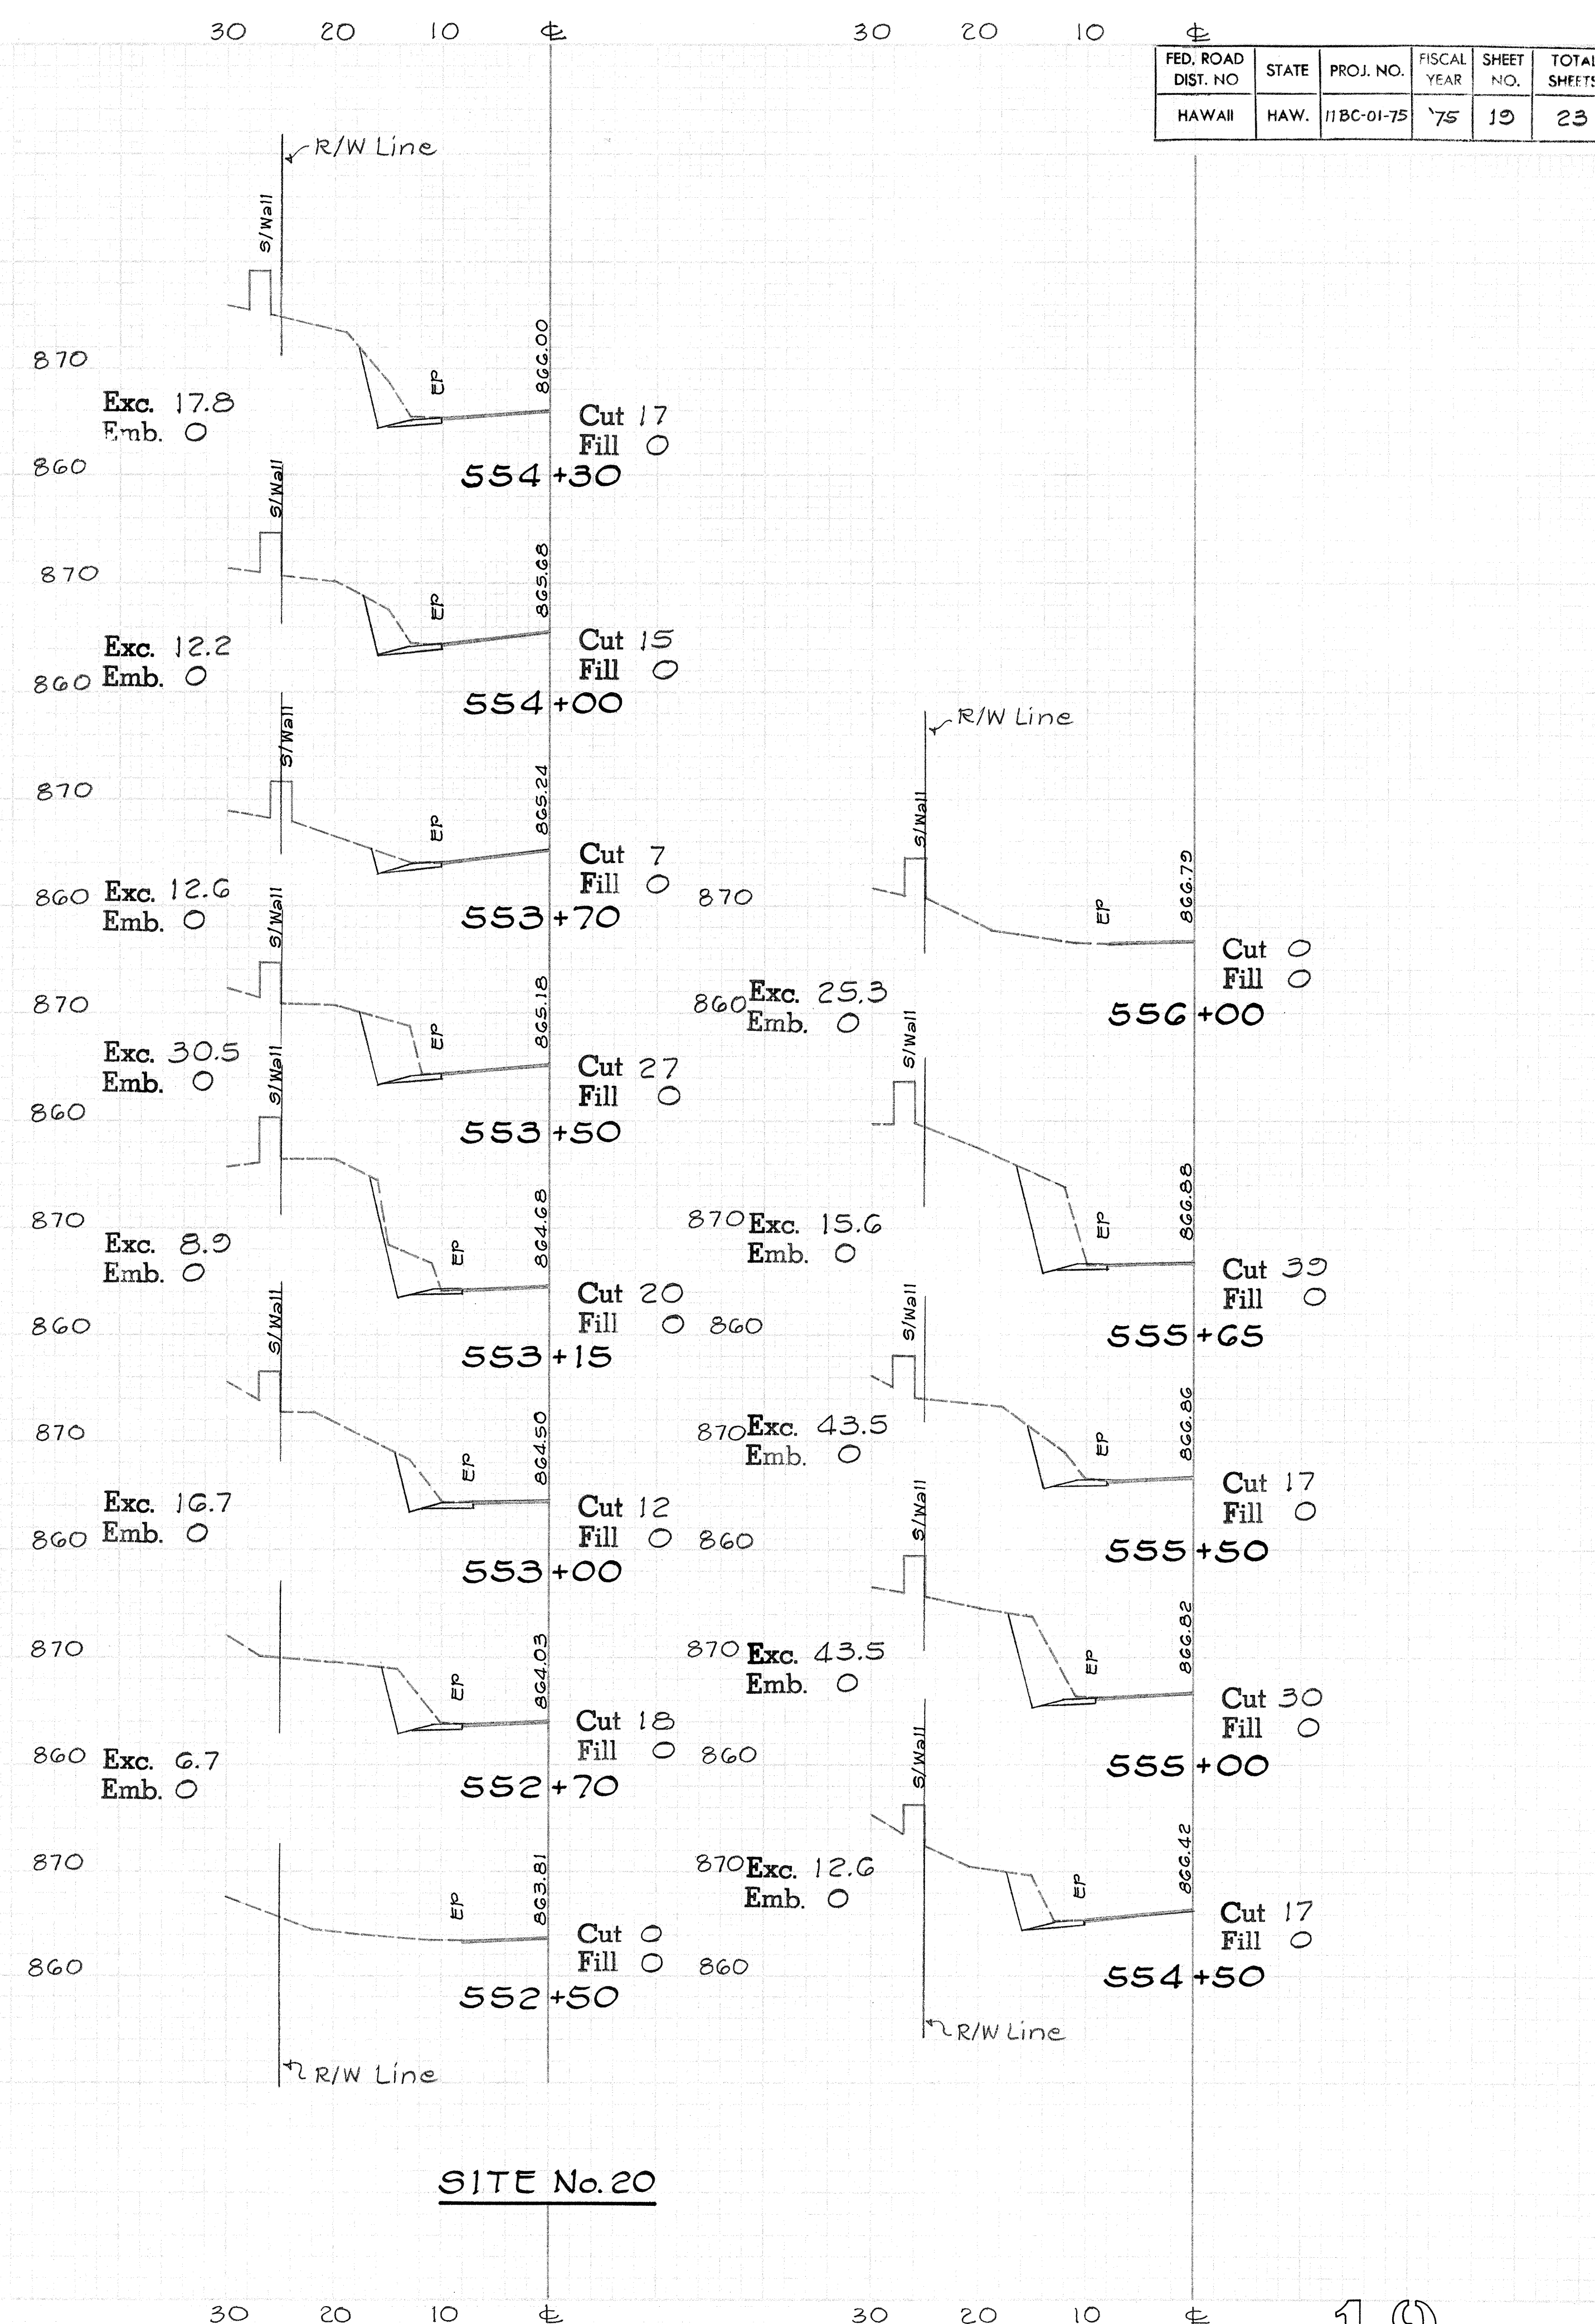


FED. ROAD DIST. NO.	STATE	PROJ. NO.	FISCAL YEAR	SHEET NO.	TOTAL SHEETS
HAWAII	HAW.	11BC-01-75	'75	20	23

FINAL SURVEY	DATE
SURVEY	
NOTE BOOK	
AREAS CHECKED	




ORIGINAL SURVEY	DATE
SURVEY	
NOTE BOOK	
AREAS CHECKED	

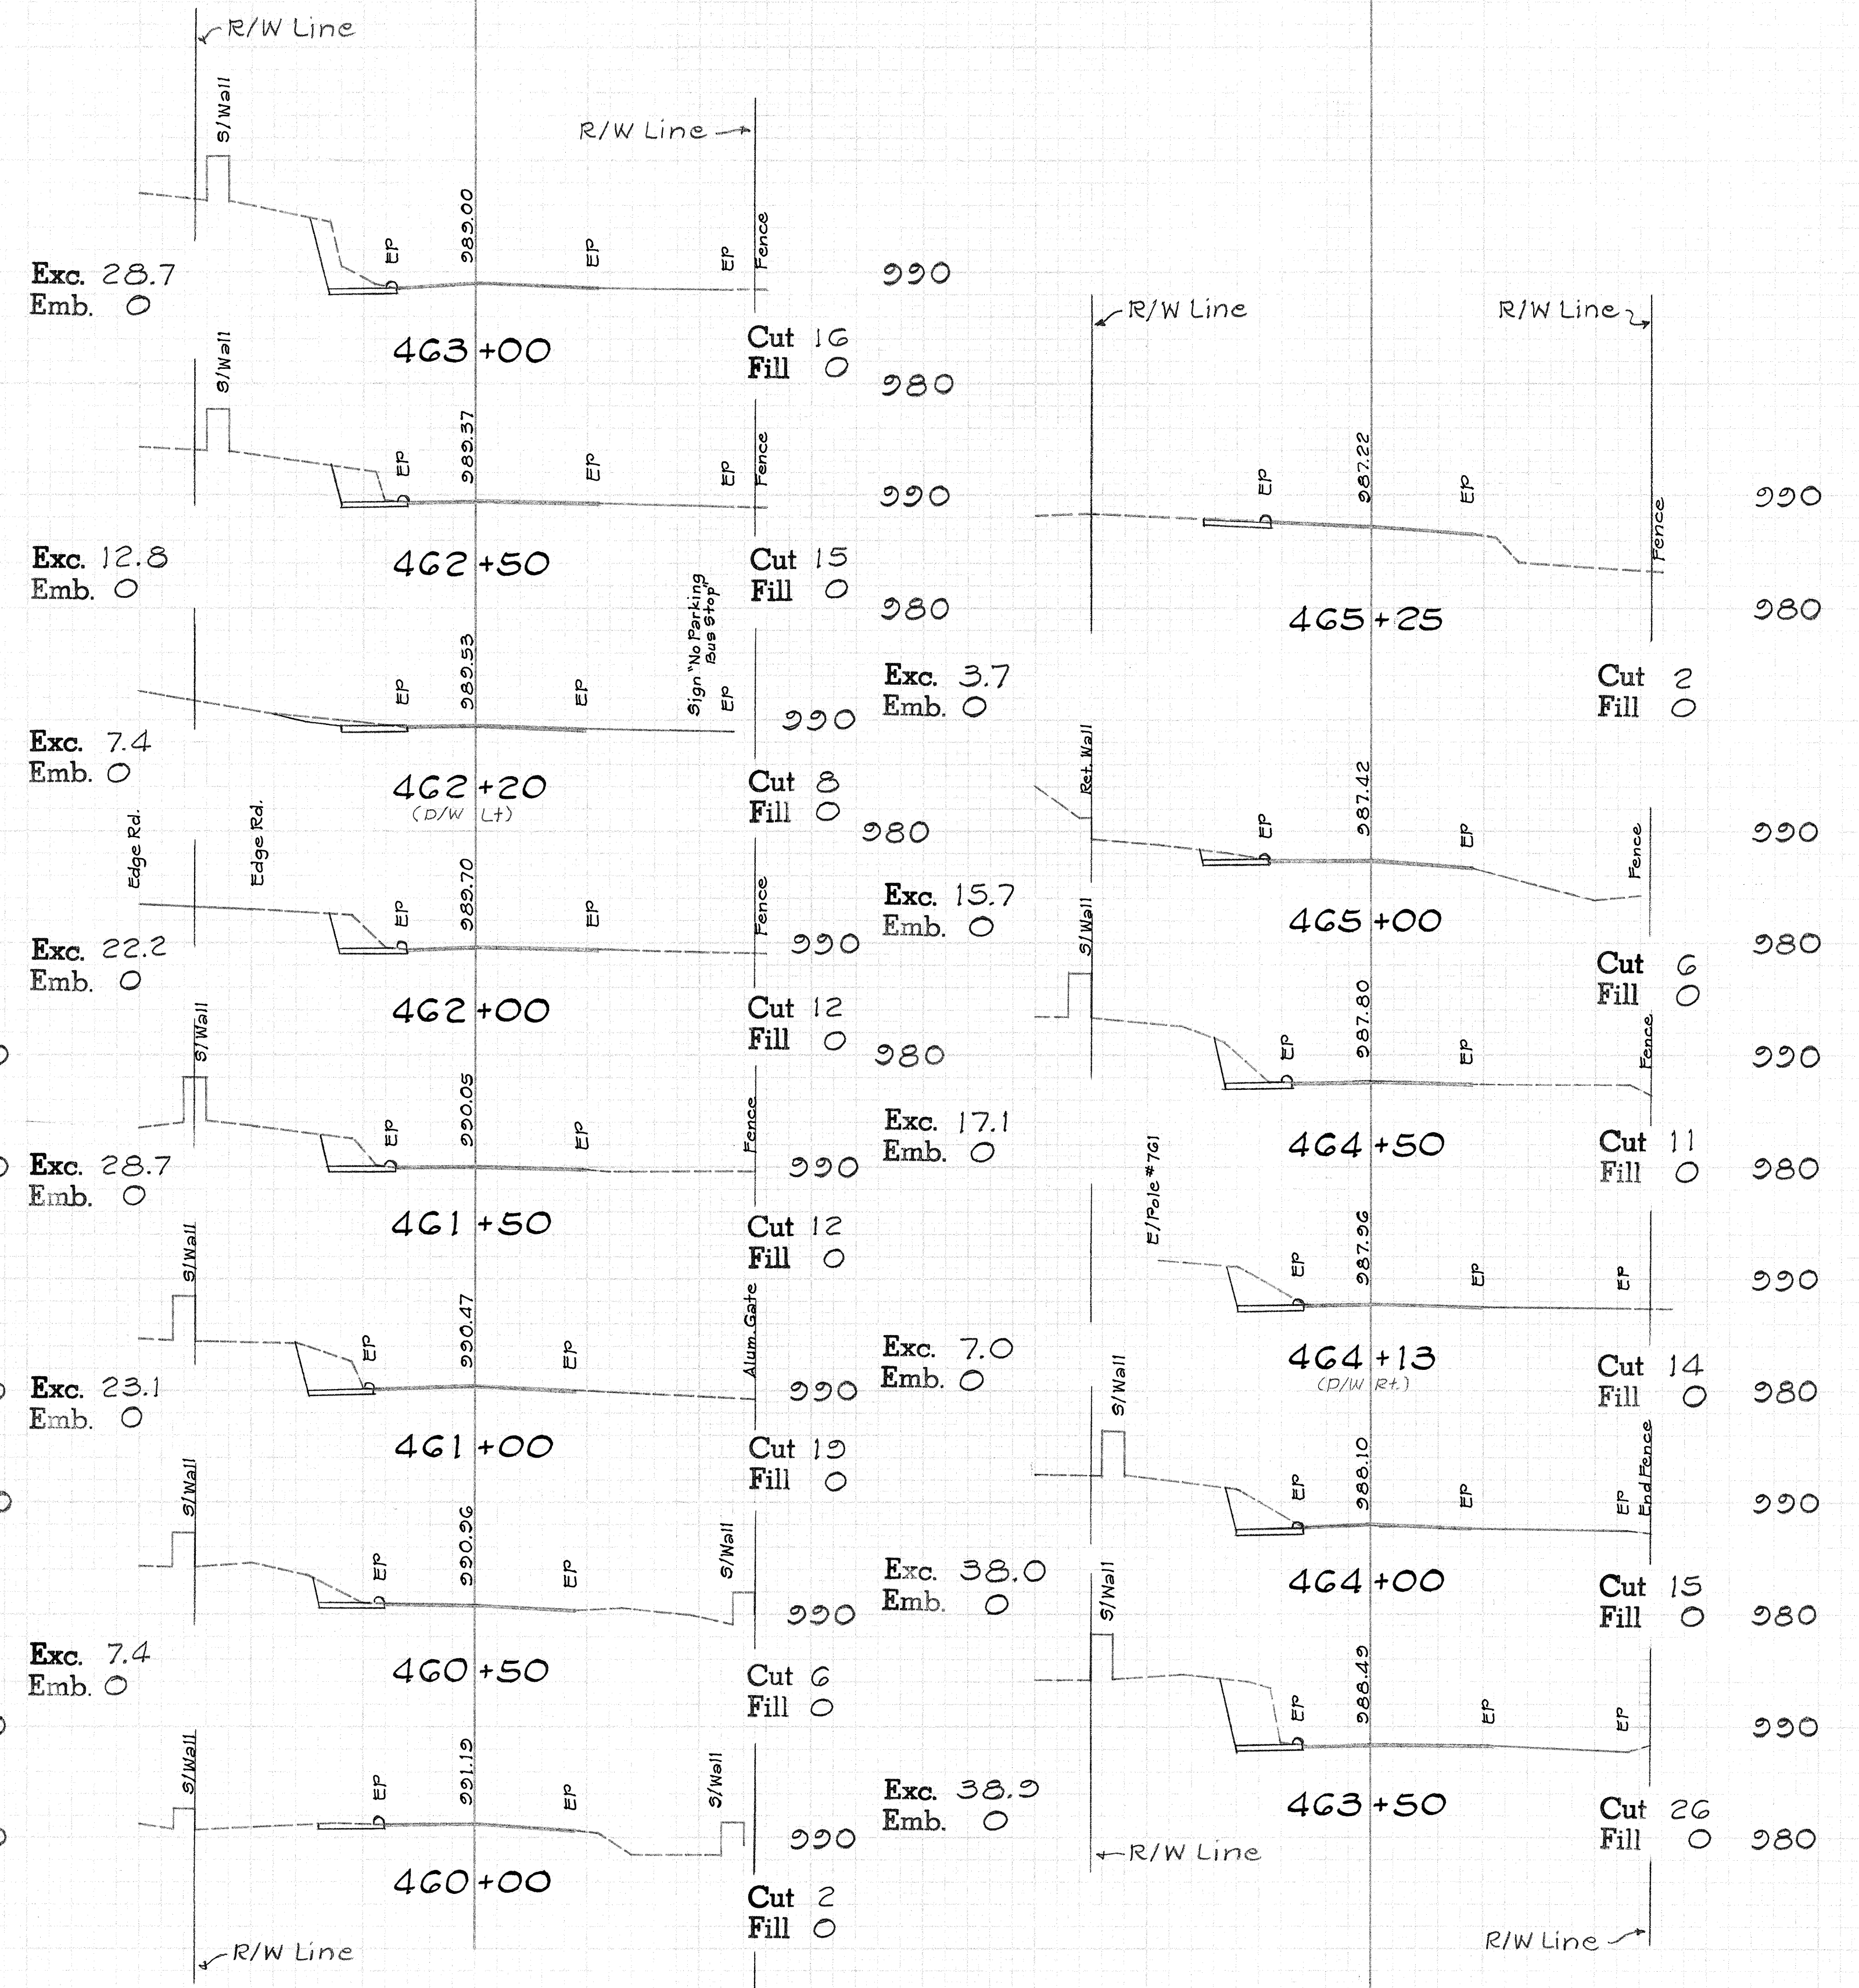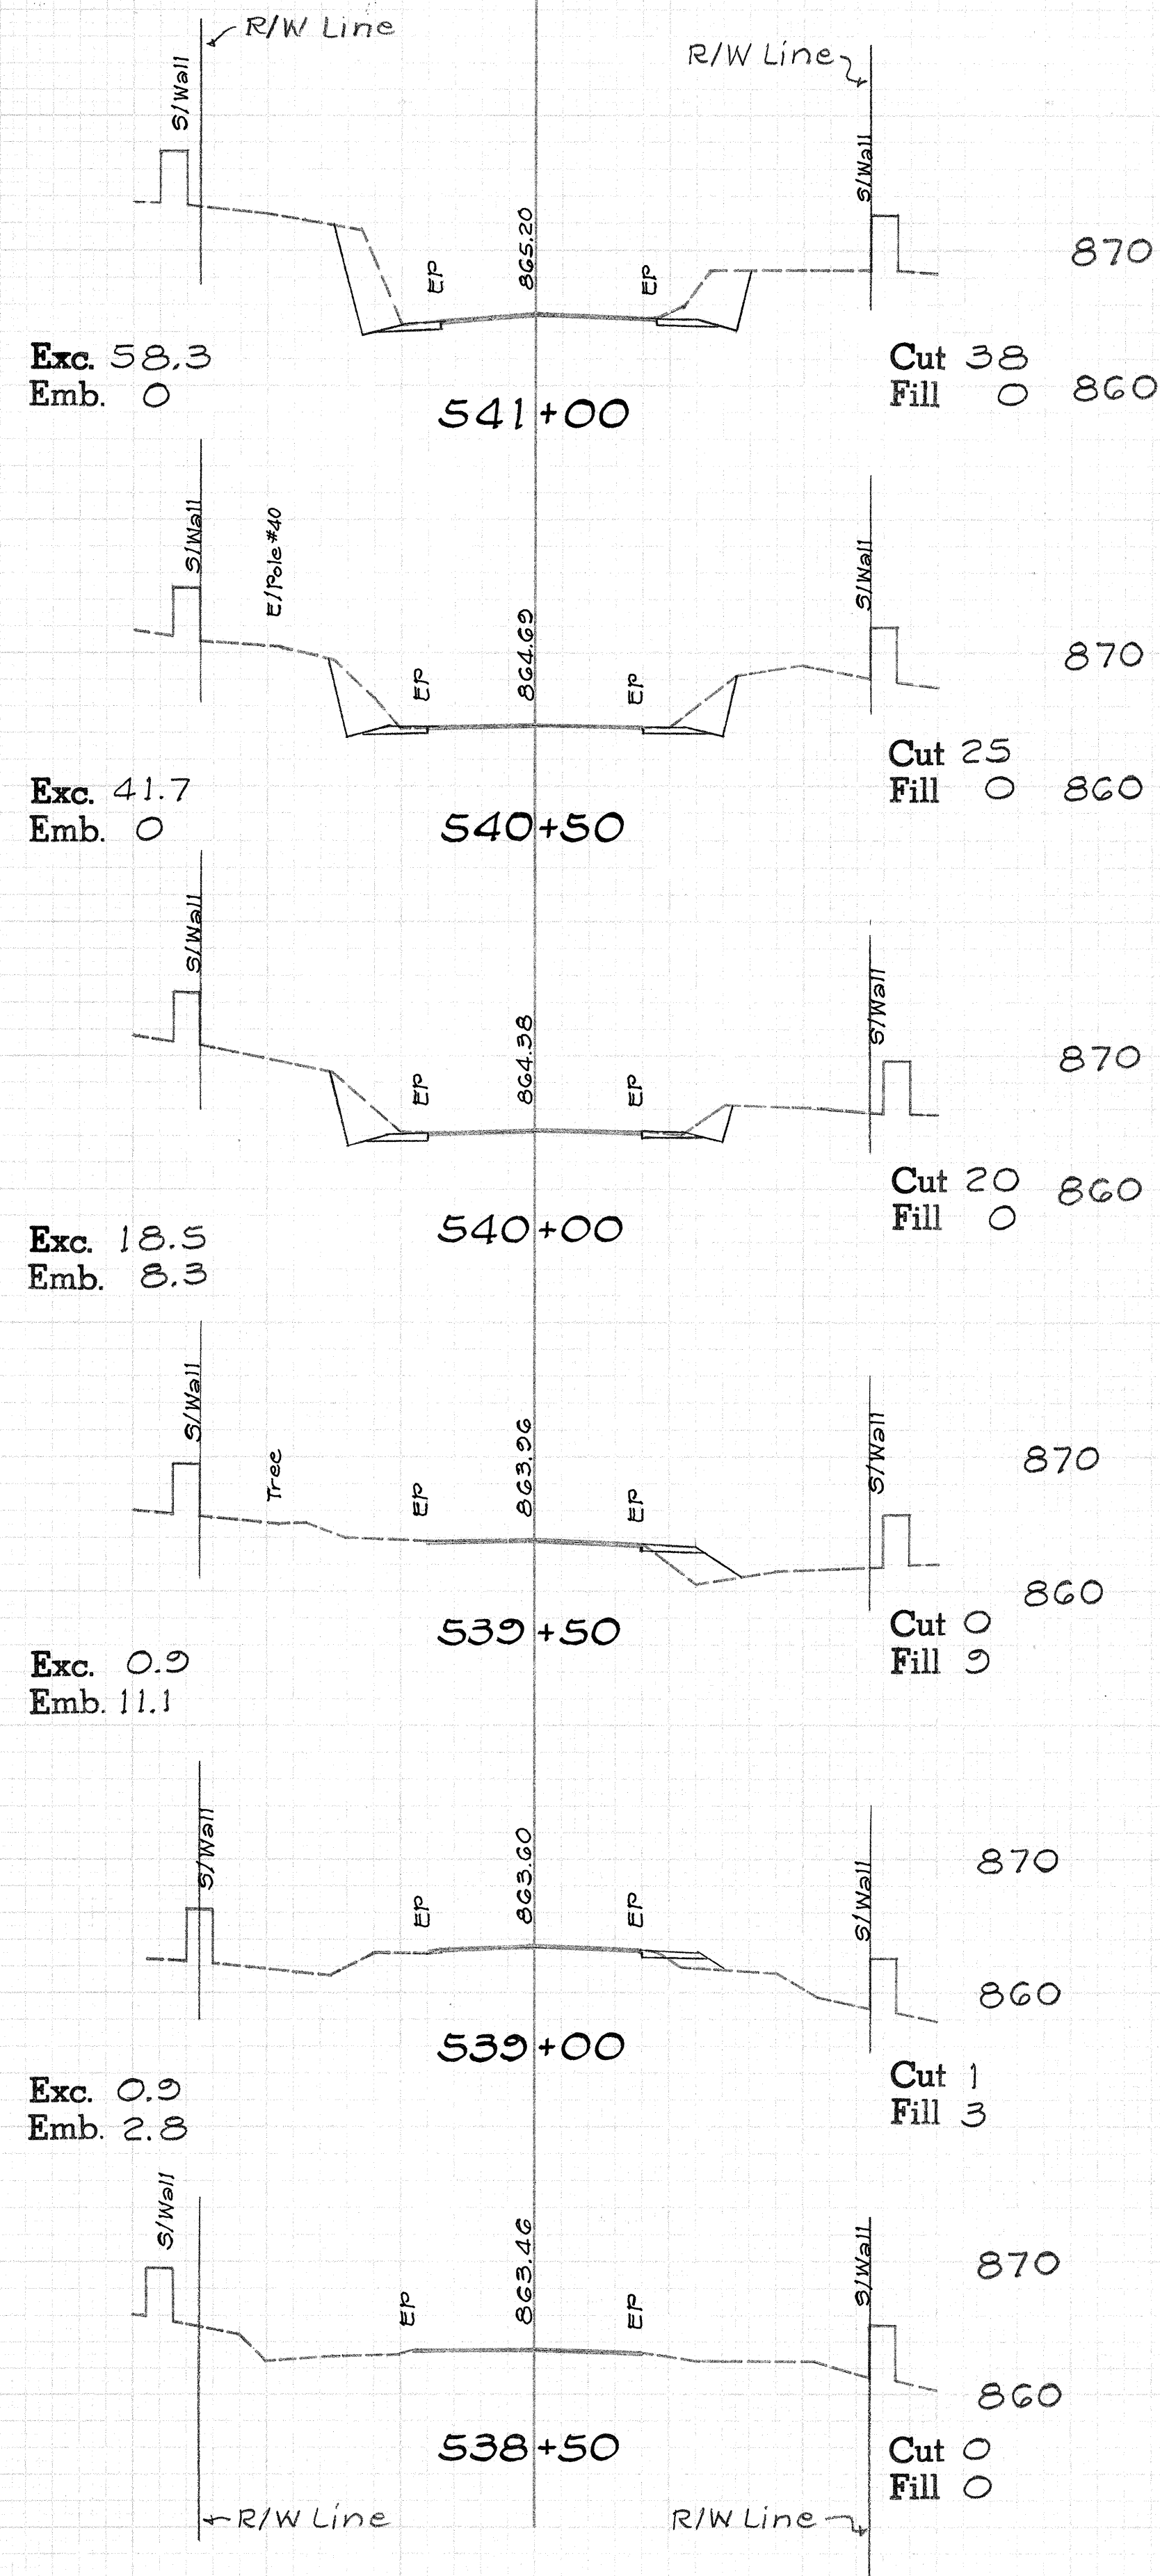

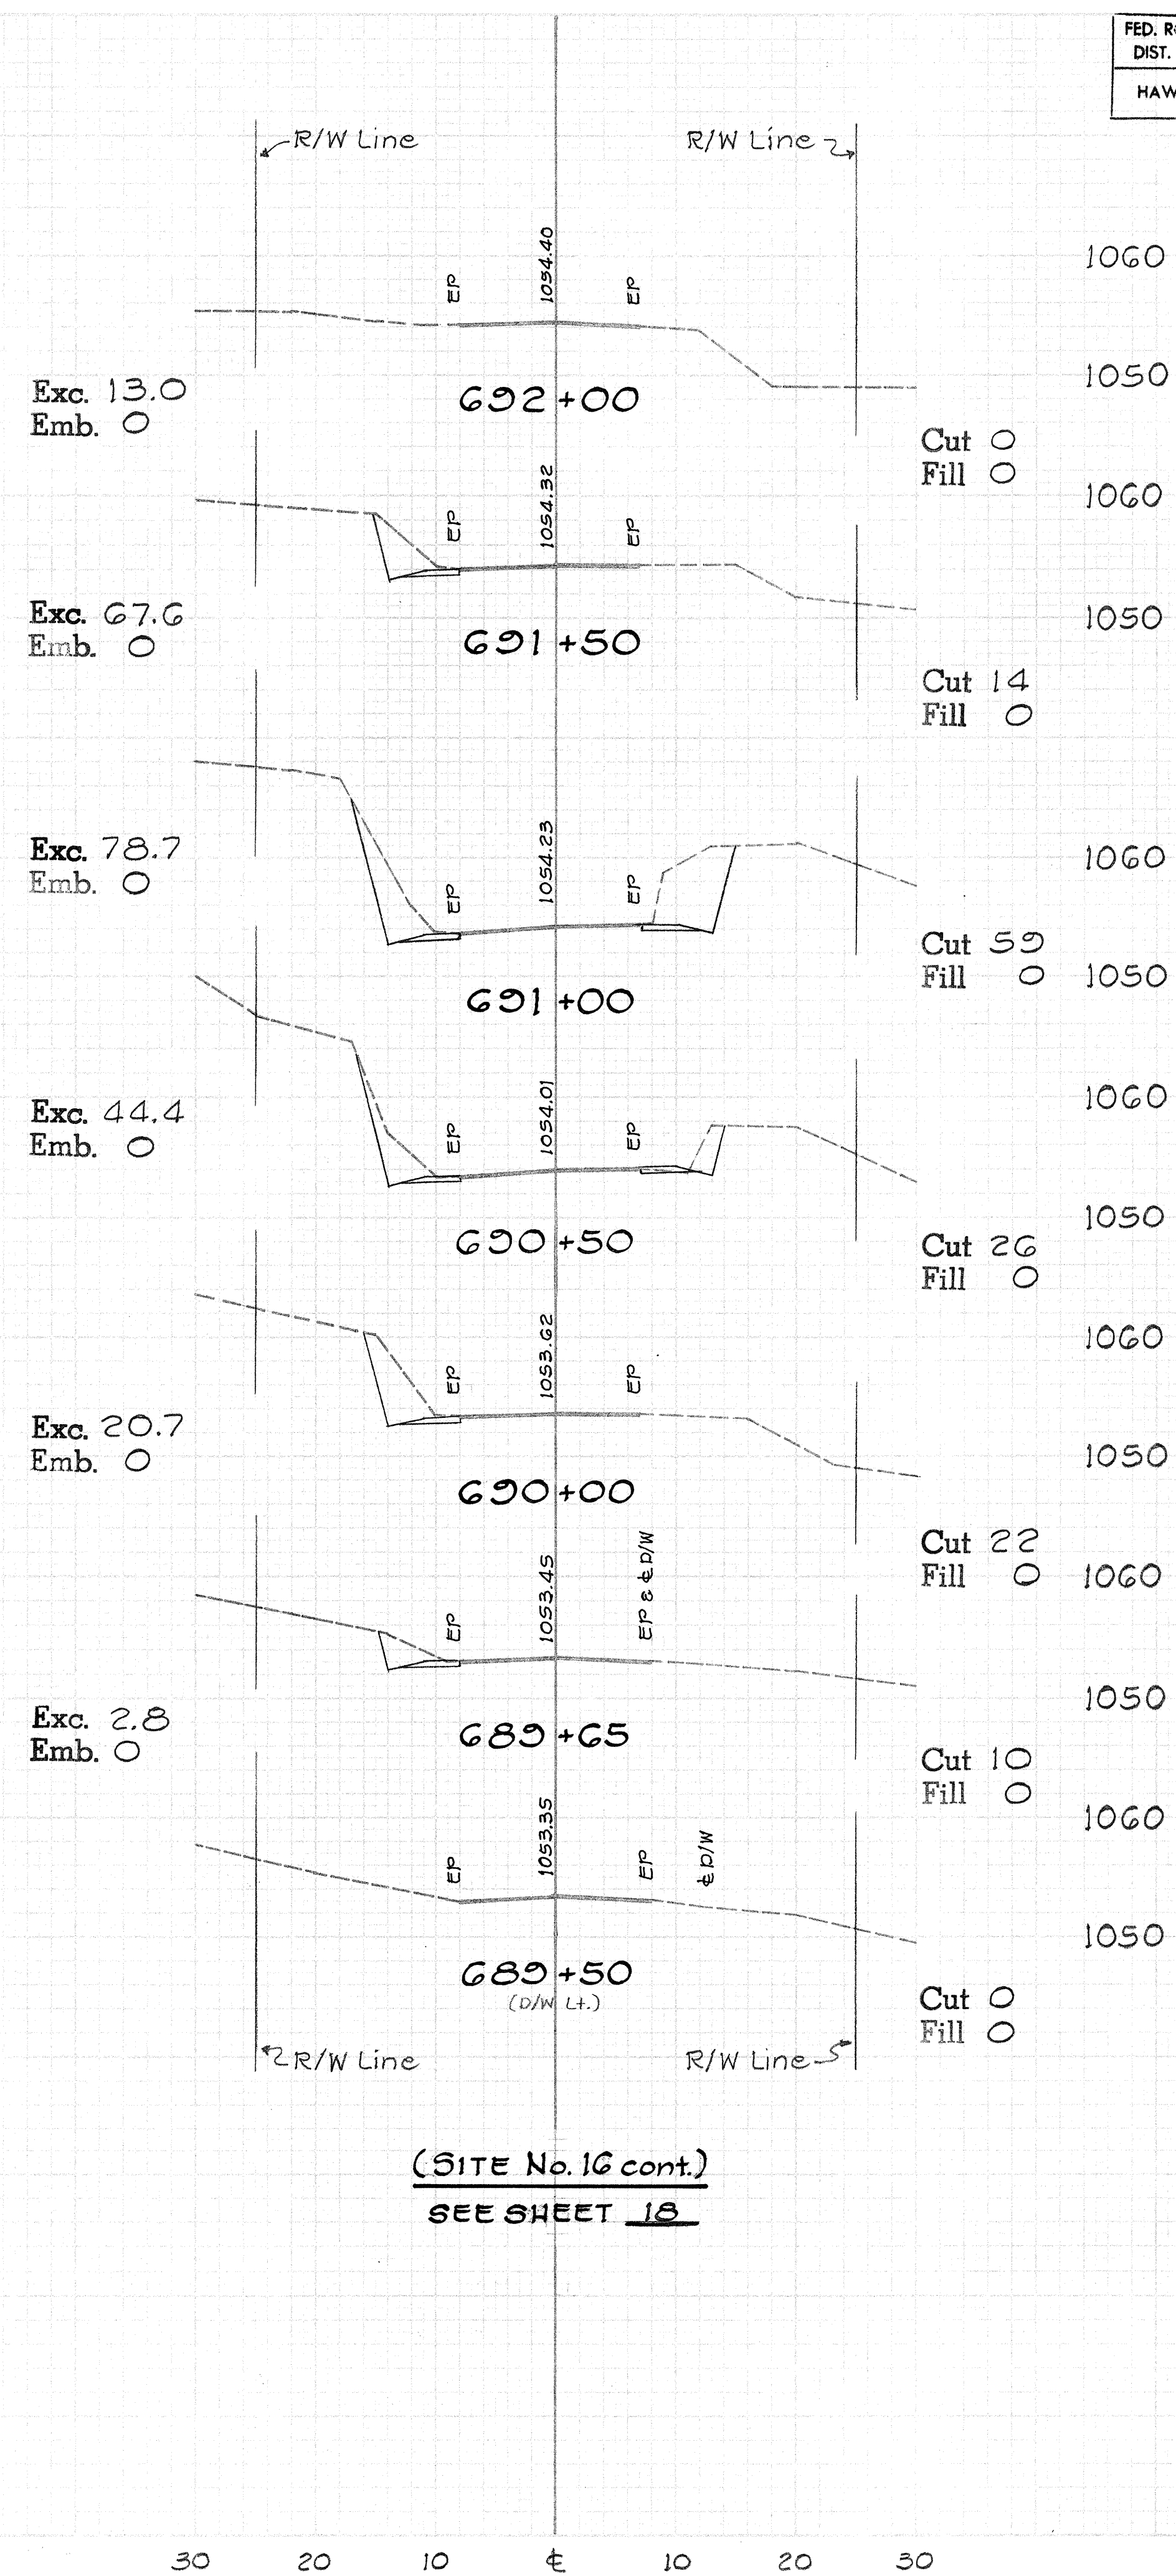

21

FED. ROAD DIST. NO.	STATE	PROJ. NO.	FISCAL YEAR	SHEET NO.	TOTAL SHEETS
HAWAII	HAW.	11BC-01-75	'75	22	23

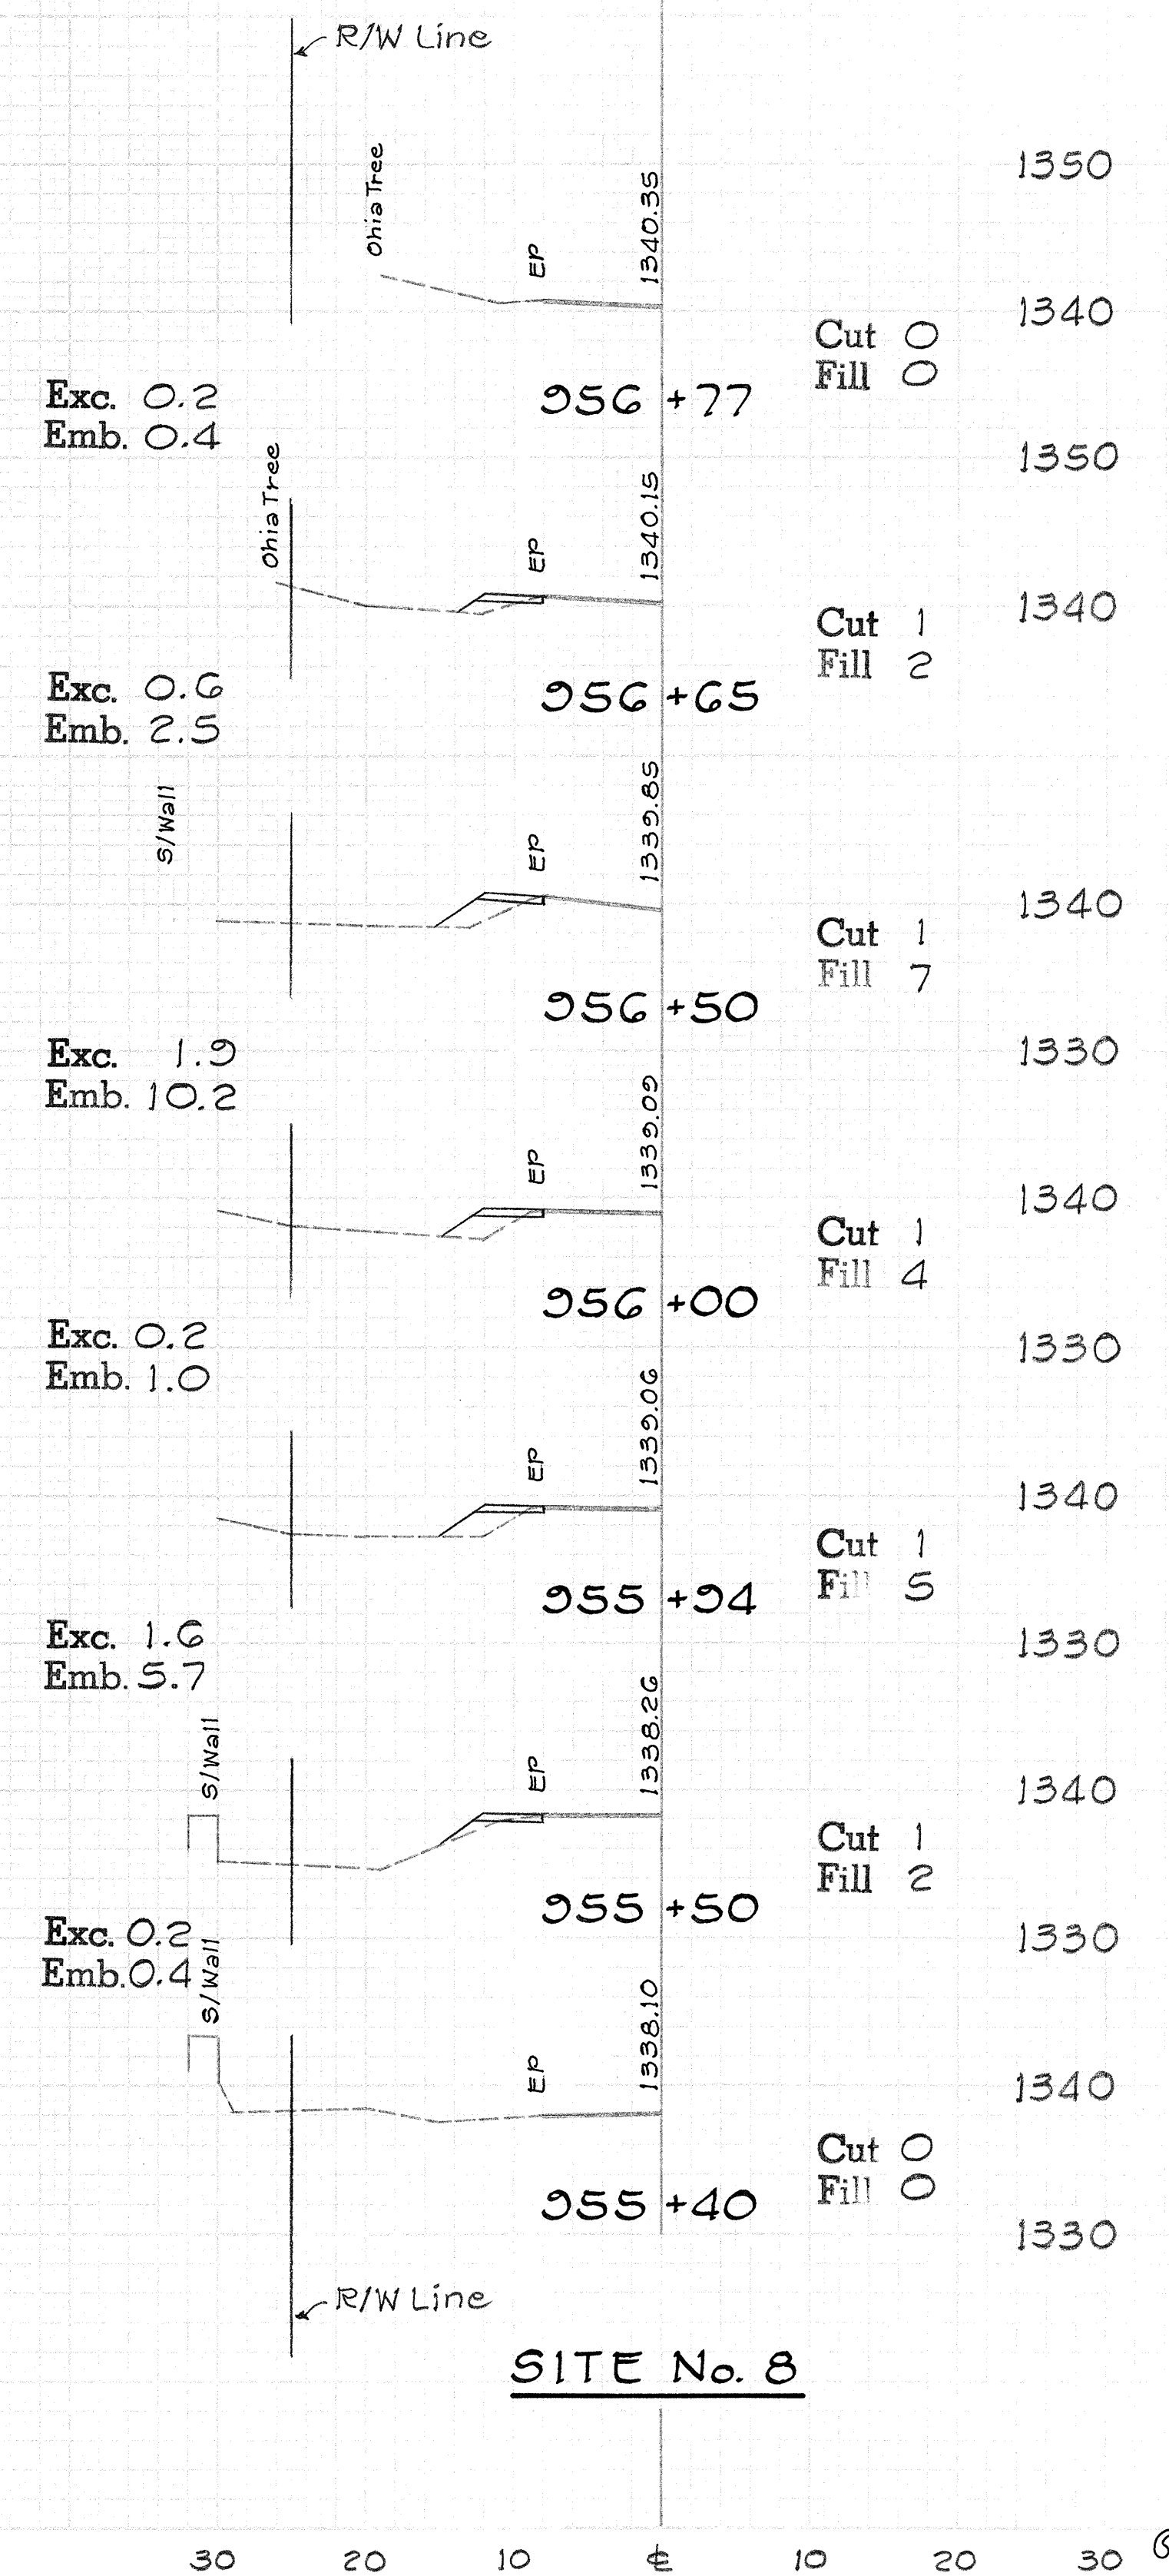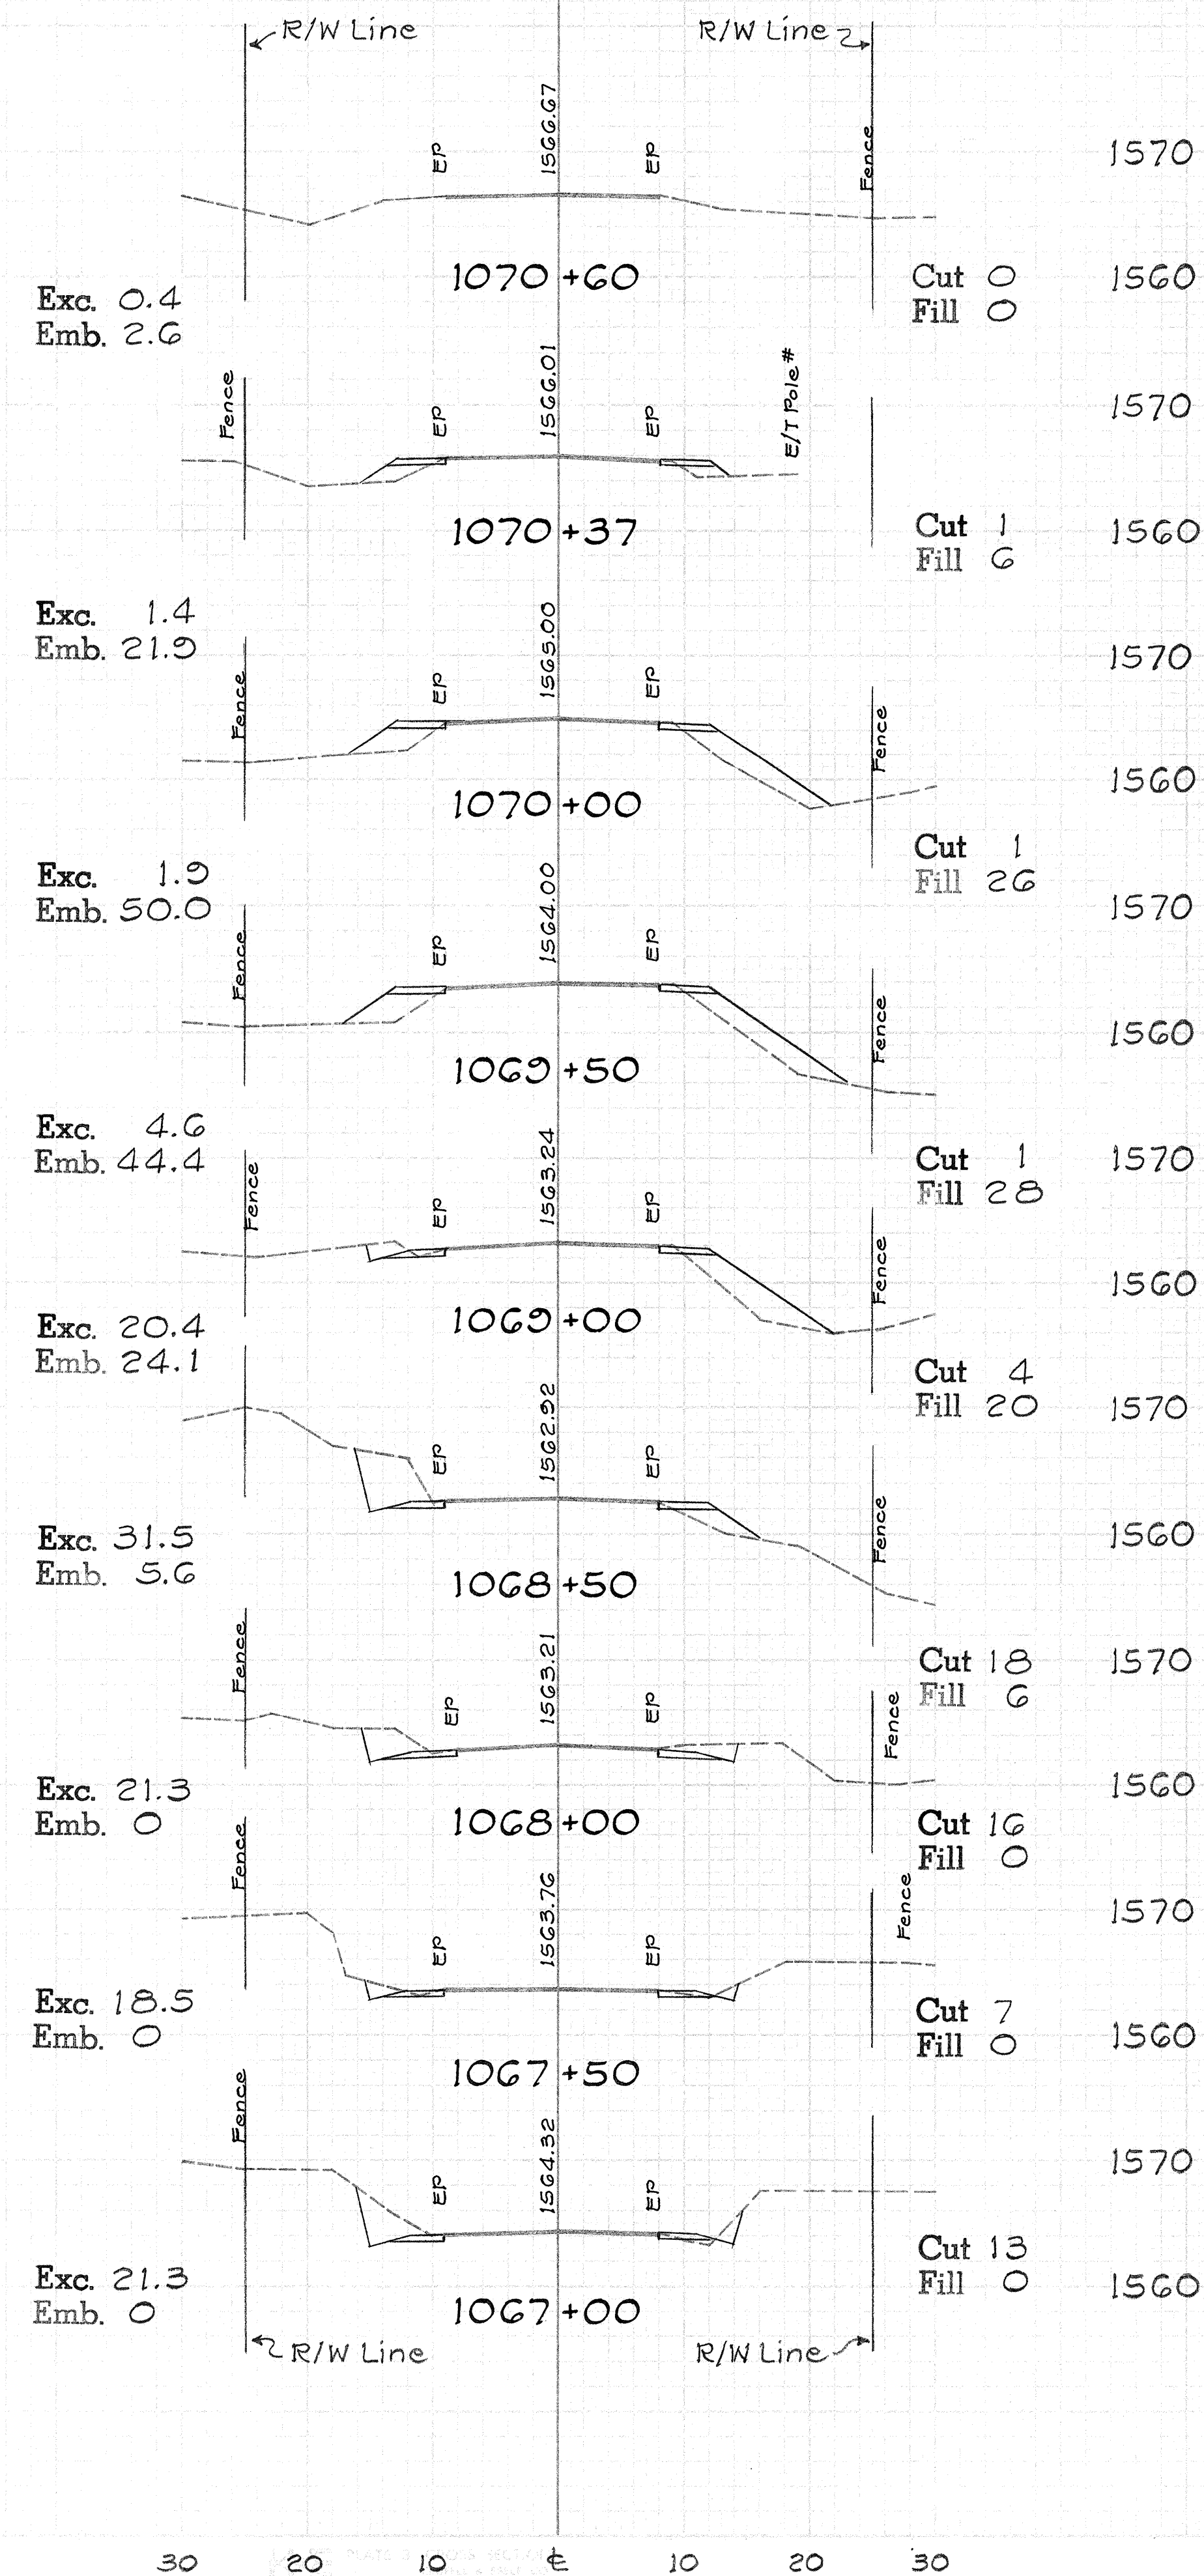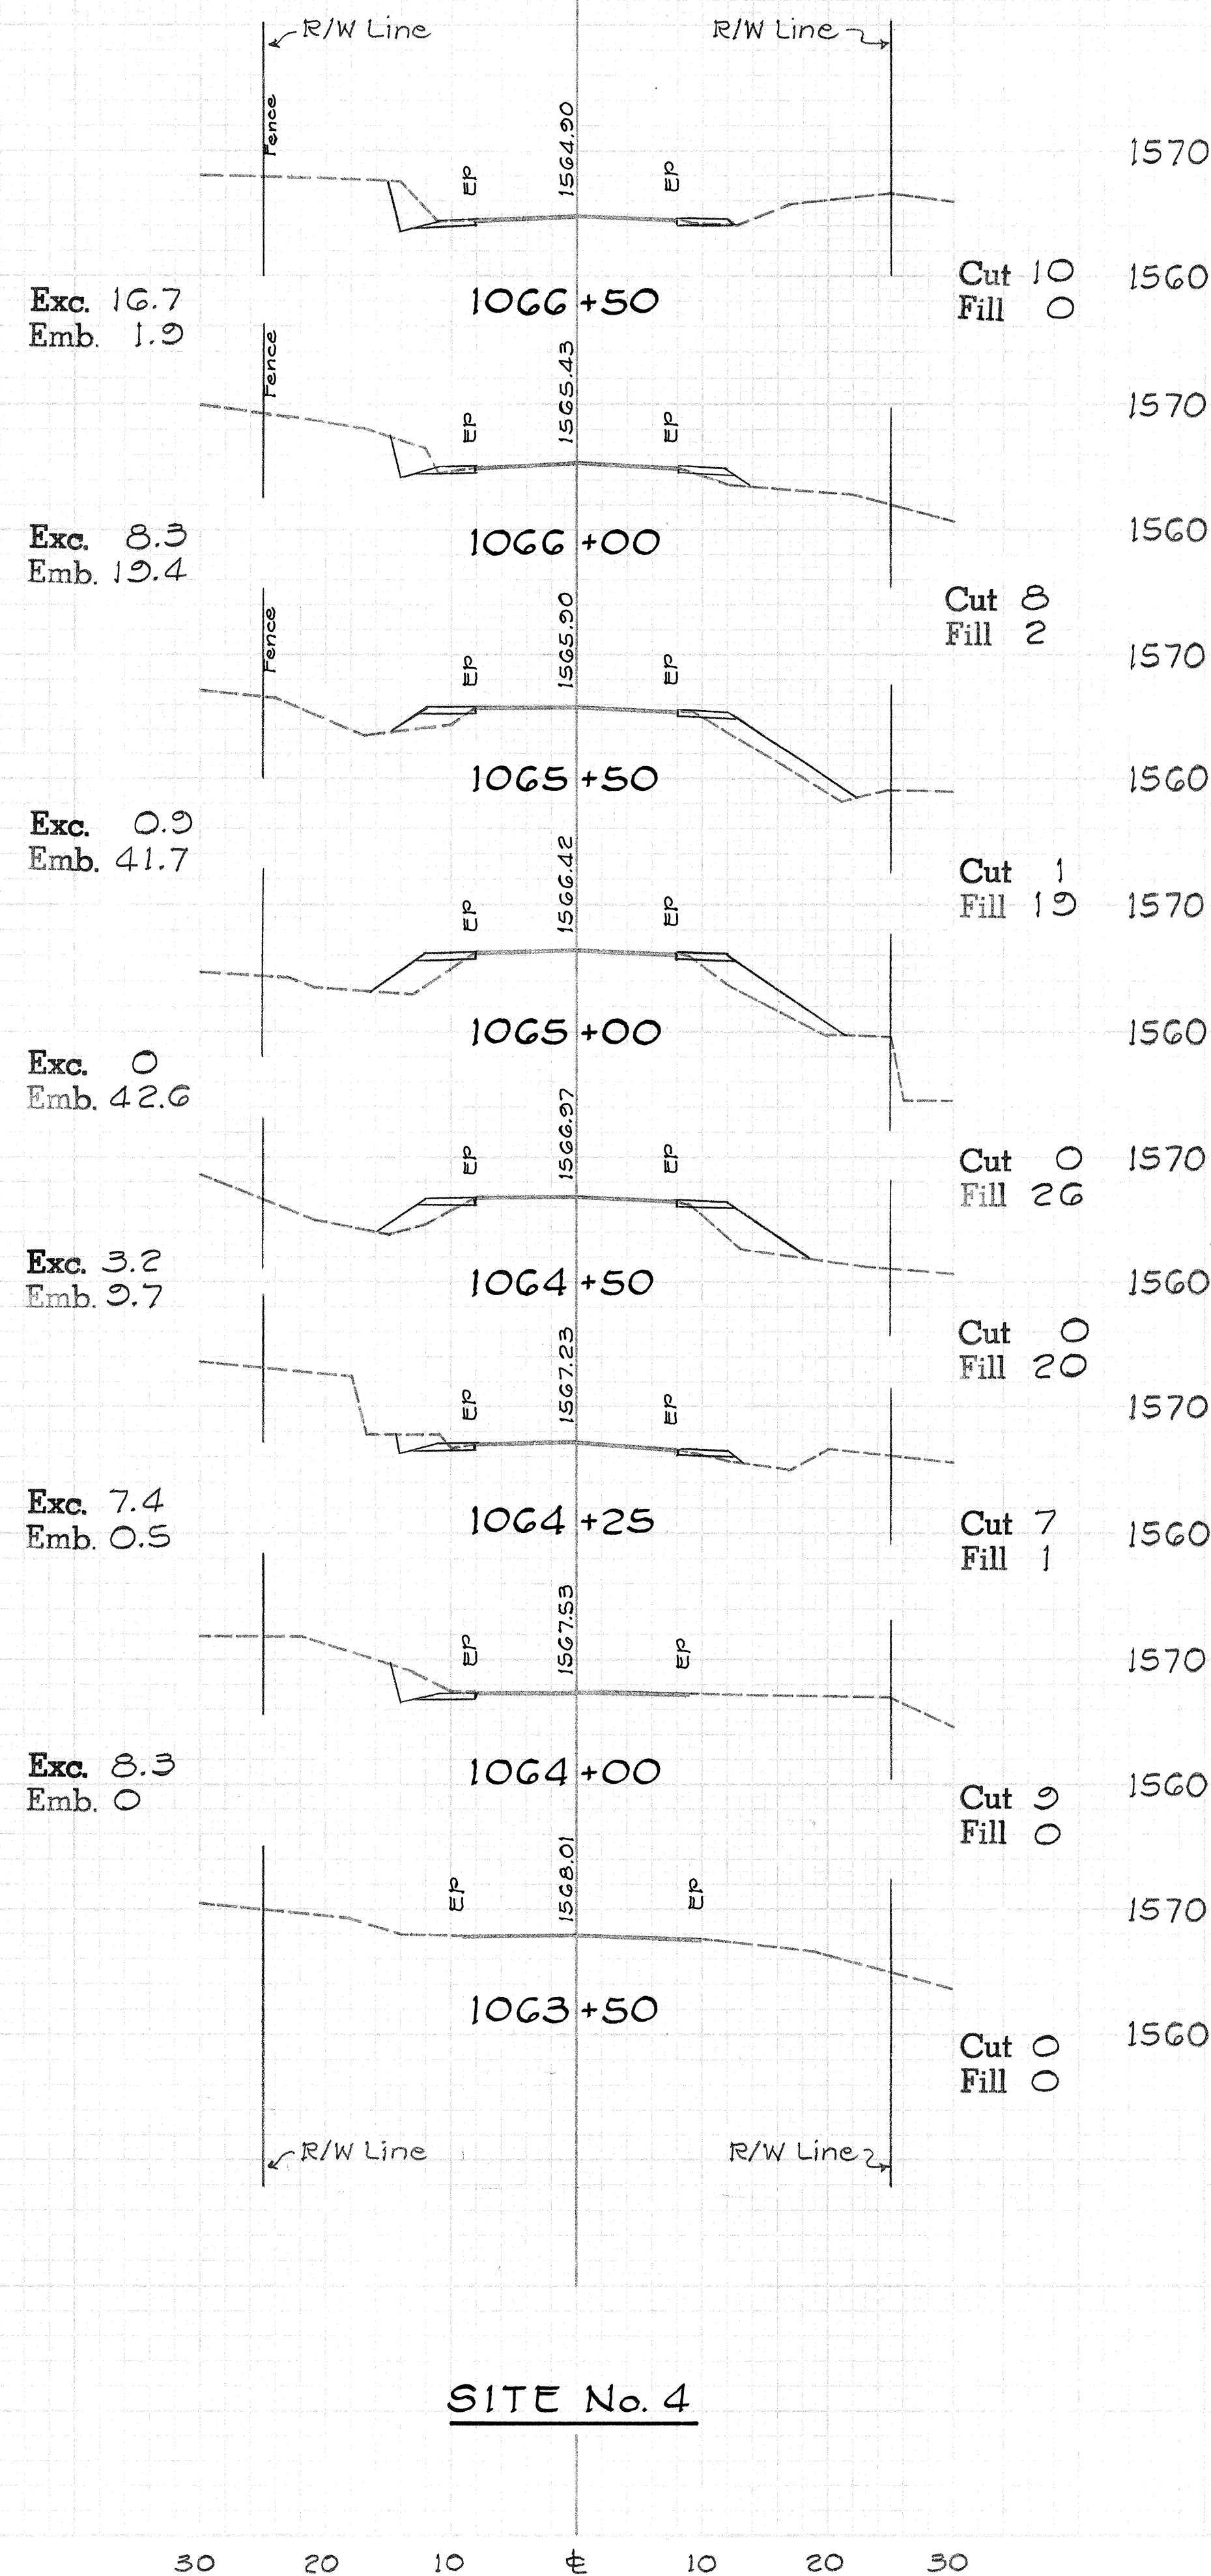

DATE	BY
FINAL SURVEY	PLOTTED
NOTE BOOK	TEMP.
NO.	AREAS CHECKED

DATE	BY
ORIGINAL SURVEY	PLOTTED
NOTE BOOK	TEMP.
NO.	AREAS CHECKED

