
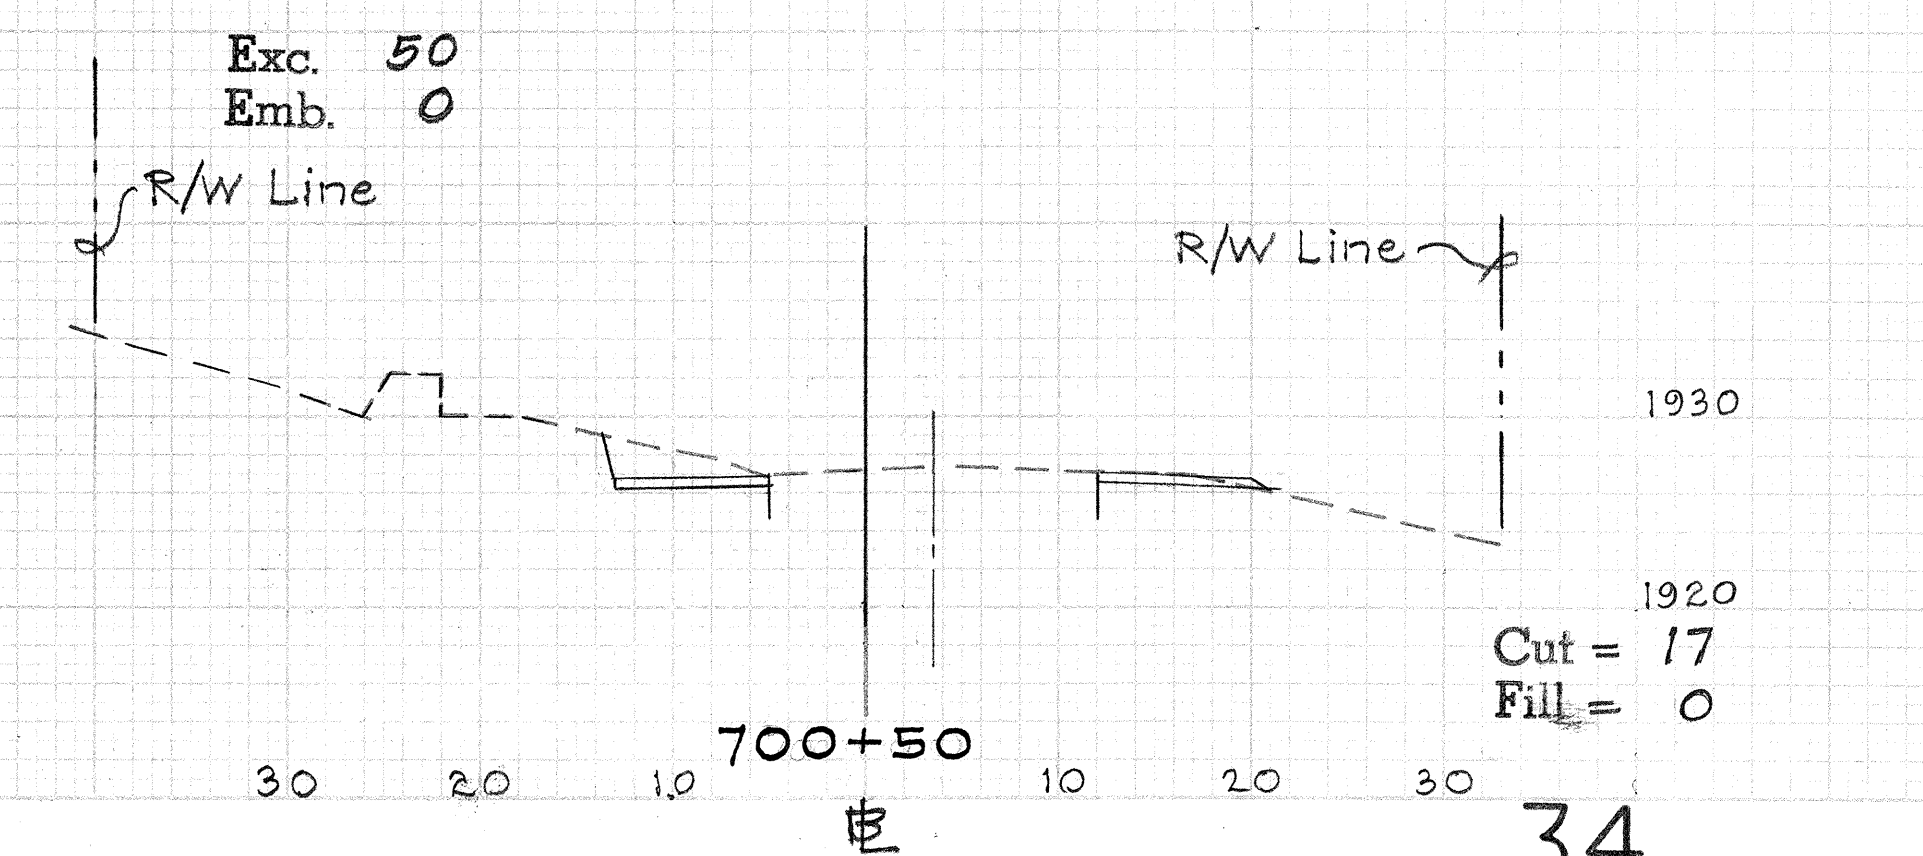
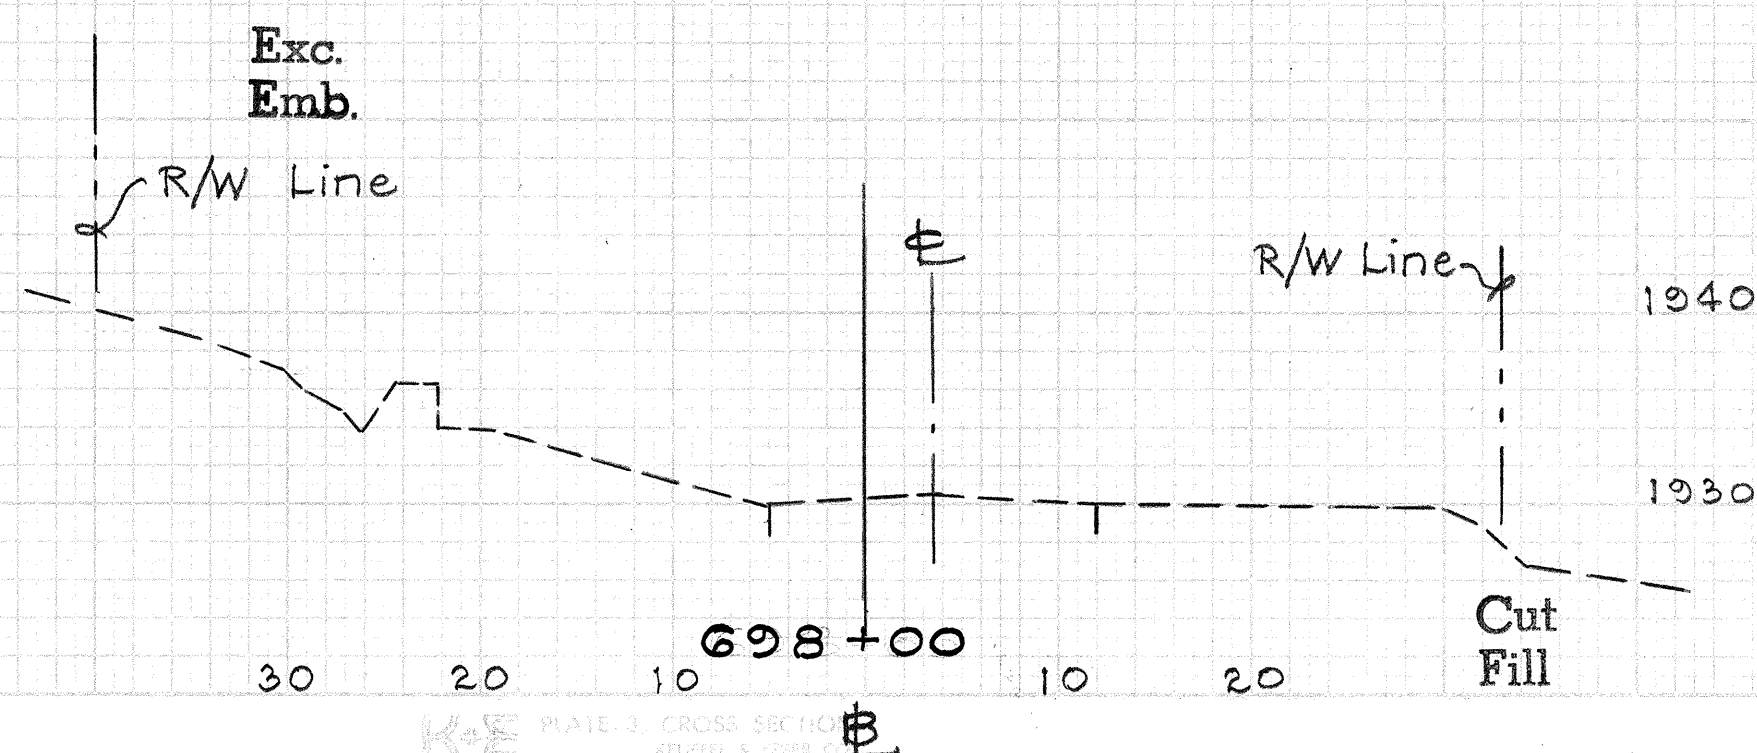
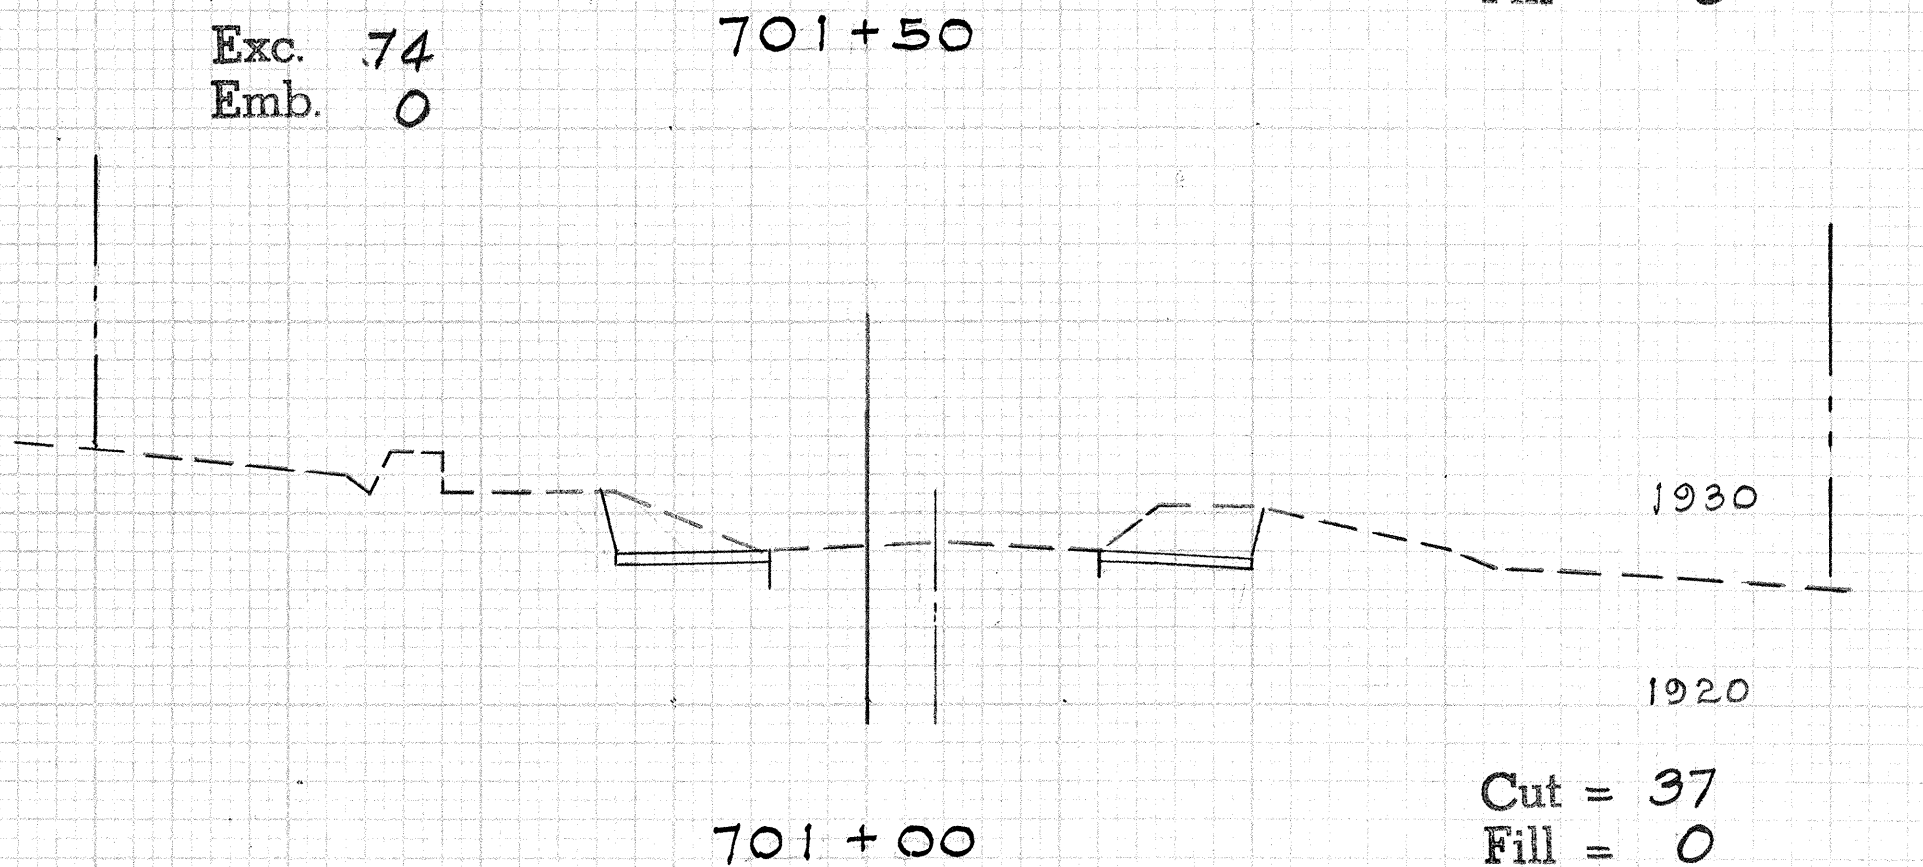
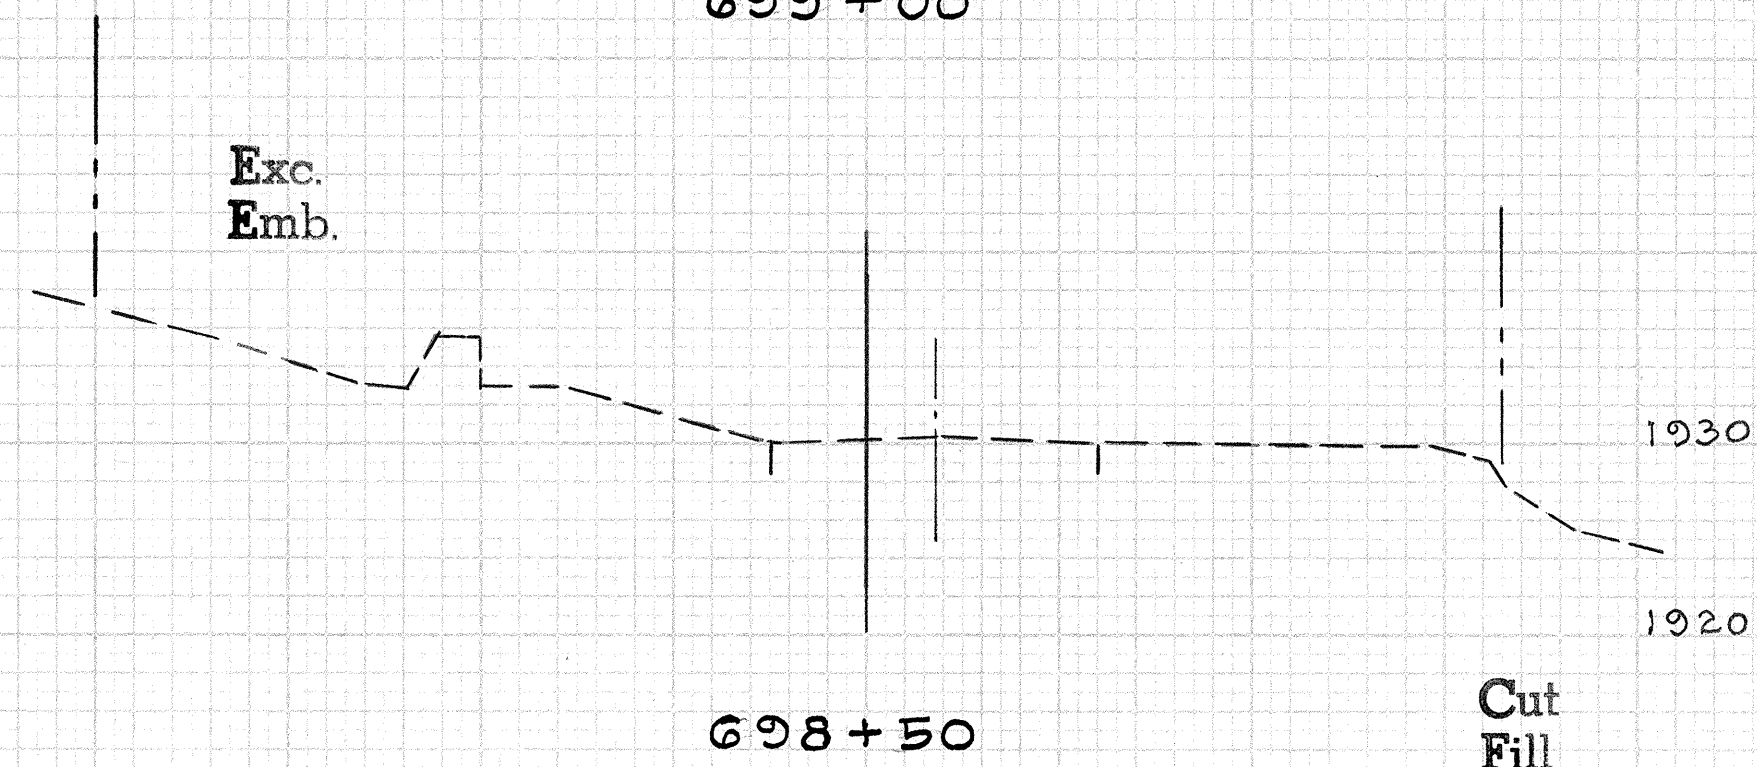
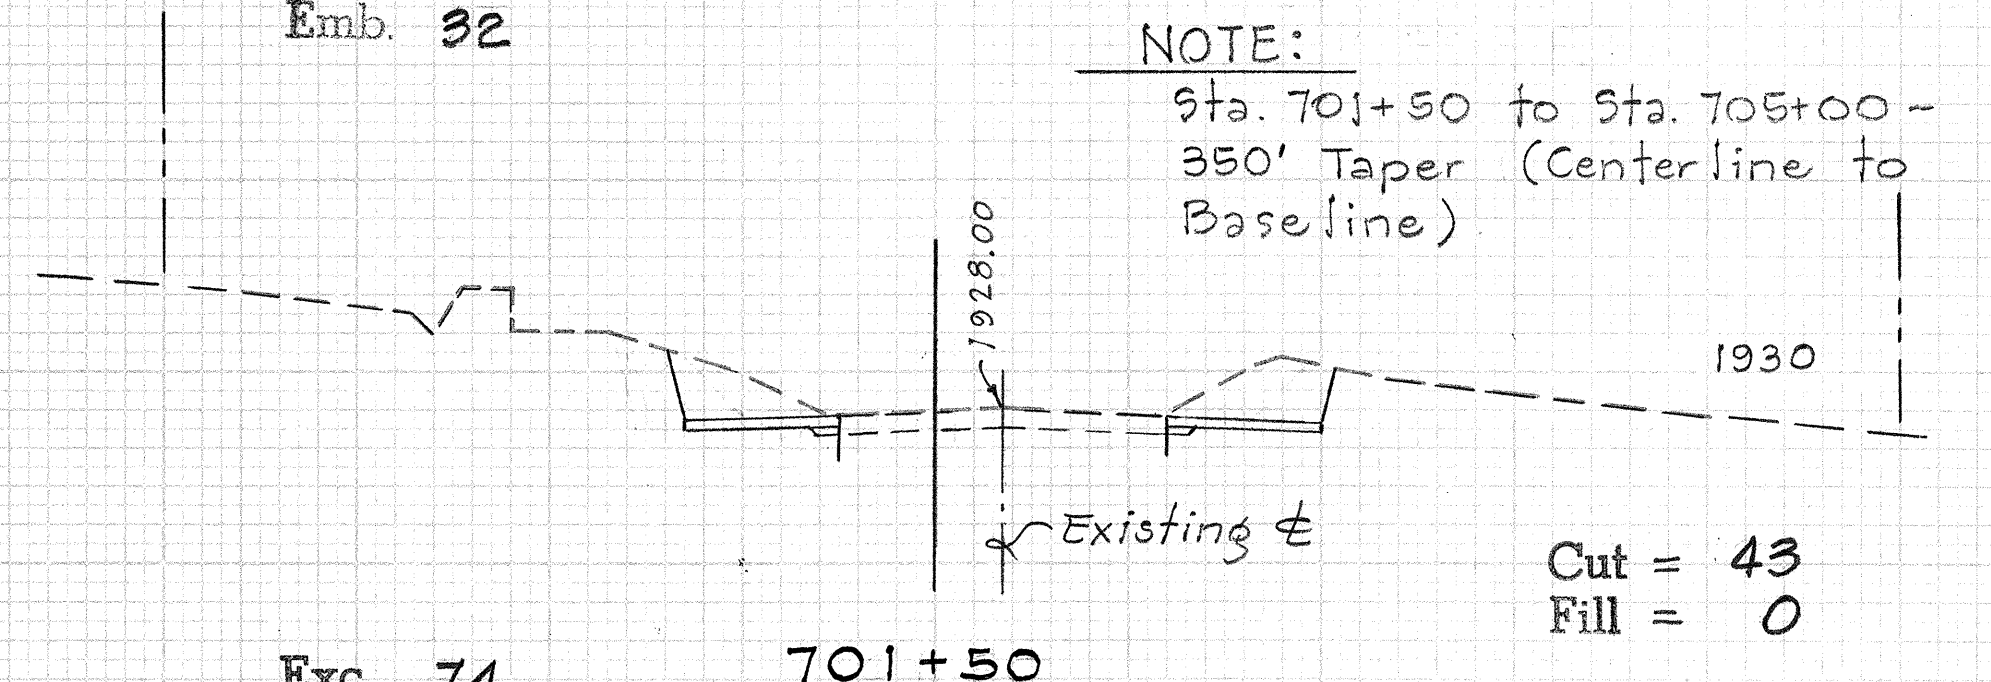
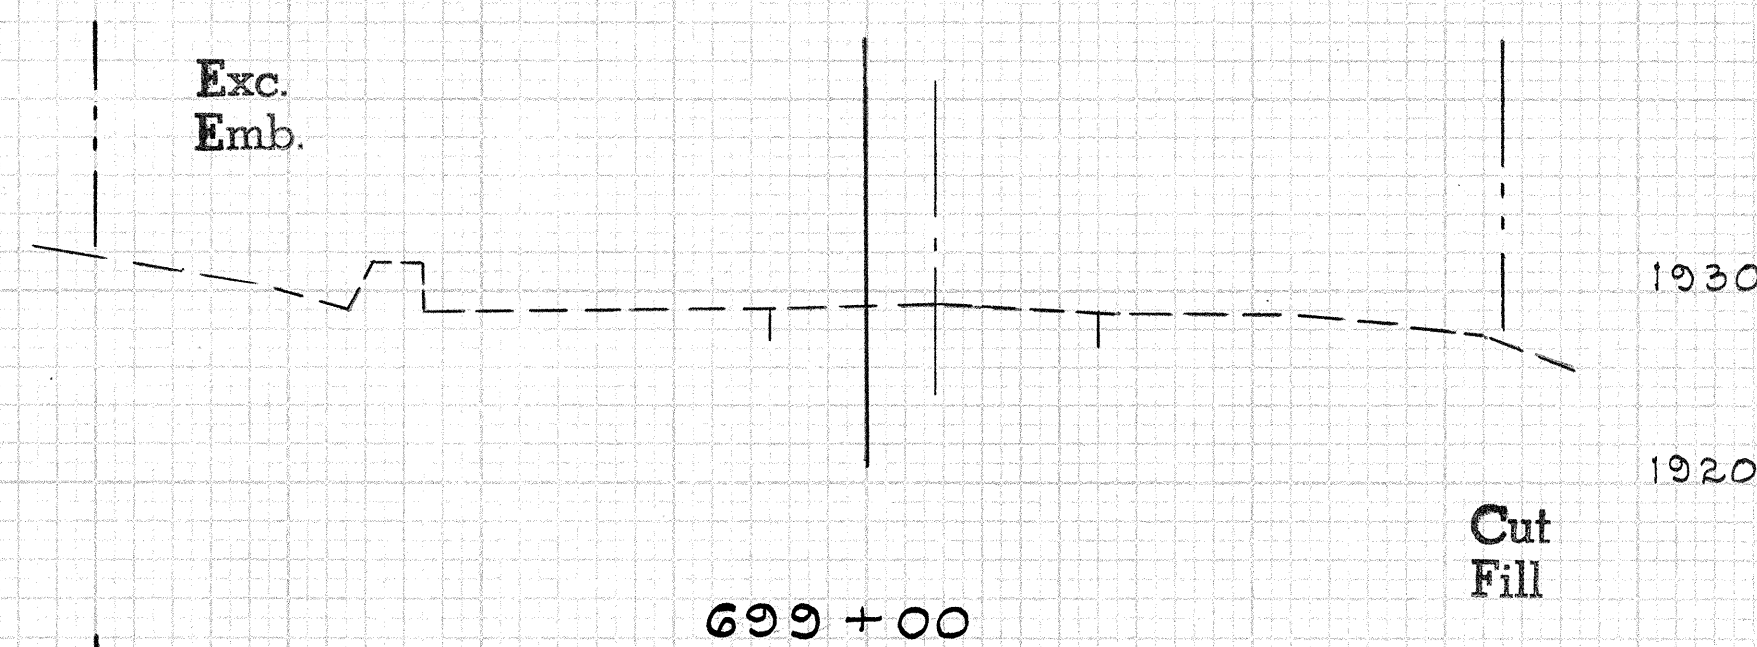
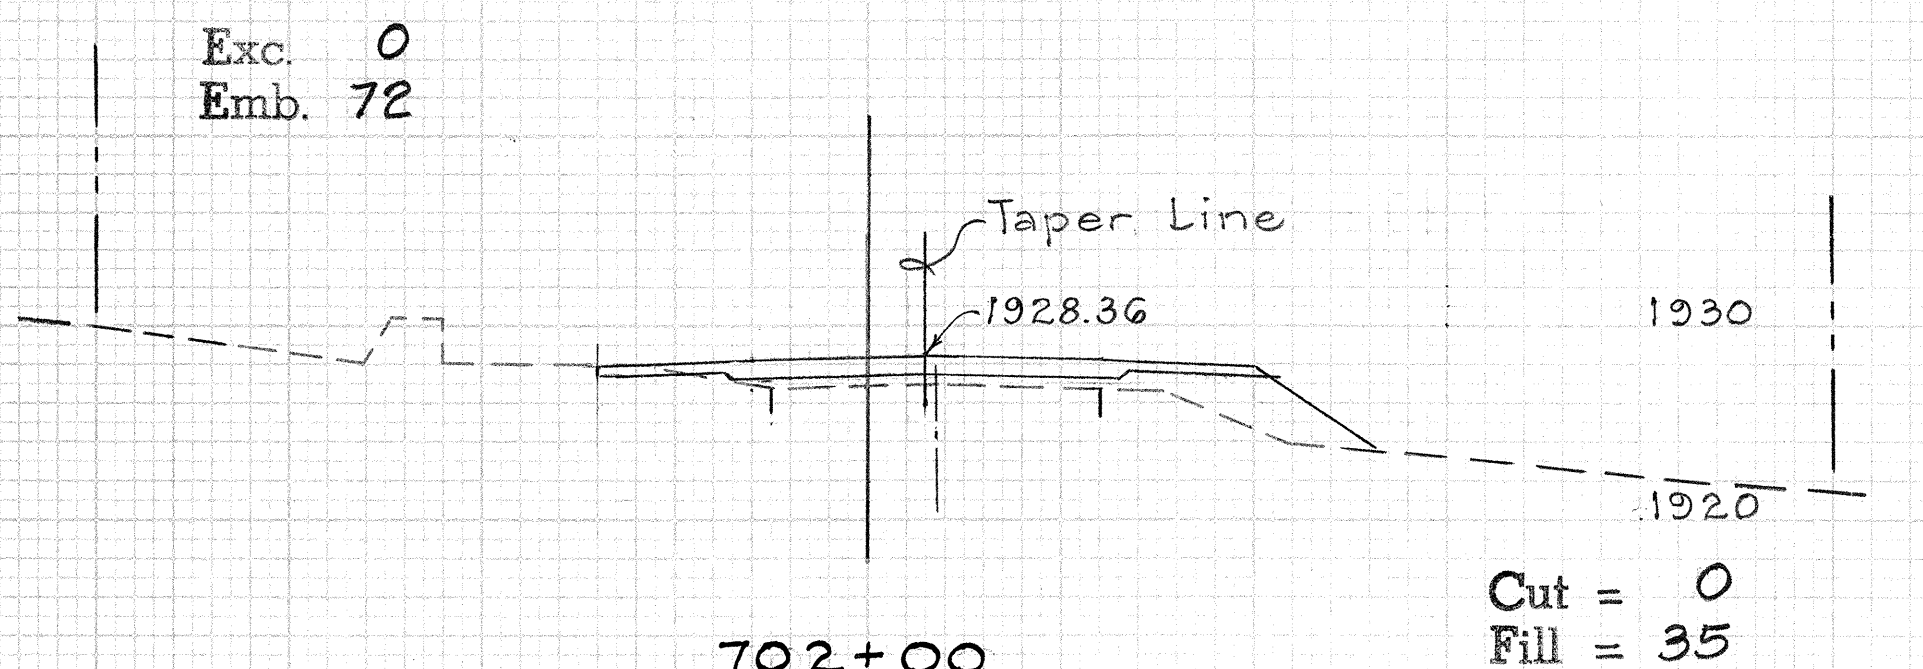
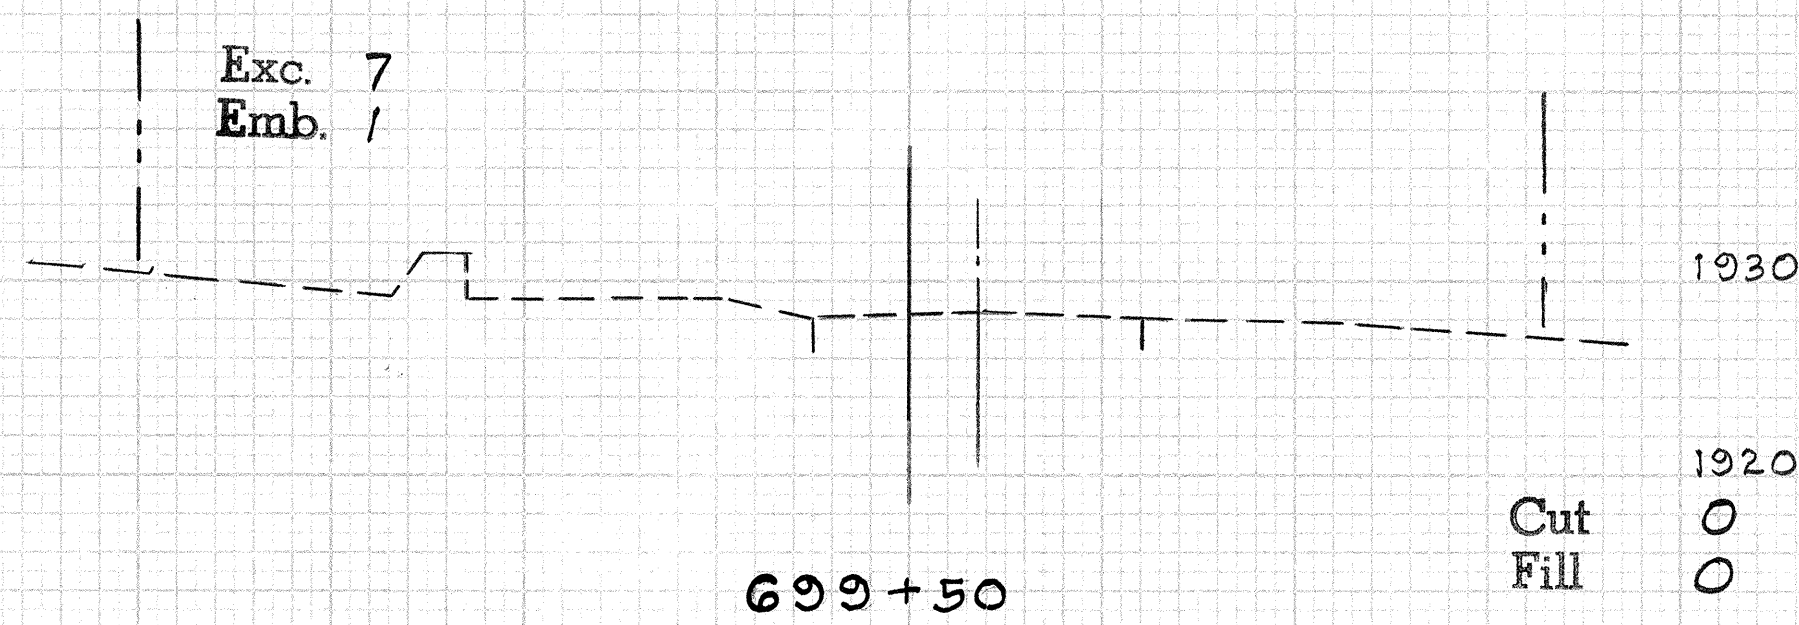
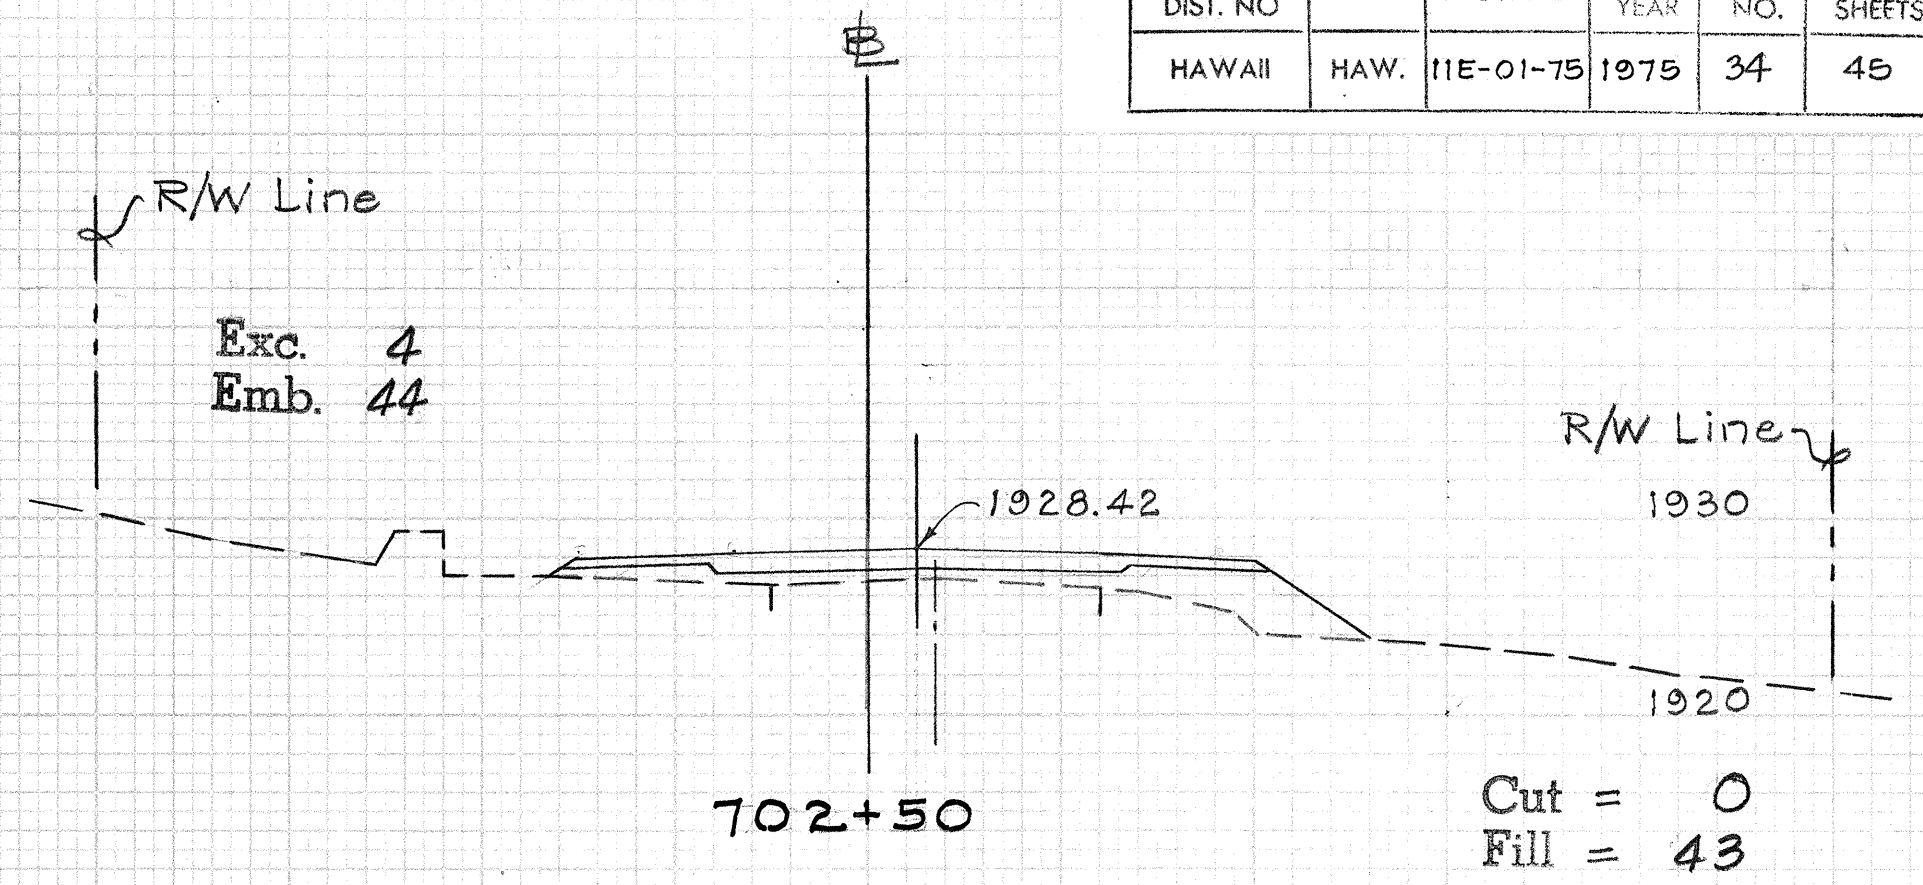



FED. ROAD DIST. NO.	STATE	PROJ. NO.	FISCAL YEAR	SHEET NO.	TOTAL SHEETS
HAWAII	HAW.	11E-01-75	1975	34	45

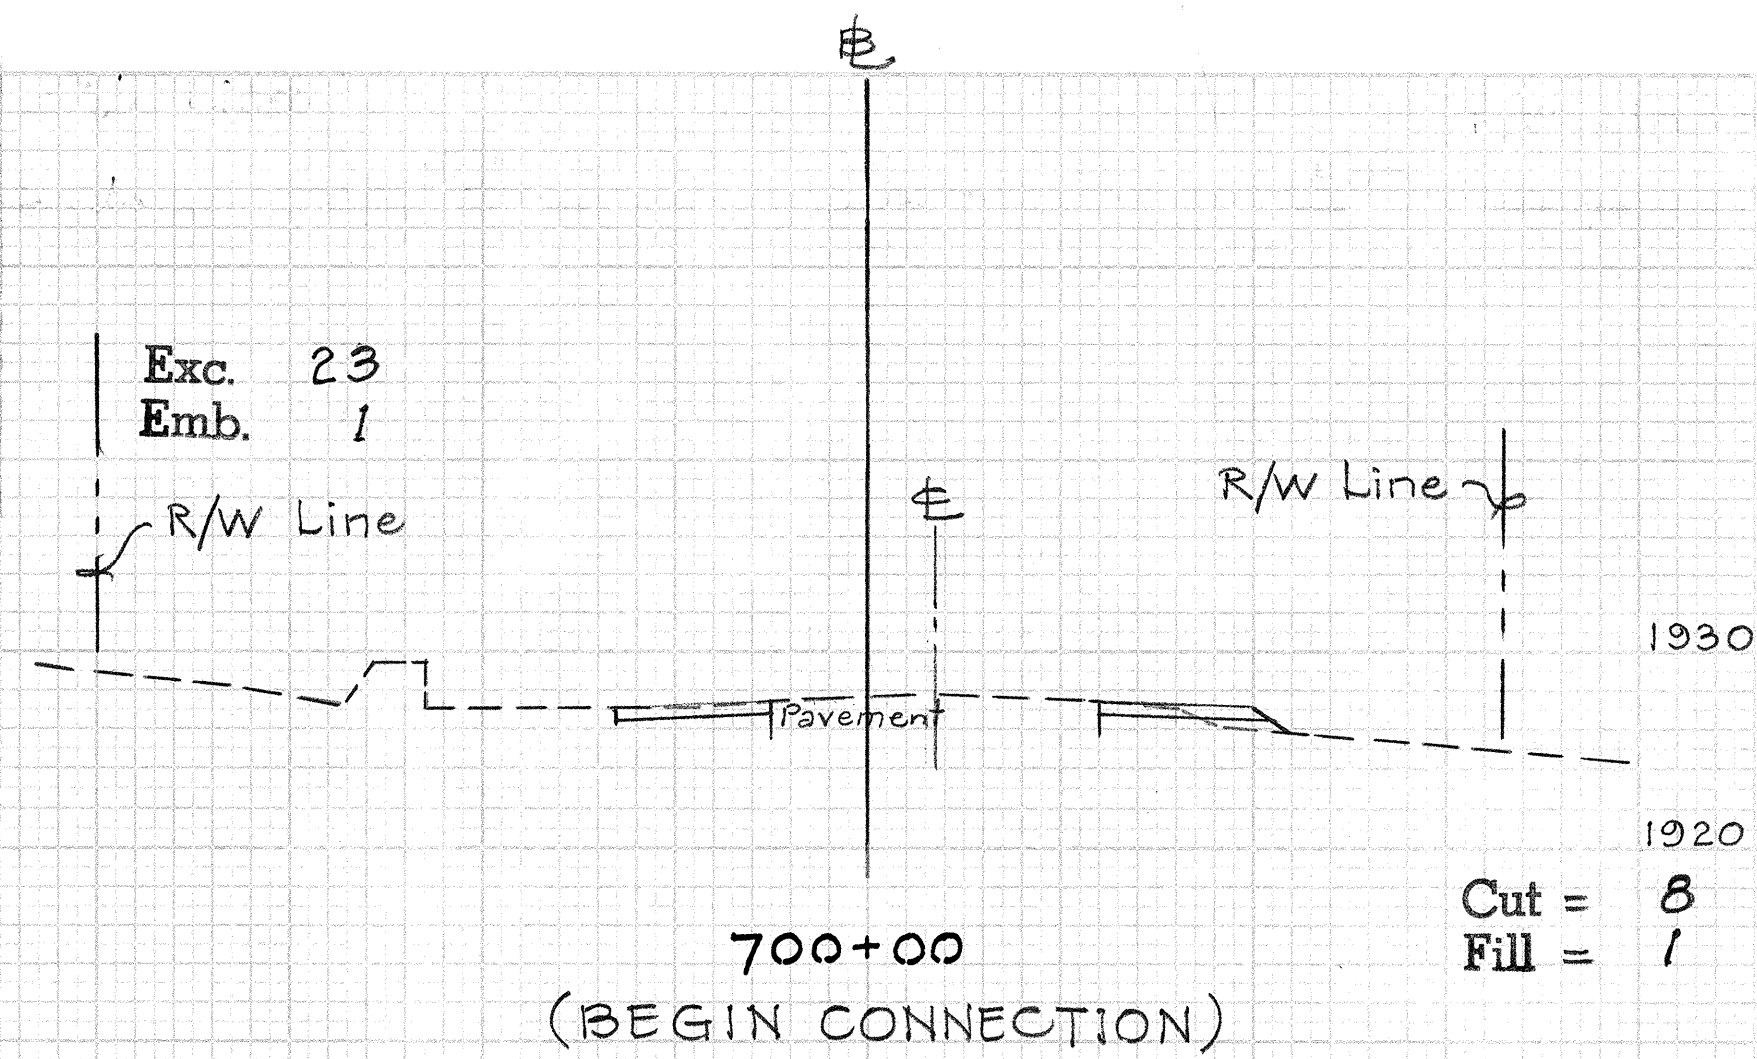

FED. ROAD DIST. NO.	STATE	PROJ. NO.	FISCAL YEAR	SHEET NO.	TOTAL SHEETS
HAWAII	HAW.	11E-01-75	1975	35	45

DATE	BY	FINAL SURVEY	PLOTTED	NOTE BOOK	TEMPLATE	AREAS CHECKED


DATE	BY	ORIGINAL SURVEY	PLOTTED	NOTE BOOK	TEMPLATE	AREAS CHECKED

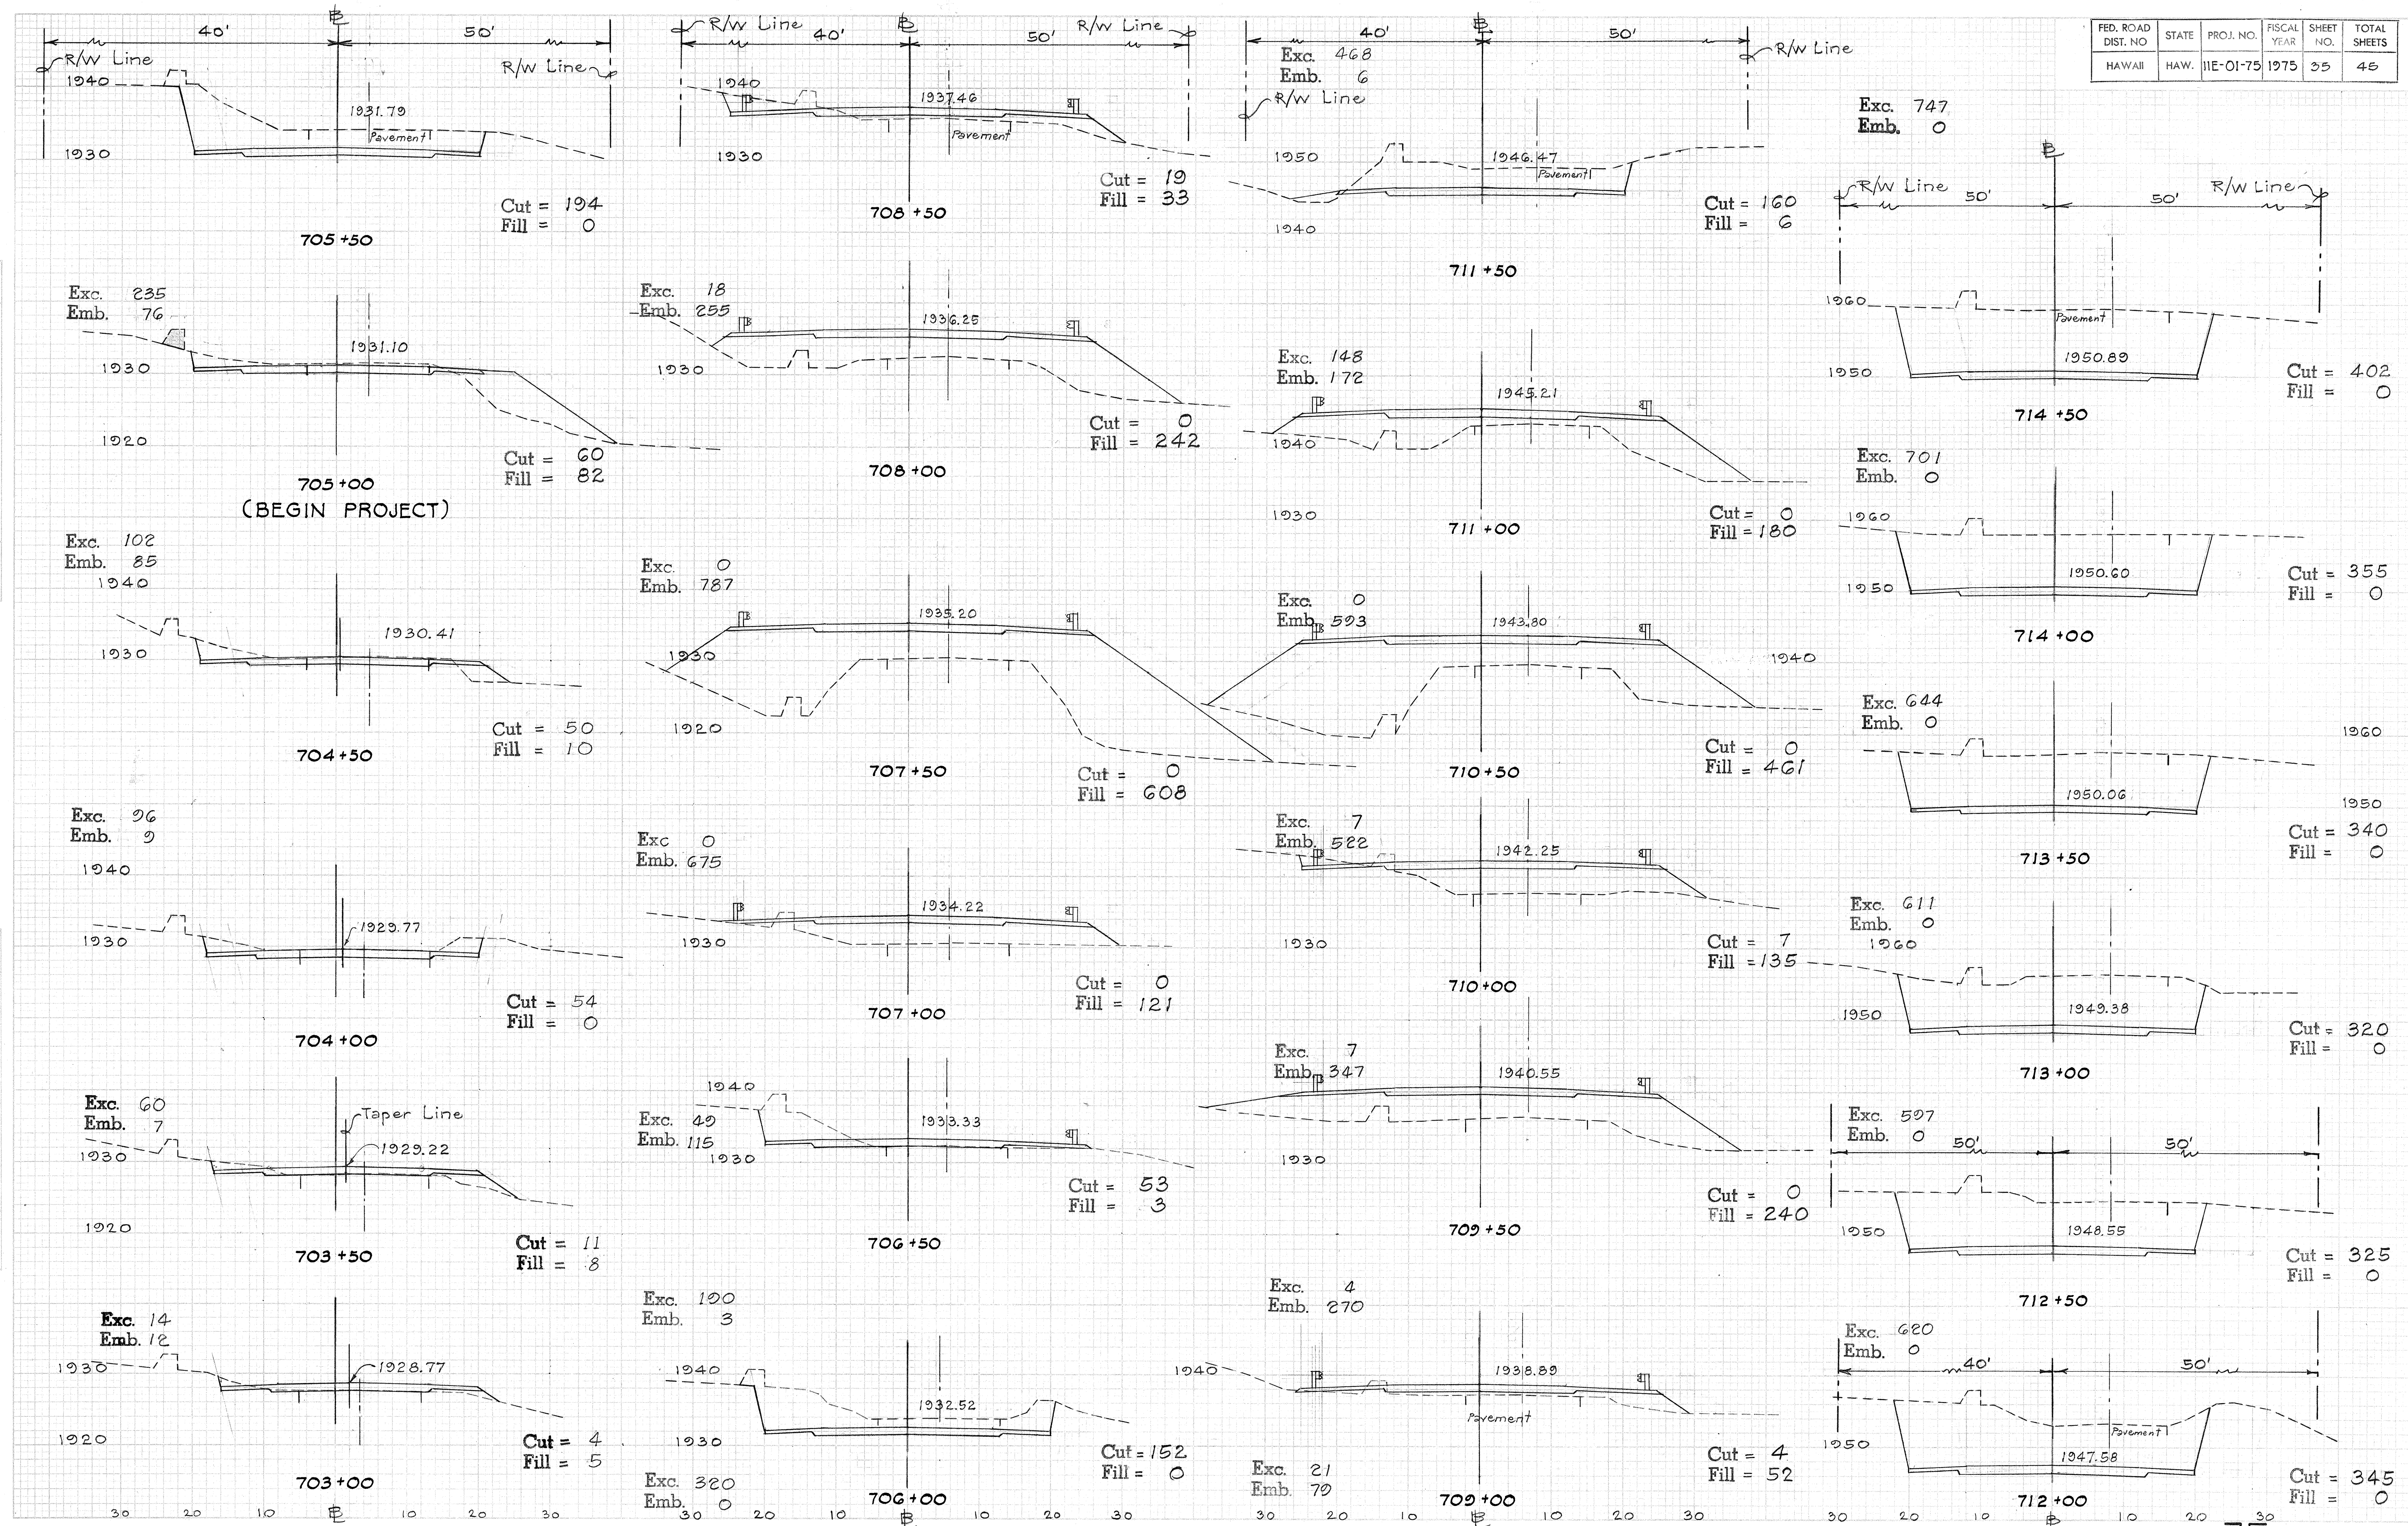

FED. ROAD DIST. NO.	STATE	PROJ. NO.	FISCAL YEAR	SHEET NO.	TOTAL SHEETS
HAWAII	HAW.	11E-01-75	1975	36	45

DATE	BY	SCALE

DATE	BY	SCALE

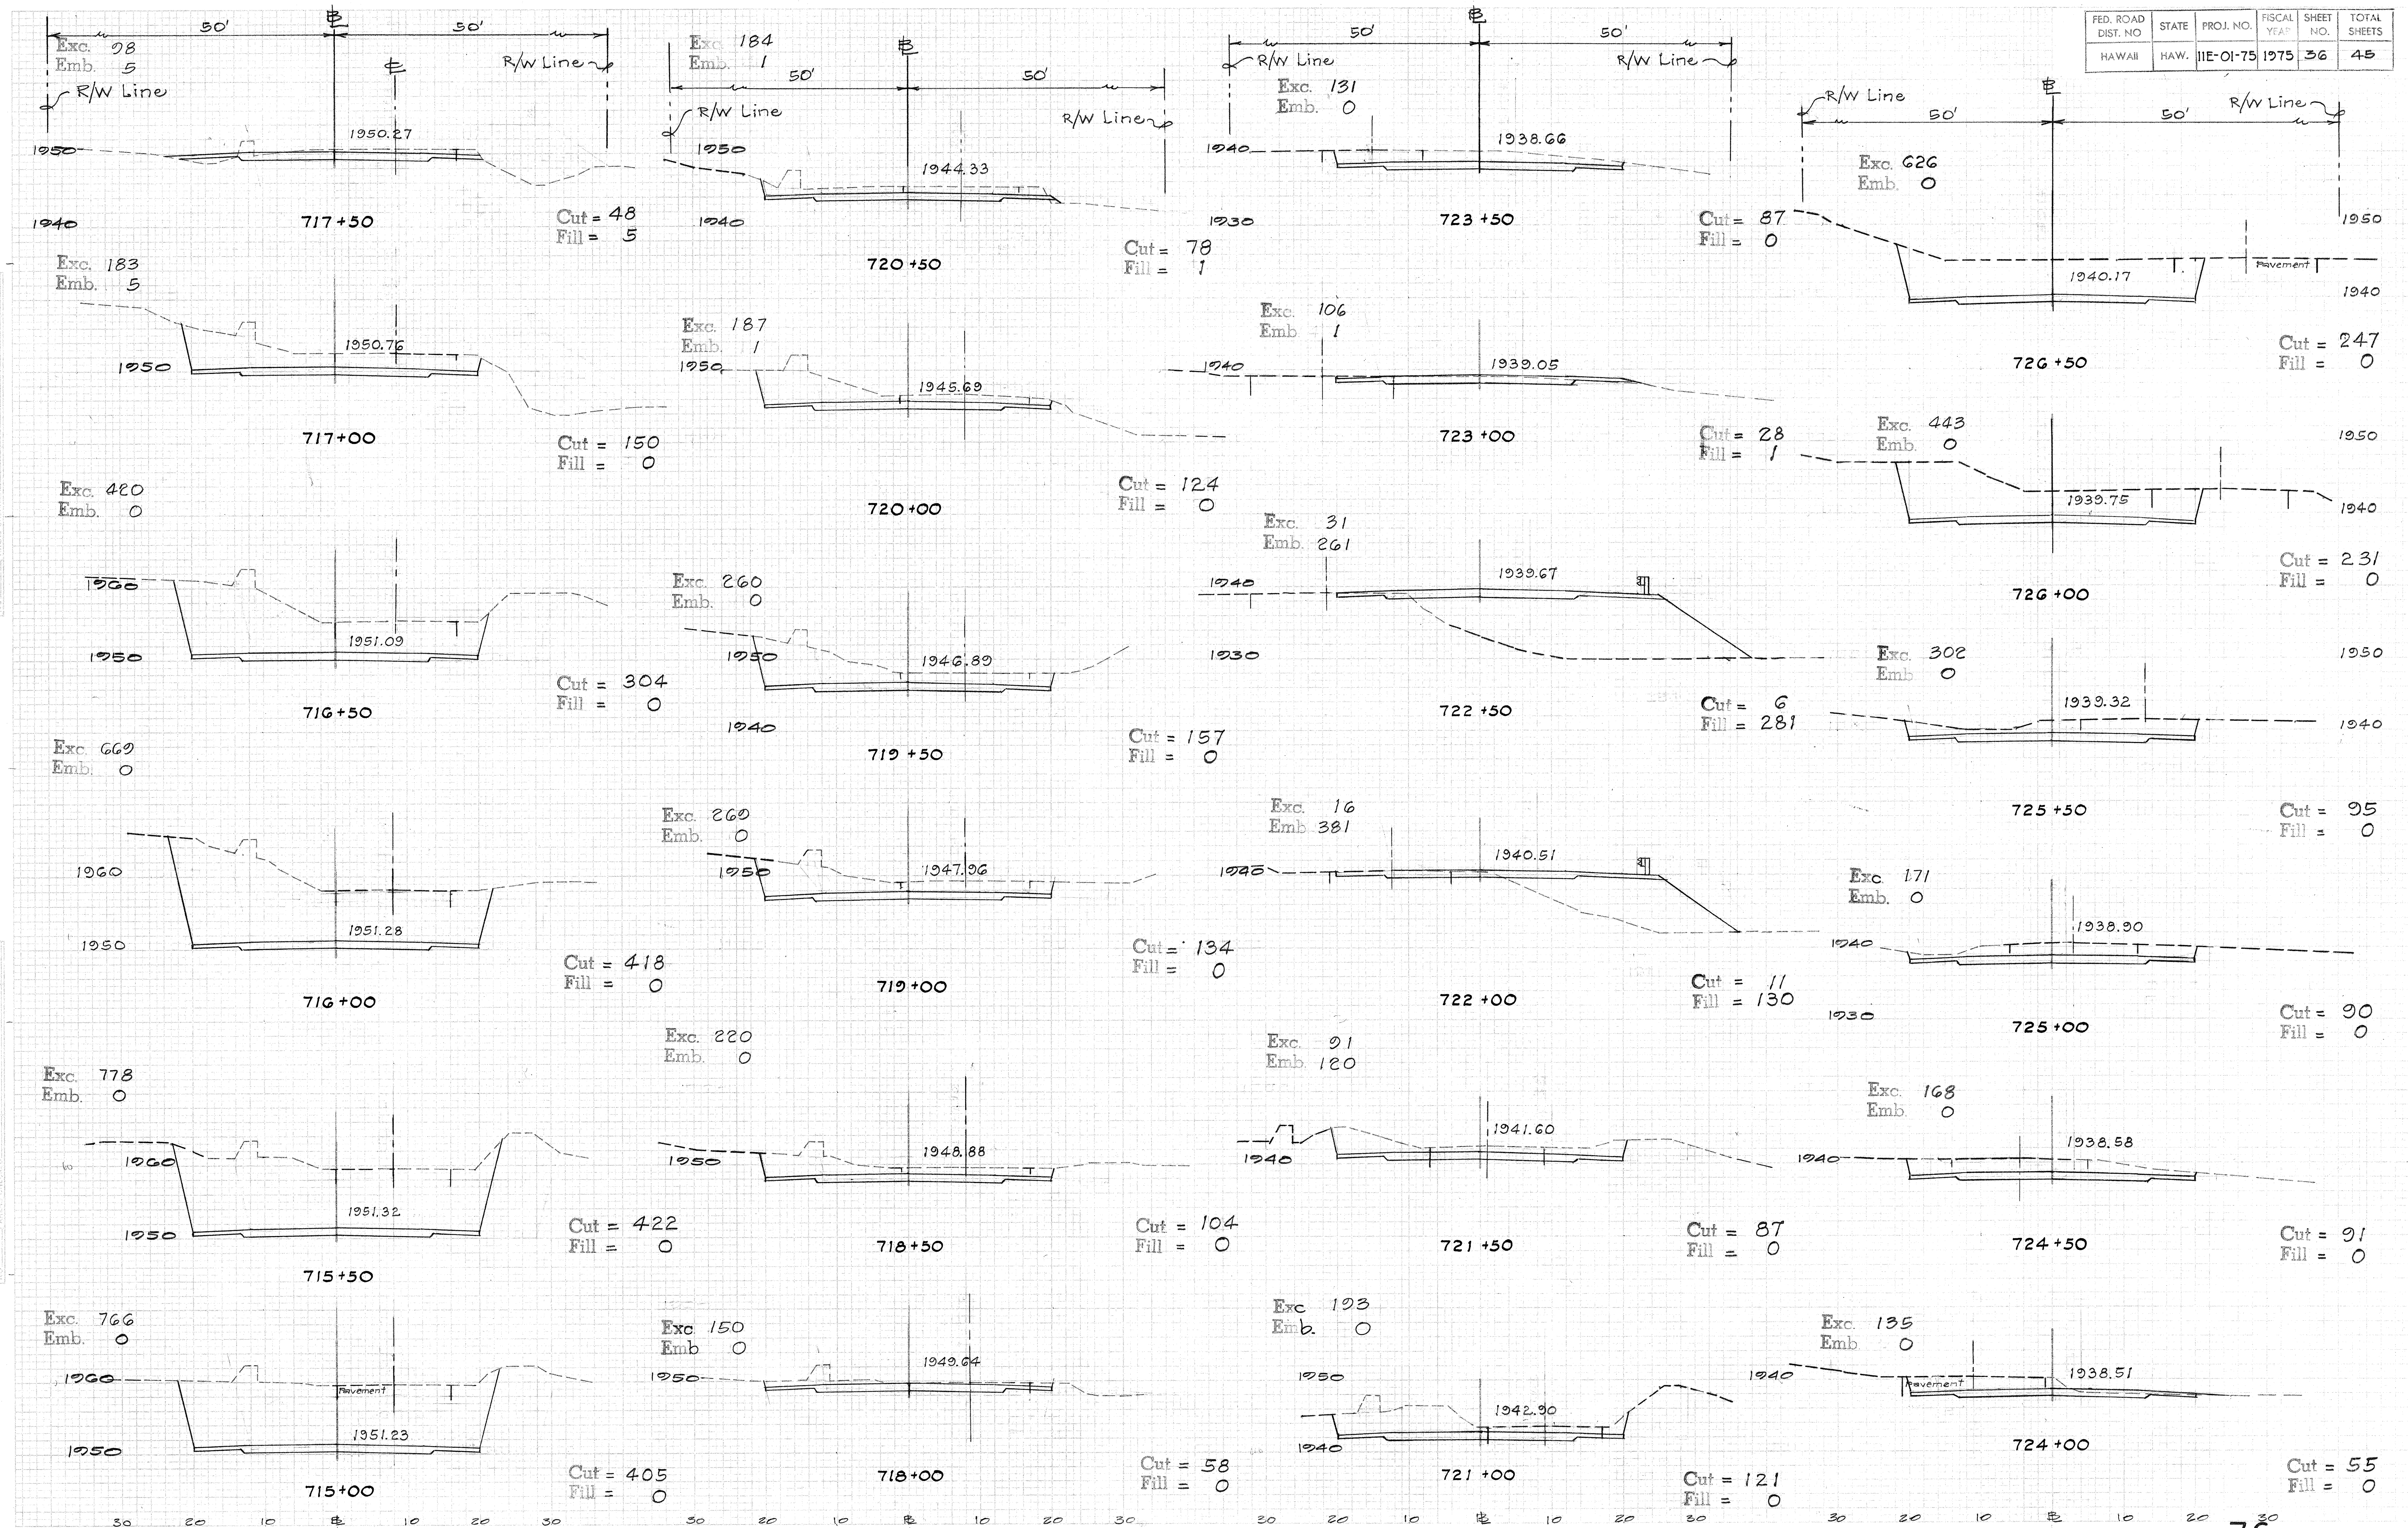

FED. ROAD DIST. NO.	STATE	PROJ. NO.	FISCAL YEAR	SHEET NO.	TOTAL SHEETS
HAWAII	HAW.	11E-01-75	1975	37	49

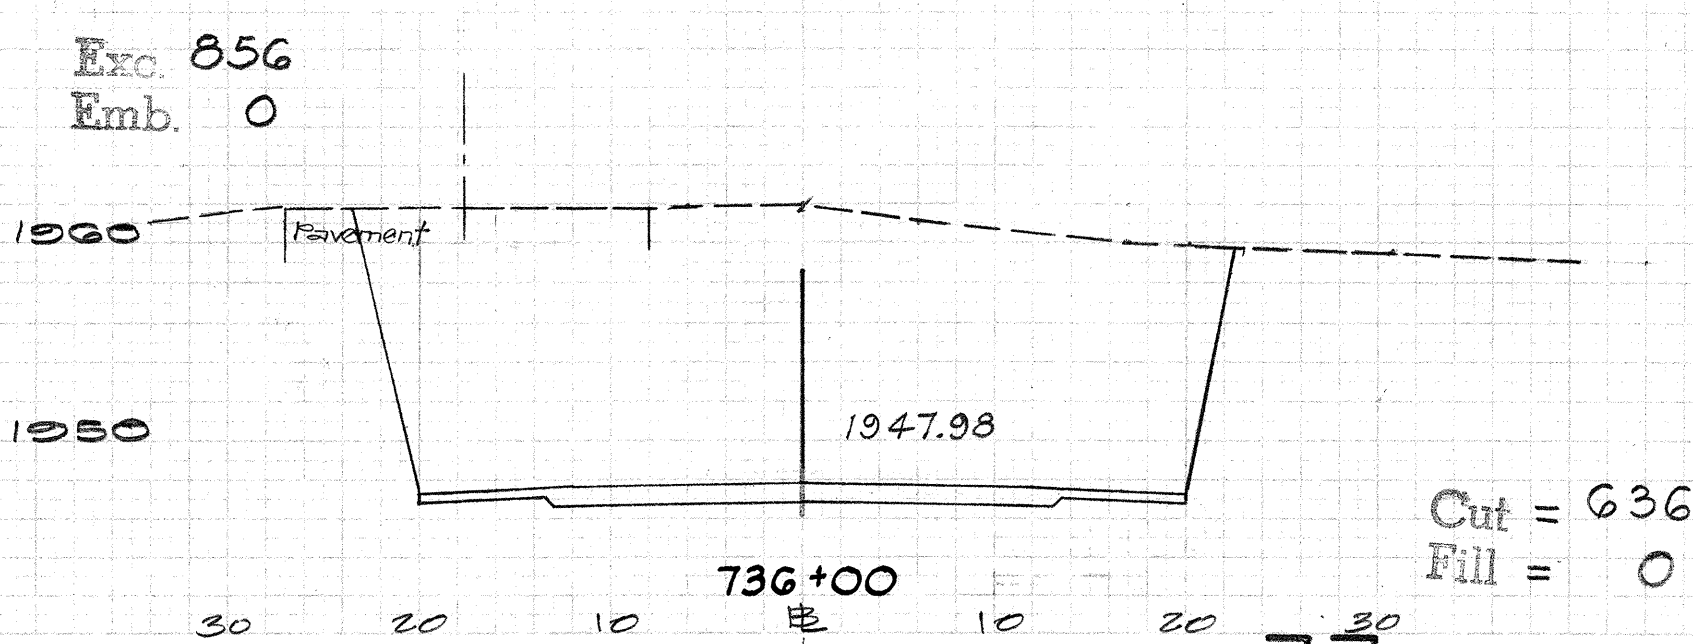
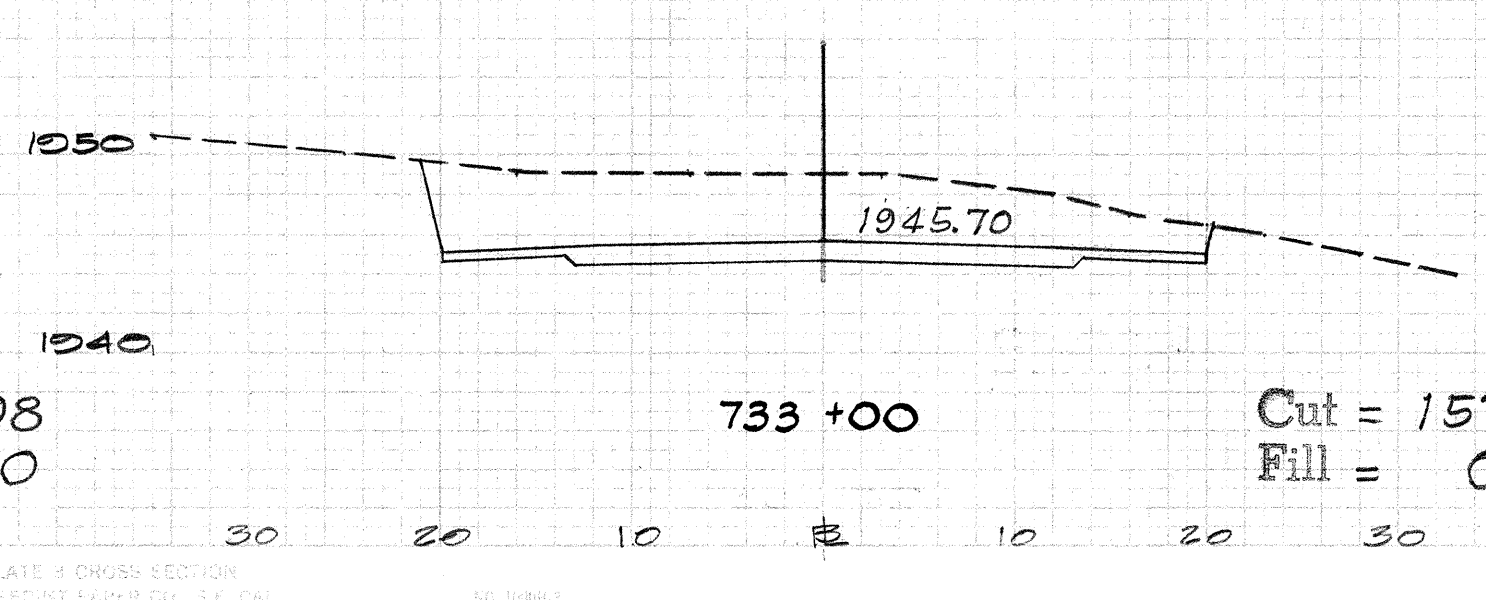
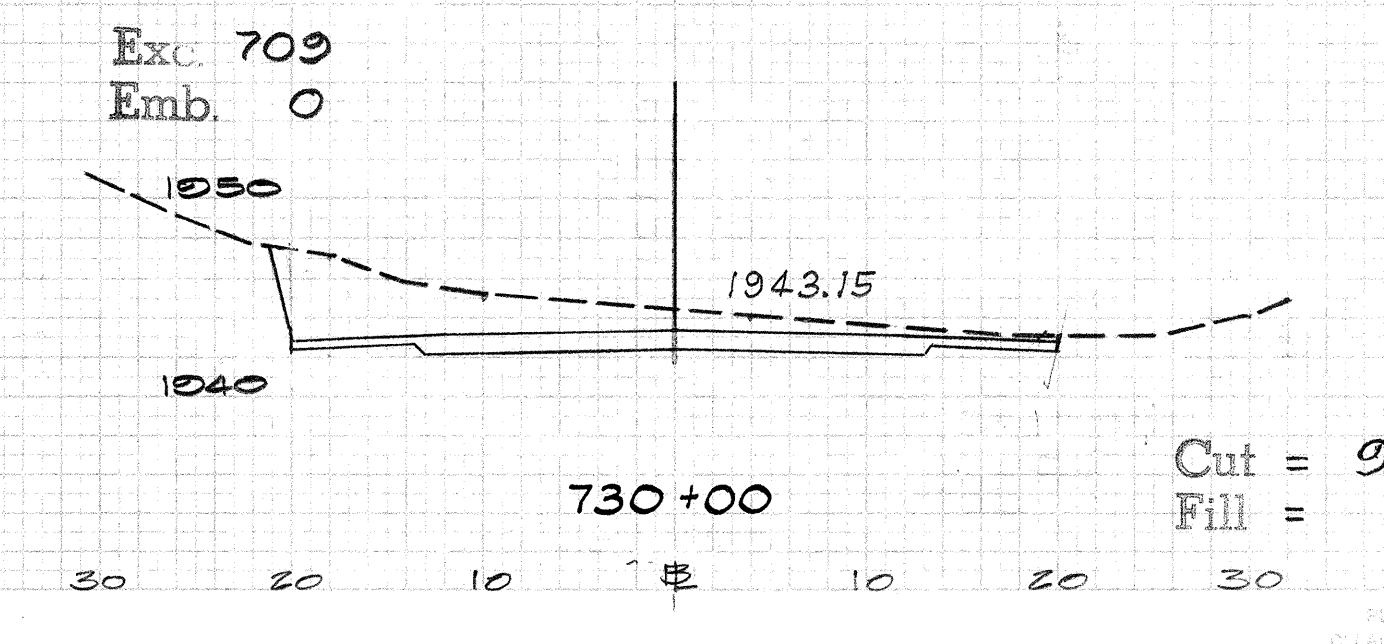
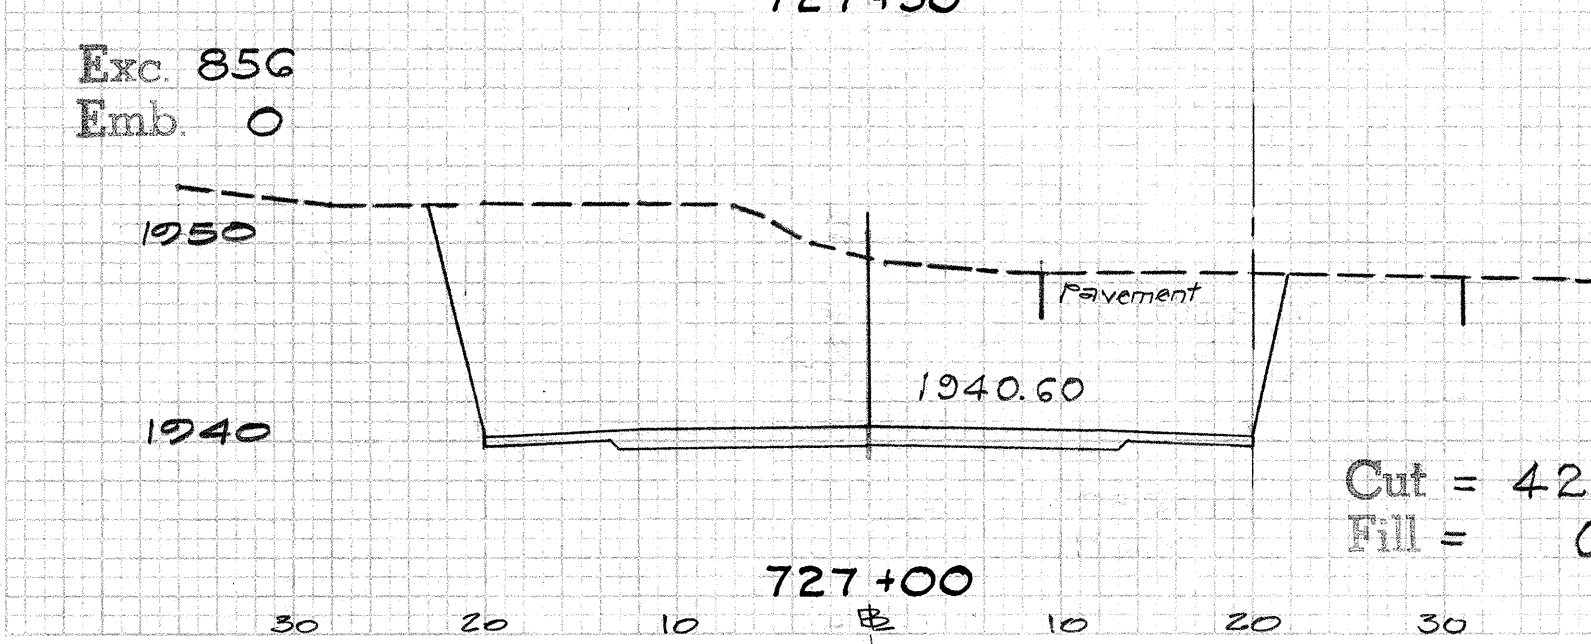
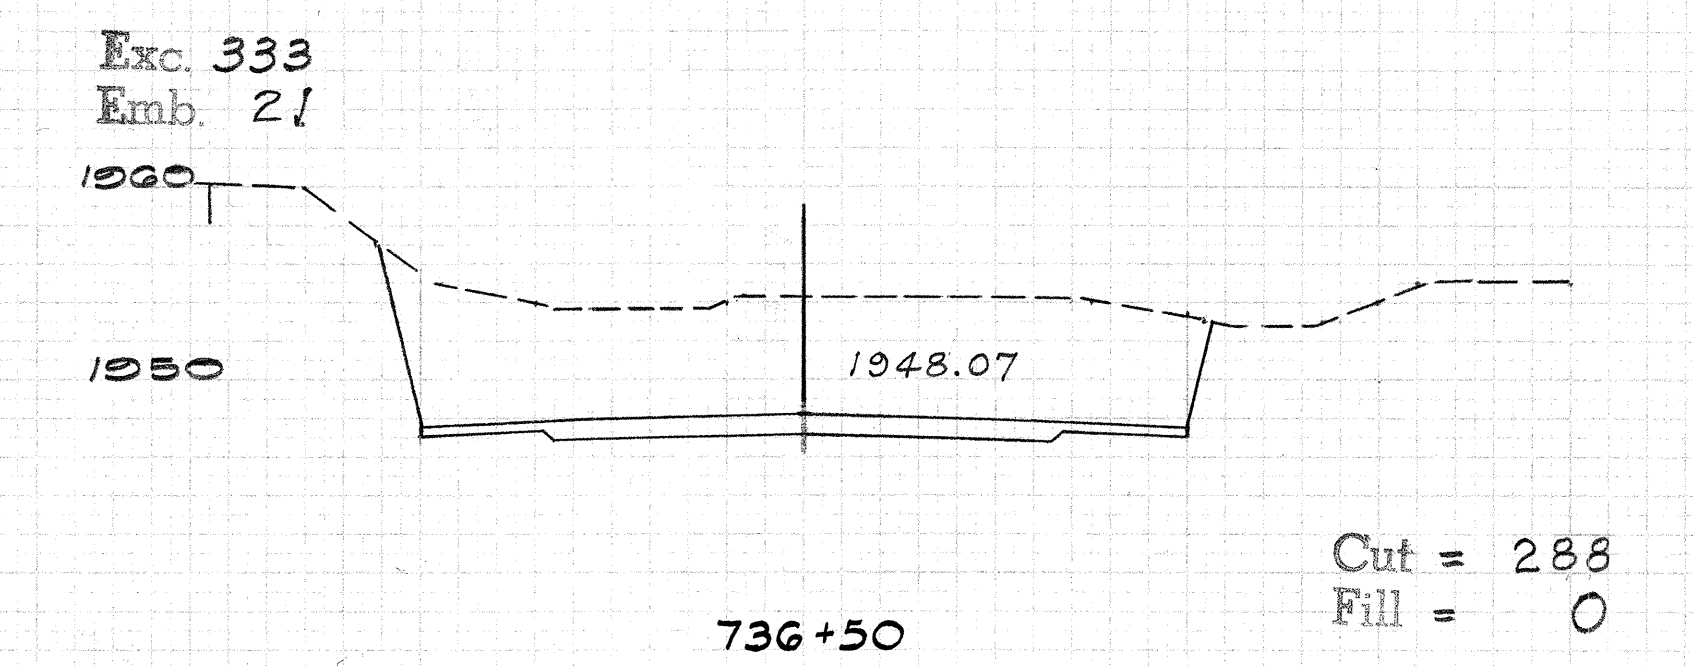
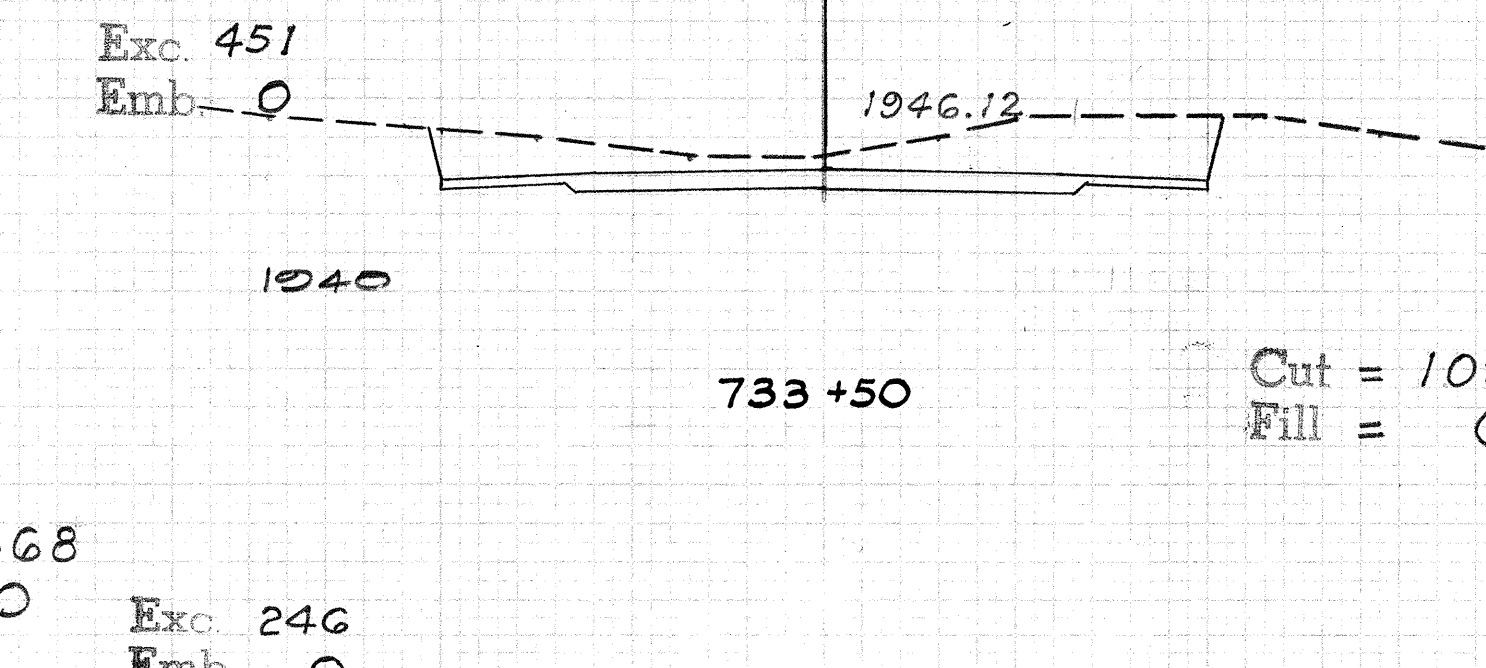
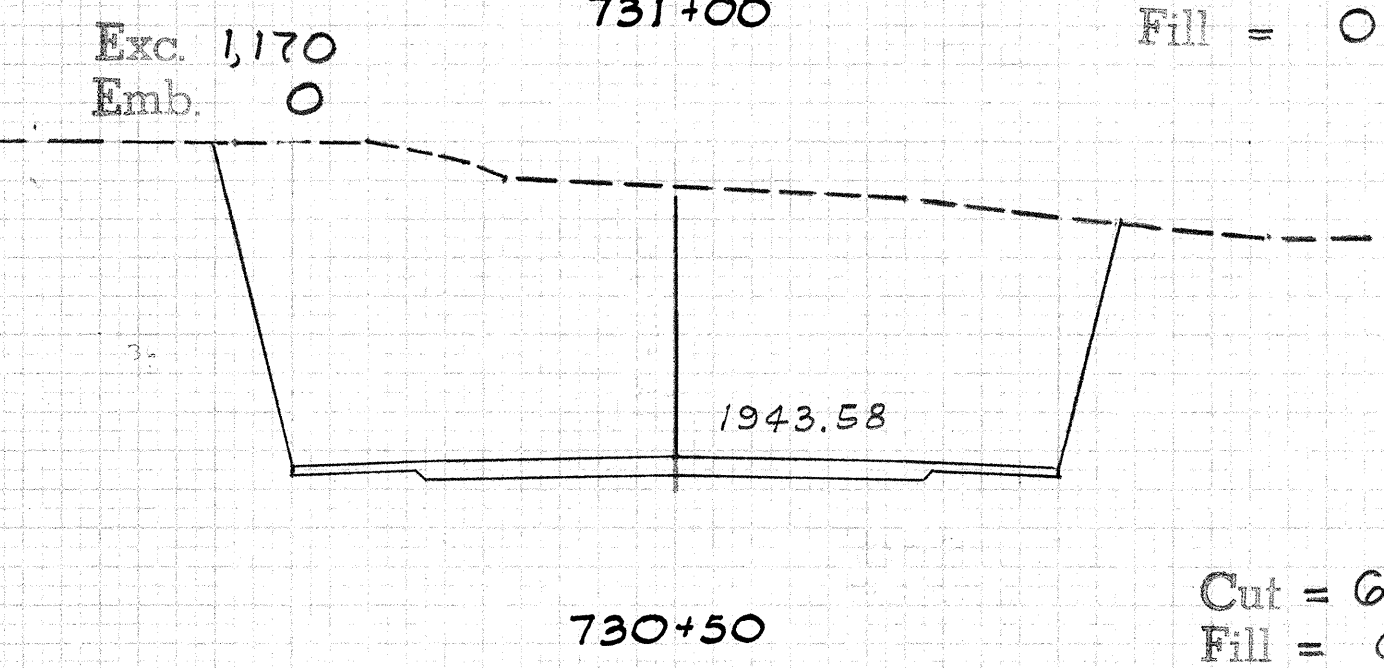
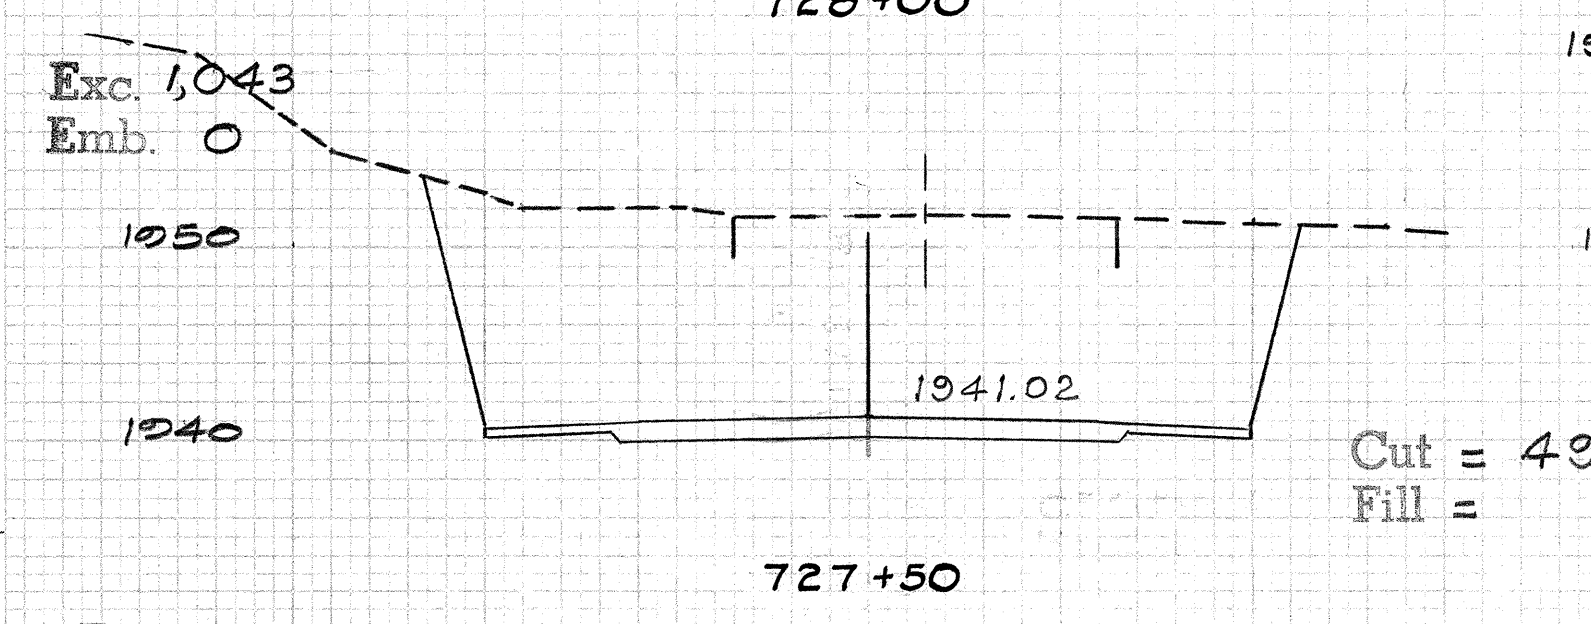
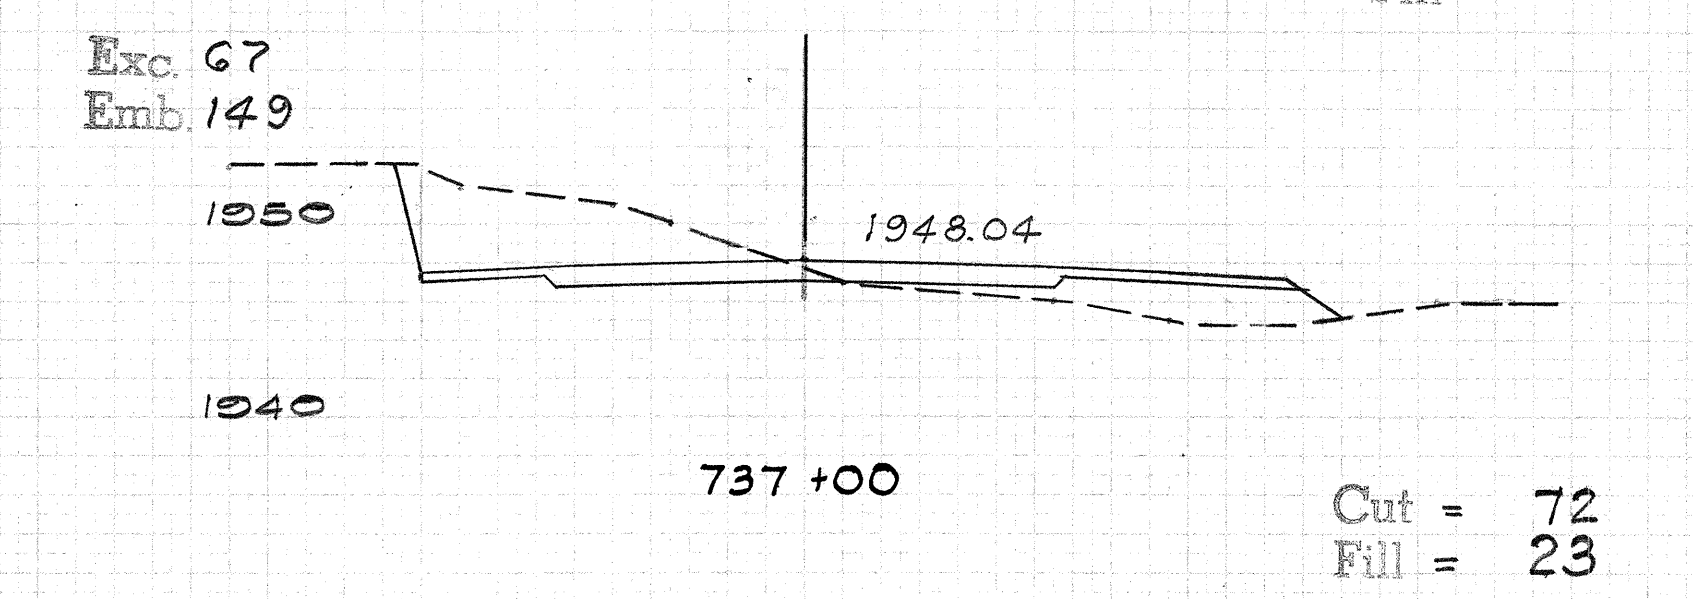
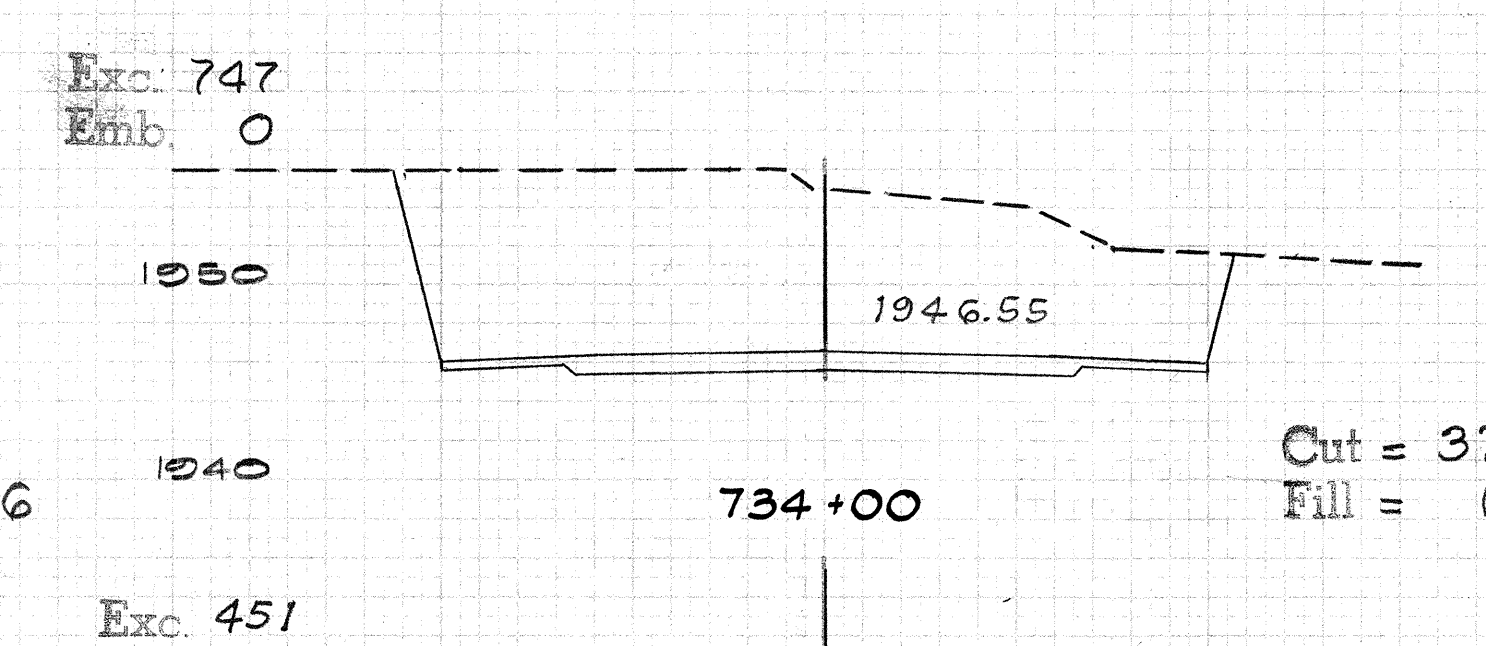
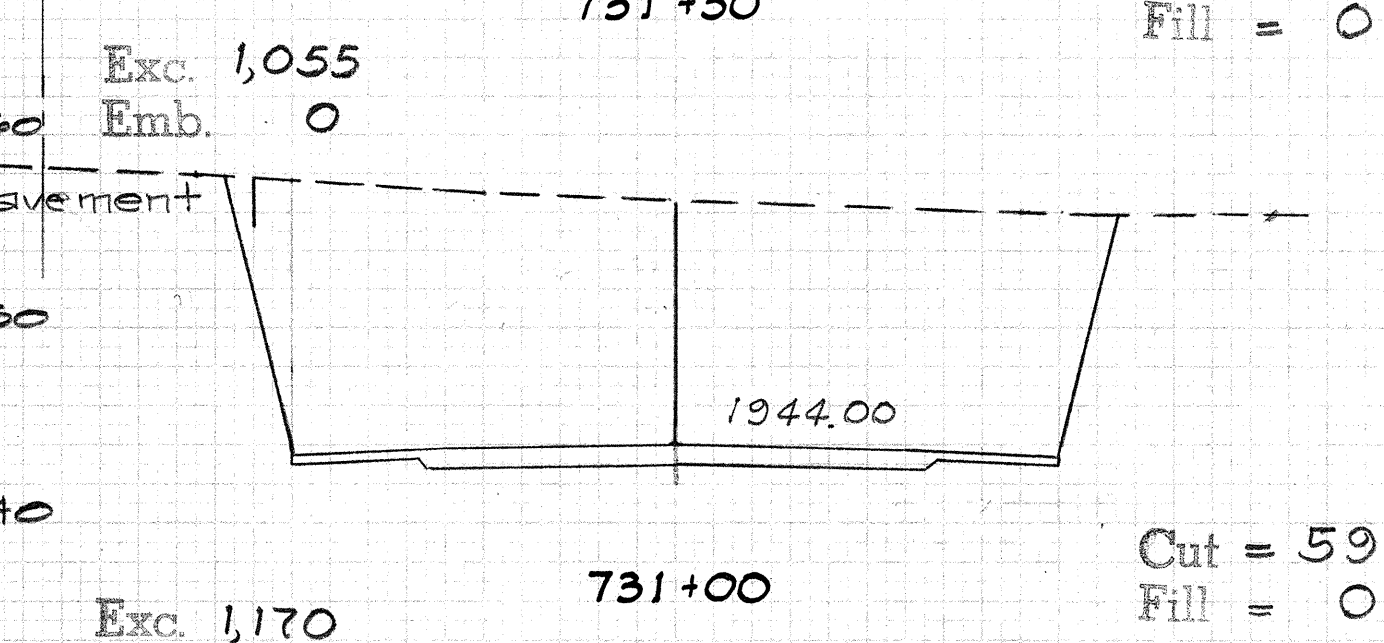
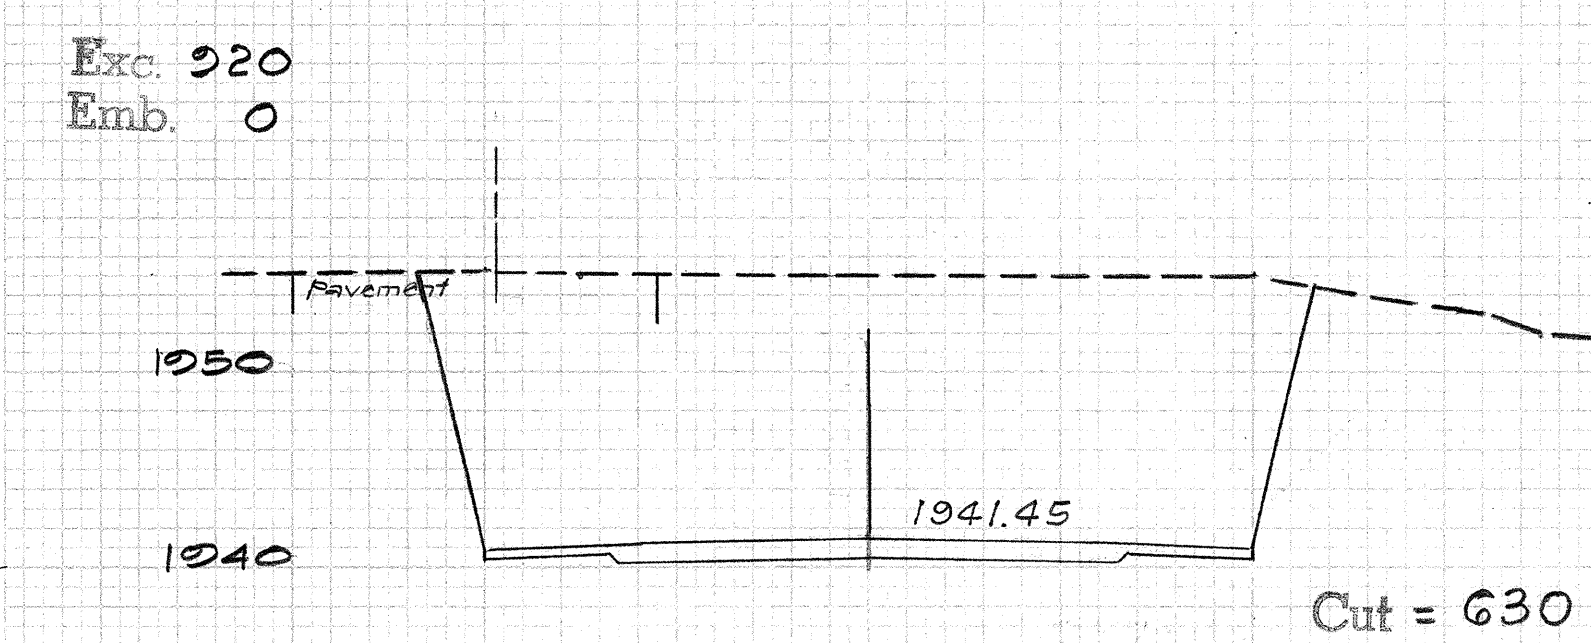
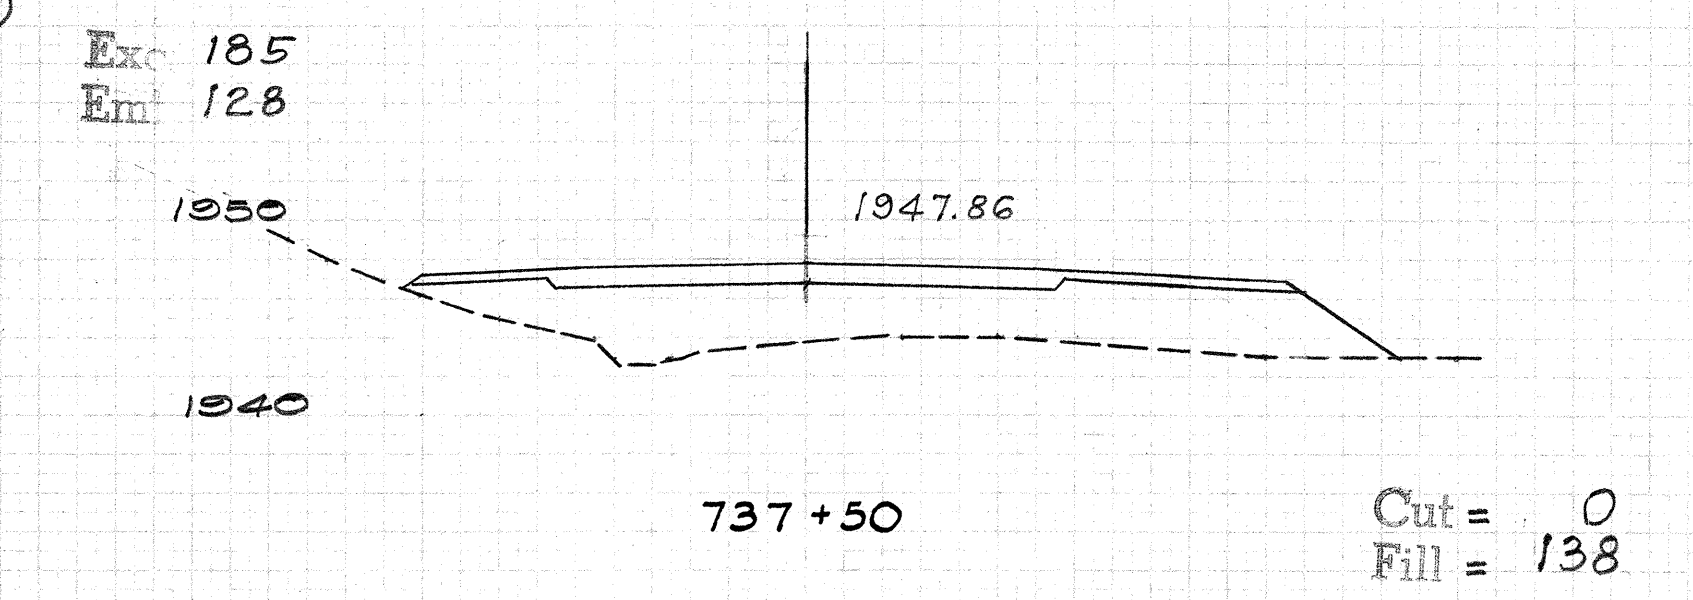
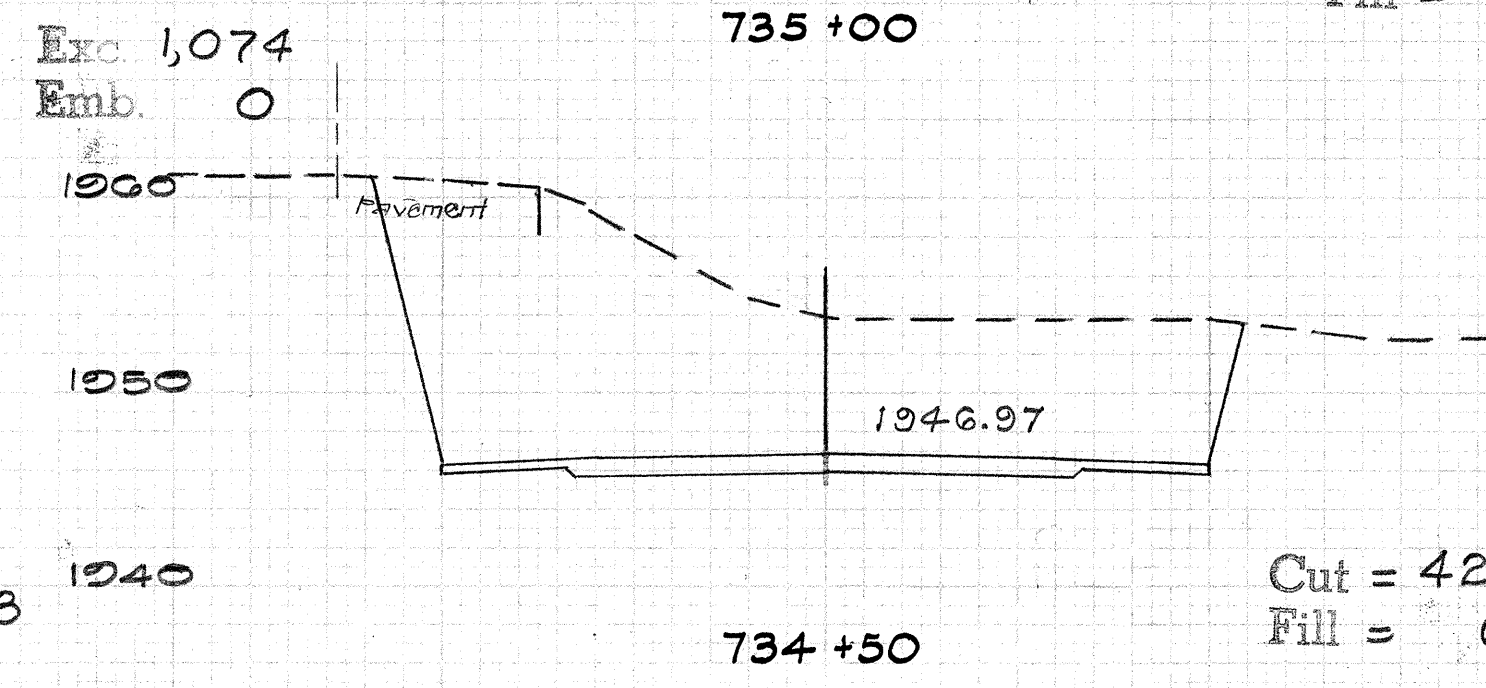
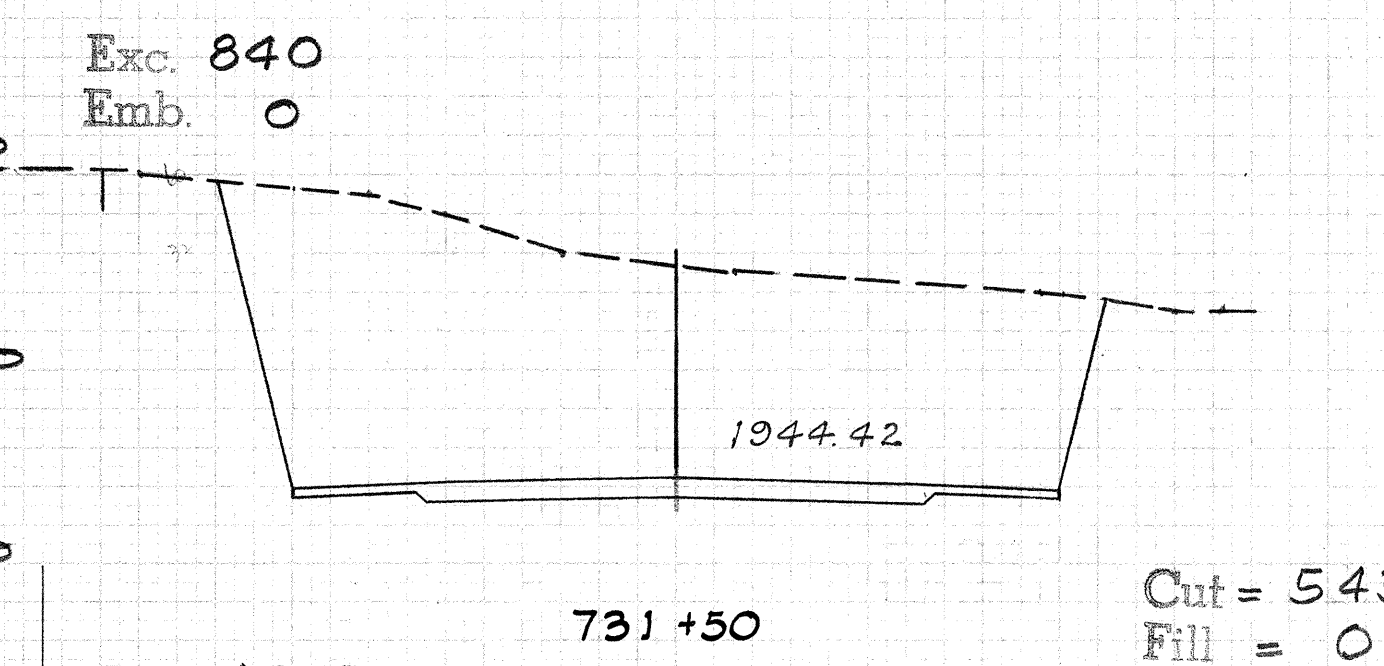
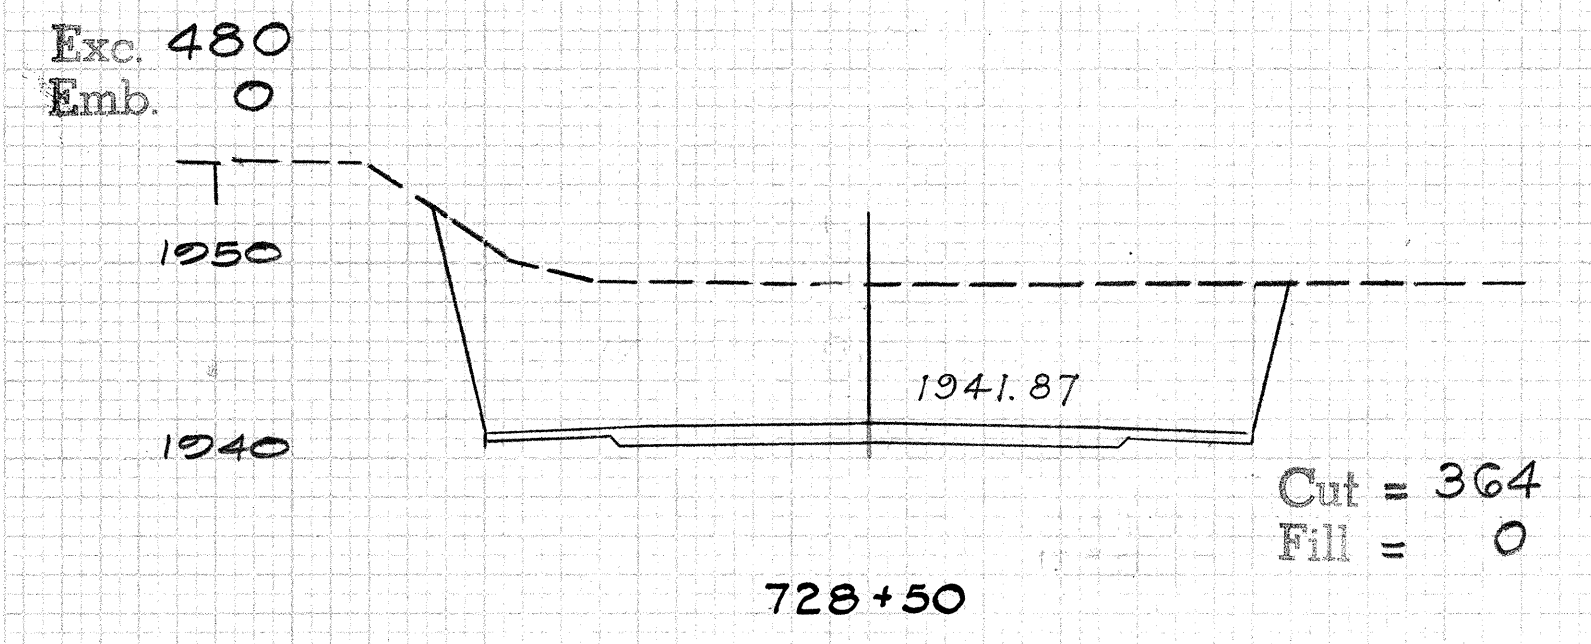
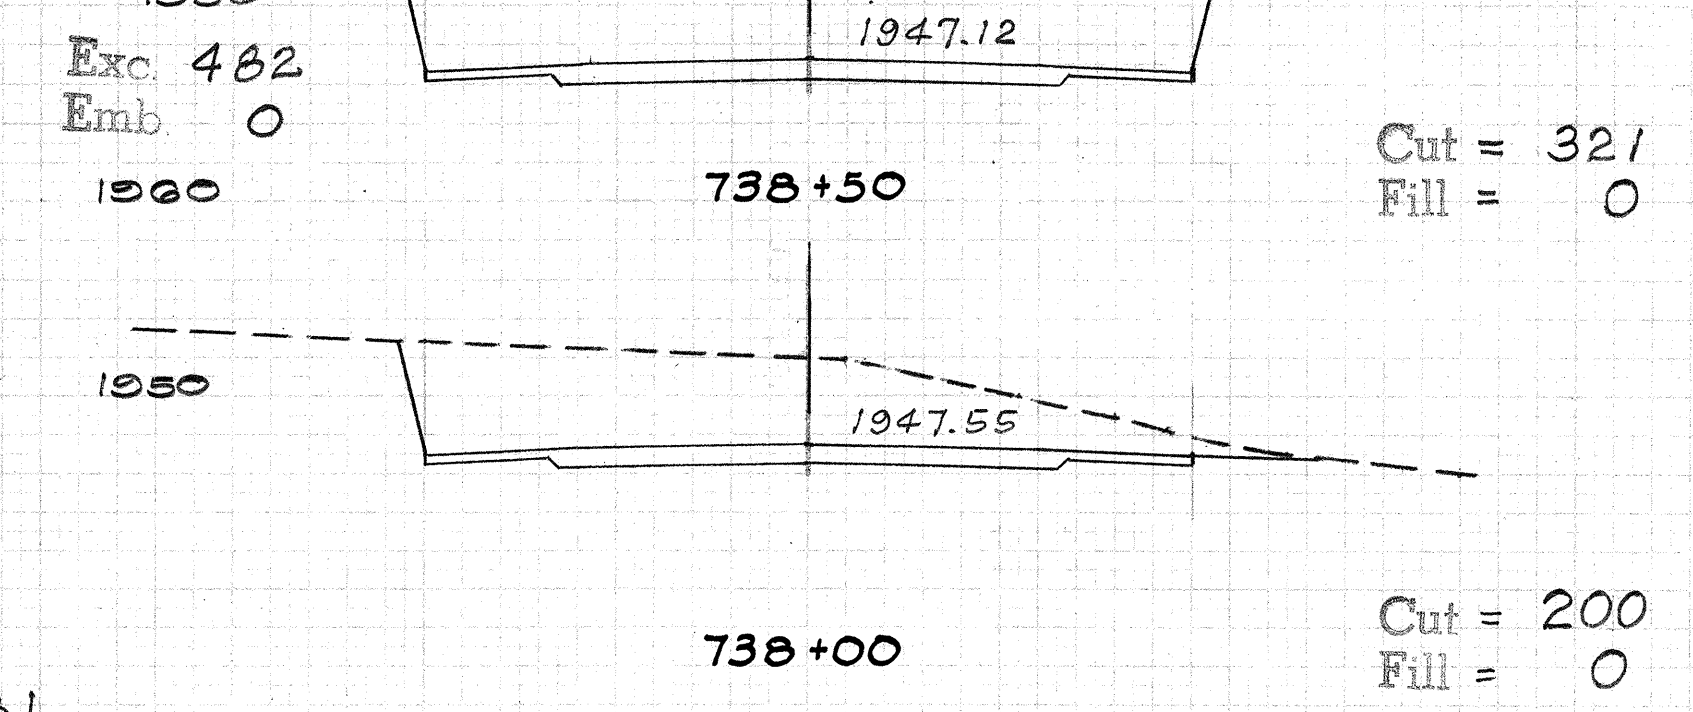
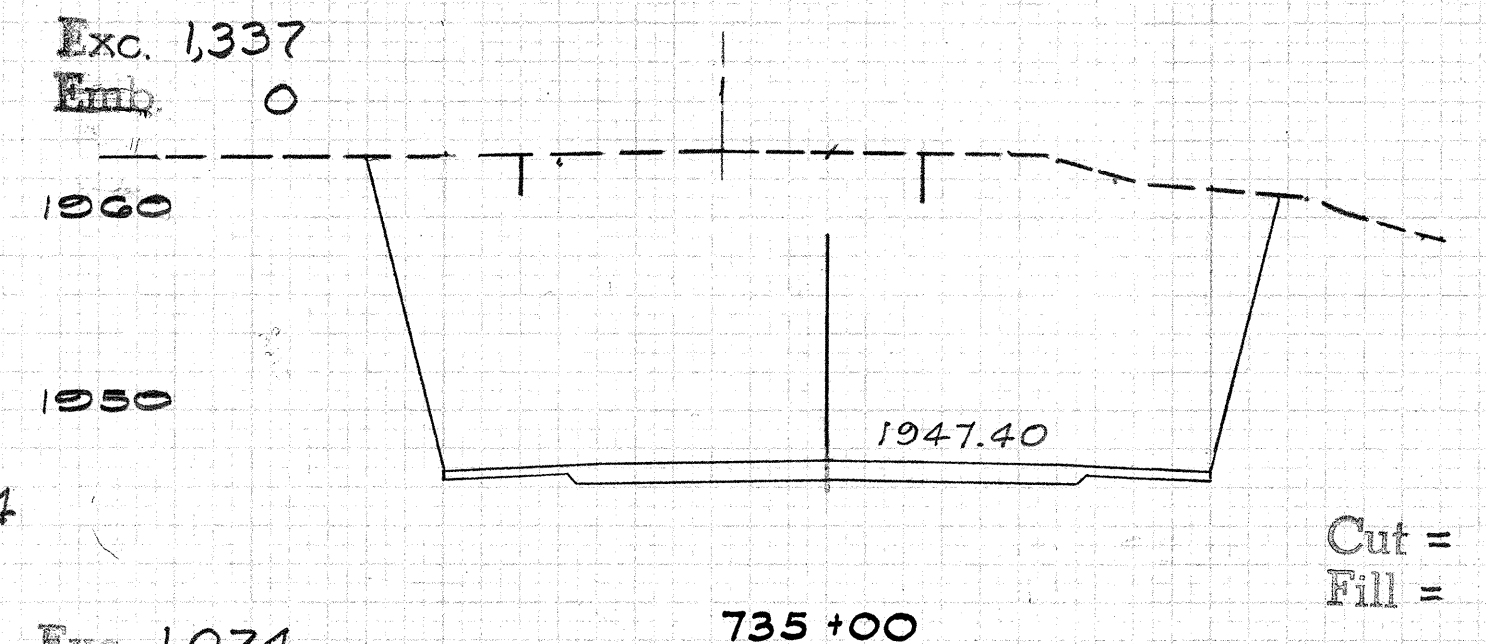
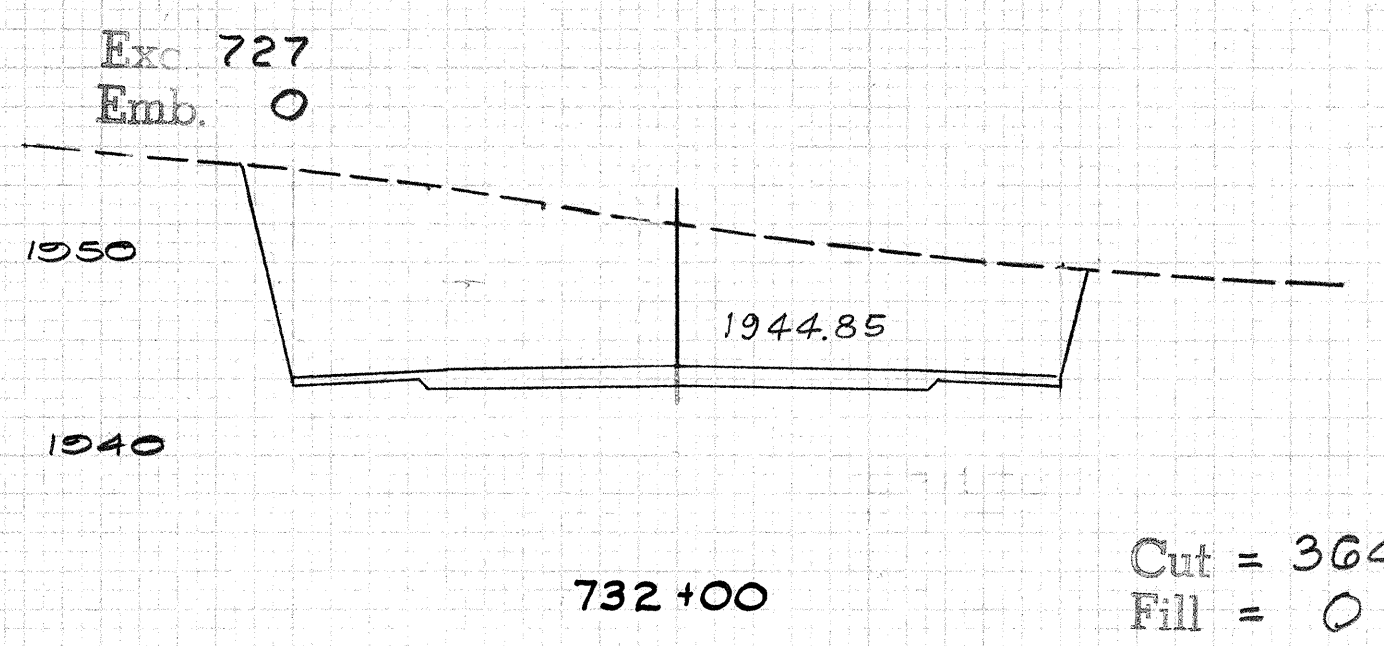
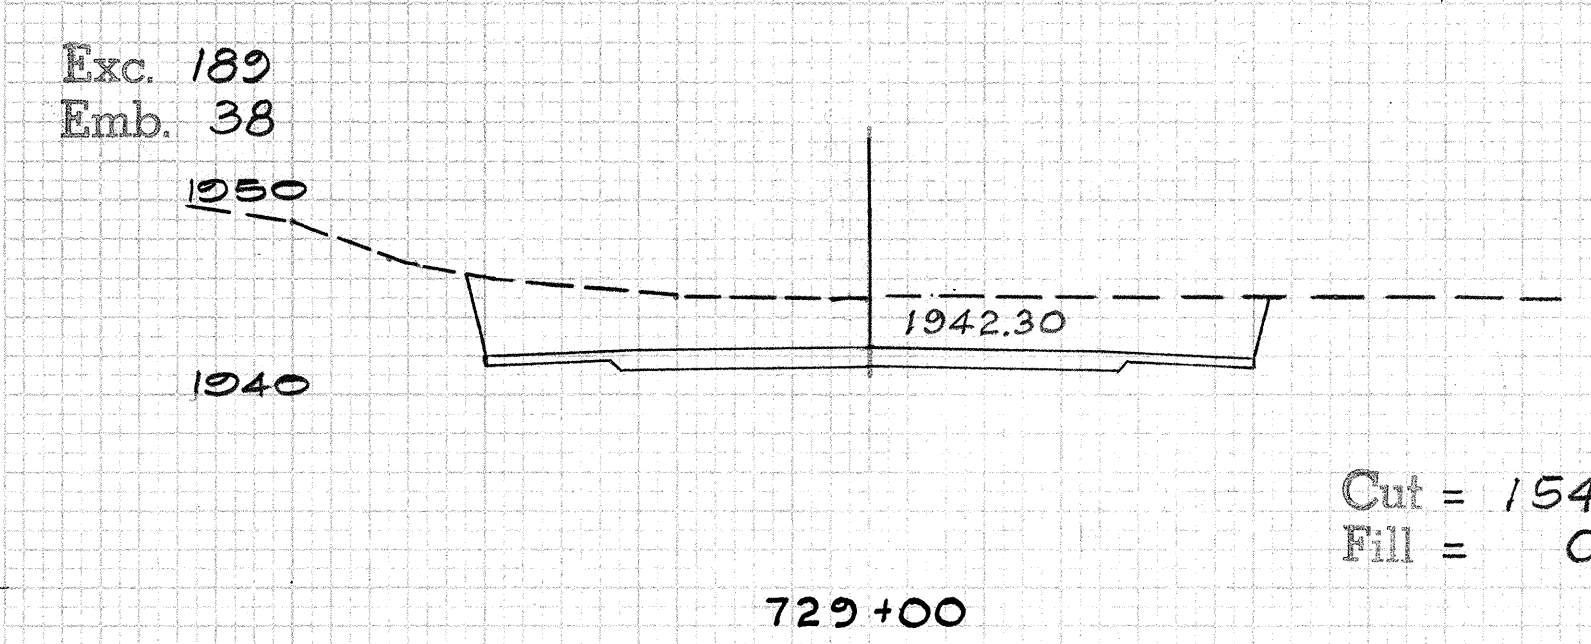
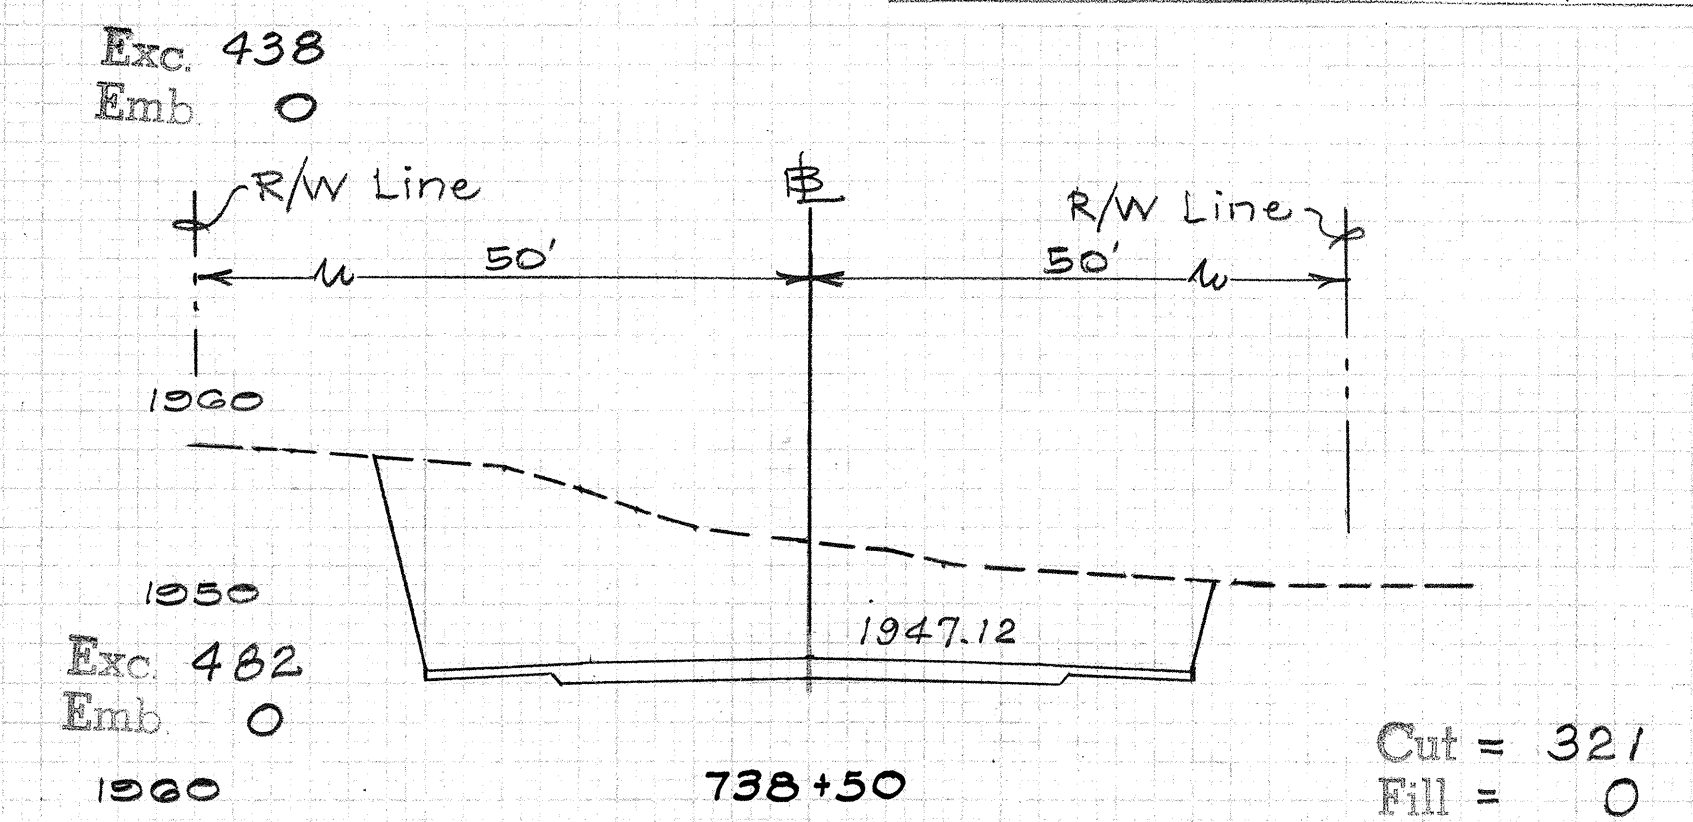
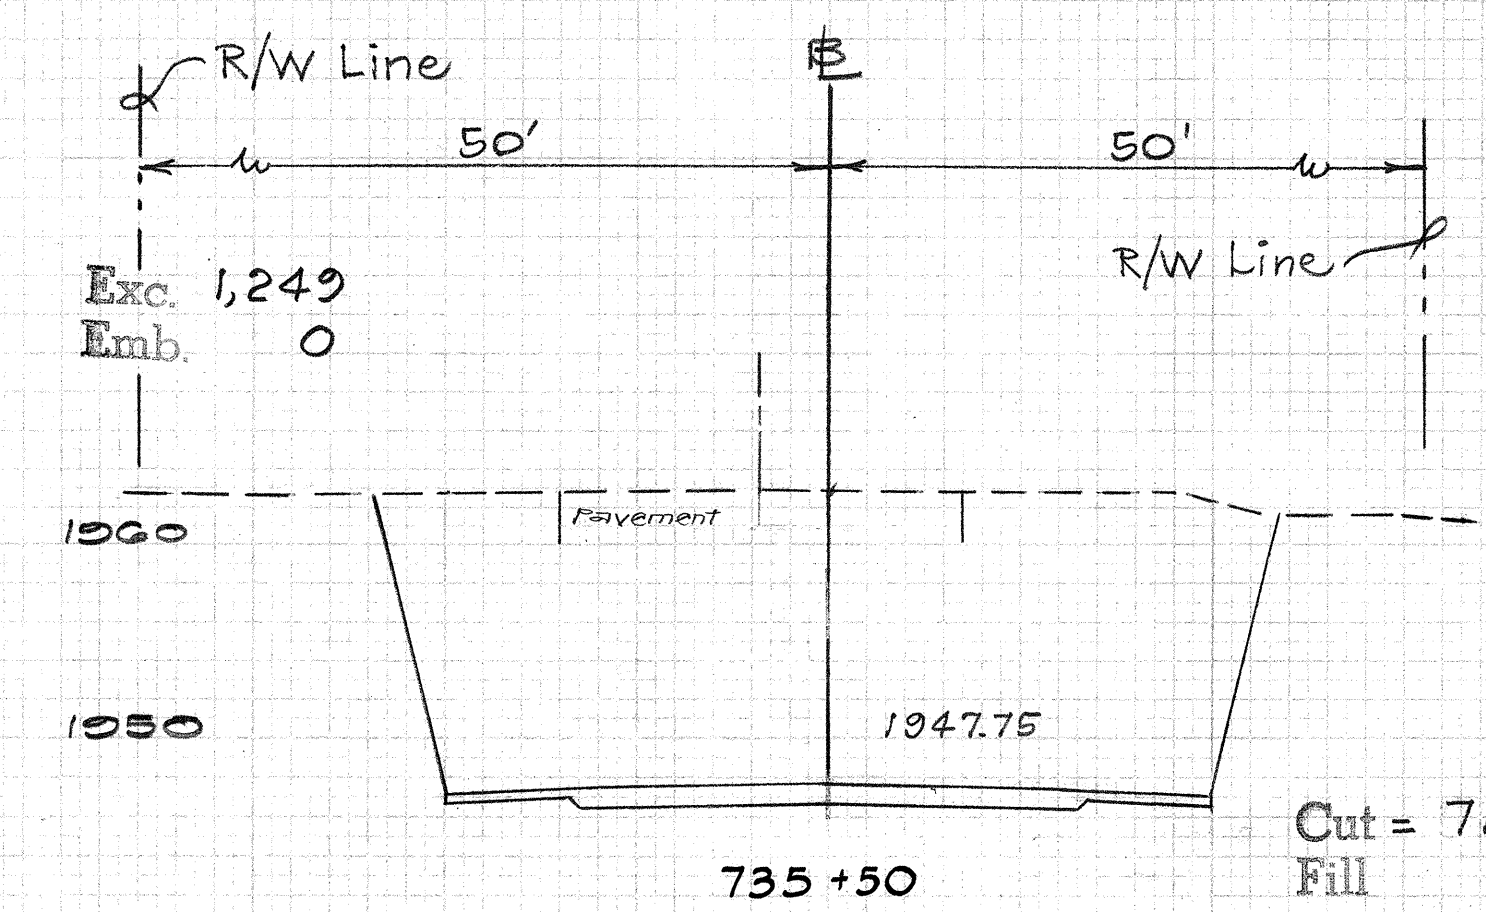
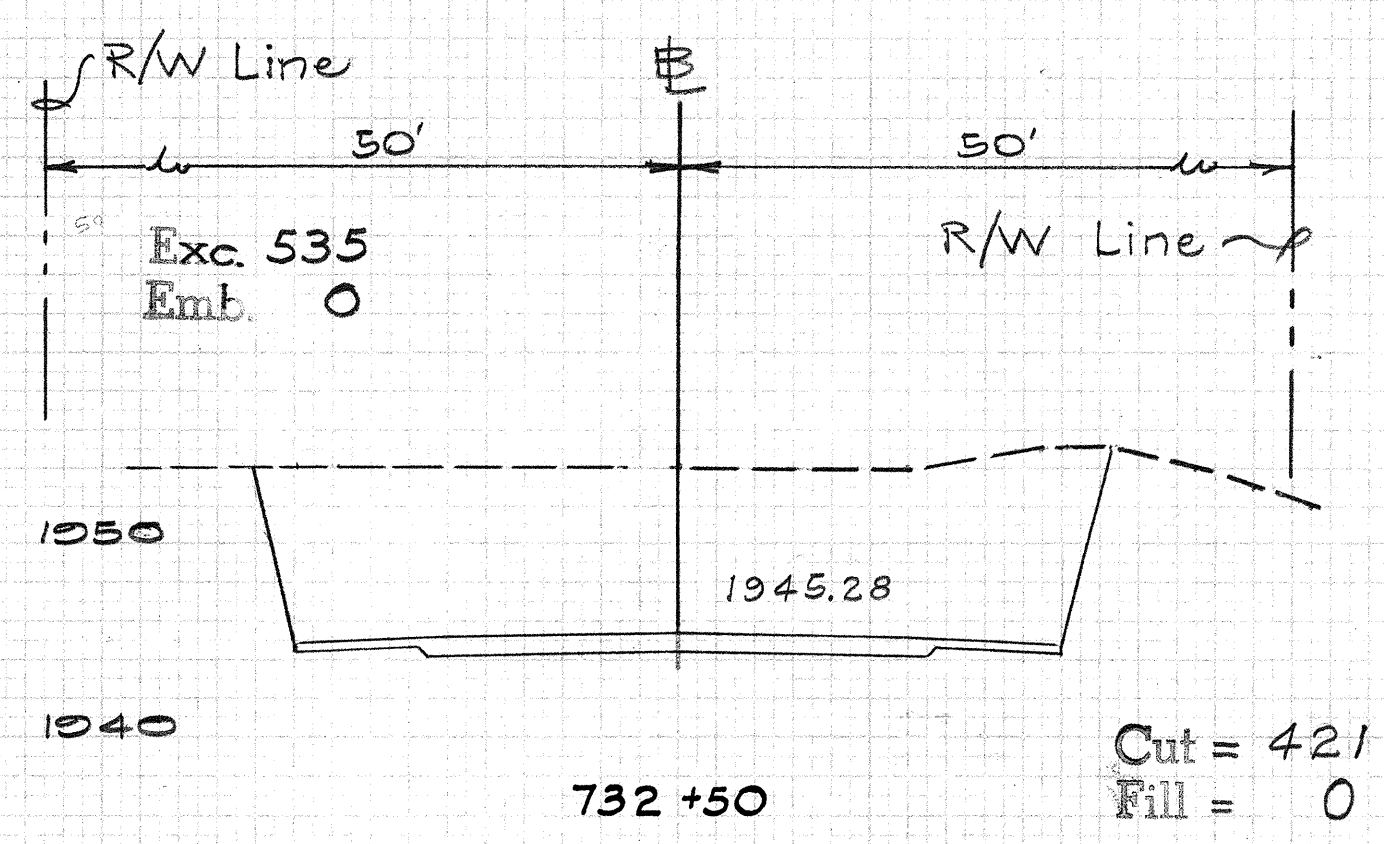
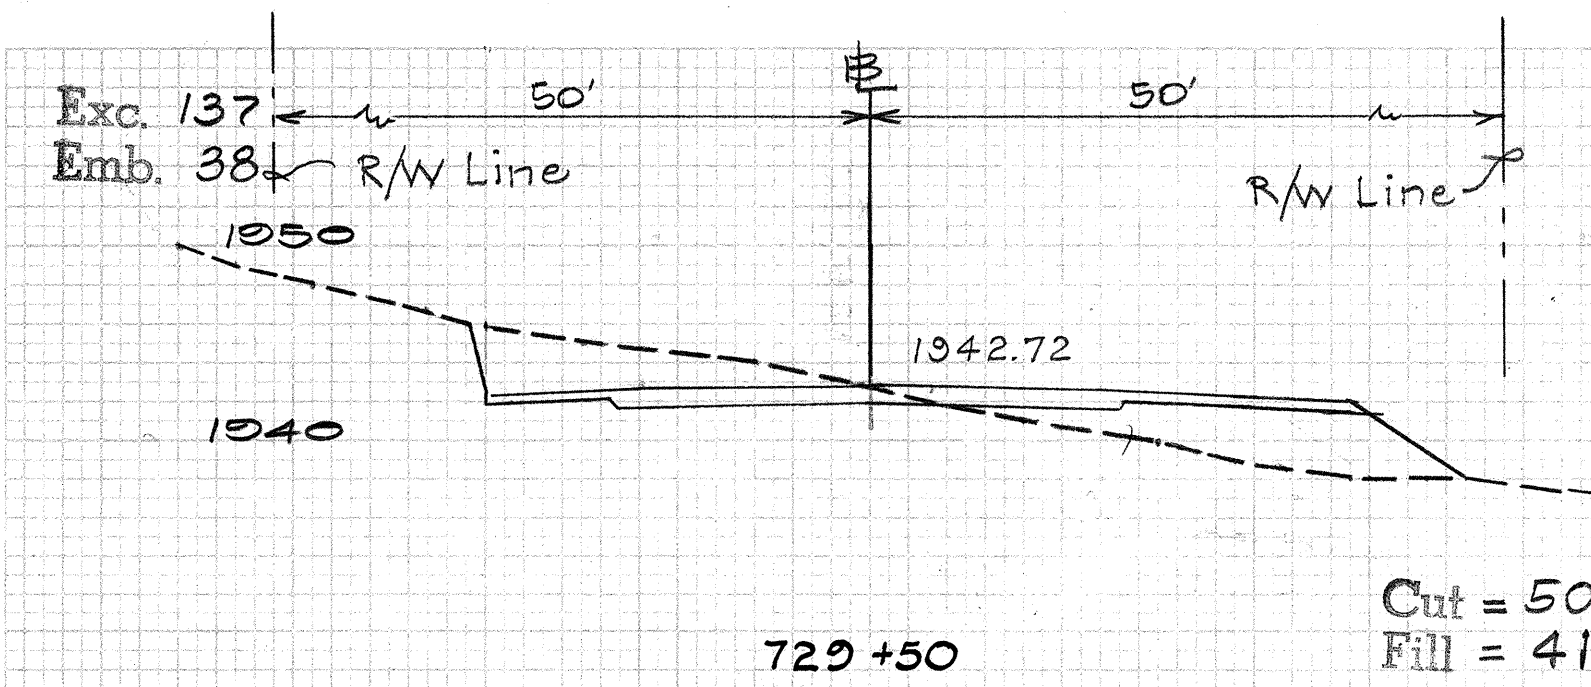


PLATE 4 CROSS SECTION
COURTESY OF THE HAWAIIAN HIGHWAY ENGINEERING SOCIETY

FED. ROAD DIST. NO.	STATE	PROJ. NO.	FISCAL YEAR	SHEET NO.	TOTAL SHEETS
HAWAII	HAW.	HE-01-75	1975	38	45


















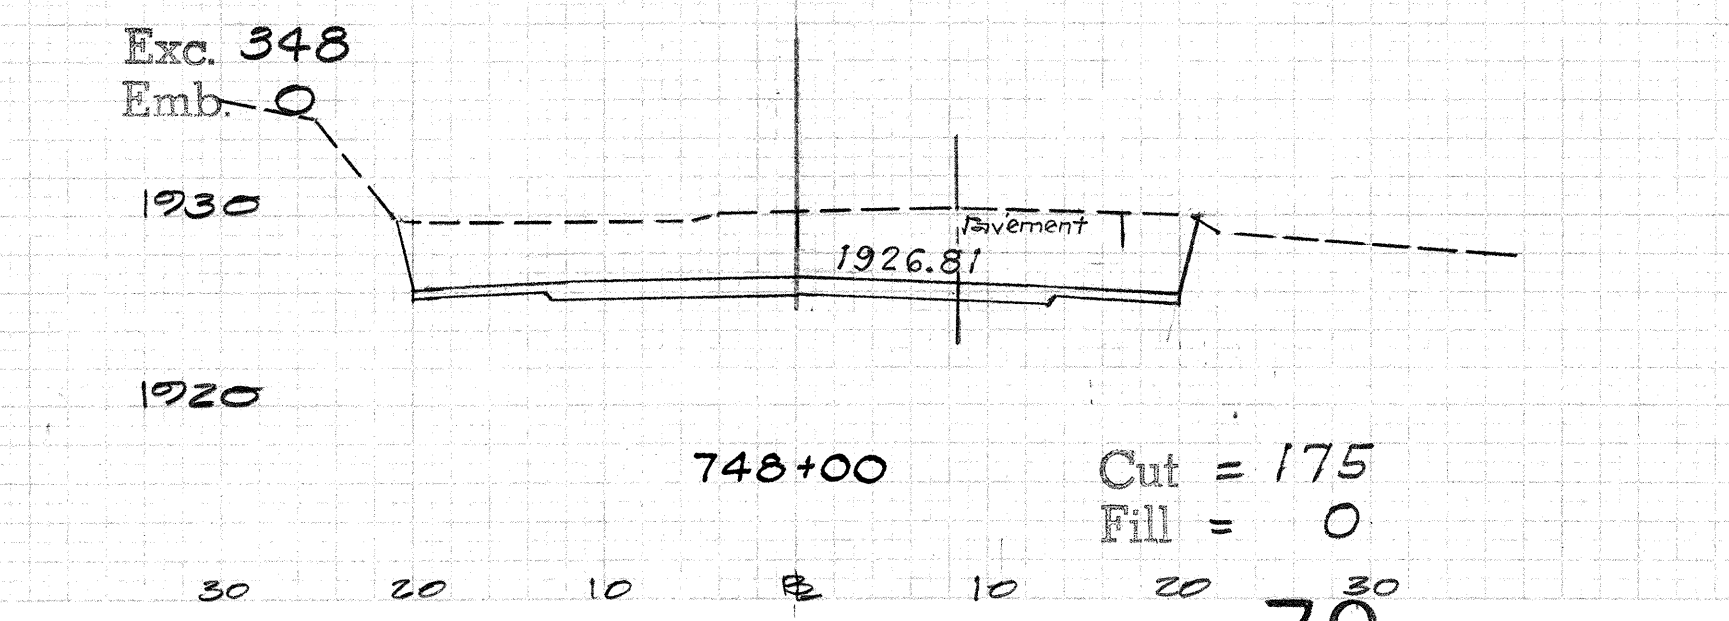



PLATE 3 CROSS SECTION
CLEARPRINT PAPER 30" X 36"

FED. ROAD DIST. NO.	STATE	PROJ. NO.	FISCAL YEAR	SHEET NO.	TOTAL SHEETS
HAWAII	HAW.	11E-01-75	1975	39	45

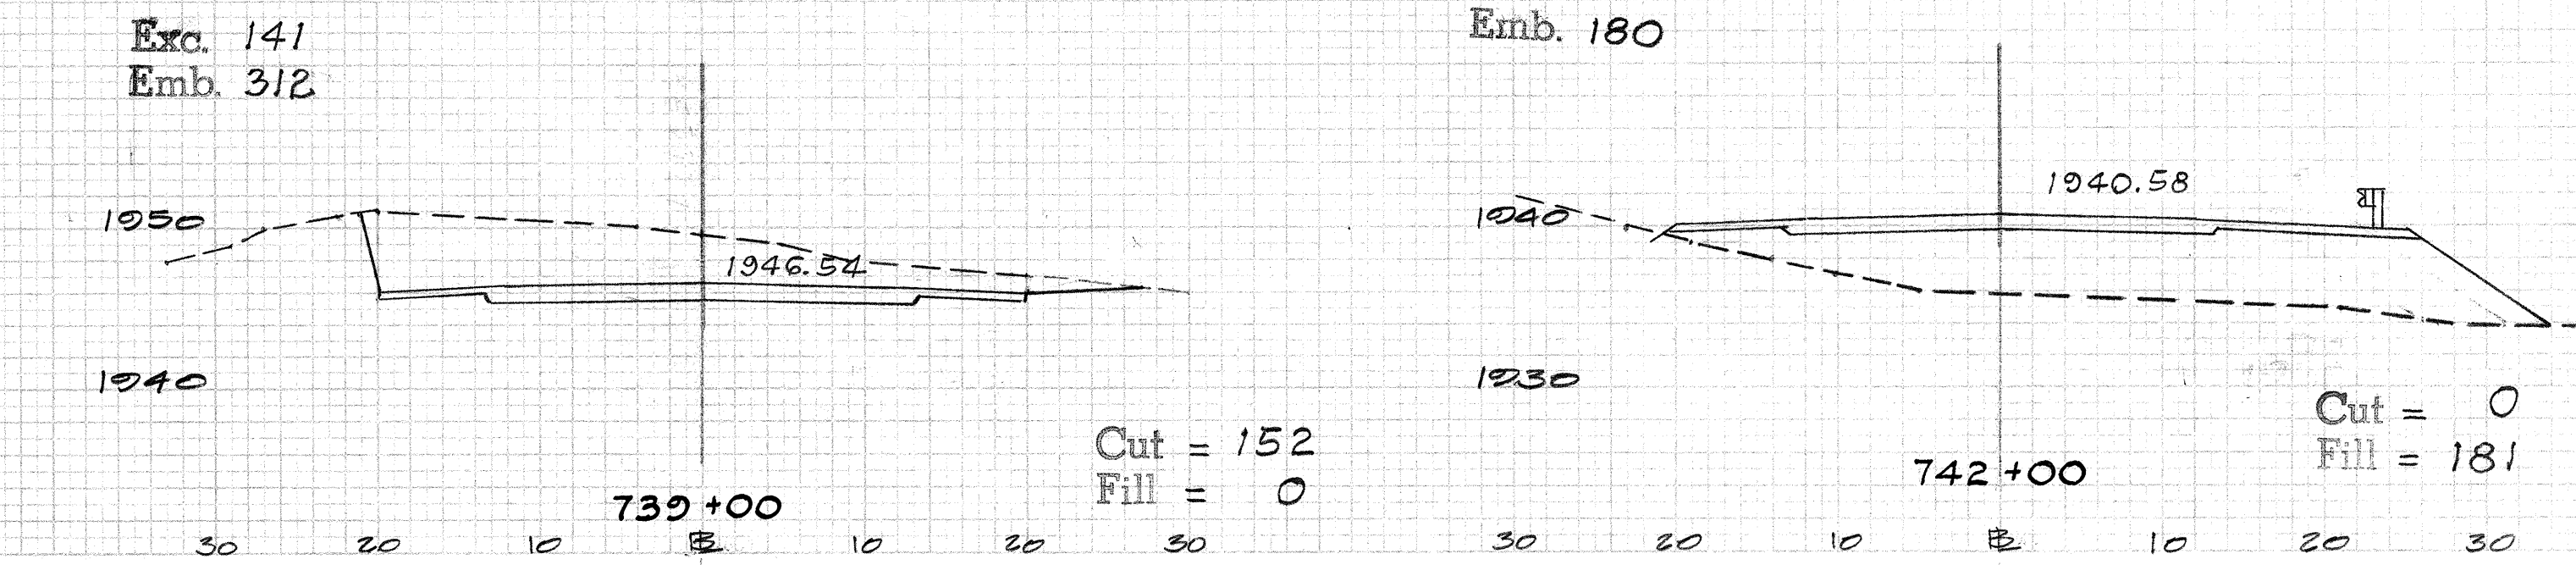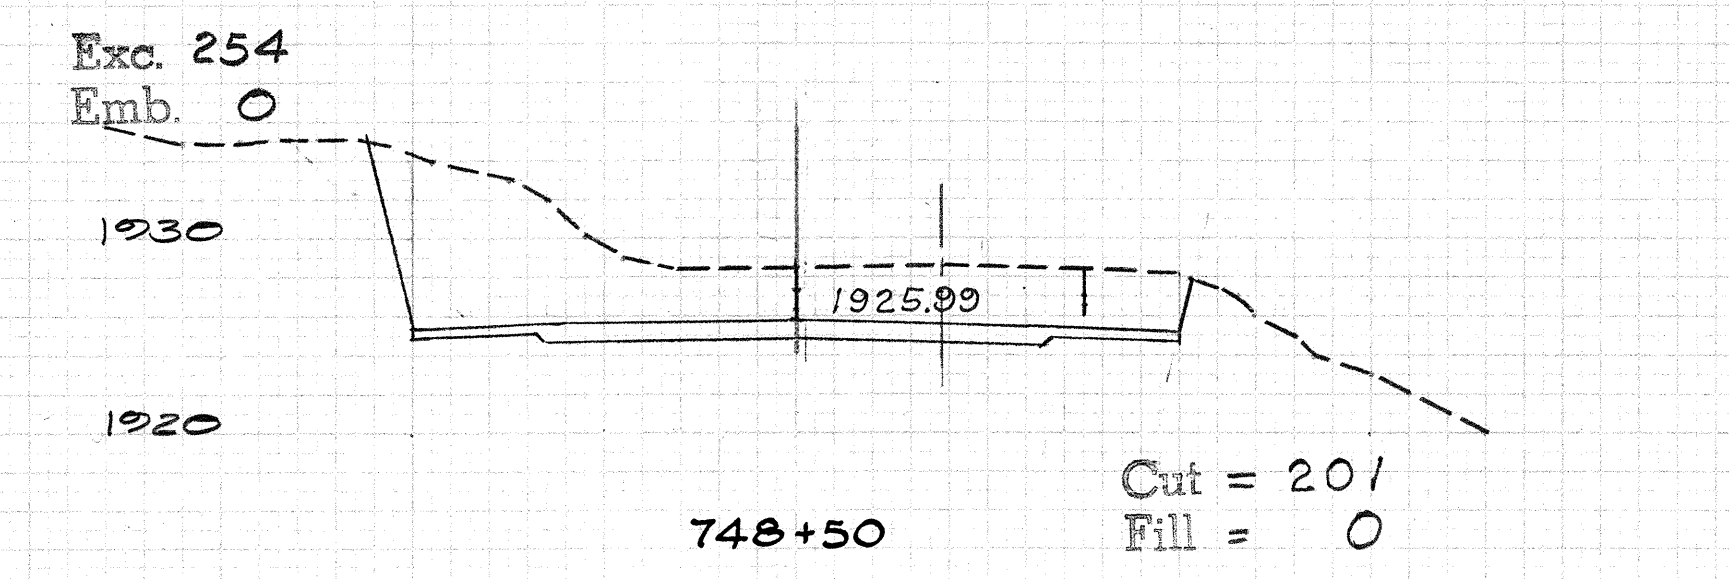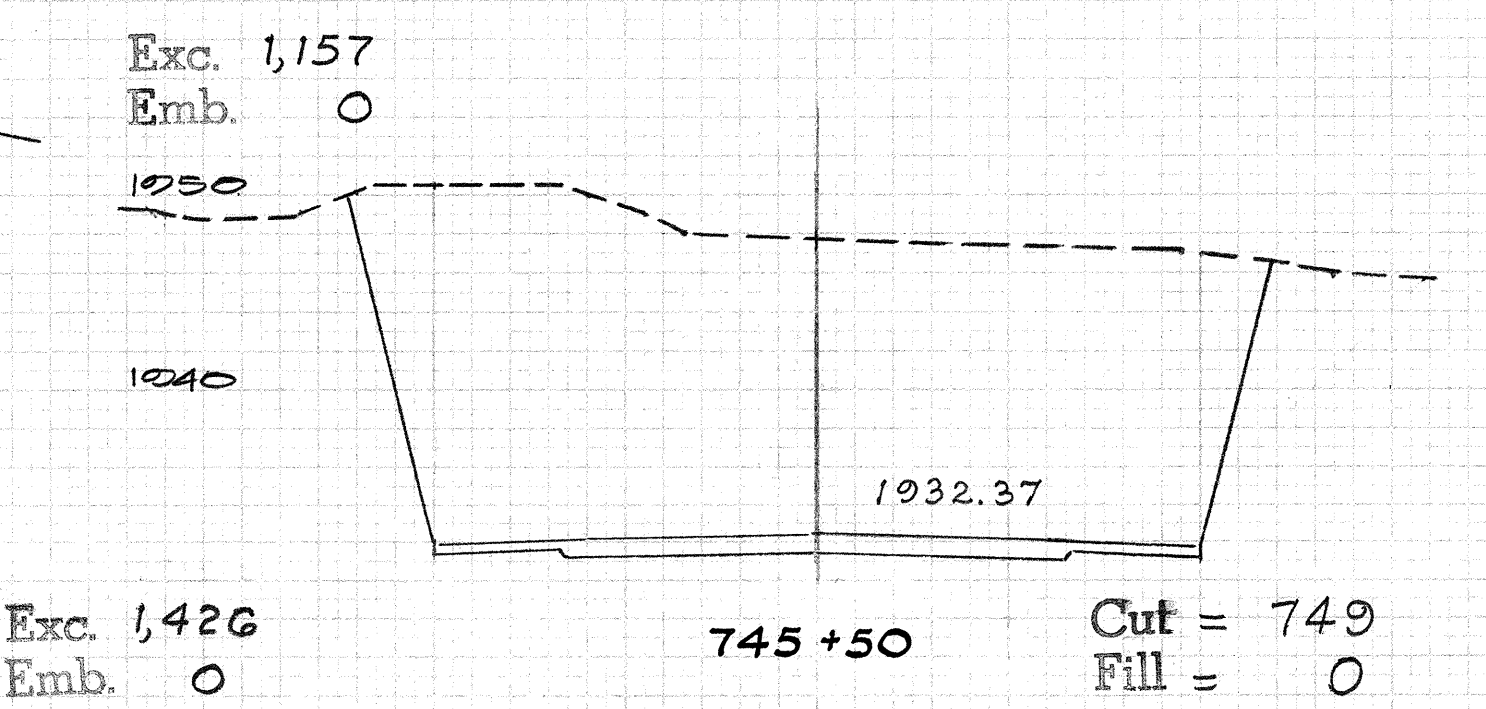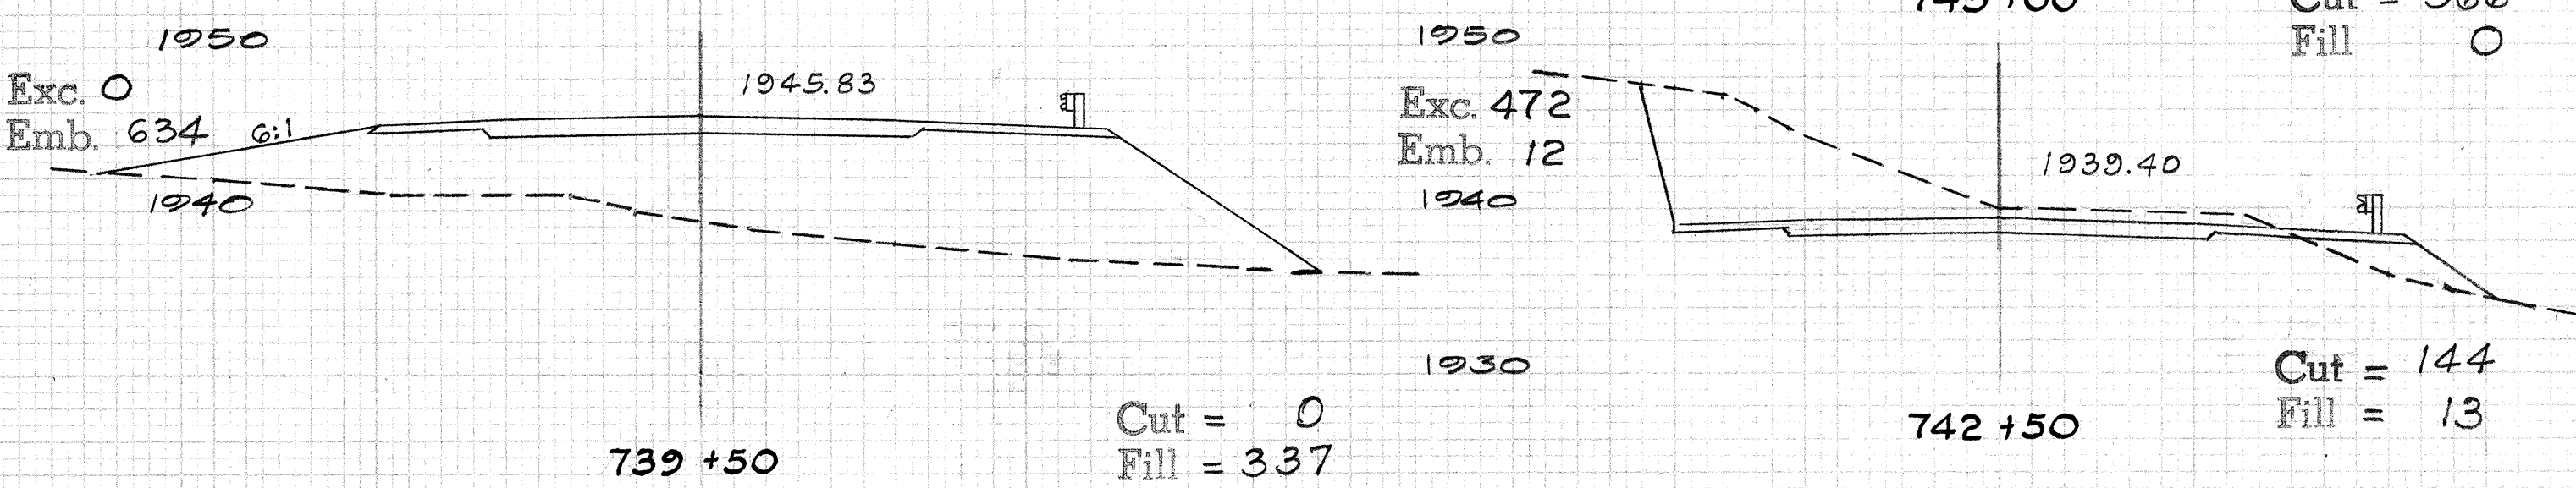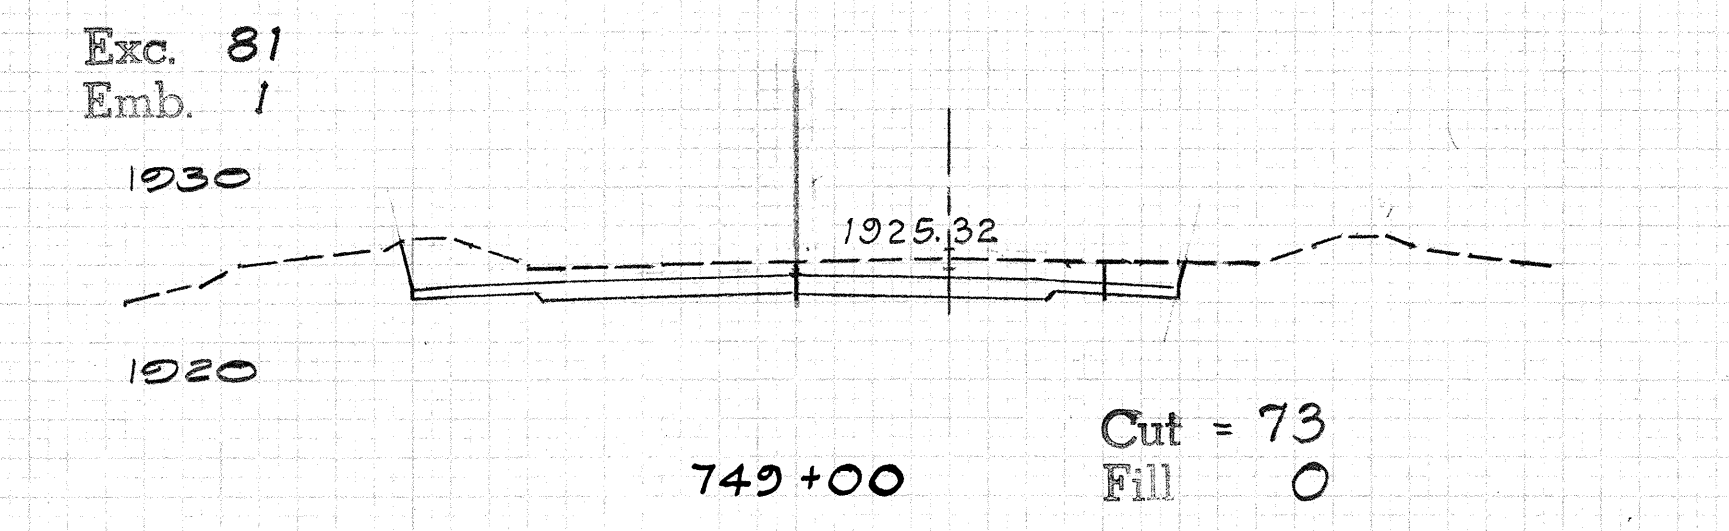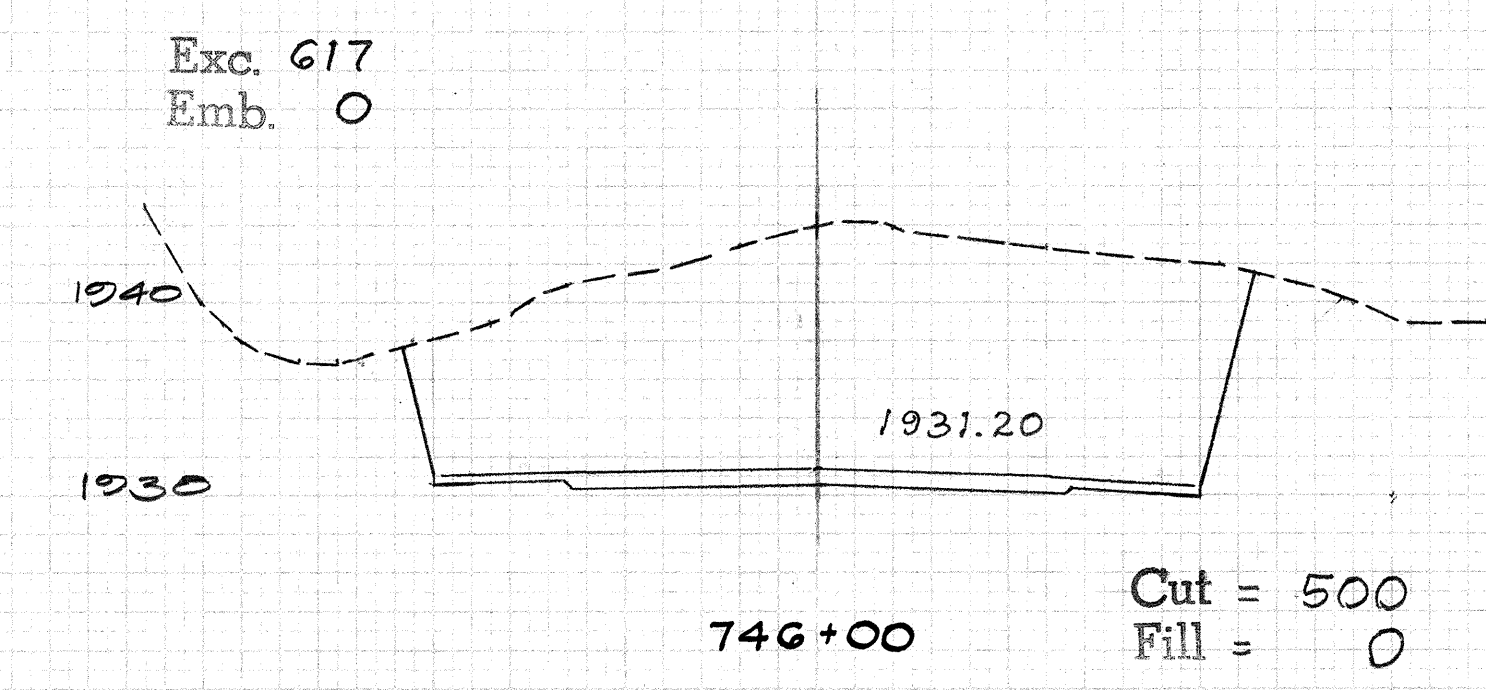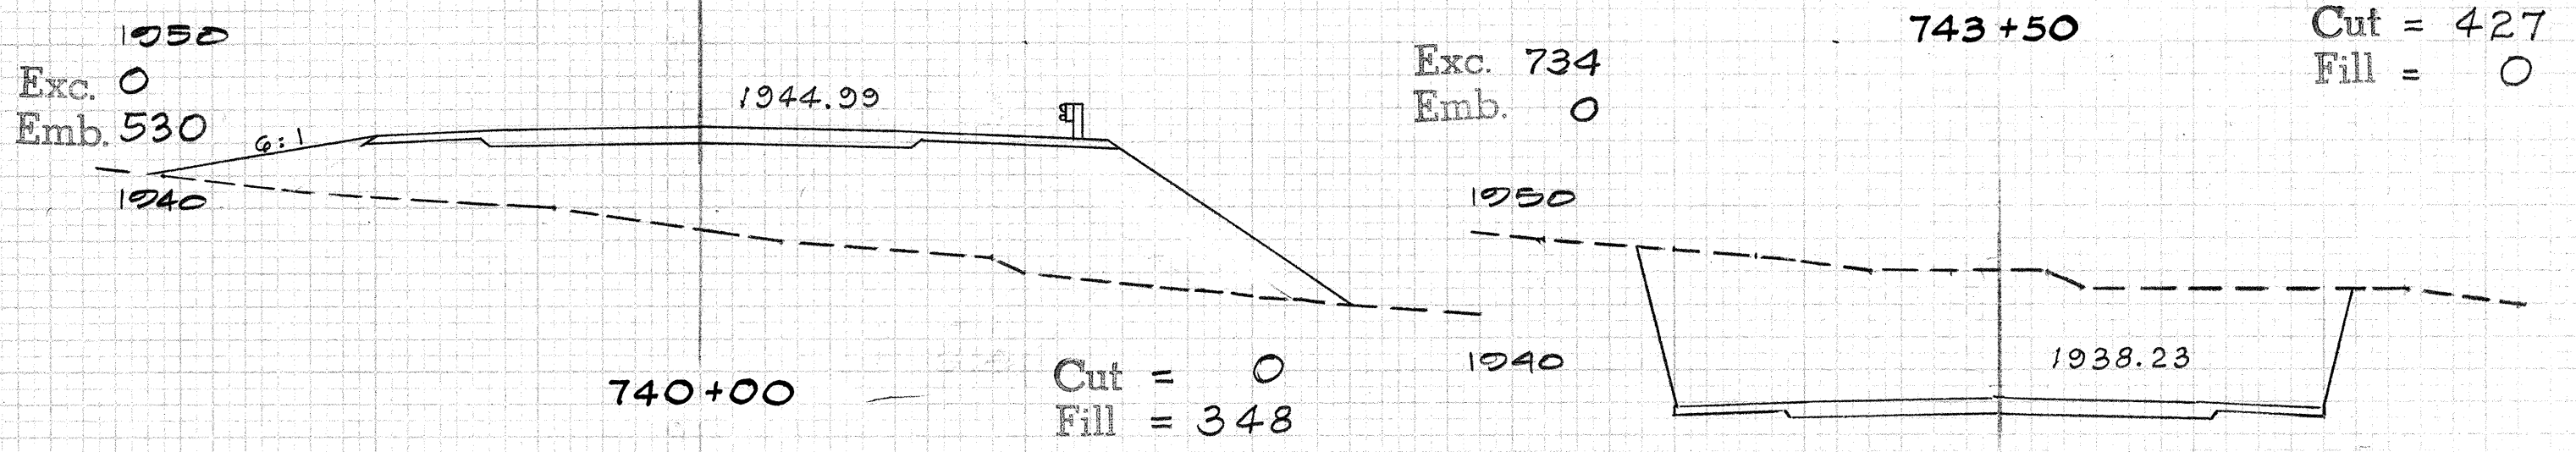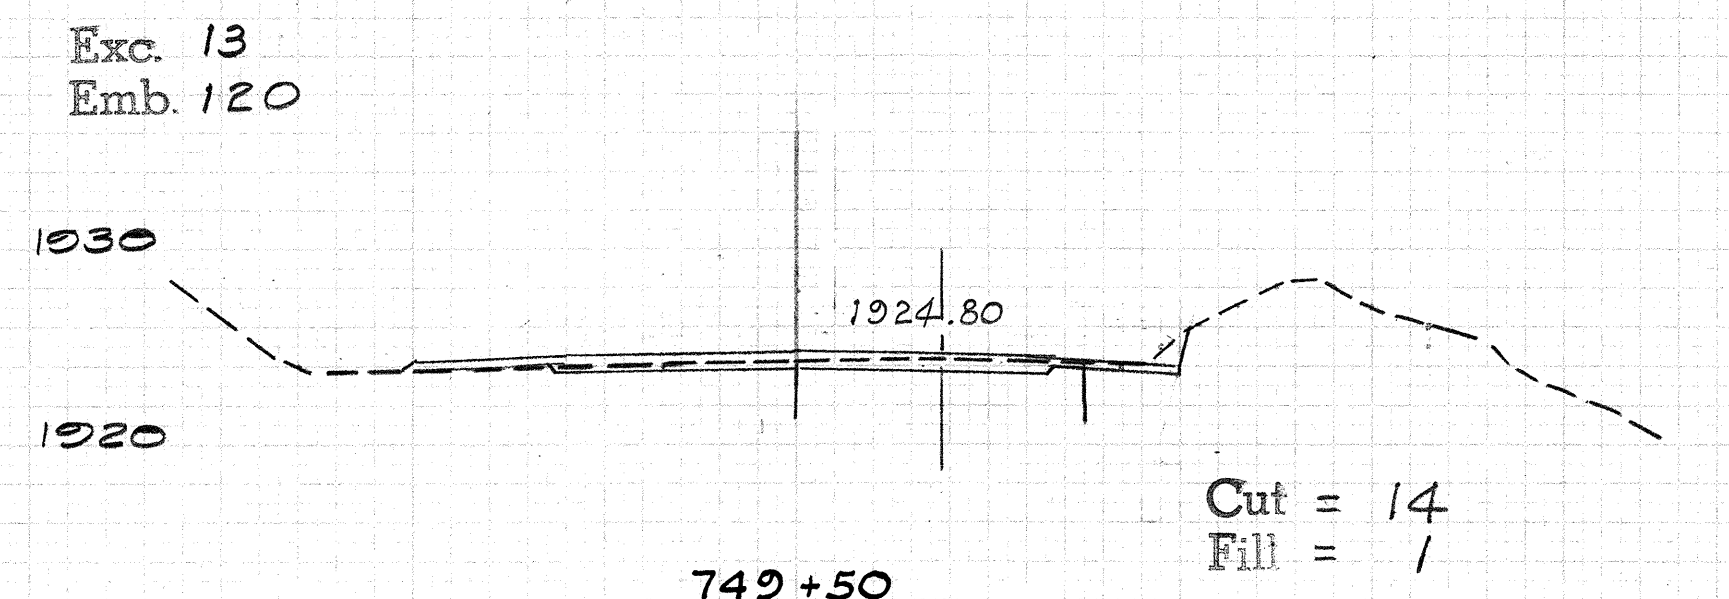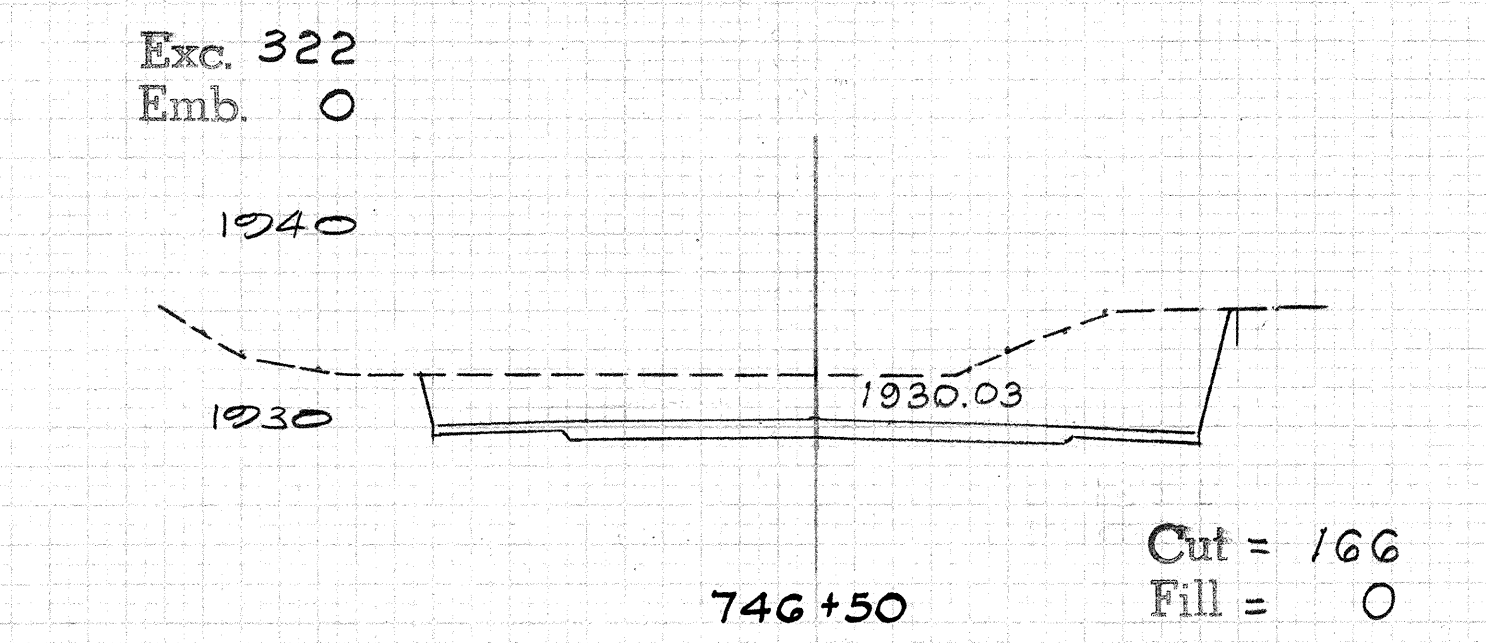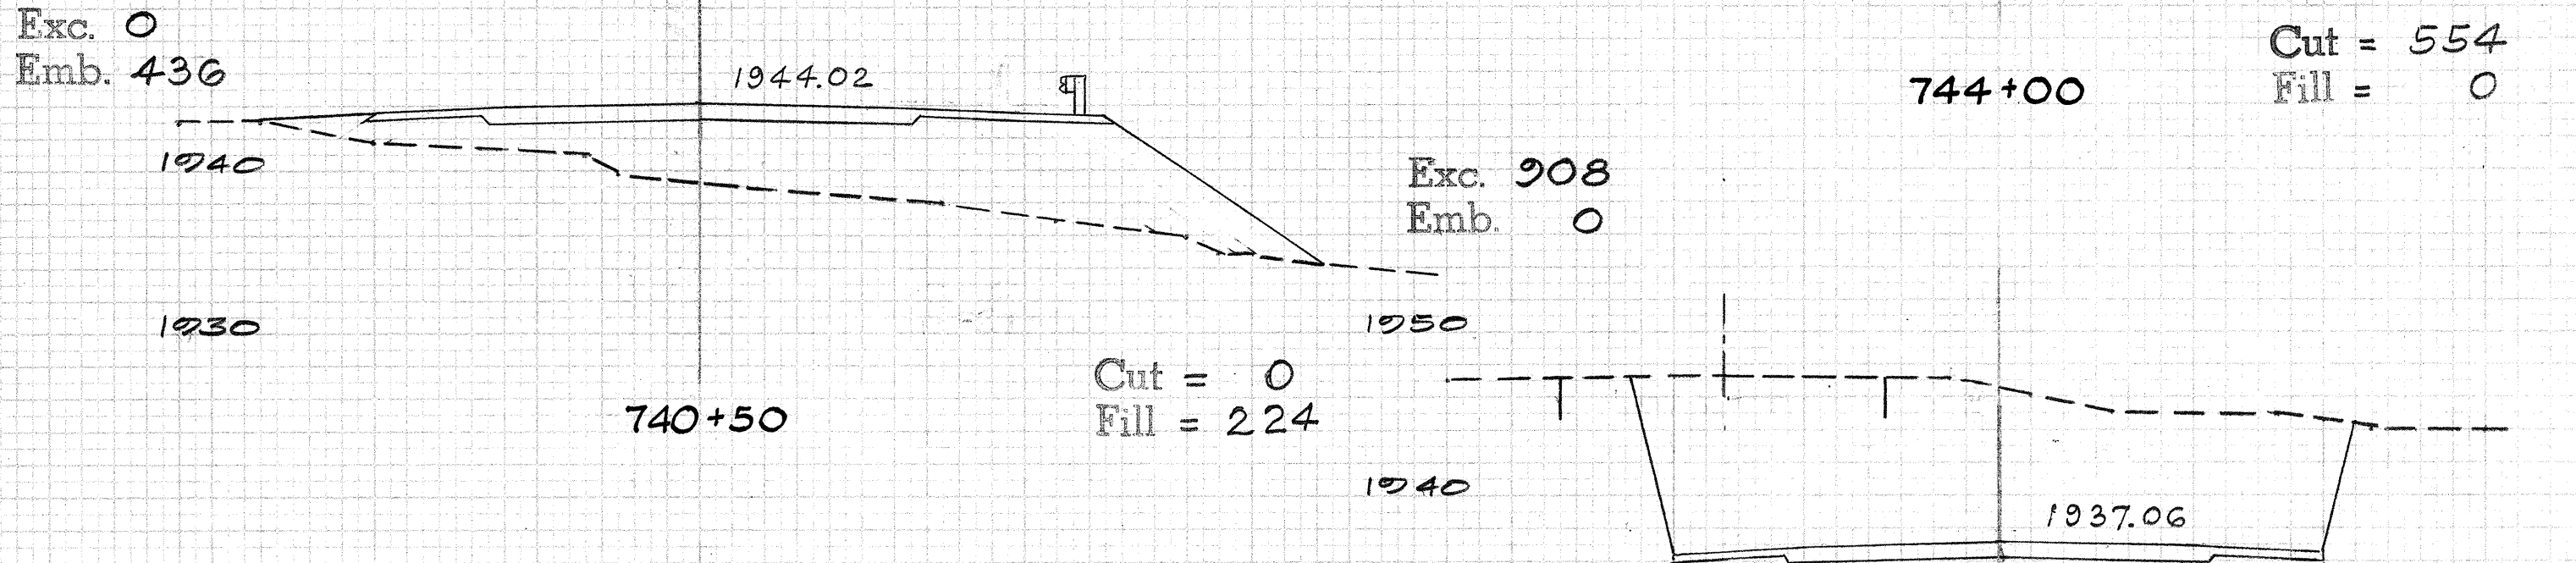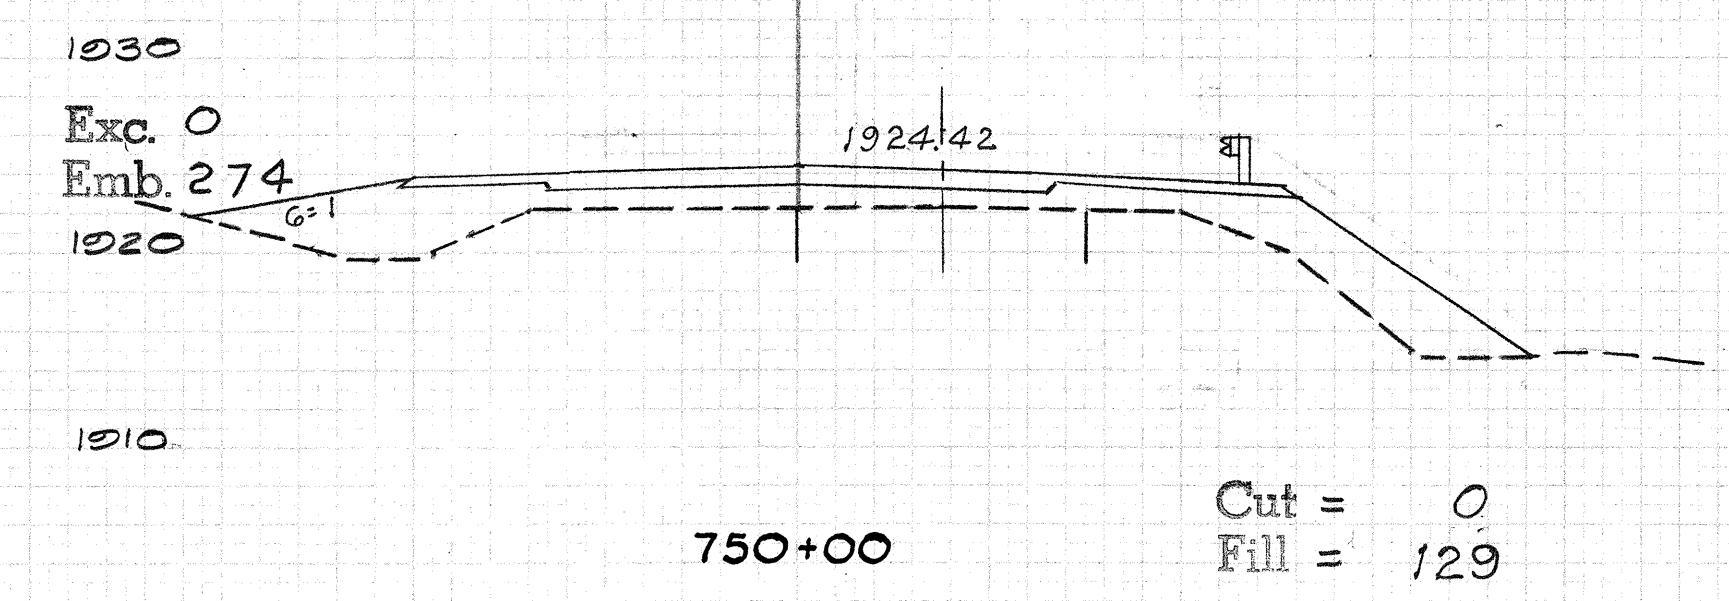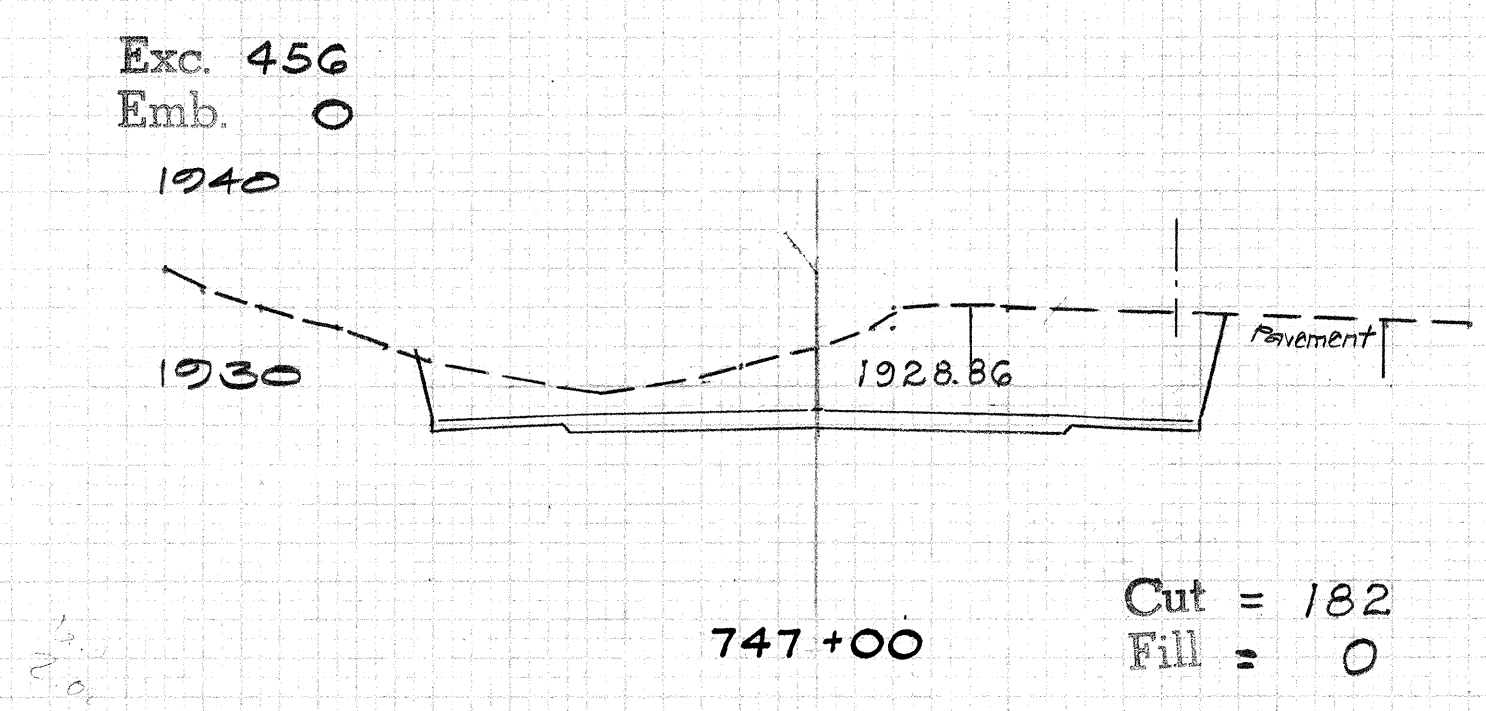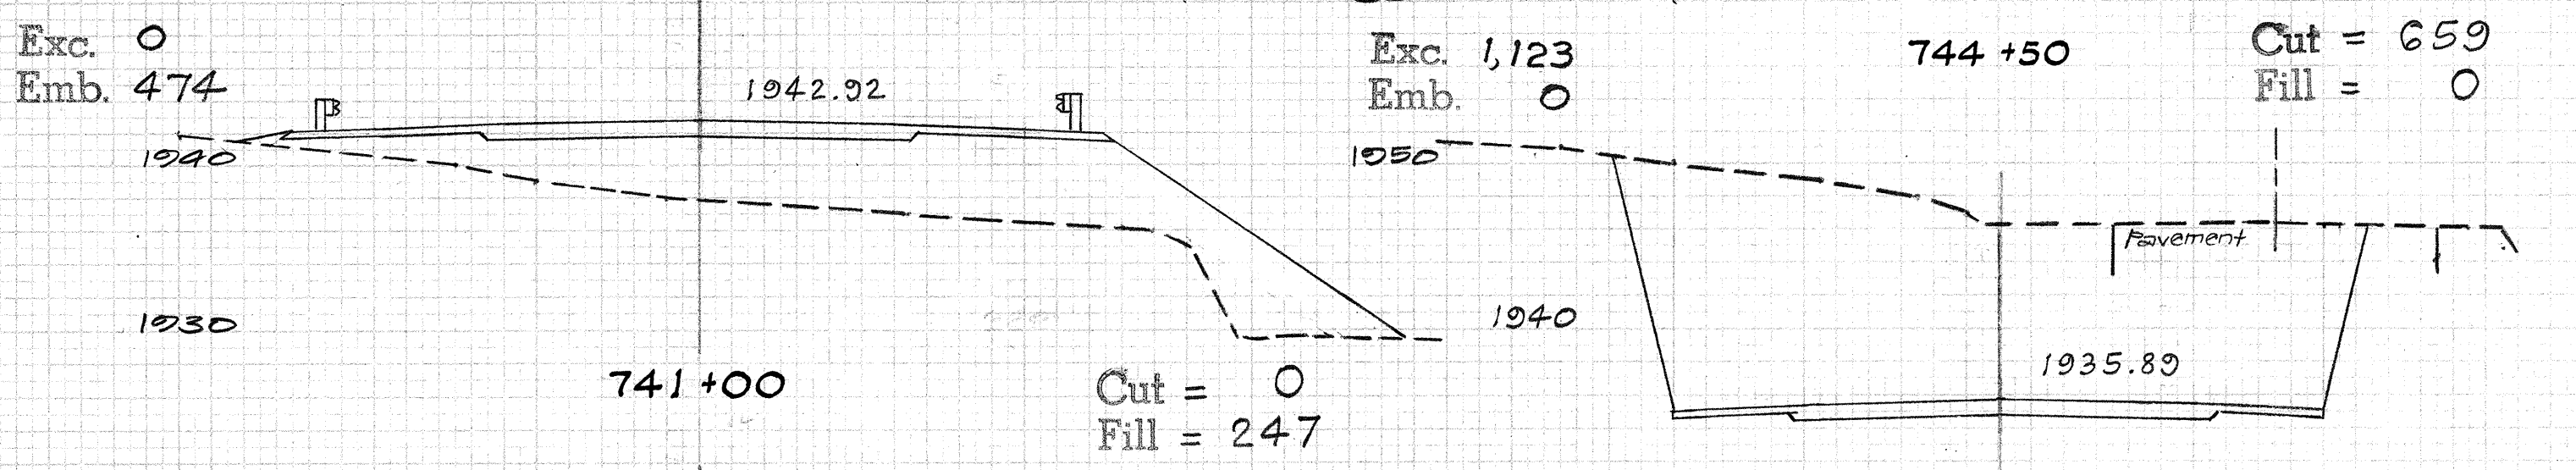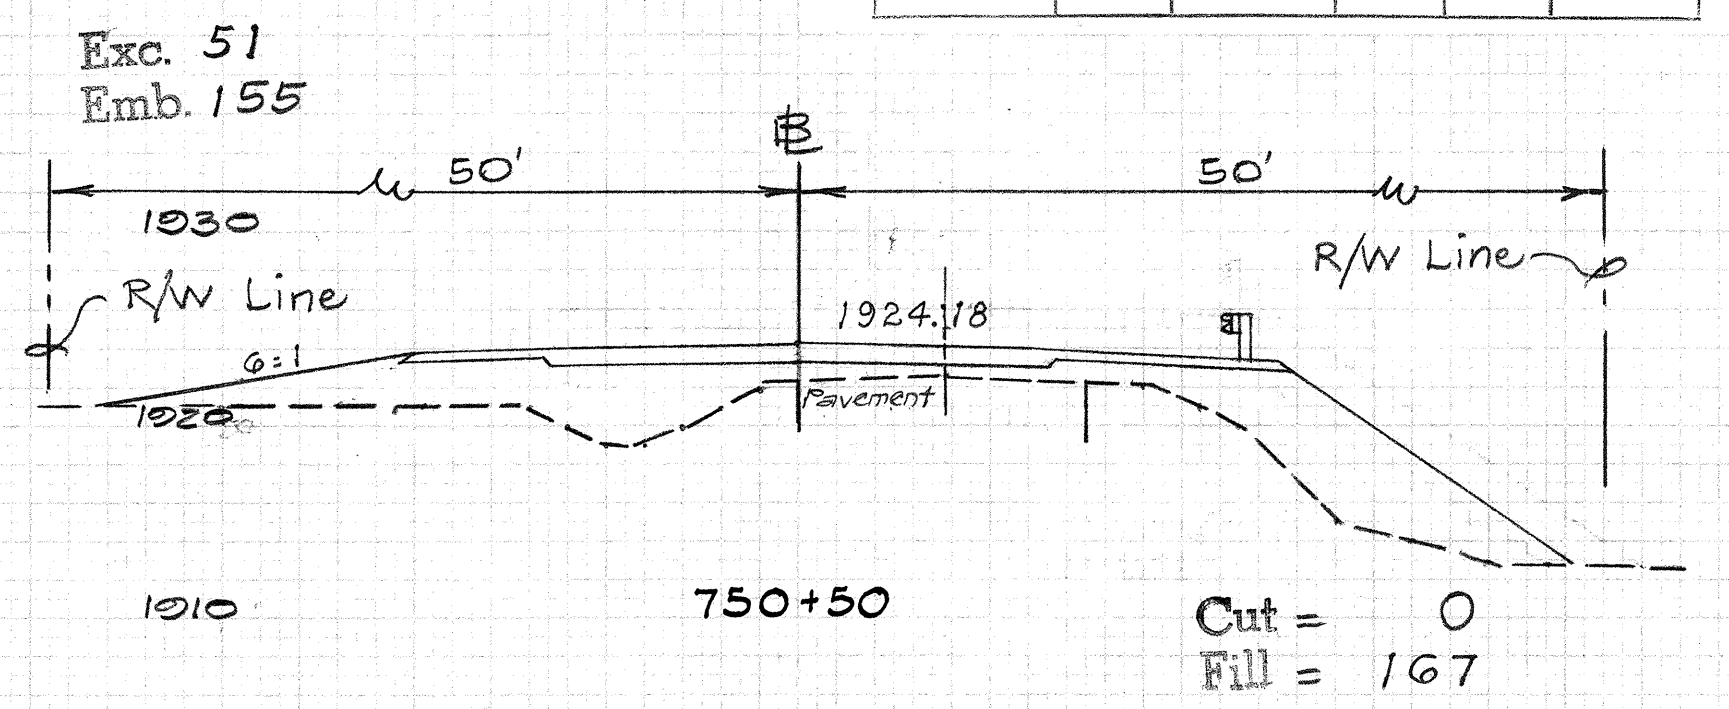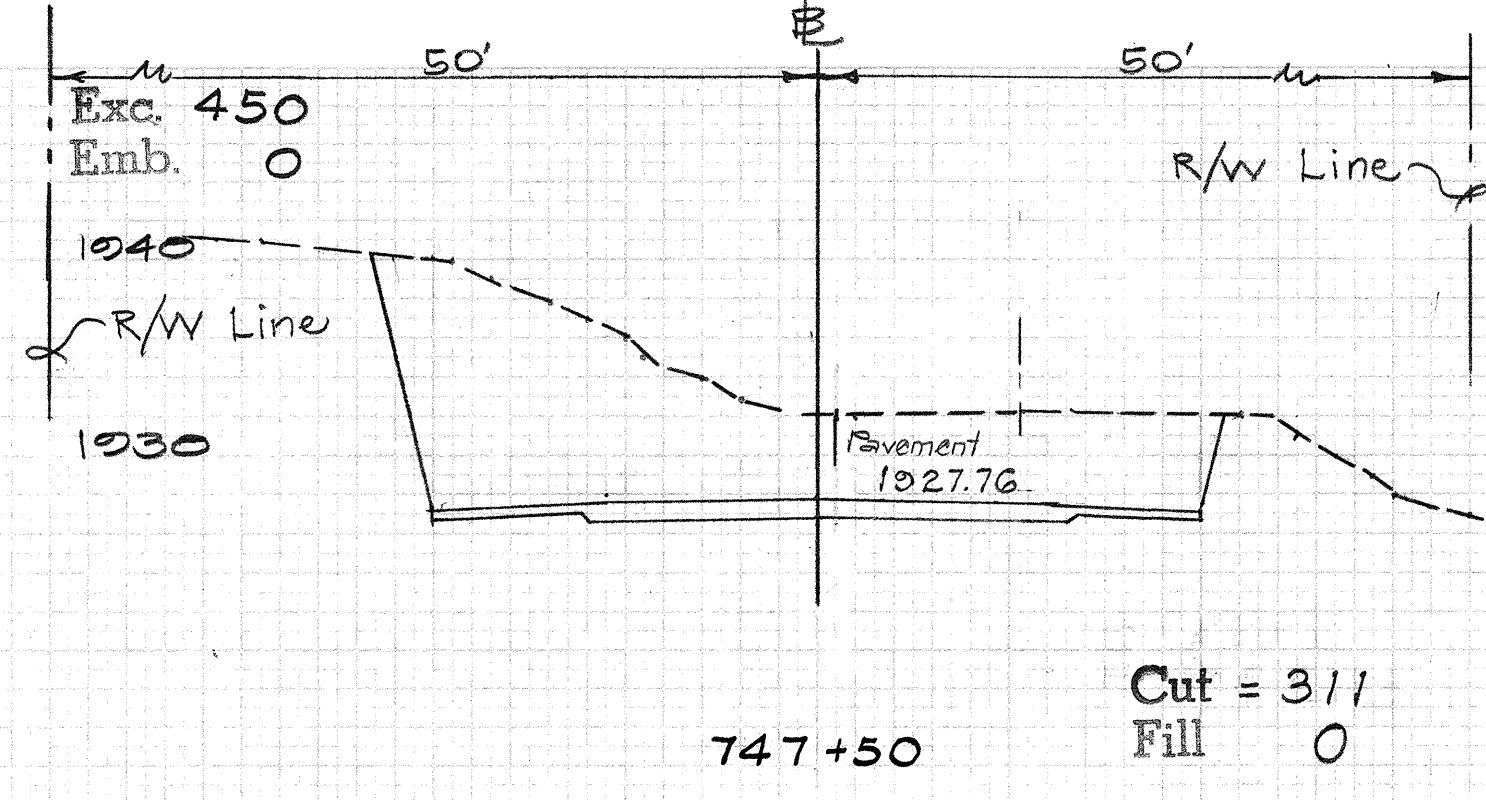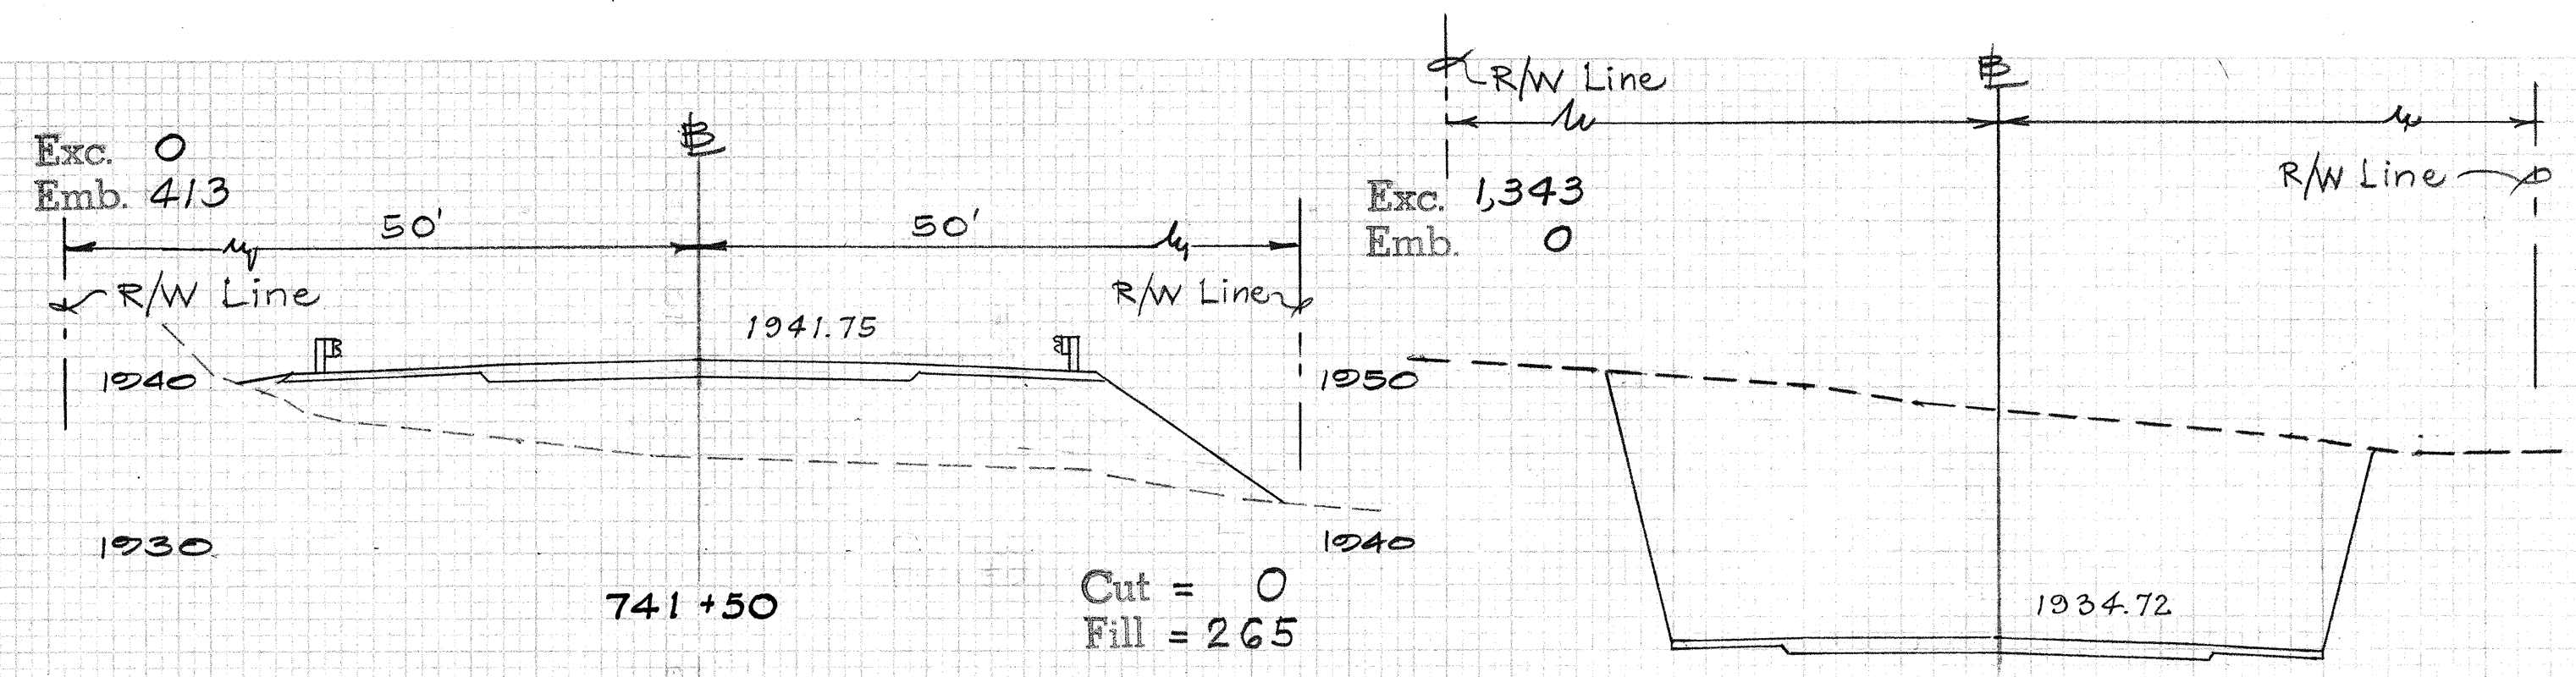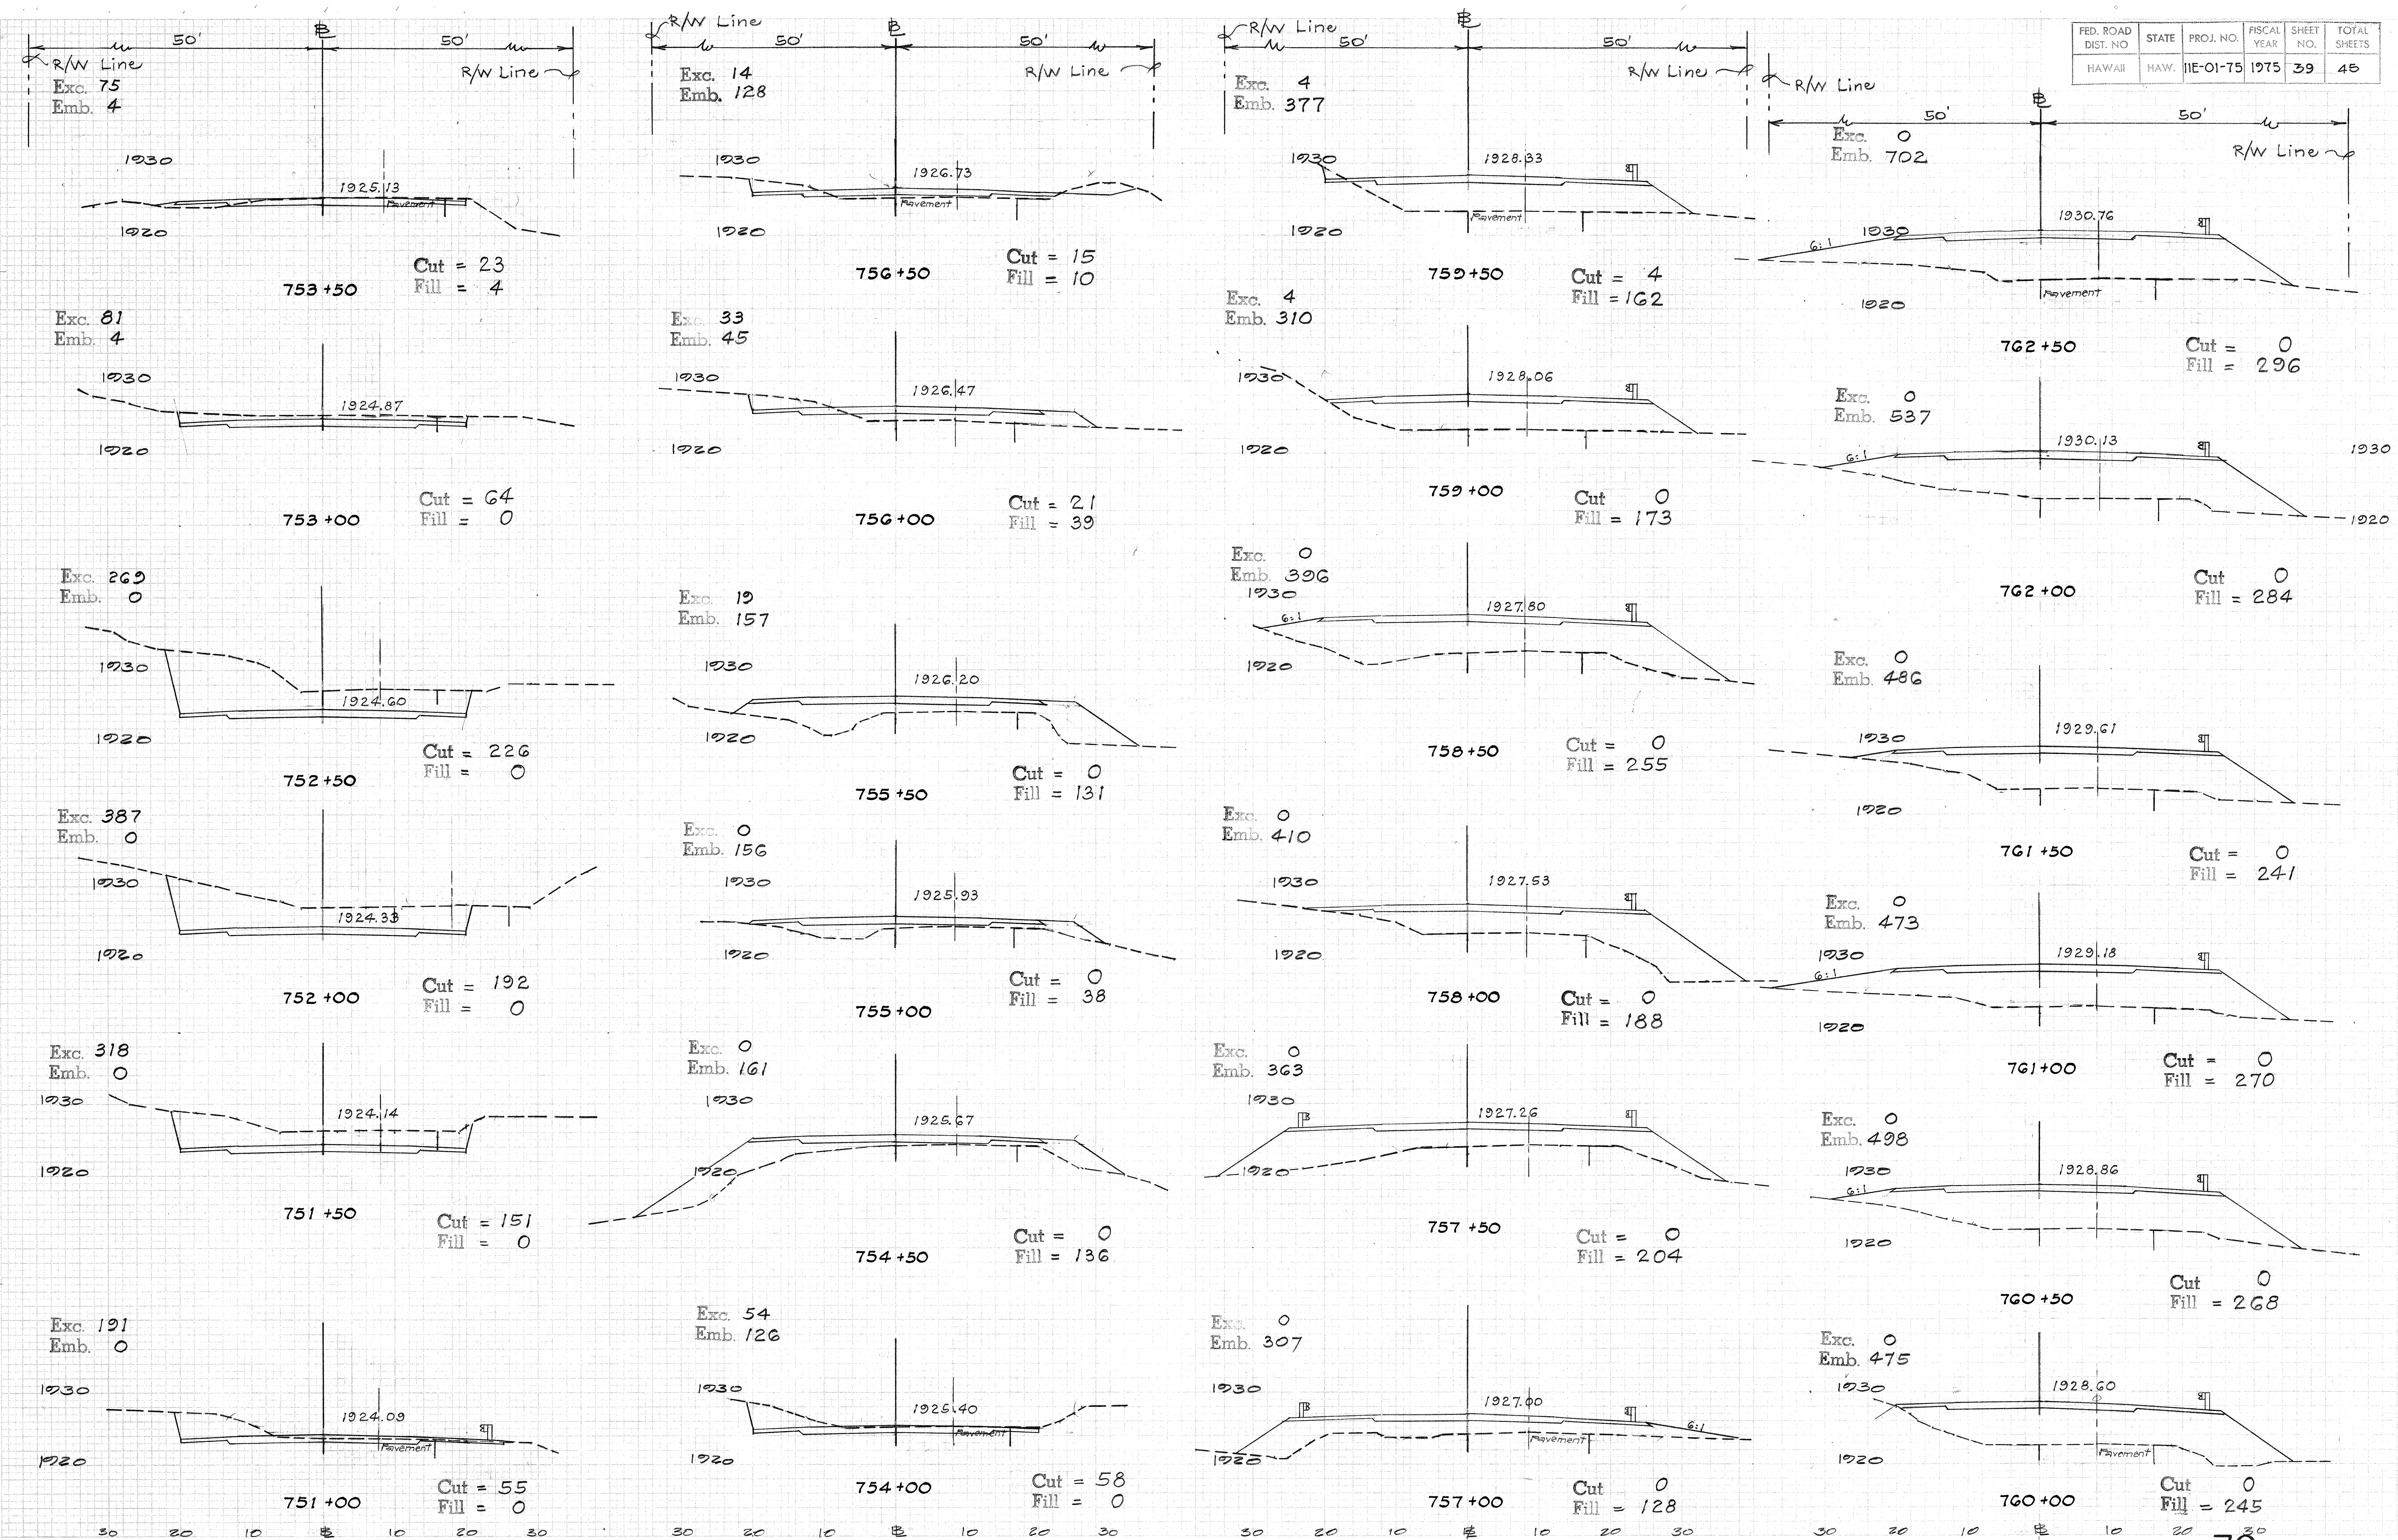

























DATE
BY
SURVEY
PLOTTER
NOTE BOOK
AREAS CHECKED

DATE
BY
SURVEY
PLOTTER
NOTE BOOK
AREAS CHECKED
























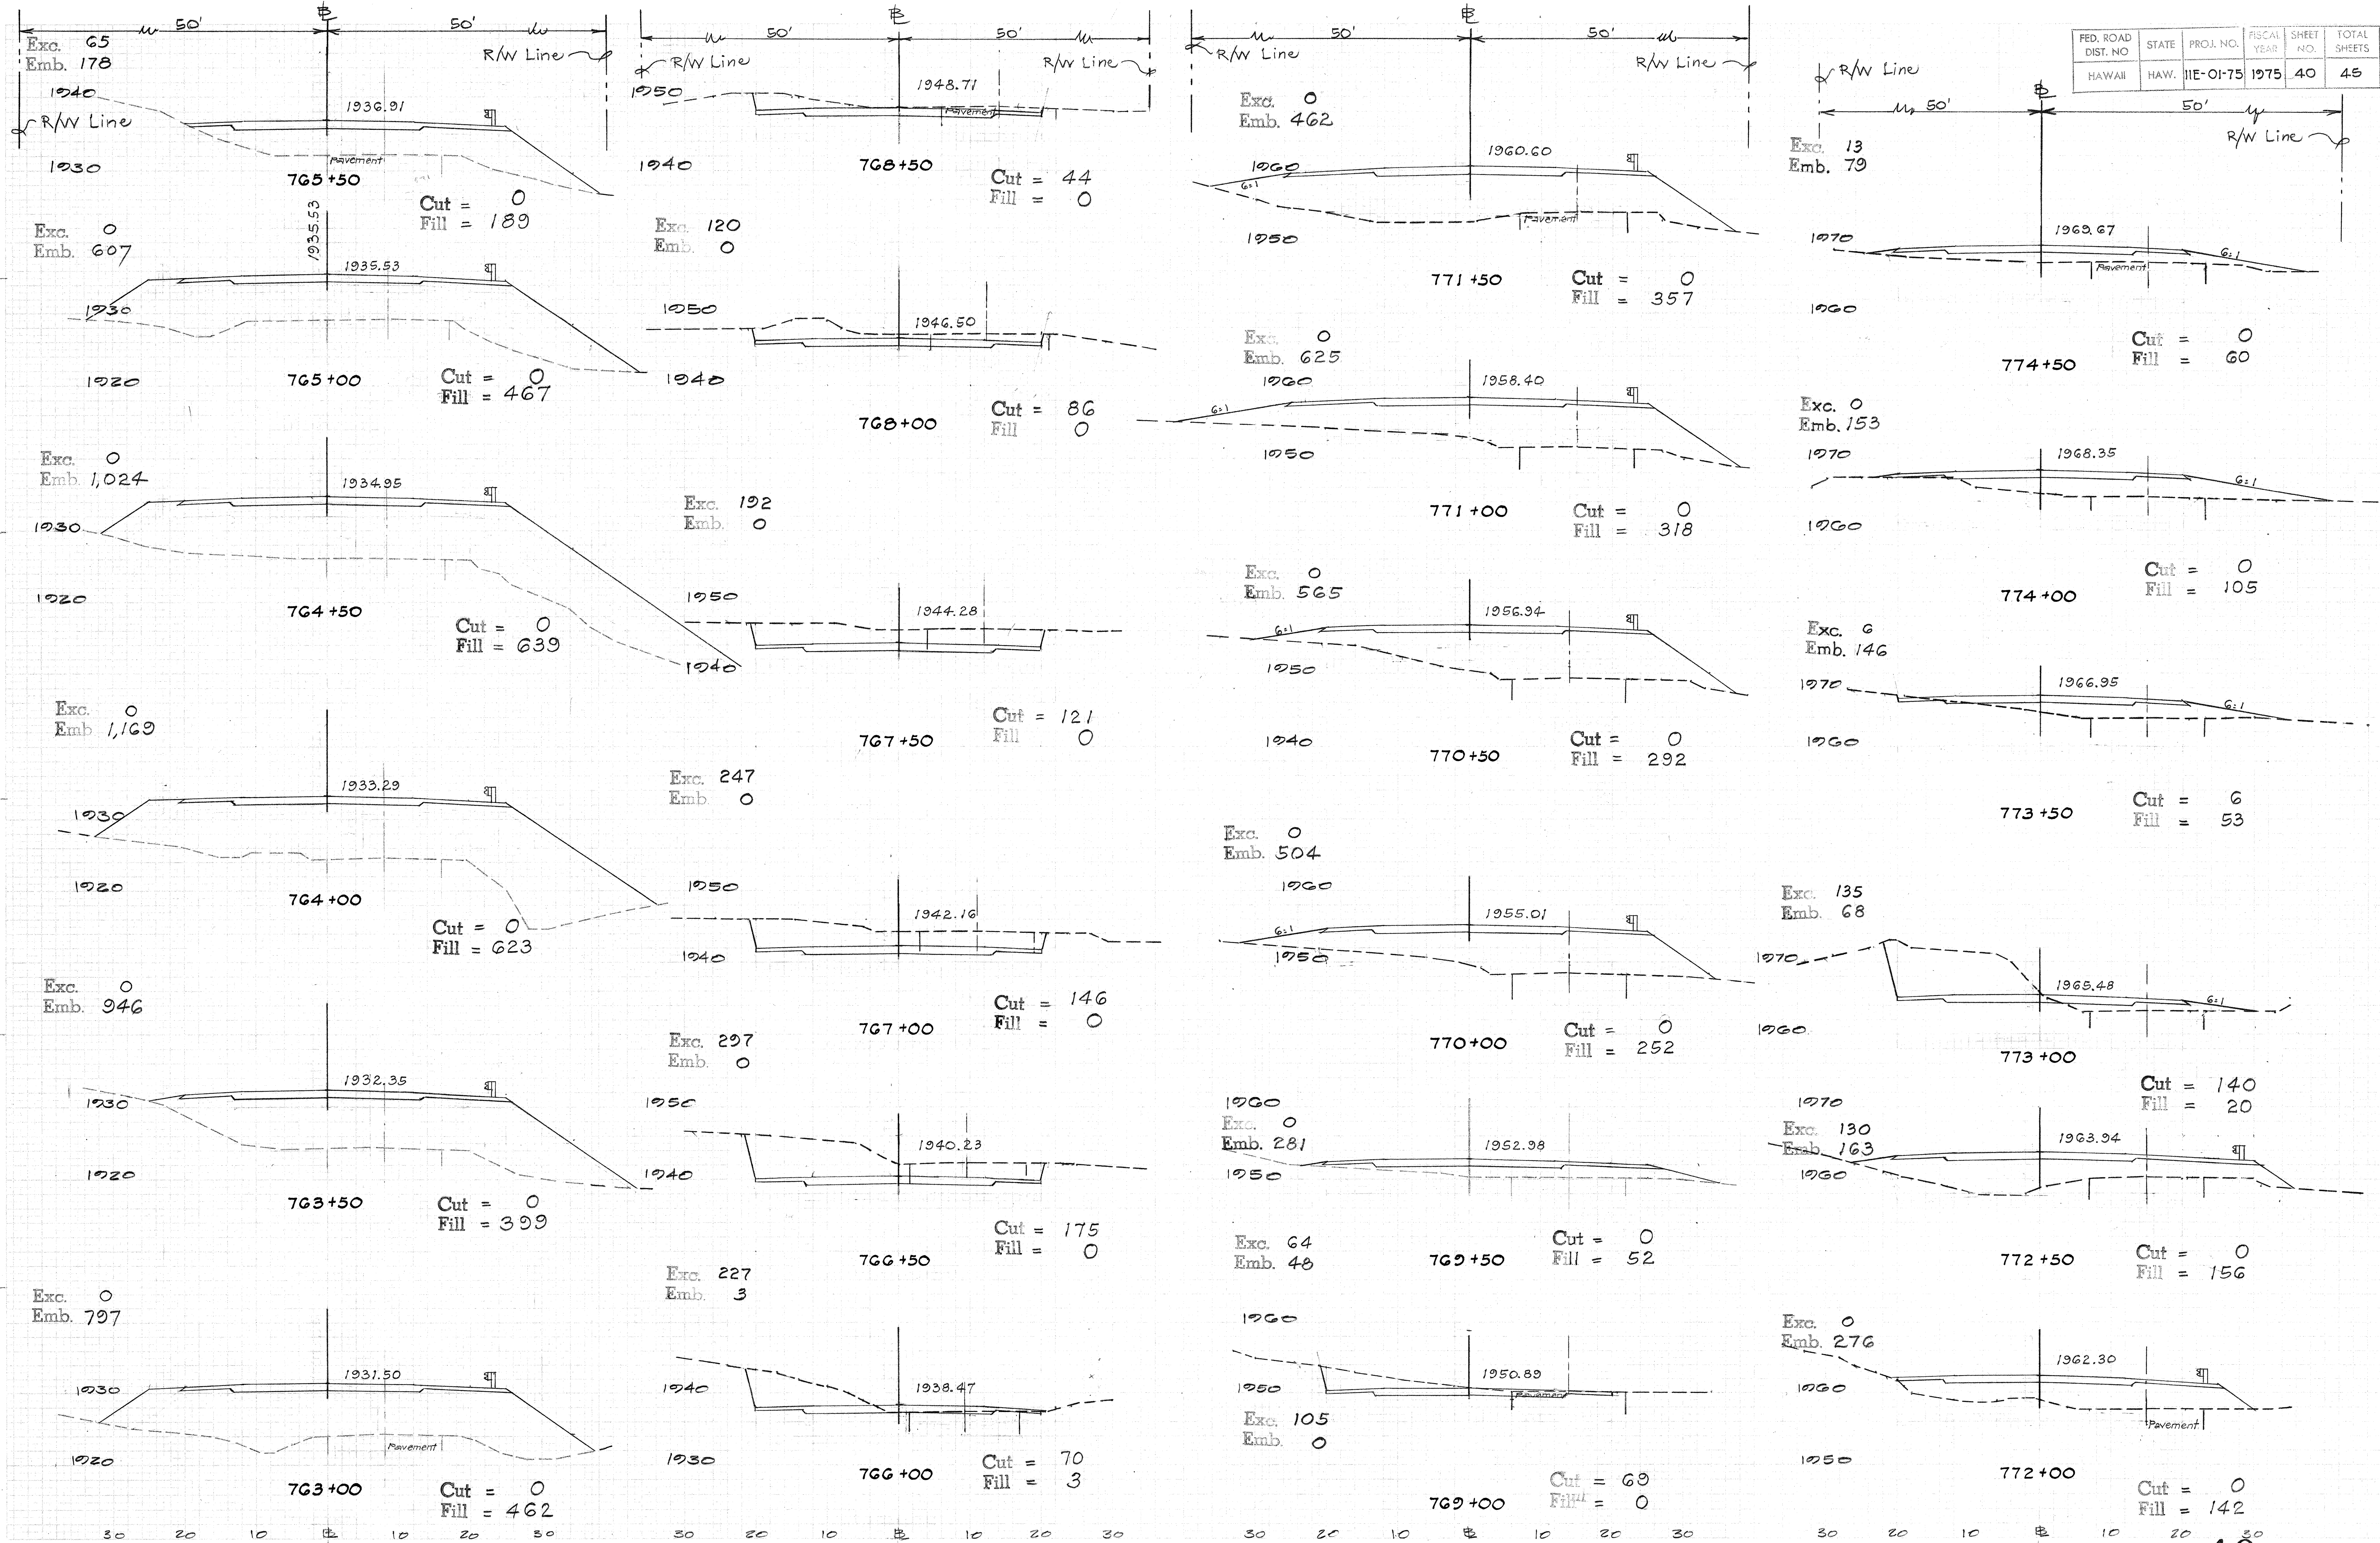


FED. ROAD DIST. NO.	STATE	PROJ. NO.	FISCAL YEAR	SHEET NO.	TOTAL SHEETS
HAWAII	HAW.	11E-01-75	1975	40	45

























FED. ROAD DIST. NO.	STATE	PROJ. NO.	FISCAL YEAR	SHEET NO.	TOTAL SHEETS
HAWAII	HAW.	11E-01-75	1975	41	45

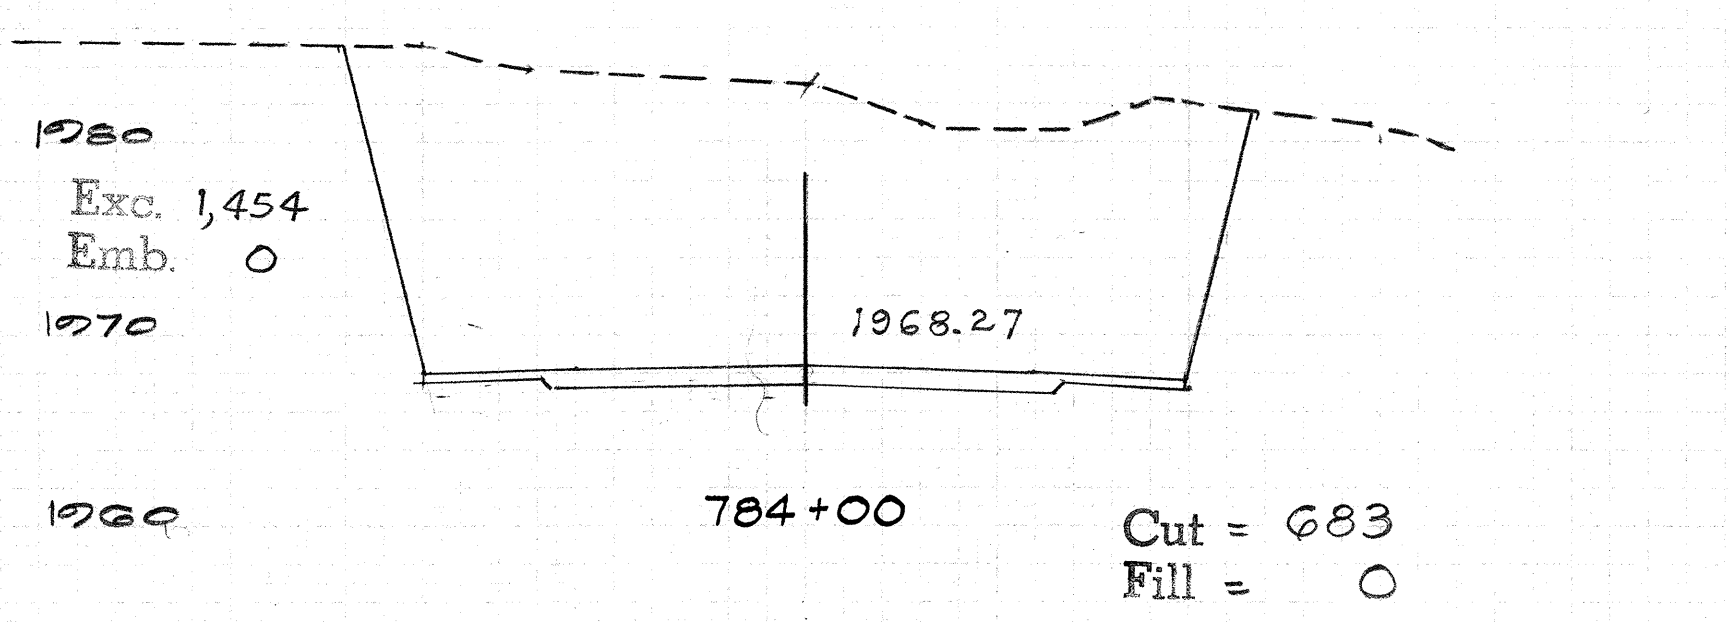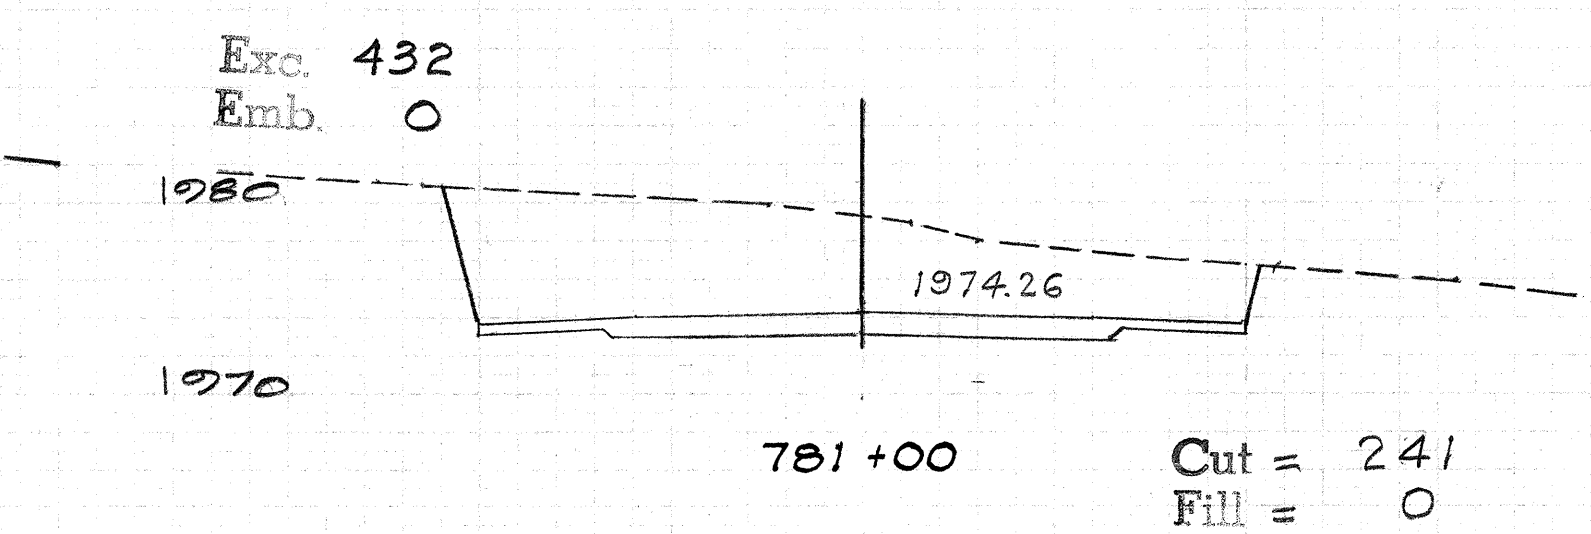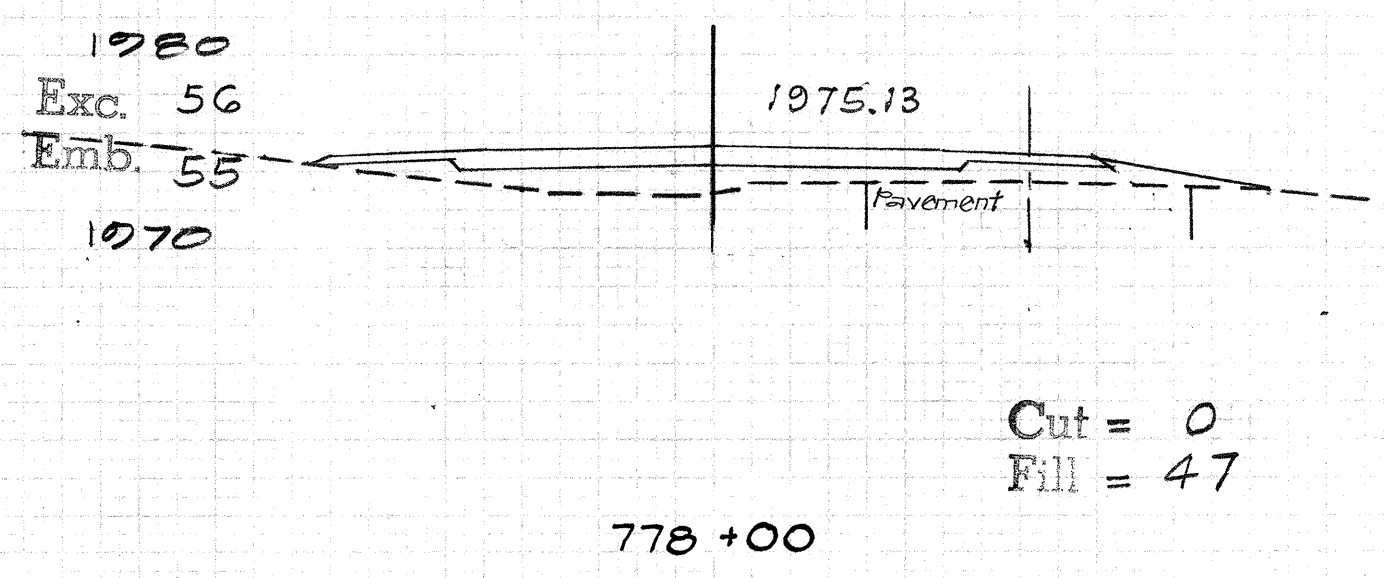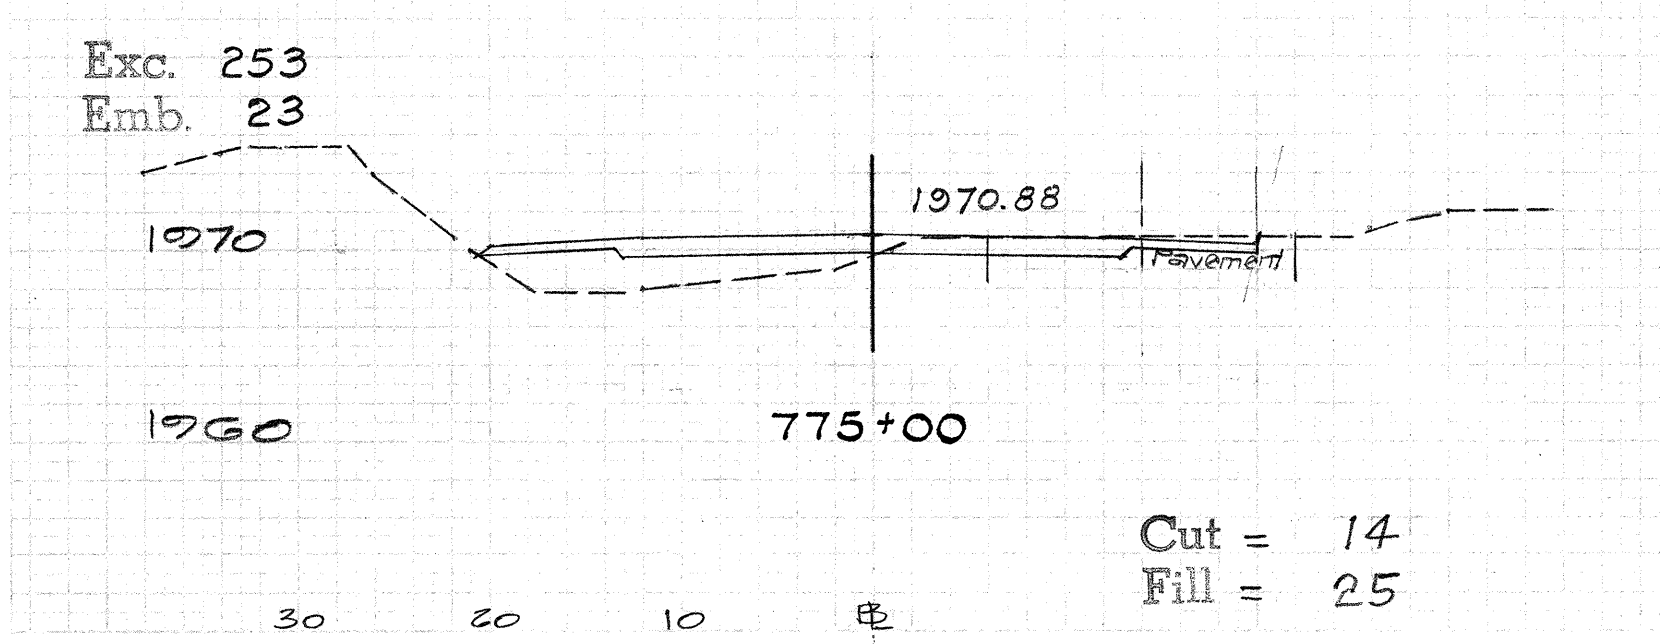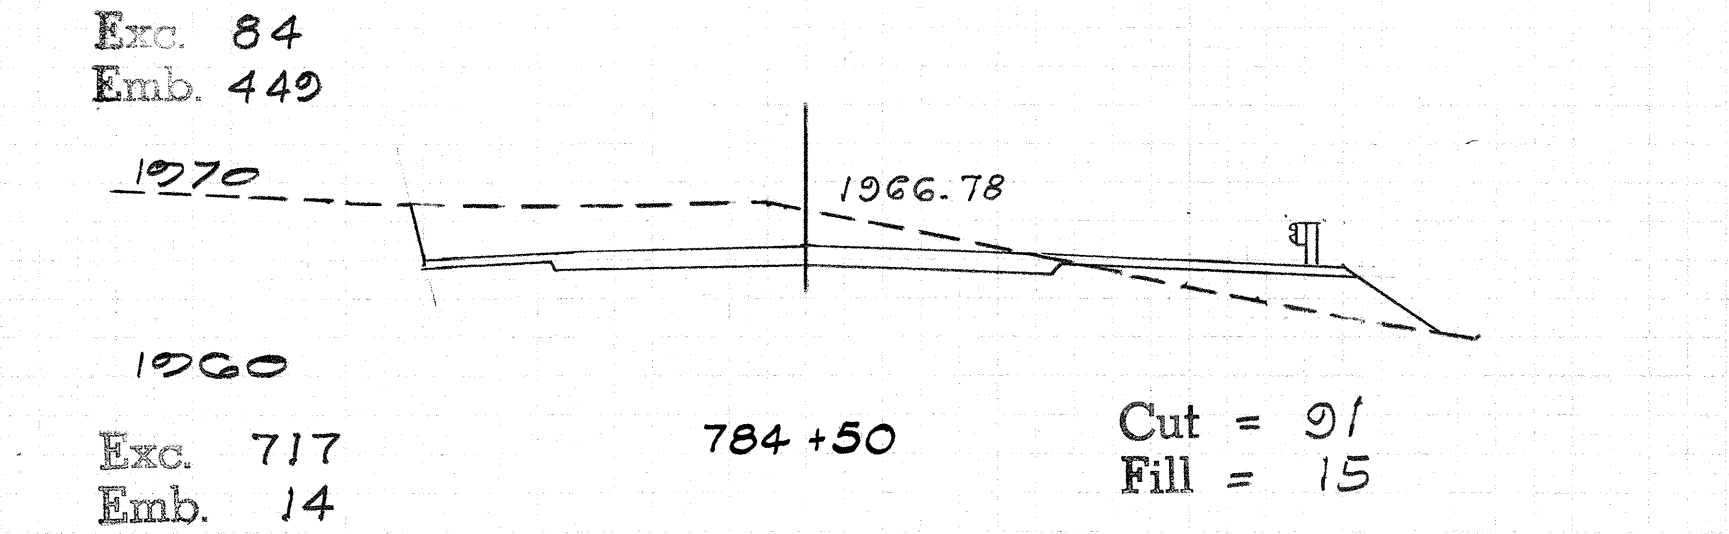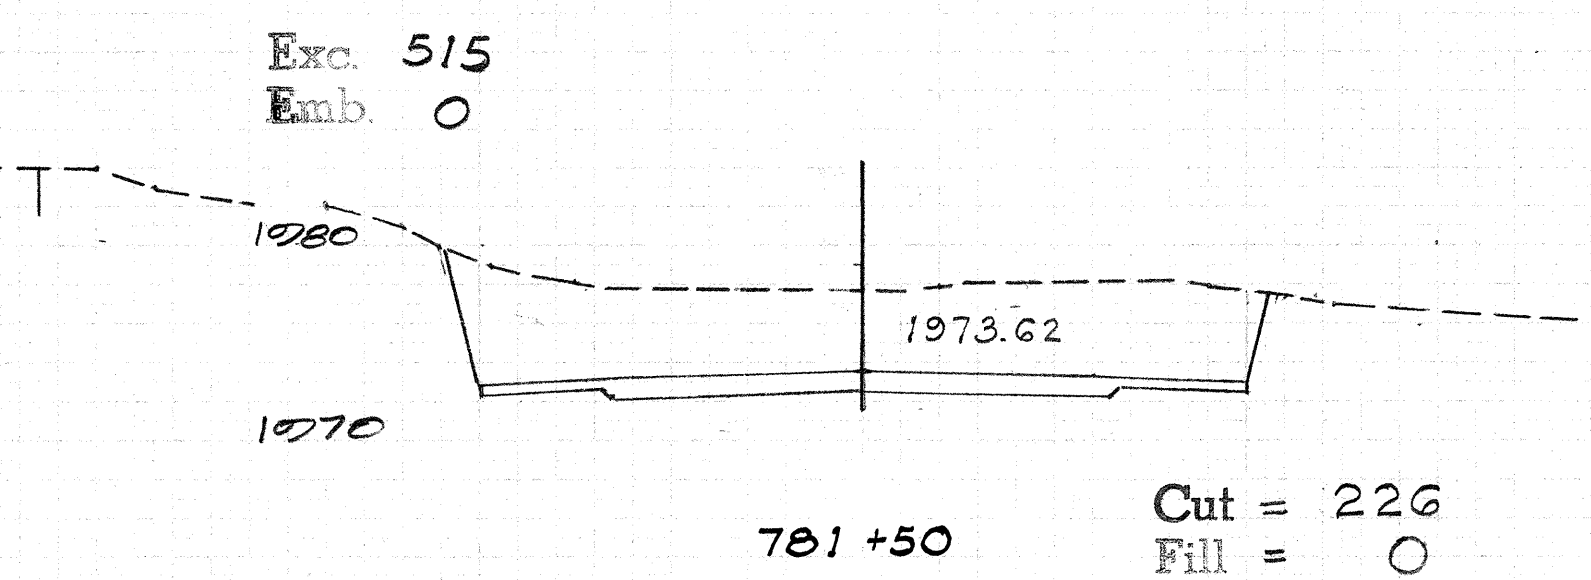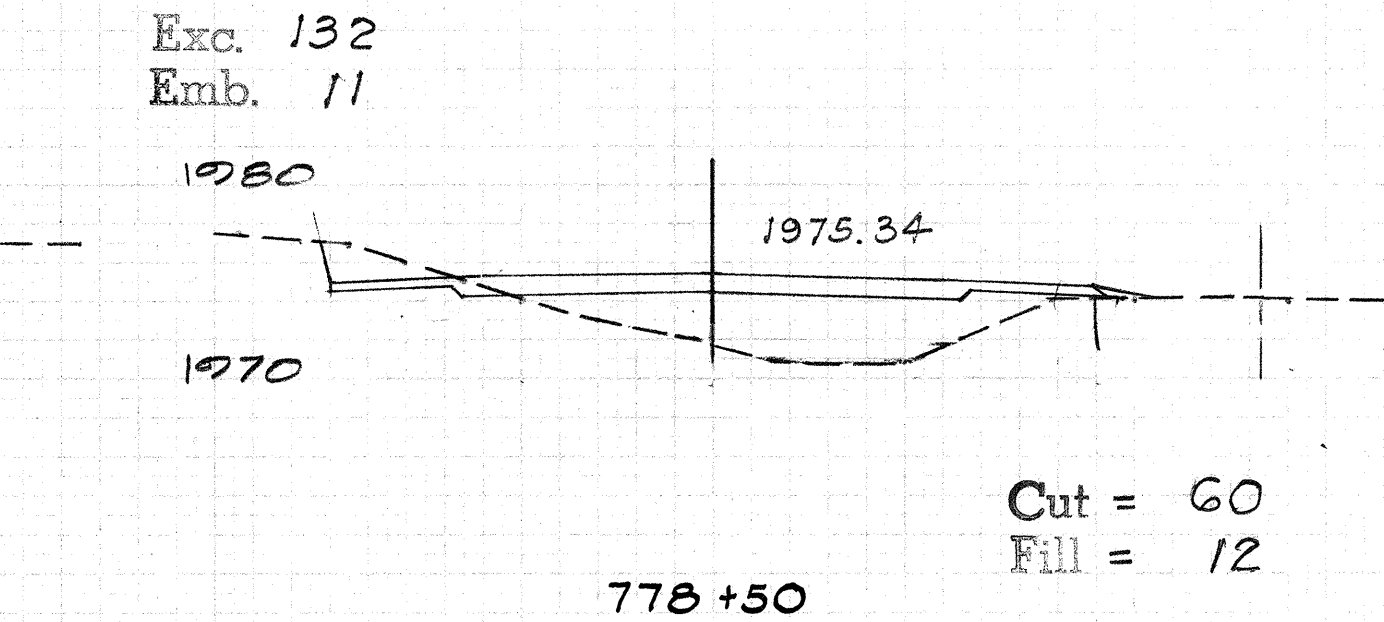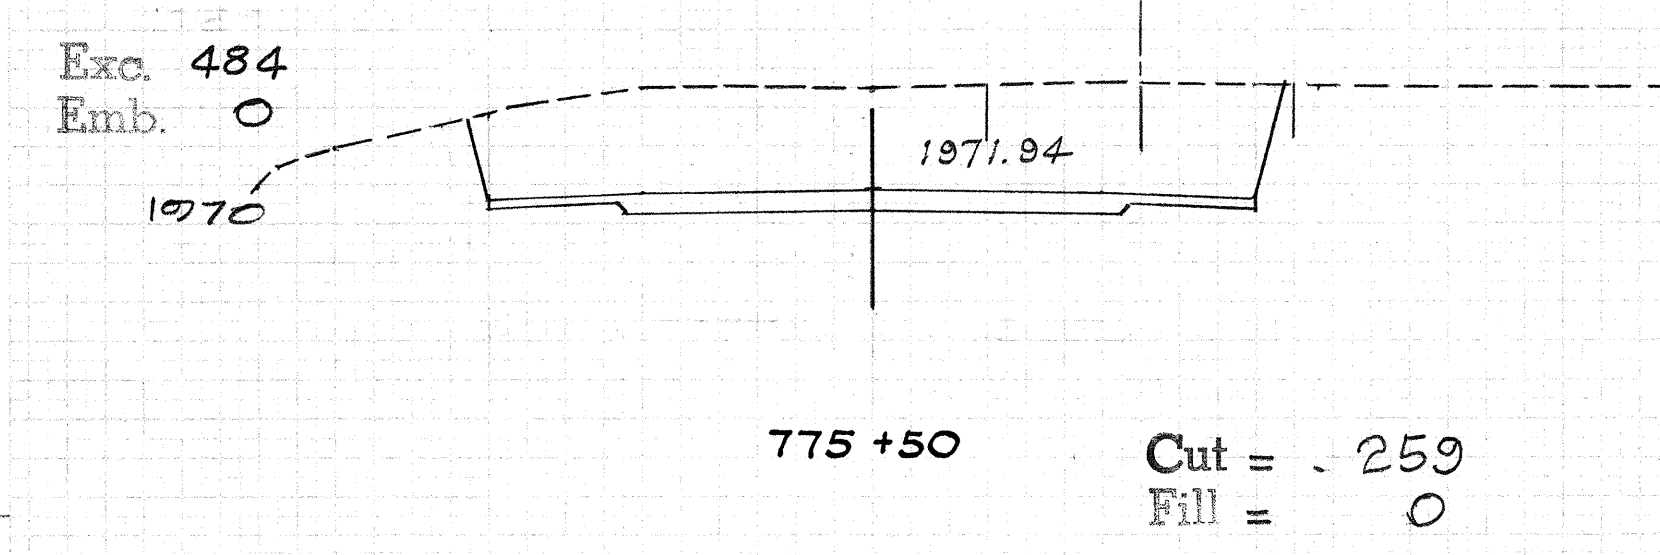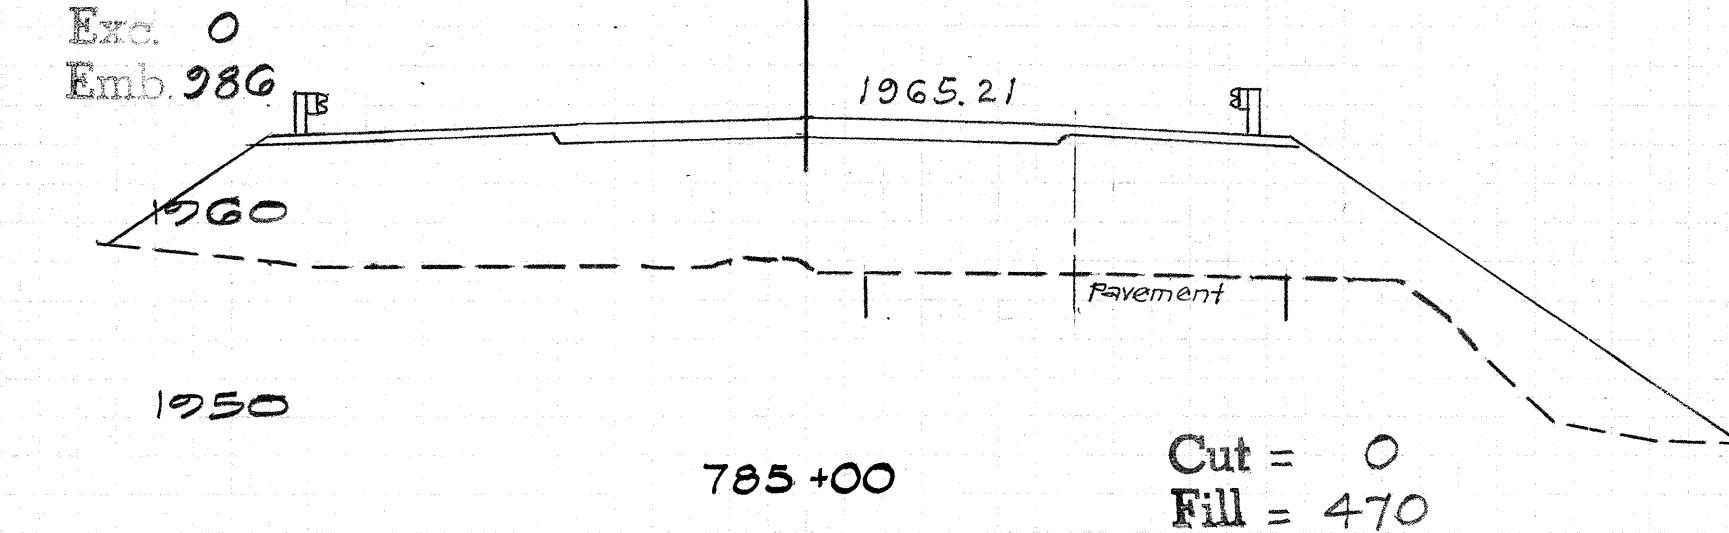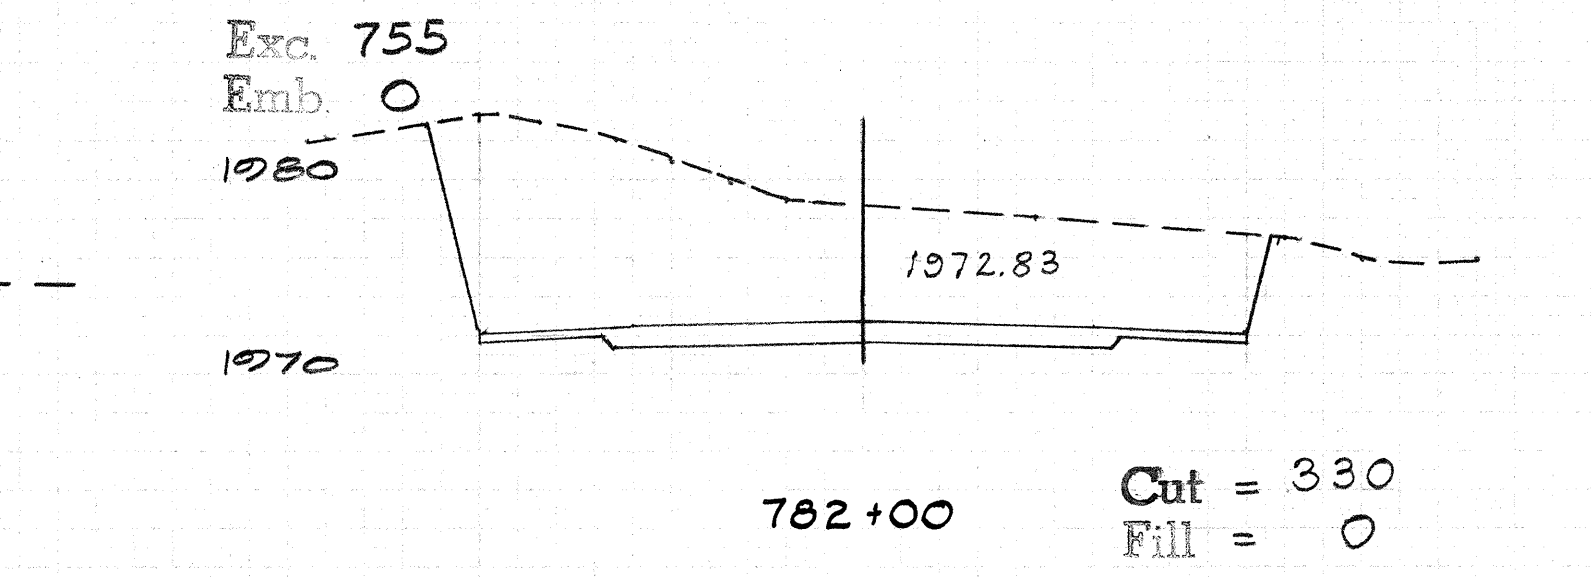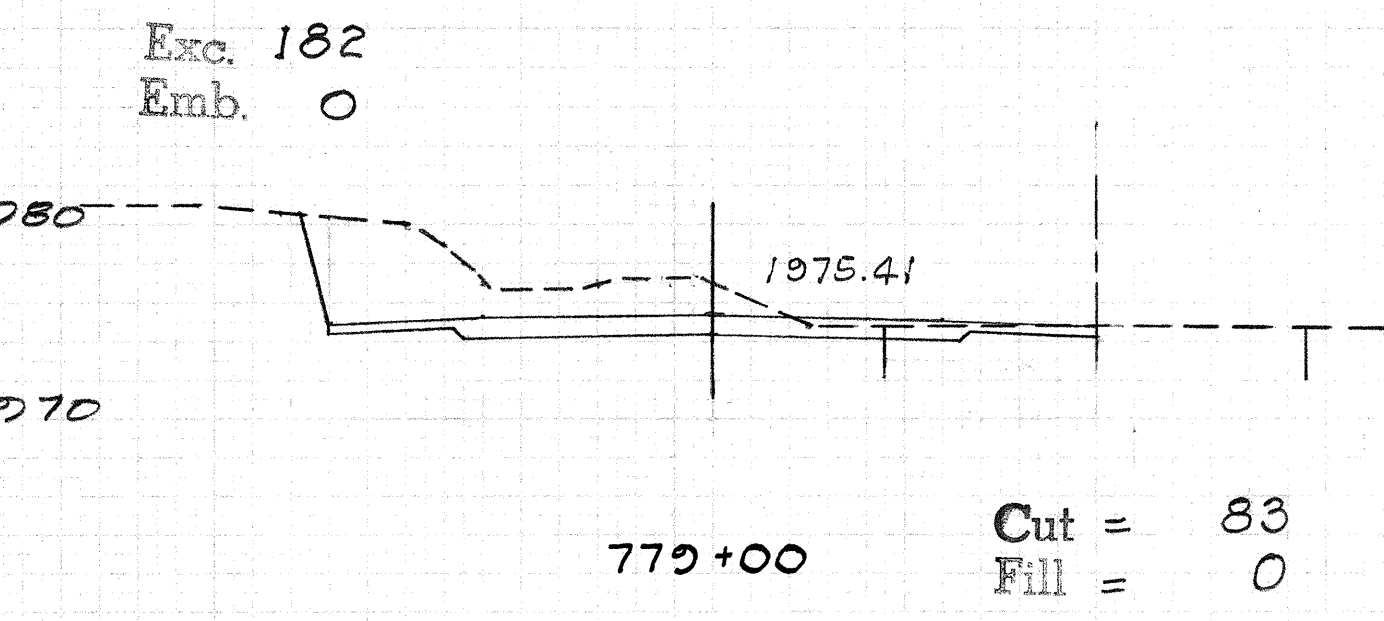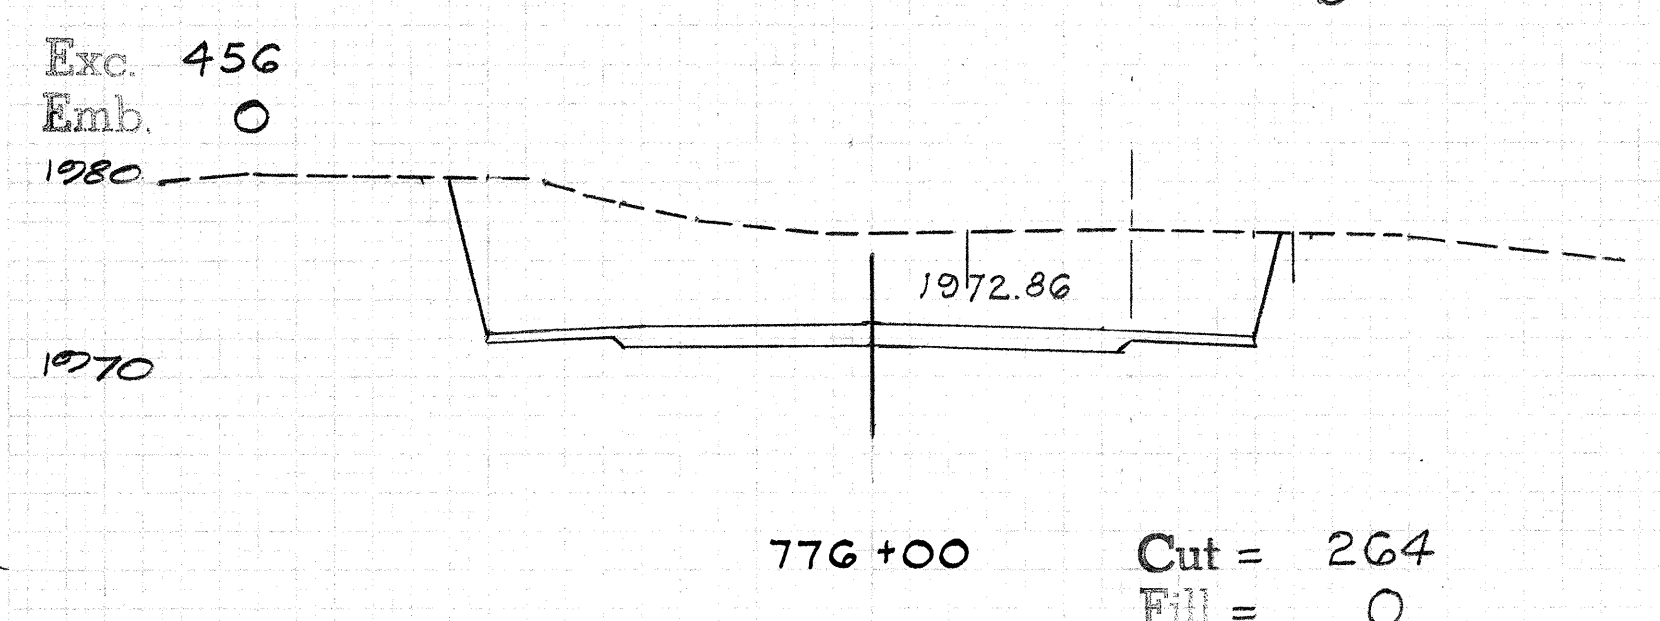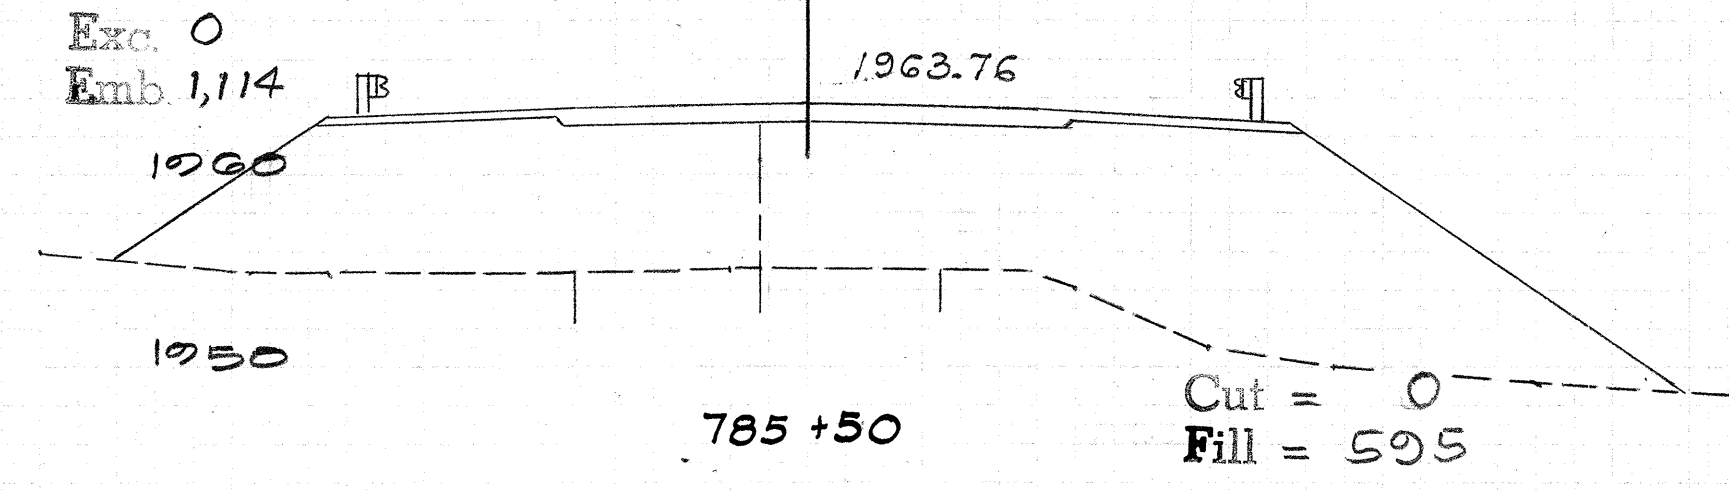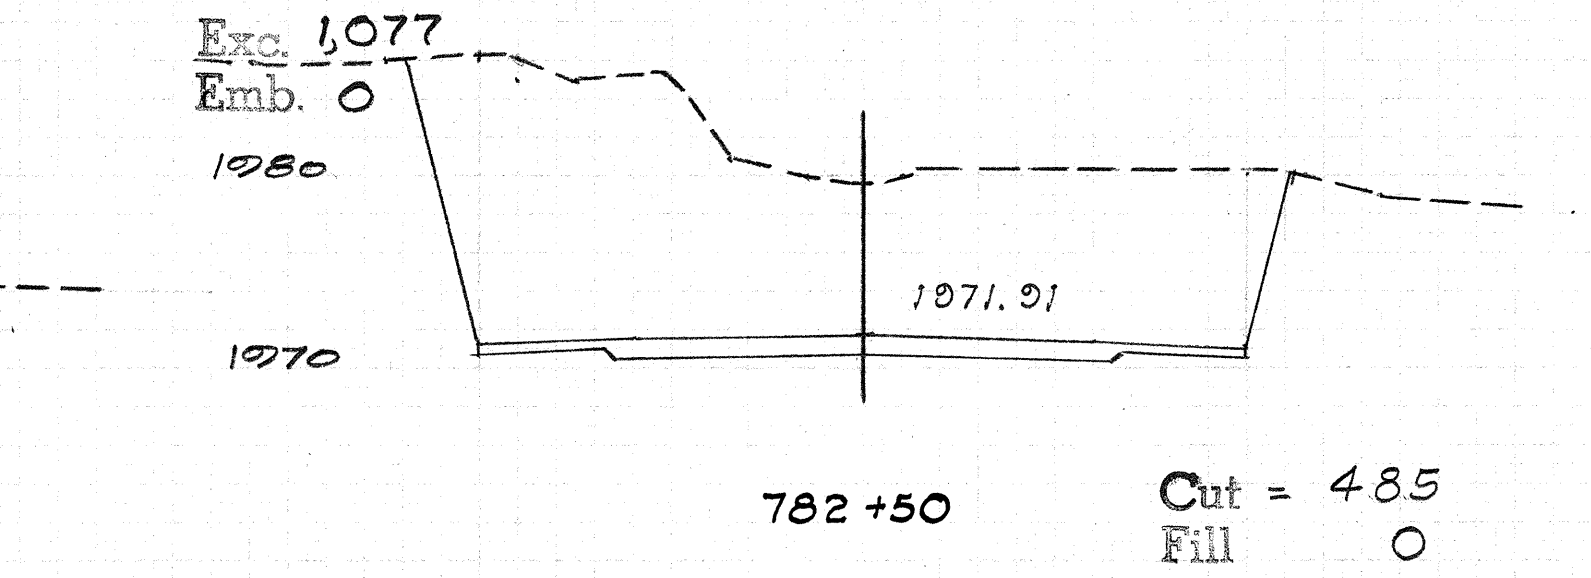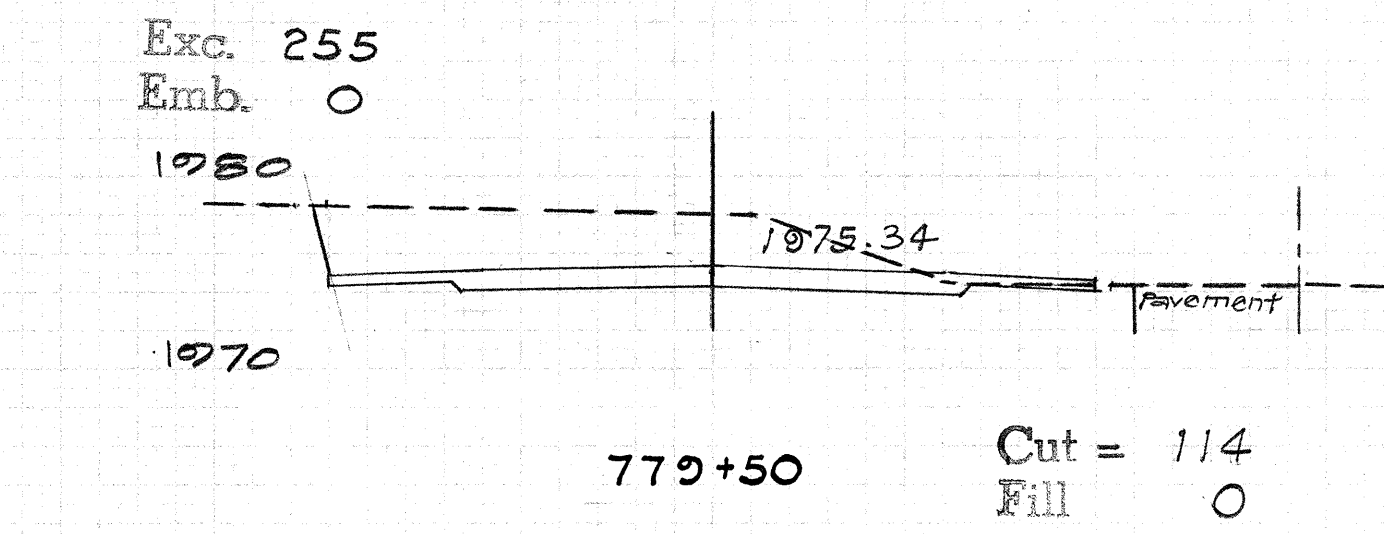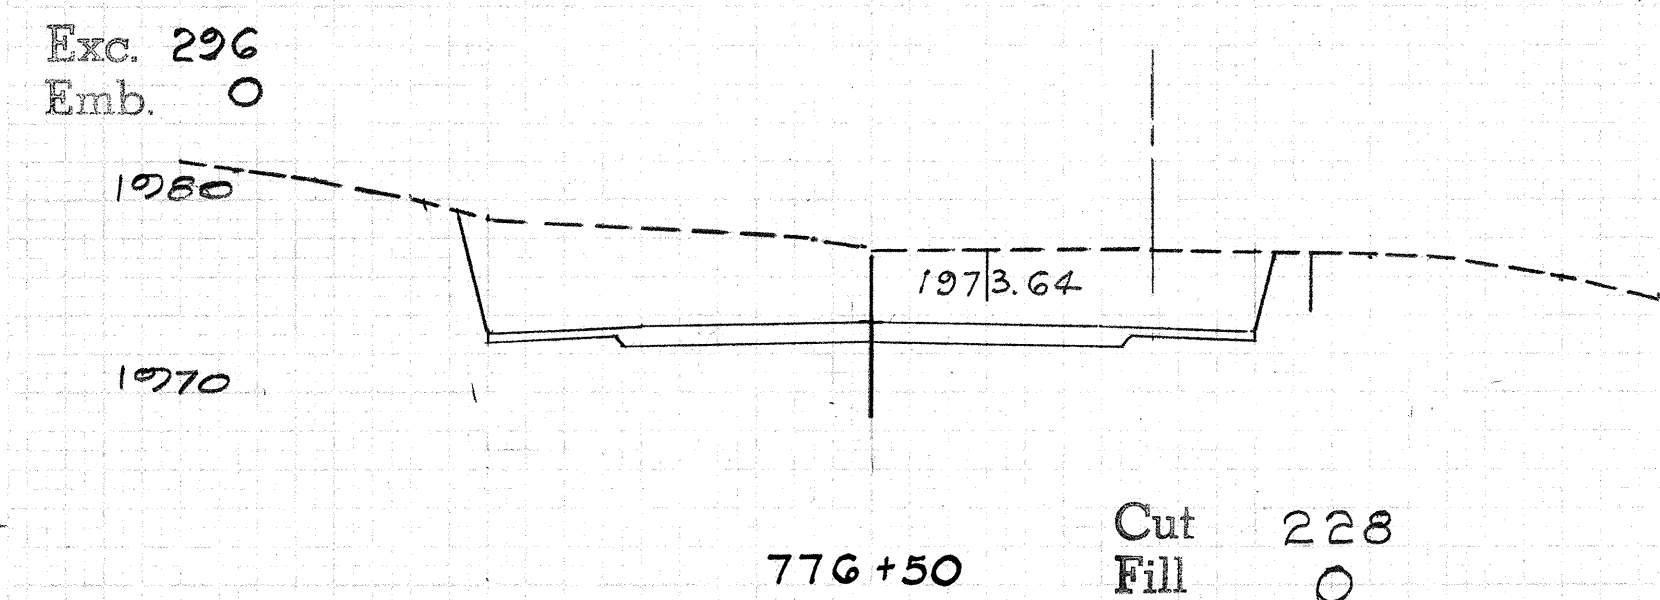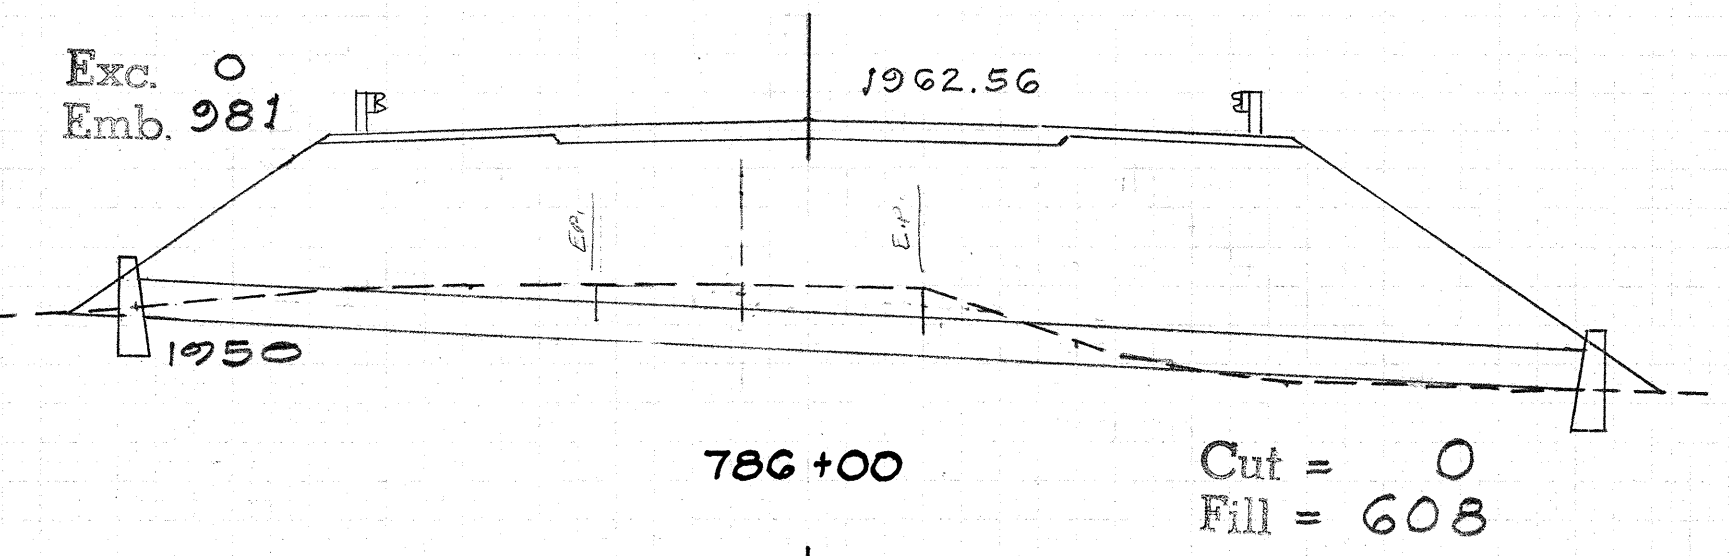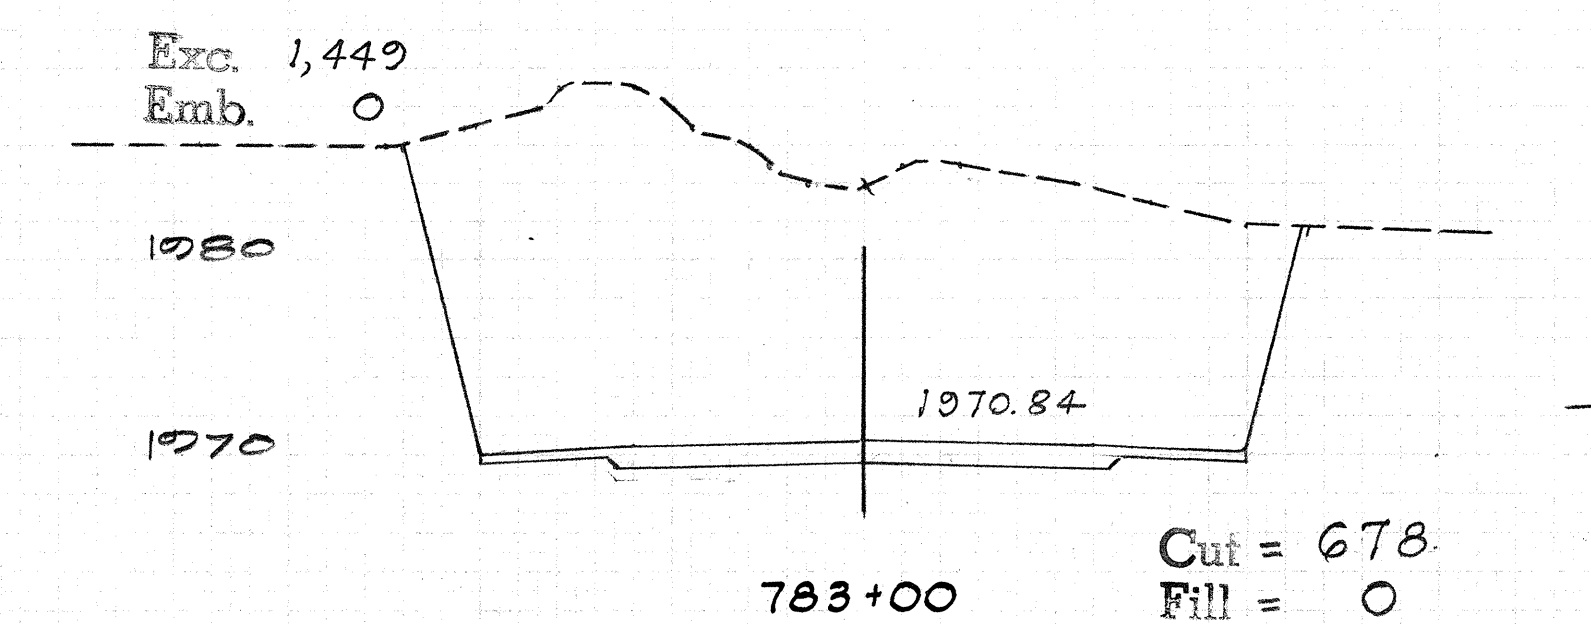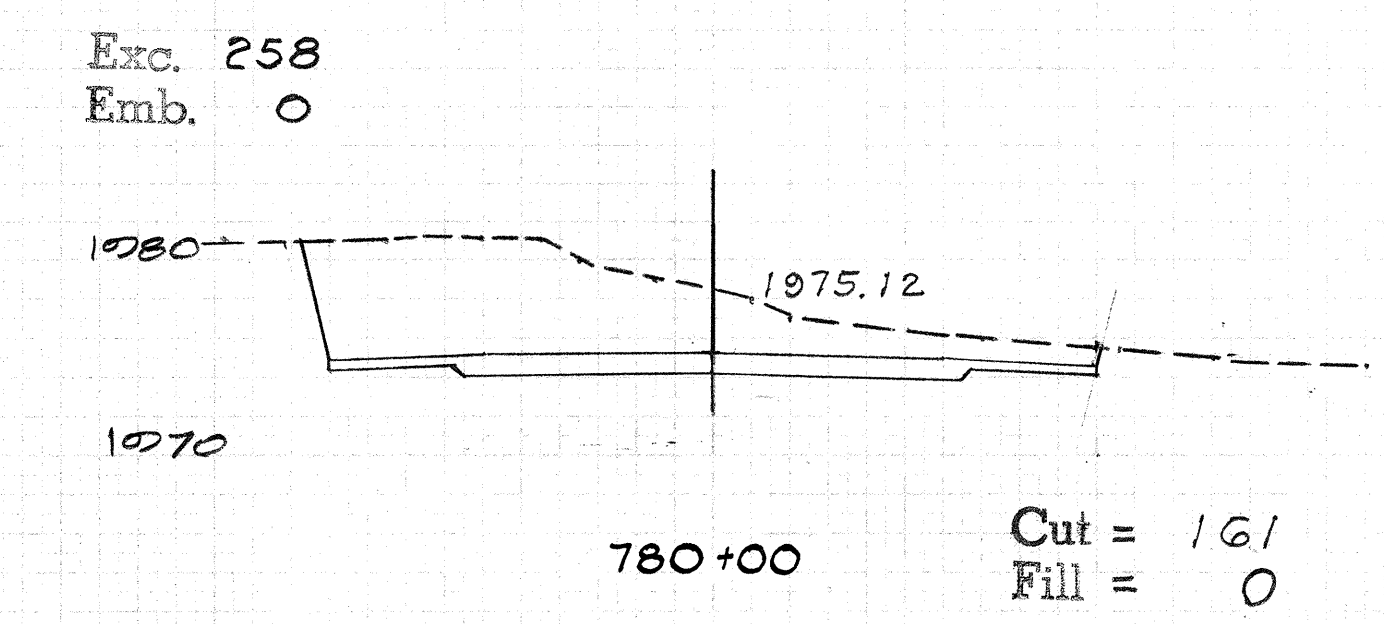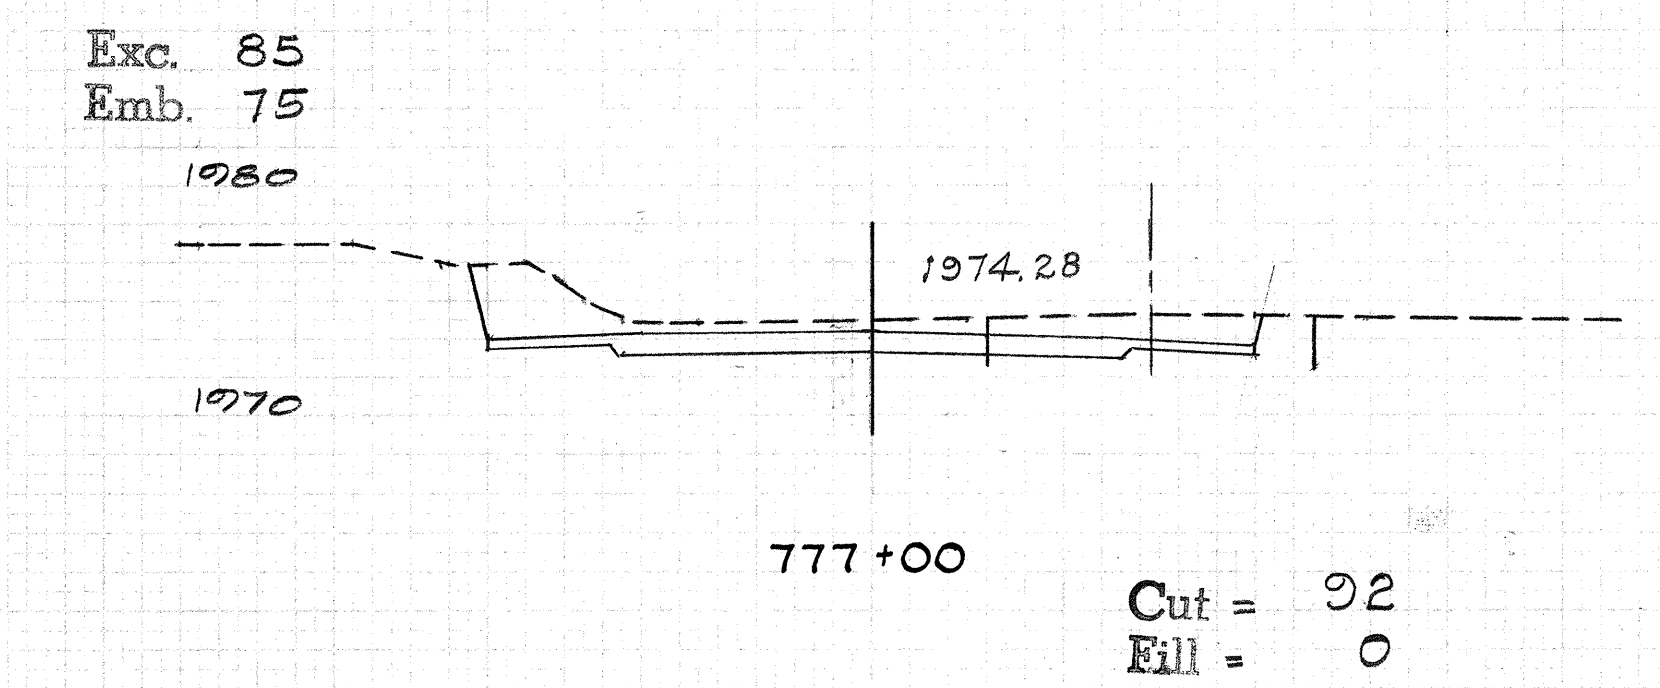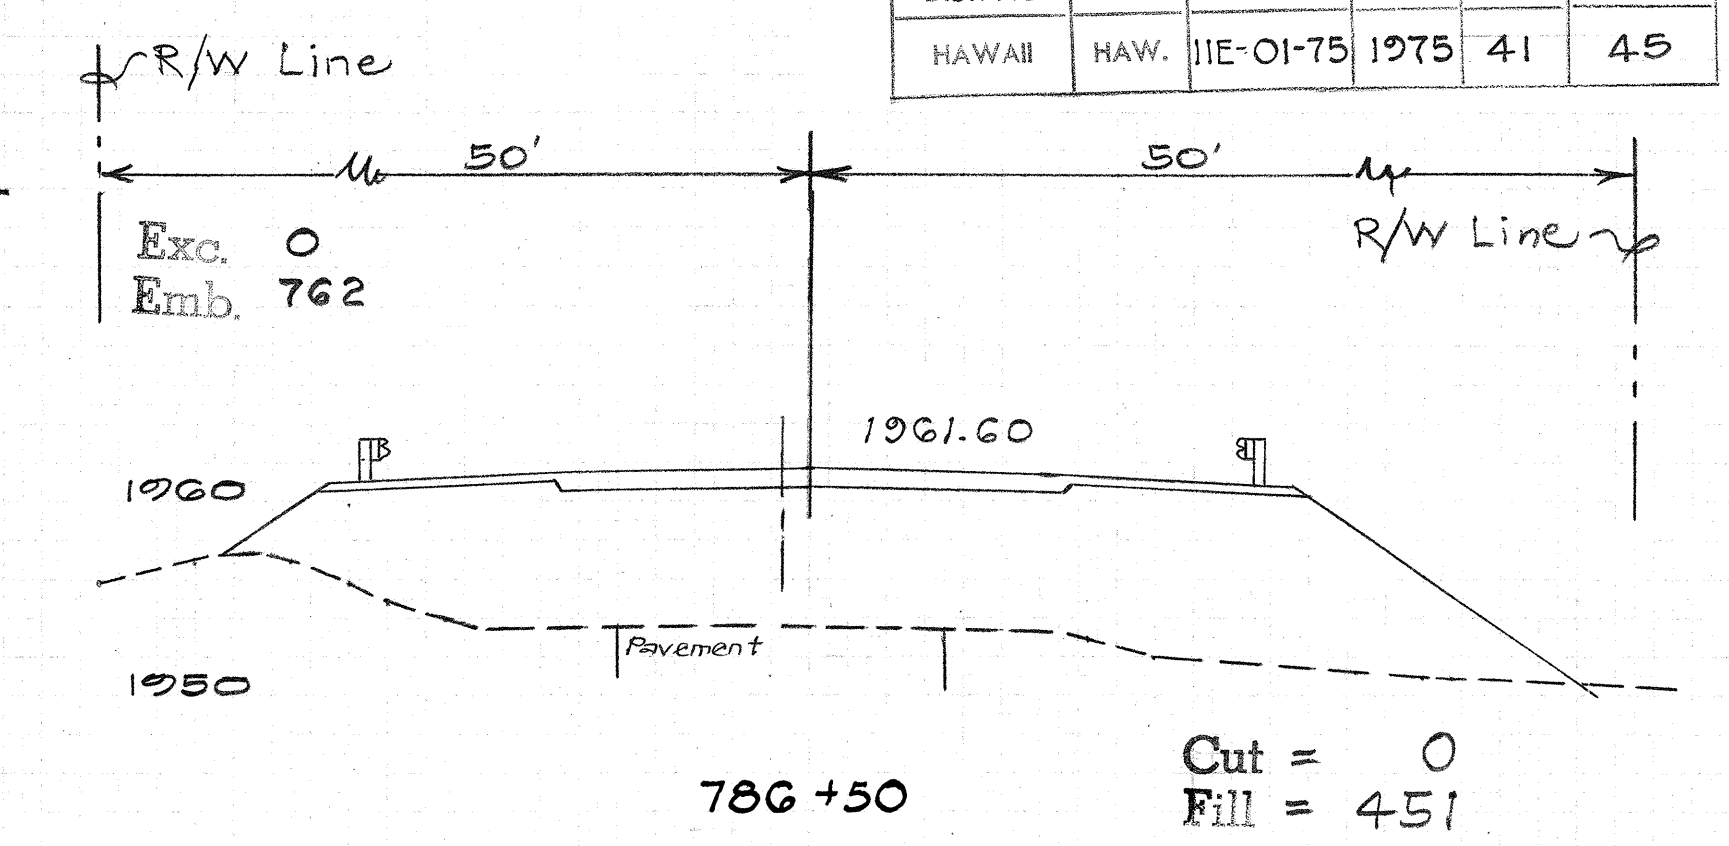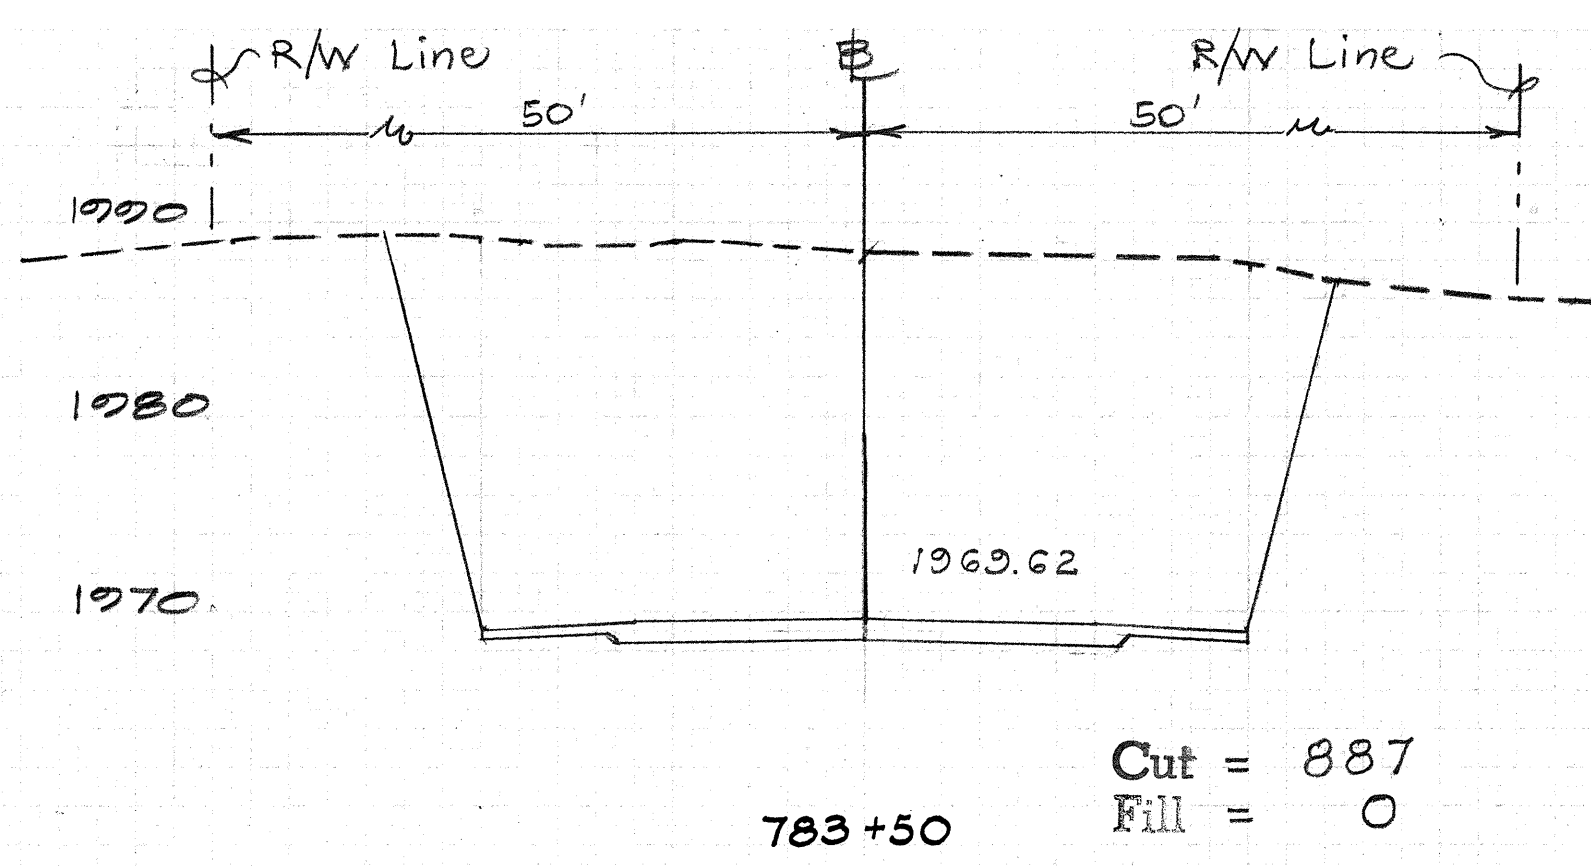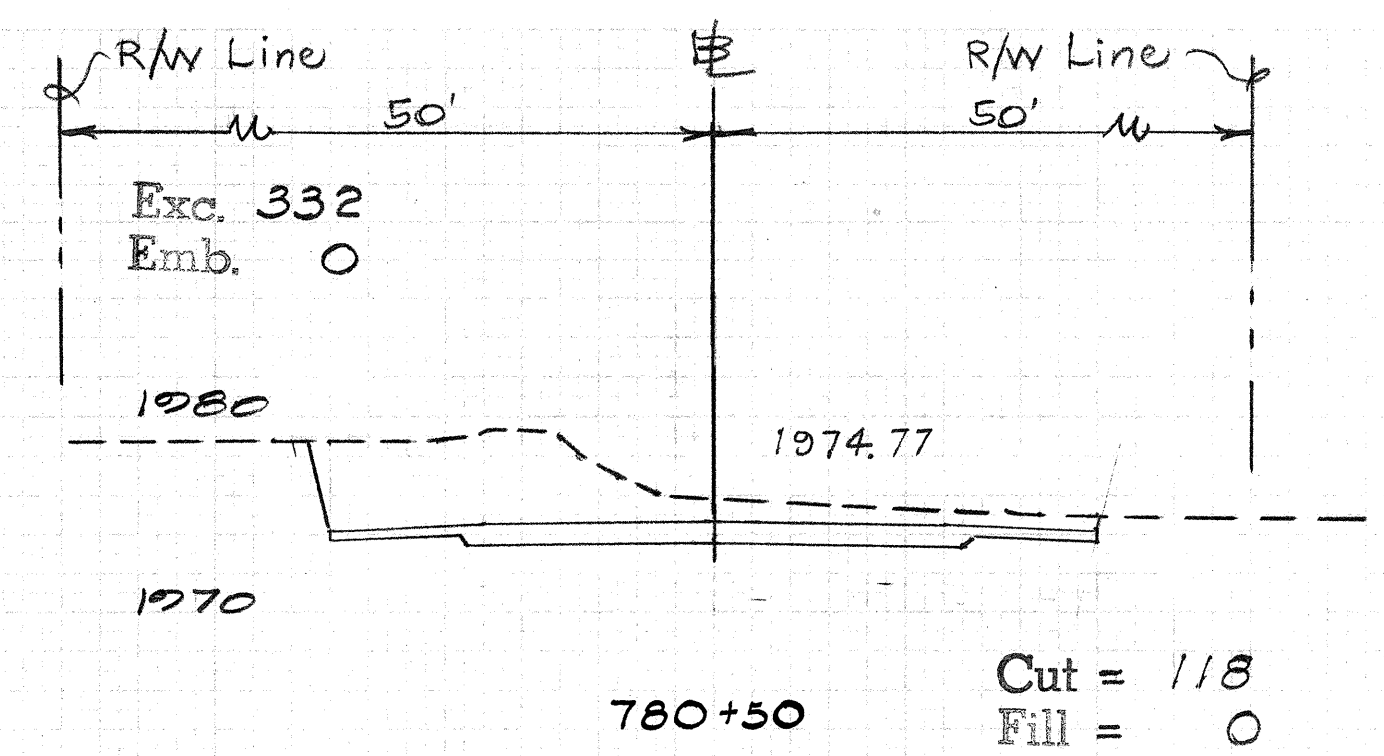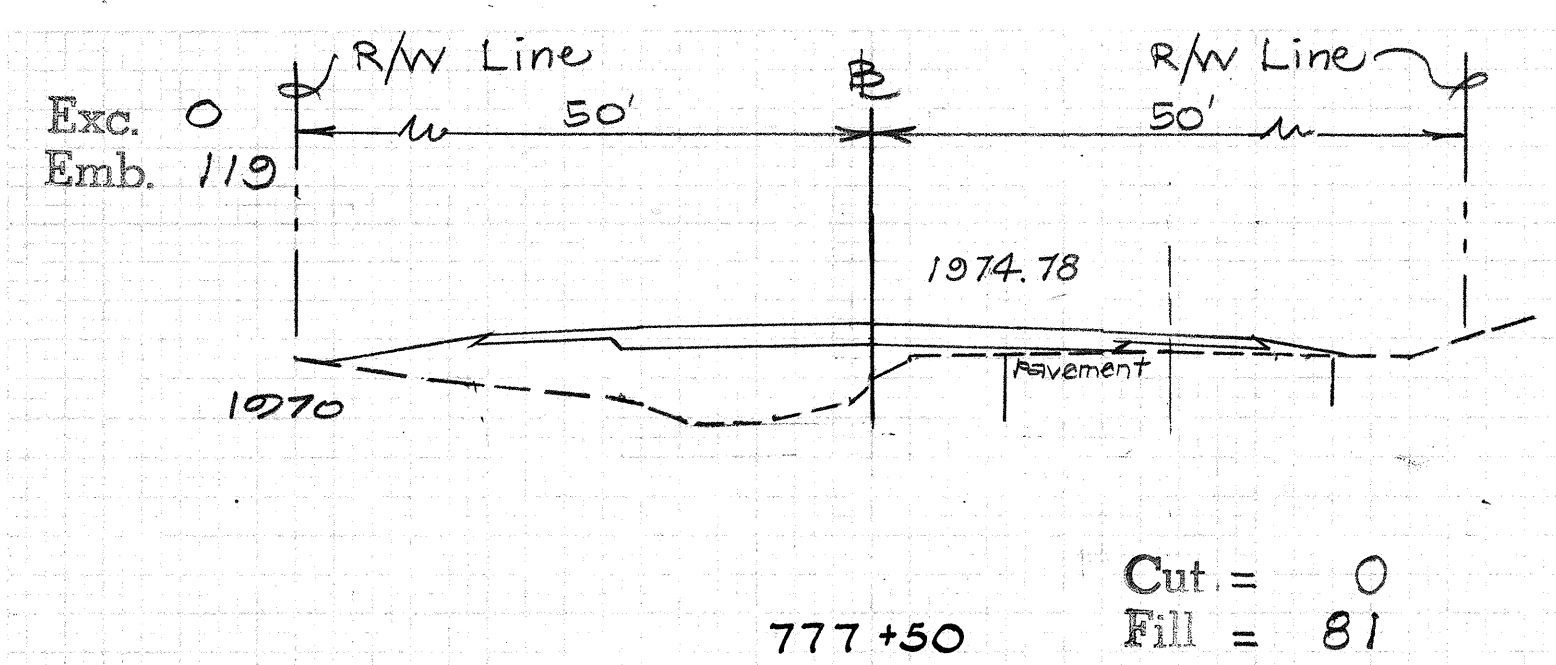

























FED. ROAD DIST. NO.	STATE	PROJ. NO.	FISCAL YEAR	SHEET NO.	TOTAL SHEETS
HAWAII	HAW.	11E-01-75	1975	42	45

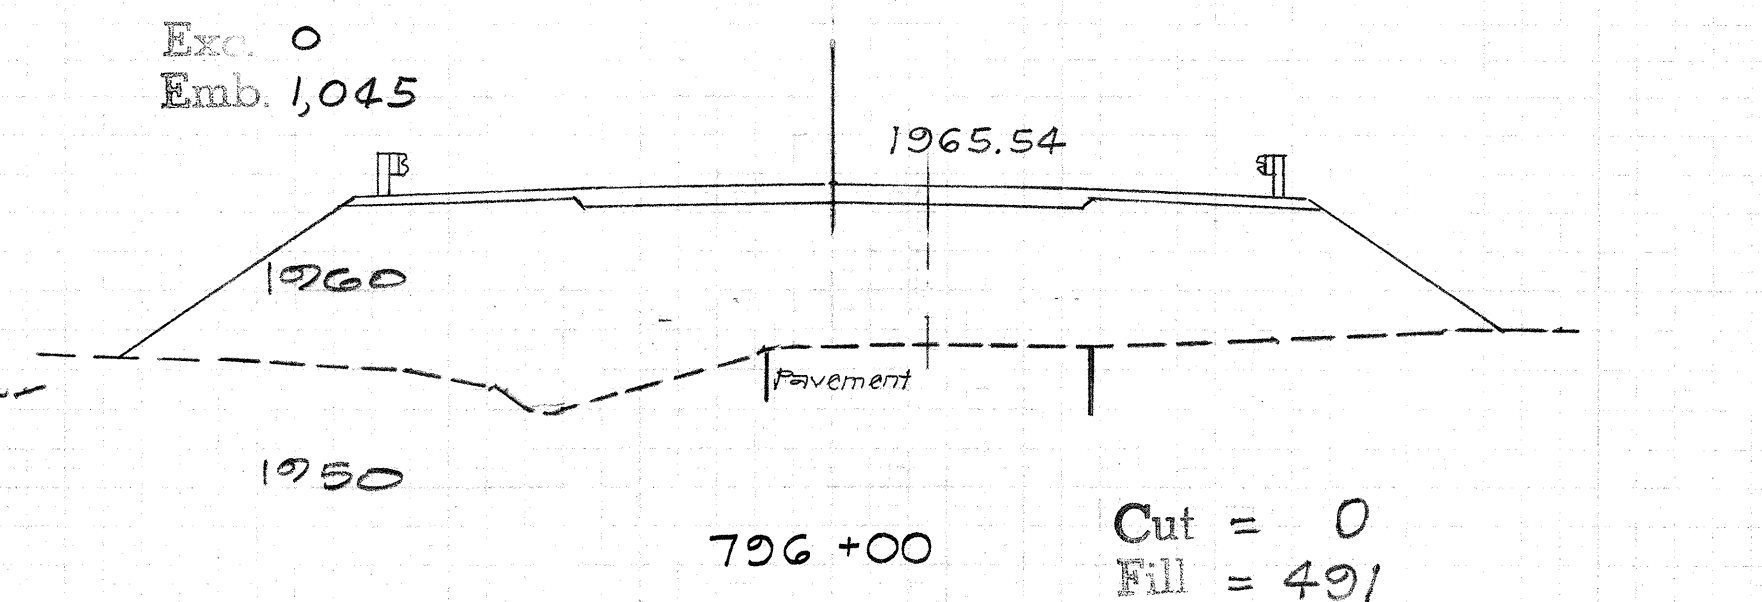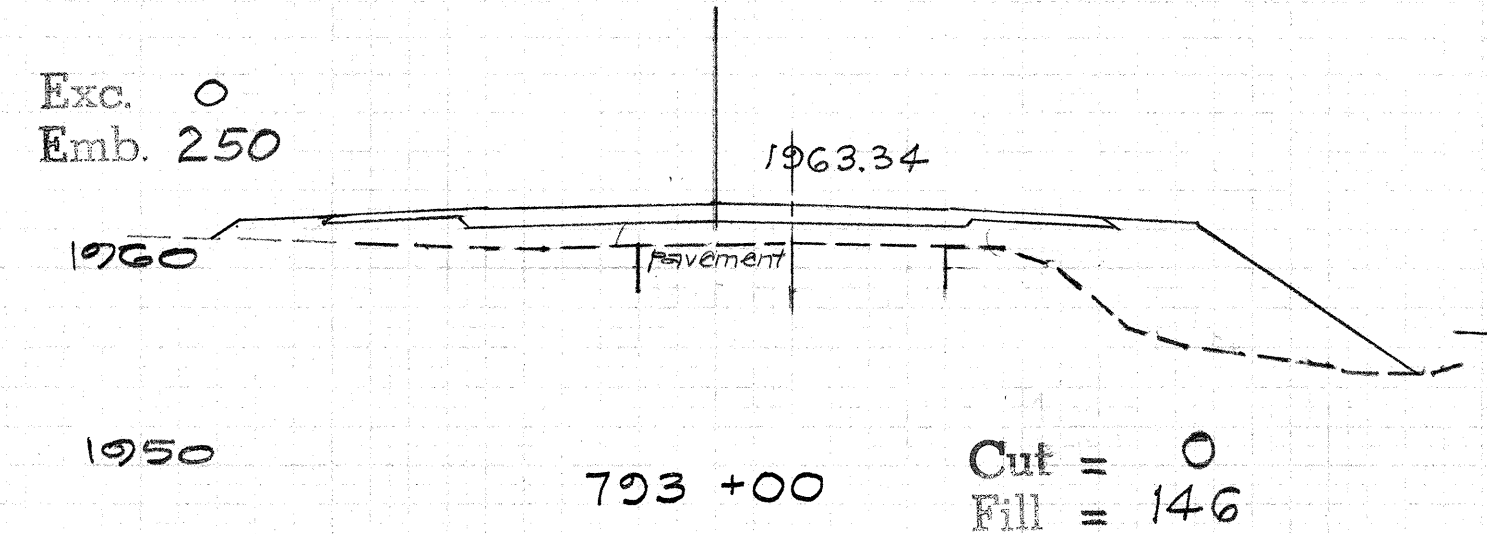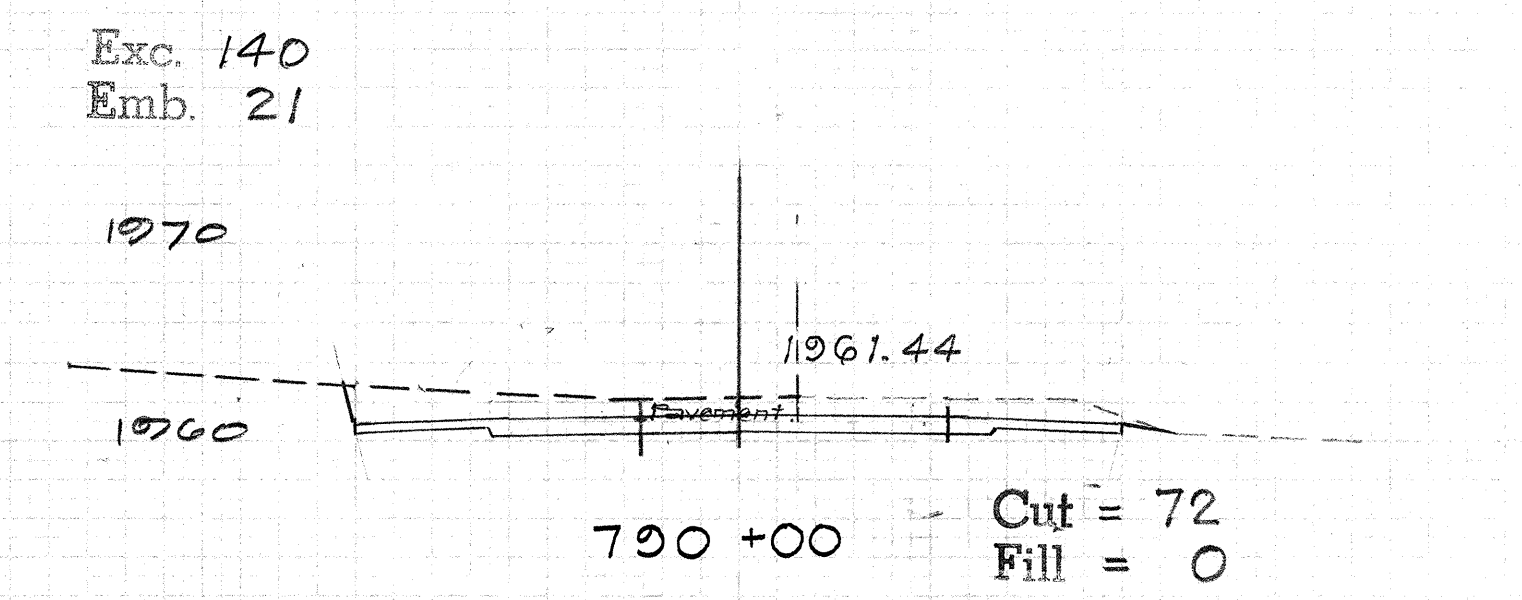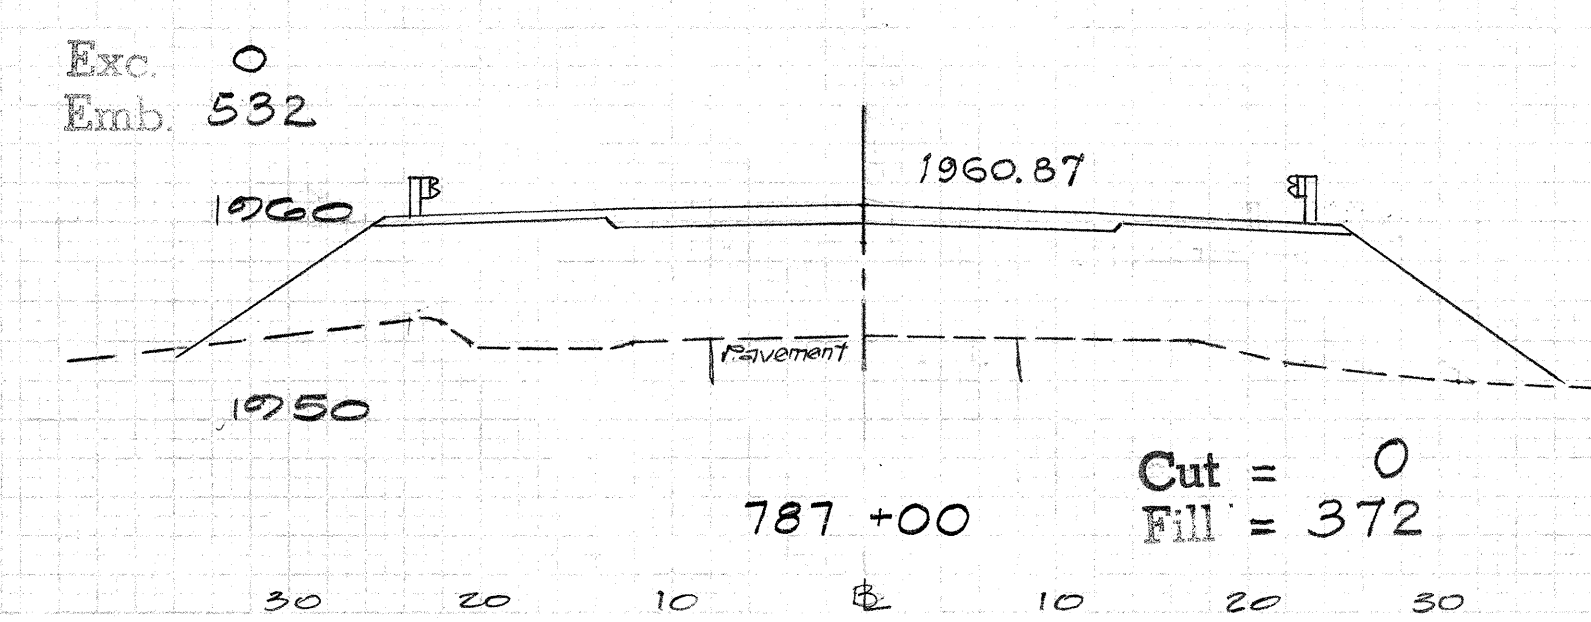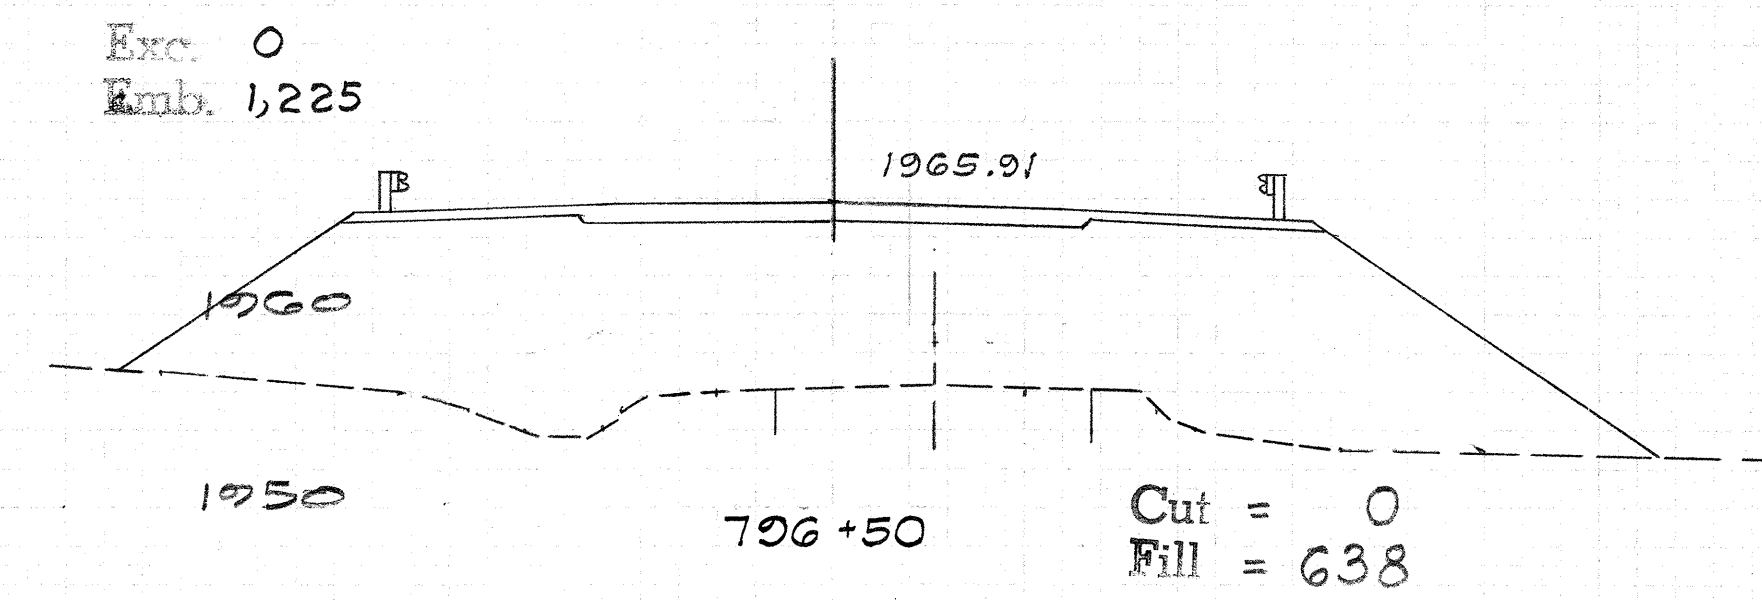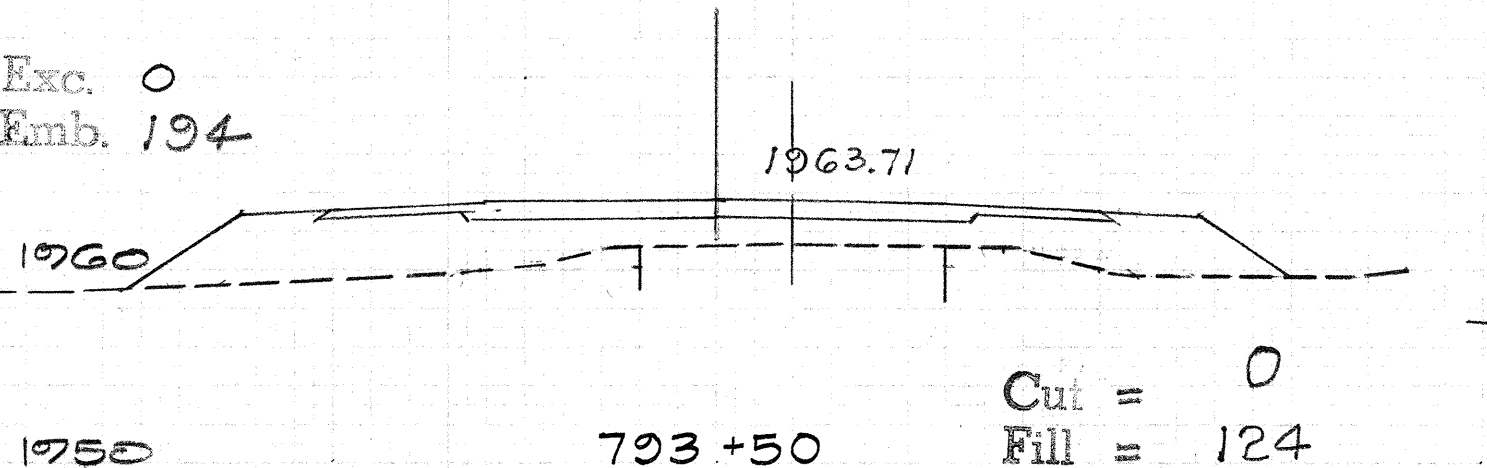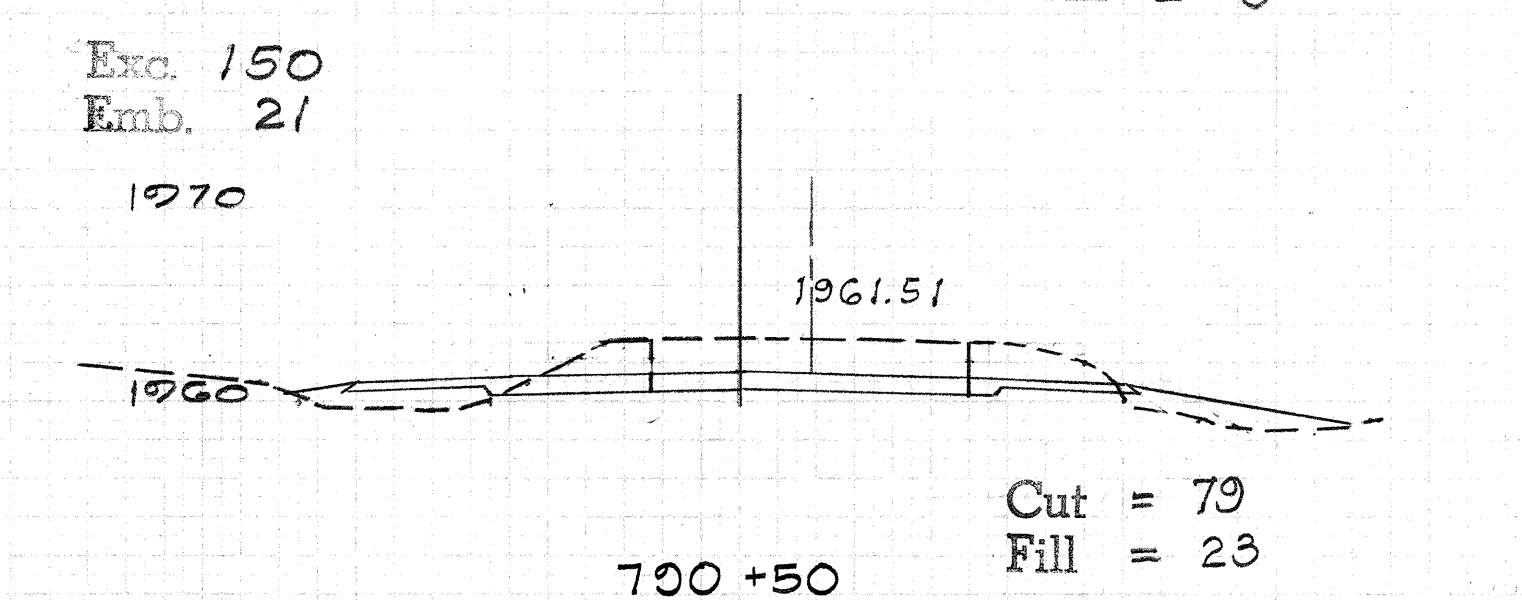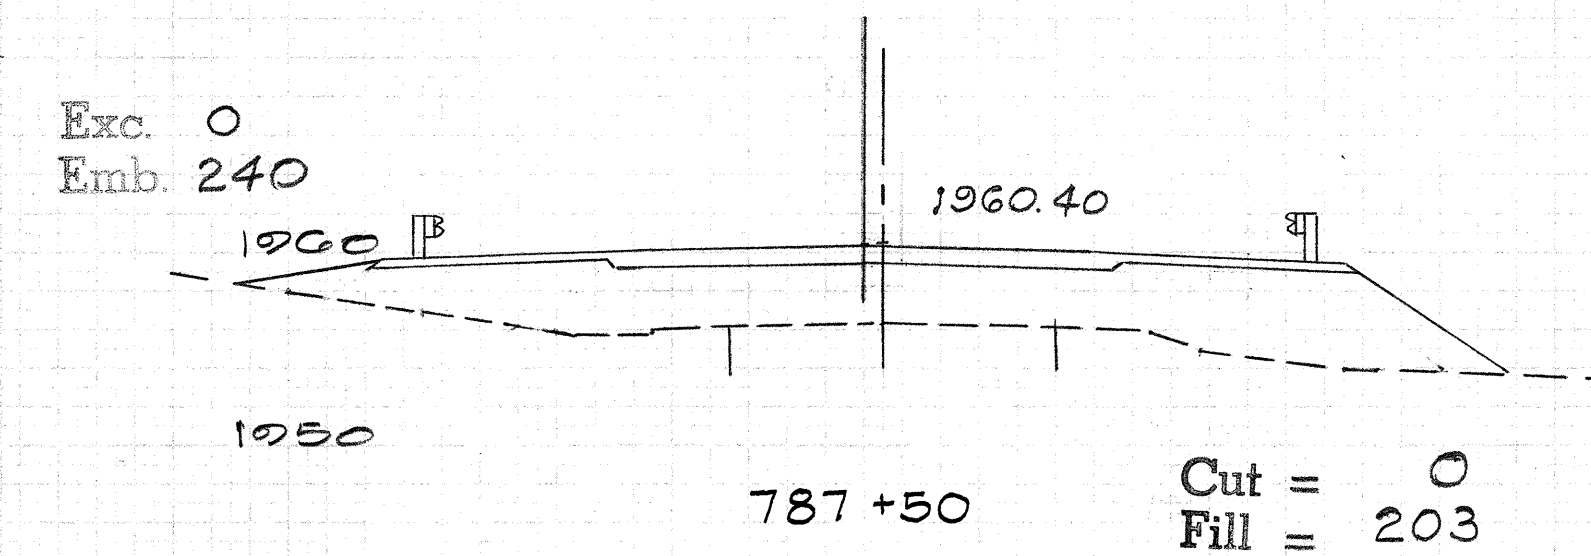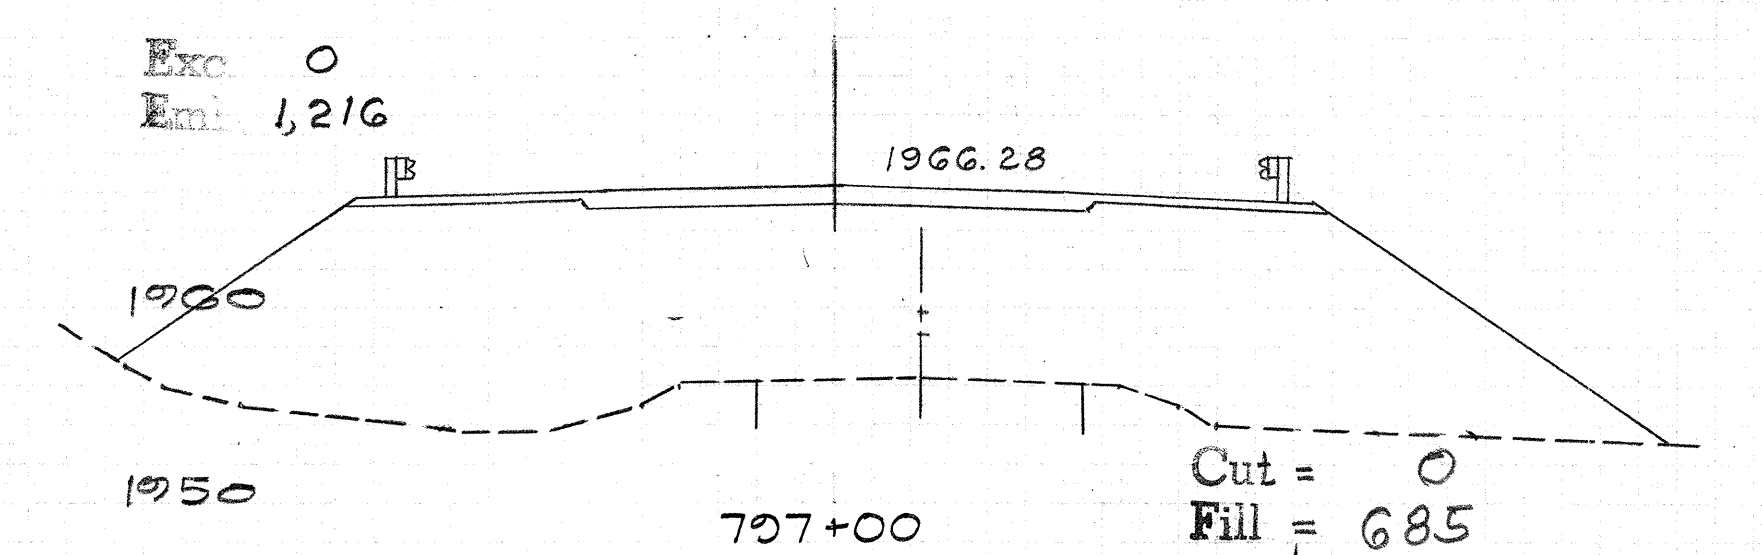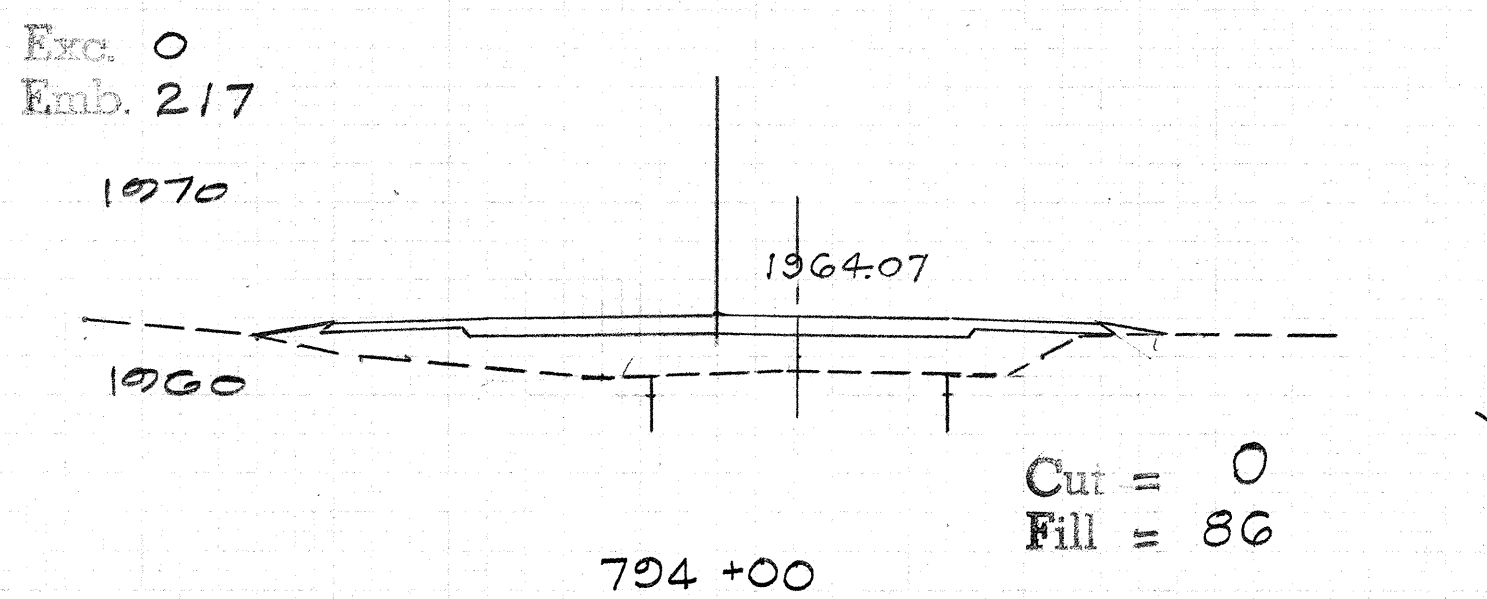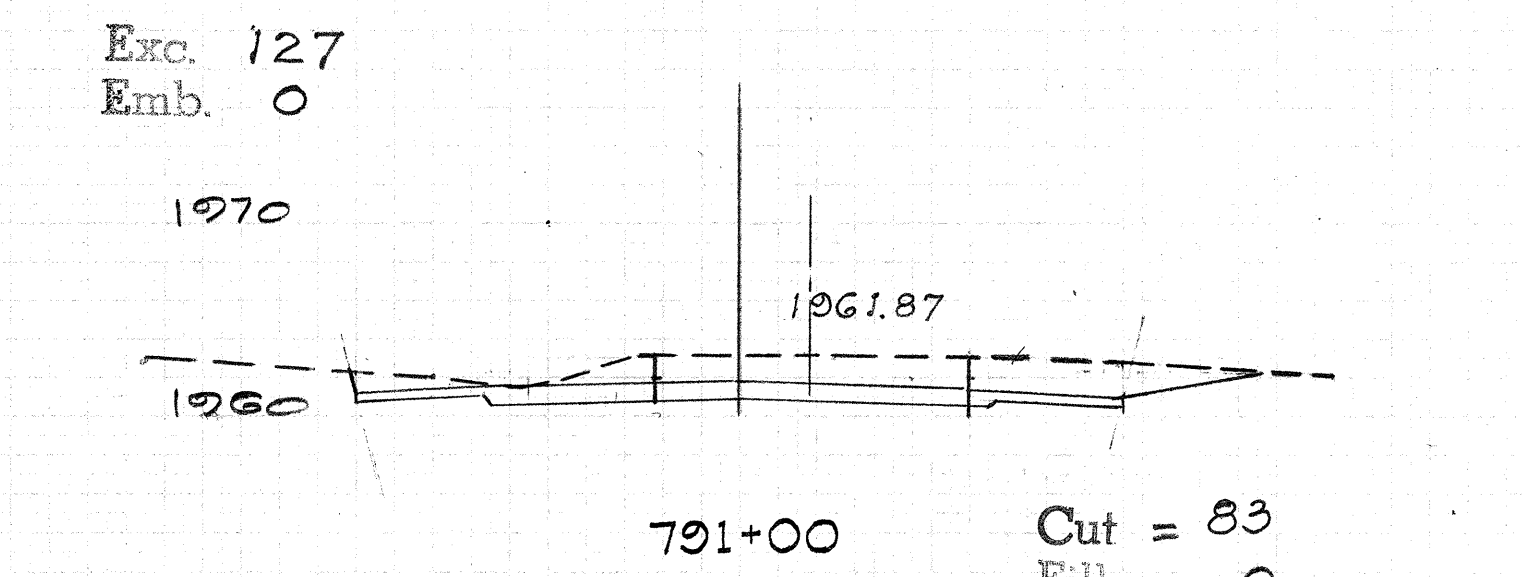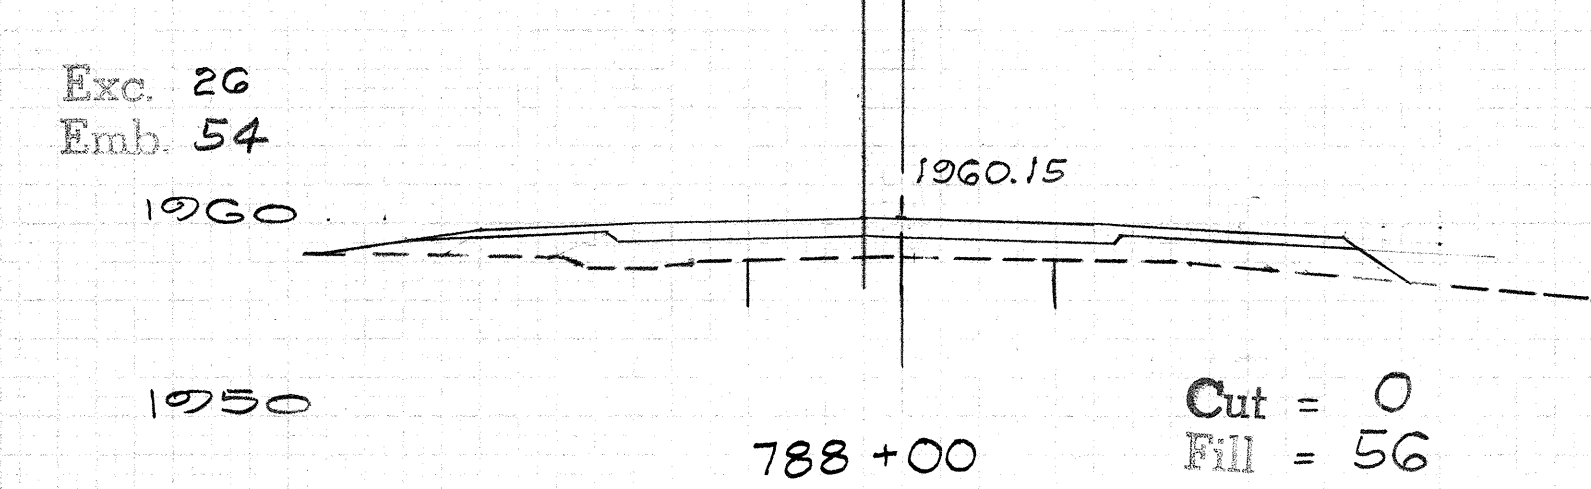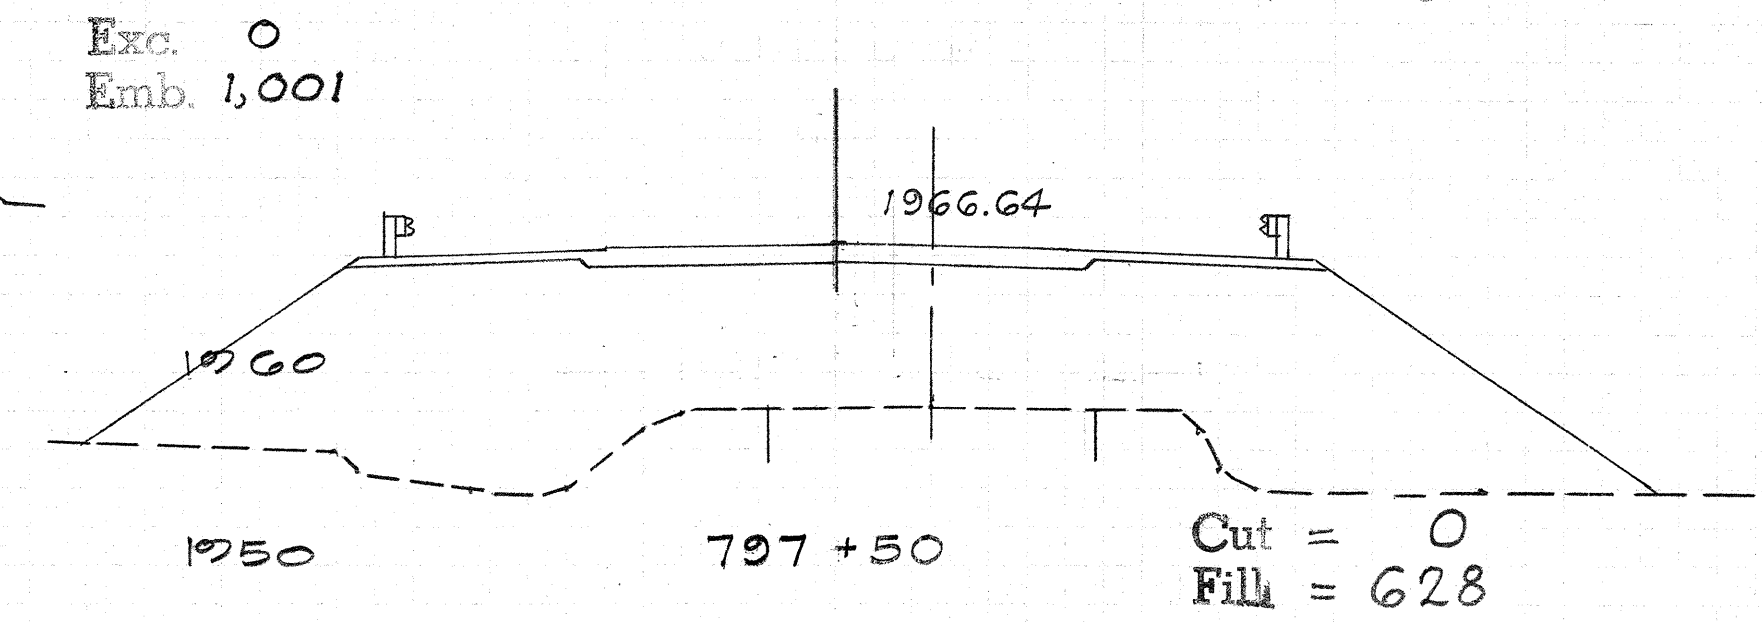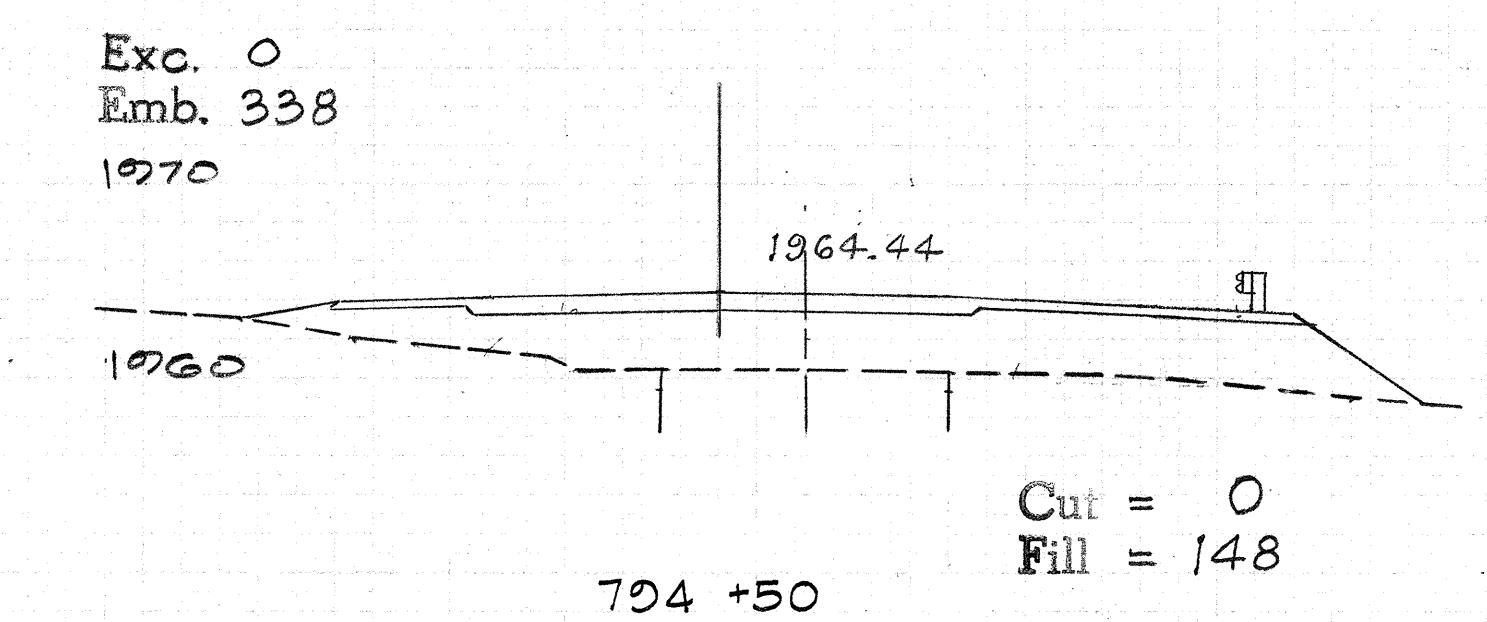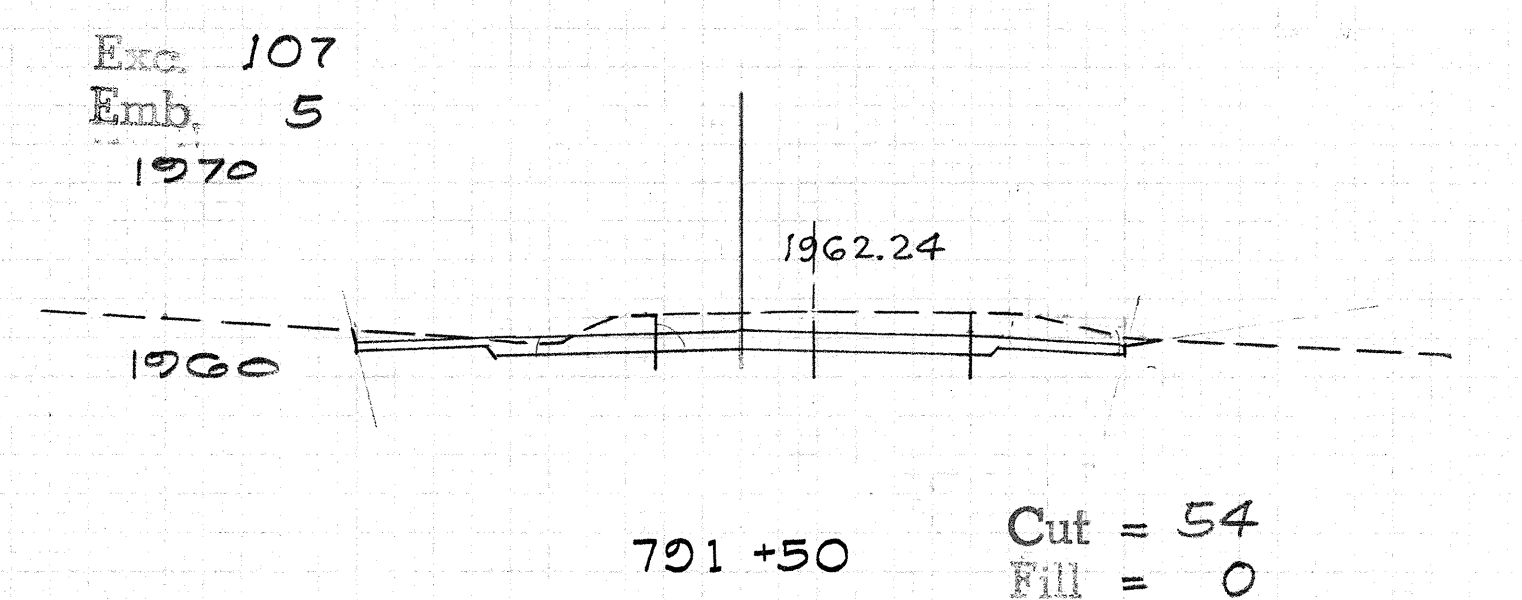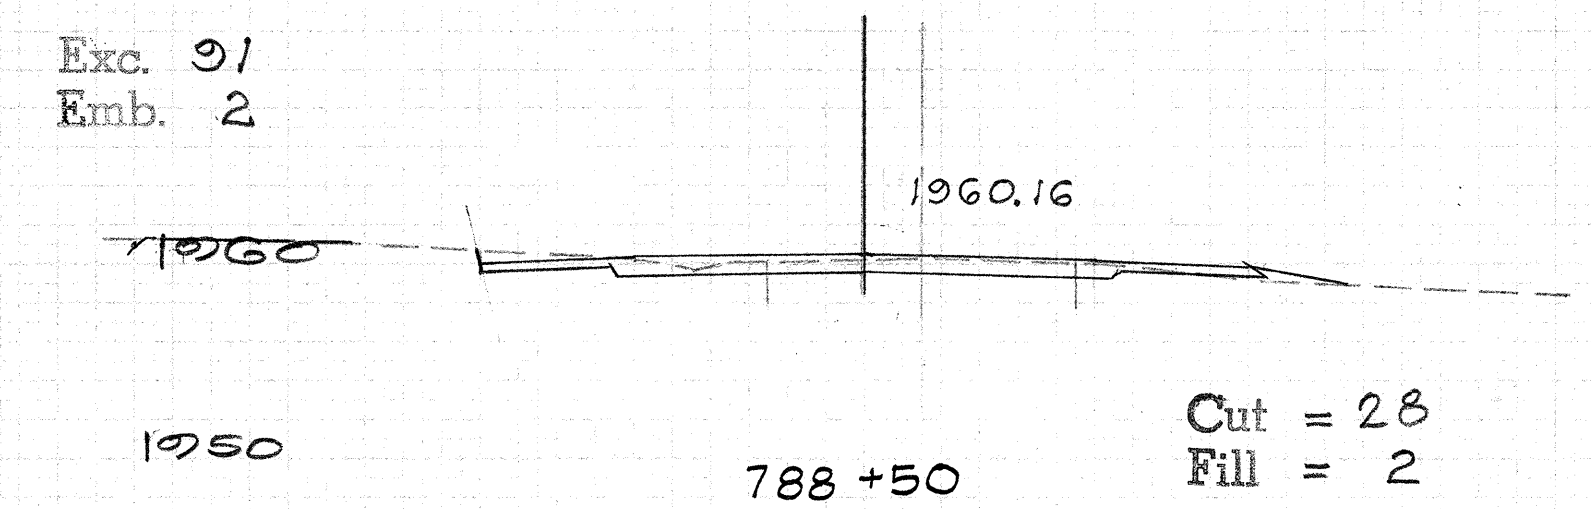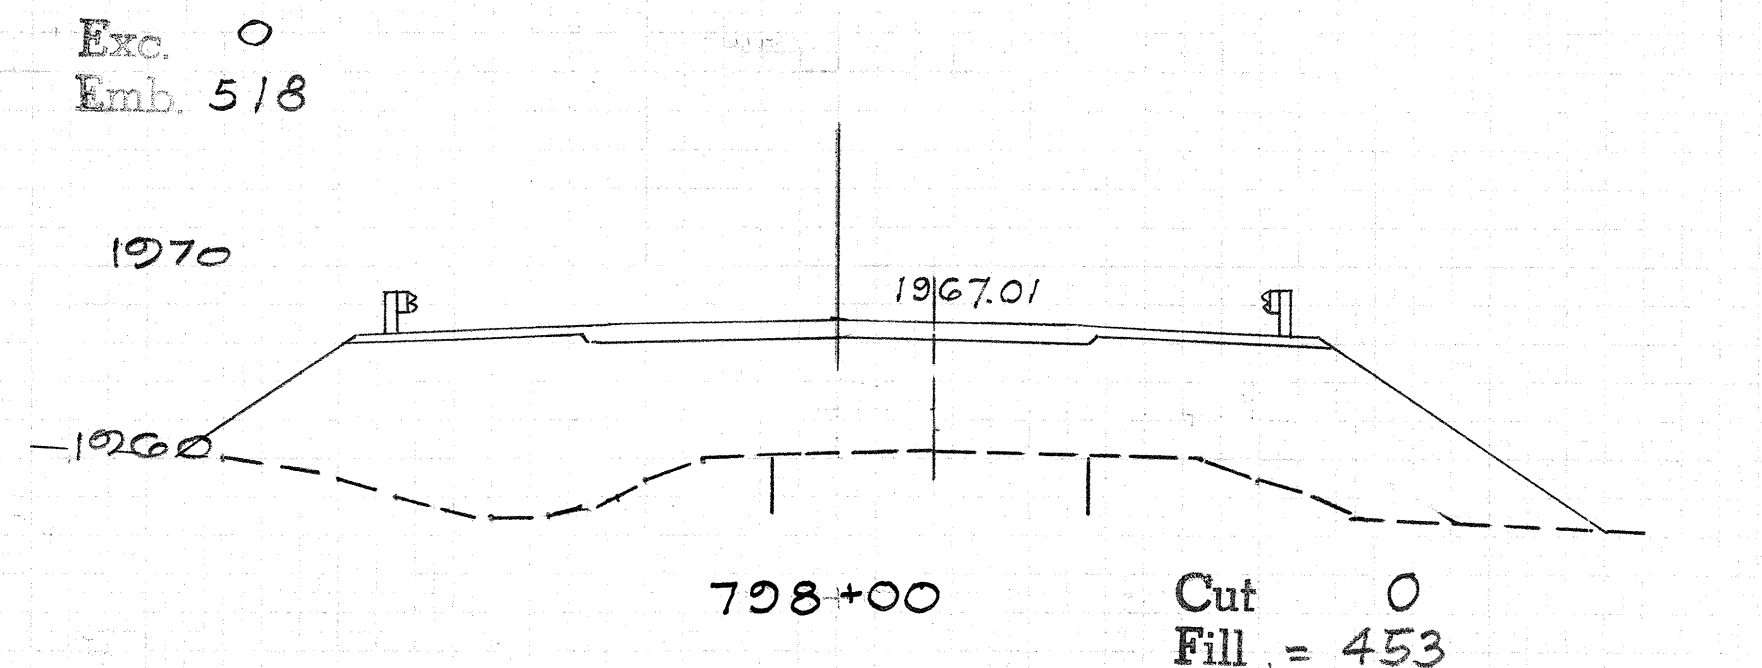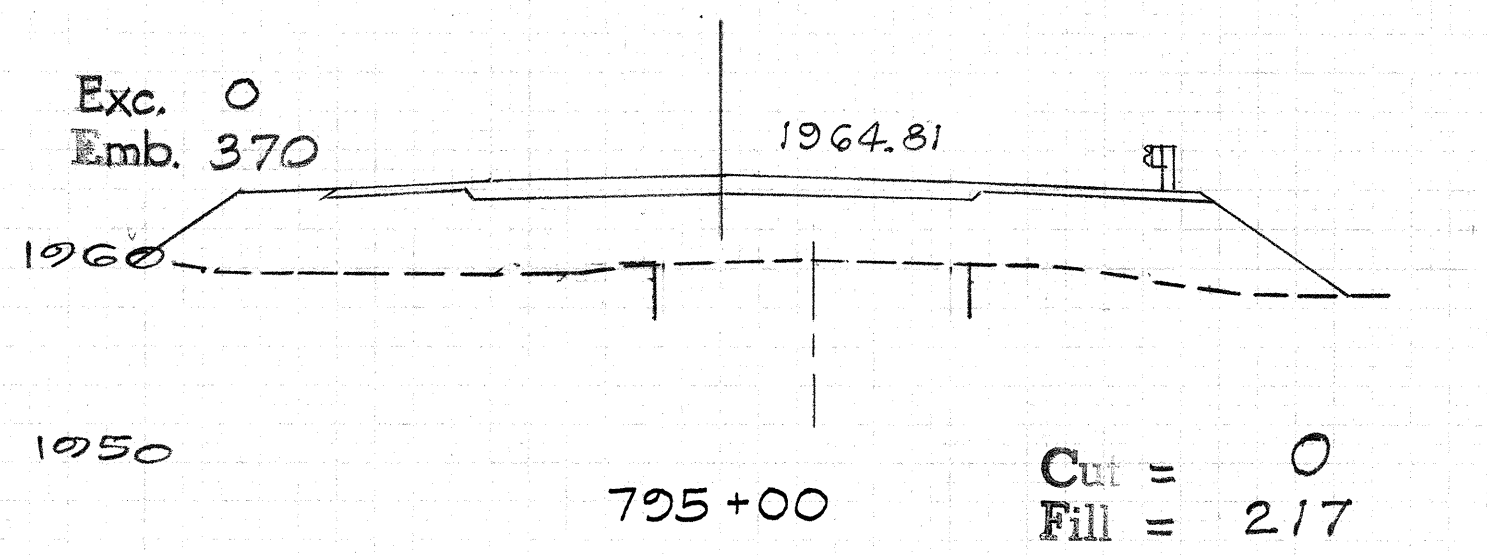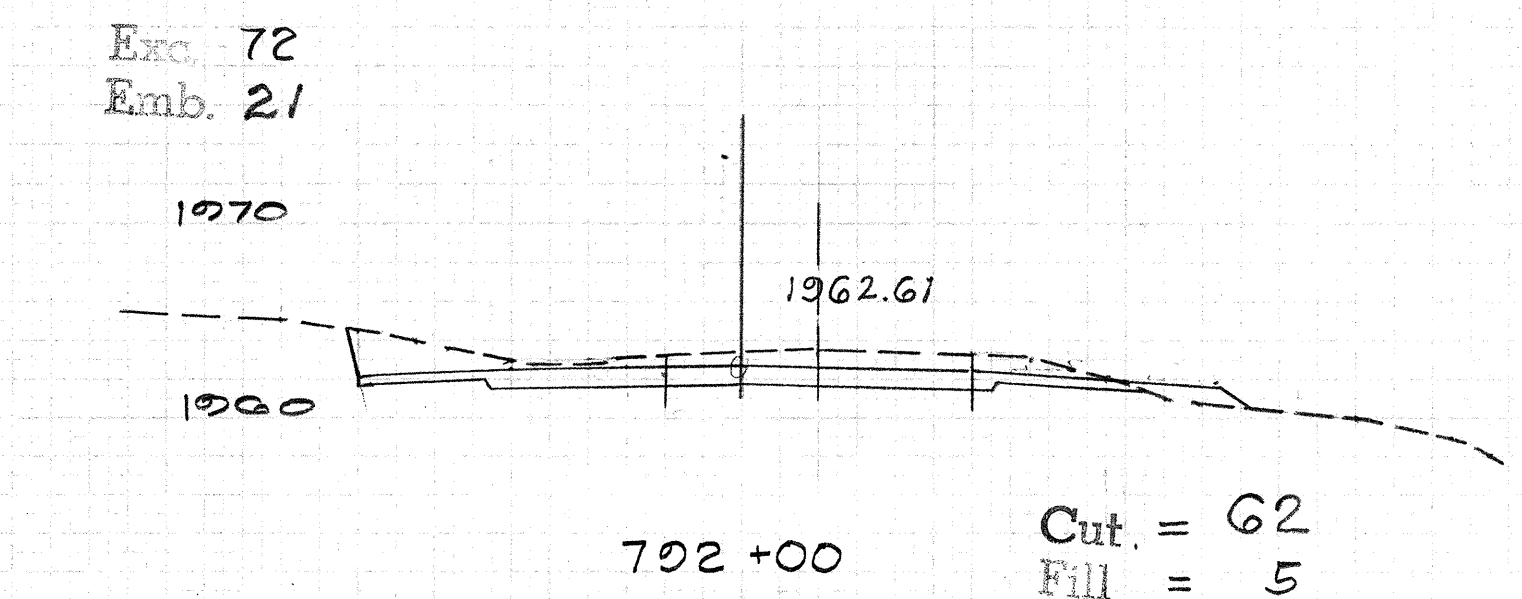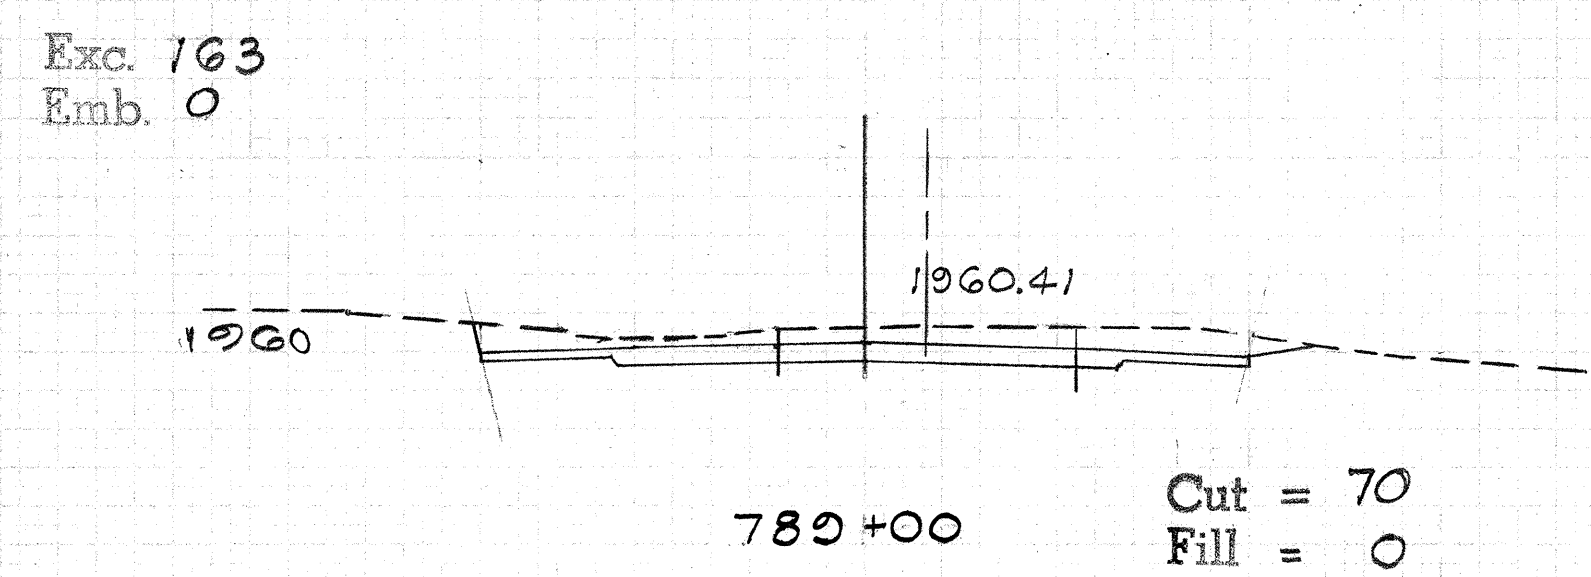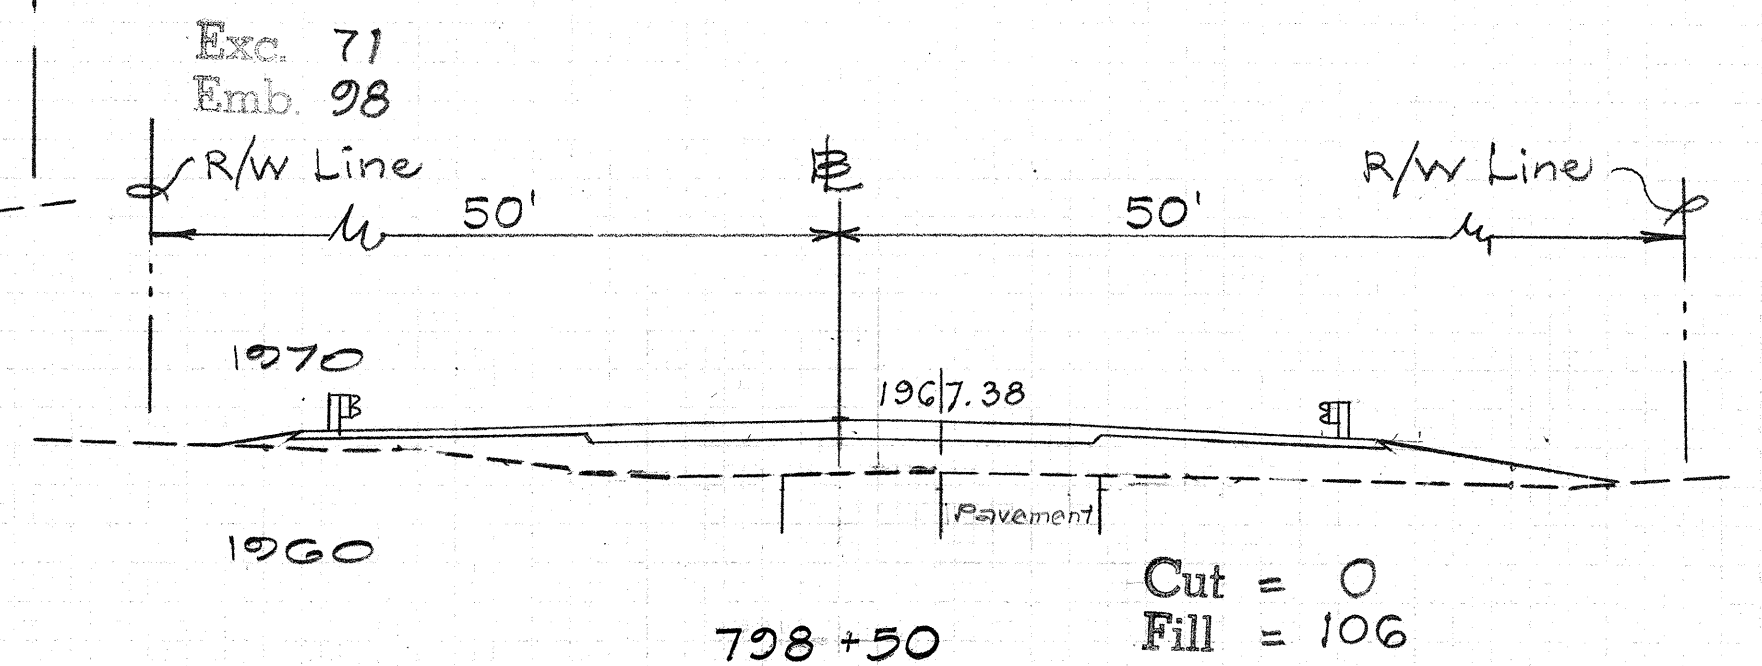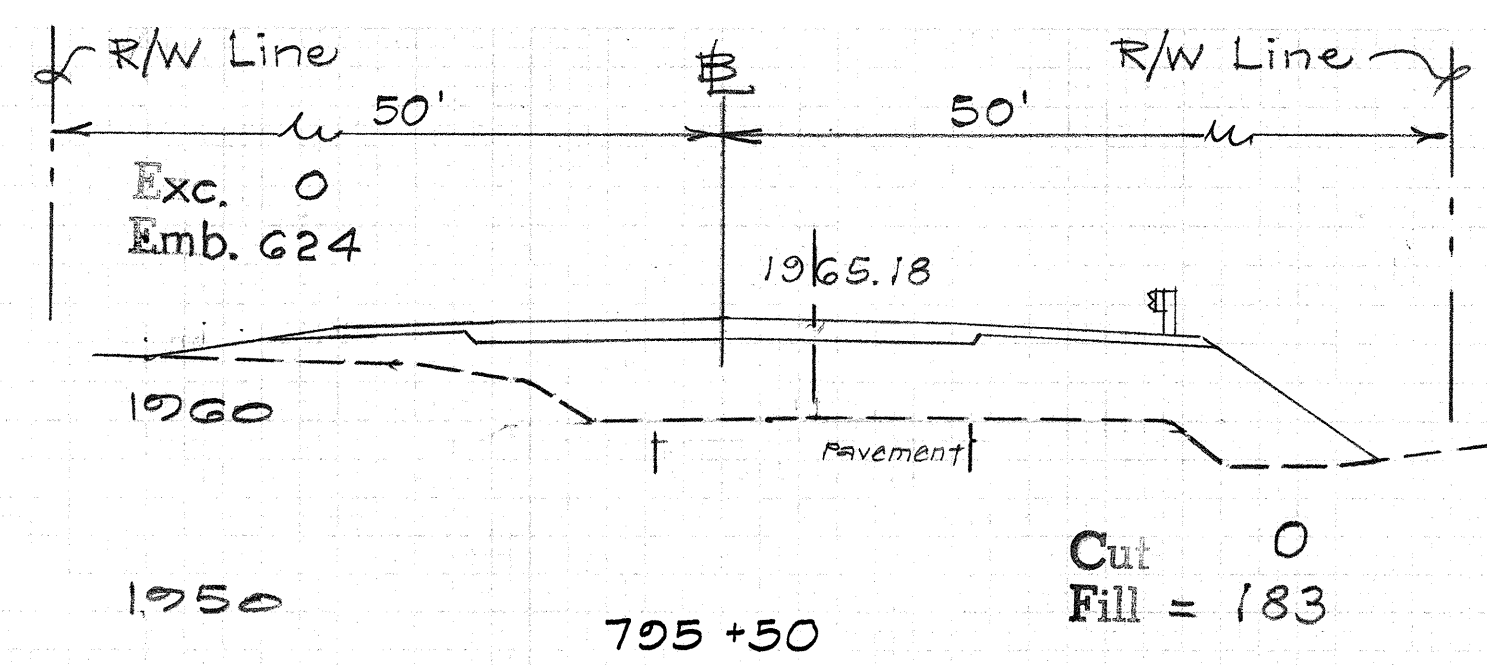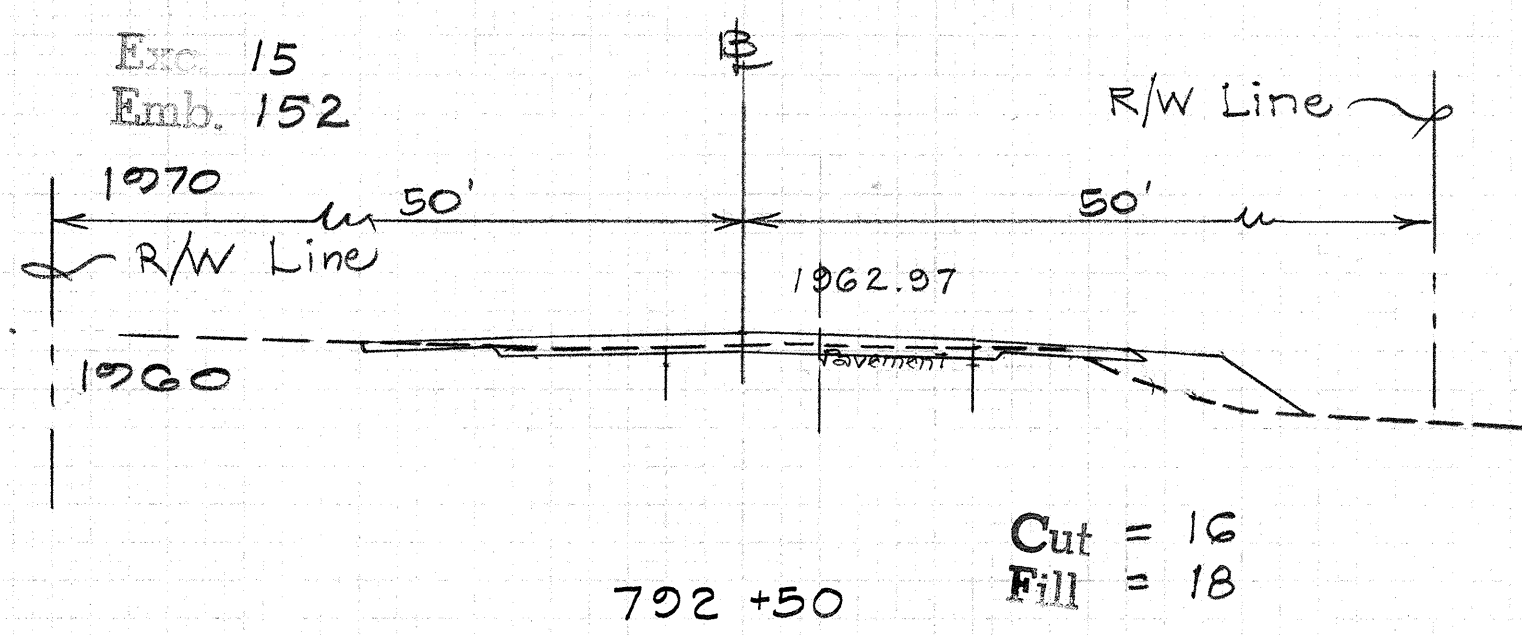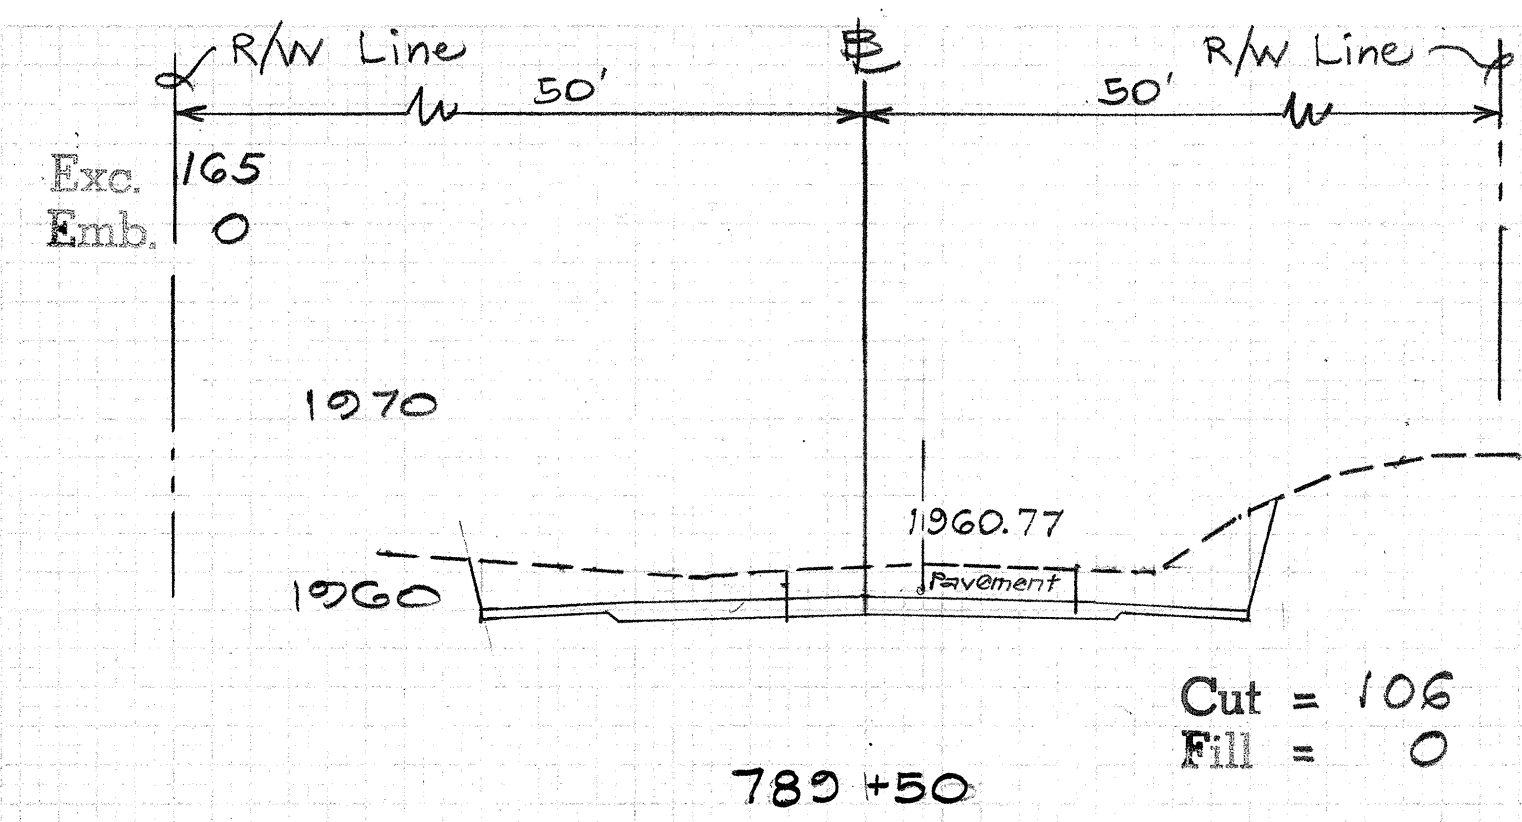

FED. ROAD DIST. NO.	STATE	PROJ. NO.	FISCAL YEAR	SHEET NO.	TOTAL SHEETS
HAWAII	HAW.	11E-01-75	1975	43	45

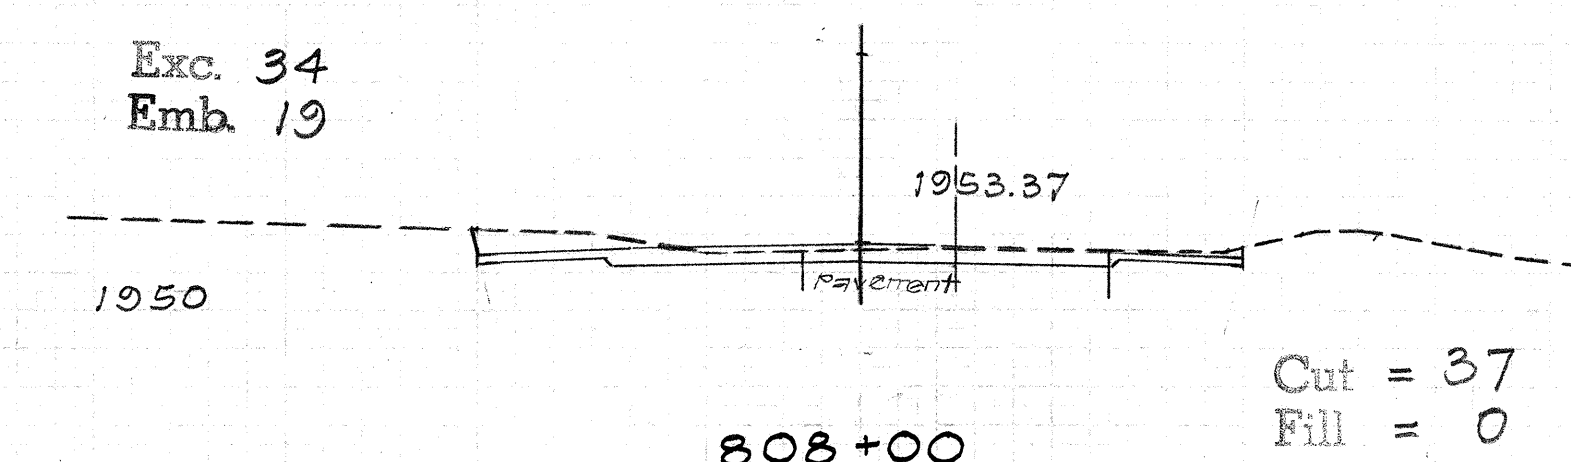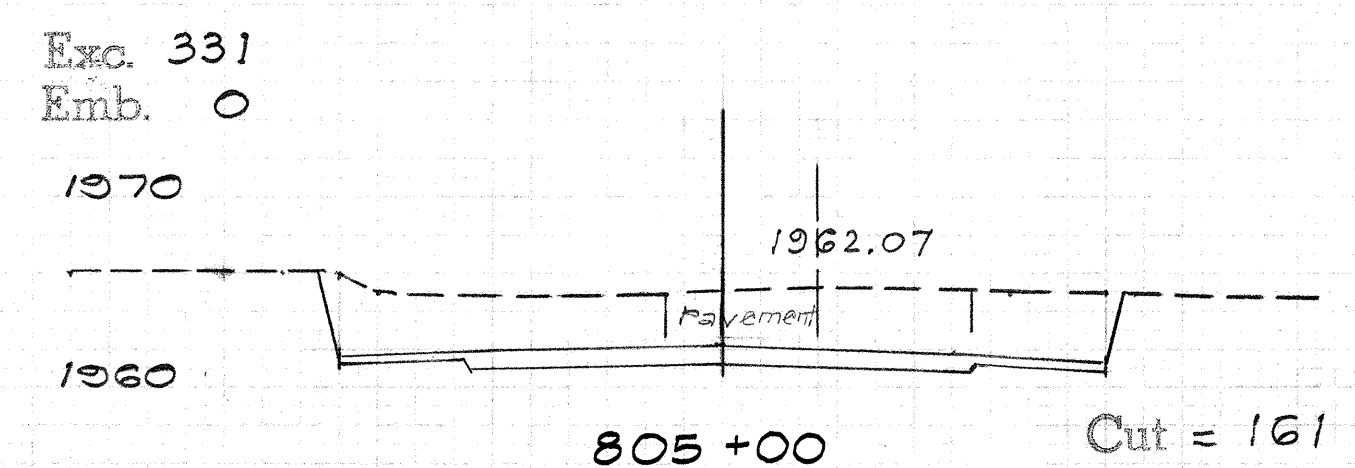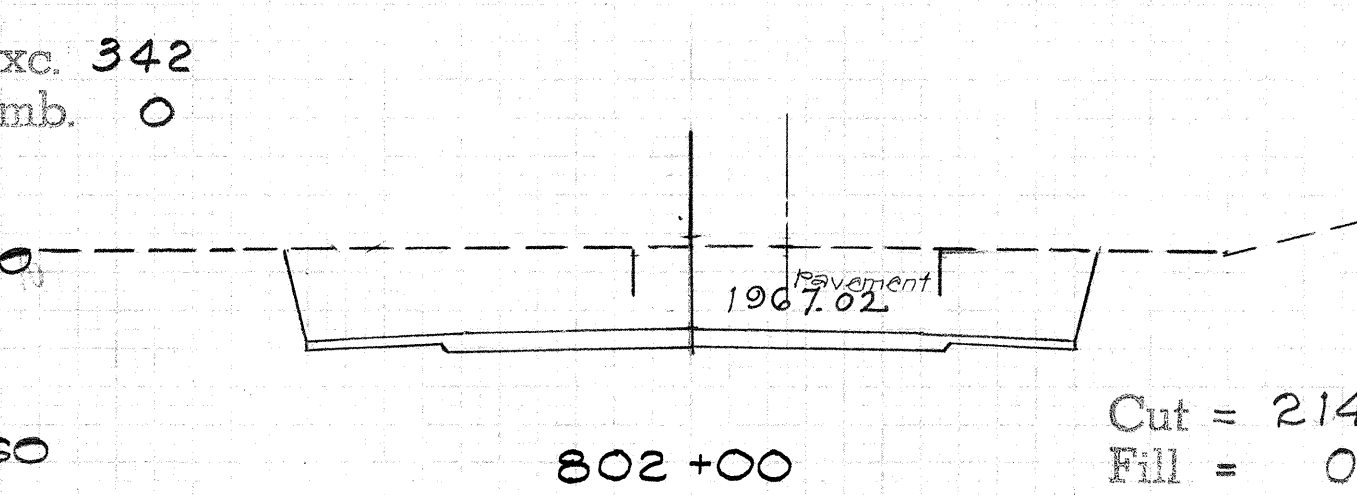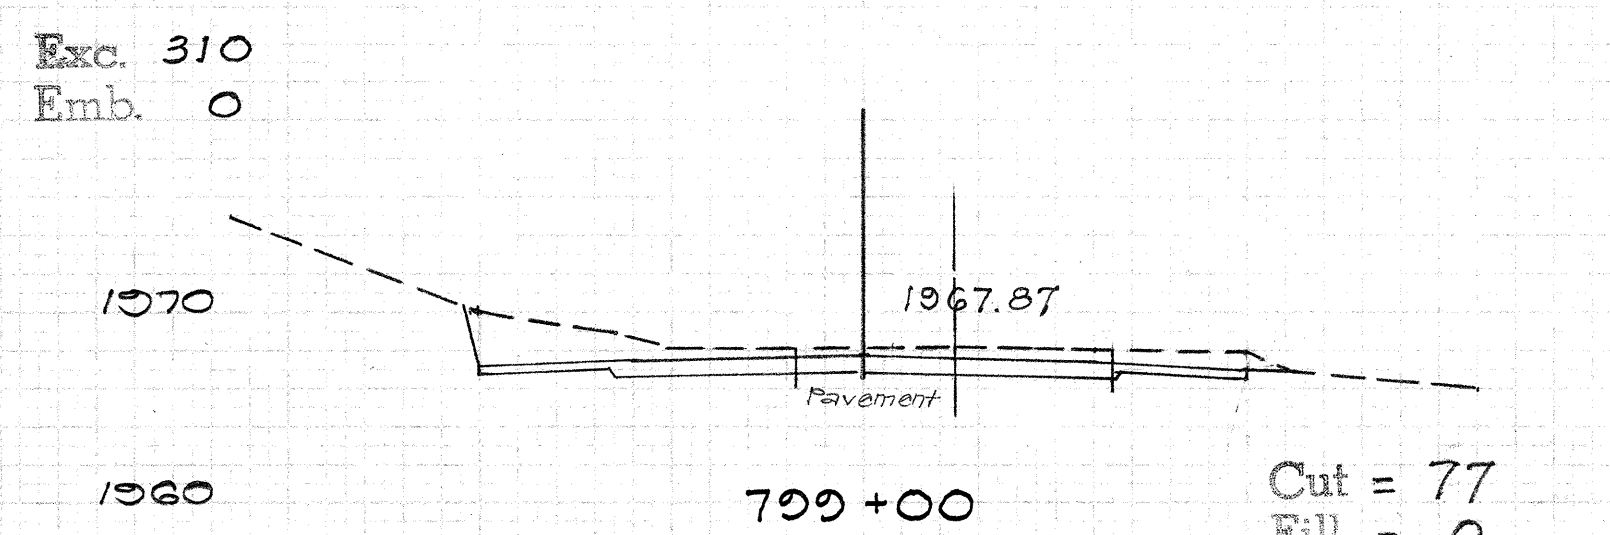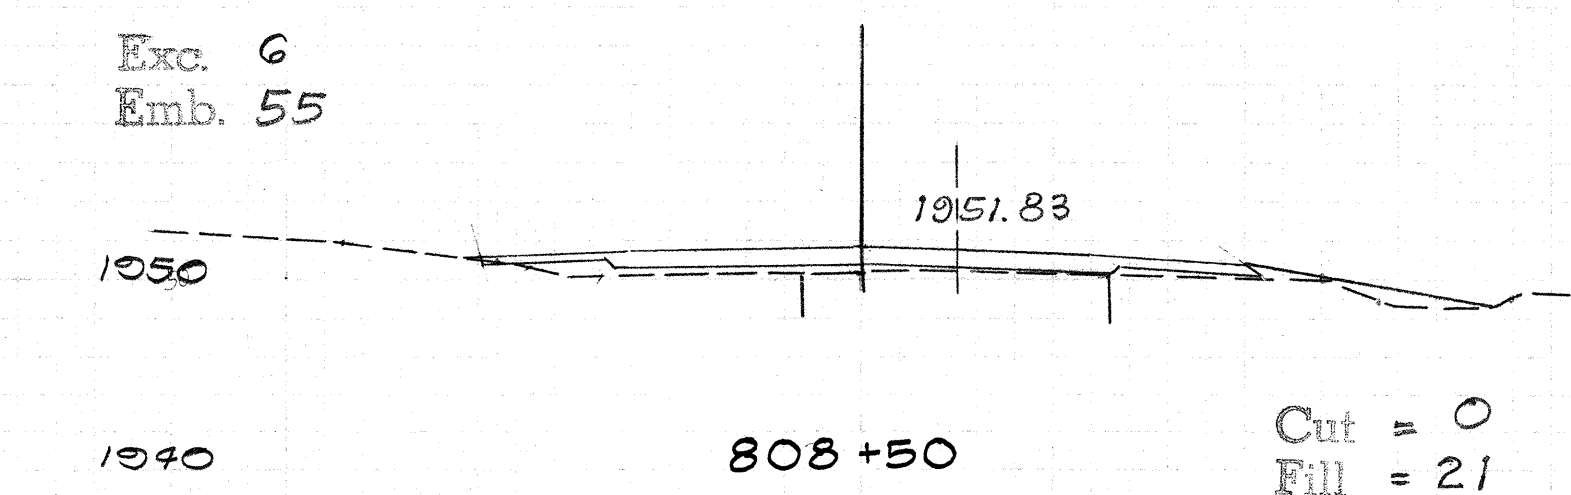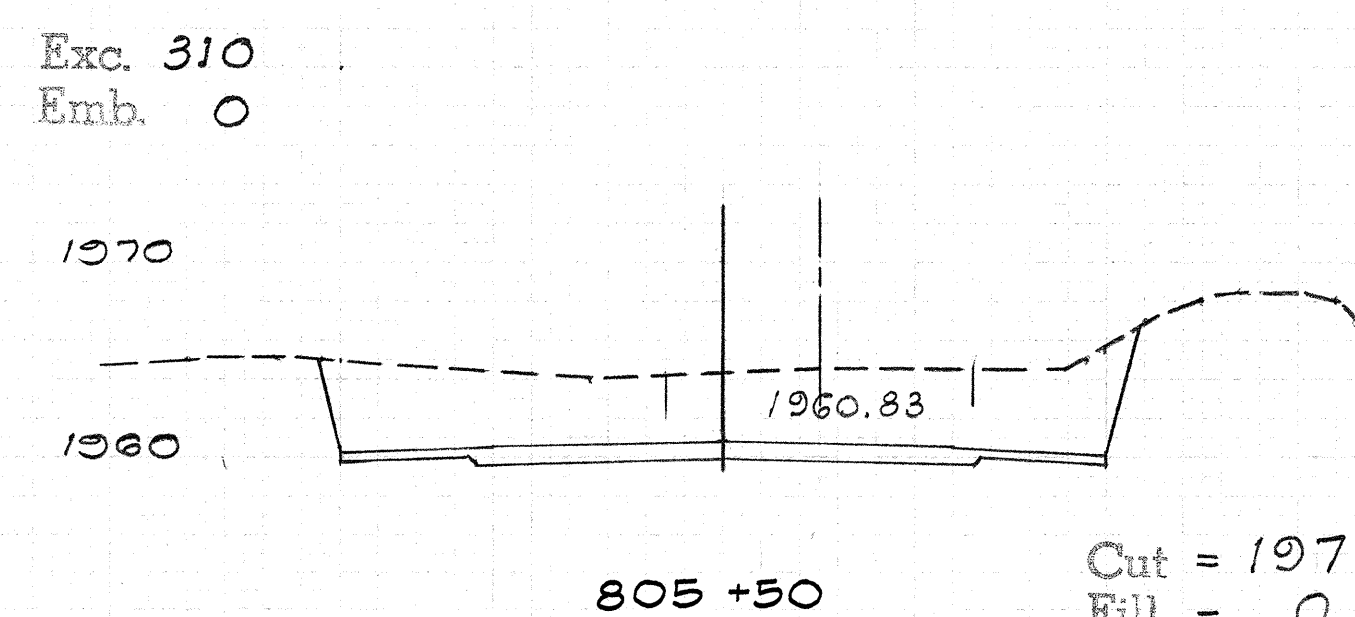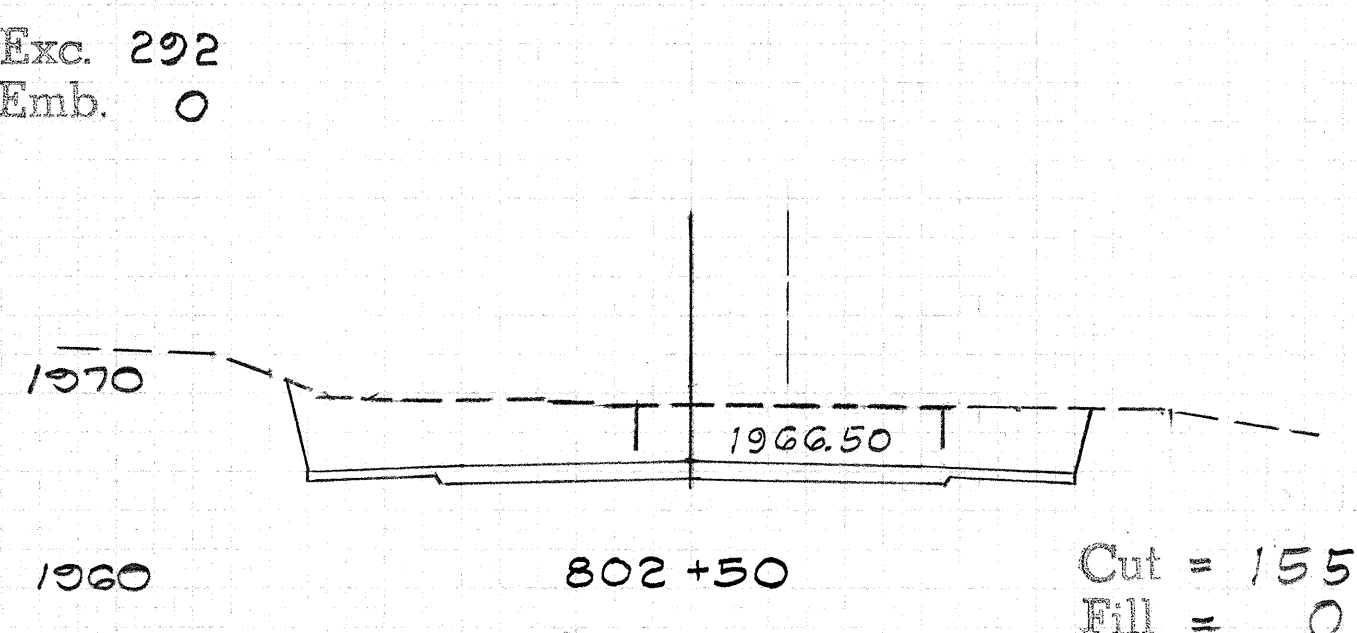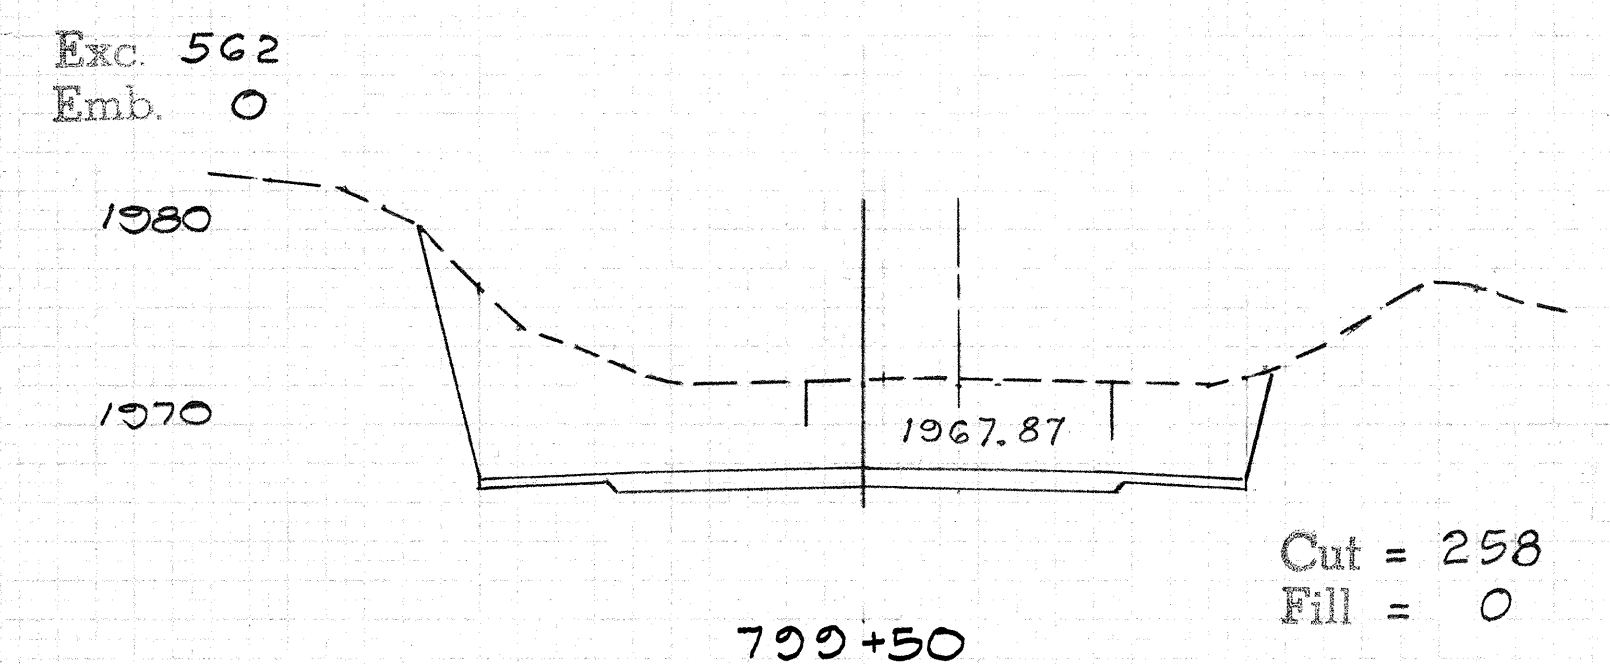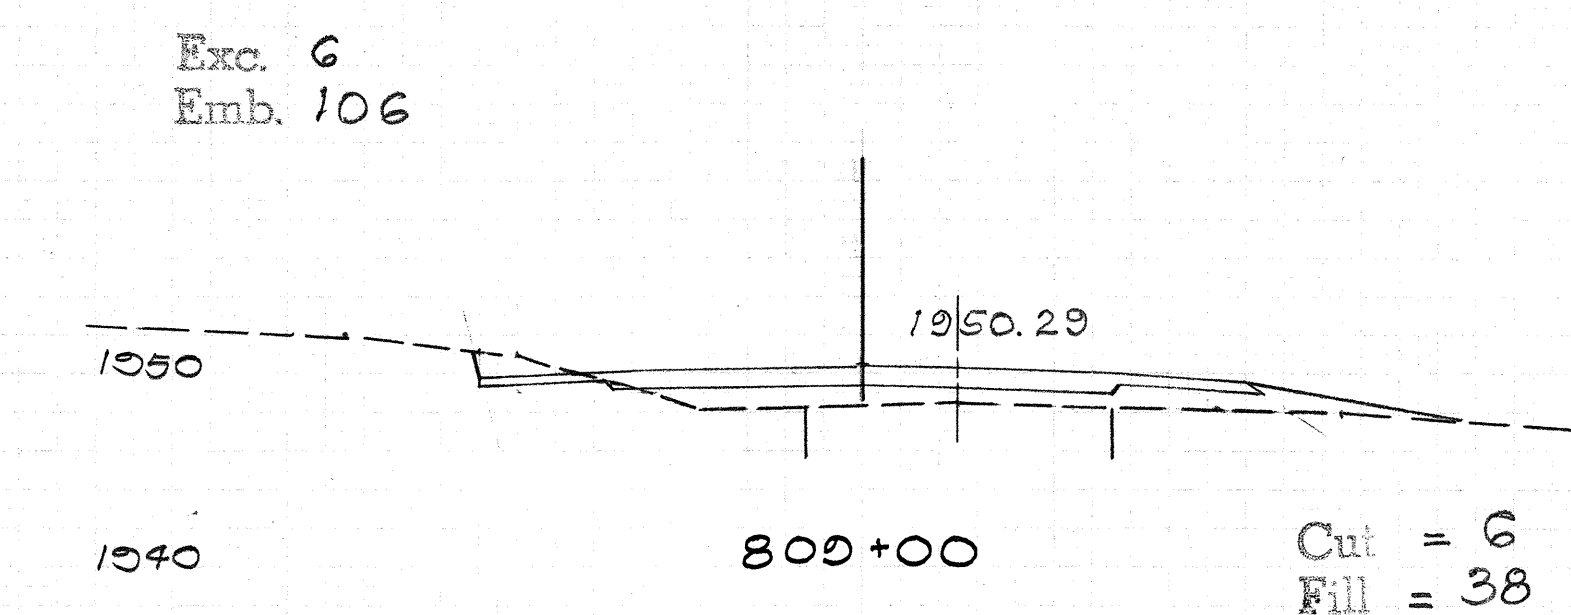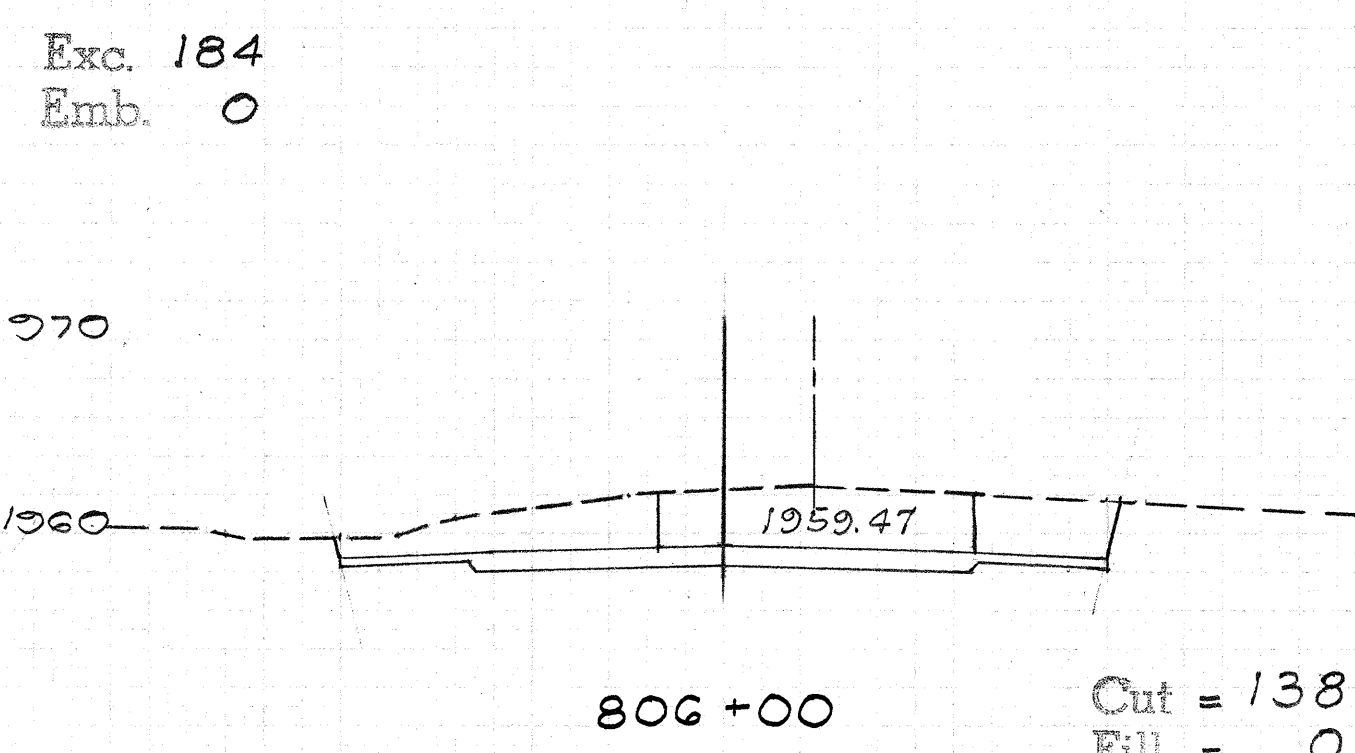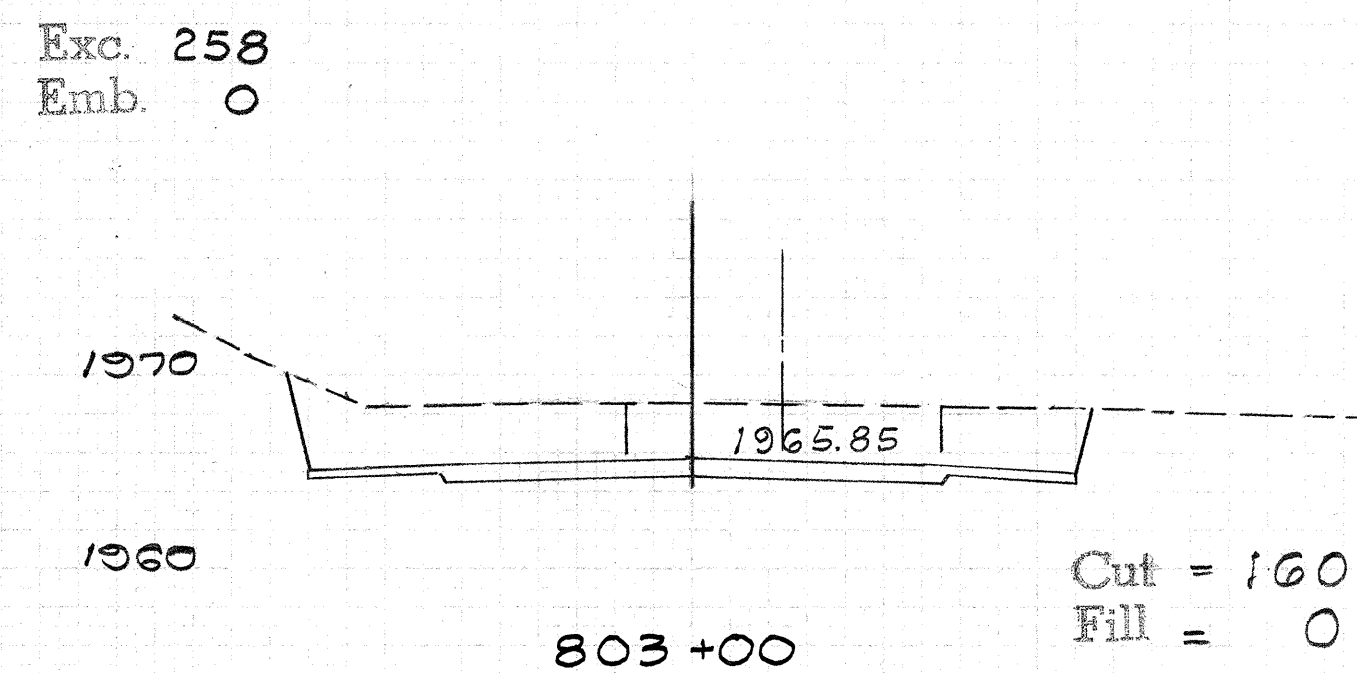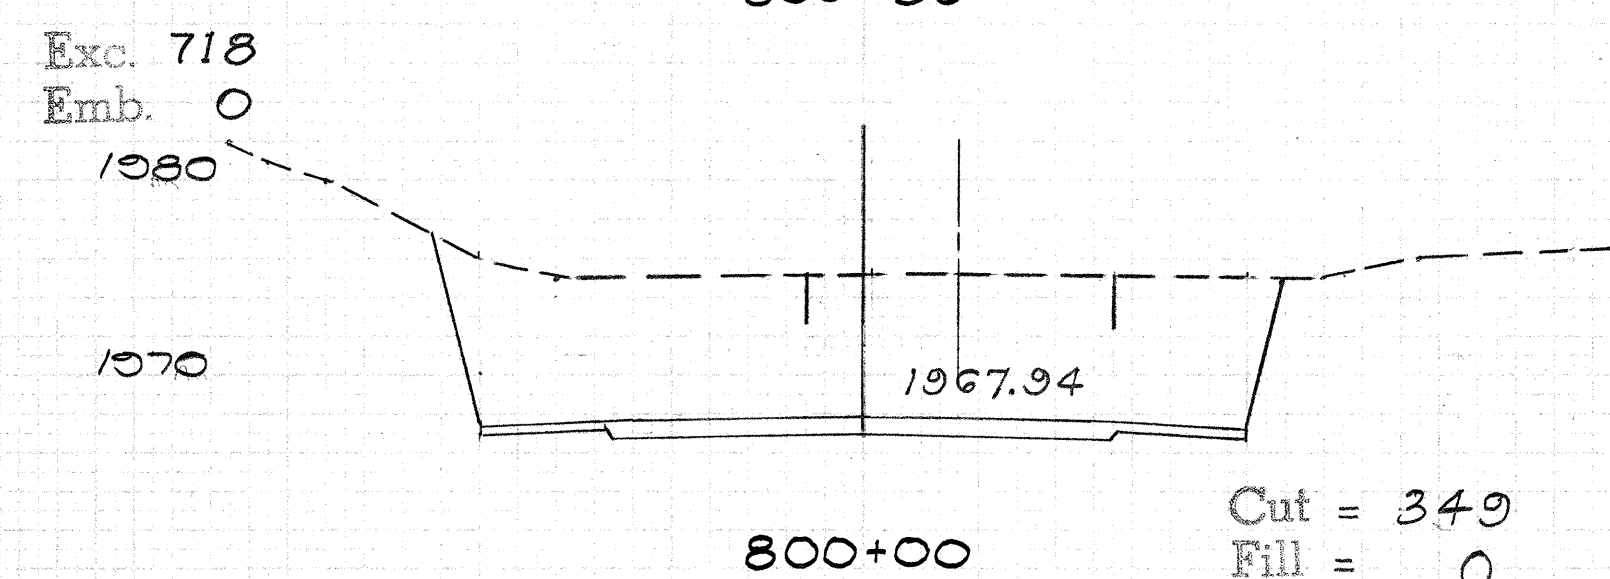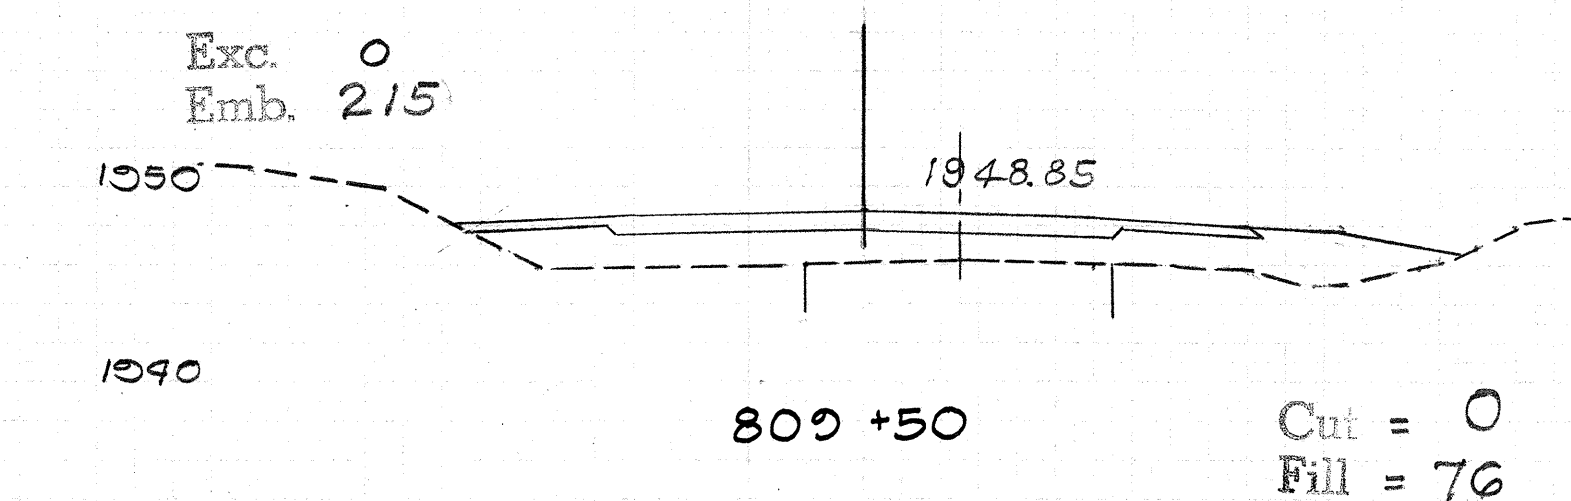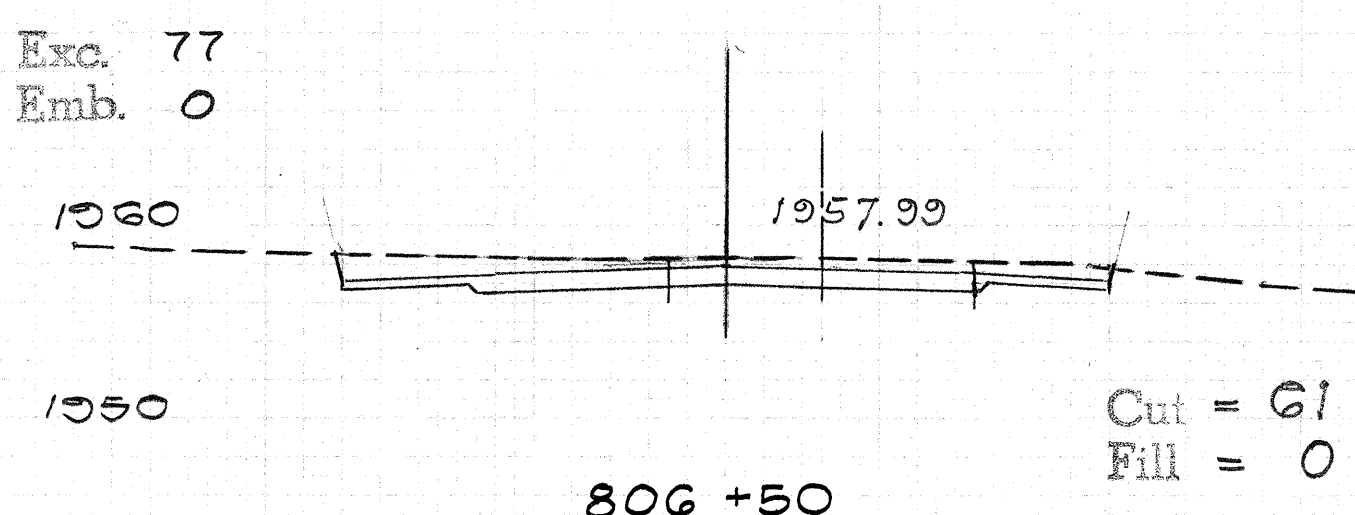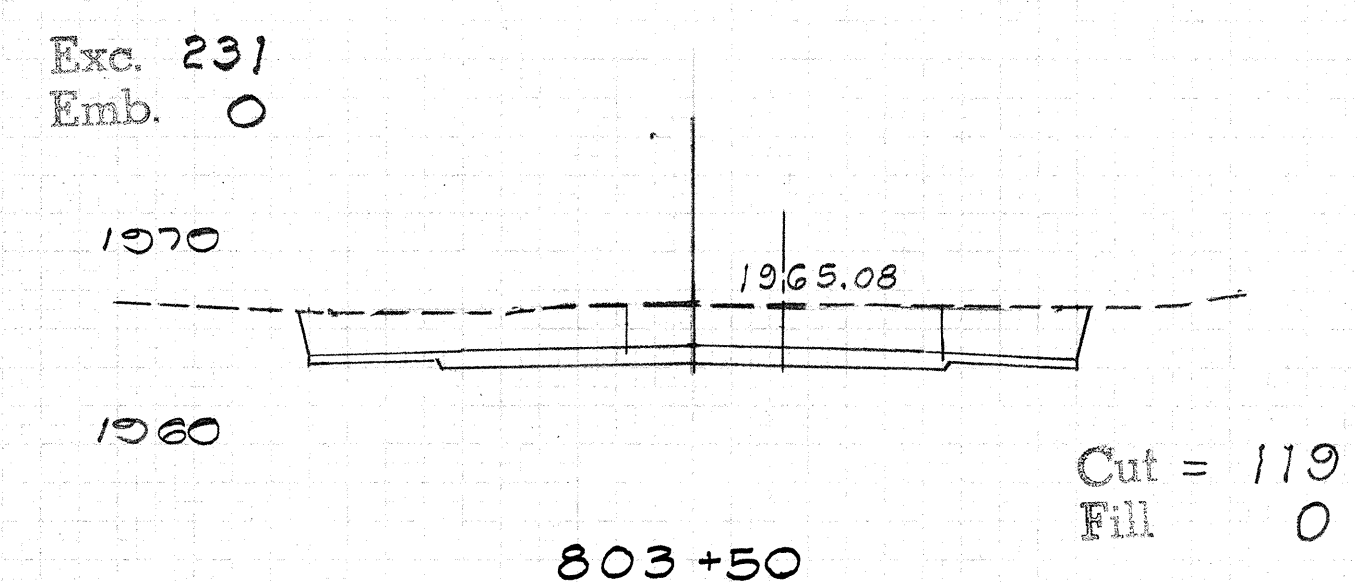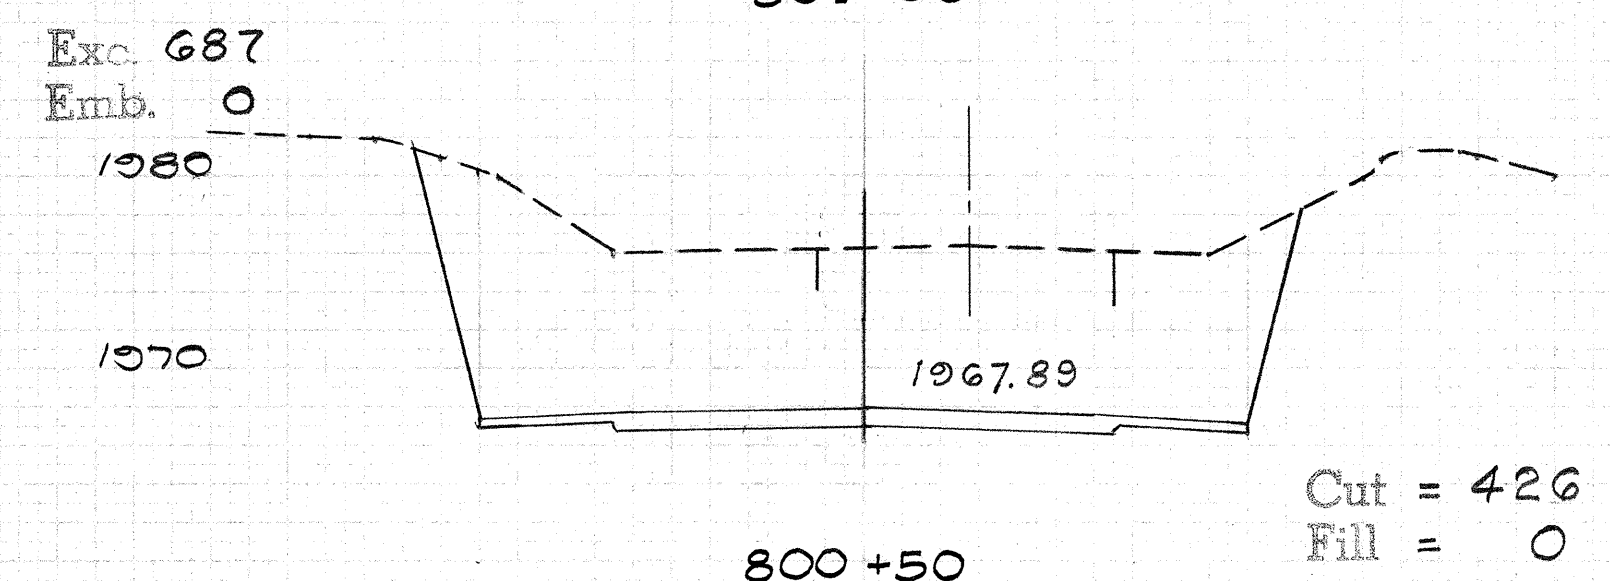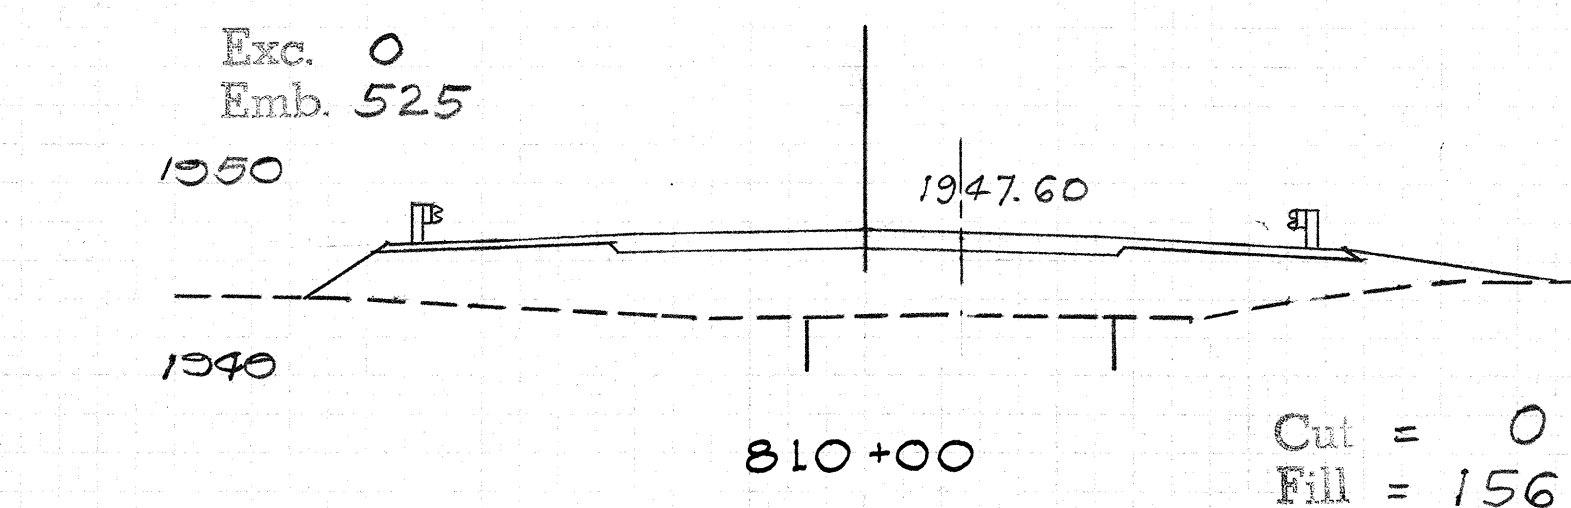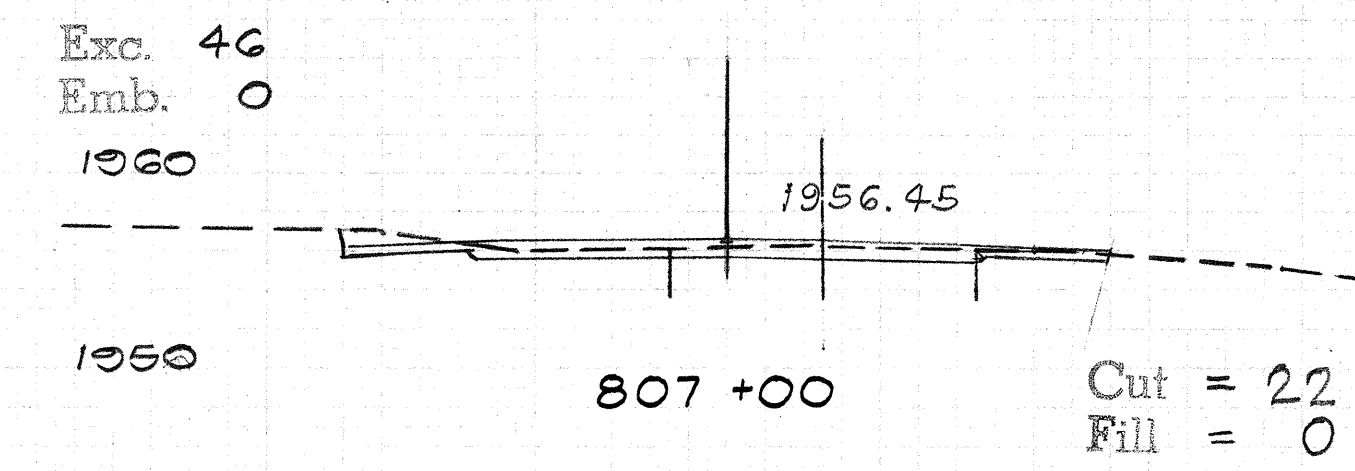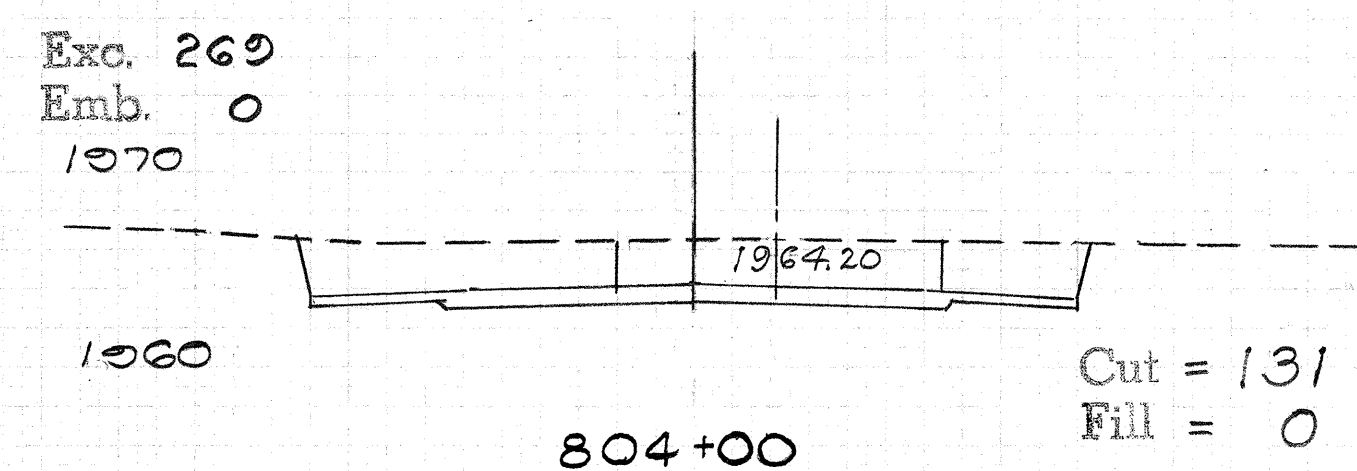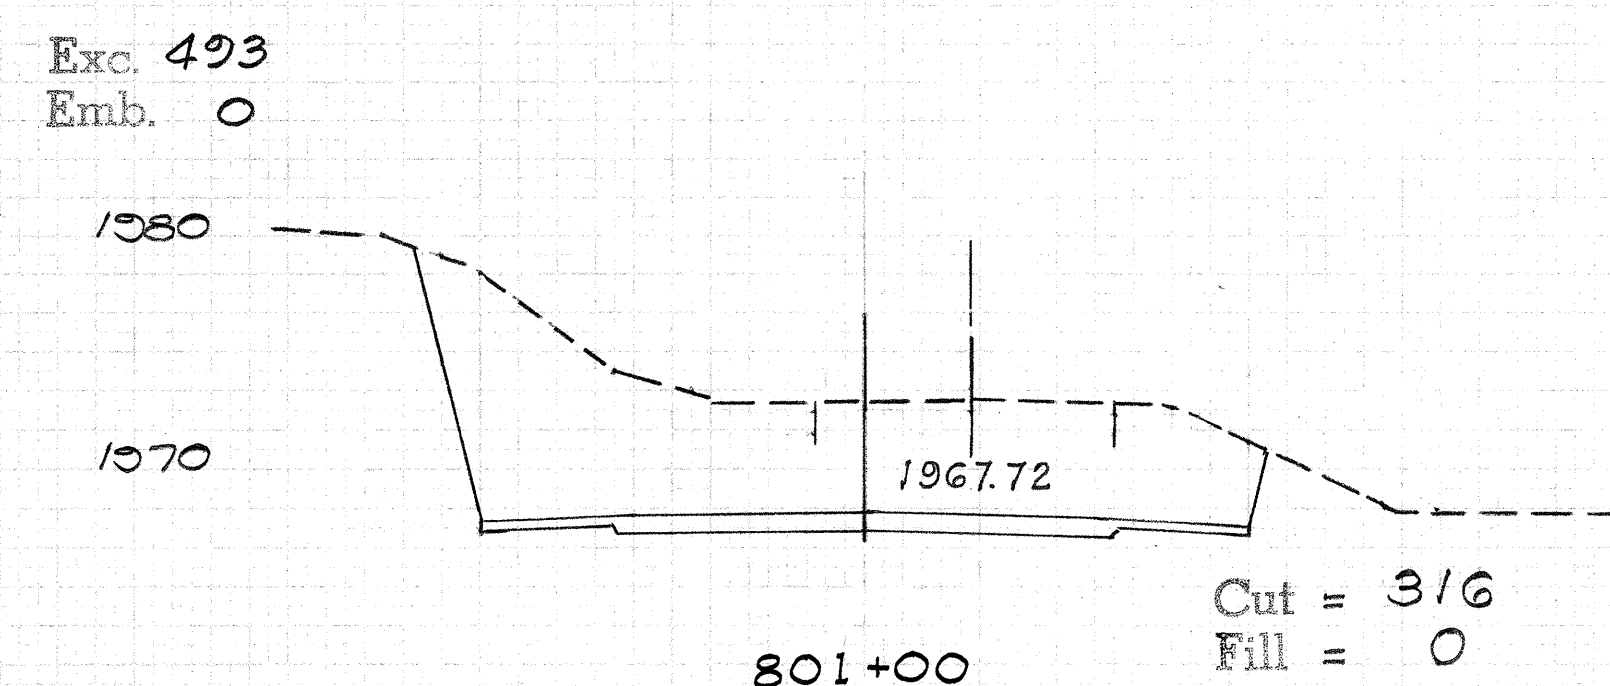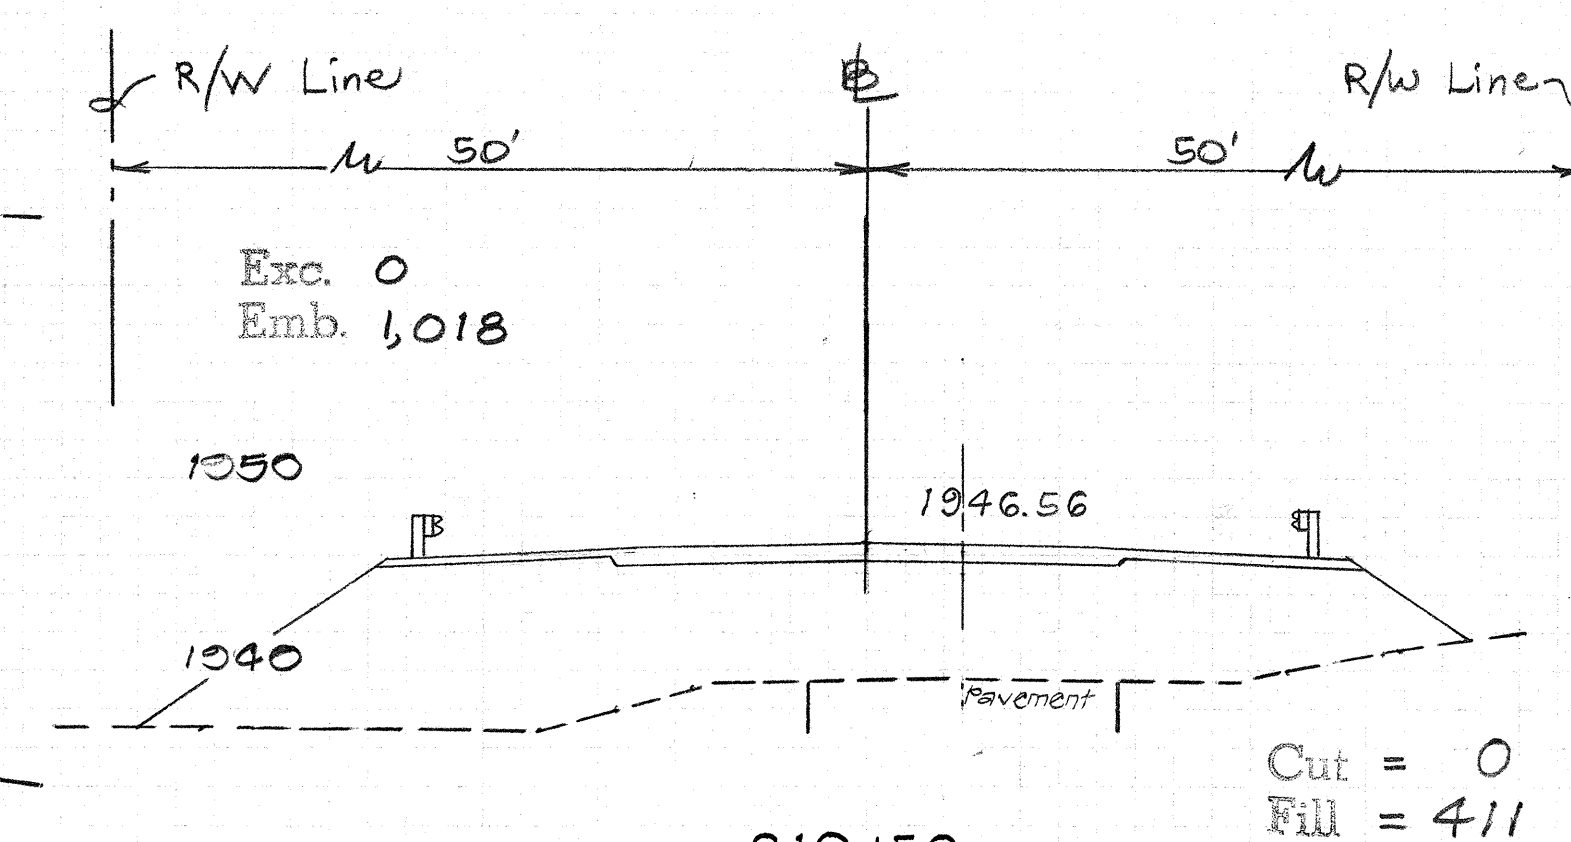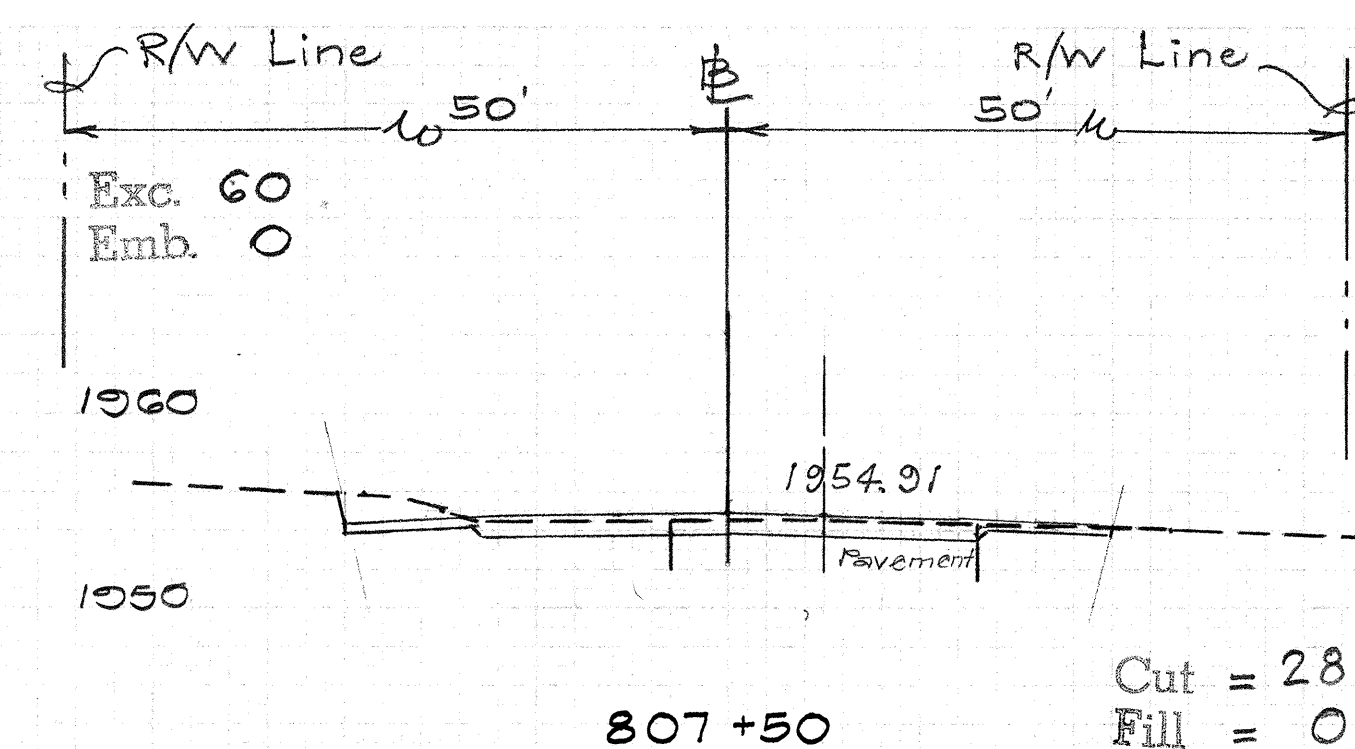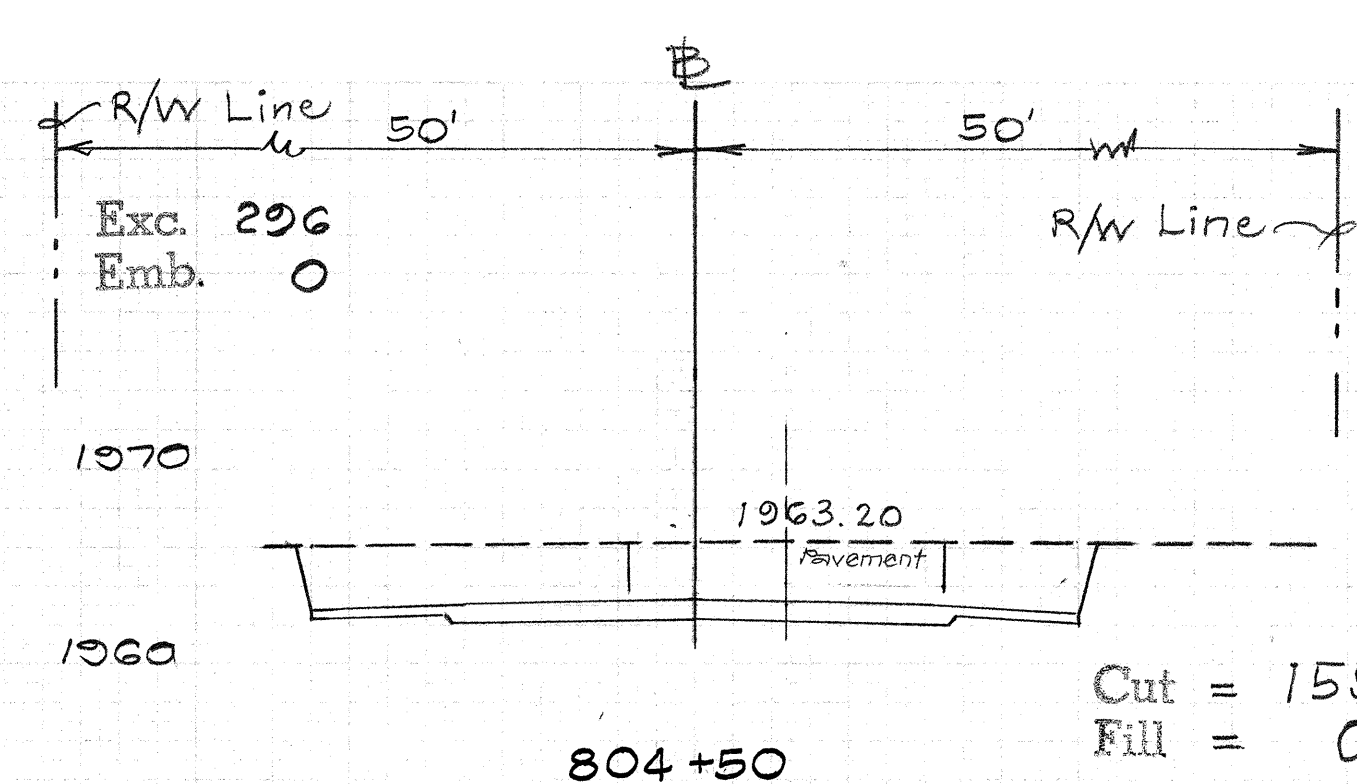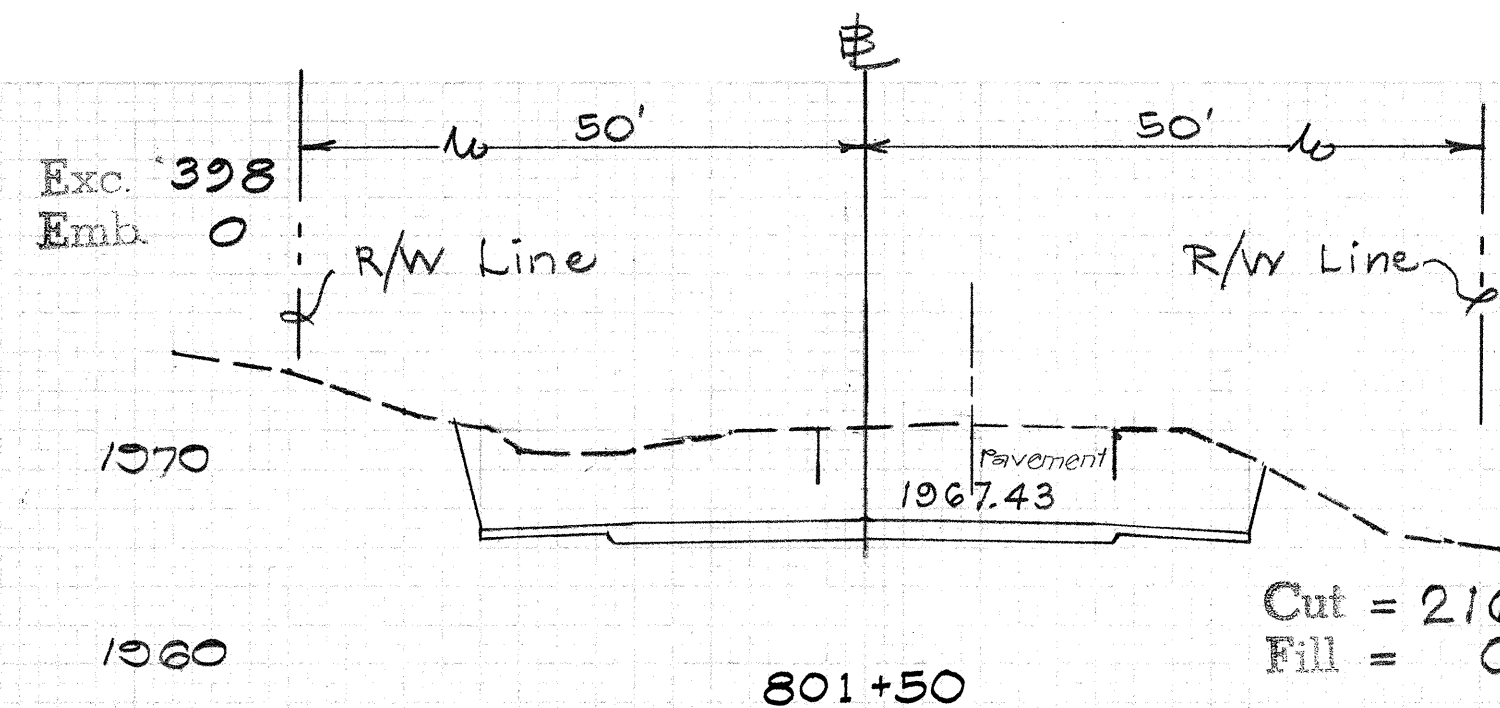










FED. ROAD DIST. NO.	STATE	PROJ. NO.	FISCAL YEAR	SHEET NO.	TOTAL SHEETS
HAWAII	HAW.	11E-01-75	1975	44	45

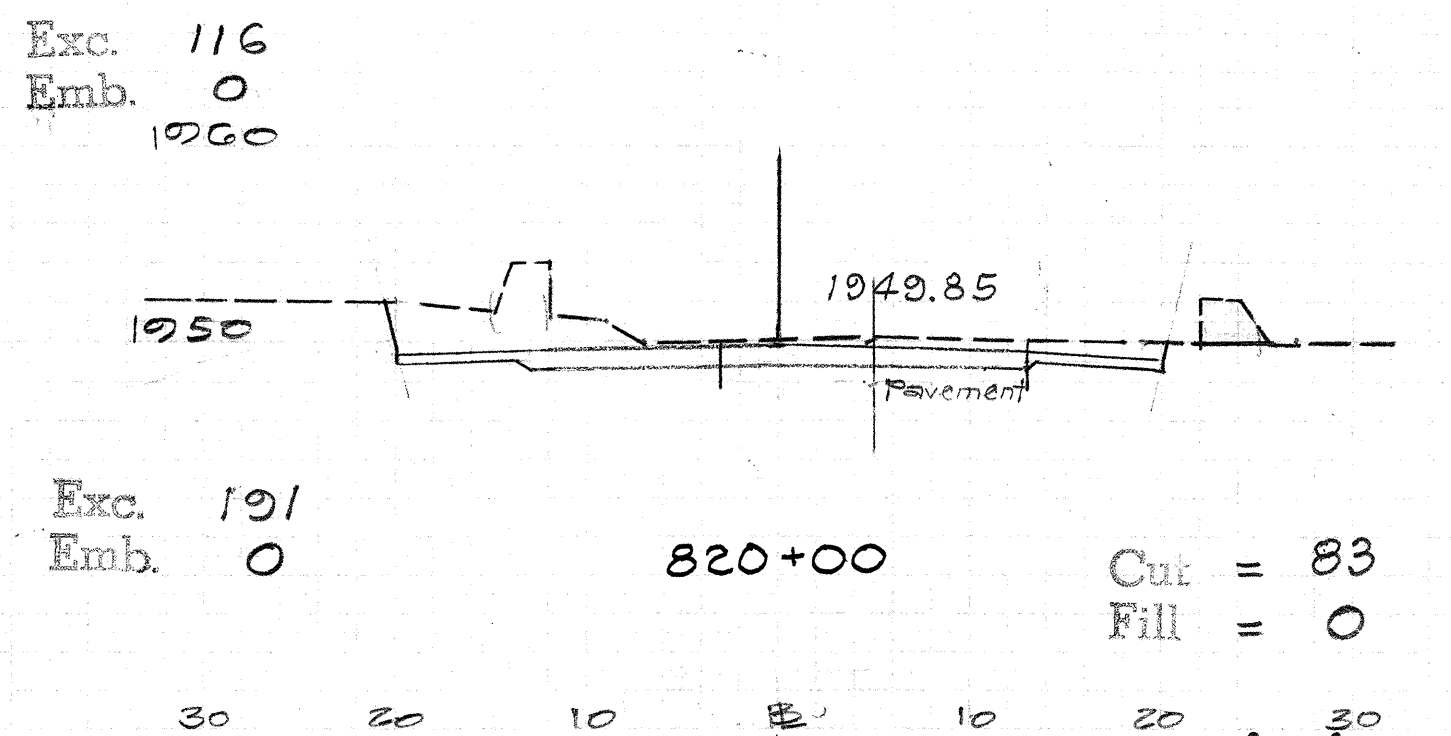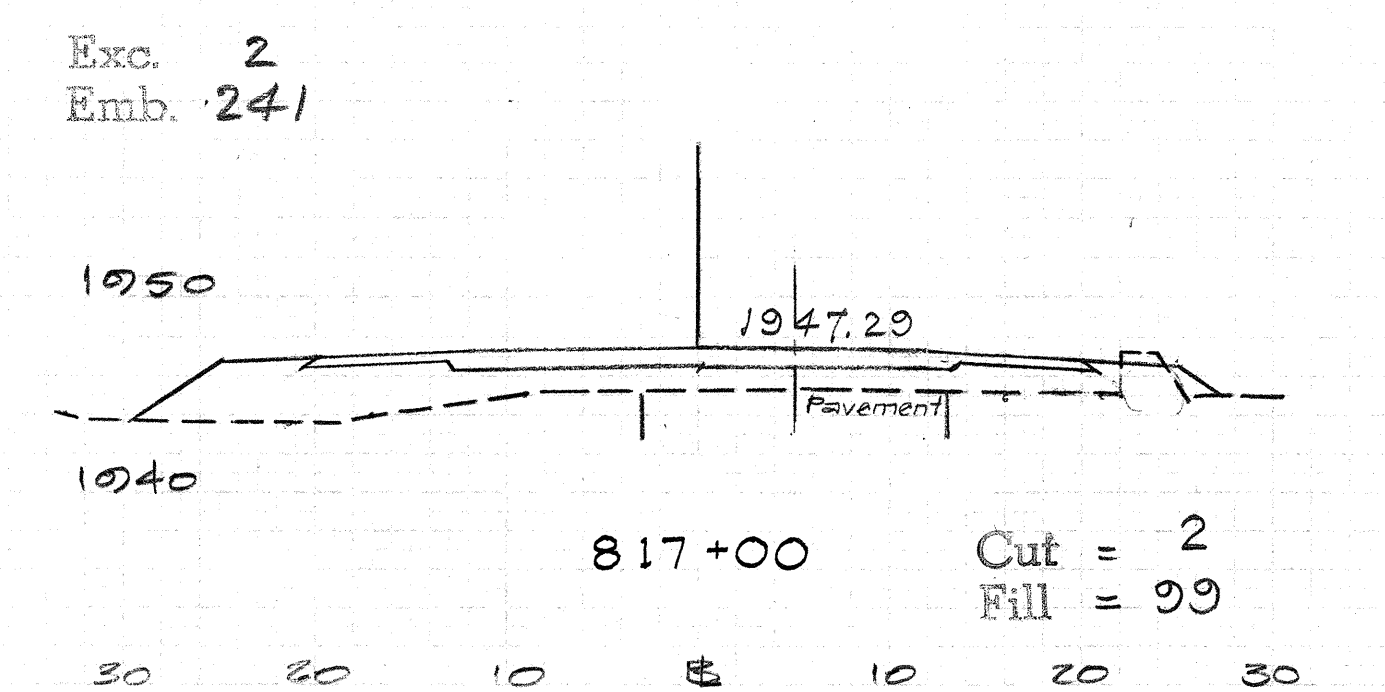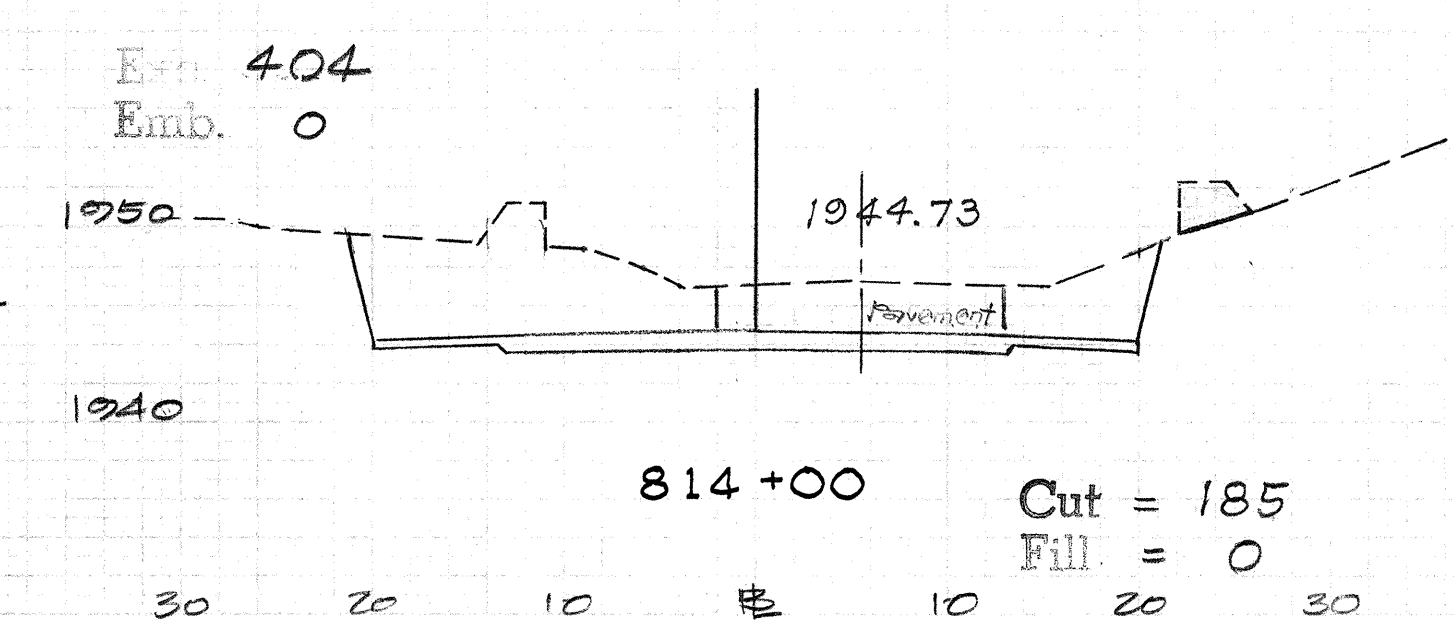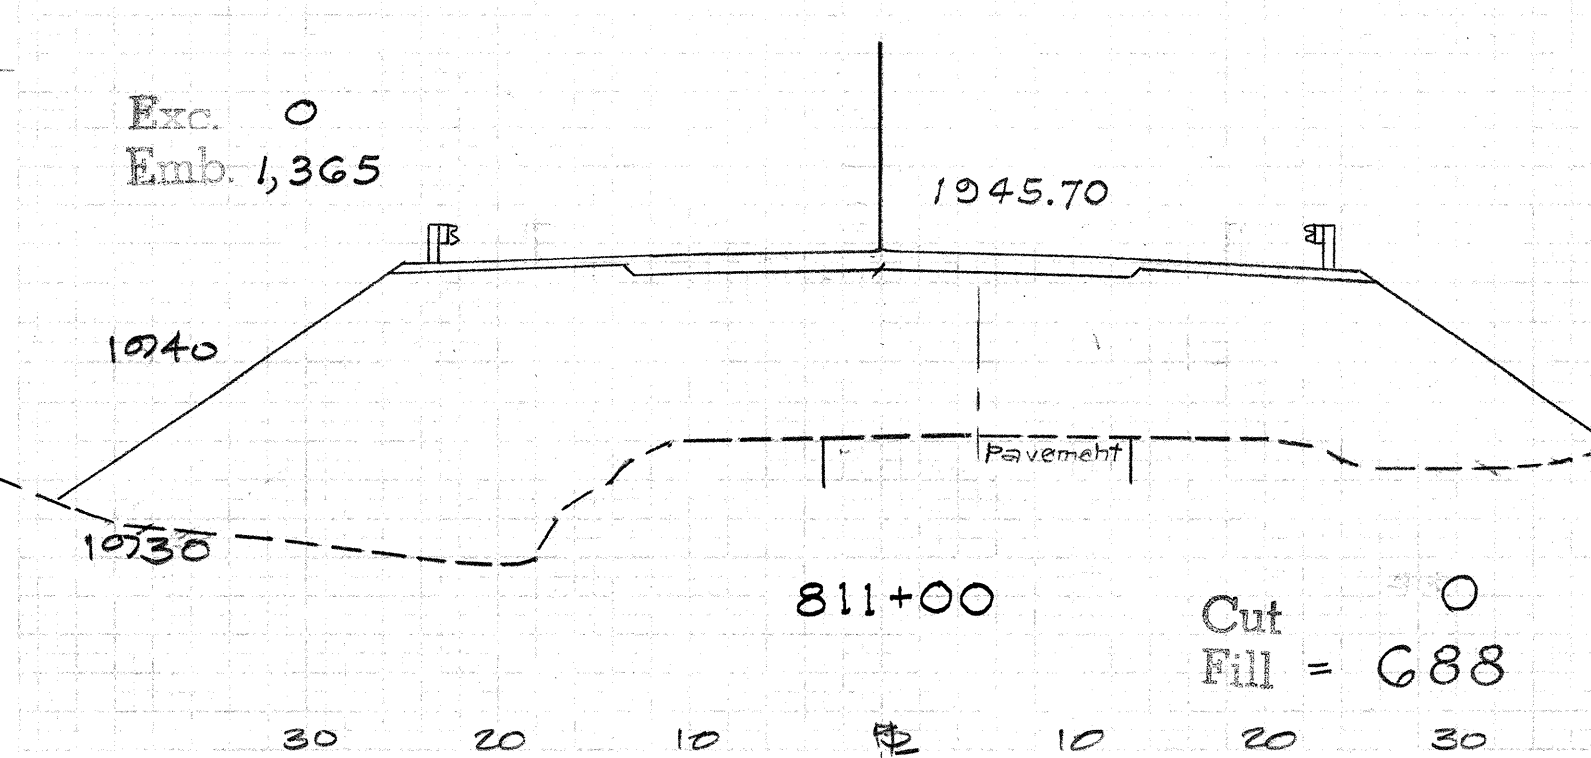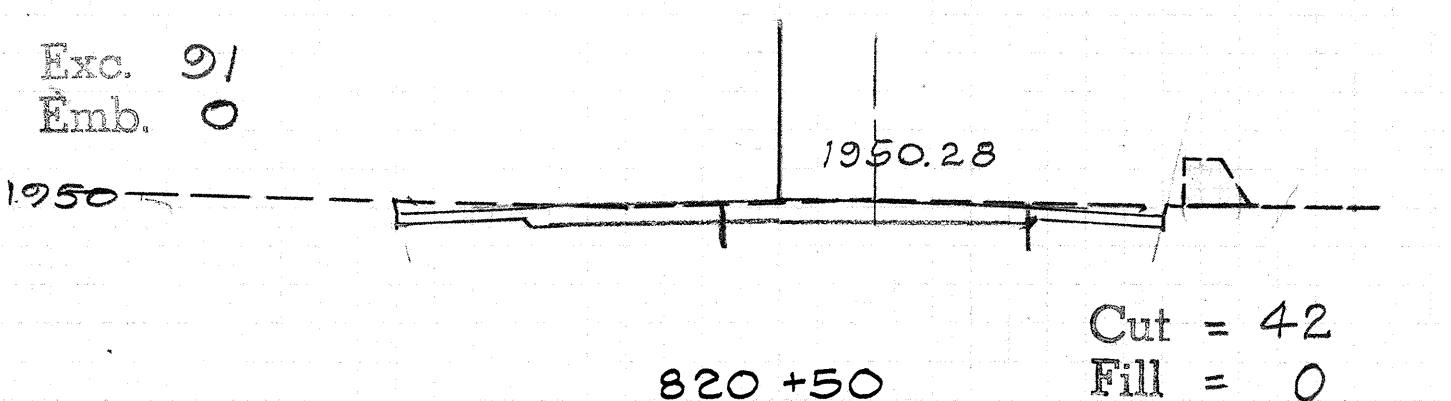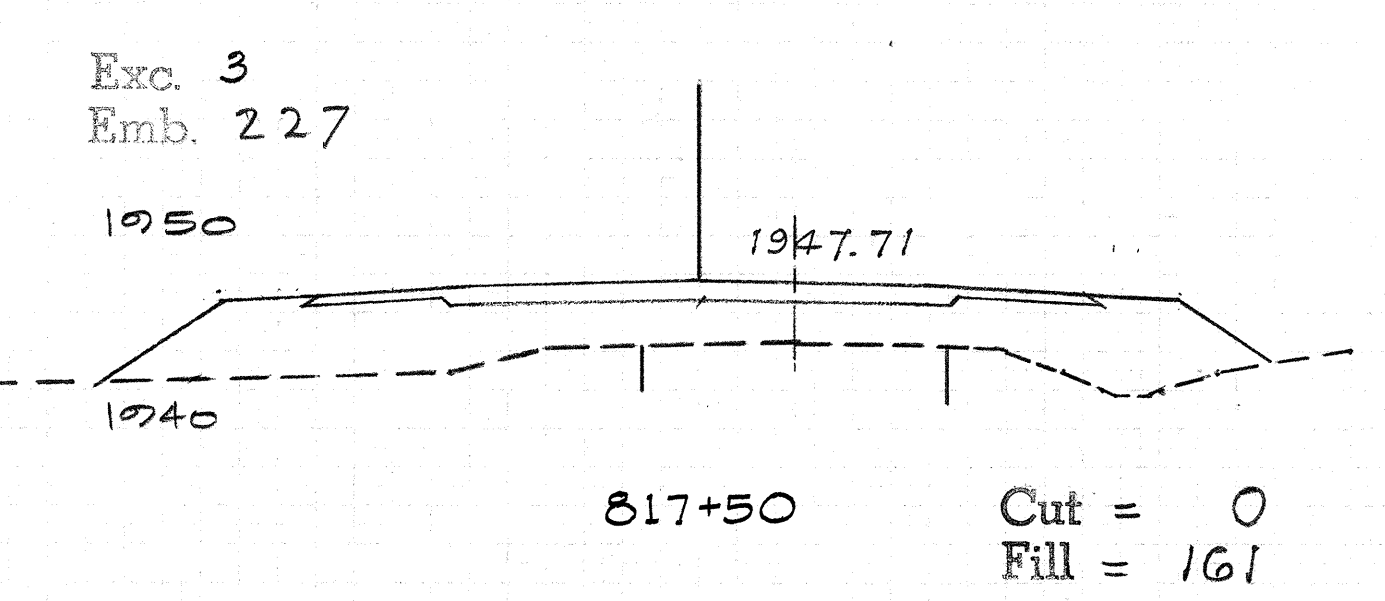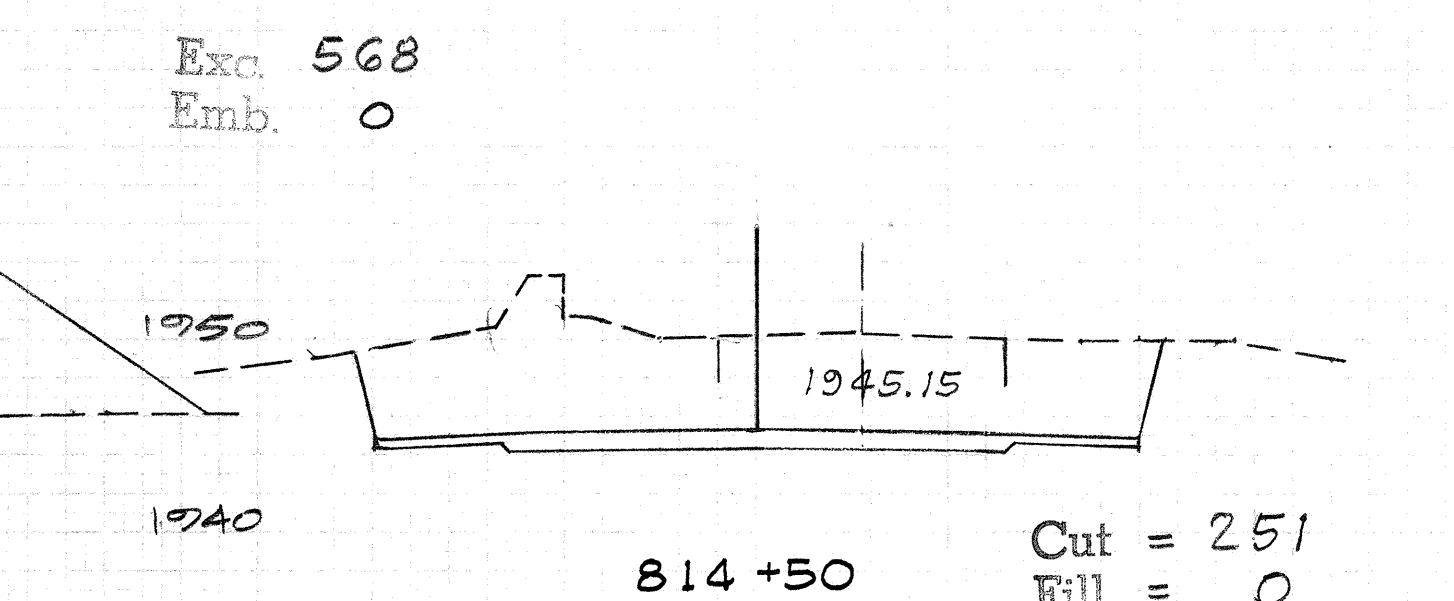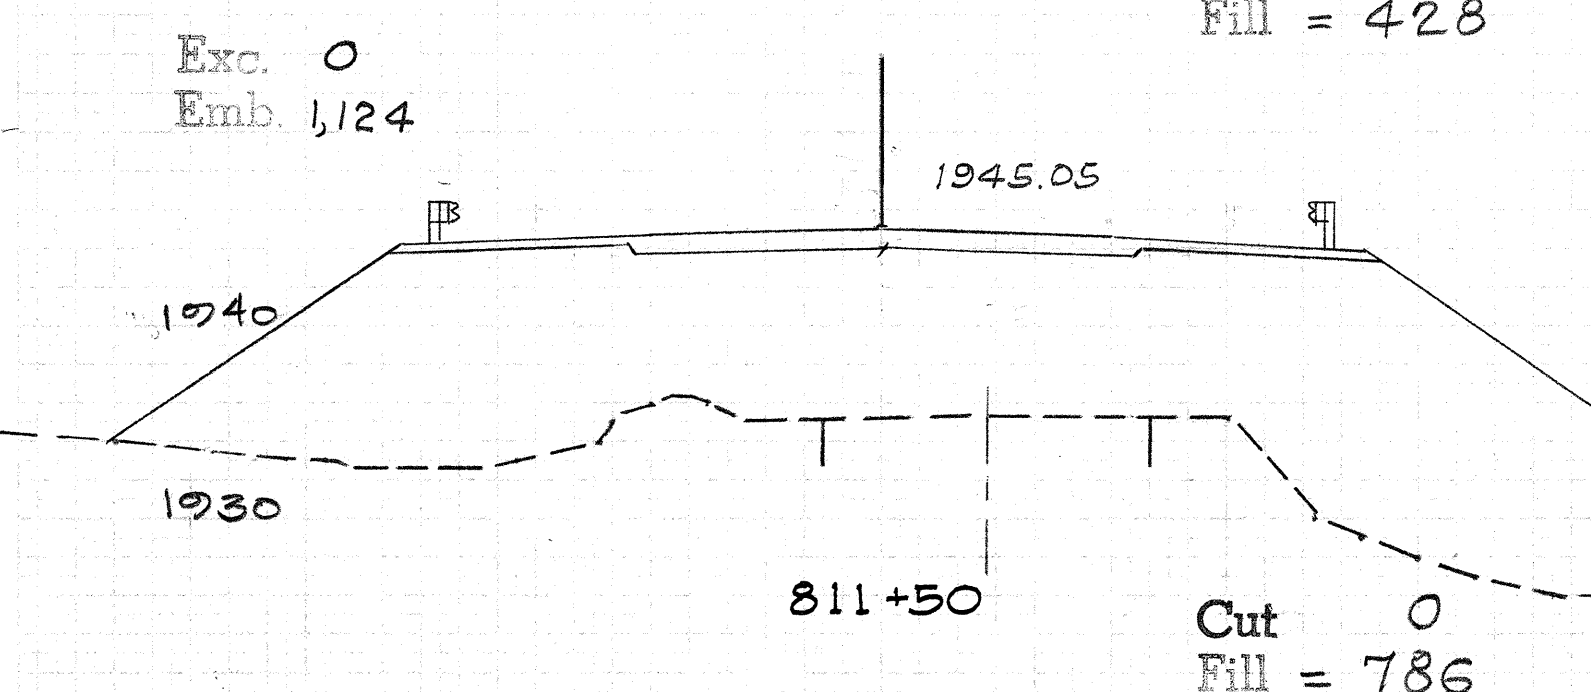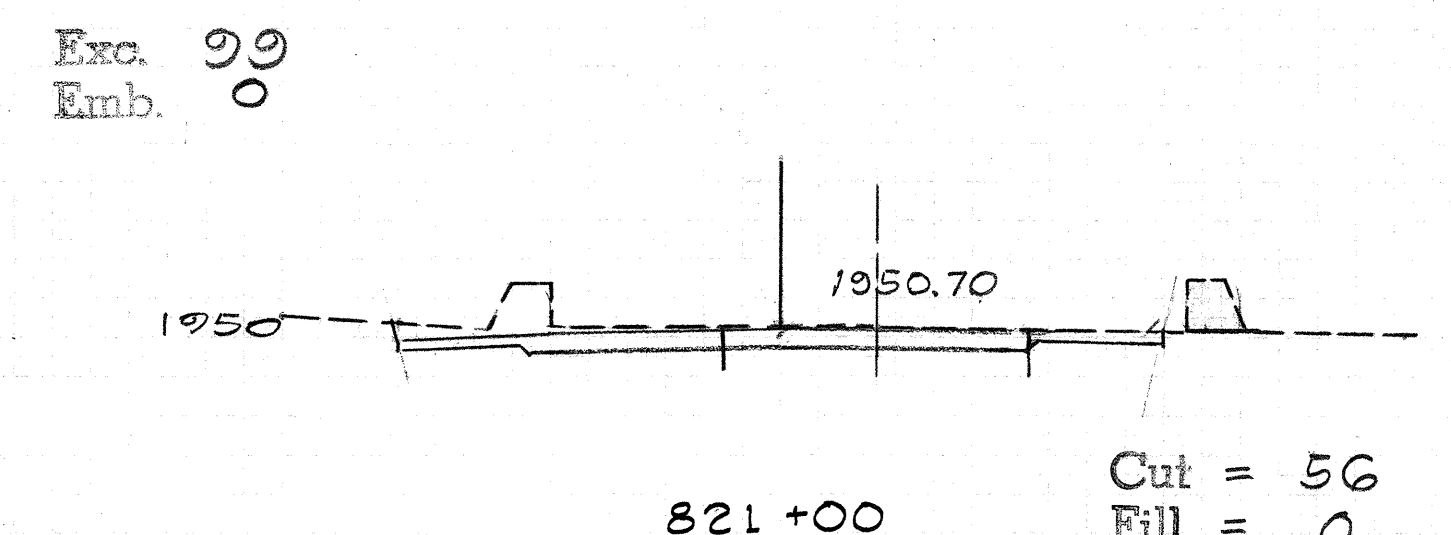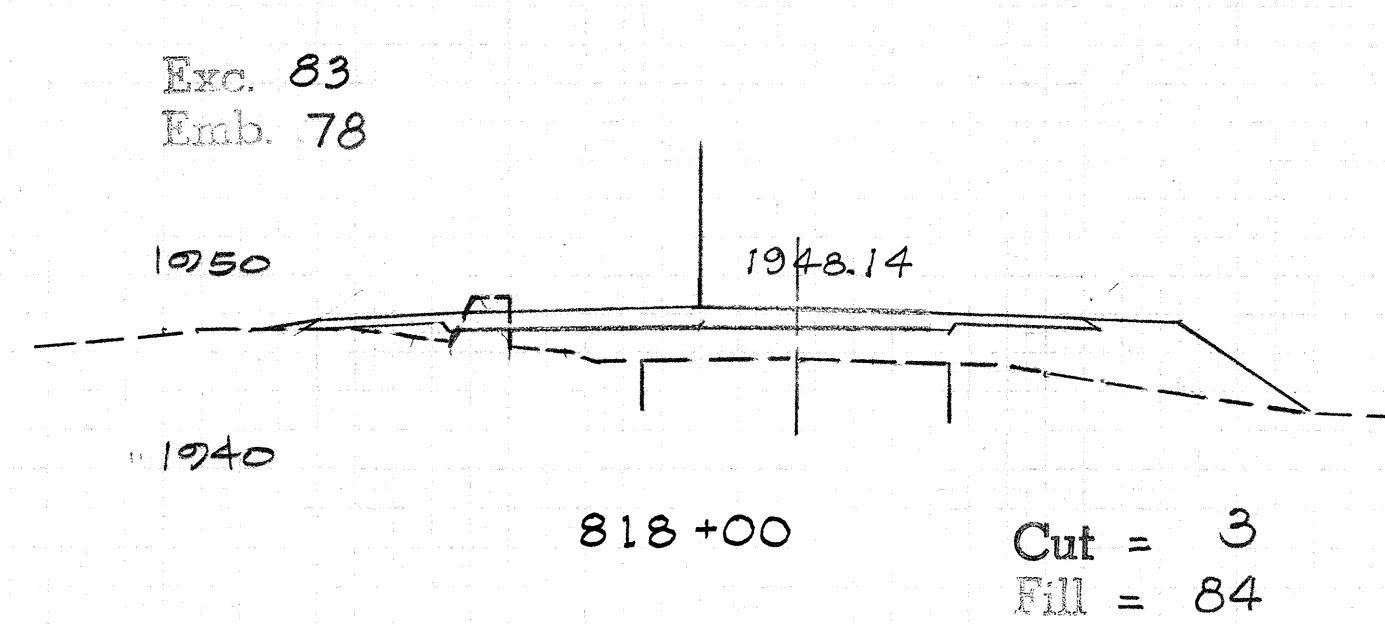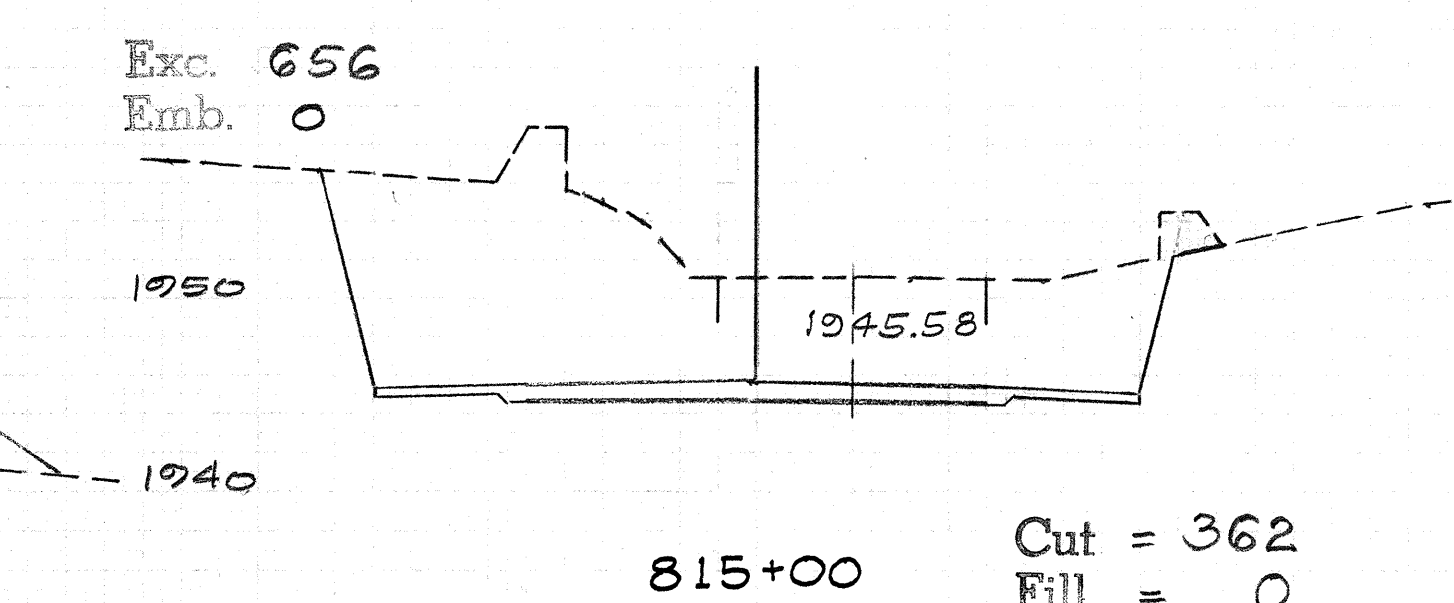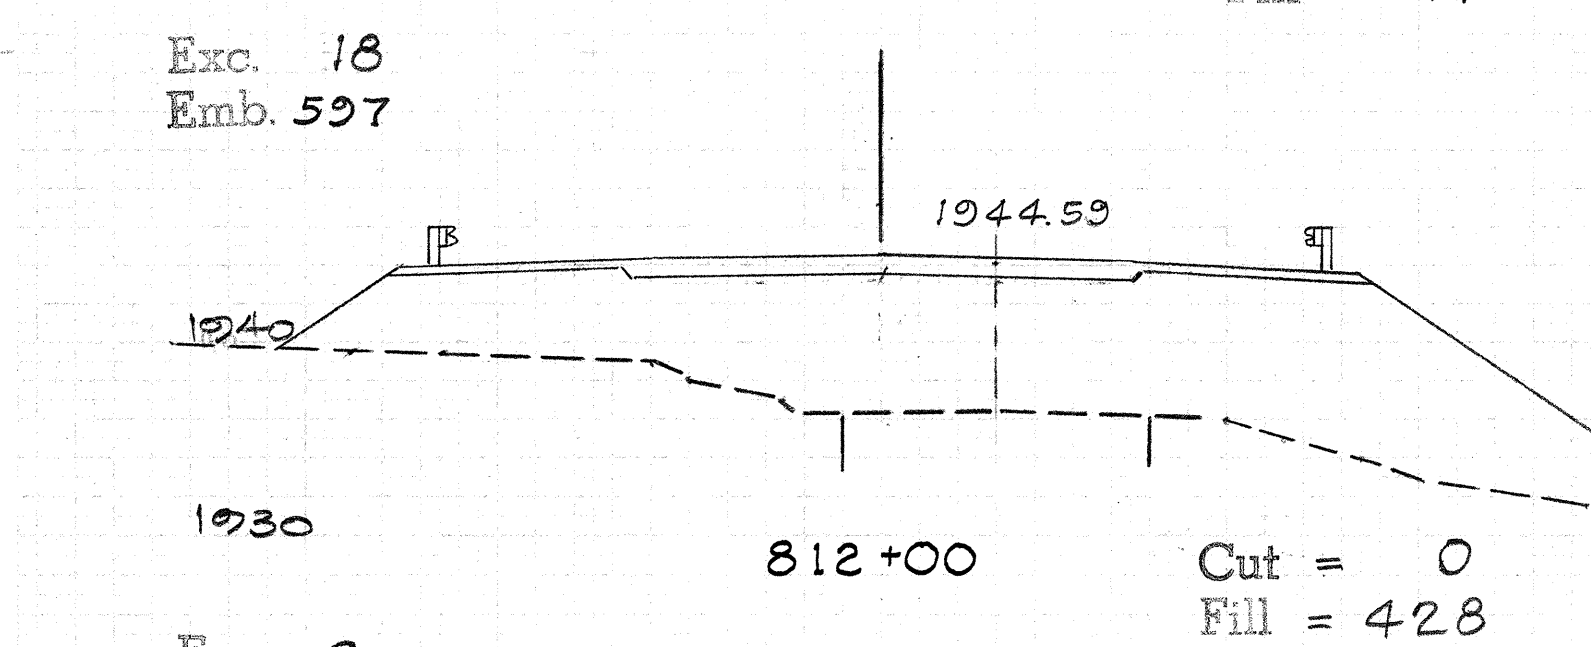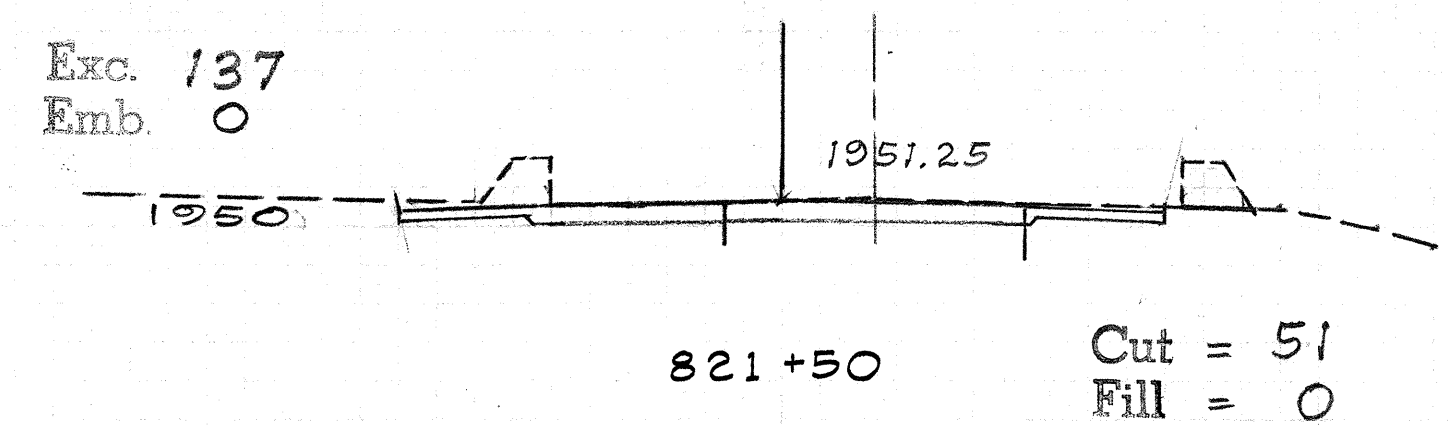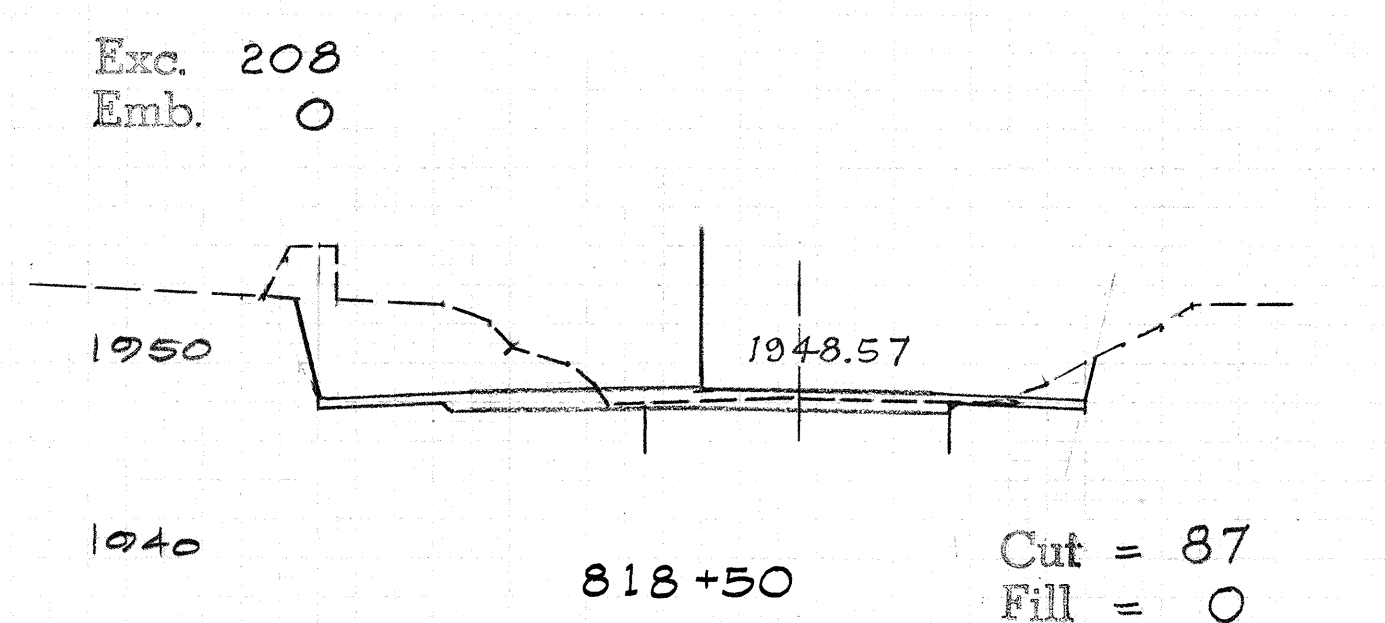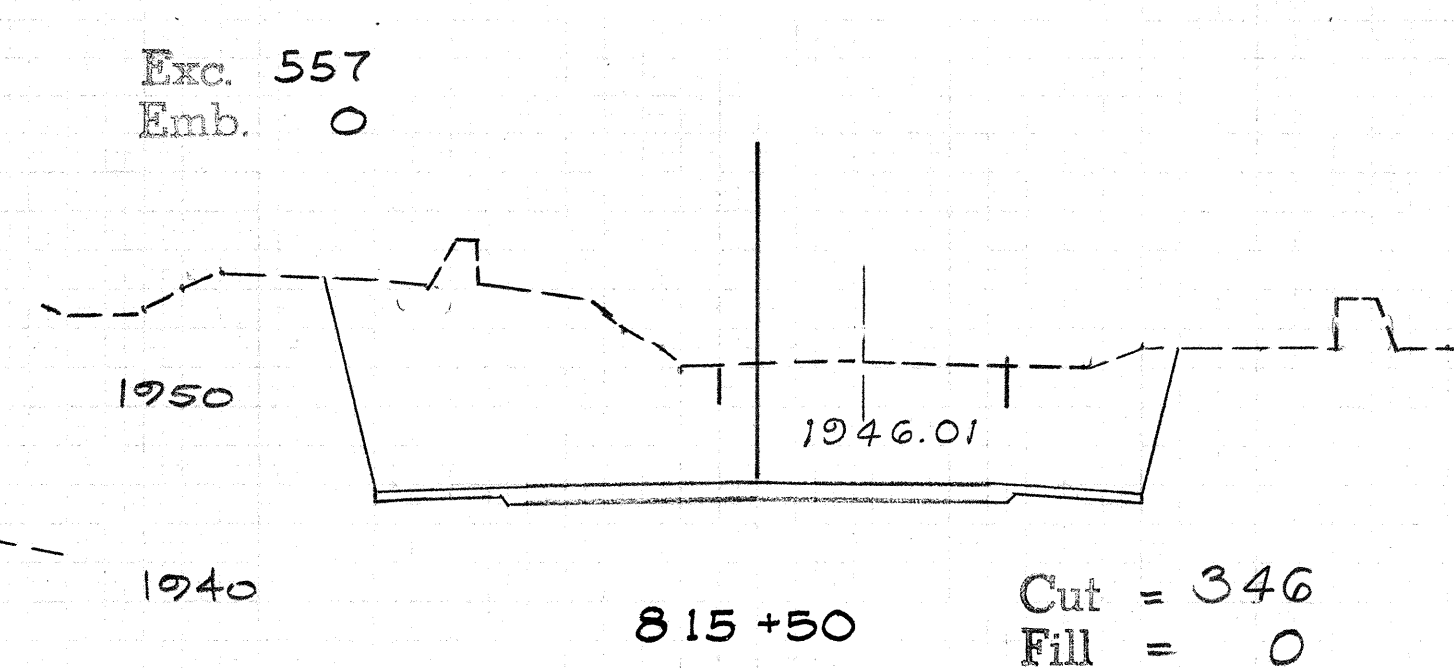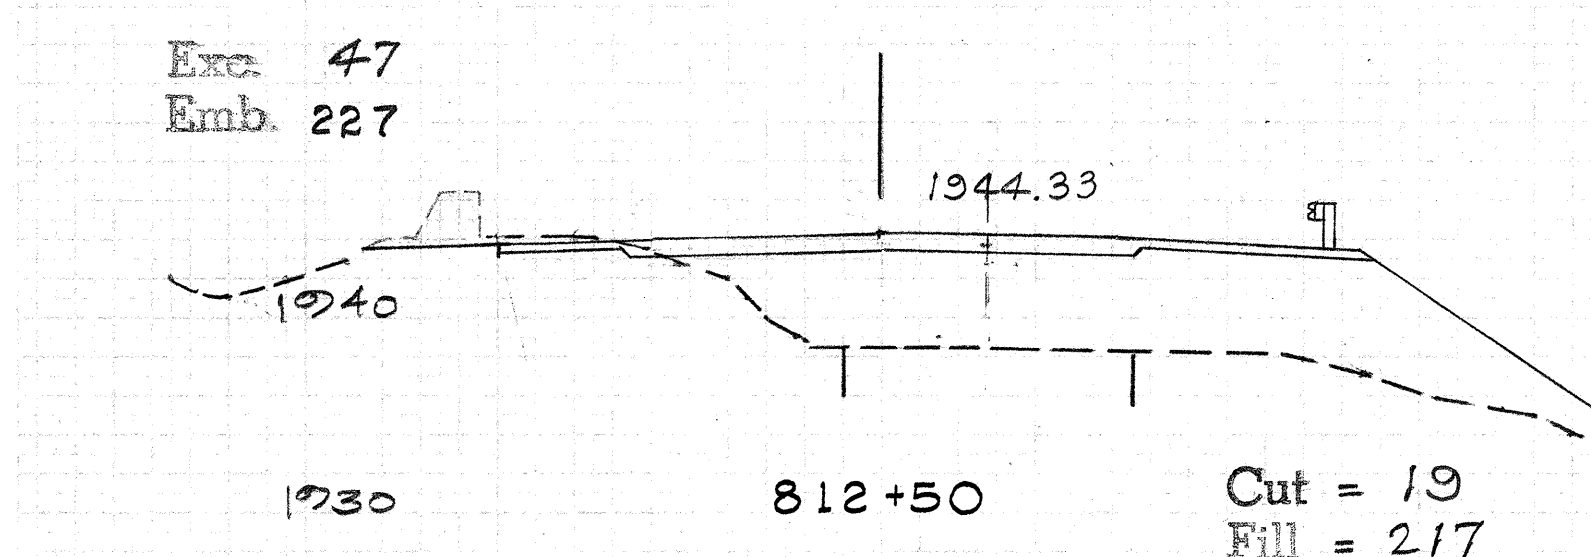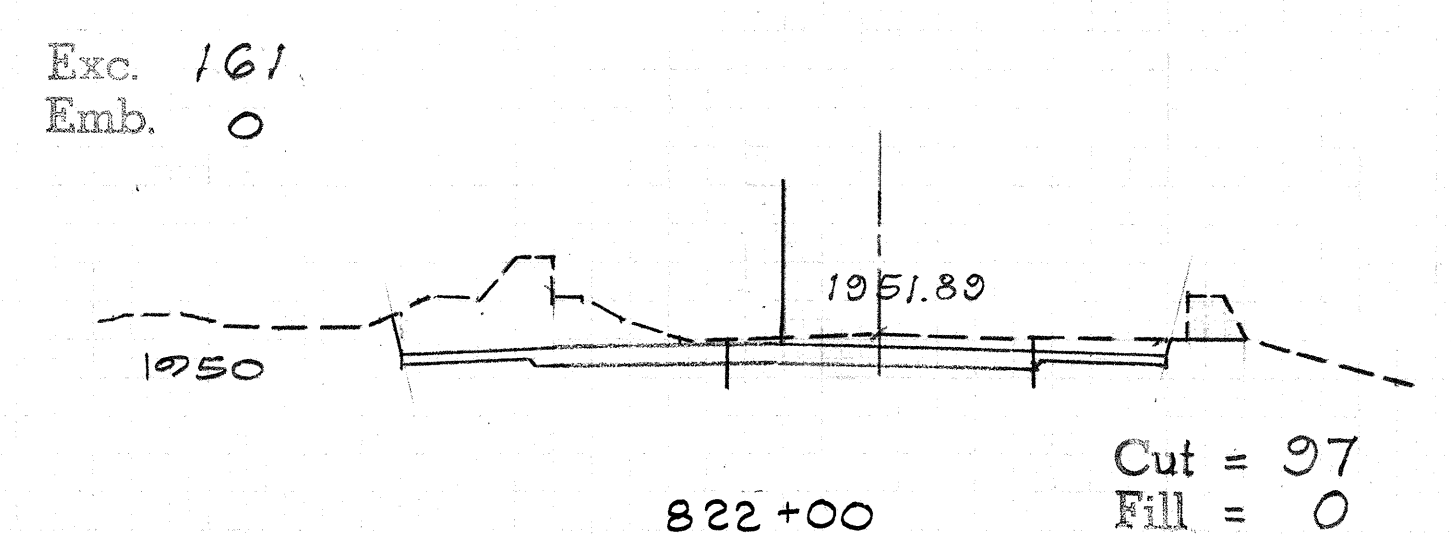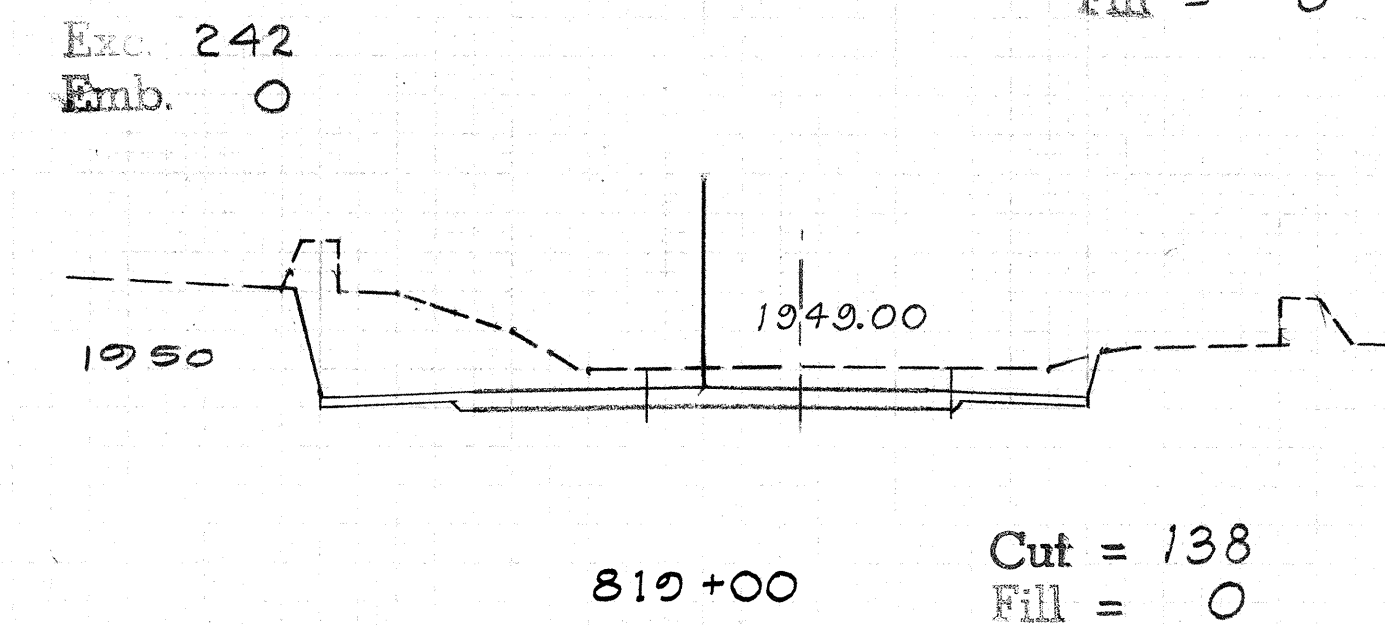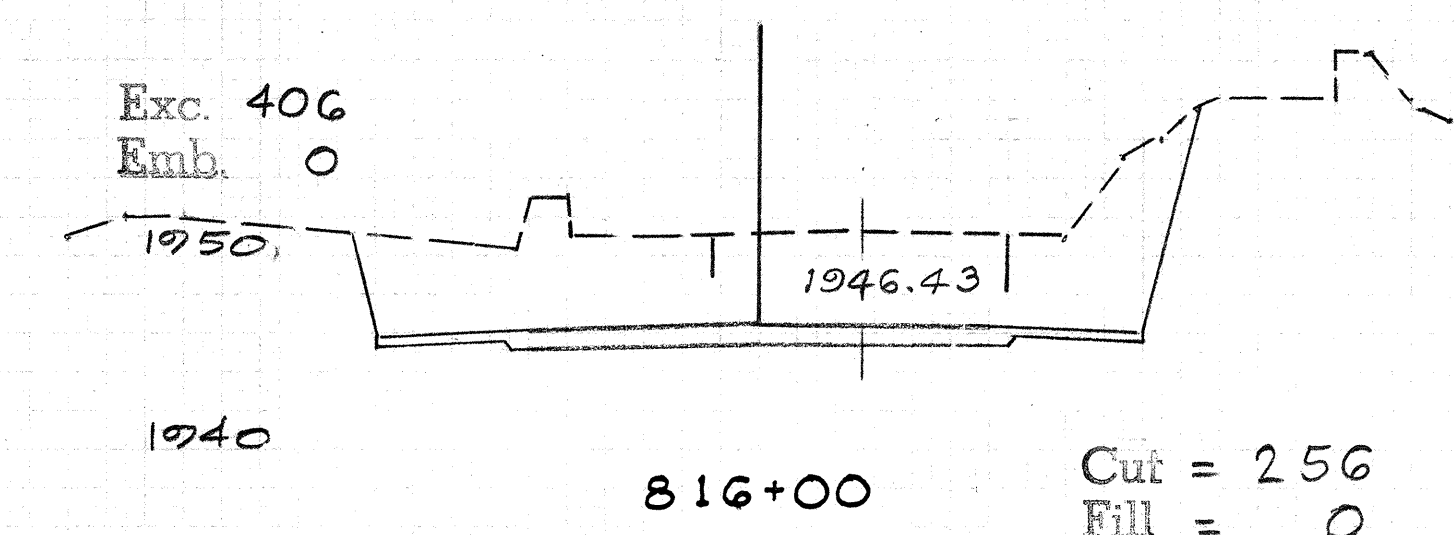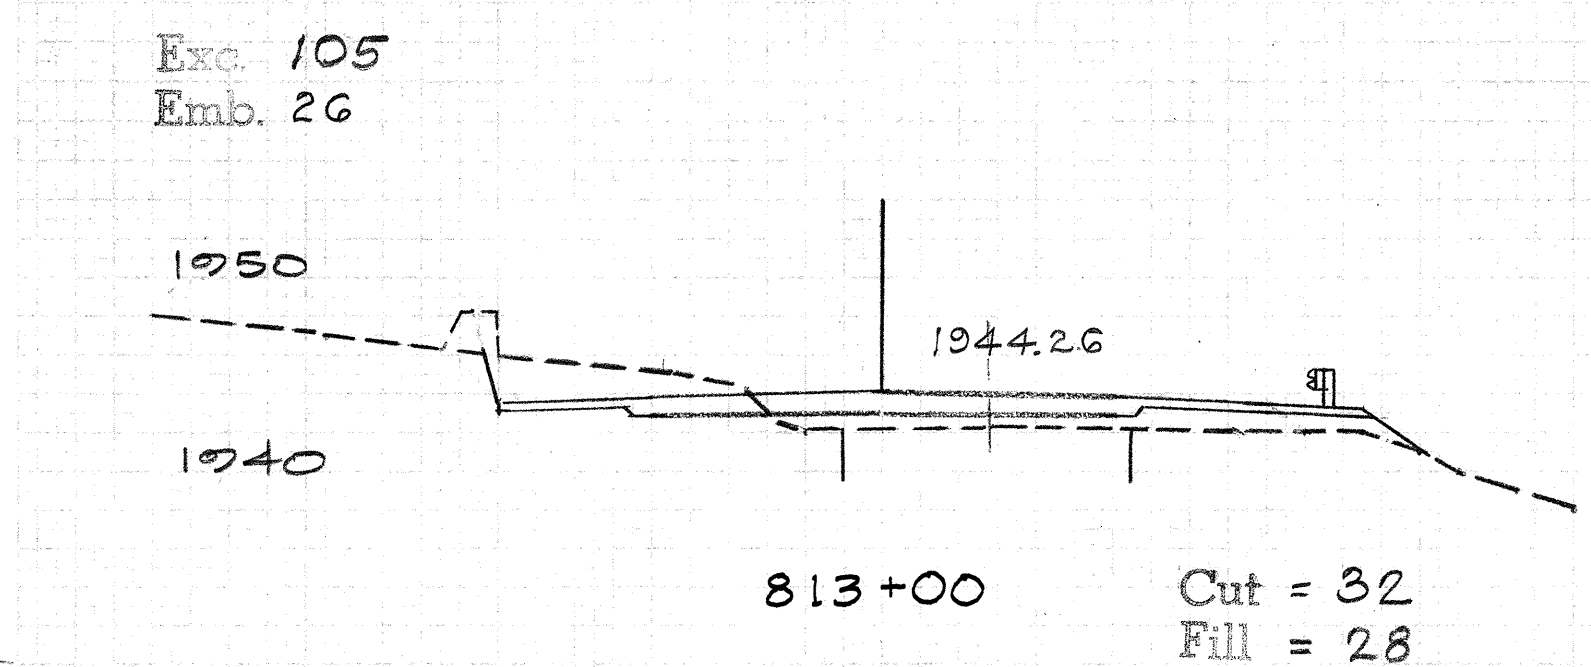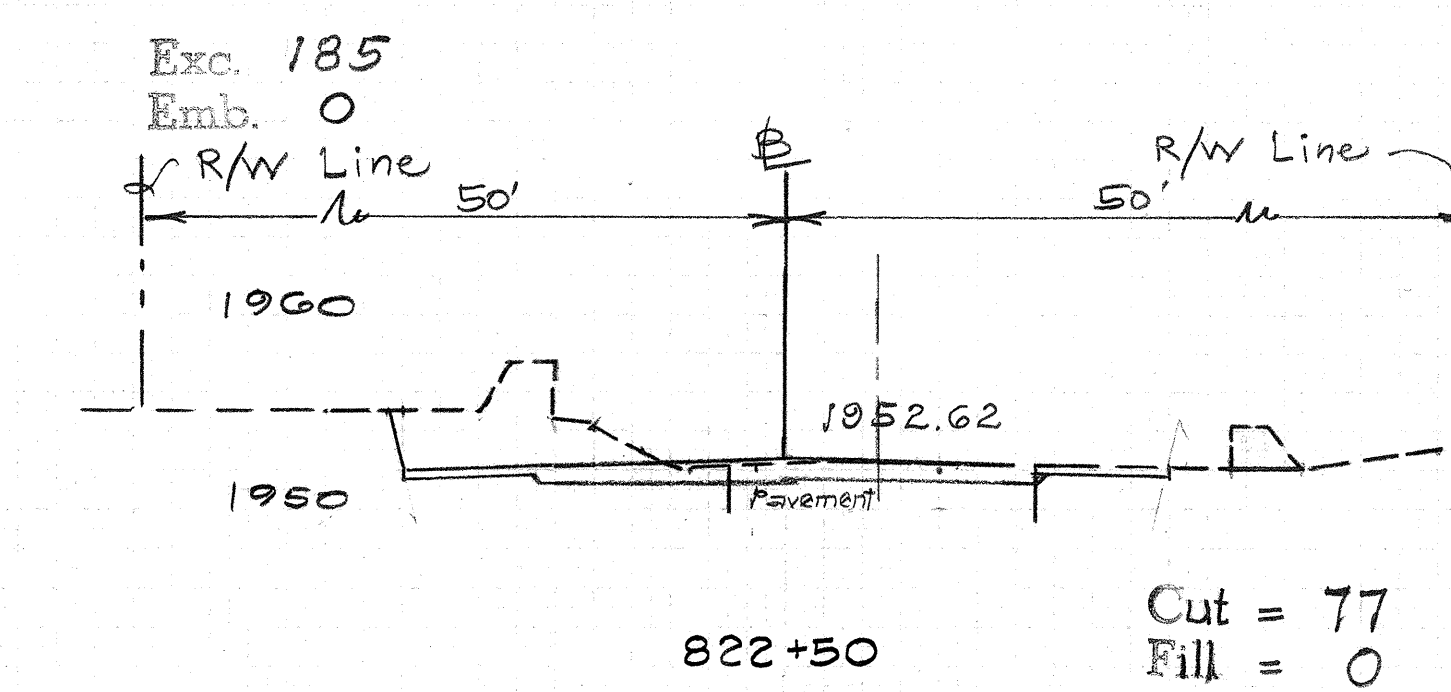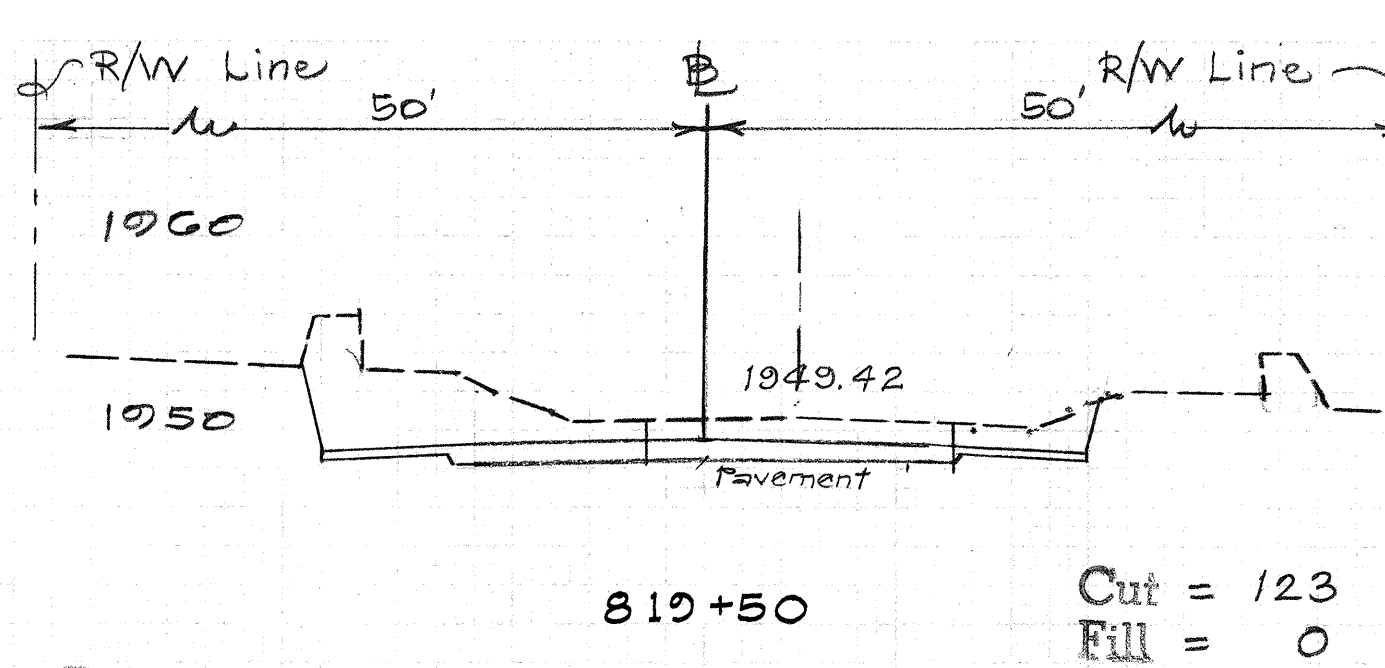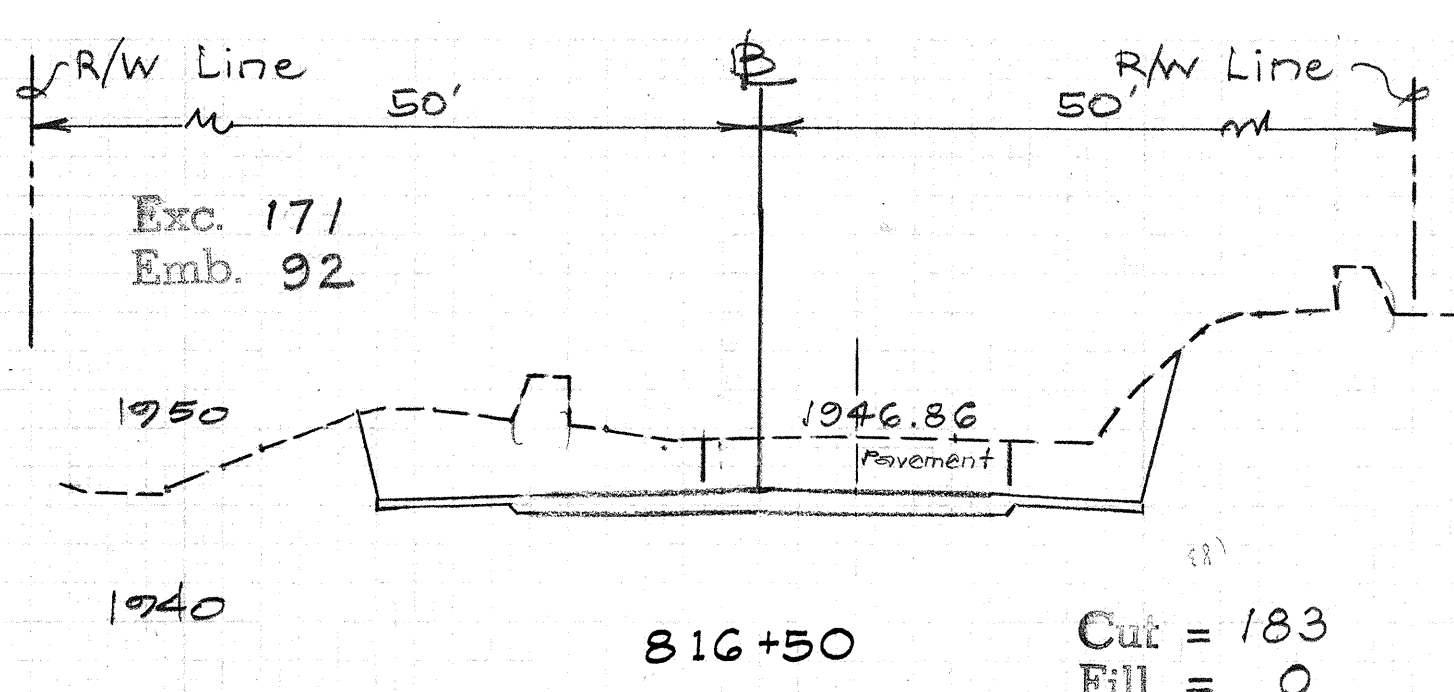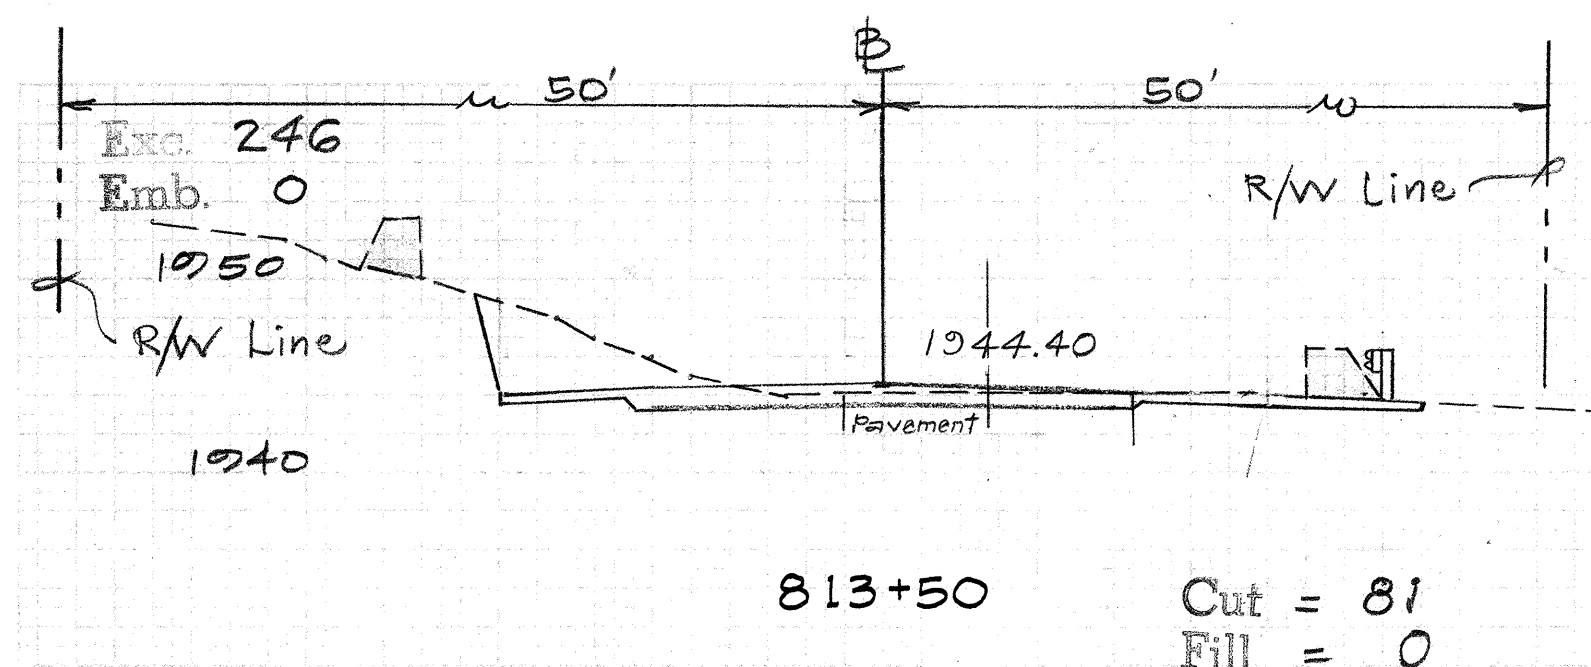

FED. ROAD DIST. NO.	STATE	PROJ. NO.	FISCAL YEAR	SHEET NO.	TOTAL SHEETS
HAWAII	HAW.	JIE-01-75	1975	45	45




DATE	BY	REVIEWED	DATE
NO.	AREA	NO.	AREA

DATE	BY	REVIEWED	DATE
NO.	AREA	NO.	AREA

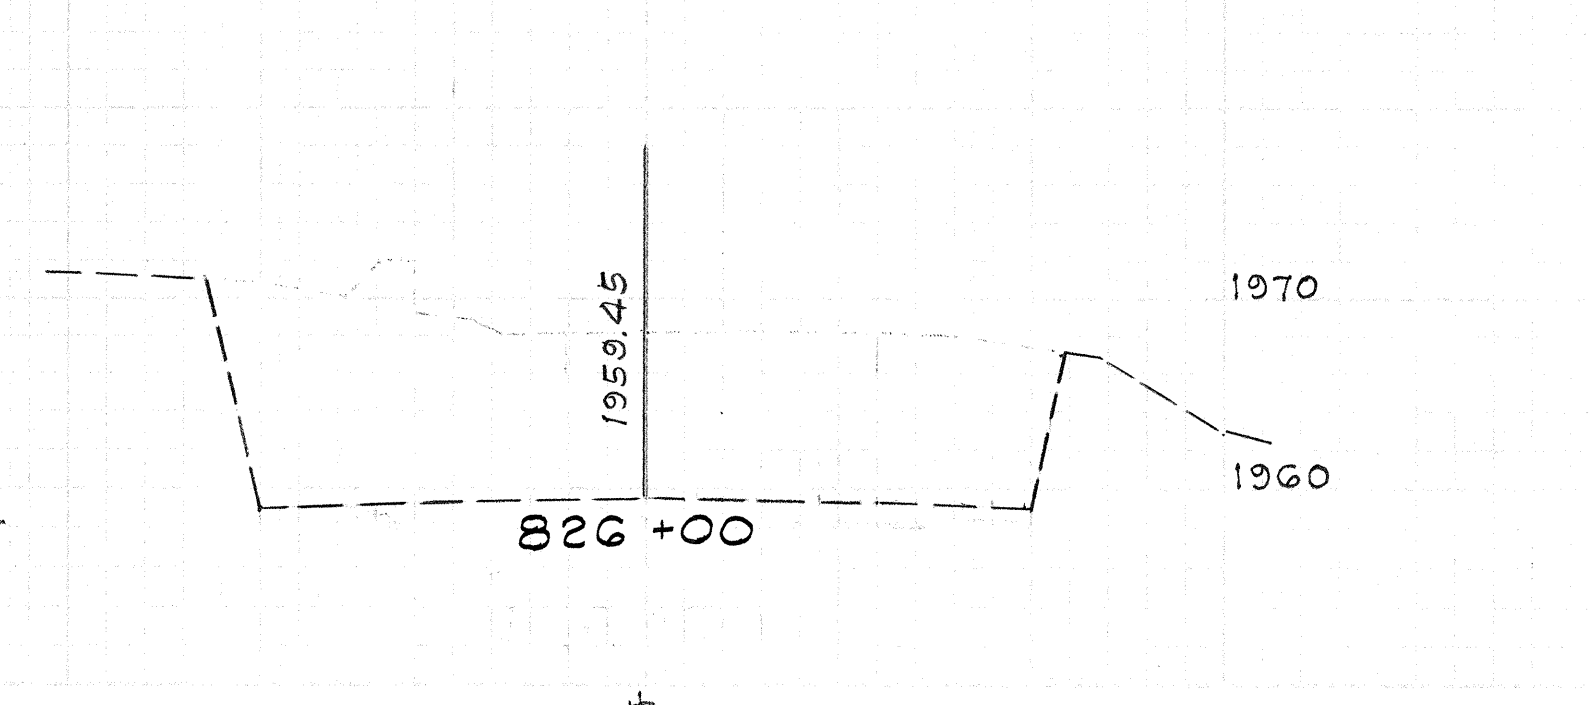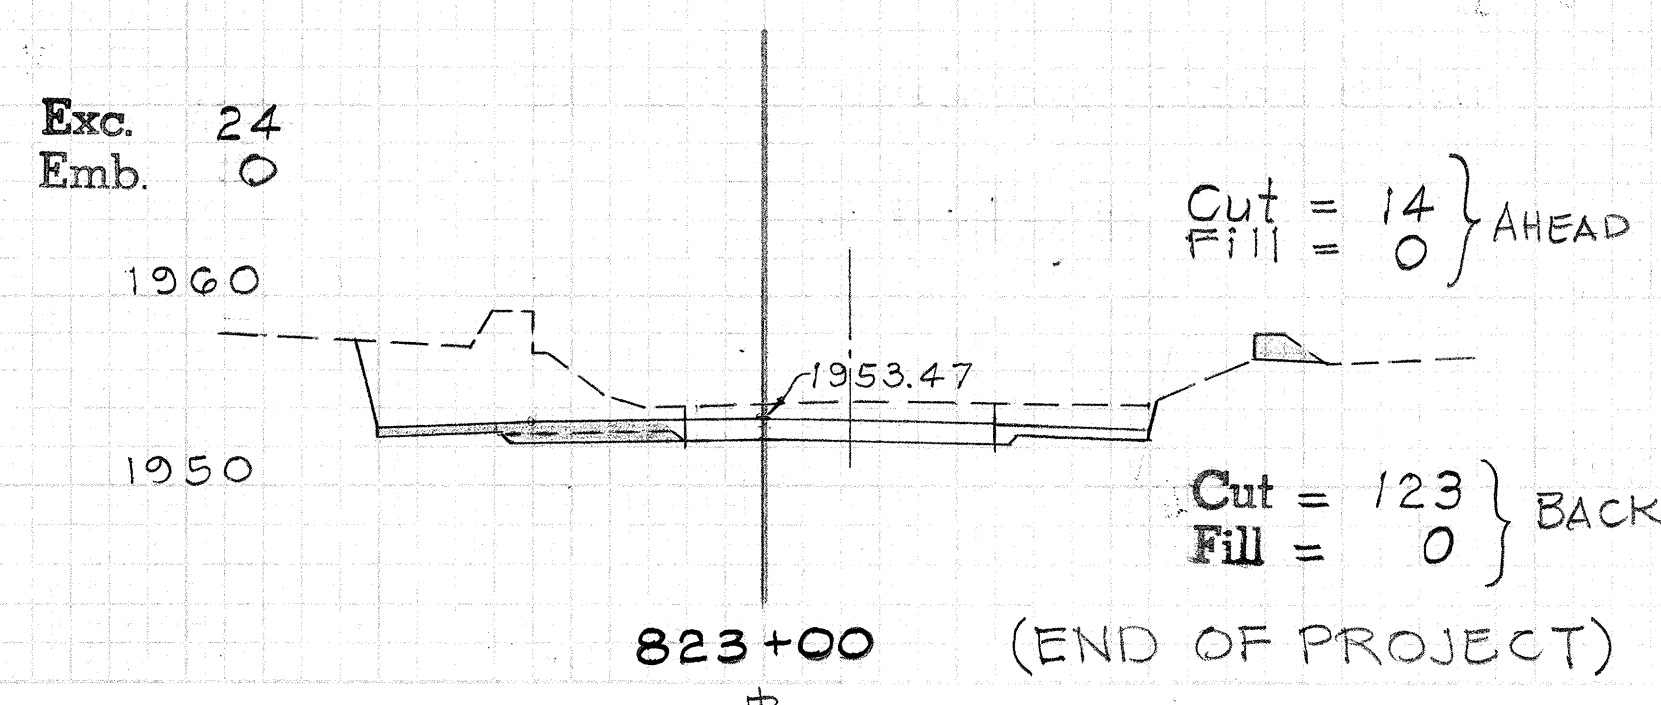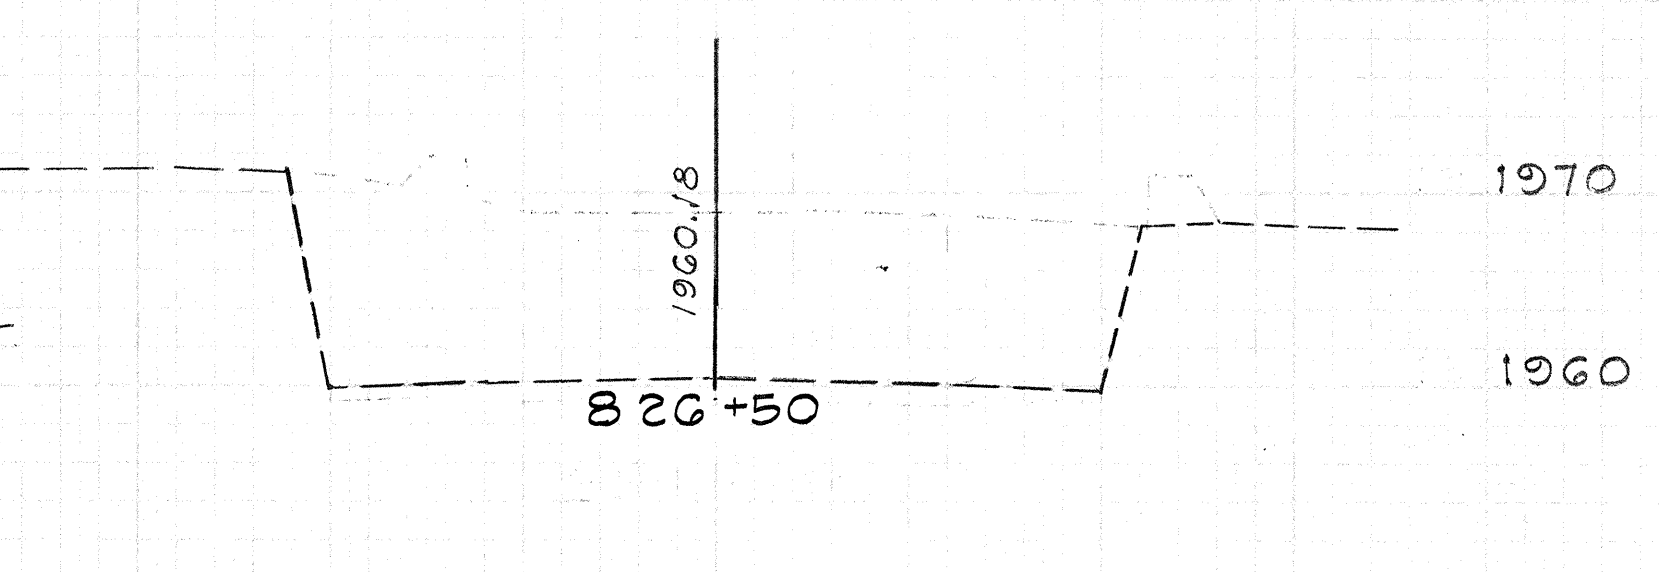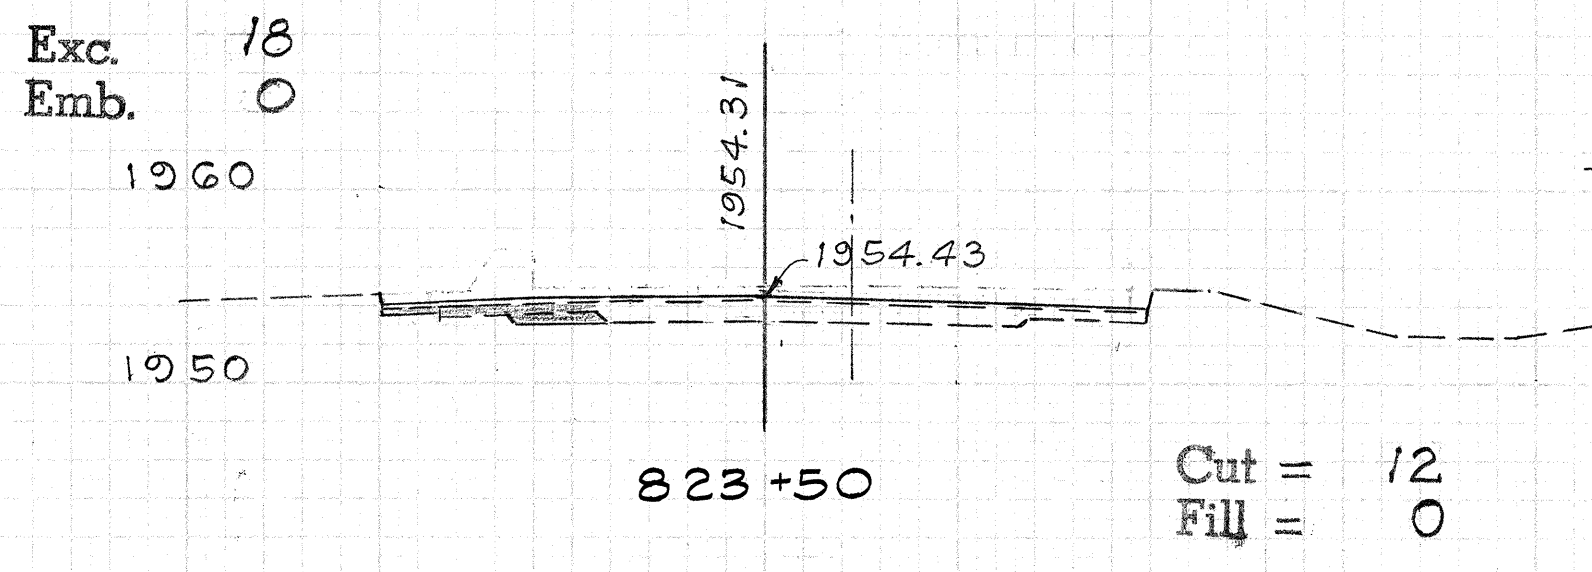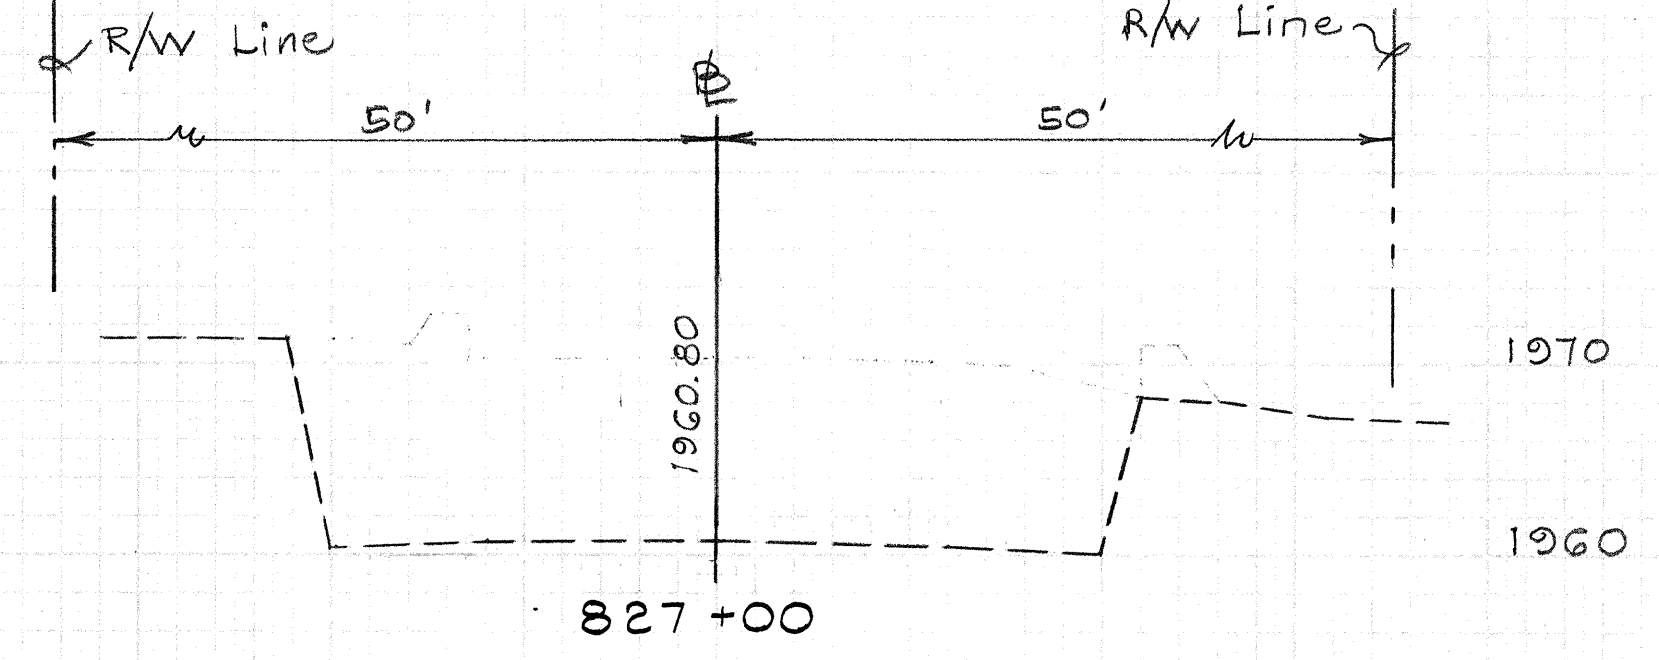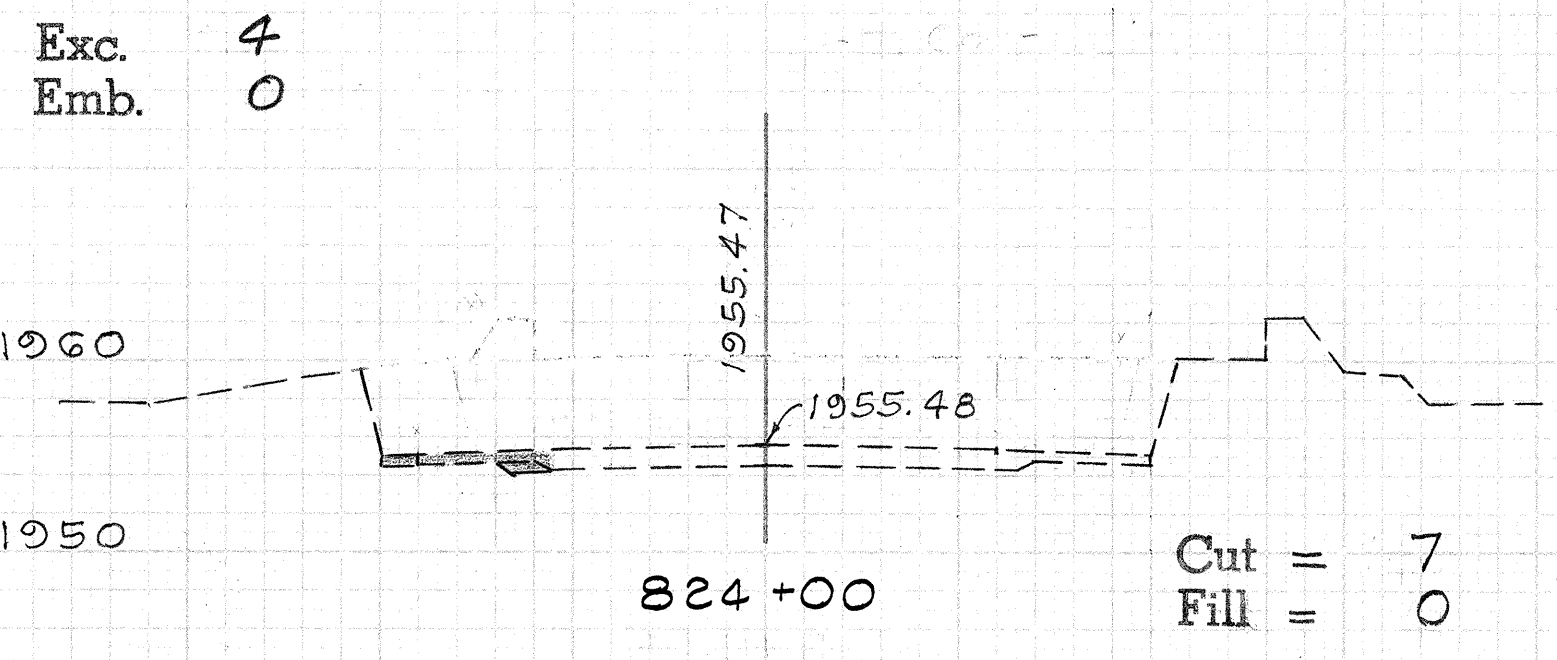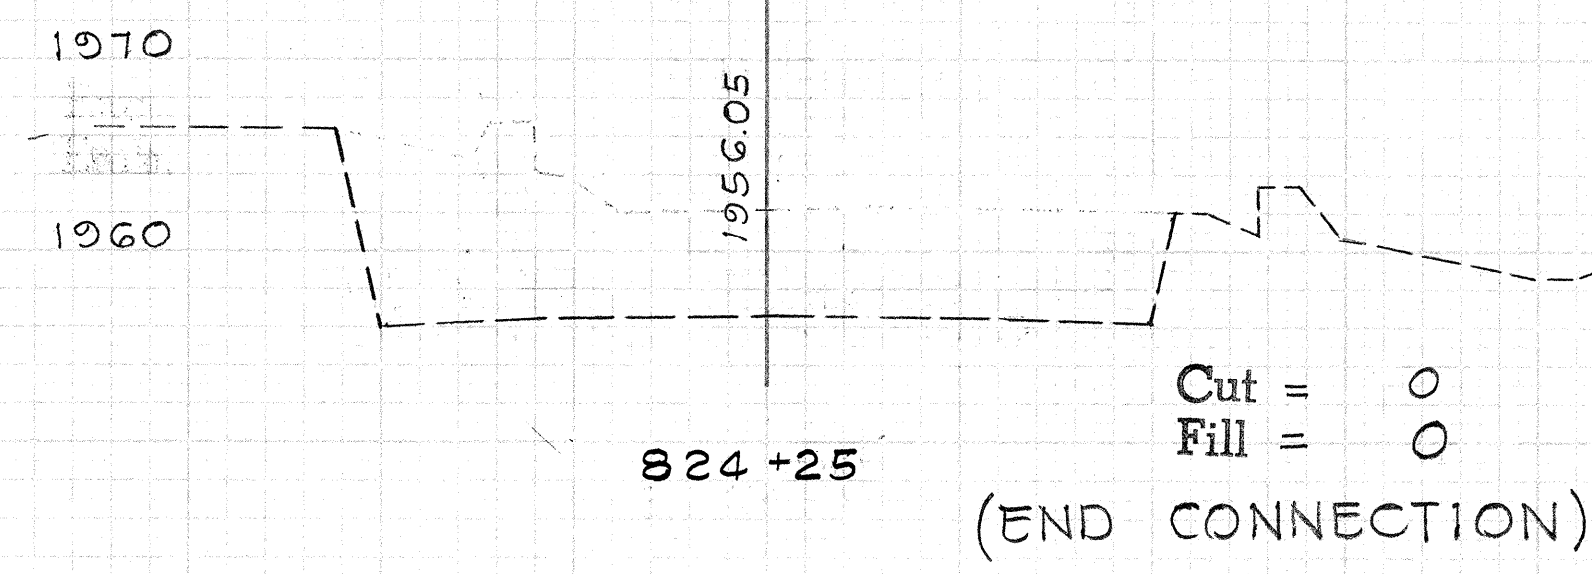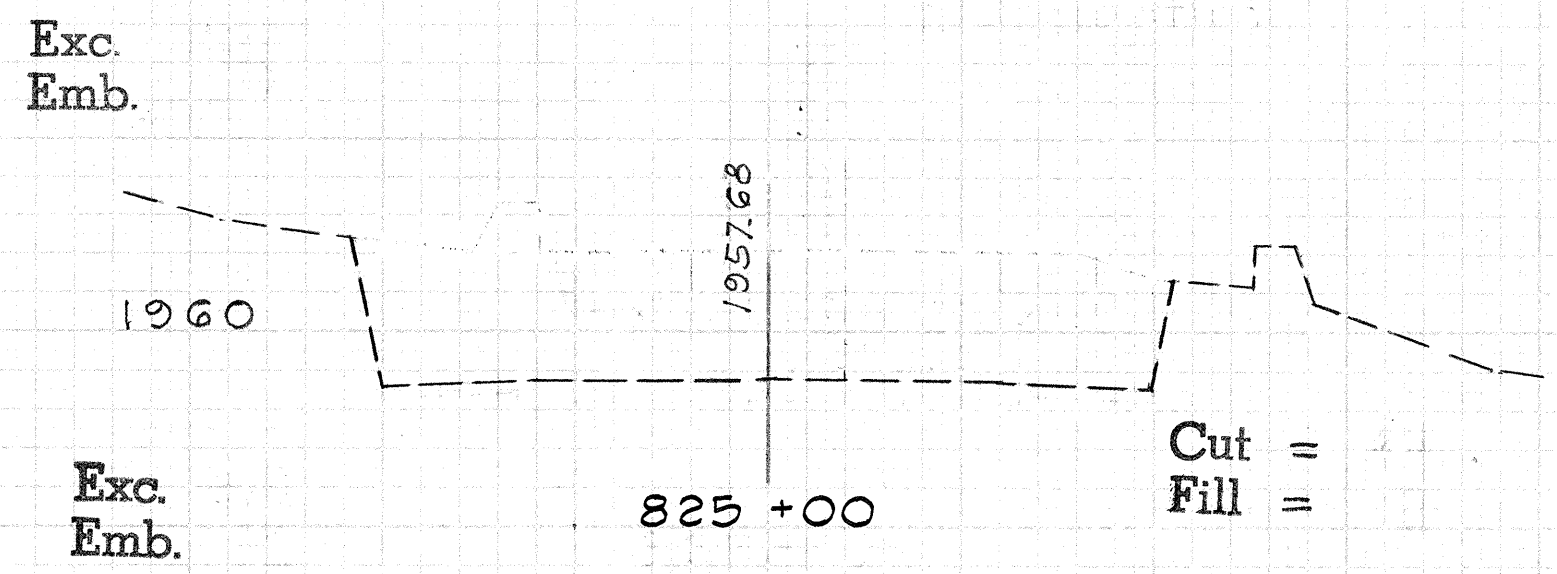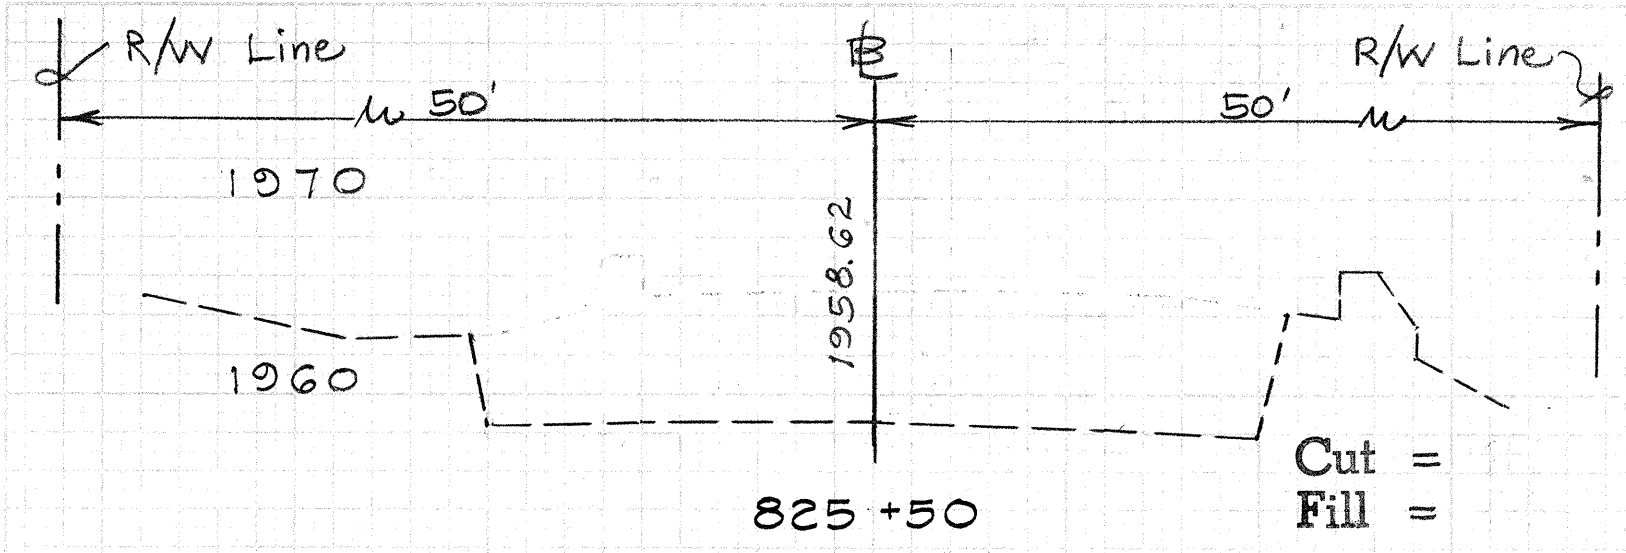

FED. ROAD DIST. NO.	STATE	PROJ. NO.	FISCAL YEAR	SHEET NO.	TOTAL SHEETS
HAWAII	HAW.	11E-01-75	1975	604554	45

FINAL SURVEY	DATE
NO. 1	1975
NO. 2	1975
NO. 3	1975
NO. 100	1975

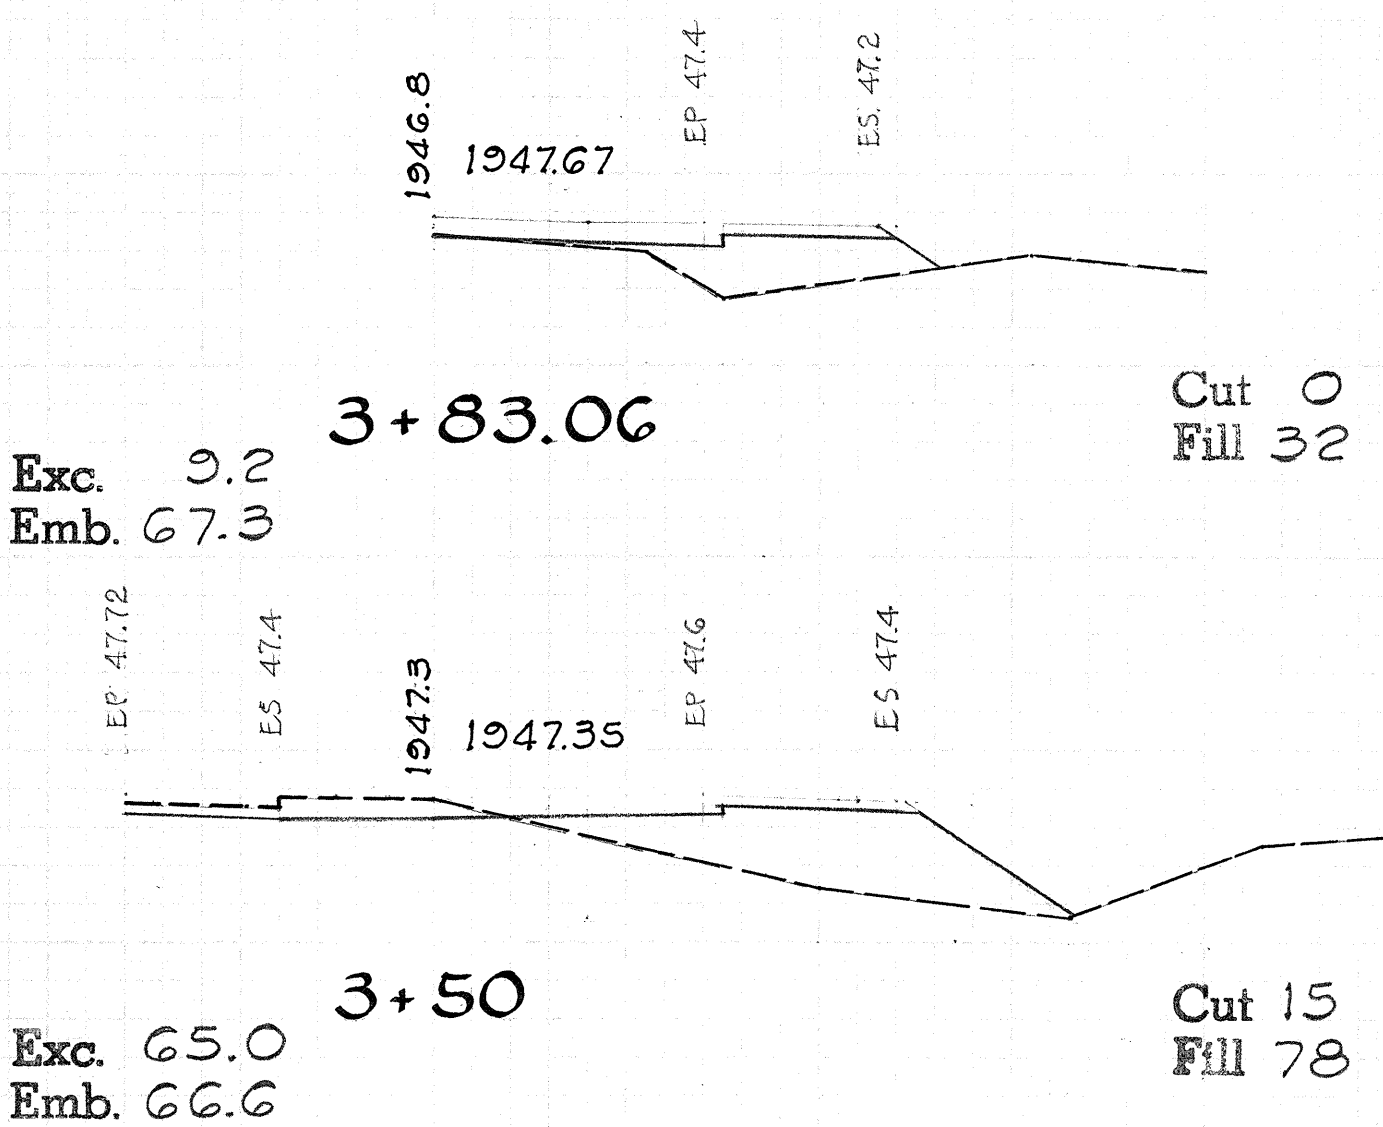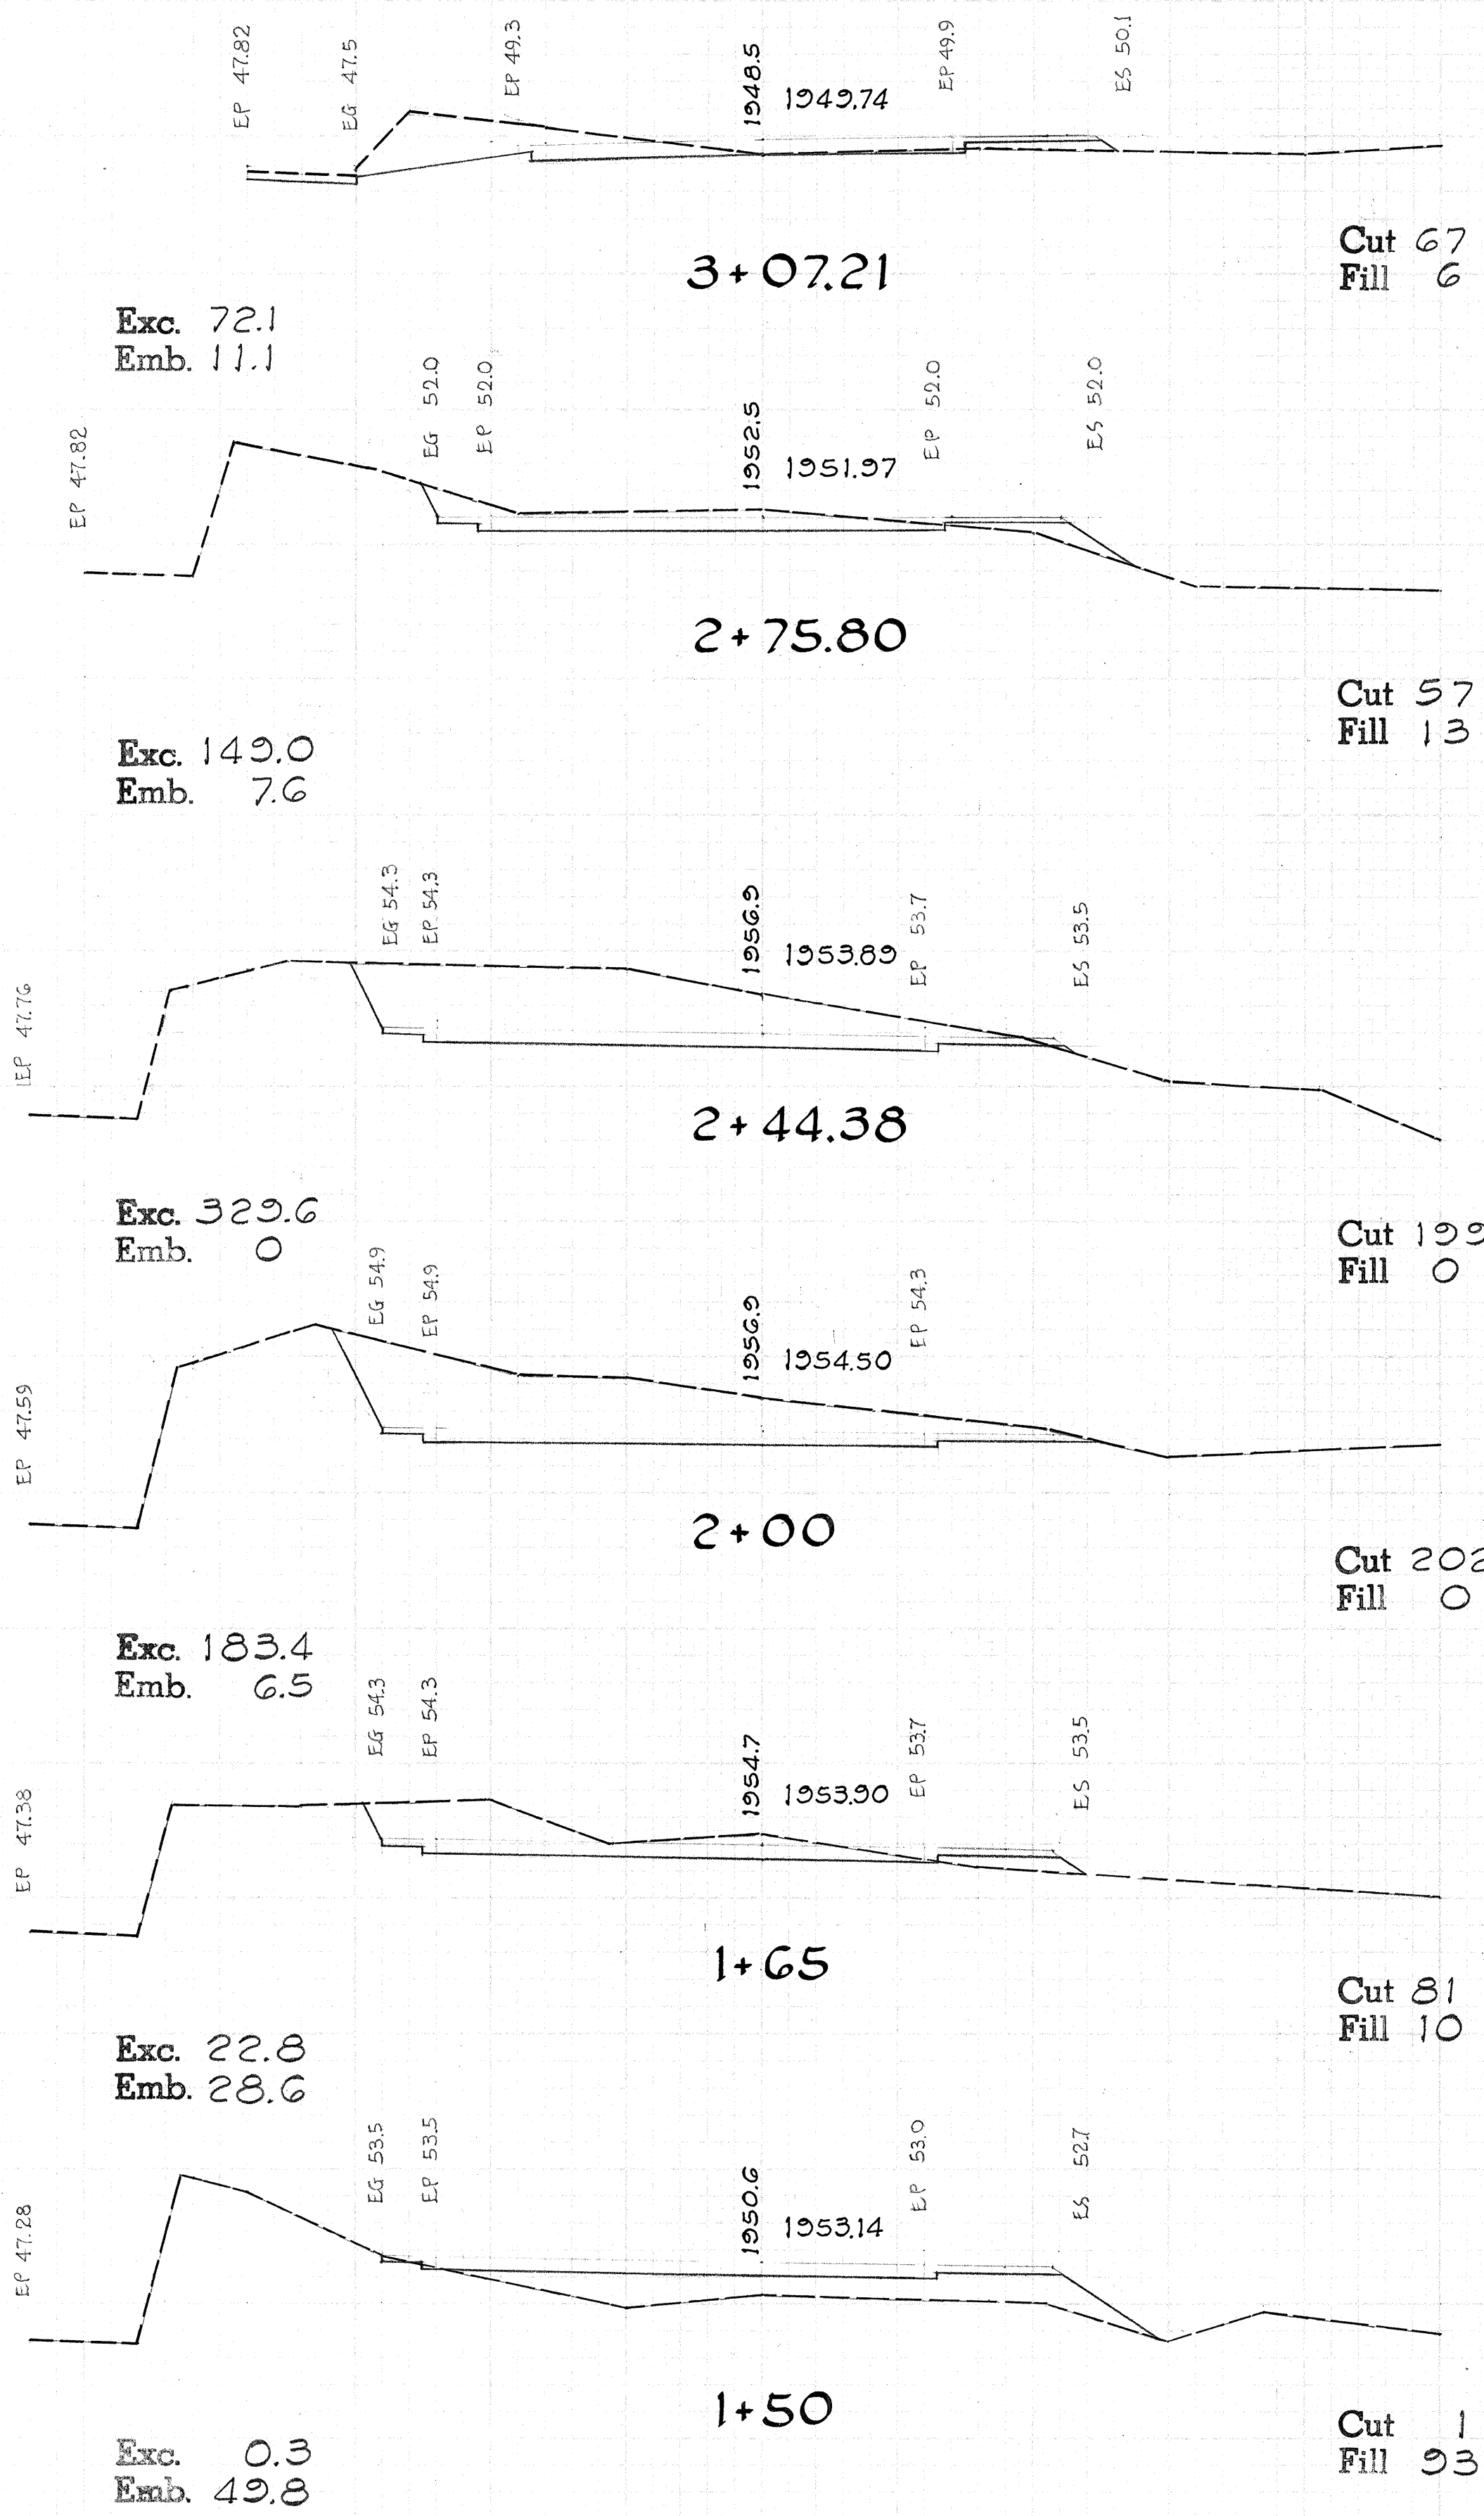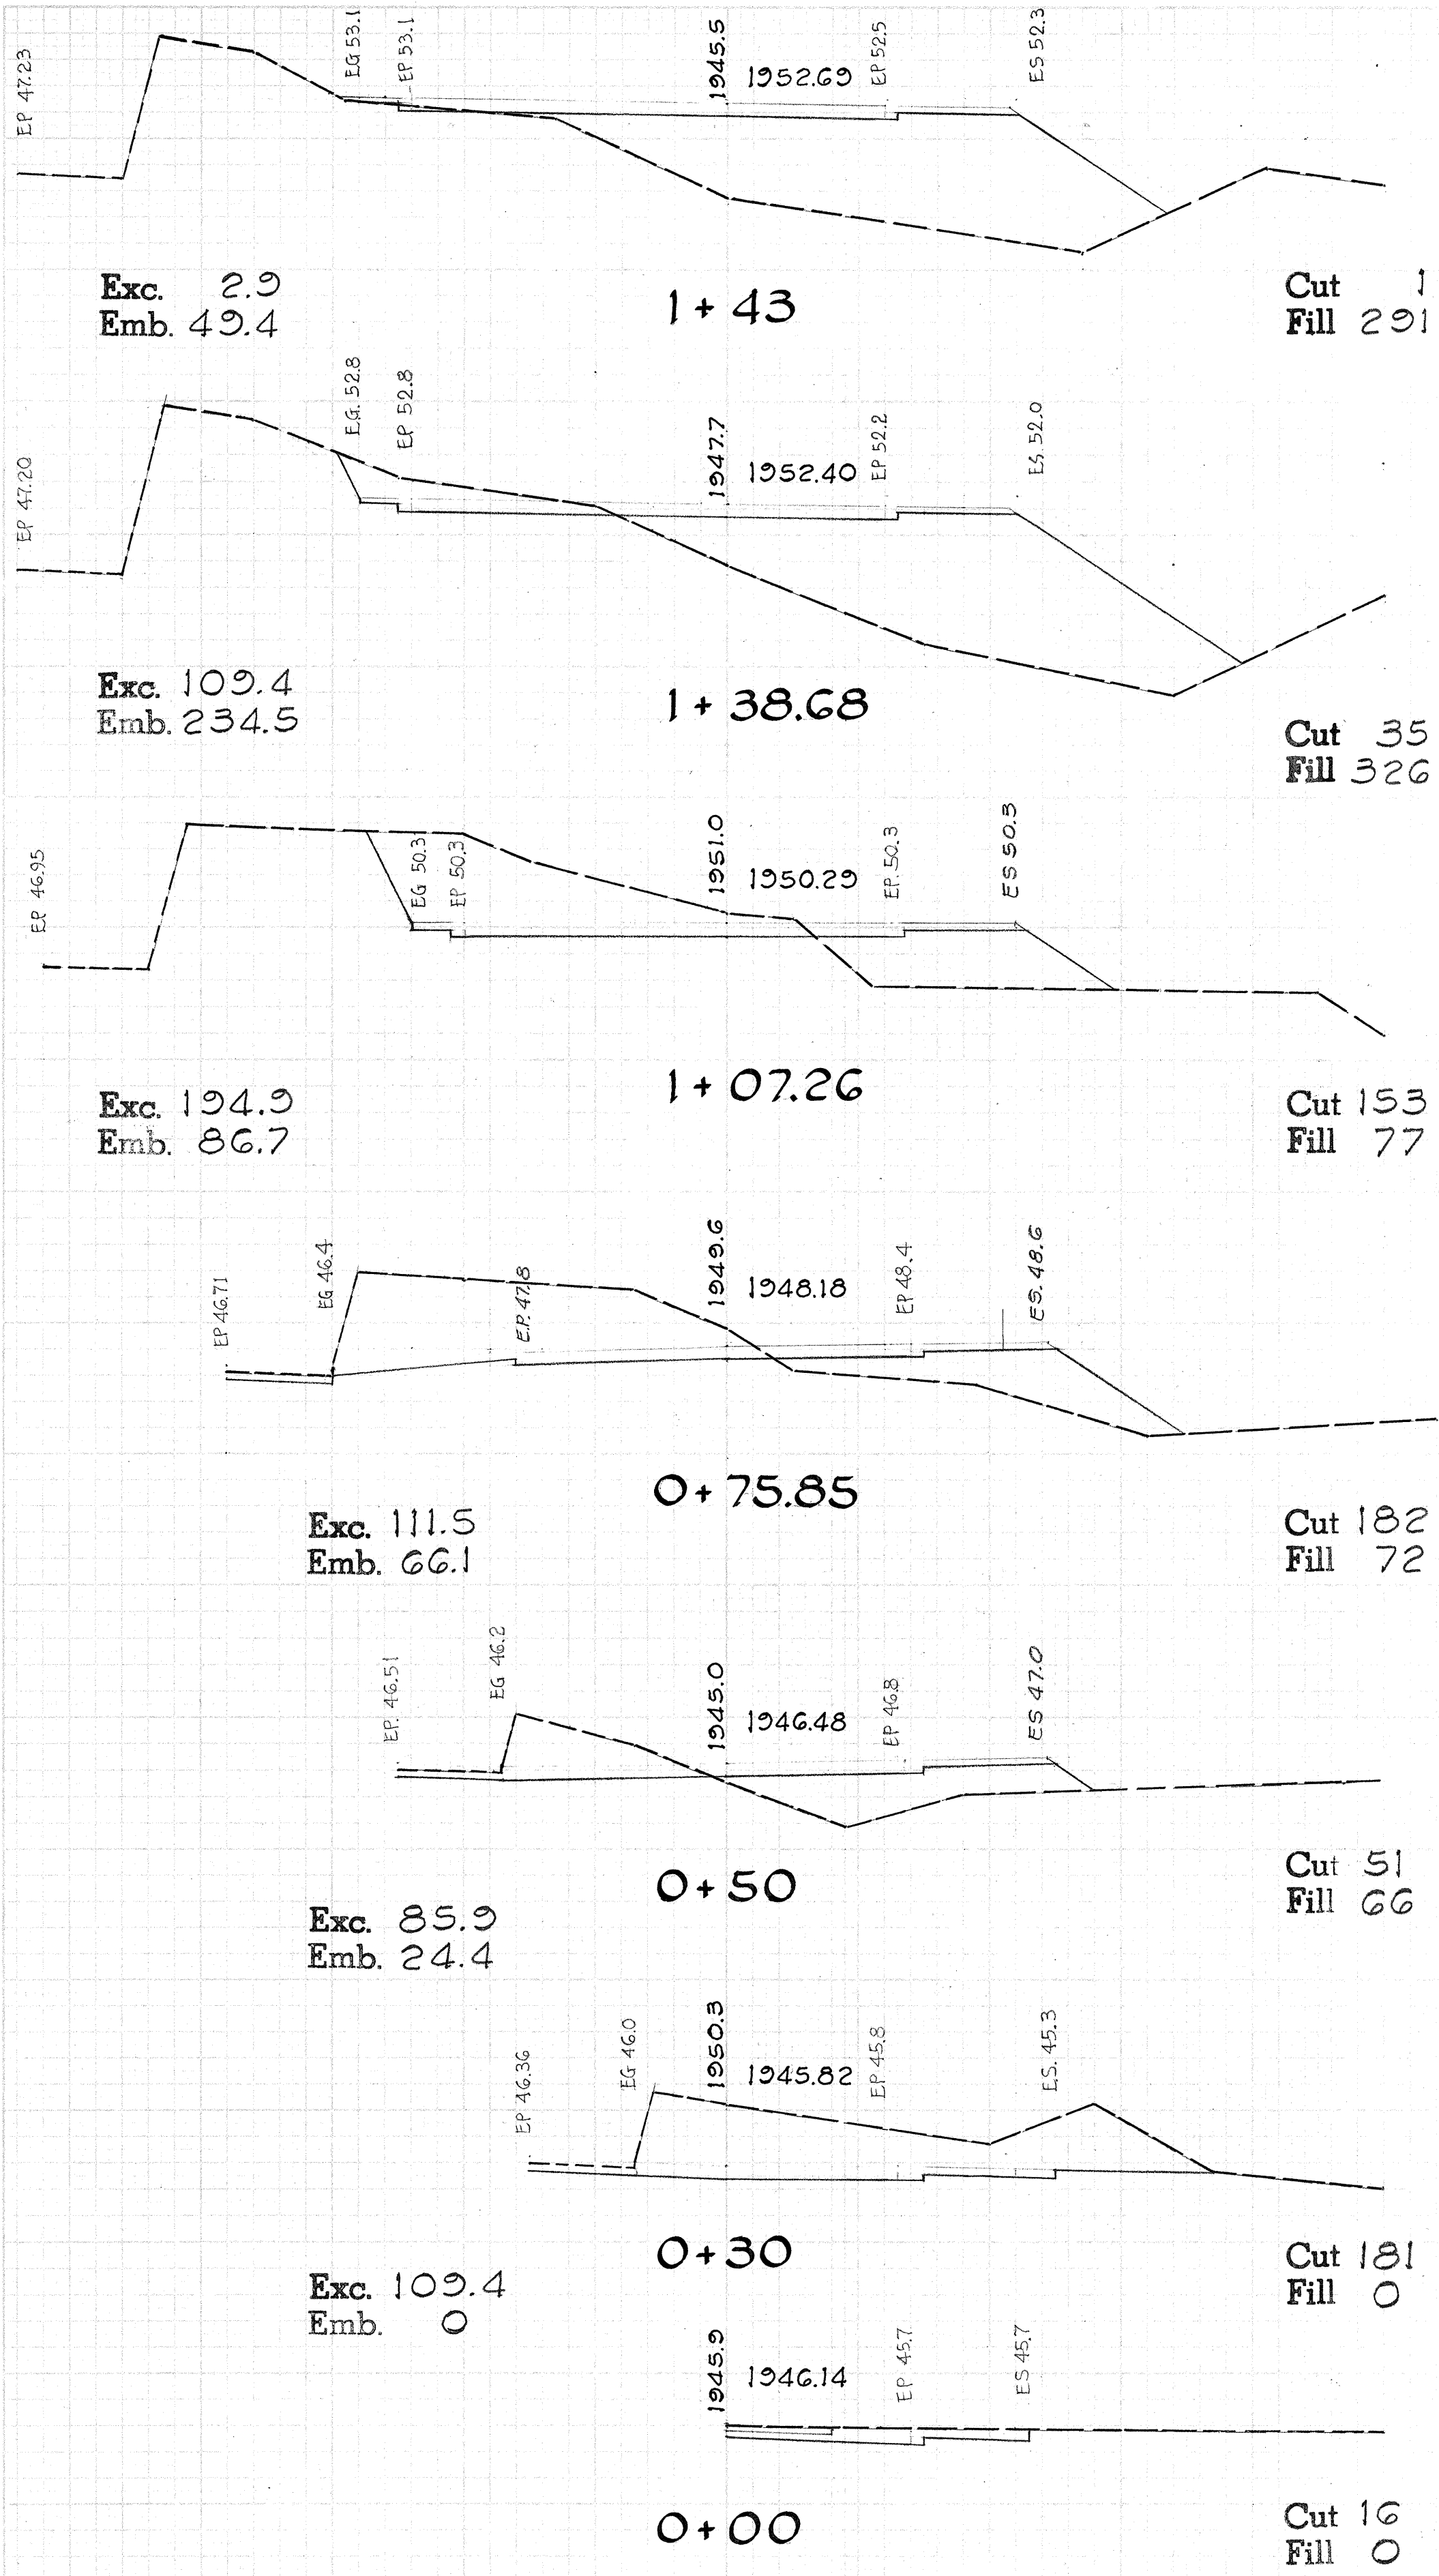

SCENIC LOOKOUT
Contract Change Order #1

C.O. 45 S-1

Scenic Lookout - Kahuku-Papa