


FED. ROAD DIST. NO.	STATE	PROJ. NO.	FISCAL YEAR	SHEET NO.	TOTAL SHEETS
HAWAII	HAW.	11E-01-75	1975	13	45

GENERAL NOTES:

1. All painted stripes shall be done by State Forces.
2. The Contractor shall furnish, deliver and install the pavement markers in accordance with the special provisions and as shown on the plans. At certain locations where striping is required, the Contractor shall install the pavement markers only after striping has been done by State Forces.
3. For summary of signs and pavement markers, see Sheet No. 15.
4. Changes in installation of guard rails have been noted in the Plan and Profile sheets.

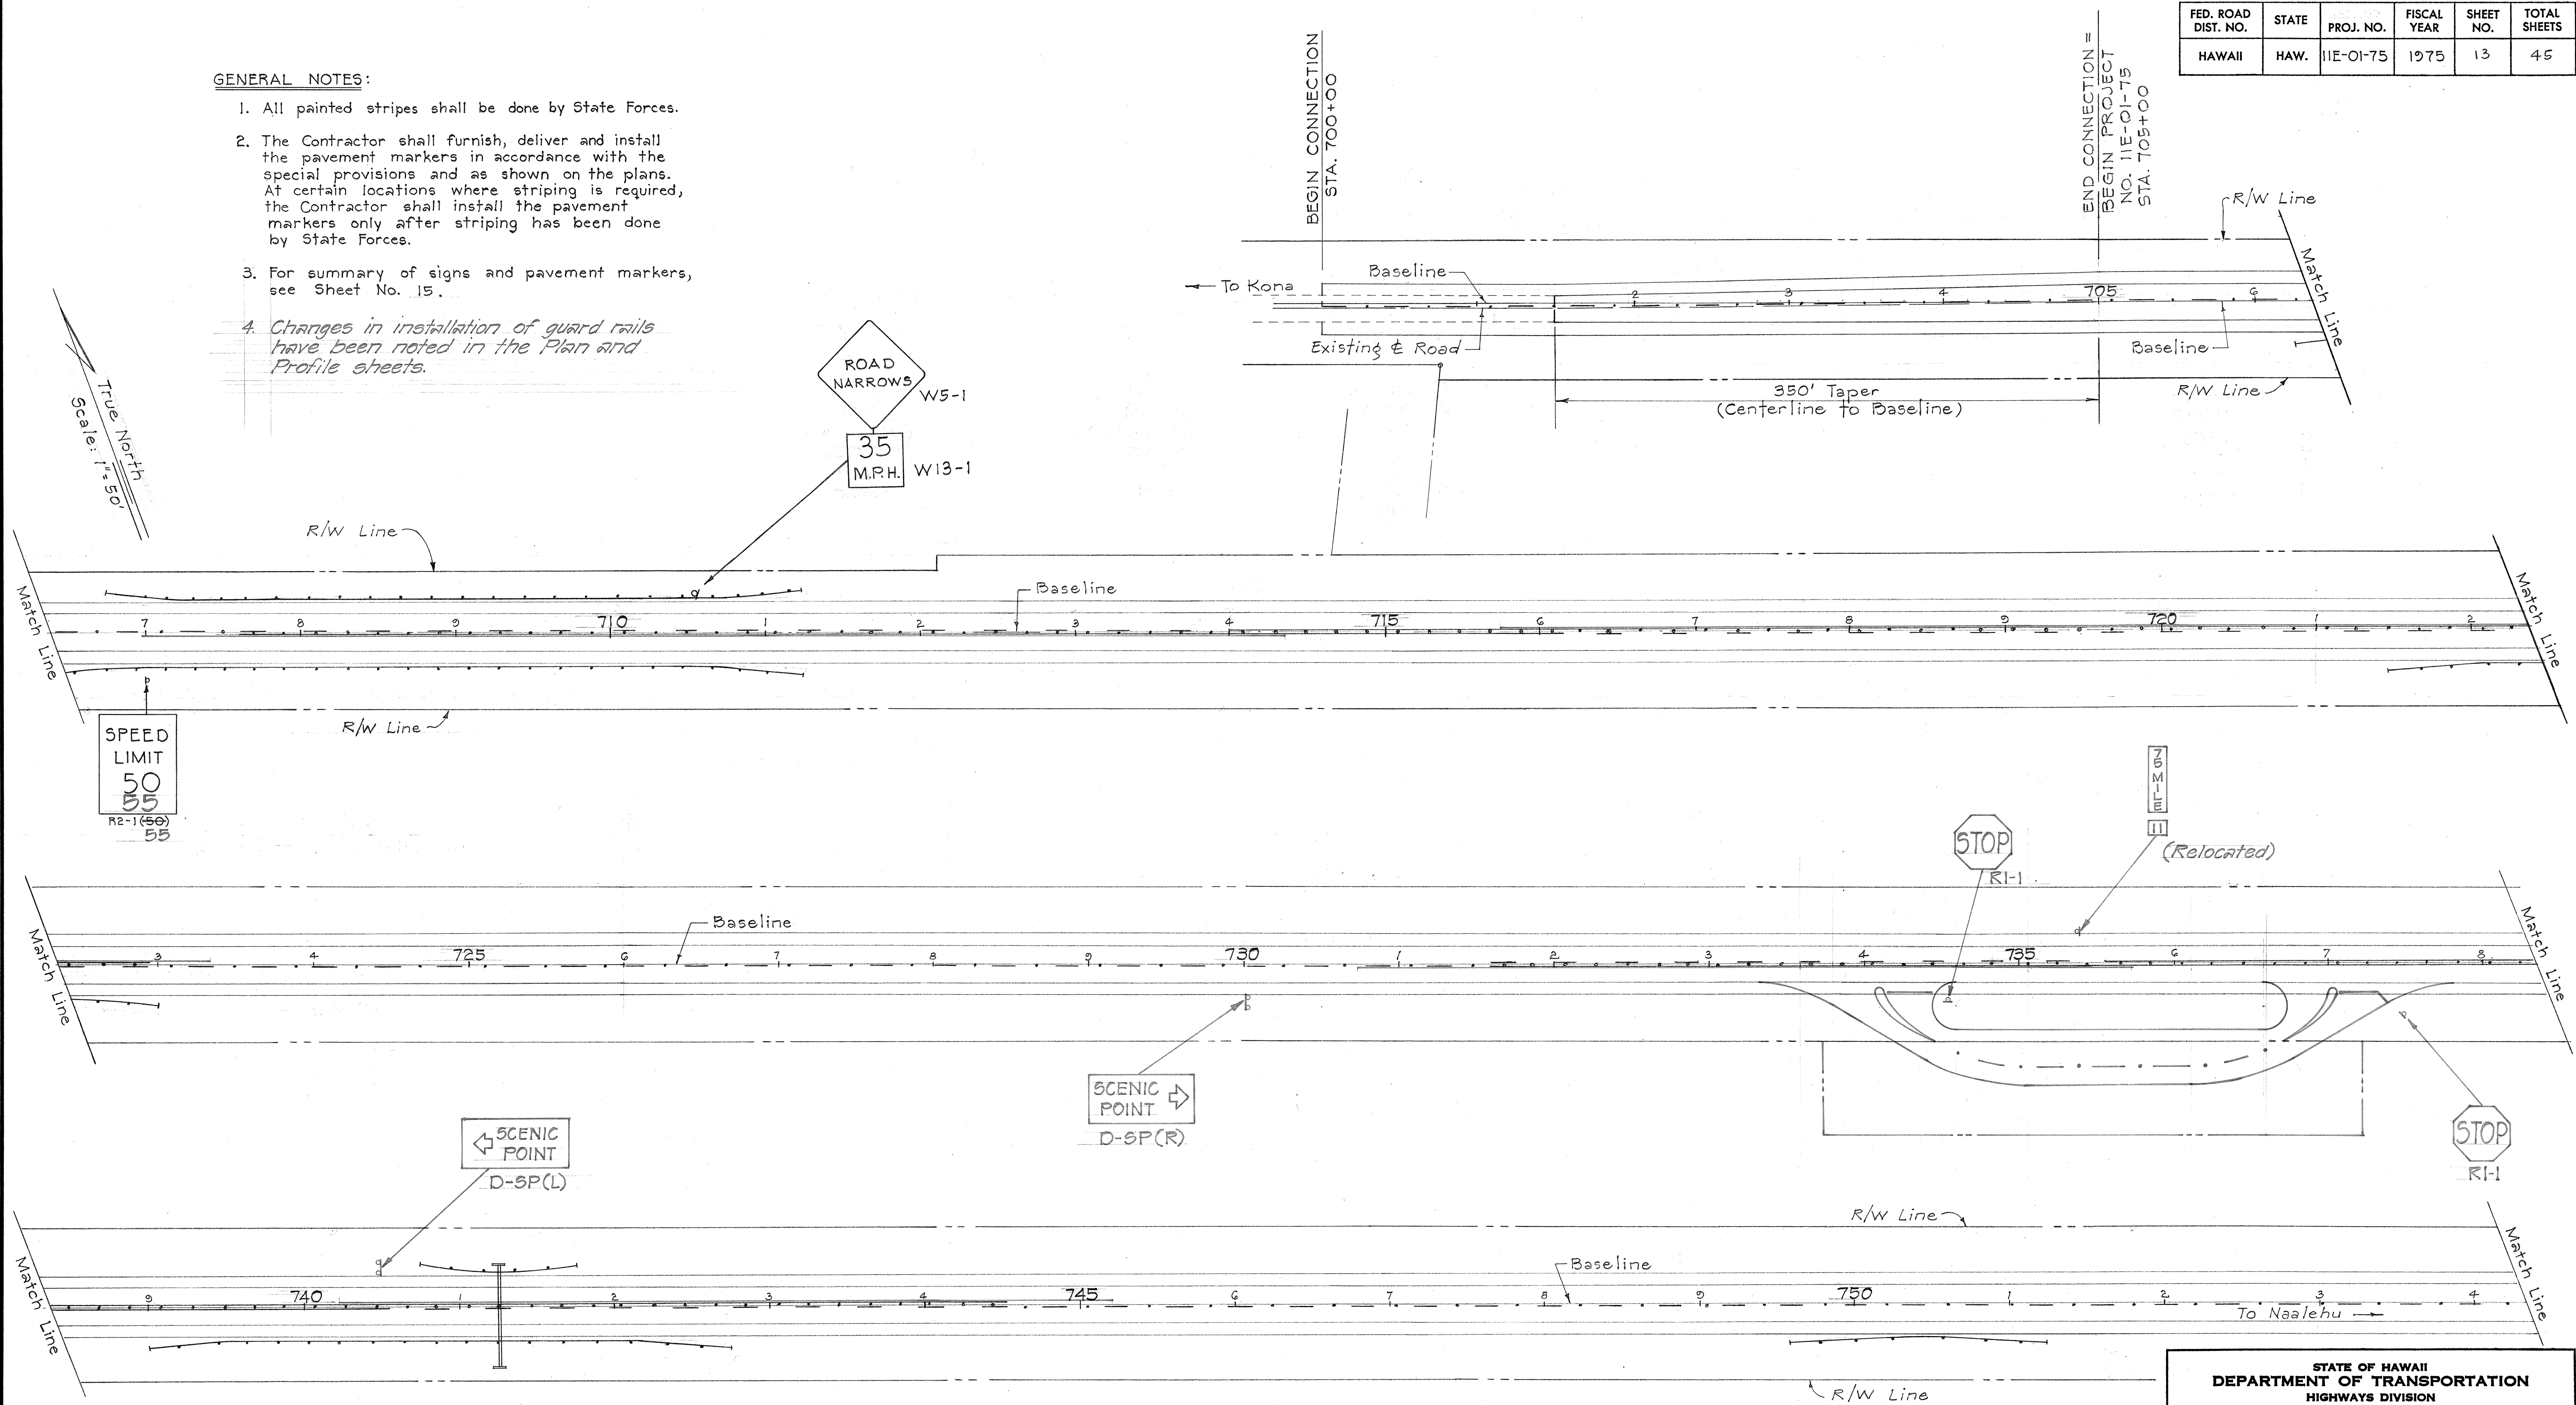

DATE	_____
DESIGNED BY	_____
TRACED BY	_____
NOTED BY	_____
CHECKED BY	_____
ORIGINAL PLAN	_____
NOTE BOOK	_____
No.	_____


STATE OF HAWAII
DEPARTMENT OF TRANSPORTATION
HIGHWAYS DIVISION

SIGNALS, STRIPING AND
PAVEMENT MARKERS

HAWAII BELT ROAD
KAHUKU TO PAPA
PROJECT NO. 11E-01-75

Scale: As Noted Date: February, 1975
SHEET No. 1 OF 3 SHEETS

FED. ROAD DIST. NO.	STATE	PROJ. NO.	FISCAL YEAR	SHEET NO.	TOTAL SHEETS
HAWAII	HAW.	11E-01-75	1975	14	45

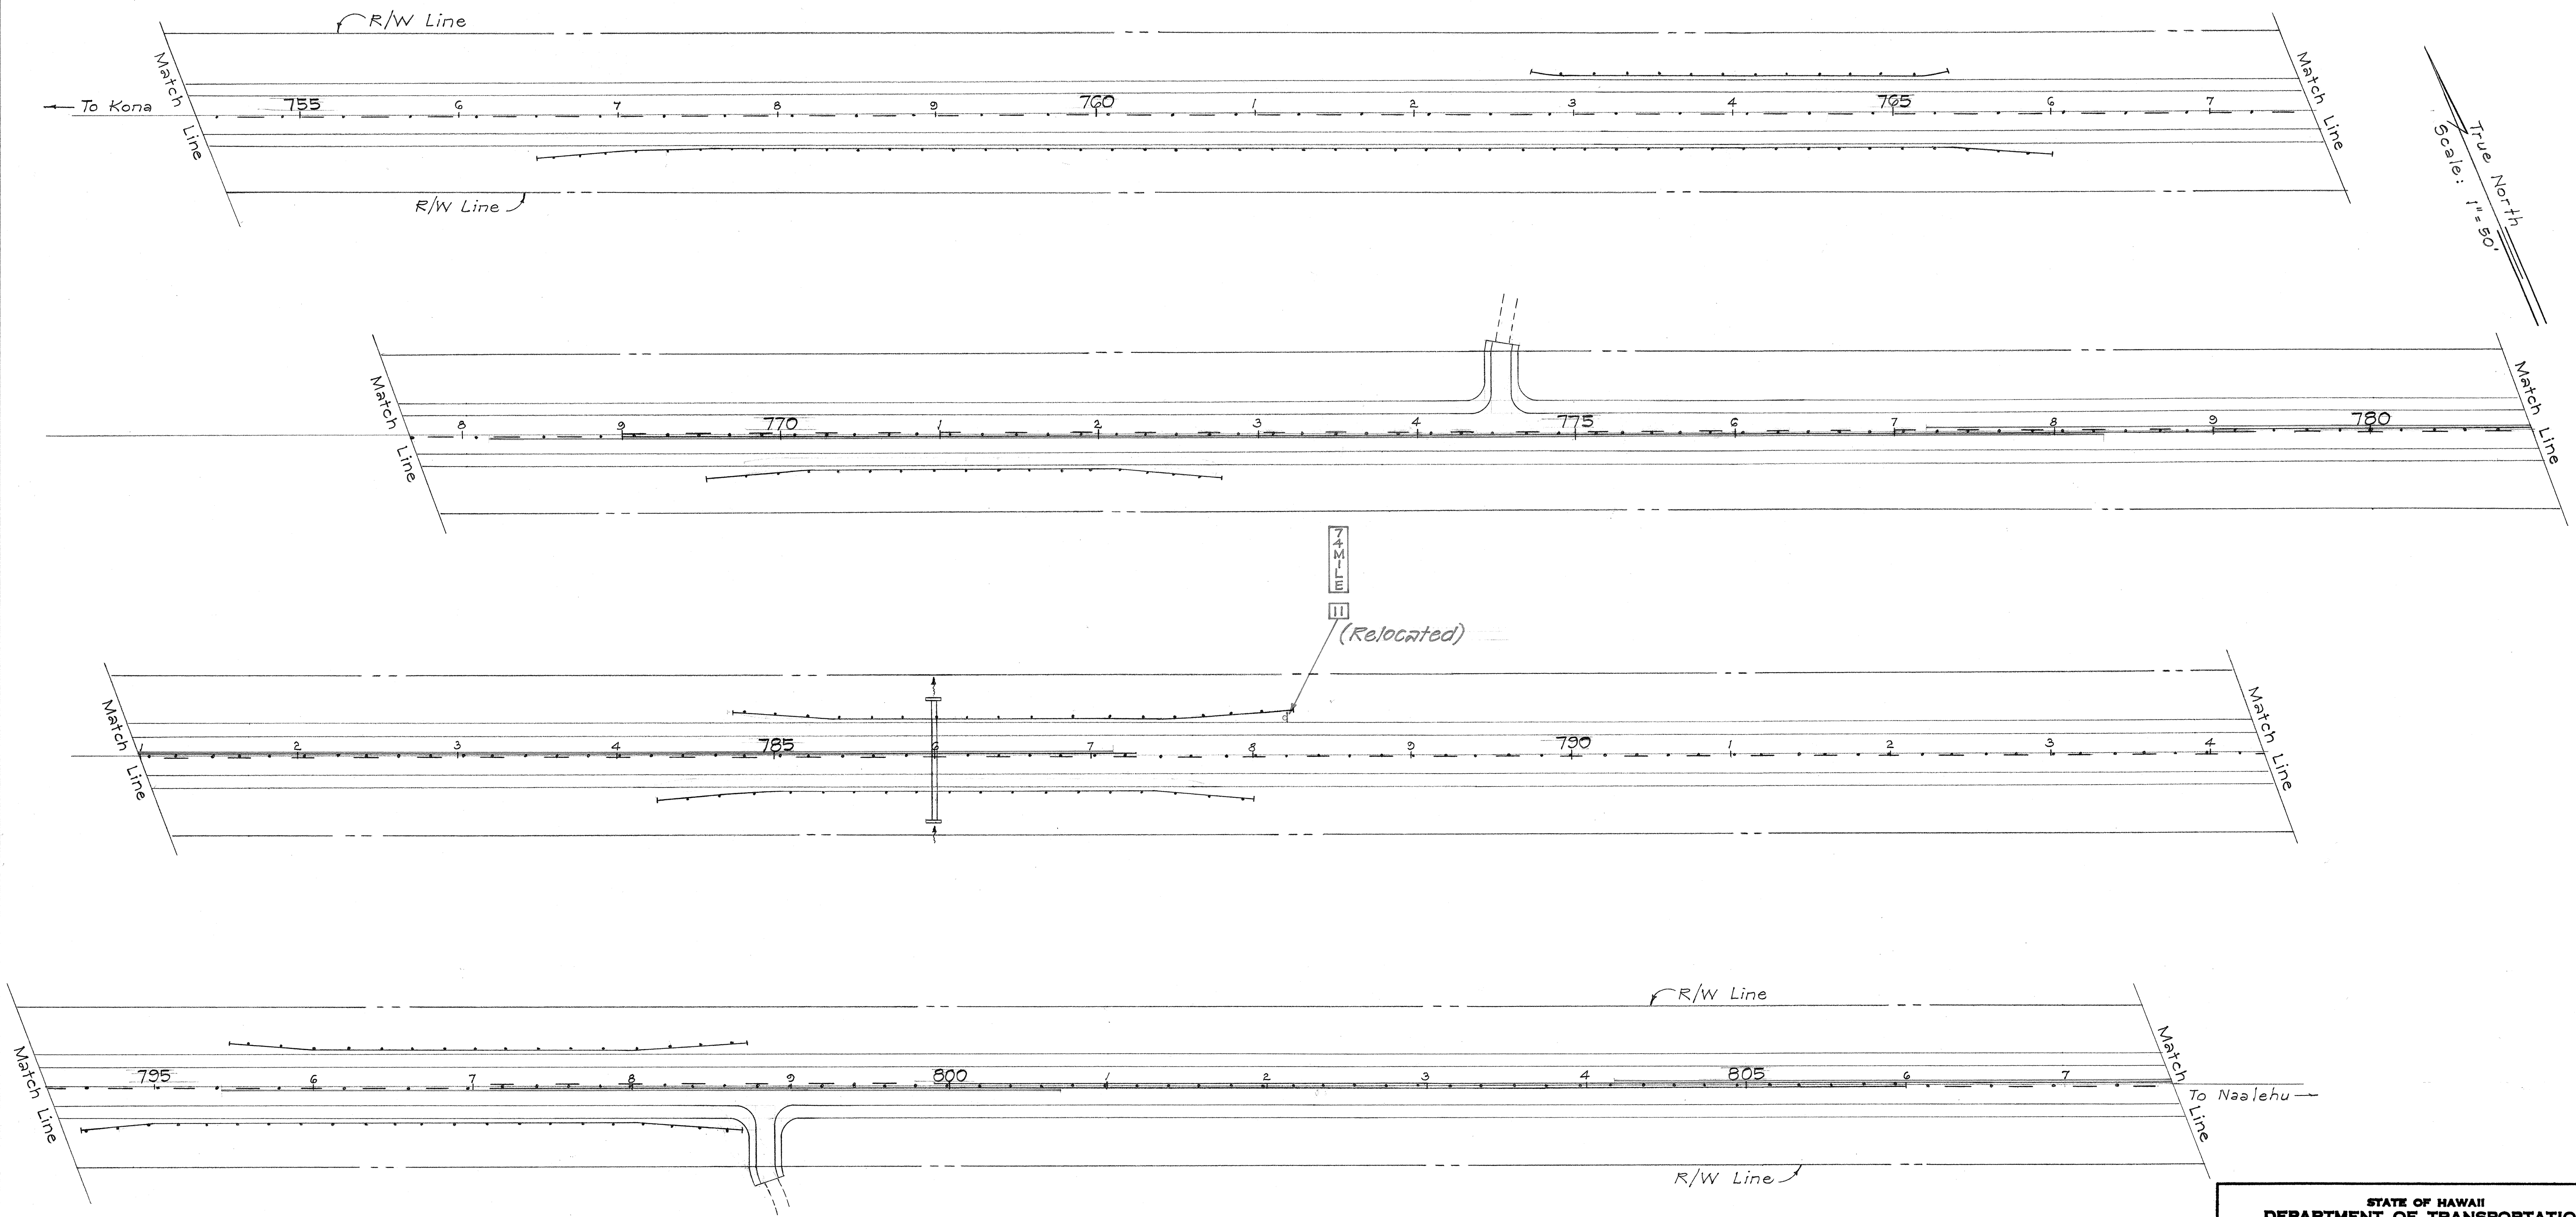

DESIGNED BY	DATE
TRACED BY	
DESIGNED BY	
QUANTITIES BY	
CHECKED BY	
ORIGINAL PLAN	
NOTE BOOK	
NO.	


STATE OF HAWAII
DEPARTMENT OF TRANSPORTATION
HIGHWAYS DIVISION

SIGNALS, STRIPING AND
PAVEMENT MARKERS

HAWAII BELT ROAD
KAHUKU TO PAPA
PROJECT NO. 11E-01-75

Scale: As Noted Date: February, 1975
SHEET NO. 2 OF 3 SHEETS

FED. ROAD DIST. NO.	STATE	PROJ. NO.	FISCAL YEAR	SHEET NO.	TOTAL SHEETS
HAWAII	HAW.	11E-01-75	1975	15	45

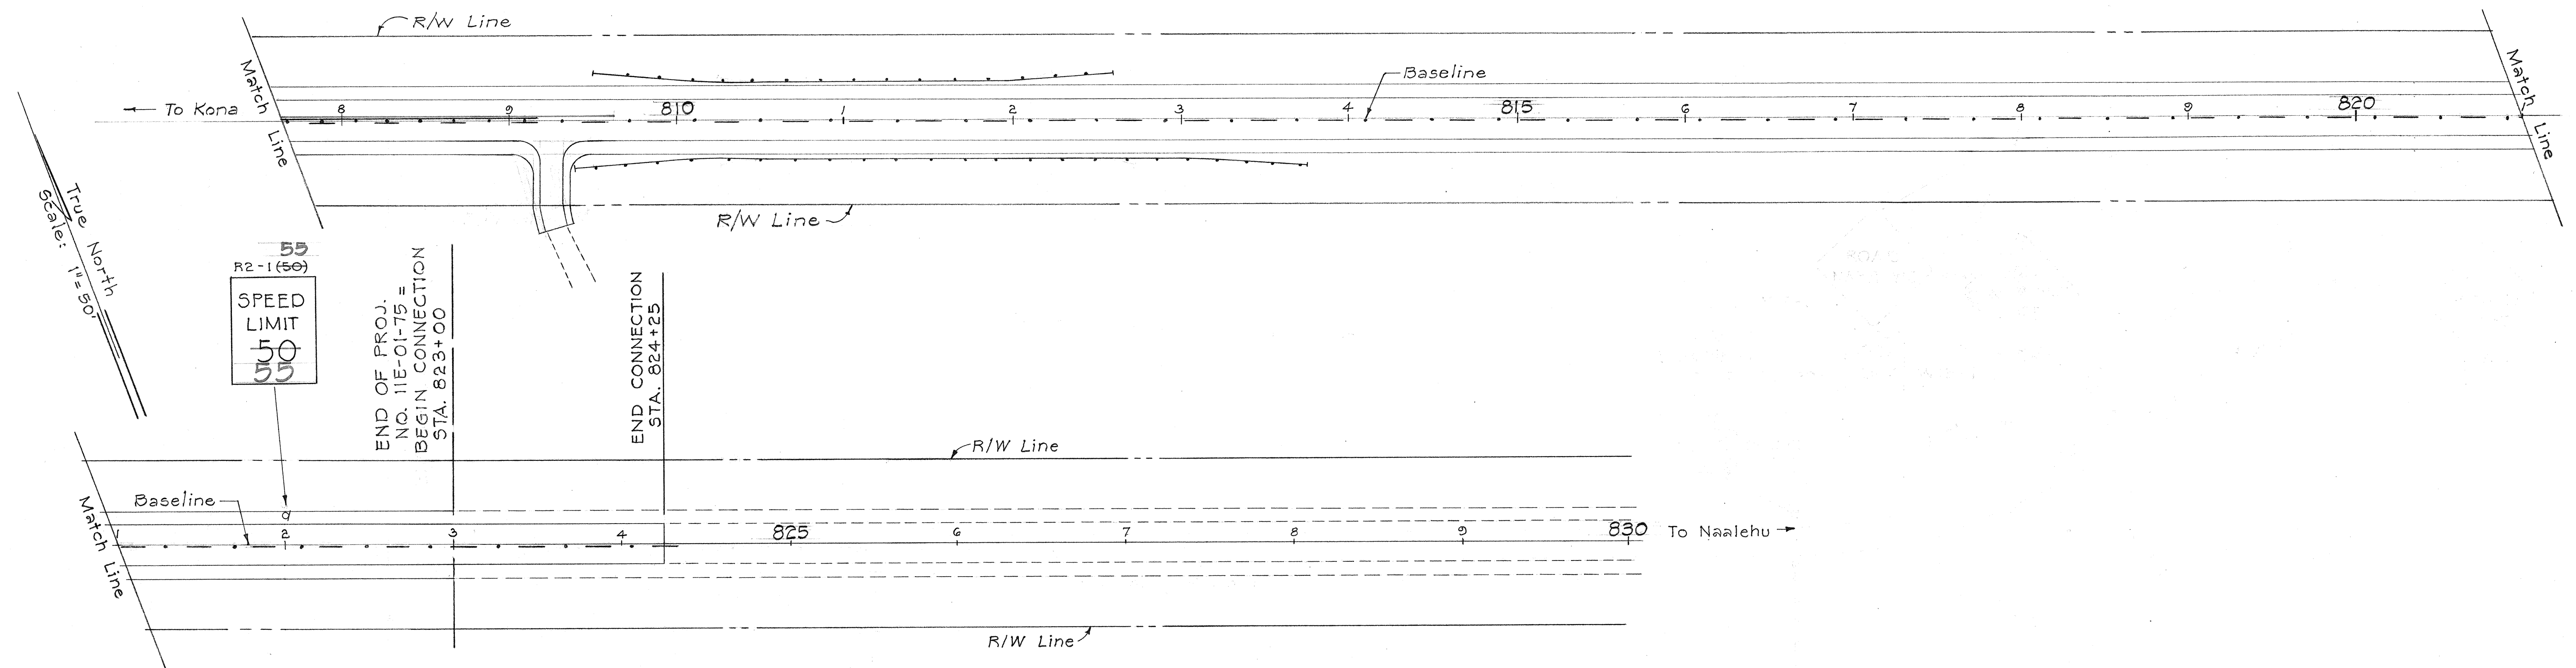

SUMMARY OF REGULATORY AND WARNING SIGNS			
TYPE	DESCRIPTION	NEW W/POST	NEW W/ POST
R2-1 (50)	SPEED LIMIT 50	2	
W5-1	ROAD NARROWS	1	
W13-1	35 M.P.H.		1
R1-1	STOP	2	
D-5P(R)	SCENIC POINT →	1	
D-5P(L)	← SCENIC POINT	1	

[illegible]

STATE OF HAWAII
DEPARTMENT OF TRANSPORTATION
HIGHWAYS DIVISION

SIGNS, STRIPING AND
PAVEMENT MARKERS

HAWAII BELT ROAD
KAHUKU TO PAPA
PROJECT NO. 11E-01-75

Scale: As Noted Date: February, 1975.

SHEET No. 3 OF 3 SHEETS