
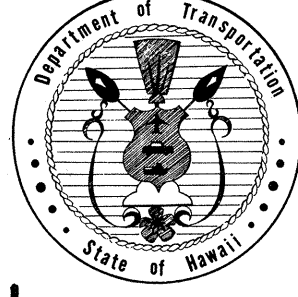


INDEX TO DRAWINGS	
SHEET NO.	DESCRIPTION
1	TITLE SHEET
2*	TYPICAL SECTION
3-12*	PLAN AND PROFILE
13-15	SIGNS, STRIPING AND PAVEMENT MARKERS
16	DRAINAGE
17-33	STANDARD DETAILS
34-45*	CROSS SECTIONS


*C.O. 2S-1, C.O. 5S-1, & C.O. 45S-1 are supplement sheets to the project plans.

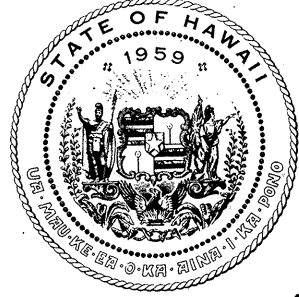

STATE OF HAWAII
DEPARTMENT OF TRANSPORTATION
HIGHWAYS DIVISION
"AS BUILT"
PLANS FOR

HAWAII BELT ROAD
KAHUKU TO PAPA
PROJECT NO. IIE-01-75
DISTRICT OF KA'U
ISLAND OF HAWAII

STATE	PROJ.NO.	FISCAL YEAR	SHEET NO.	TOTAL SHEETS
HAW.	IIE-01-75	1975	1	45

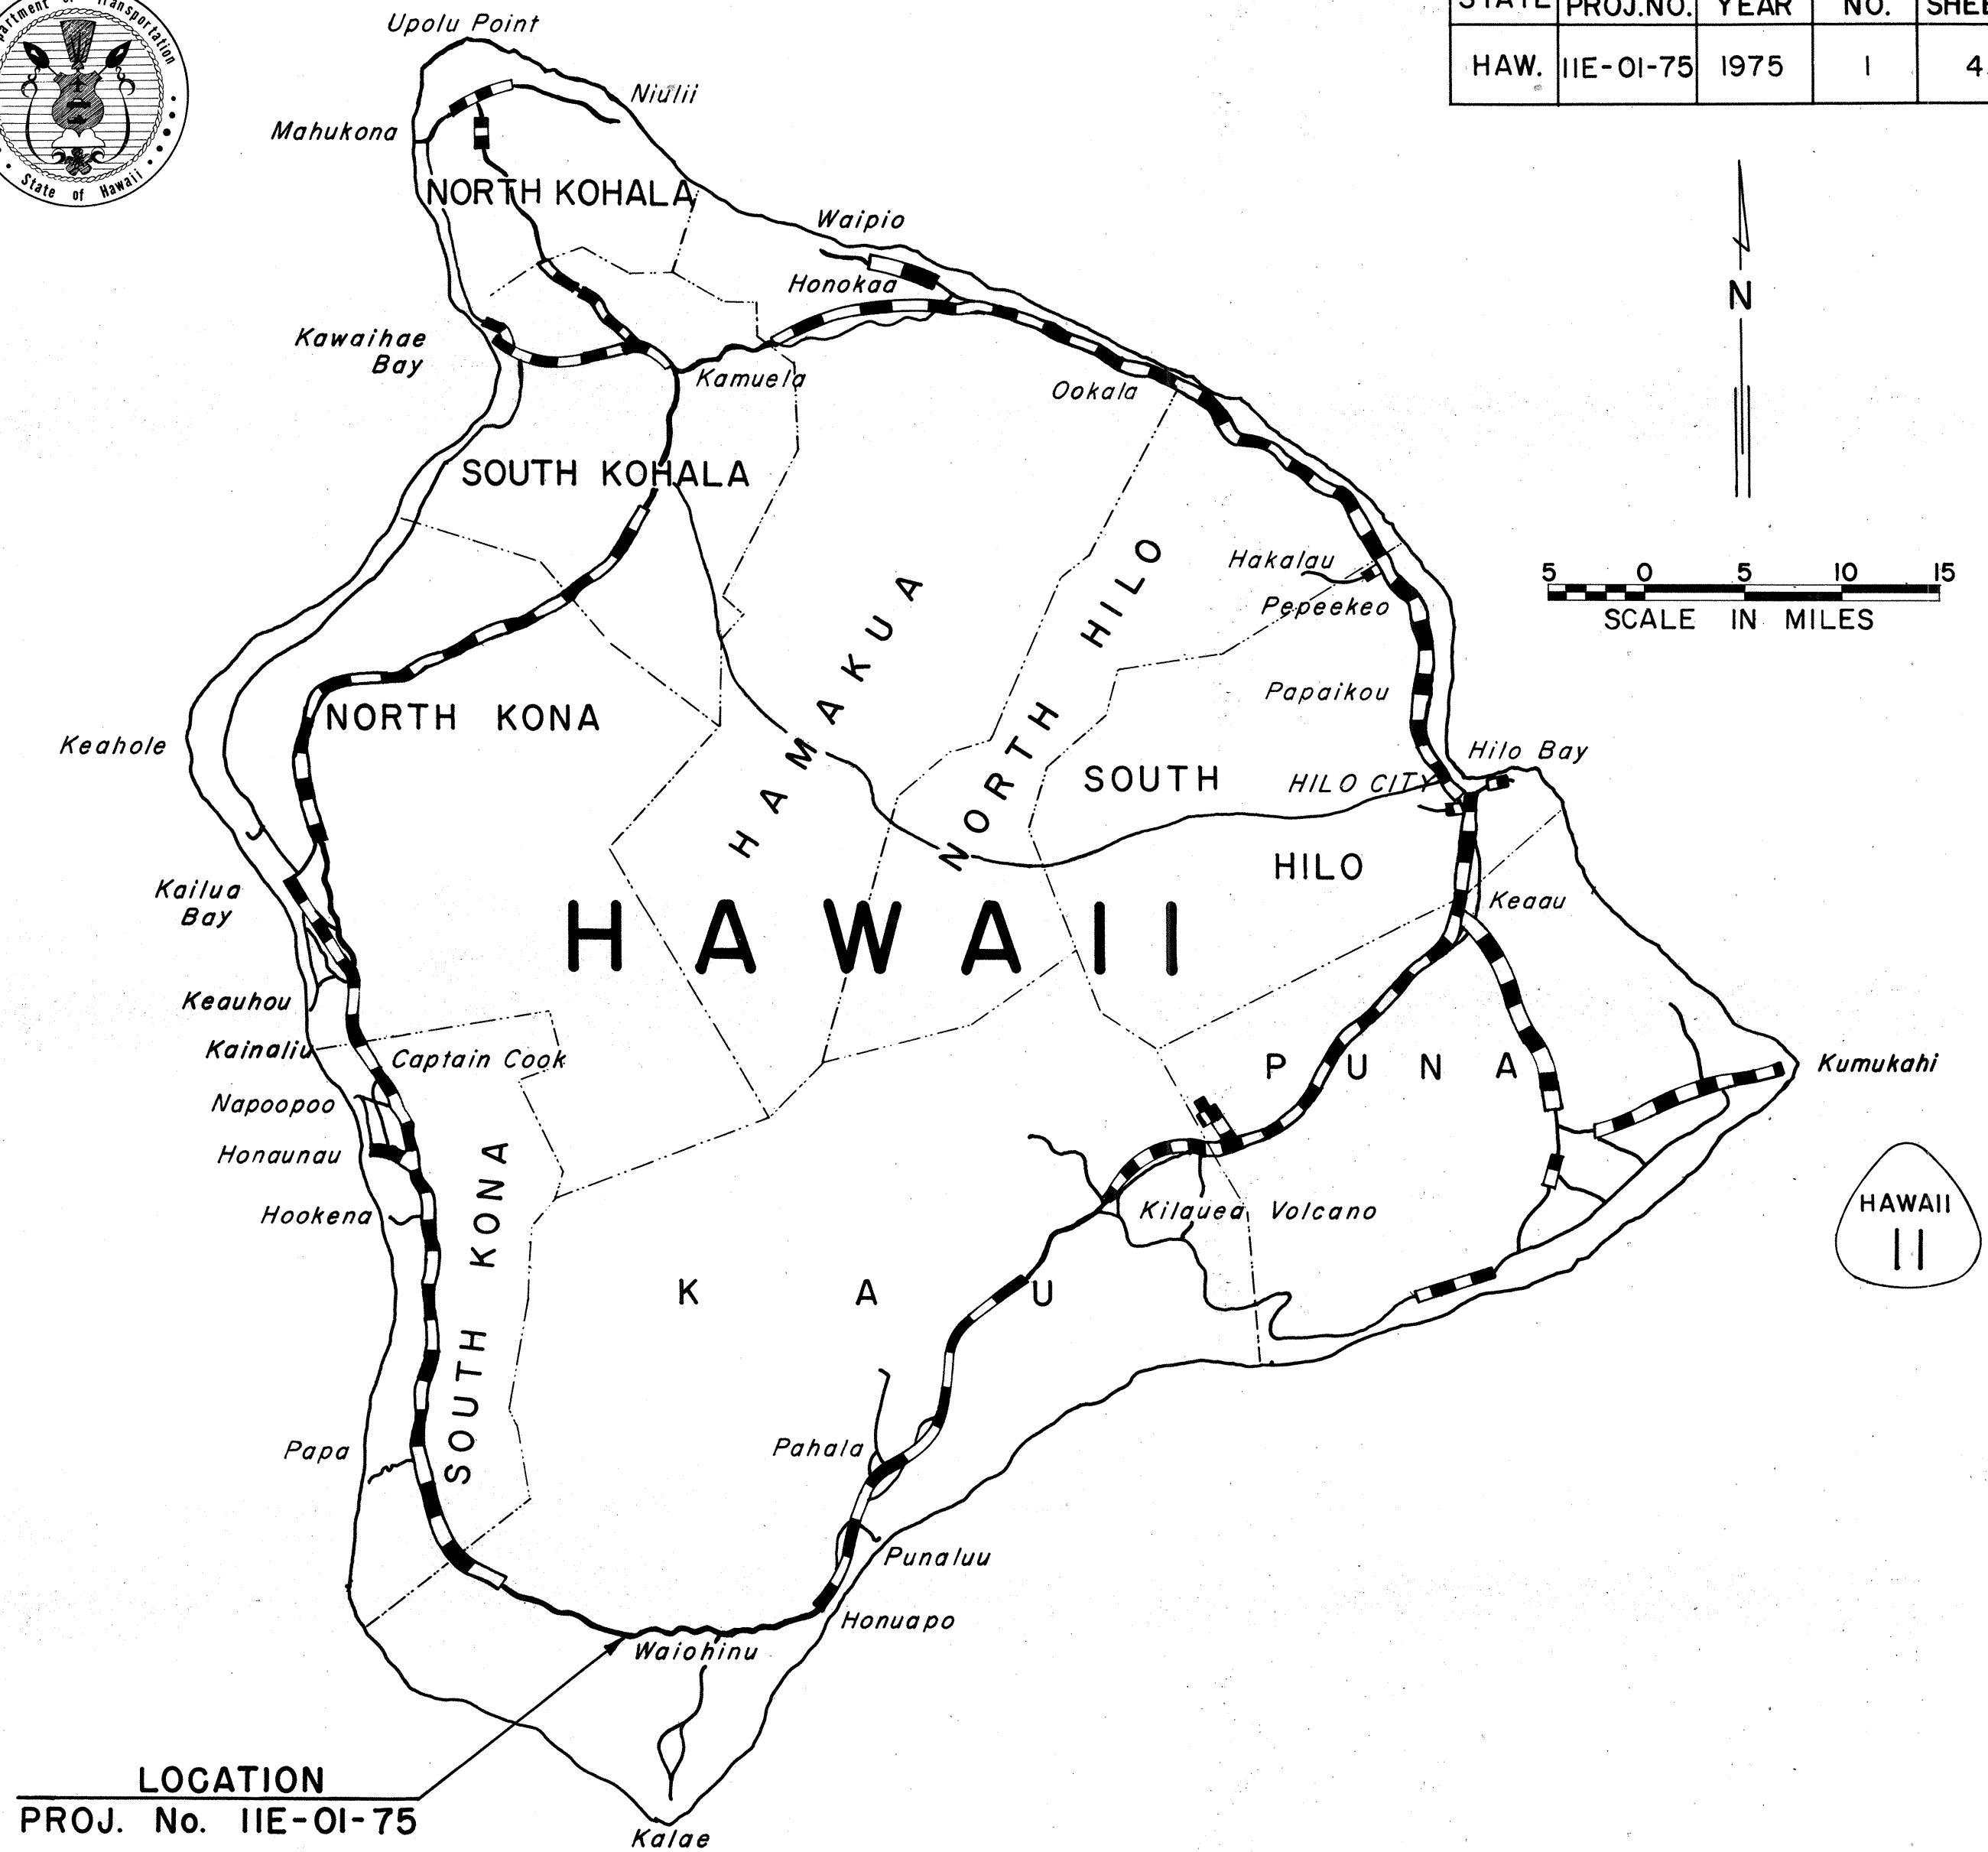


LOCATION
PROJ. No. IIE-01-75

Federal Aid Projects Previously Constructed Or Under Construction

NOTE:
ALL CHANGES MADE DURING CONSTRUCTION HAVE BEEN NOTED IN RED ON THESE TRACINGS AND CHECKED BY:

Jorge J. J. J. 8-16-76
PROJECT ENGINEER DATE

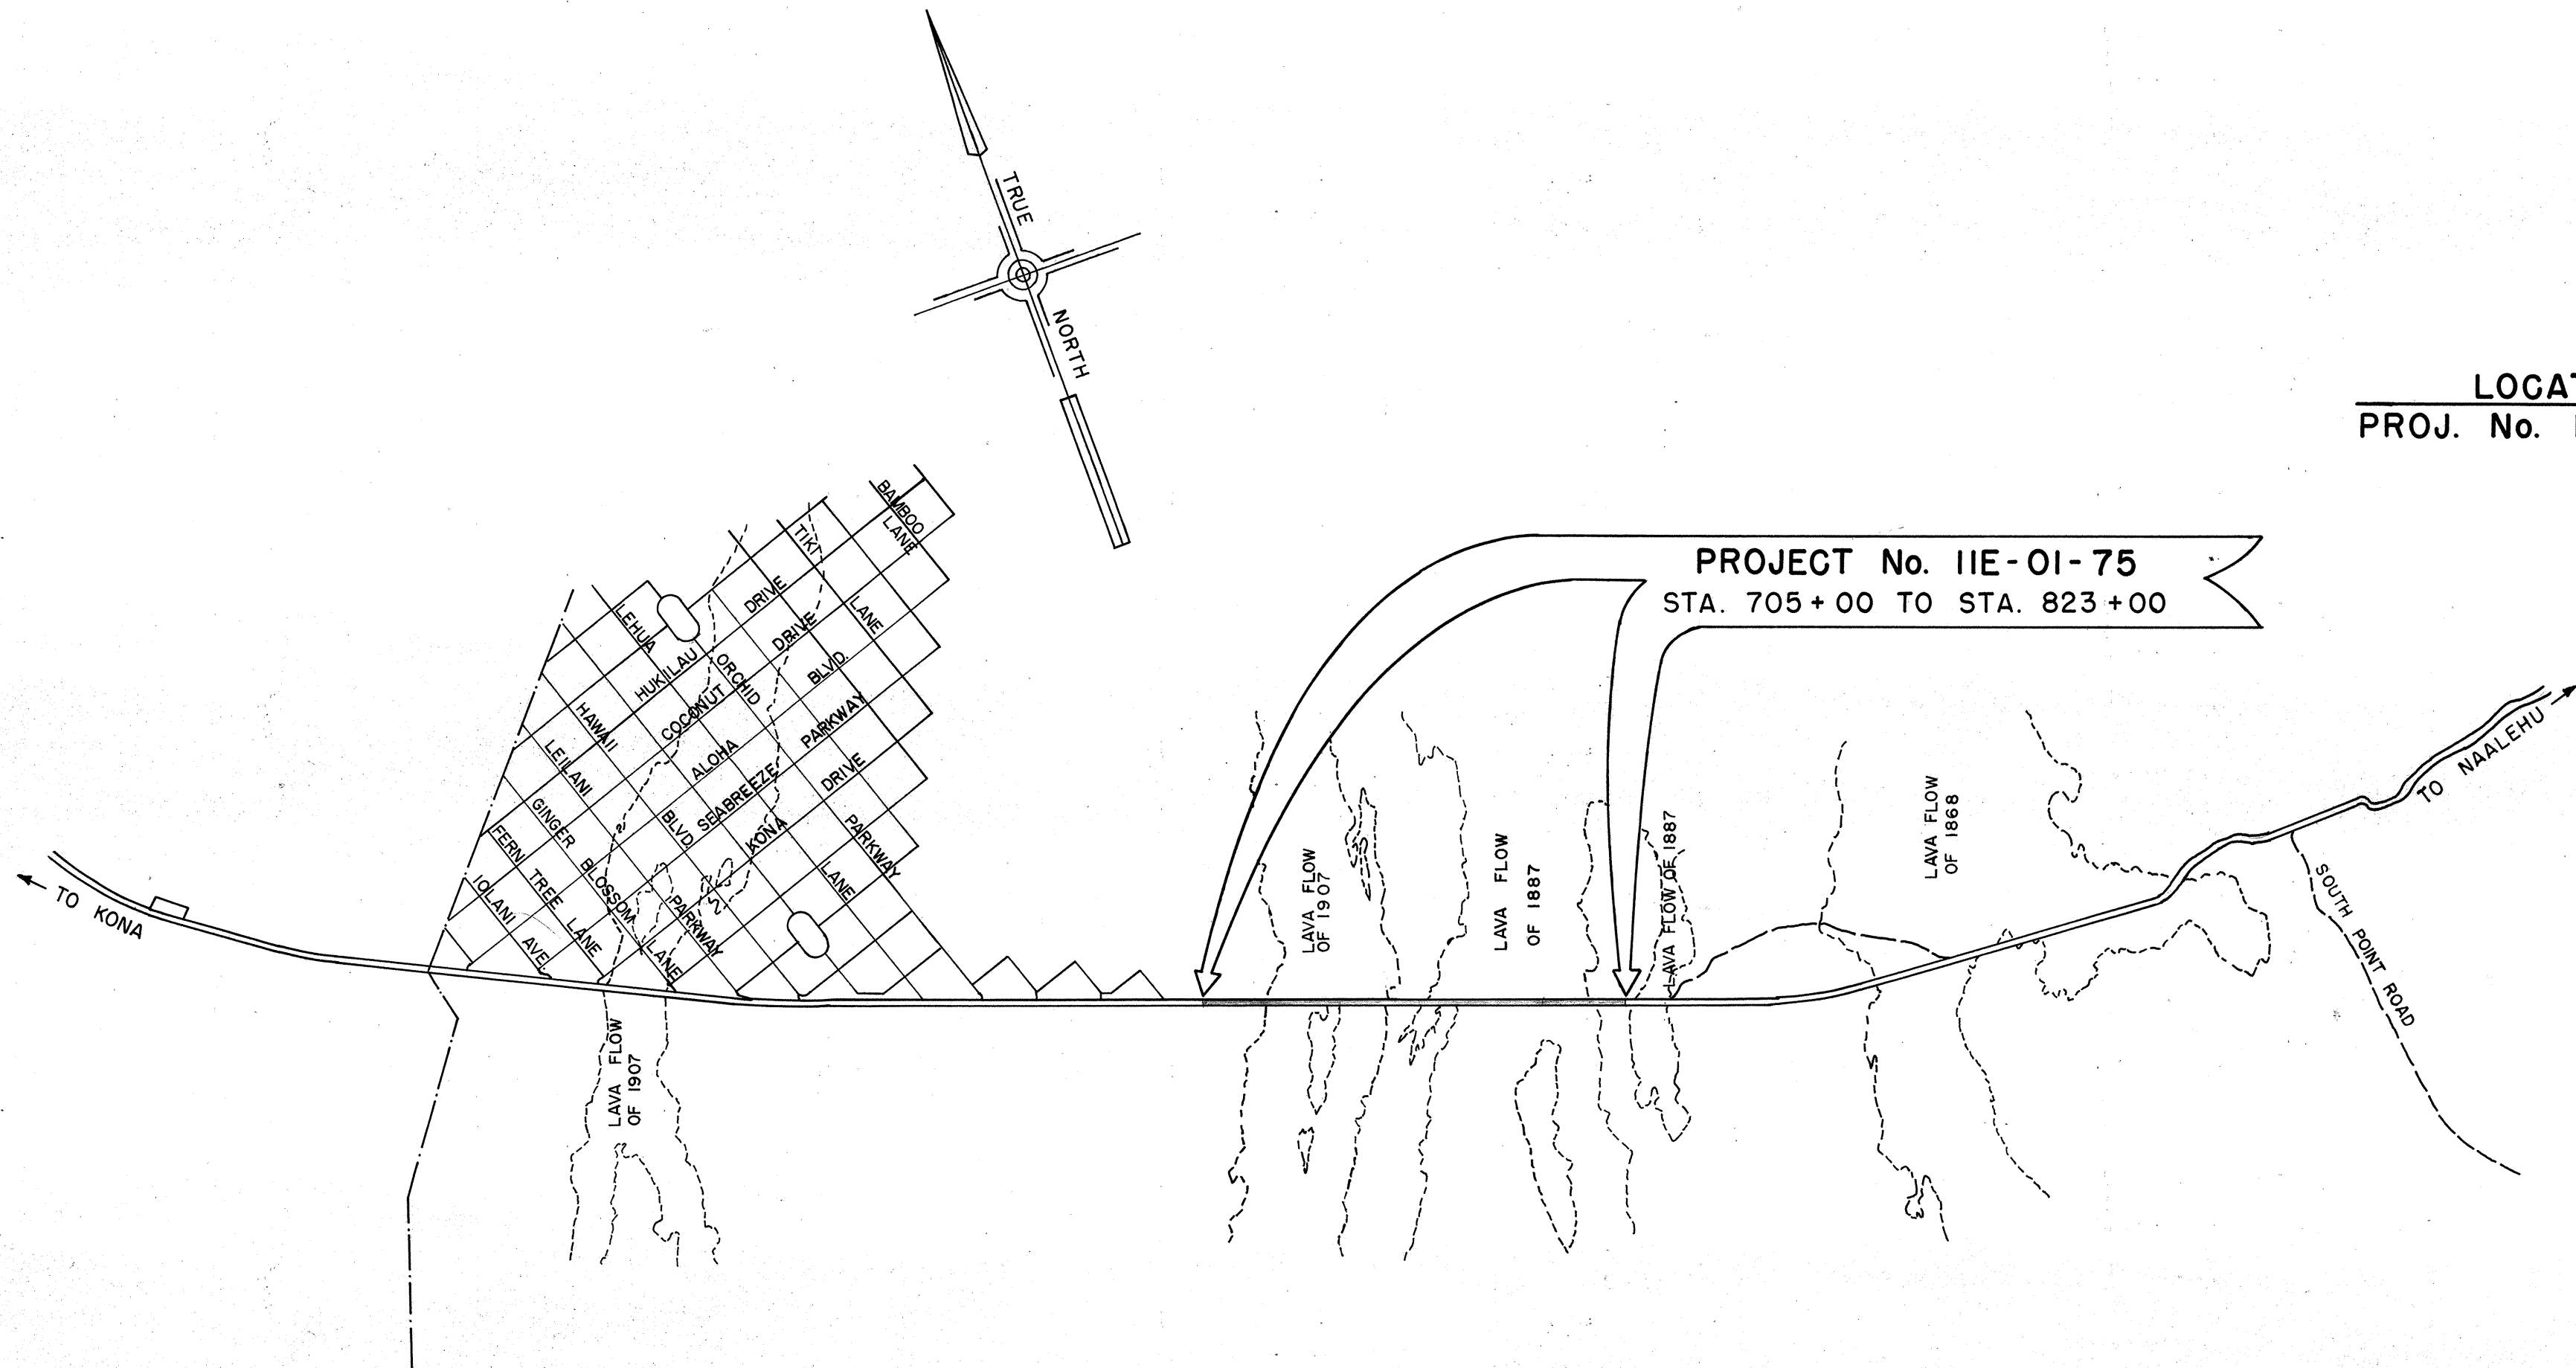

GENERAL LOCATION PLAN
SCALE: 1" = 4000'

GROSS LENGTH OF PROJECT 2.23 MILES

HAWAII DISTRICT A. Nishimura April 1975
DESIGNED BY P. S. & E. BY PHONE DATE

DEPARTMENT OF TRANSPORTATION STATE OF HAWAII	
APPROVED:	
<i>Douglas S. Sakamoto</i>	6/10/75
DIR. OF TRANSPORTATION	DATE