




FED. ROAD DIST. NO.	STATE	PROJ. NO.	FISCAL YEAR	SHEET NO.	TOTAL SHEETS
HAWAII	HAW.	11E-01-75	1975	2	4.5

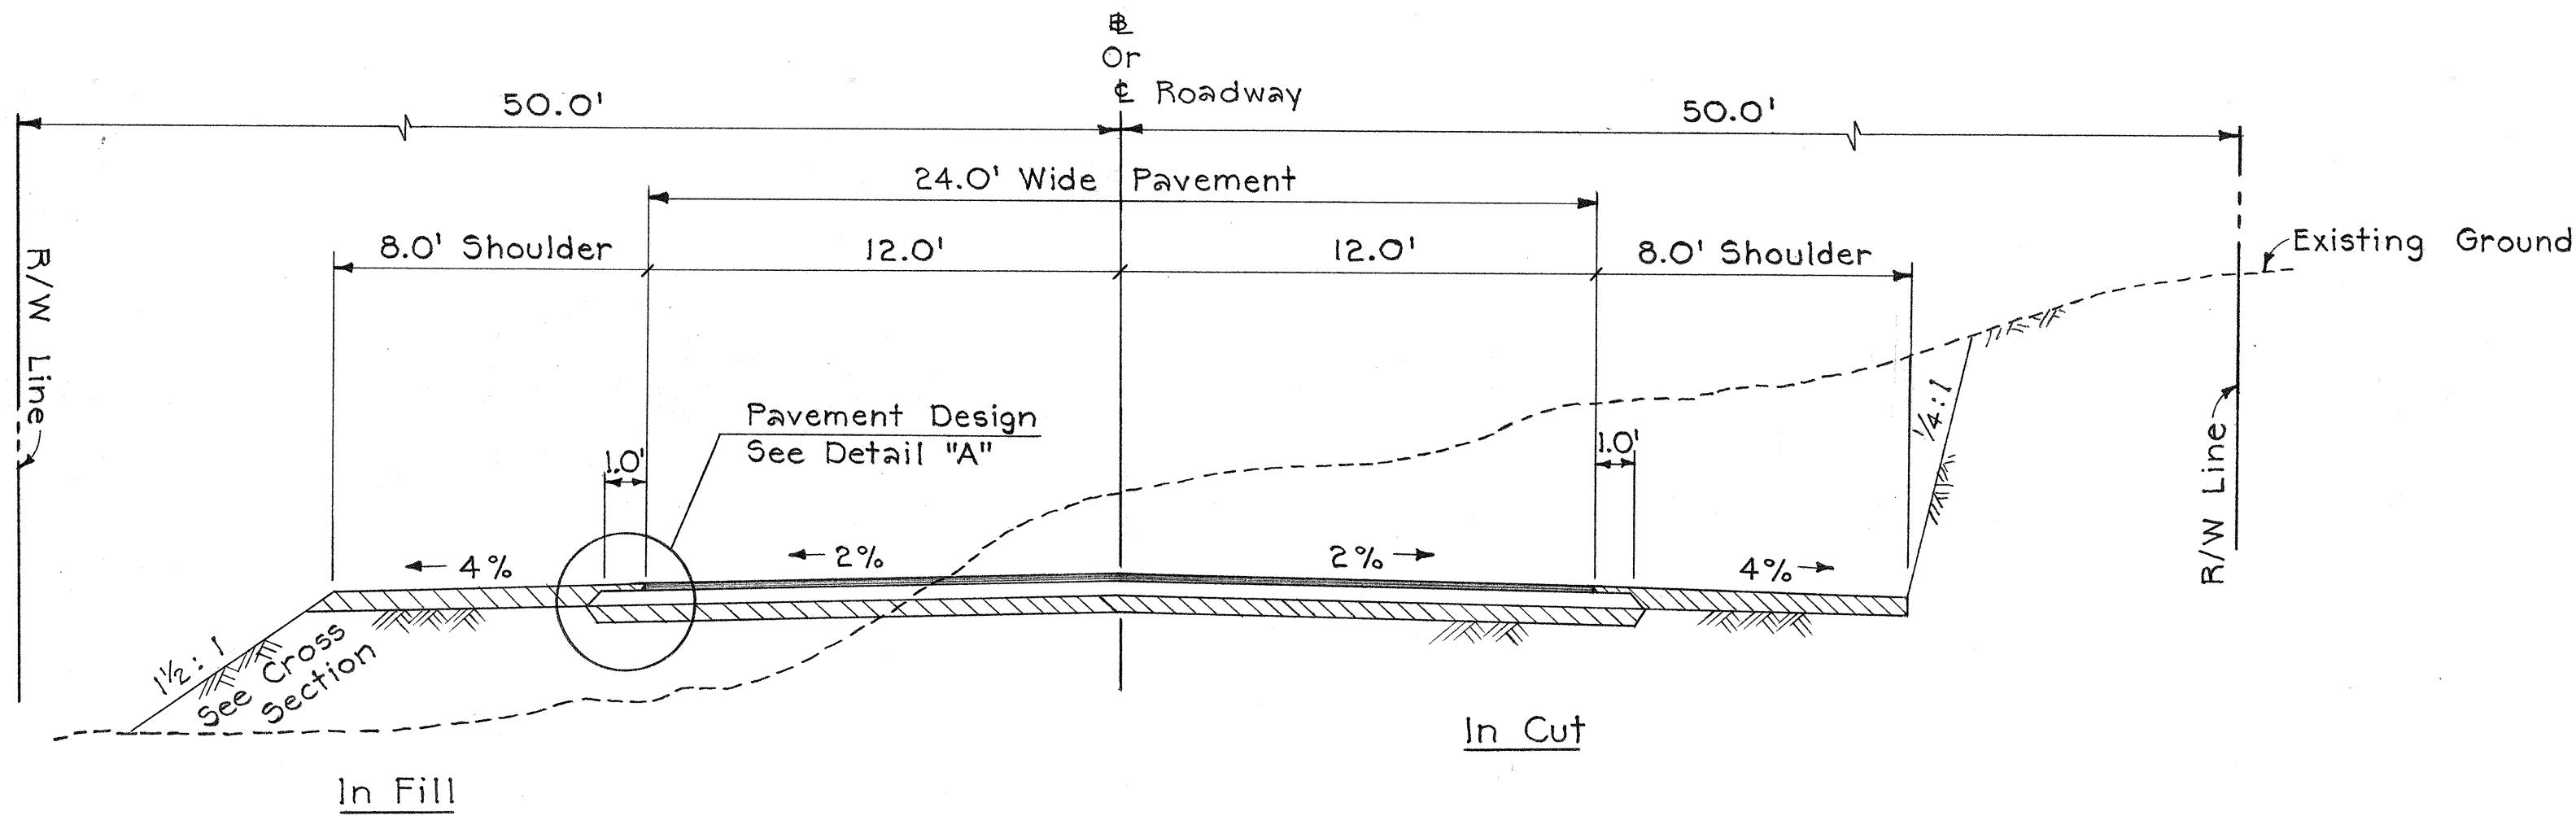


TYPICAL SECTION ON TANGENT
Scale: 1/4" = 1'-0"

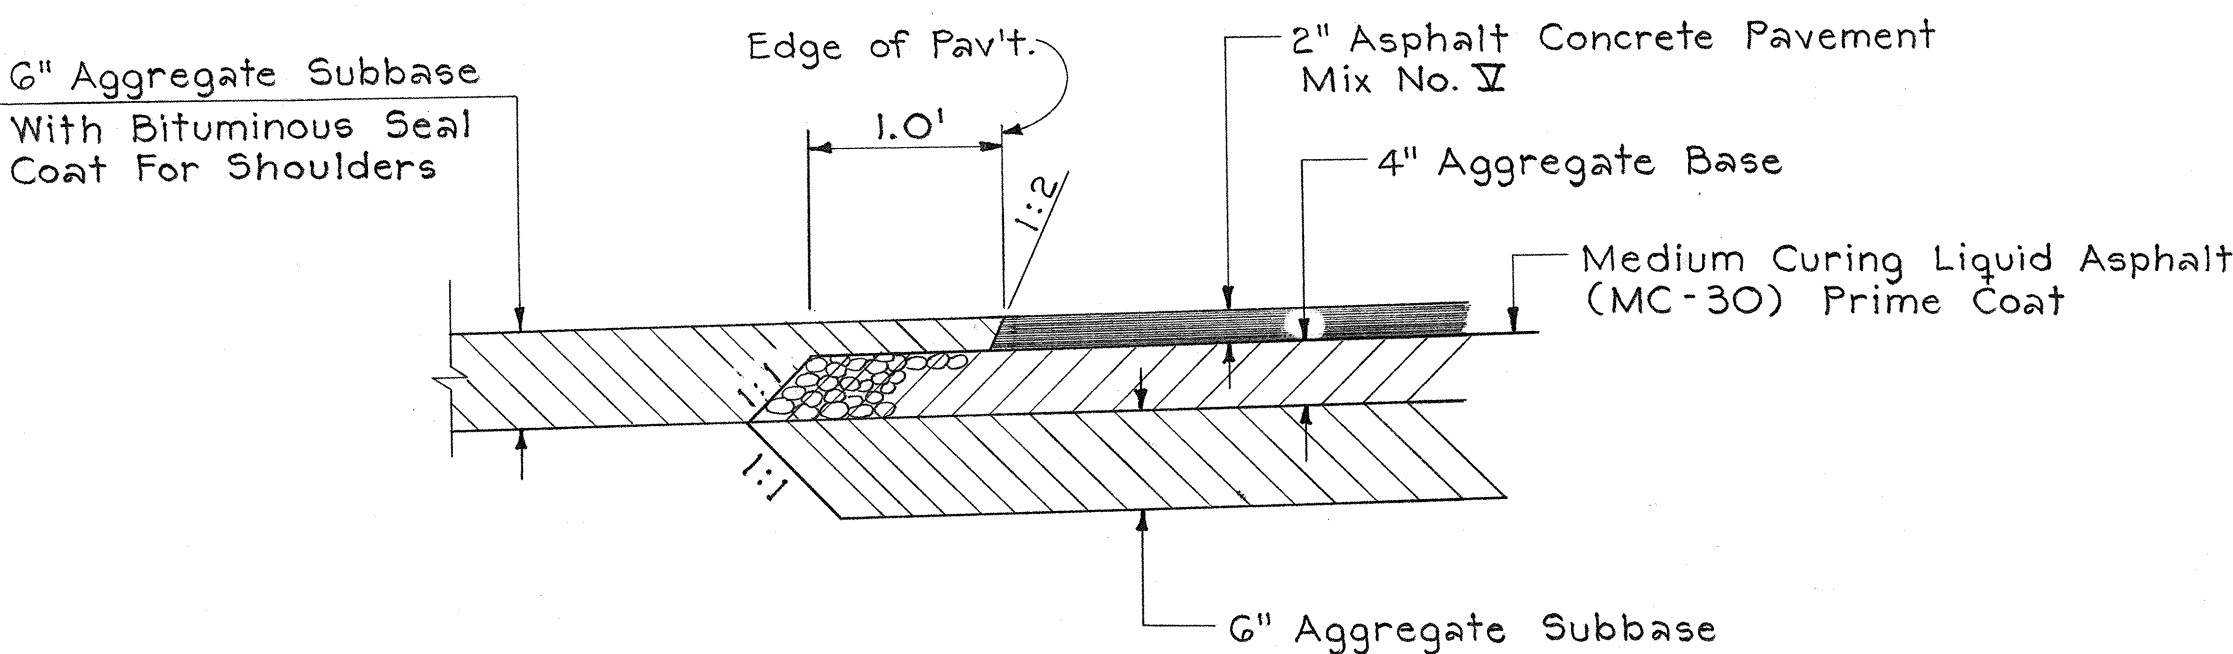


Scale: 1" = 1'-0"

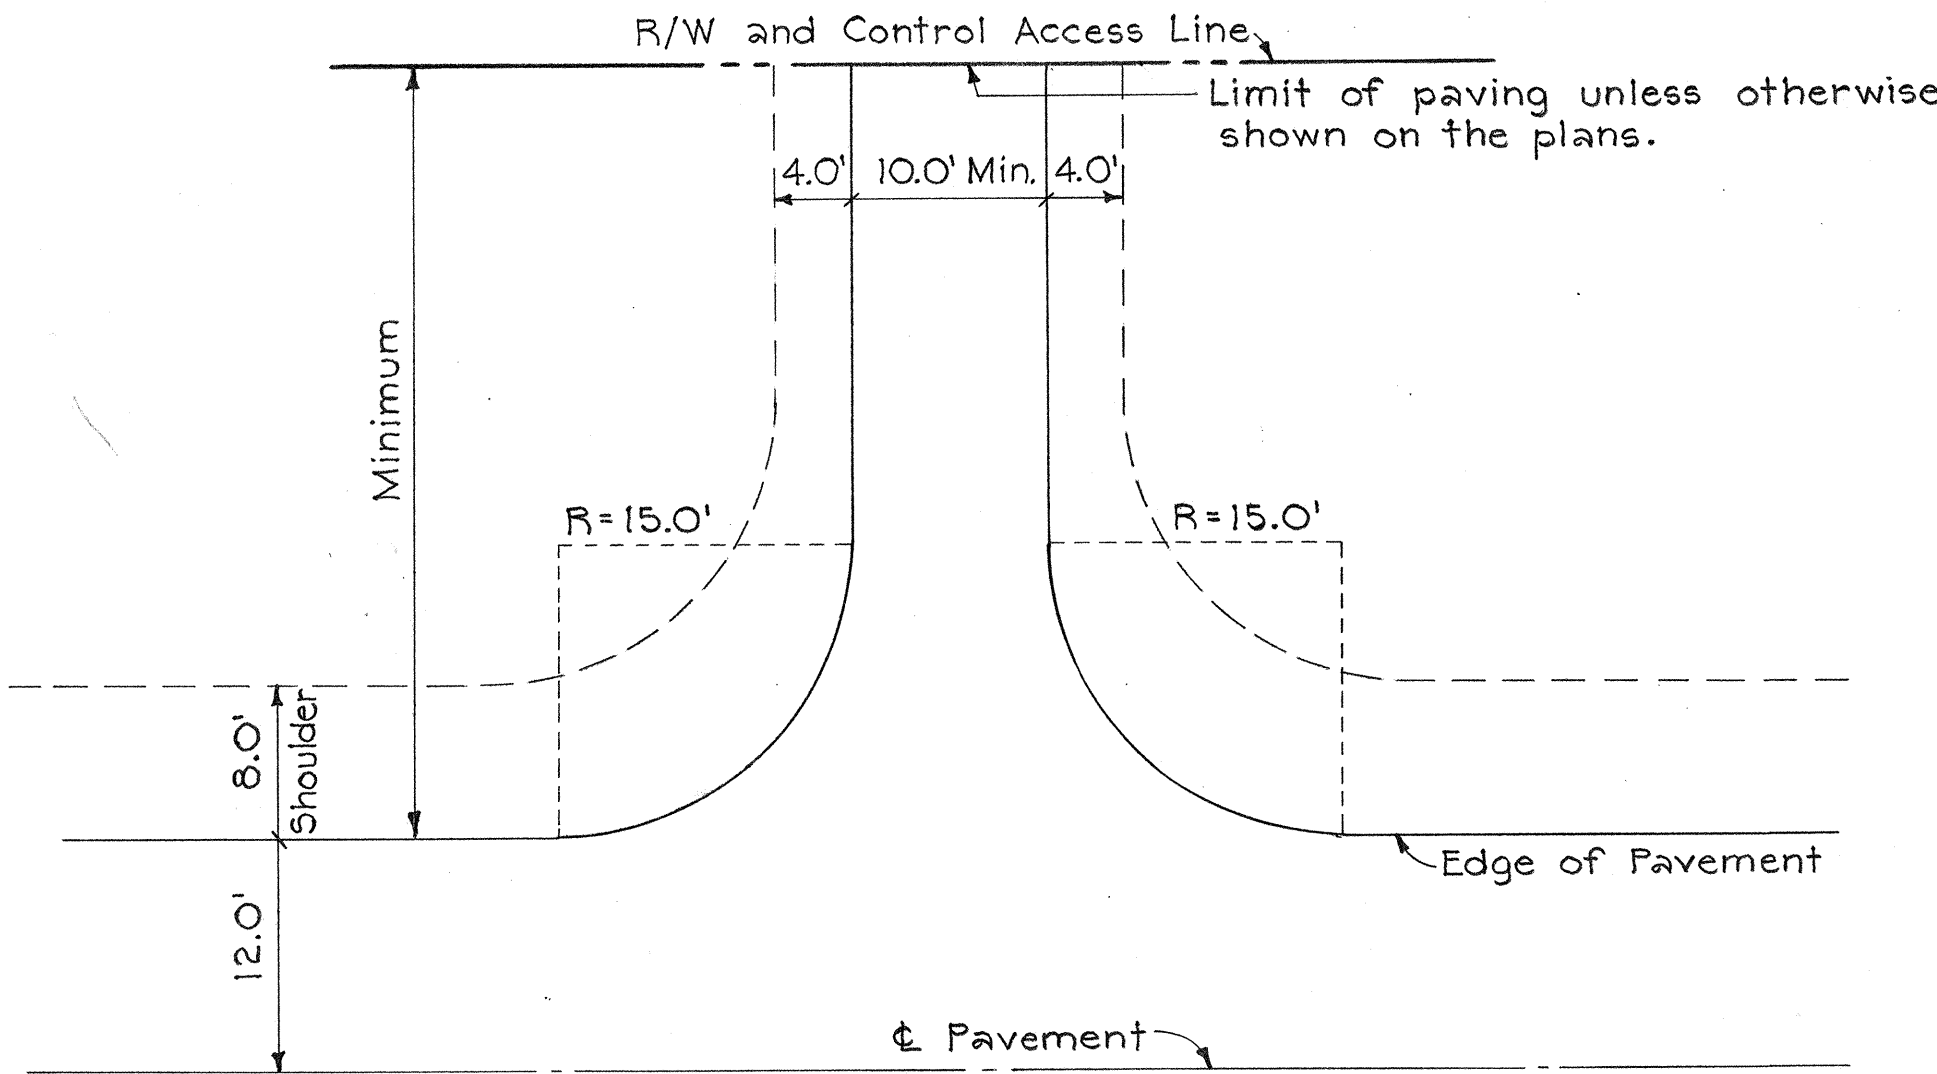


Scale: 1" = 10'-0"

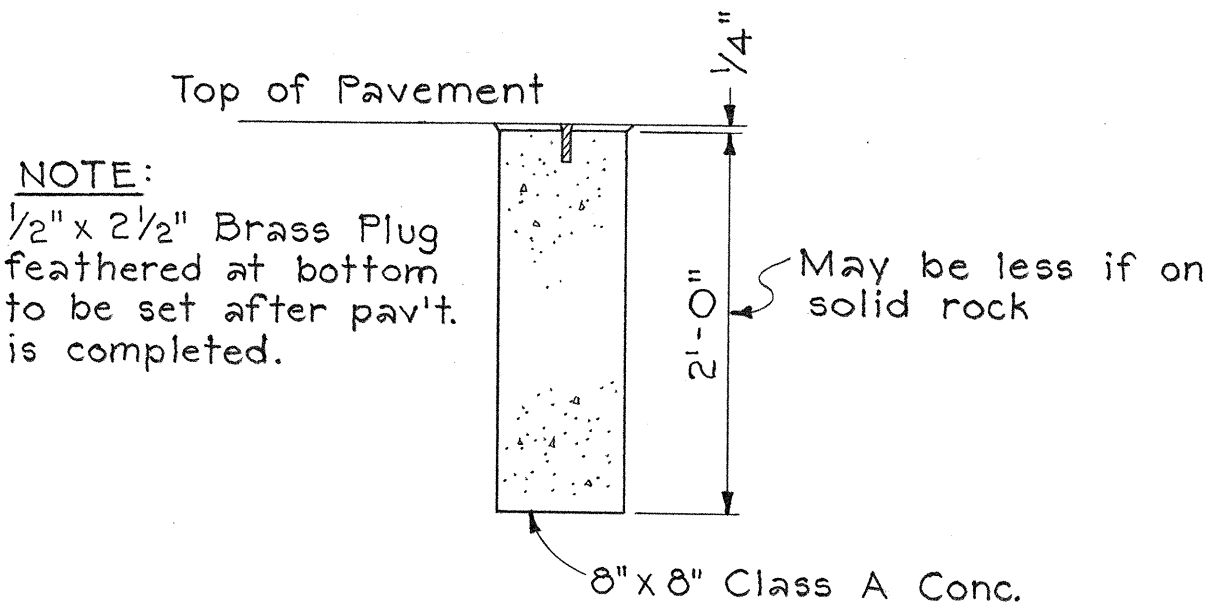

Scale: 1" = 1'-0"

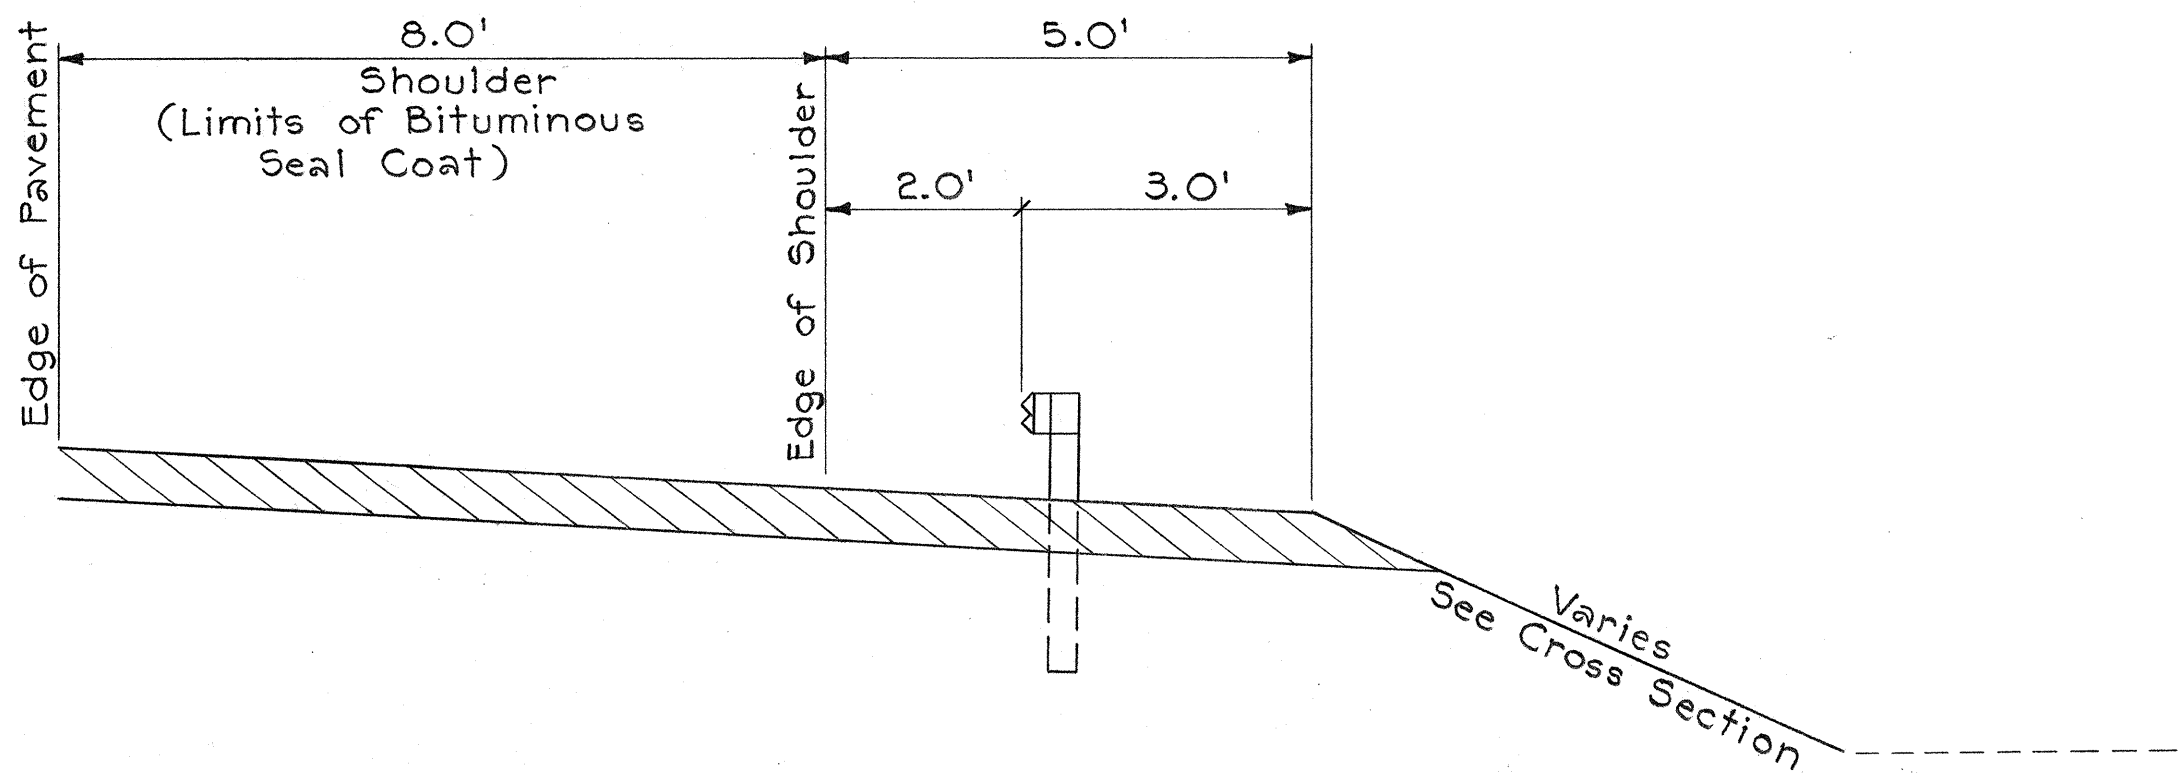

Scale: 1/2" = 1'-0"

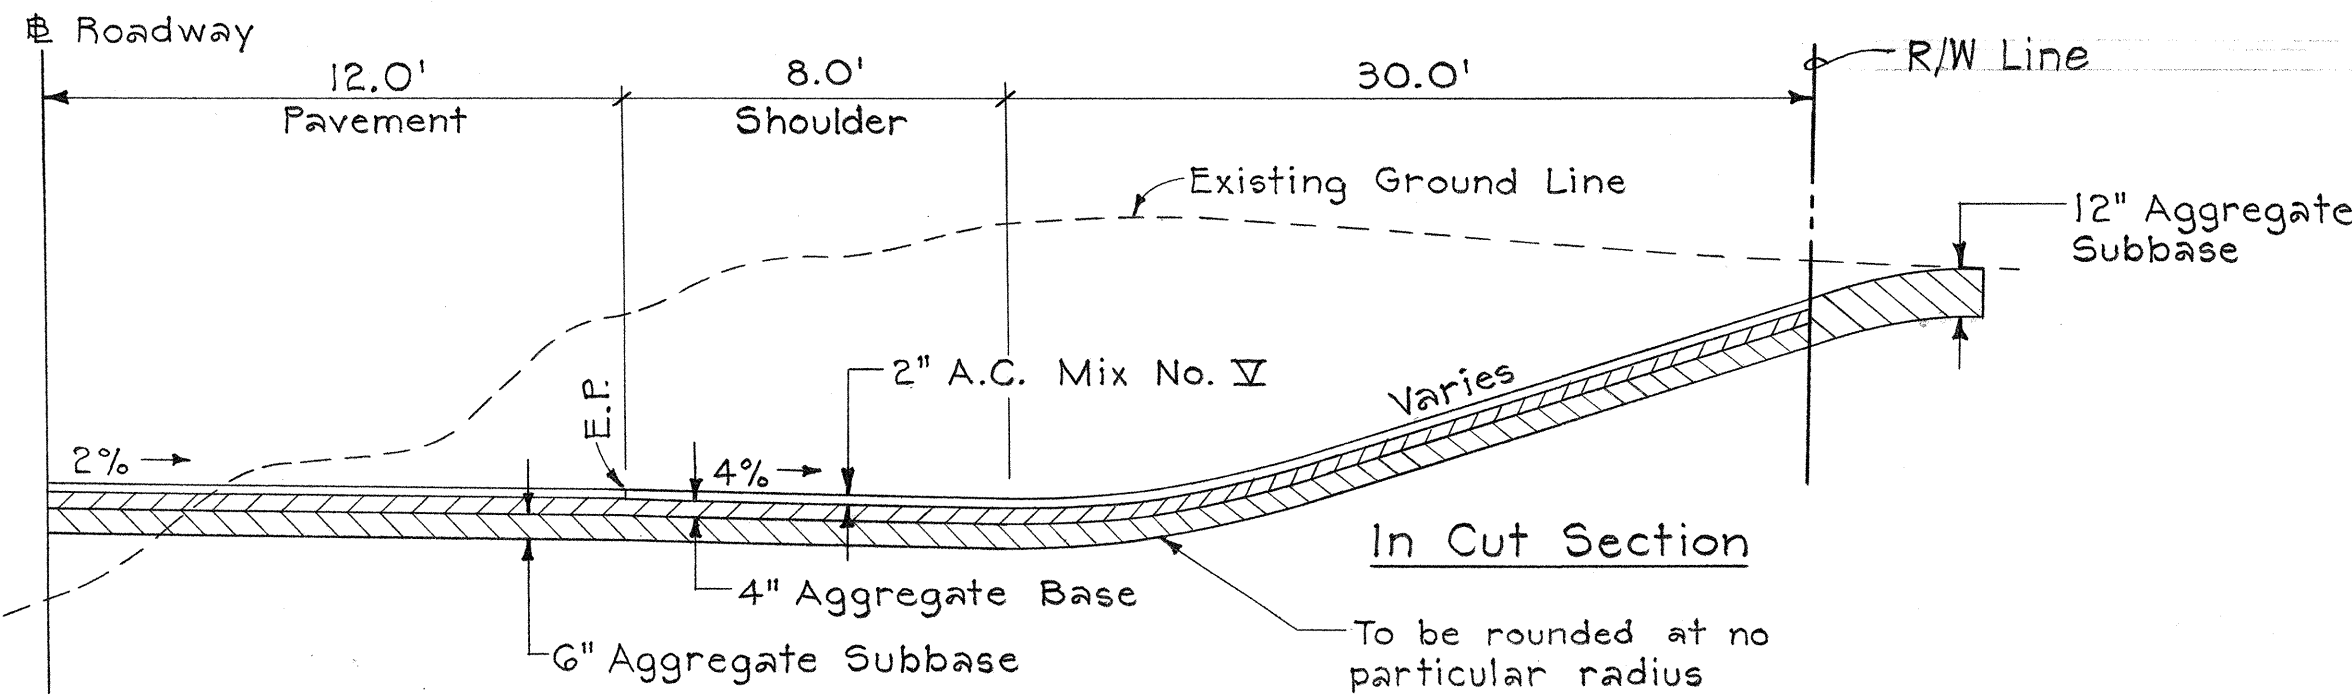


Scale: 1/4" = 1'-0"

STATE OF HAWAII
DEPARTMENT OF TRANSPORTATION
HIGHWAYS DIVISION
TYPICAL SECTIONS OF
ROADWAY, SIDEROAD AND
CENTERLINE MONUMENT
KAHUKU TO PAPA
PROJECT No. 11E-01-75

Scale: As Noted Date: Feb. 1975

SHEET No. 1 OF 1 SHEETS

FED. ROAD DIST. NO.	STATE	PROJ. NO.	FISCAL YEAR	SHEET NO.	TOTAL SHEETS
HAWAII	HAW.	11E-01-75	1975	60.25-1	45

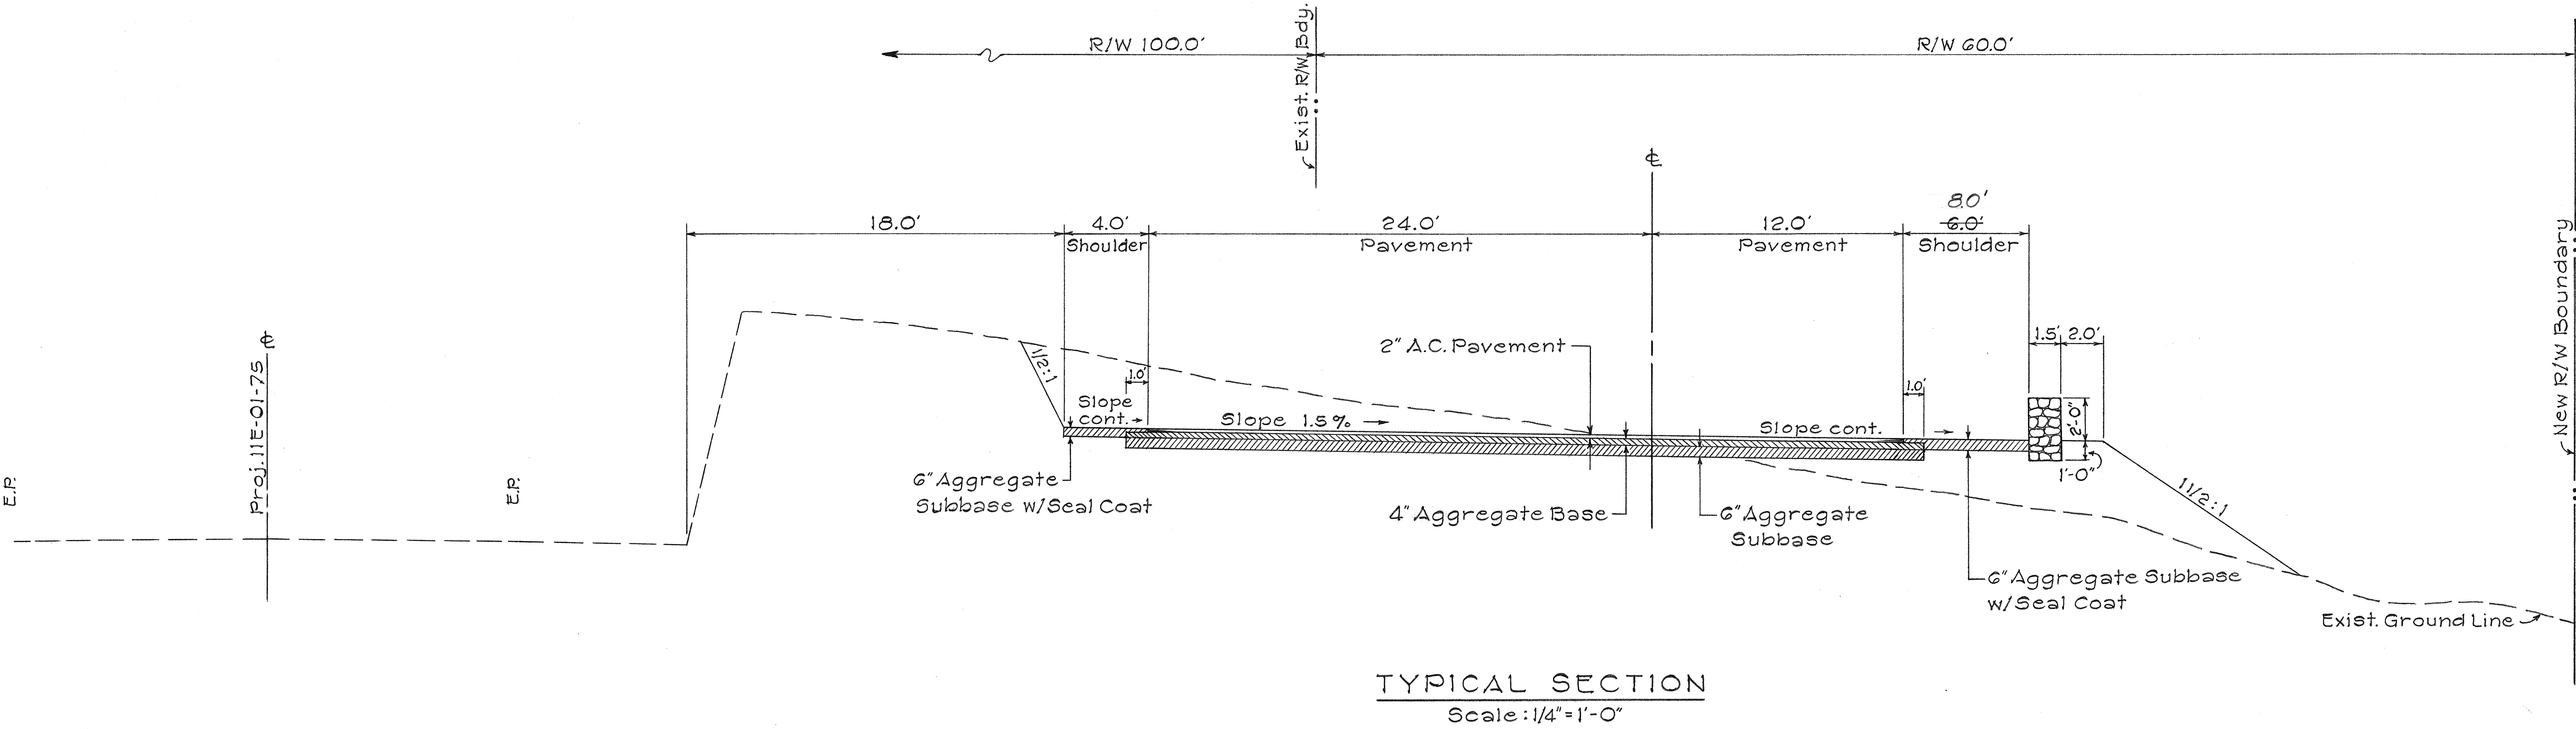

Contract Change Order #1

STATE OF HAWAII
DEPARTMENT OF TRANSPORTATION
HIGHWAYS DIVISION

SCENIC LOOKOUT
KAHUKU ~ PAPA
DISTRICT OF KAU, HAWAII

Scale: As Noted Date: Feb. 1976
SHEET No. OF SHEETS

C.O. 2 S-1

ORIGINAL PLAN	SURVEY PLOTTED BY	DATE
NOTE BOOK	DRAWN BY	
No.	DESIGNED BY	
	QUANTITIES BY	
	CHECKED BY	