
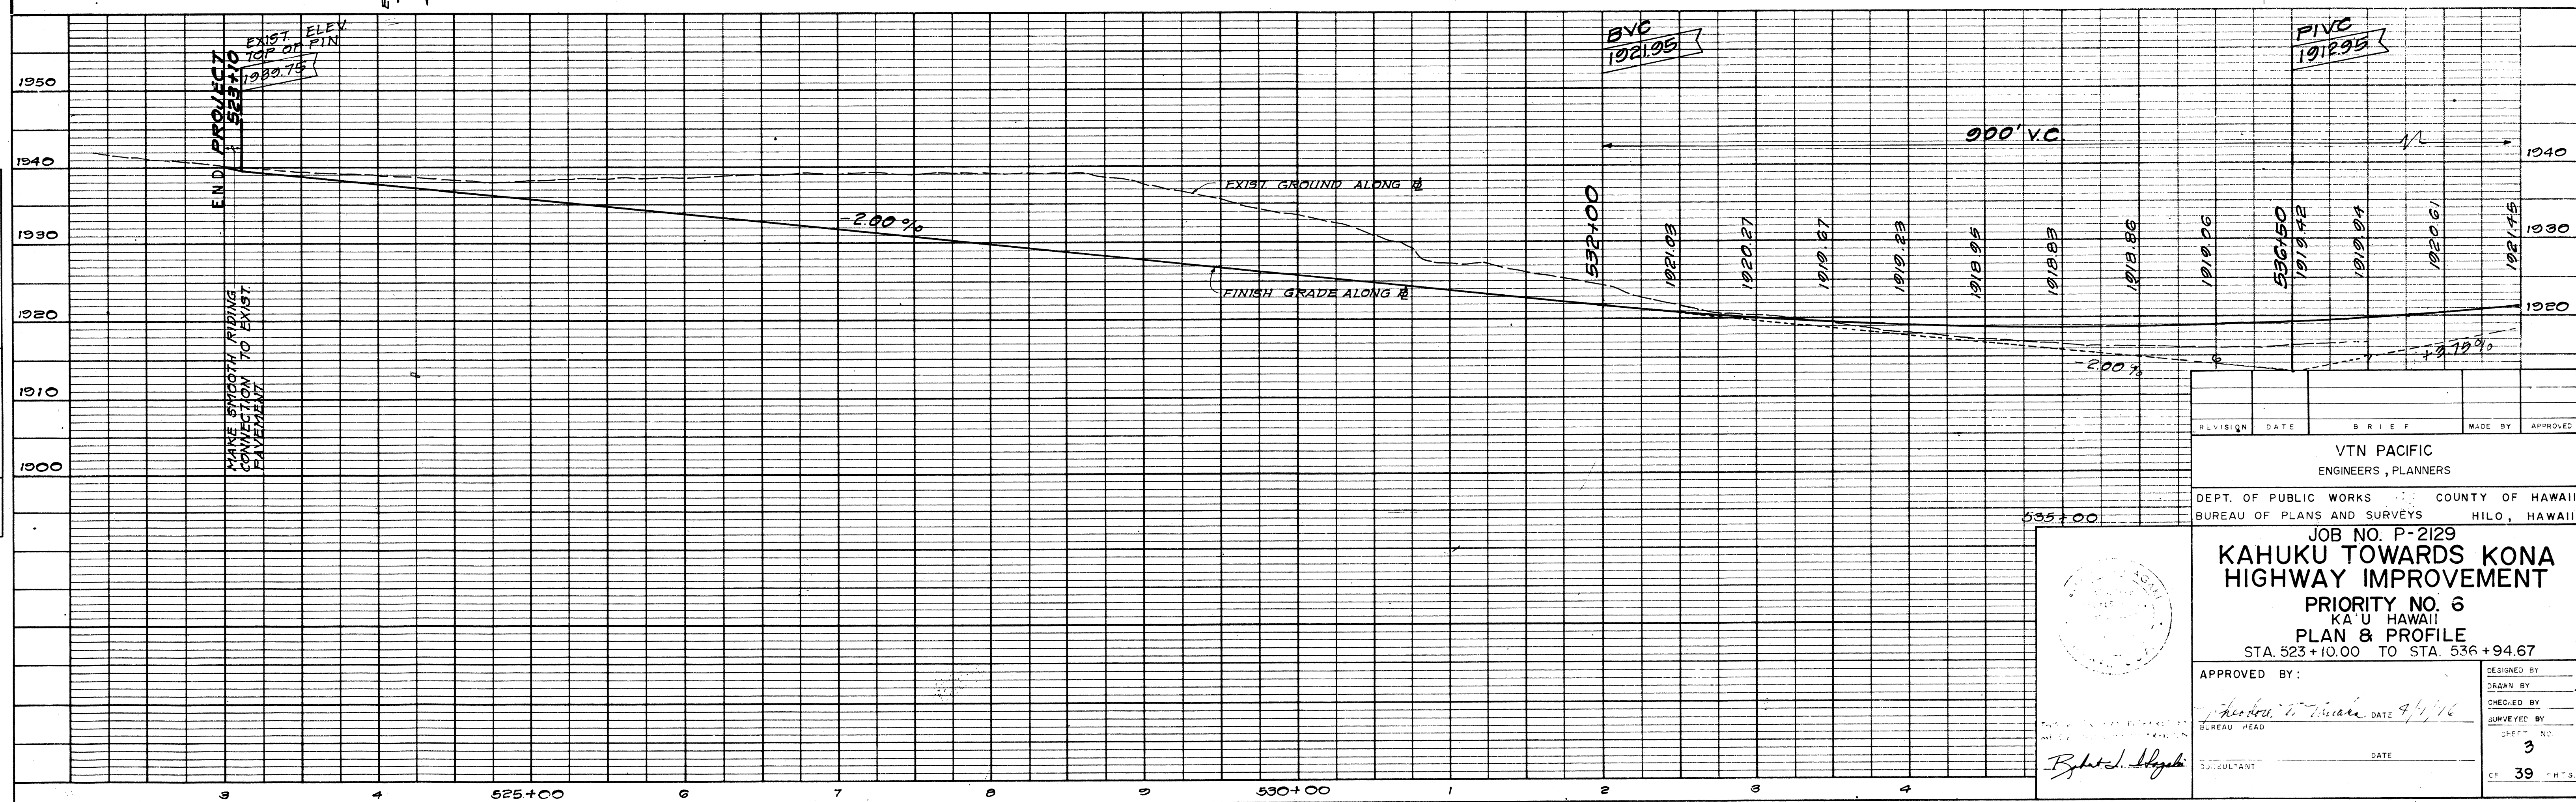




PLAN	DATE
SURVEYED	BY
NOTED	DATE
GRADES CHECKED	DATE
STRUCTURE NOTATIONS CHG.	DATE

PROFILE	DATE
SURVEYED	BY
NOTED	DATE
GRADES CHECKED	DATE
STRUCTURE NOTATIONS CHG.	DATE

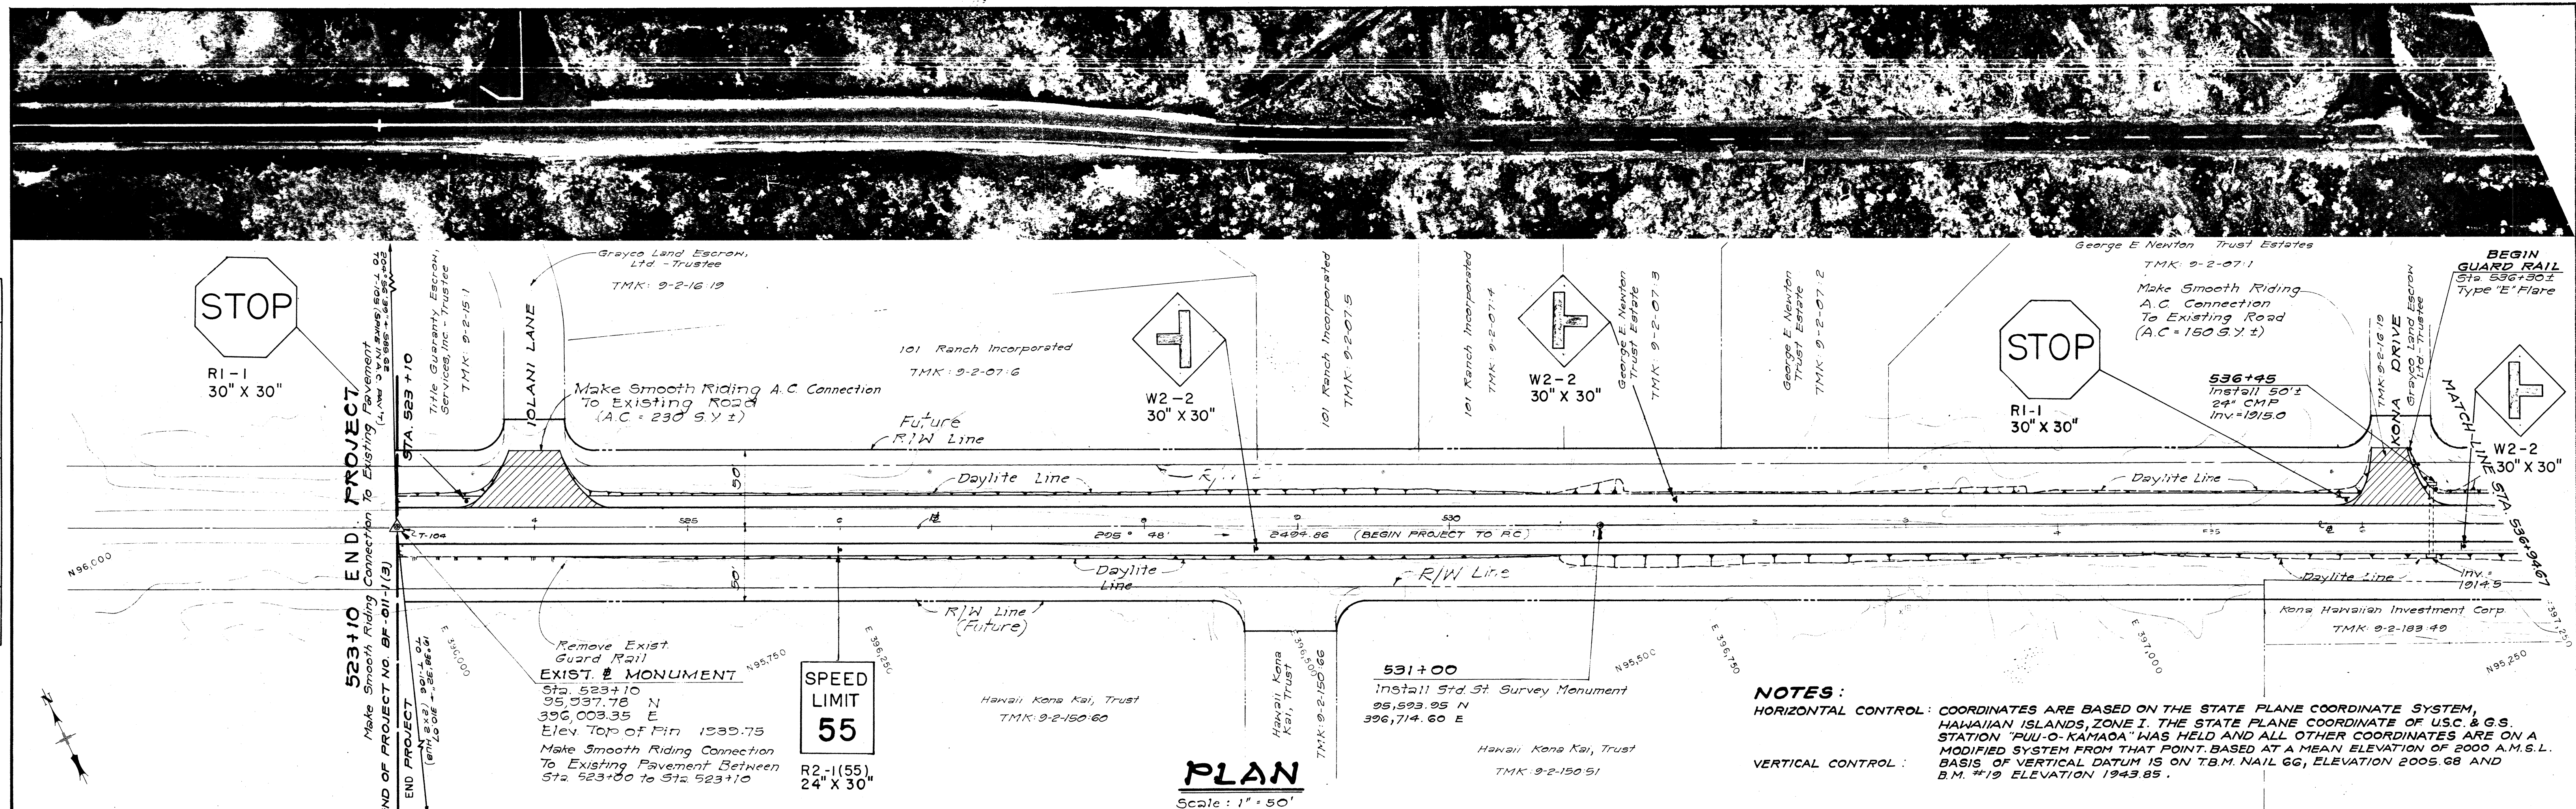


REVISION	DATE	BRIEF	MADE BY	APPROVED
VTN PACIFIC ENGINEERS, PLANNERS				
DEPT. OF PUBLIC WORKS COUNTY OF HAWAII BUREAU OF PLANS AND SURVEYS HILO, HAWAII				
JOB NO. P-2129 KAHUKU TOWARDS KONA HIGHWAY IMPROVEMENT PRIORITY NO. 6 KA'U HAWAII PLAN & PROFILE STA. 523+10.00 TO STA. 536+45.67				
APPROVED BY:			DESIGNED BY:	
BUREAU HEAD			DRAWN BY:	
DATE			CHECKED BY:	
DATE			SURVEYED BY:	
DATE			DATE	
DATE			DATE	

PROFILE	SURVEYED	BY	DATE
NOTE BOOK	GRADES CHECKED		
NO.	B. M.'S NOTED		
	STRUCTURE NOTATIONS CHK'D.		

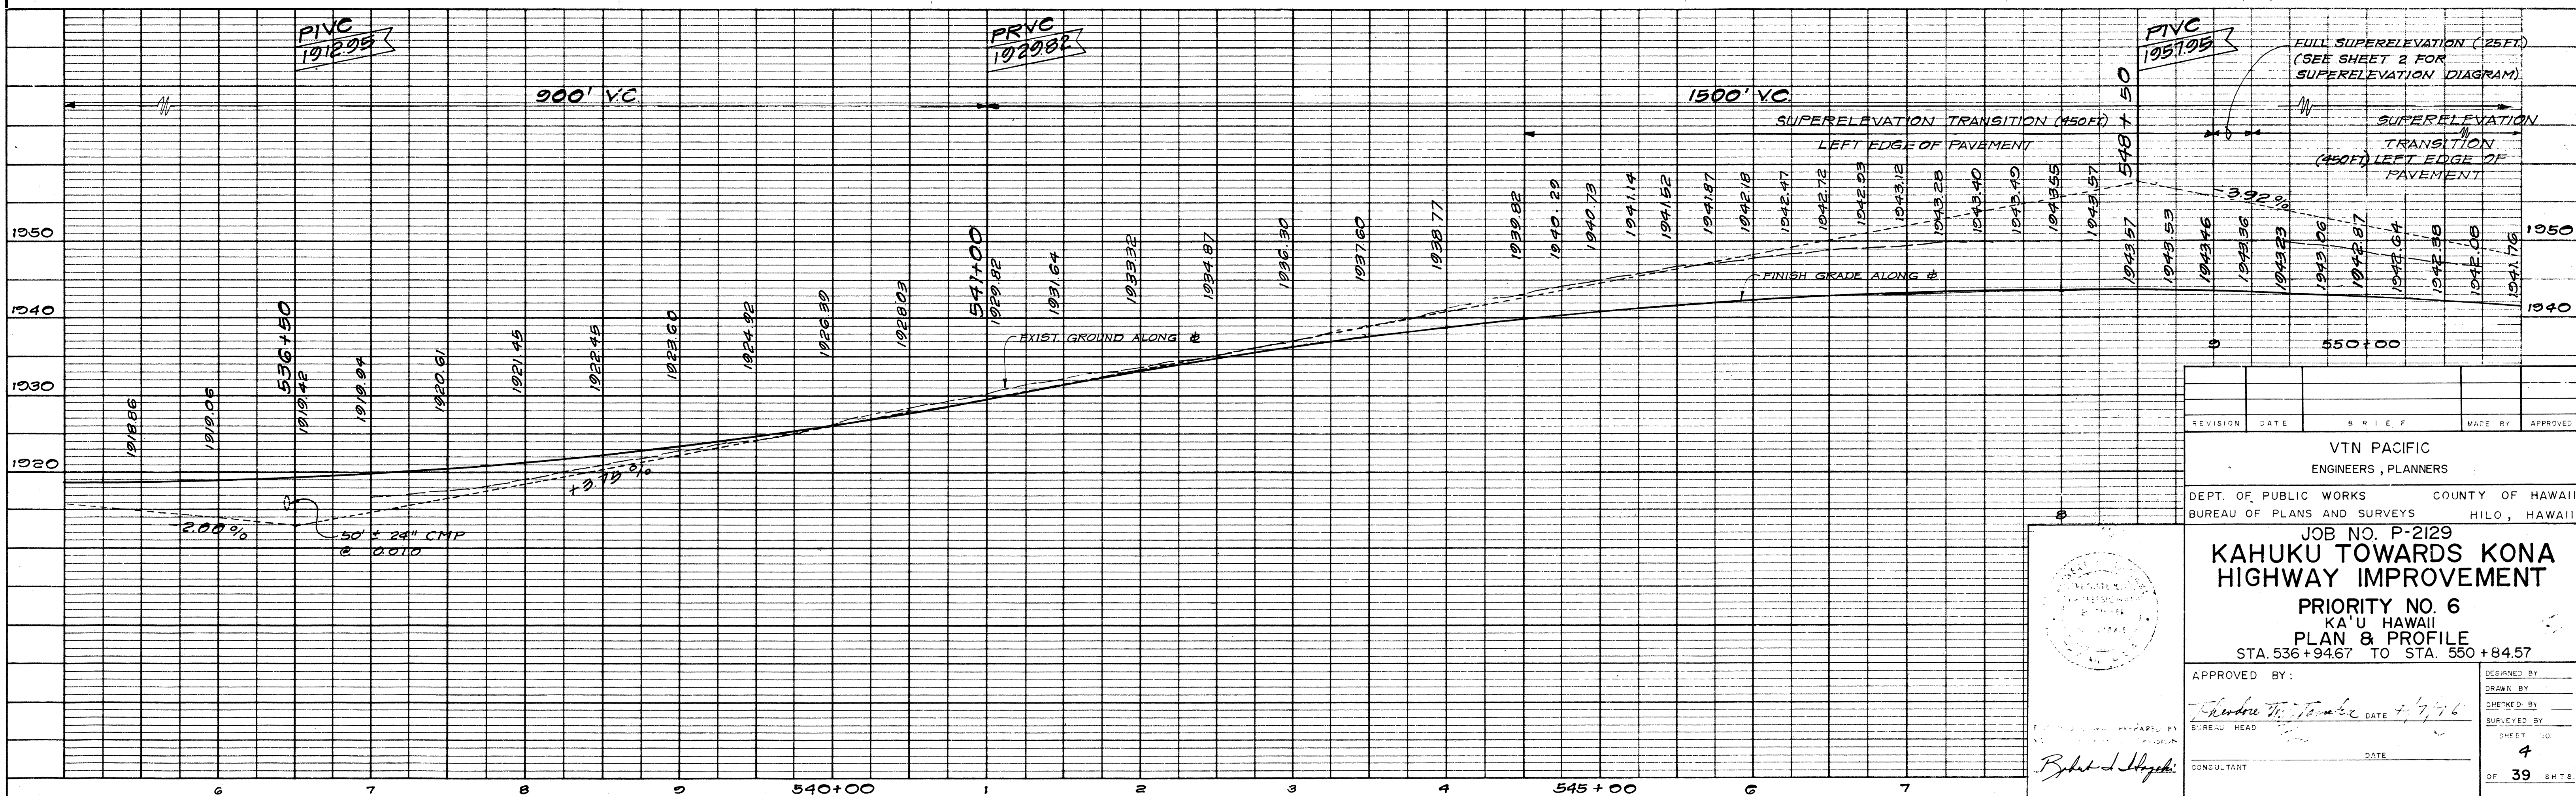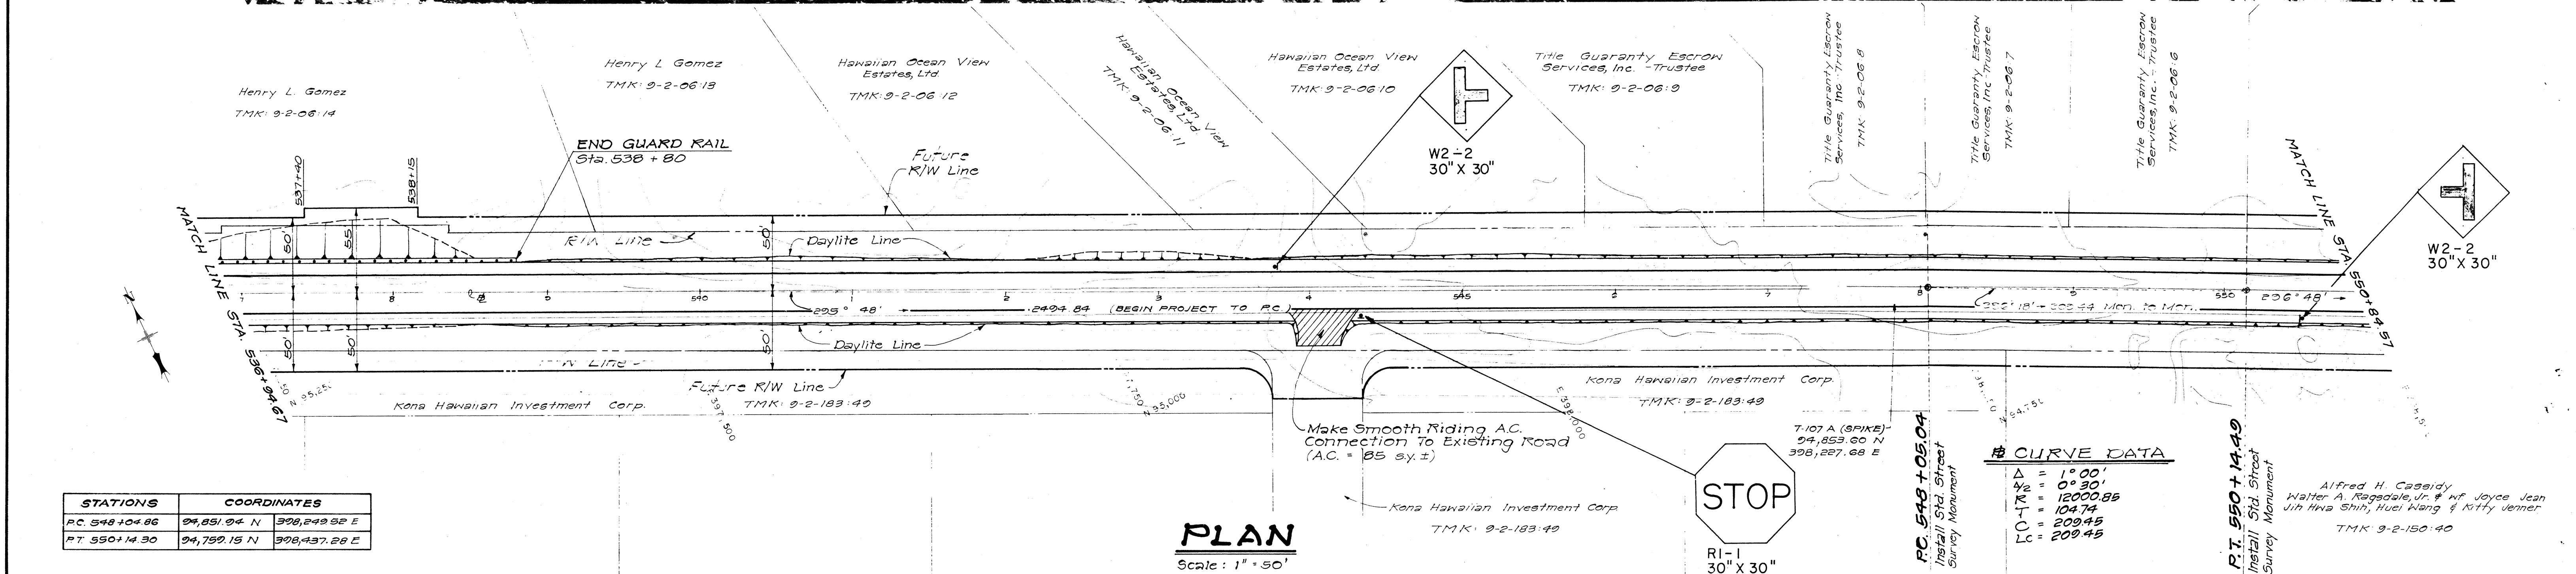


PLAN	DATE	BY
SURVEYED		
PLOTTED		
ALIGNED CHECKED		
NOTE BOOK NO.		


PROFILE	DATE	BY
SURVEYED		
PLOTTED		
GRADES CHECKED		
NOTE BOOK NO.		

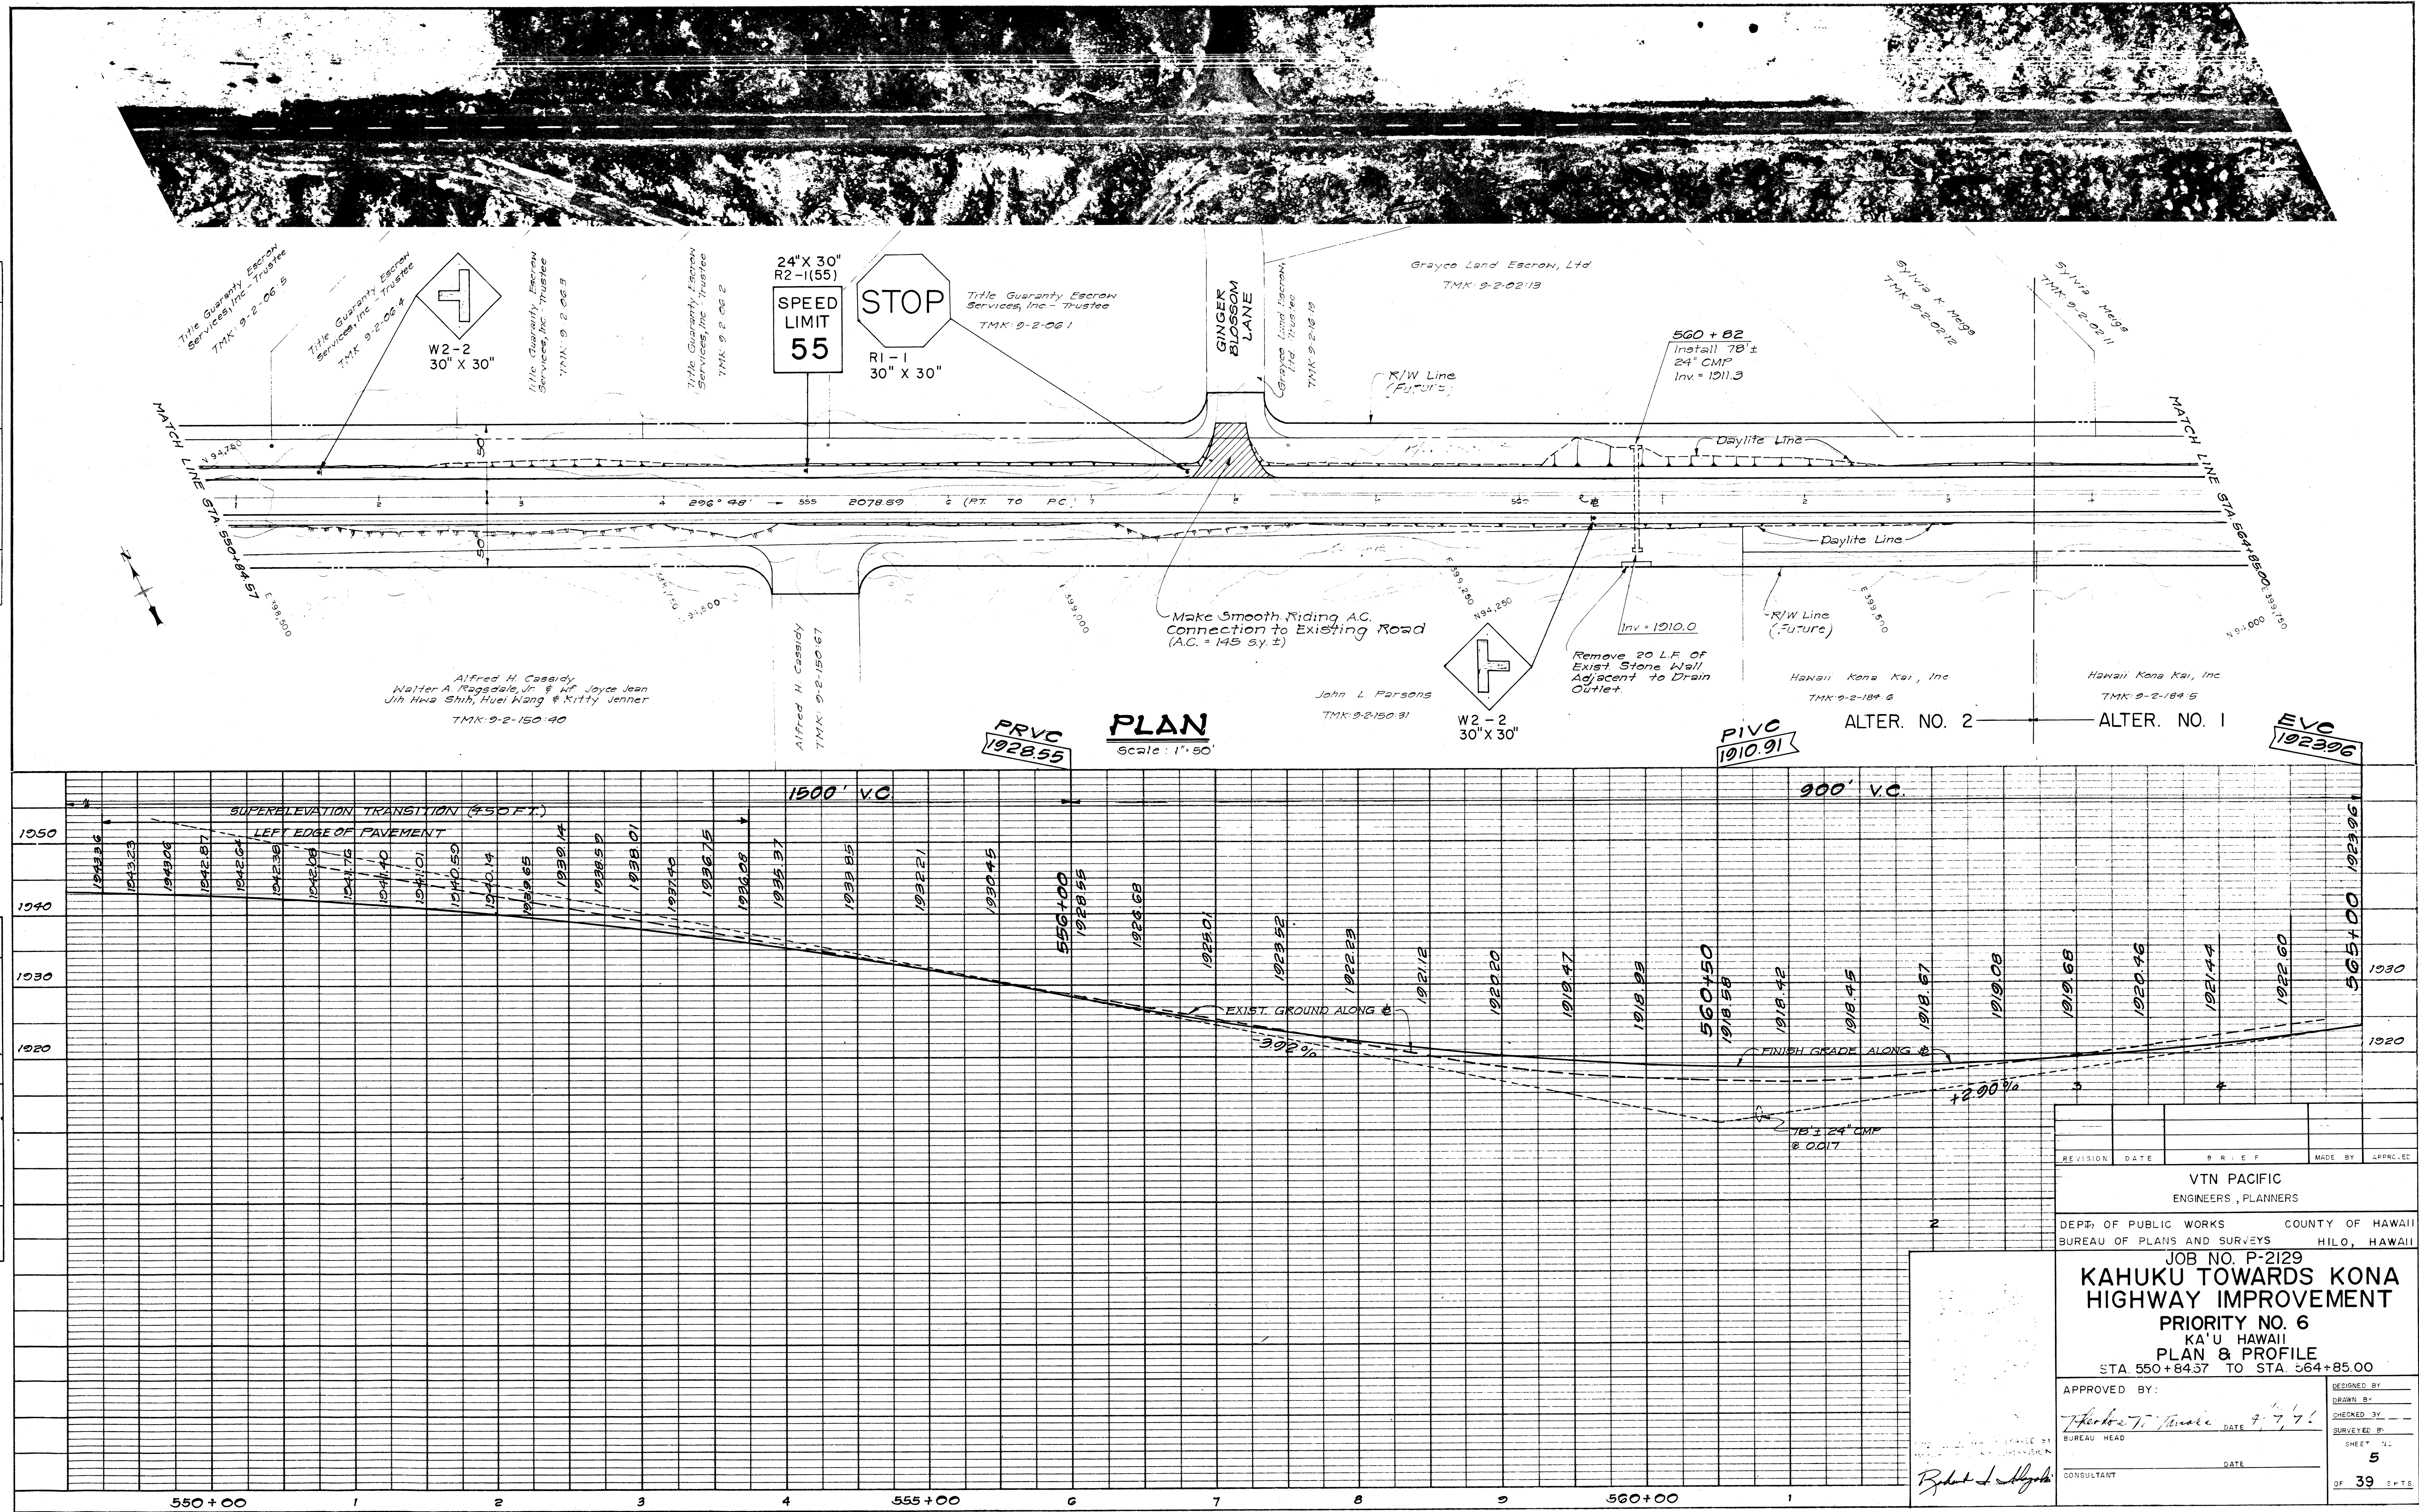

DATE	BY	SURVEYED	ALIGNED	CHECKED	RT. OF WAY
PLAN					
NOTE BOOK					
NO.					

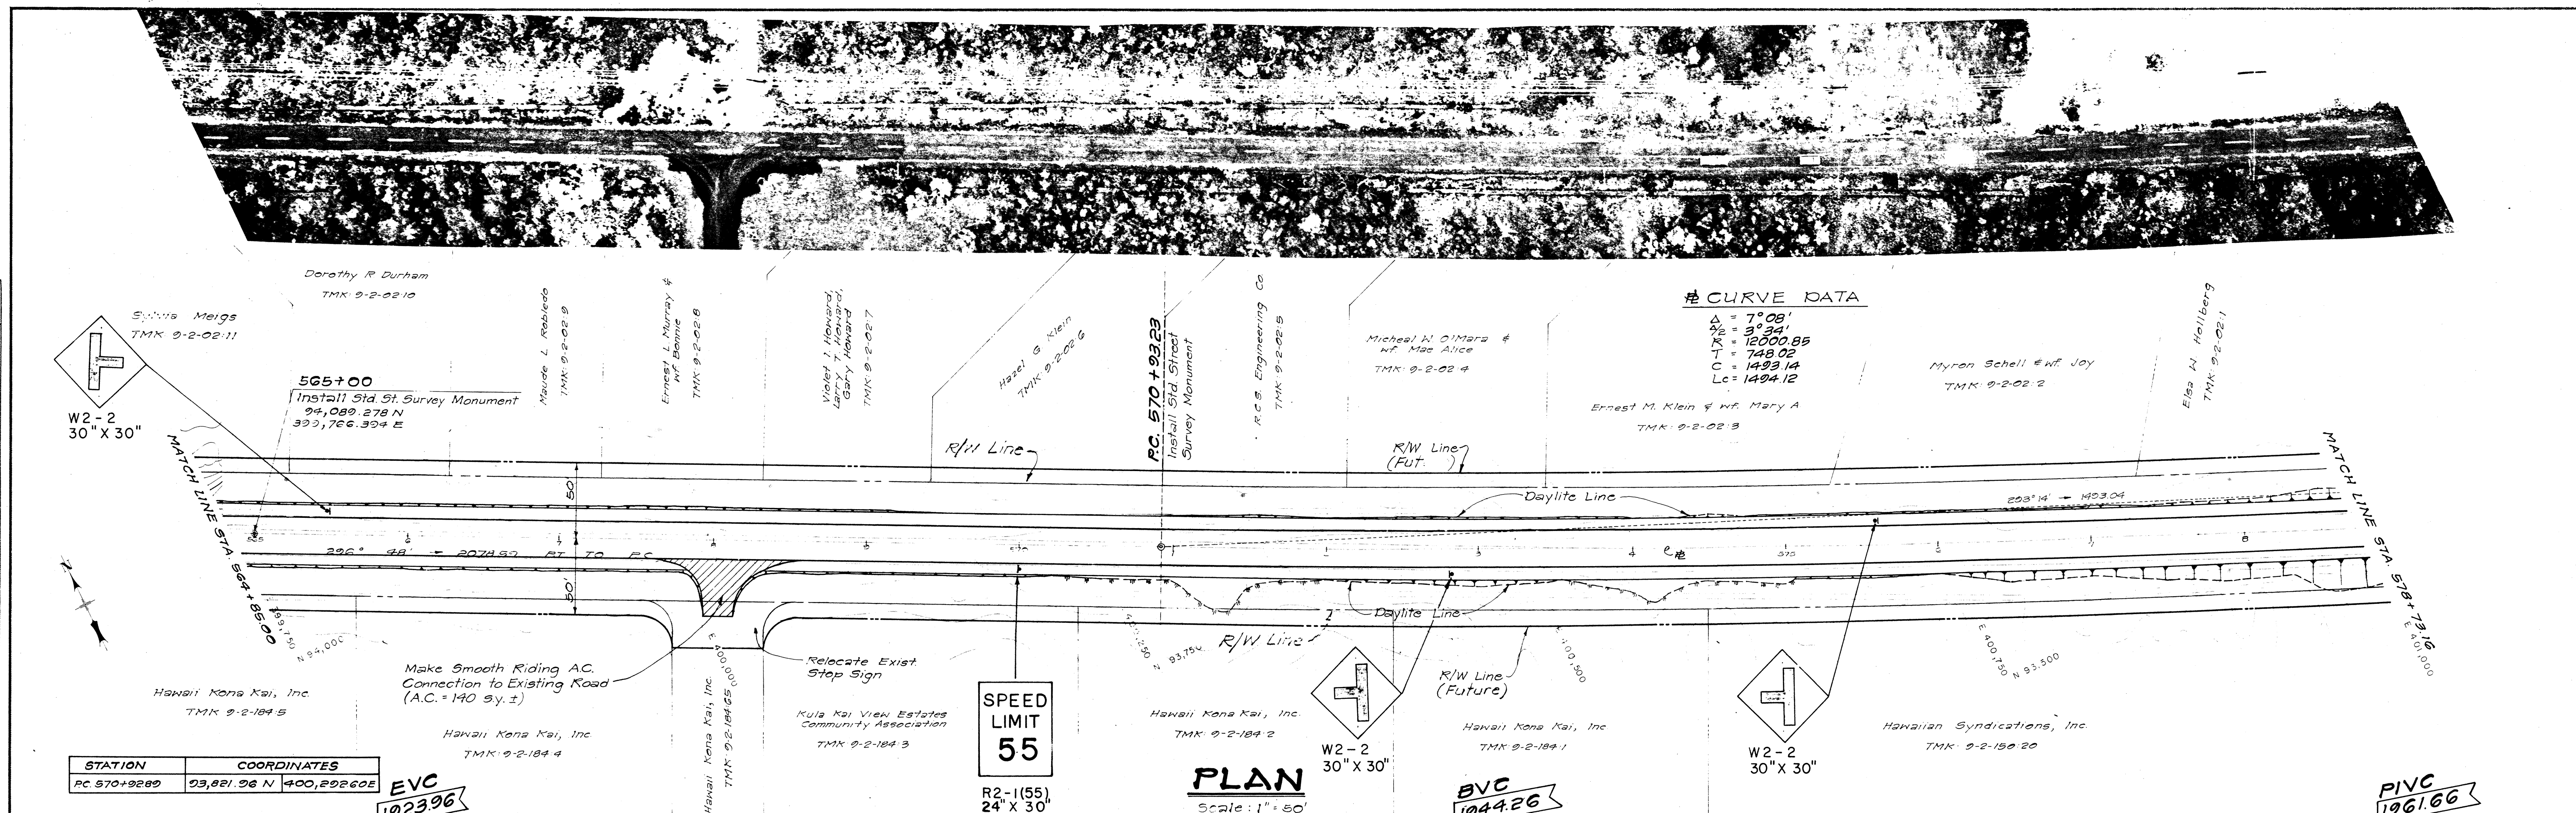


DATE	BY	SURVEYED	GRADES	CHECKED	STRUCTURE
PROFILE					
NOTE BOOK					
NO.					

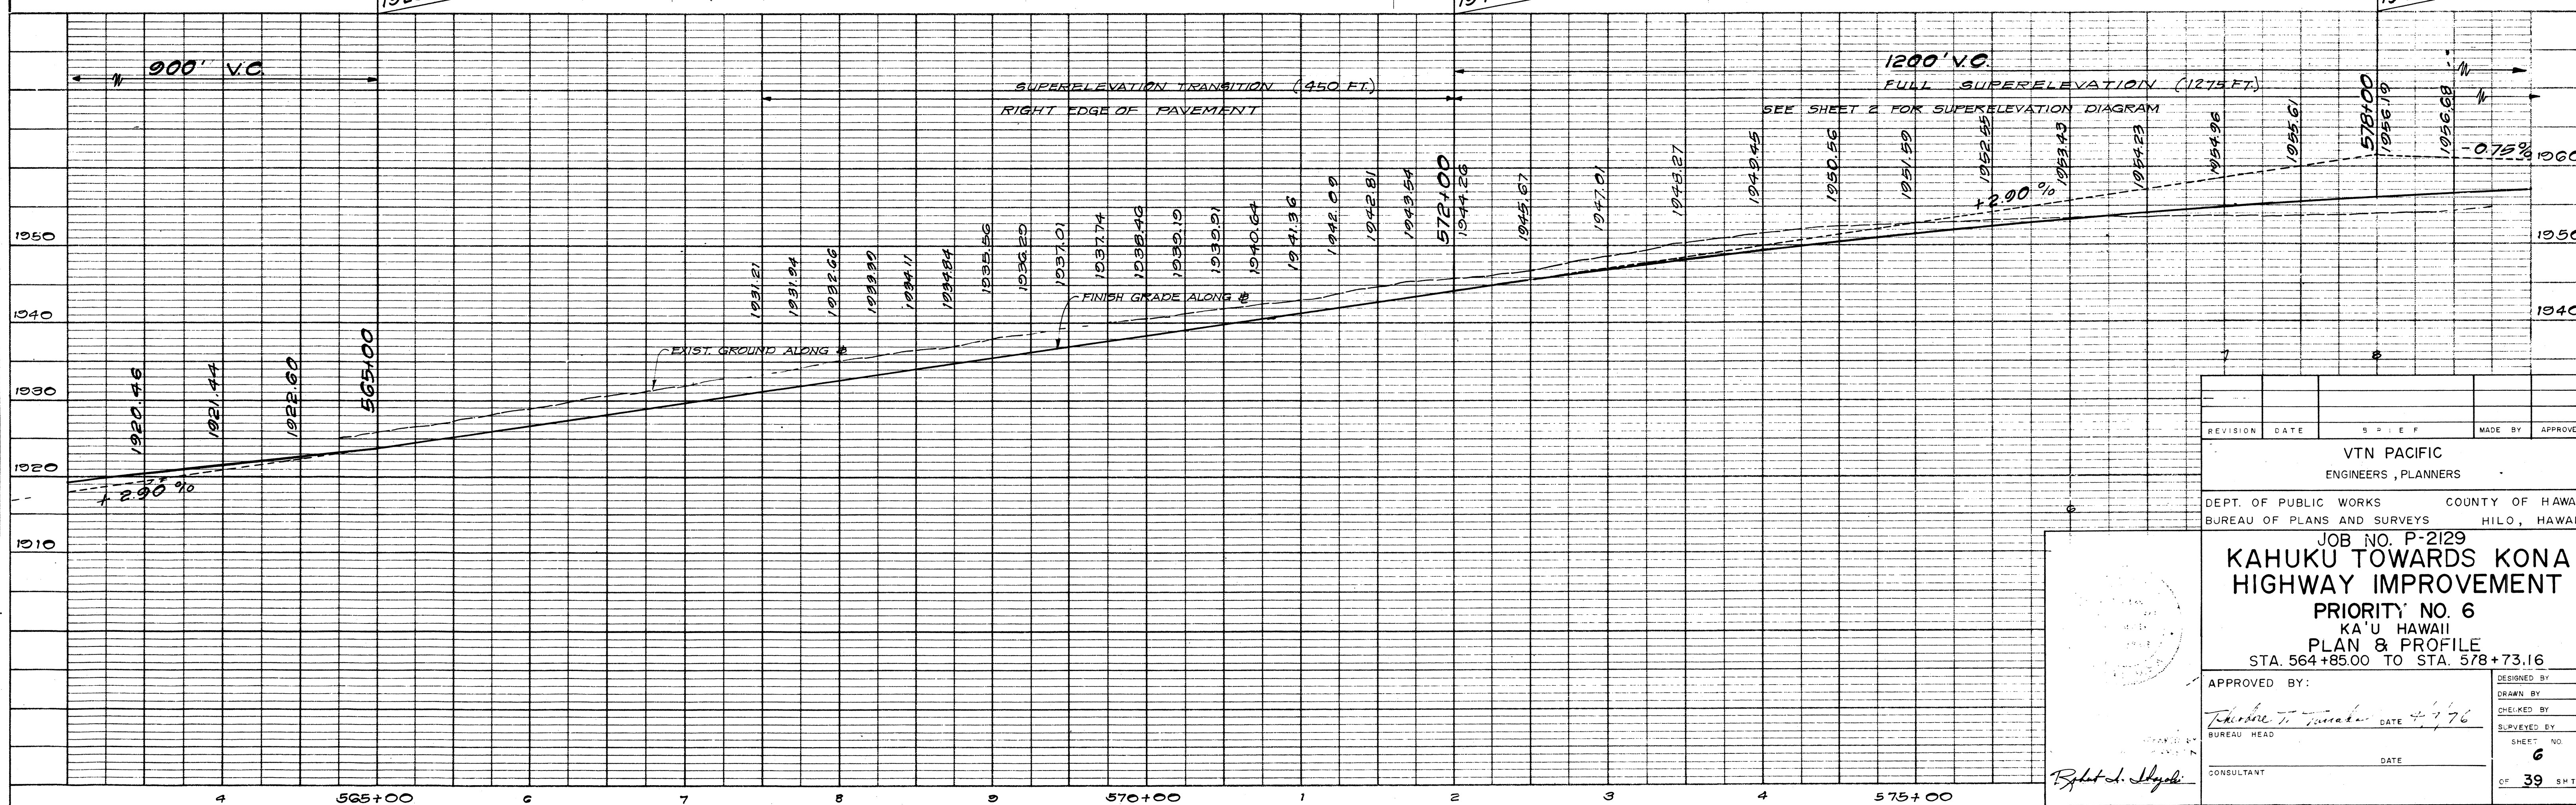

REVISION	DATE	BY	MADE BY	APPROVED
VTN PACIFIC ENGINEERS, PLANNERS				
DEPT. OF PUBLIC WORKS COUNTY OF HAWAII BUREAU OF PLANS AND SURVEYS HILO, HAWAII				
JOB NO. P-2129 KAHUKU TOWARDS KONA HIGHWAY IMPROVEMENT PRIORITY NO. 6 KA'U HAWAII PLAN & PROFILE STA. 564+85.00 TO STA. 578+73.16				
APPROVED BY: <i>[Signature]</i> DATE: 4/76				
BUREAU HEAD: <i>[Signature]</i> DATE: _____				
CONSULTANT: <i>[Signature]</i> DATE: _____				
DESIGNED BY: _____ DRAWN BY: _____ CHECKED BY: _____ SURVEYED BY: _____ SHEET NO. 6 OF 39 SHTS.				


PLAN	DATE	
	BY	
SURVEYED PLOTTED NOTE BOOK NO.	SURVEYED	
	PLOTTED	
CHECKED ALIGNMENT RT. OF WAY	CHECKED	
	ALIGNMENT	

PROFILE	DATE	
	BY	
SURVEYED PLOTTED NOTE BOOK NO.	SURVEYED	
	PLOTTED	
CHECKED GRADES B.M.'S NOTED STRUCTURE NOTATIONS	CHECKED	
	GRADES	

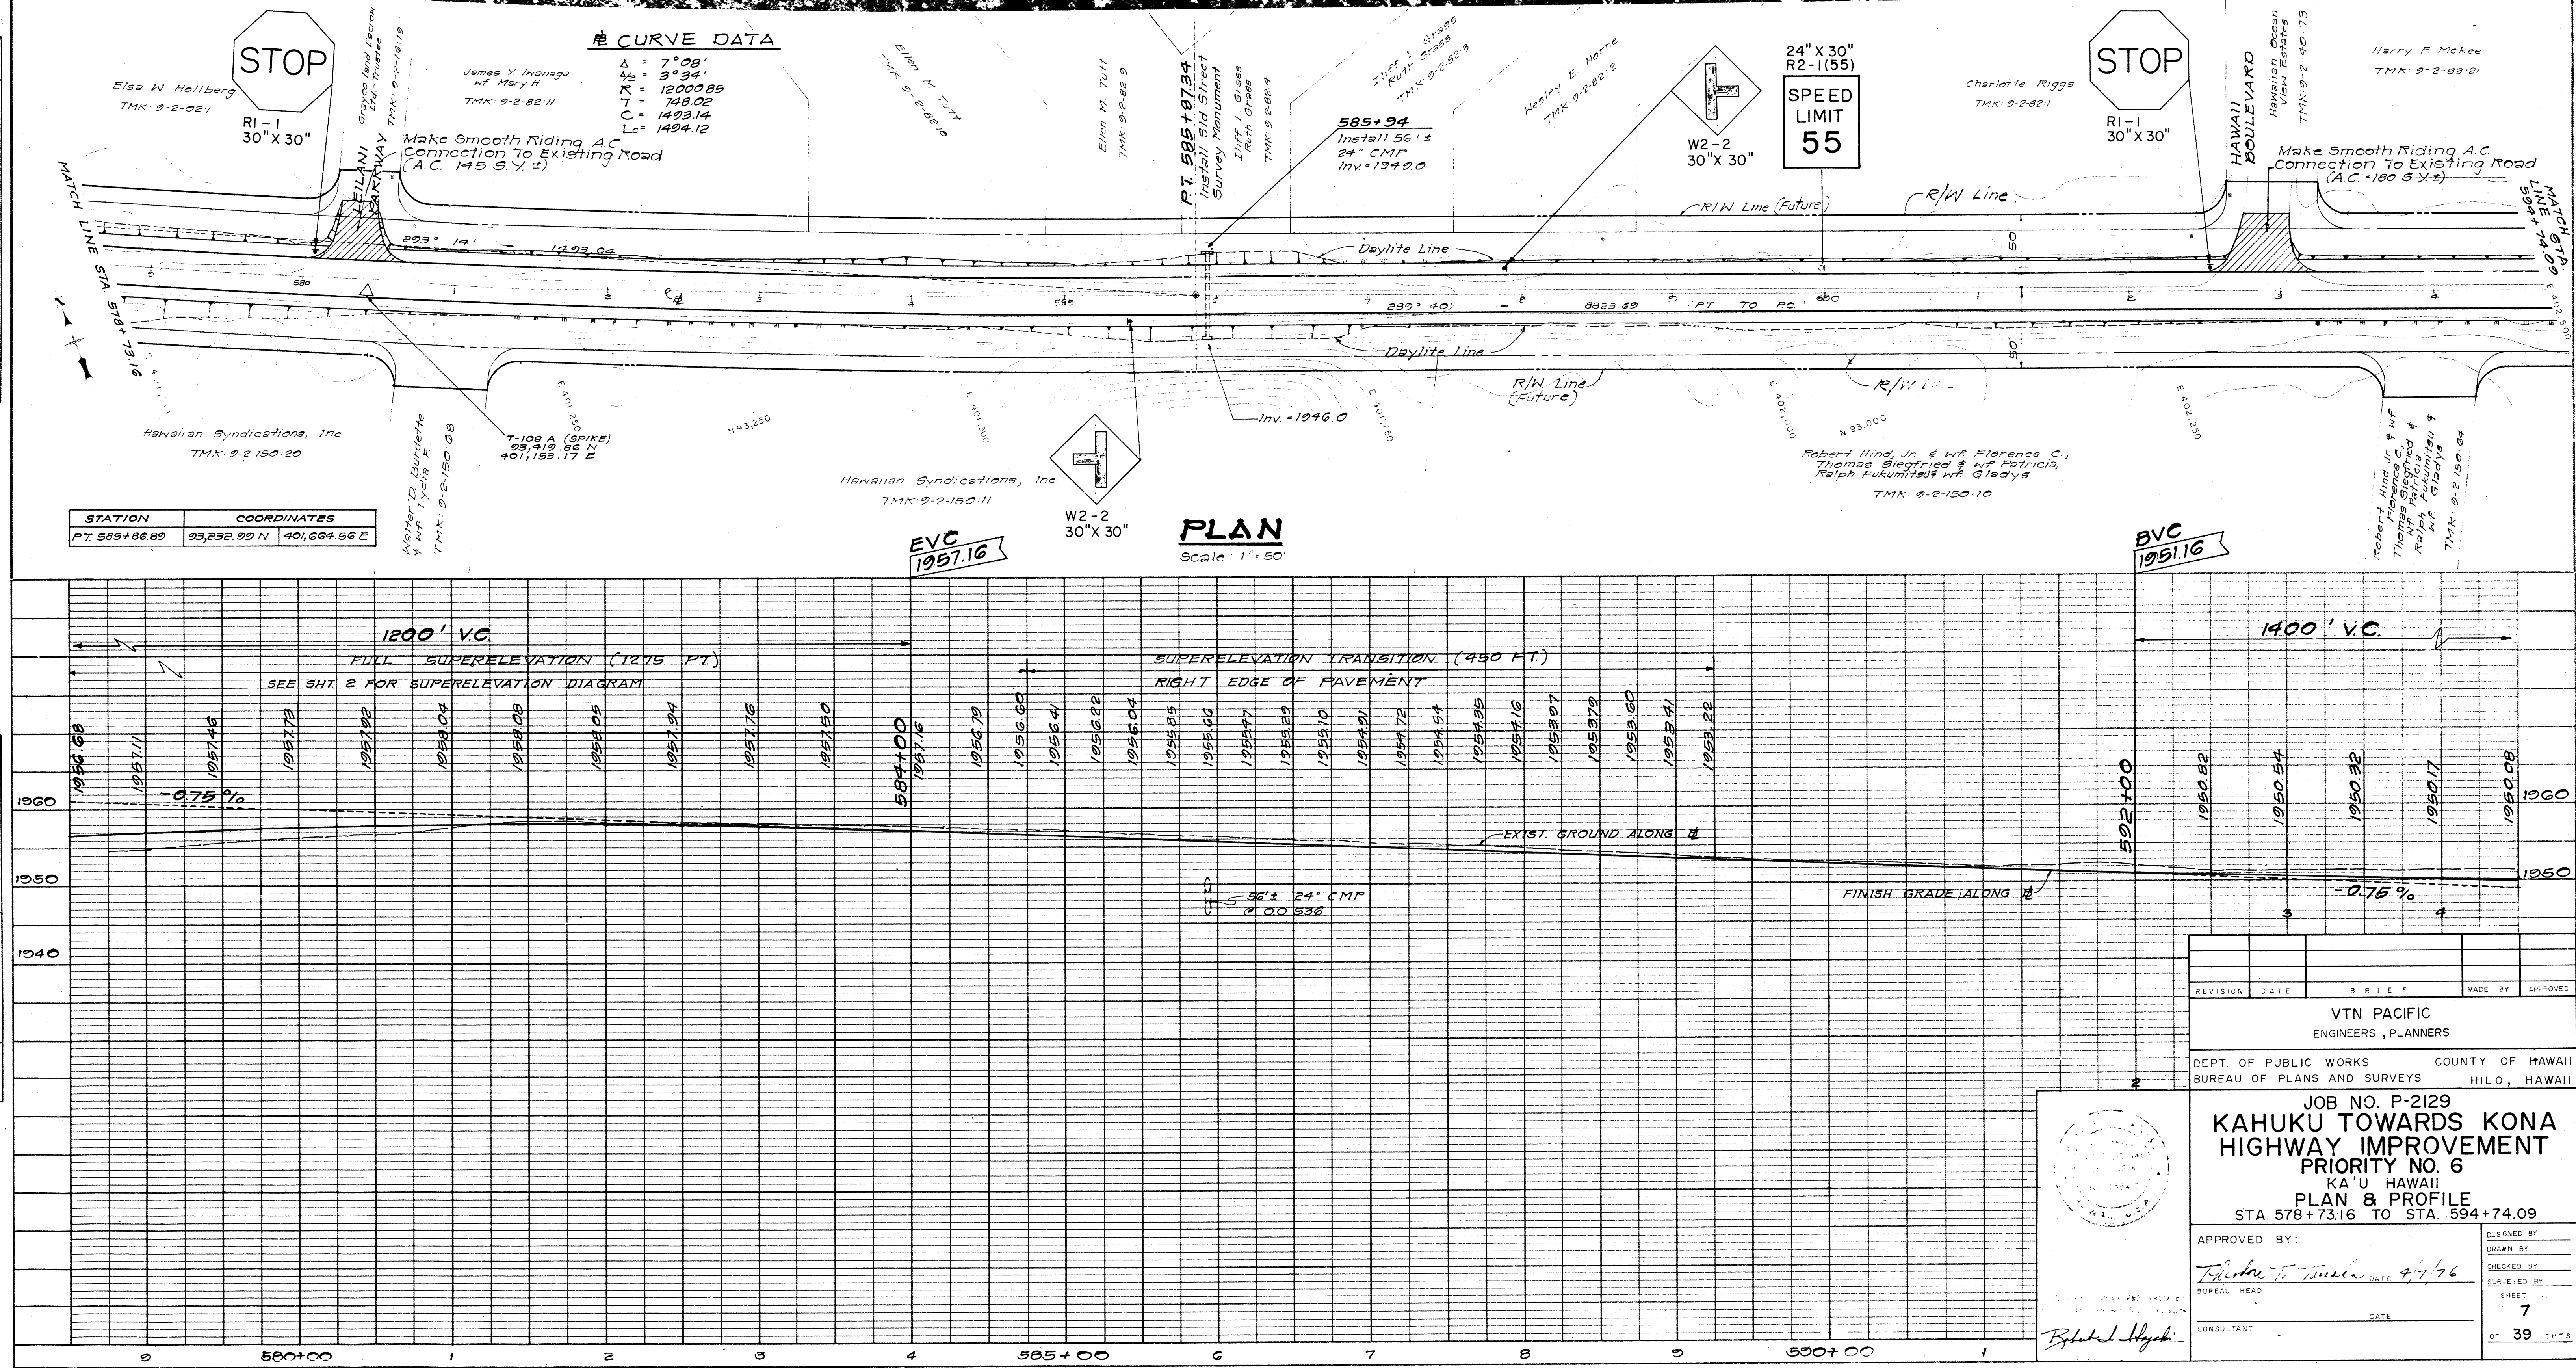

REVISION	DATE	BRIEF	MADE BY	APPROVED
VTN PACIFIC ENGINEERS, PLANNERS				
DEPT. OF PUBLIC WORKS COUNTY OF HAWAII BUREAU OF PLANS AND SURVEYS HILO, HAWAII				
JOB NO. P-2129 KAHUKU TOWARDS KONA HIGHWAY IMPROVEMENT PRIORITY NO. 6 KA'U HAWAII PLAN & PROFILE STA 578+73.16 TO STA. 594+74.09				
APPROVED BY: <i>[Signature]</i> BUREAU HEAD		DESIGNED BY: <i>[Signature]</i> DATE 4/4/76		
CHECKED BY: <i>[Signature]</i>		DRAWN BY: <i>[Signature]</i>		
CONSULTANT		DATE		
		SHEET NO. 7 OF 39		



PROFILE	SURVEYED	BY	DATE
NOTE BOOK	GRADES CHECKED		
NO.	B. M.'S NOTED		
	STRUCTURE NOTATIONS CHK'D.		

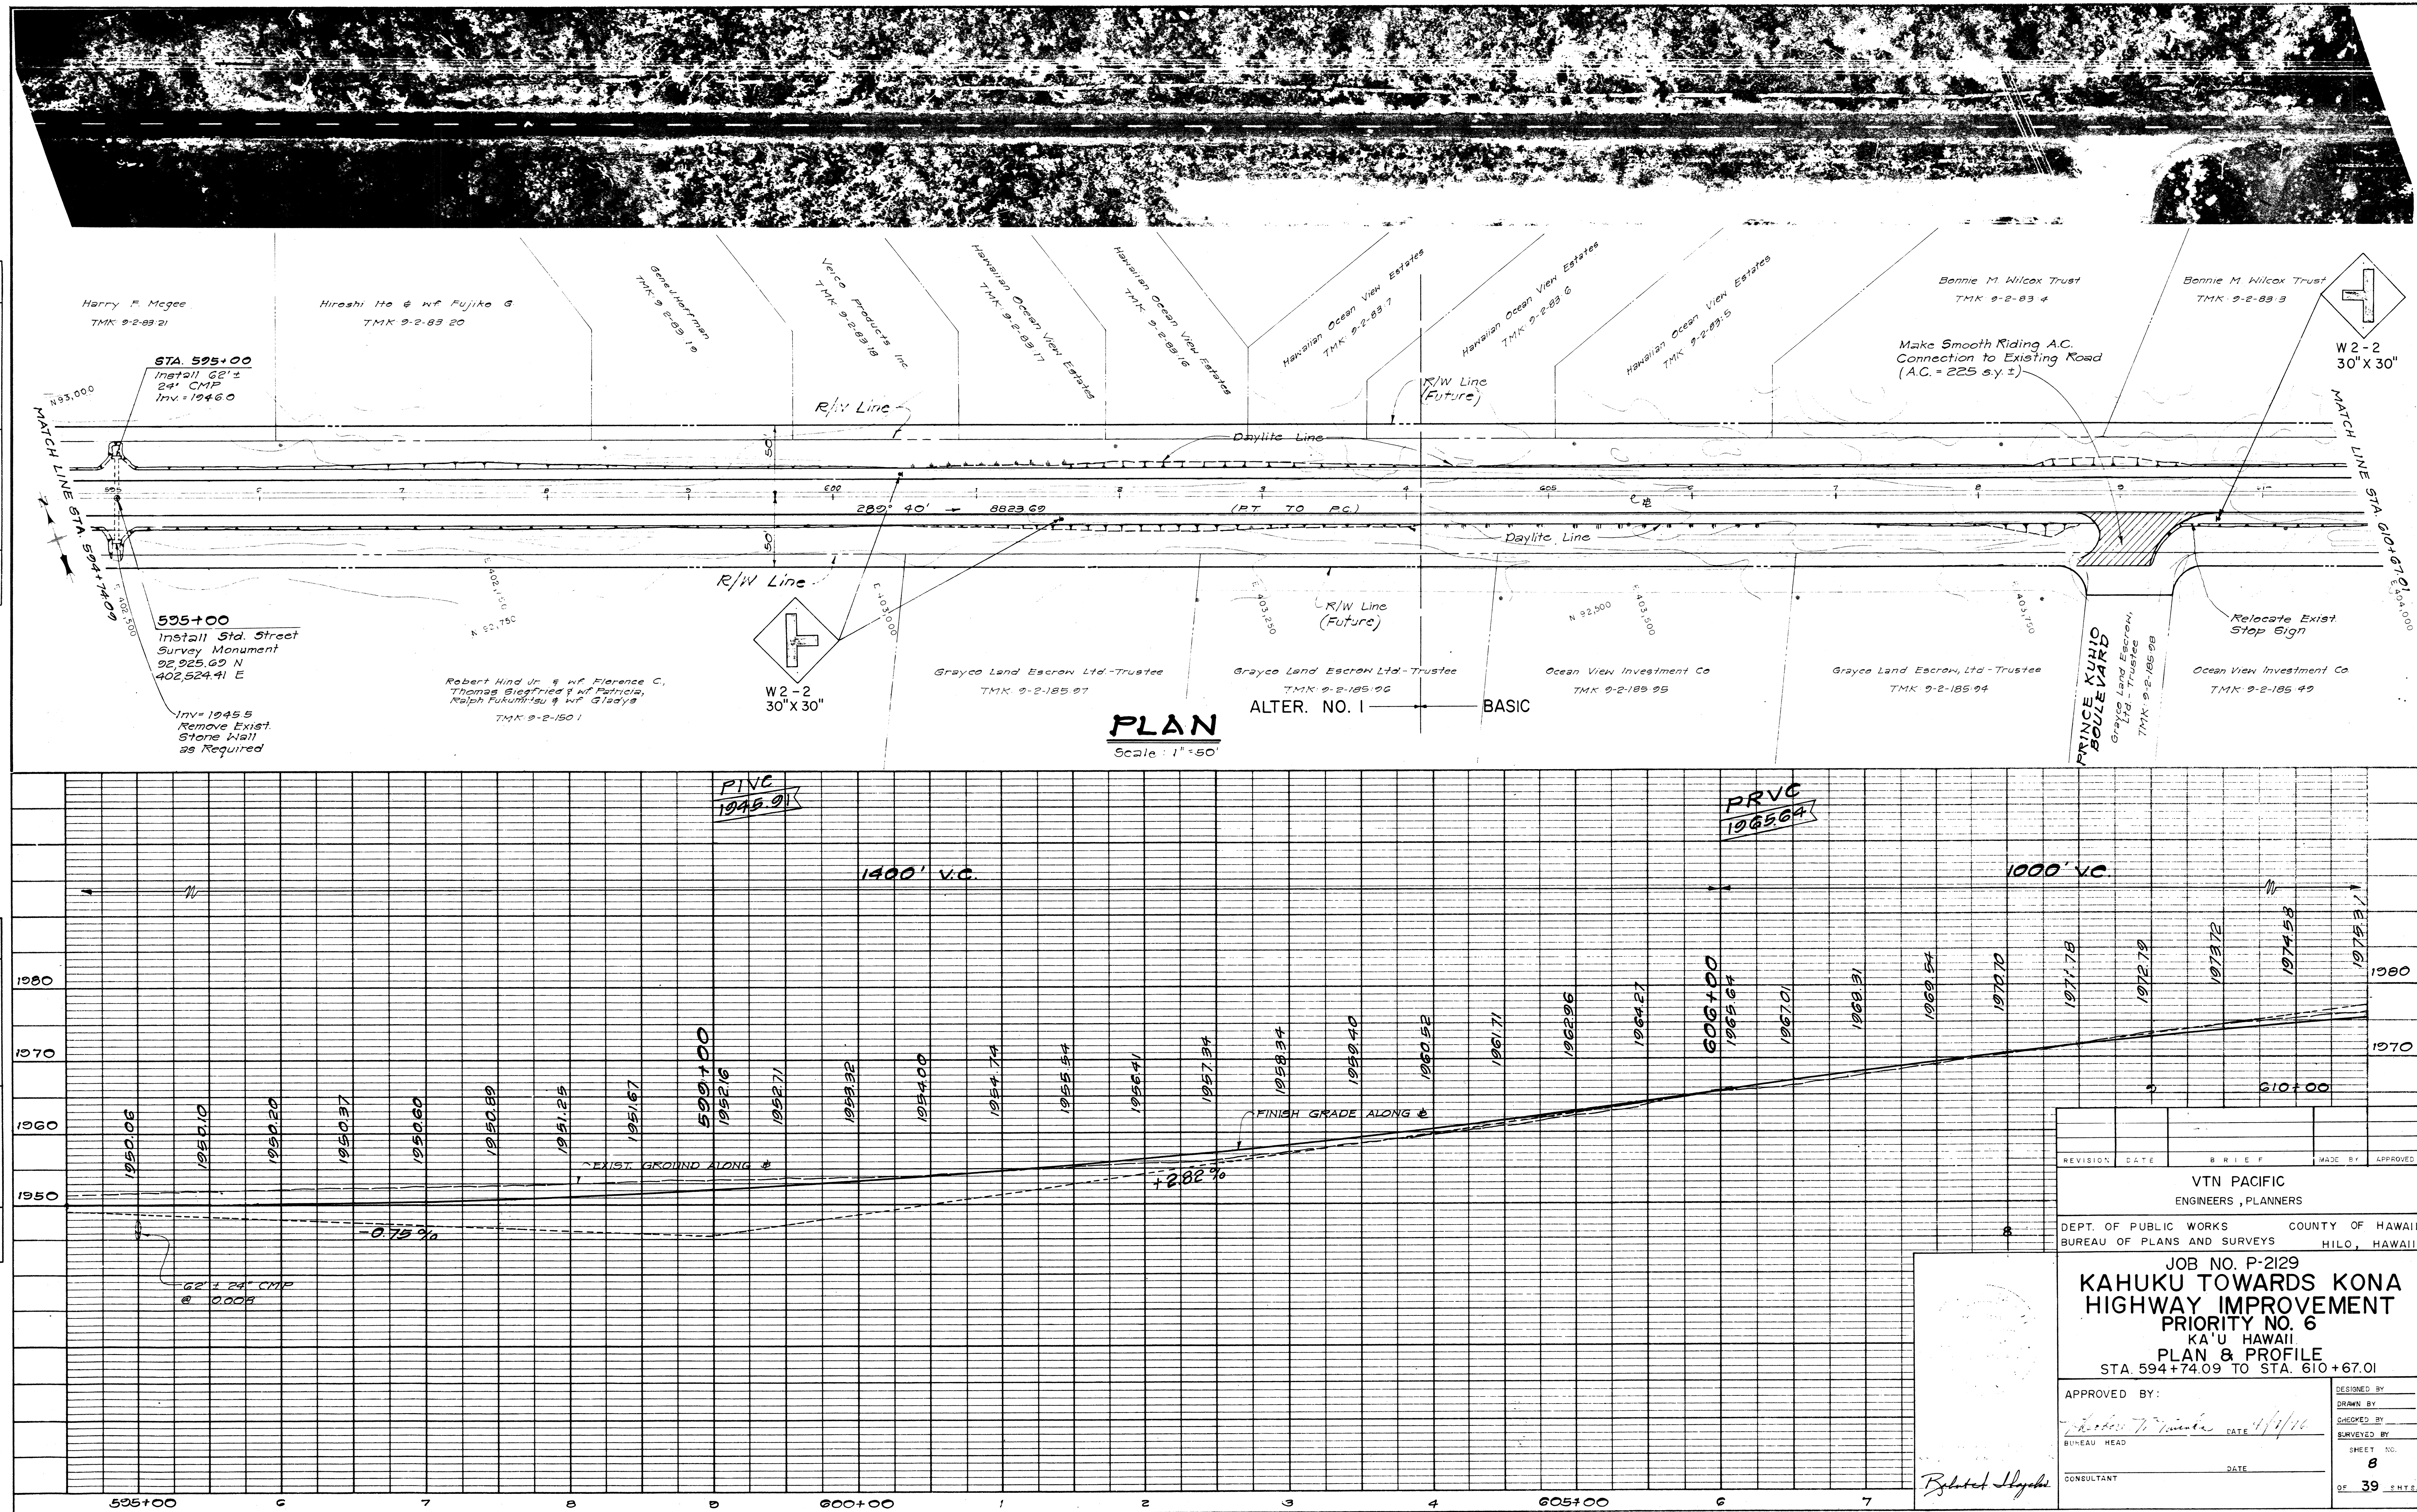

PROFILE	BY	DATE
SURVEYED		
PLOTTED		
GRADES CHECKED		
B. M.'S NOTED		
STRUCTURE NOTATIONS CHECKED		


PLAN	DATE
SURVEYED	BY
PLOTTED	DATE
ALIGNED	DATE
CHECKED	DATE
RT. OF WAY	DATE
NO.	

PROFILE	DATE
SURVEYED	BY
PLOTTED	DATE
GRADES	DATE
CHECKED	DATE
STRUCTURE	DATE
NOTATIONS	DATE
NO.	

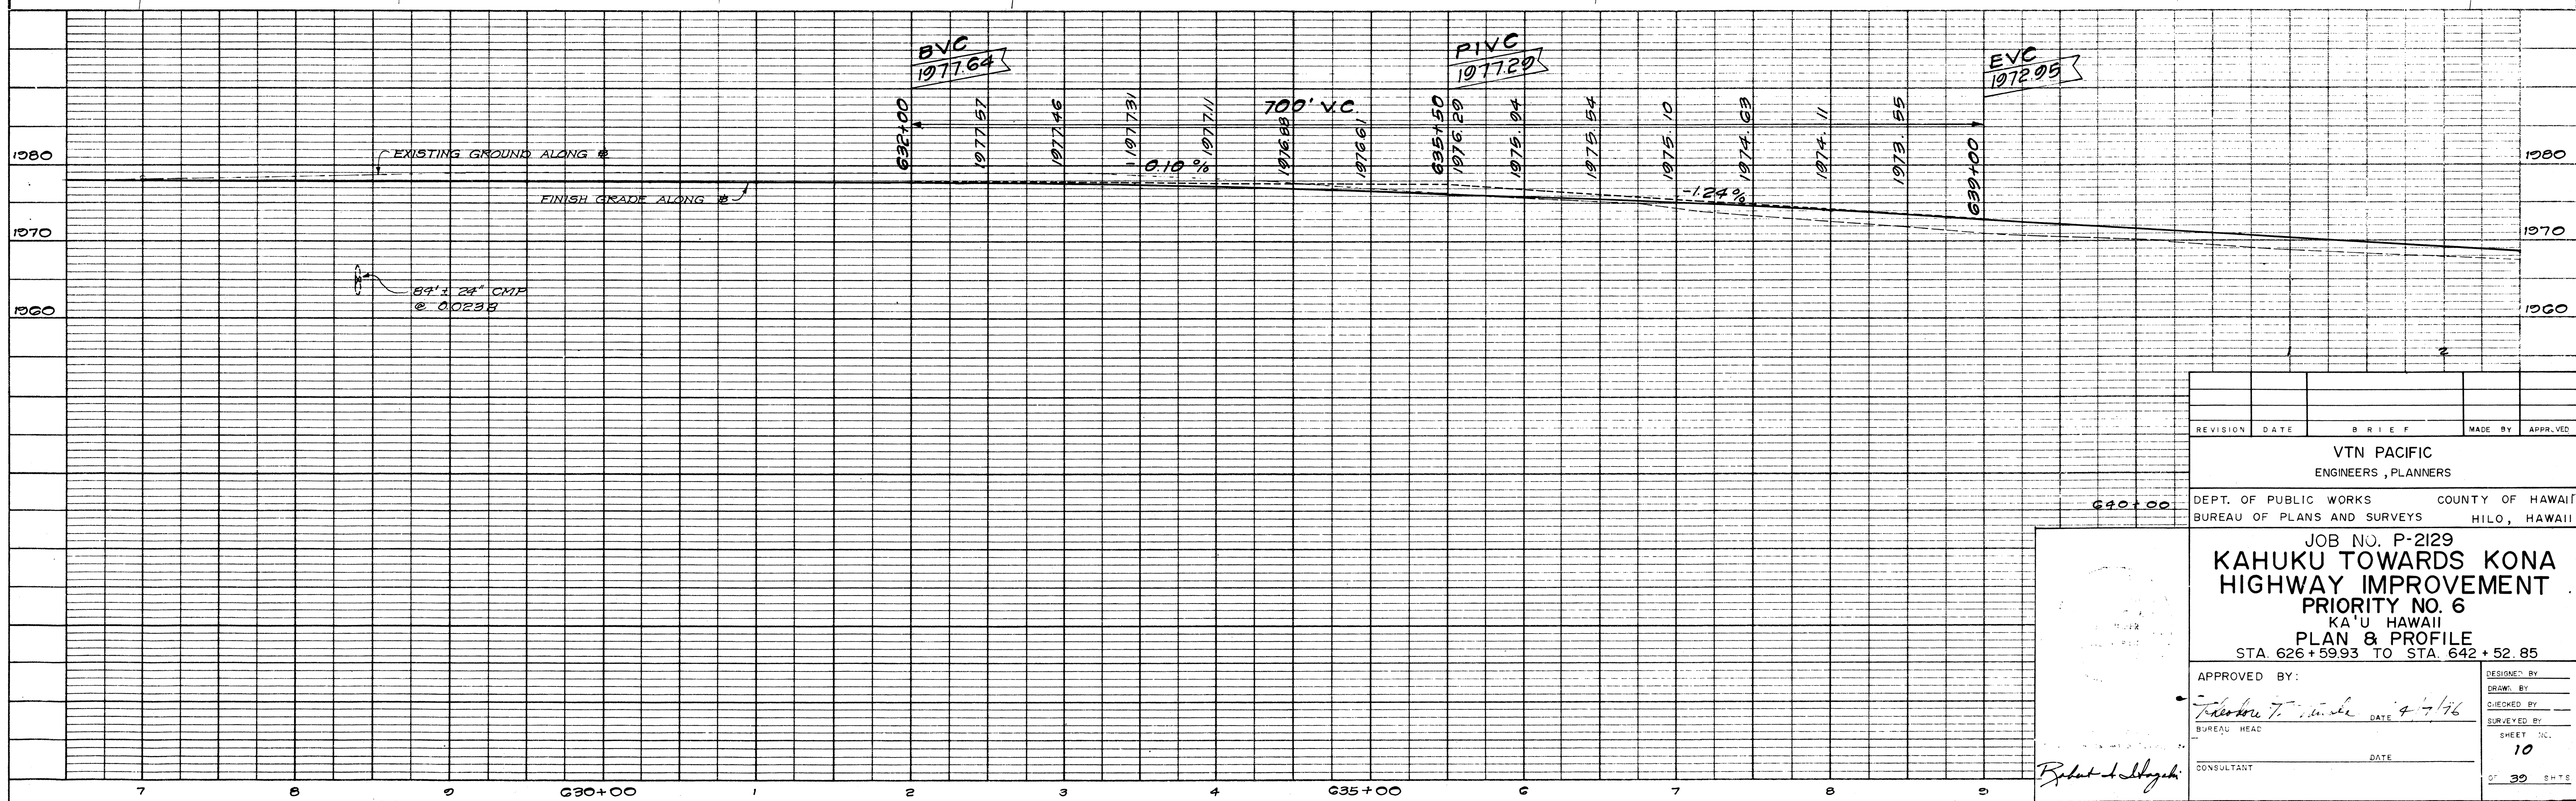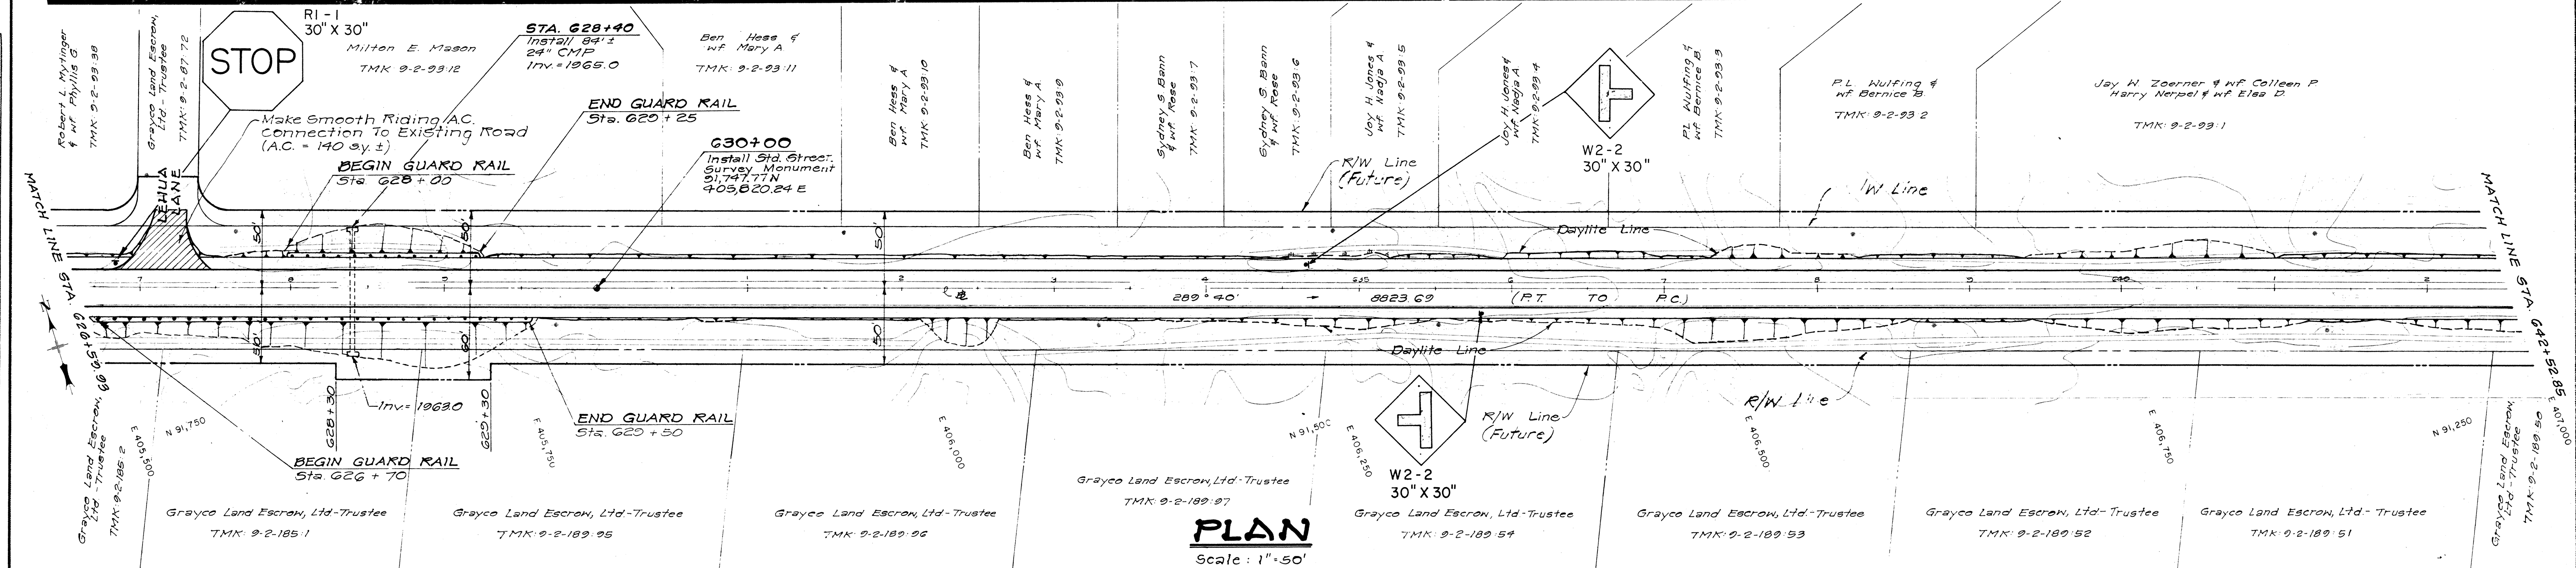


REVISION	DATE	BRIEF	MADE BY	APPROVED
VTN PACIFIC ENGINEERS, PLANNERS				
DEPT. OF PUBLIC WORKS COUNTY OF HAWAII BUREAU OF PLANS AND SURVEYS HILO, HAWAII				
JOB NO. P-2129 KAHUKU TOWARDS KONA HIGHWAY IMPROVEMENT PRIORITY NO. 6 KA'U HAWAII PLAN & PROFILE STA. 626+5993 TO STA. 642+52.85				
APPROVED BY:	DESIGNED BY:	CHECKED BY:	SURVEYED BY:	SHEET NO.
<i>Robert L. Schlegel</i>	<i>Robert L. Schlegel</i>	<i>Robert L. Schlegel</i>	<i>Robert L. Schlegel</i>	10
BUREAU HEAD	DATE	DATE	DATE	DATE
CONSULTANT				



PLAN	SURVEYED	DATE
	NOTE BOOK	BY
	ALIGNED CHECKED	
	RT. OF WAY CHECKED	


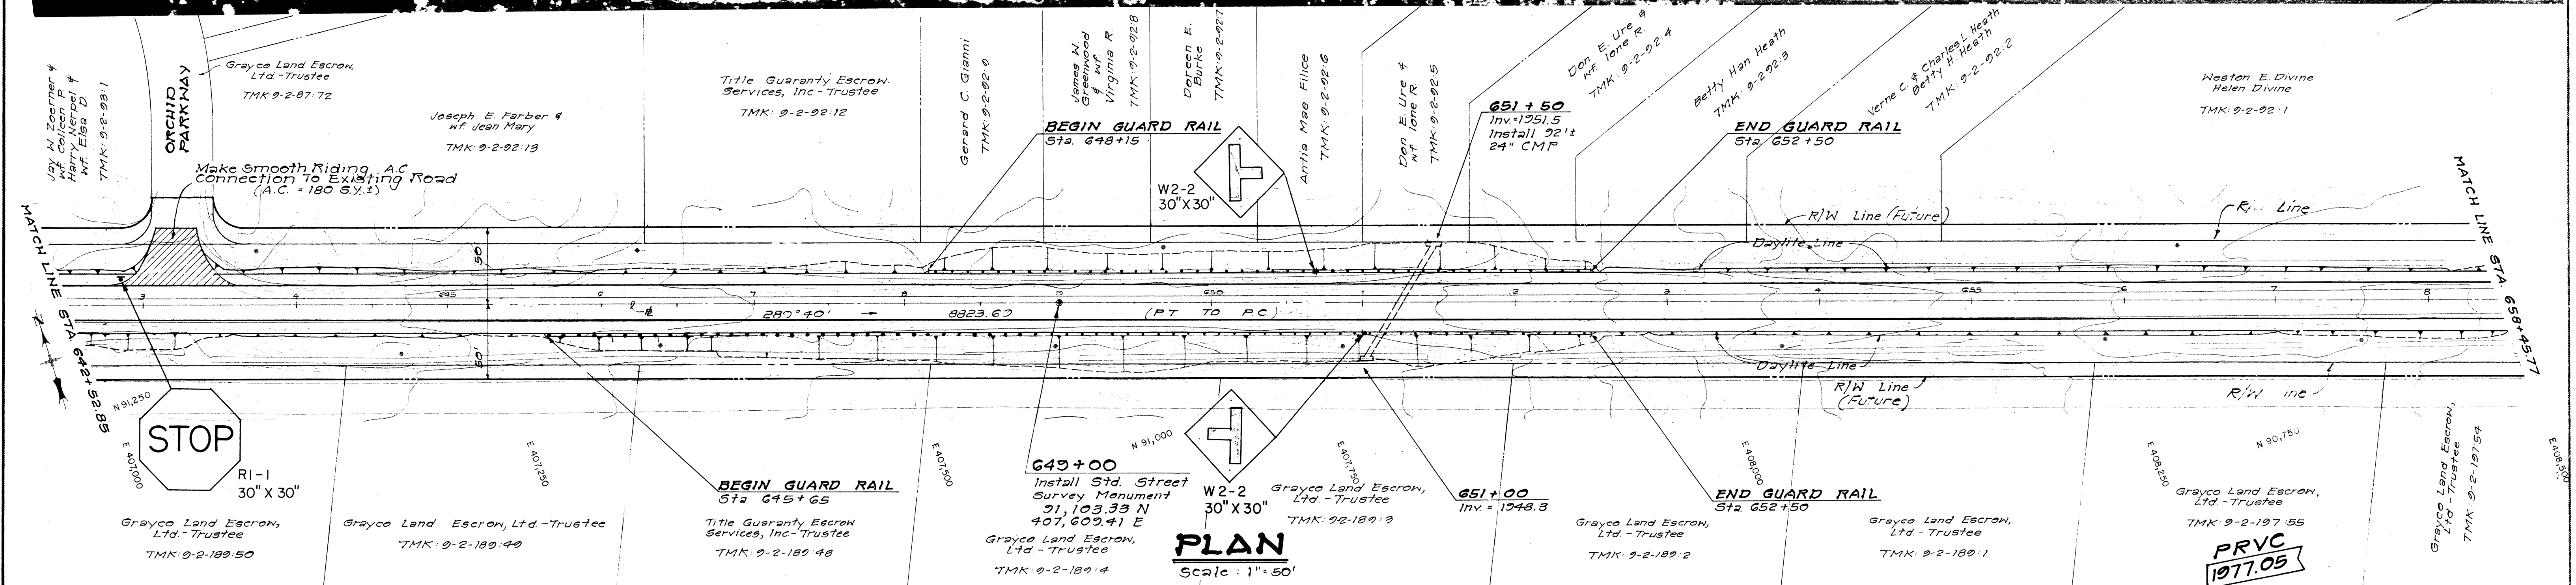


PROFILE	SURVEYED	DATE
	NOTE BOOK	BY
	GRADES CHECKED	
	STRUCTURE NOTATIONS CKD.	

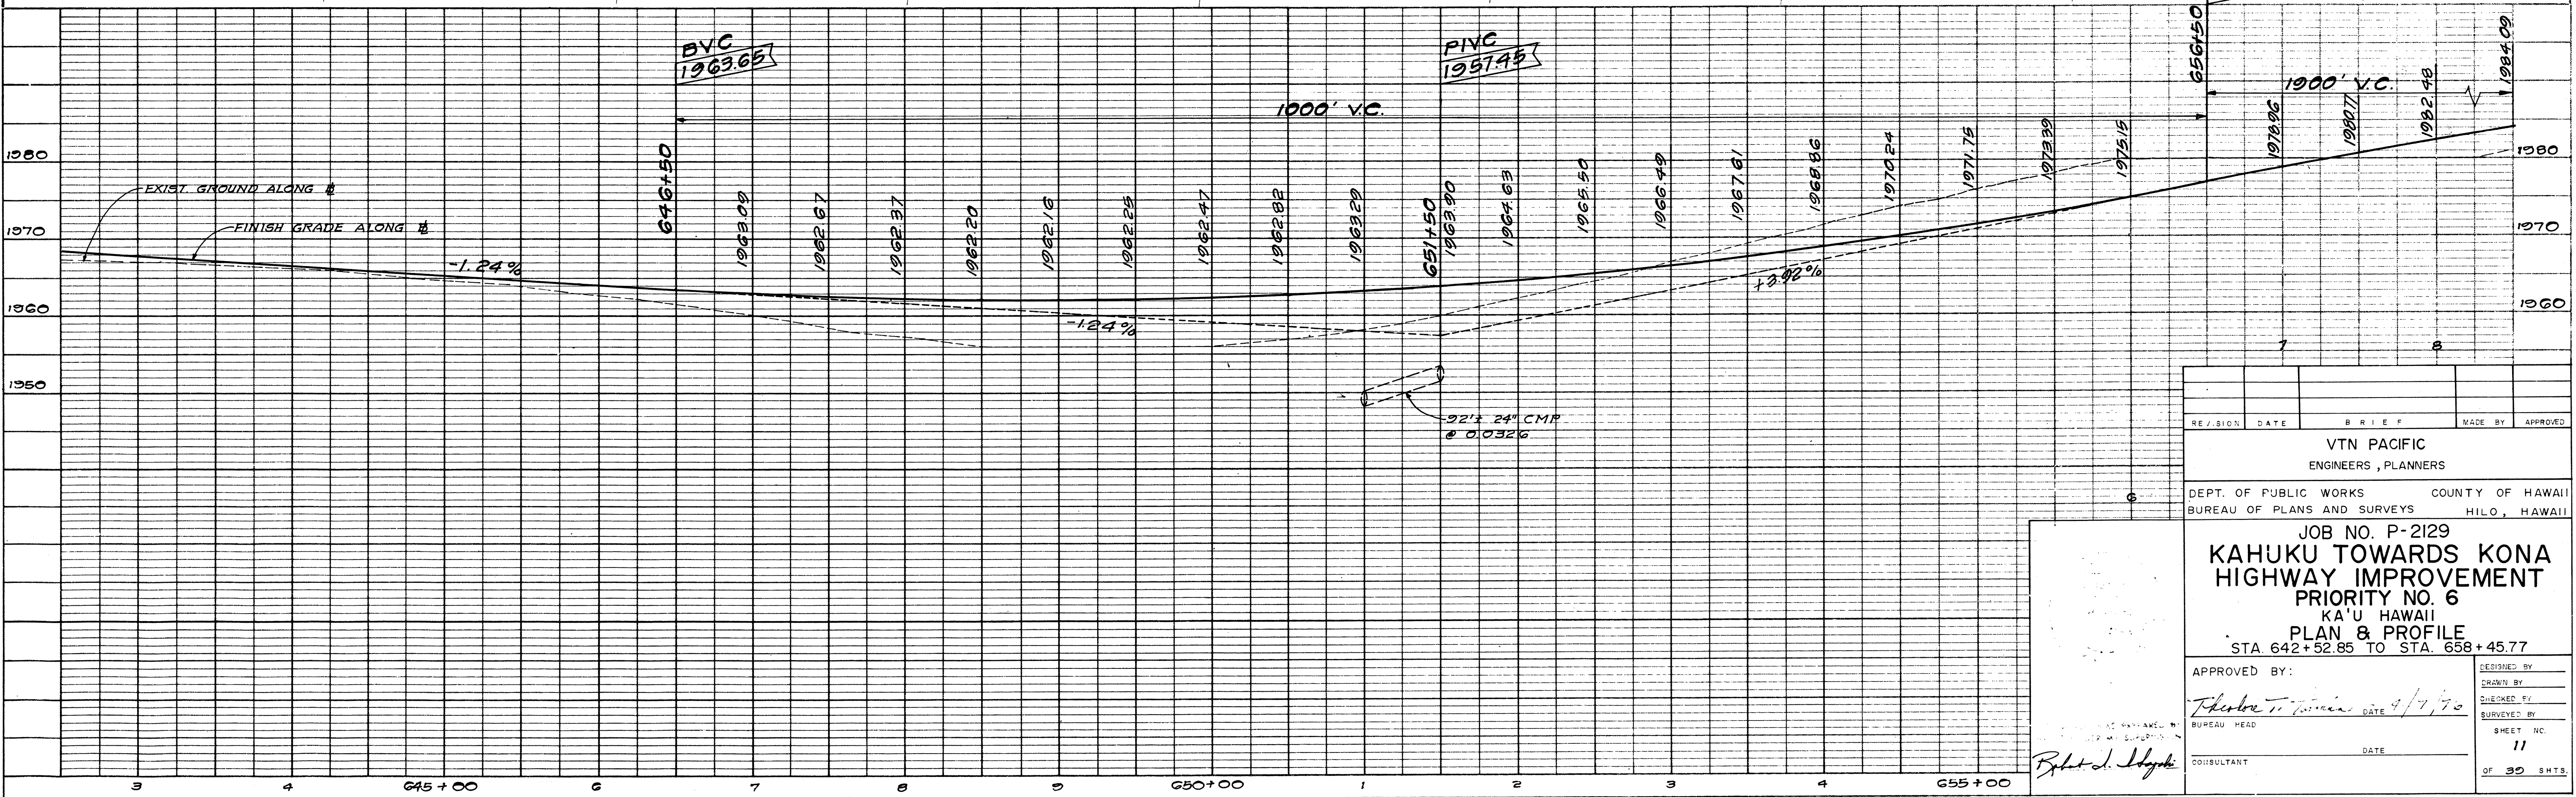

REVISION	DATE	BRIEF	MADE BY	APPROVED
VTN PACIFIC ENGINEERS, PLANNERS				
DEPT. OF PUBLIC WORKS COUNTY OF HAWAII BUREAU OF PLANS AND SURVEYS HILO, HAWAII				
JOB NO. P-2129 KAHUKU TOWARDS KONA HIGHWAY IMPROVEMENT PRIORITY NO. 6 KA'U HAWAII PLAN & PROFILE STA. 642+52.85 TO STA. 658+45.77				
APPROVED BY:		DESIGNED BY:		
CHECKED BY:		DRAWN BY:		
SURVEYED BY:		DATE: 4/1/70		
BUREAU HEAD		SHEET NO. 11		
CONSULTANT		DATE		

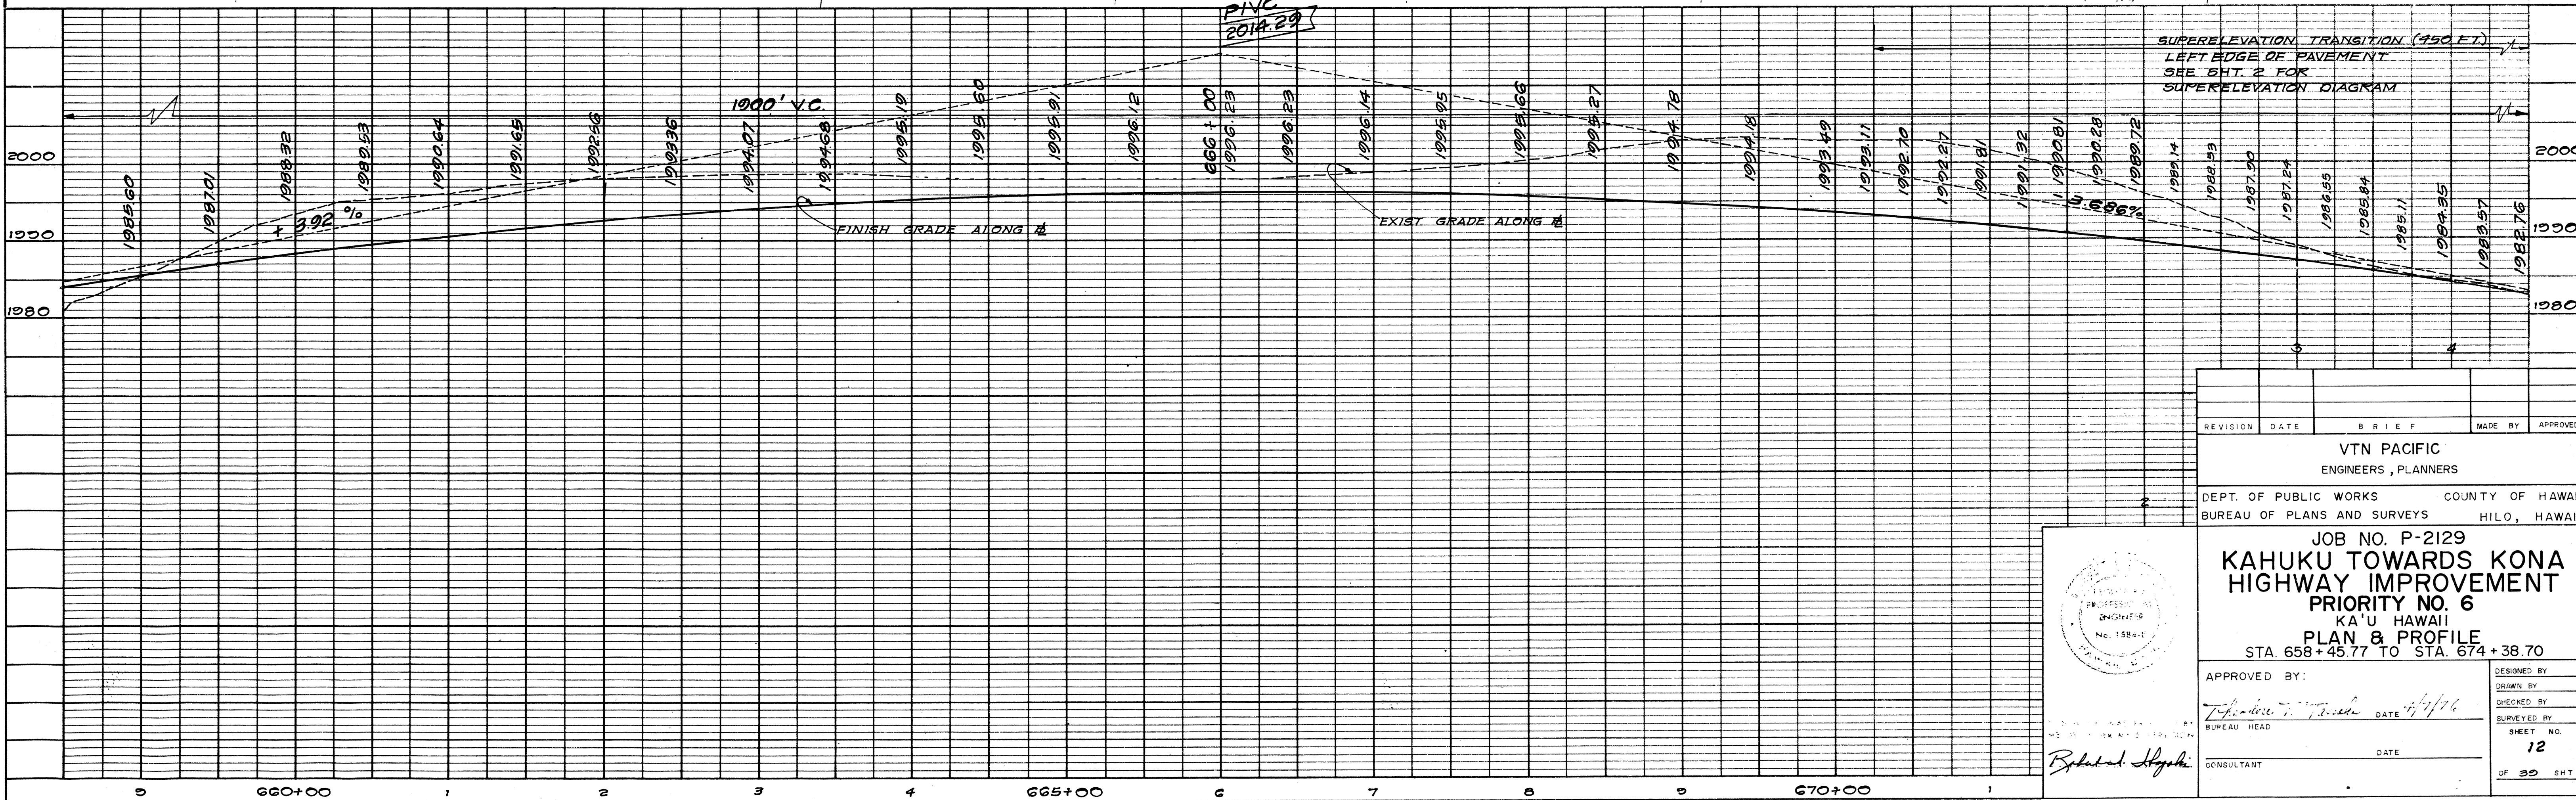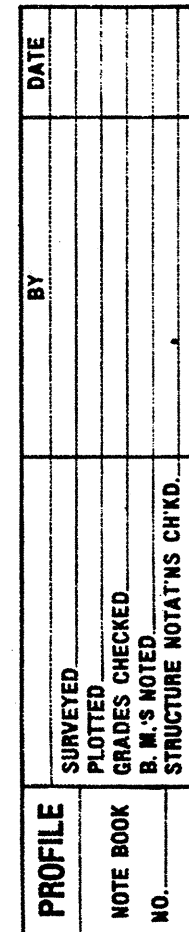

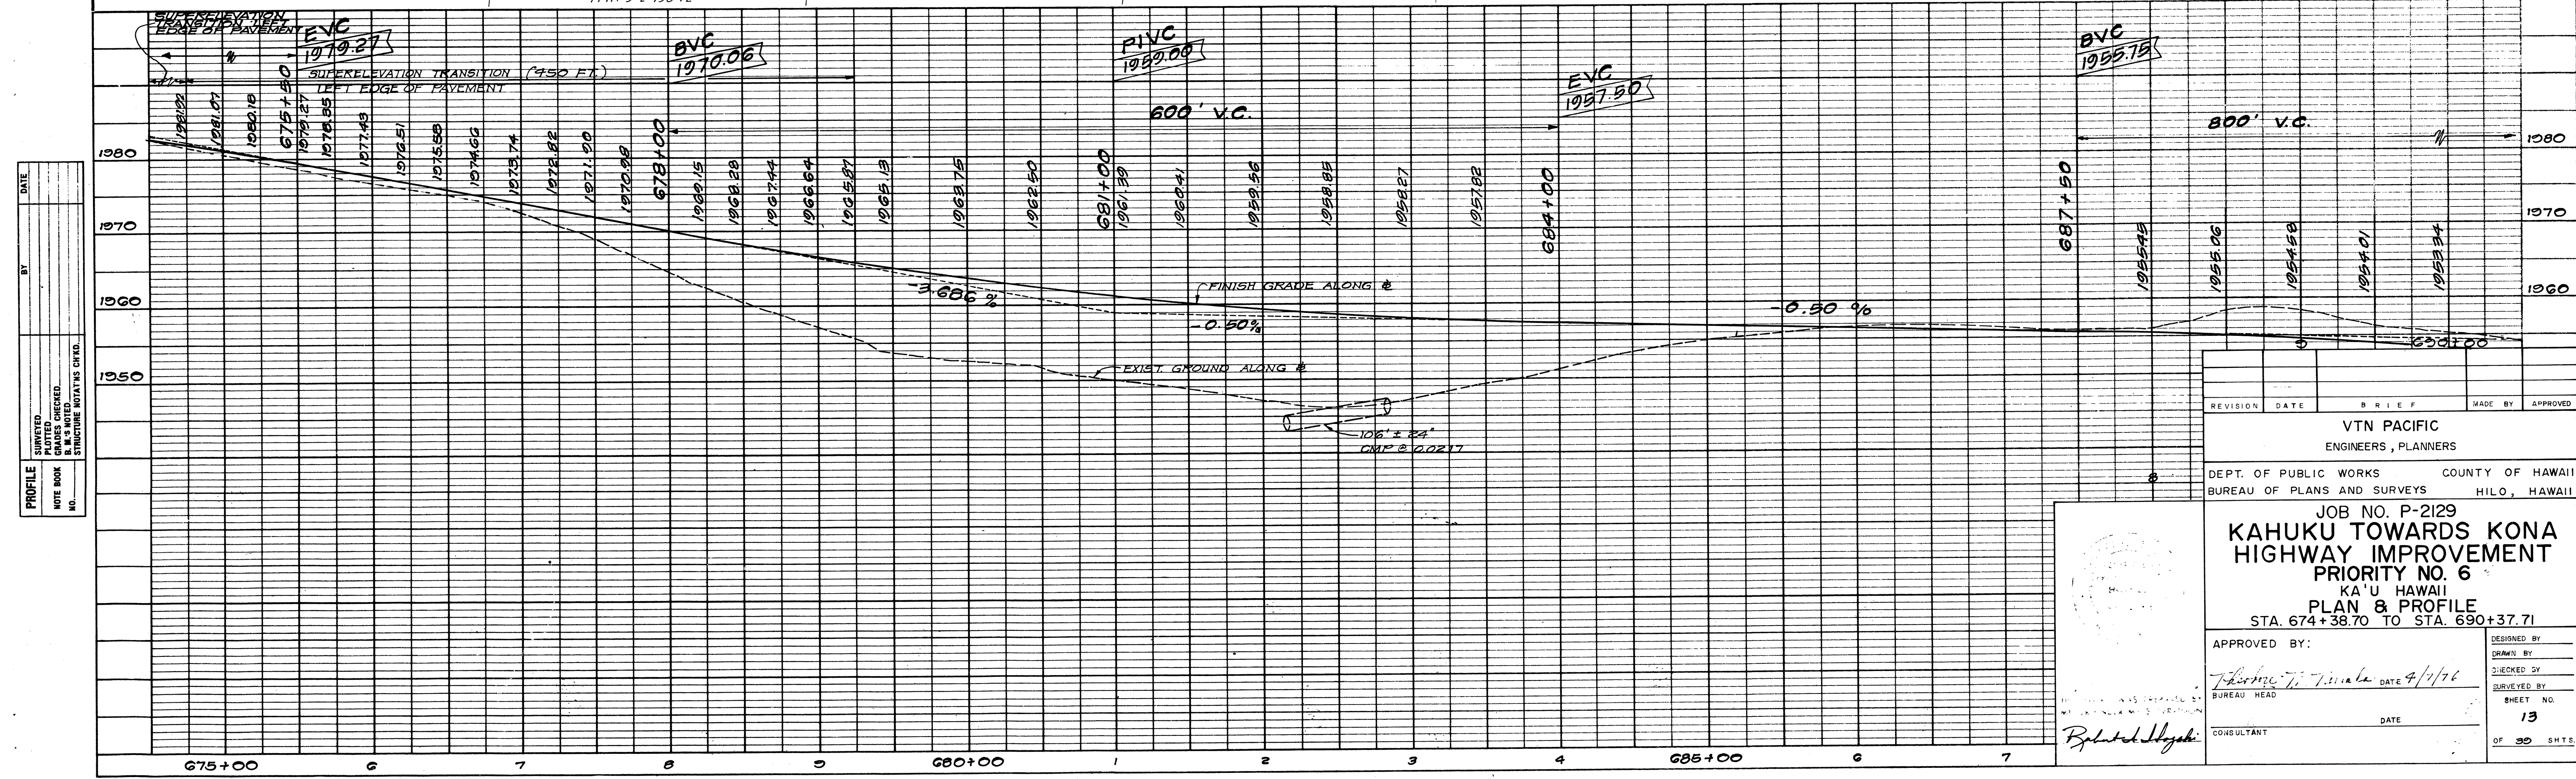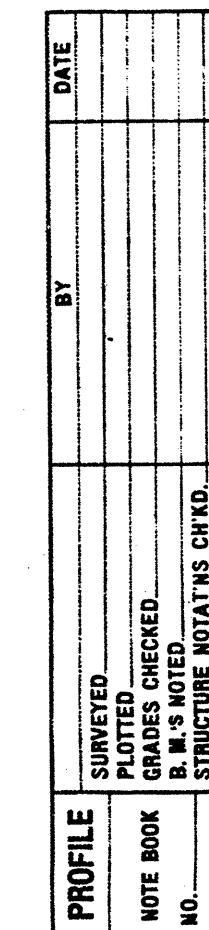

PROFILE	SURVEYED _____	BY _____	DATE _____
NOTE BOOK	PLOTTED _____		
	GRADES CHECKED _____		
	B. M.'S NOTED _____		
NO. _____	STRUCTURE NOTATIONS CHK'D.		