

237

238

239

240+00

241

242

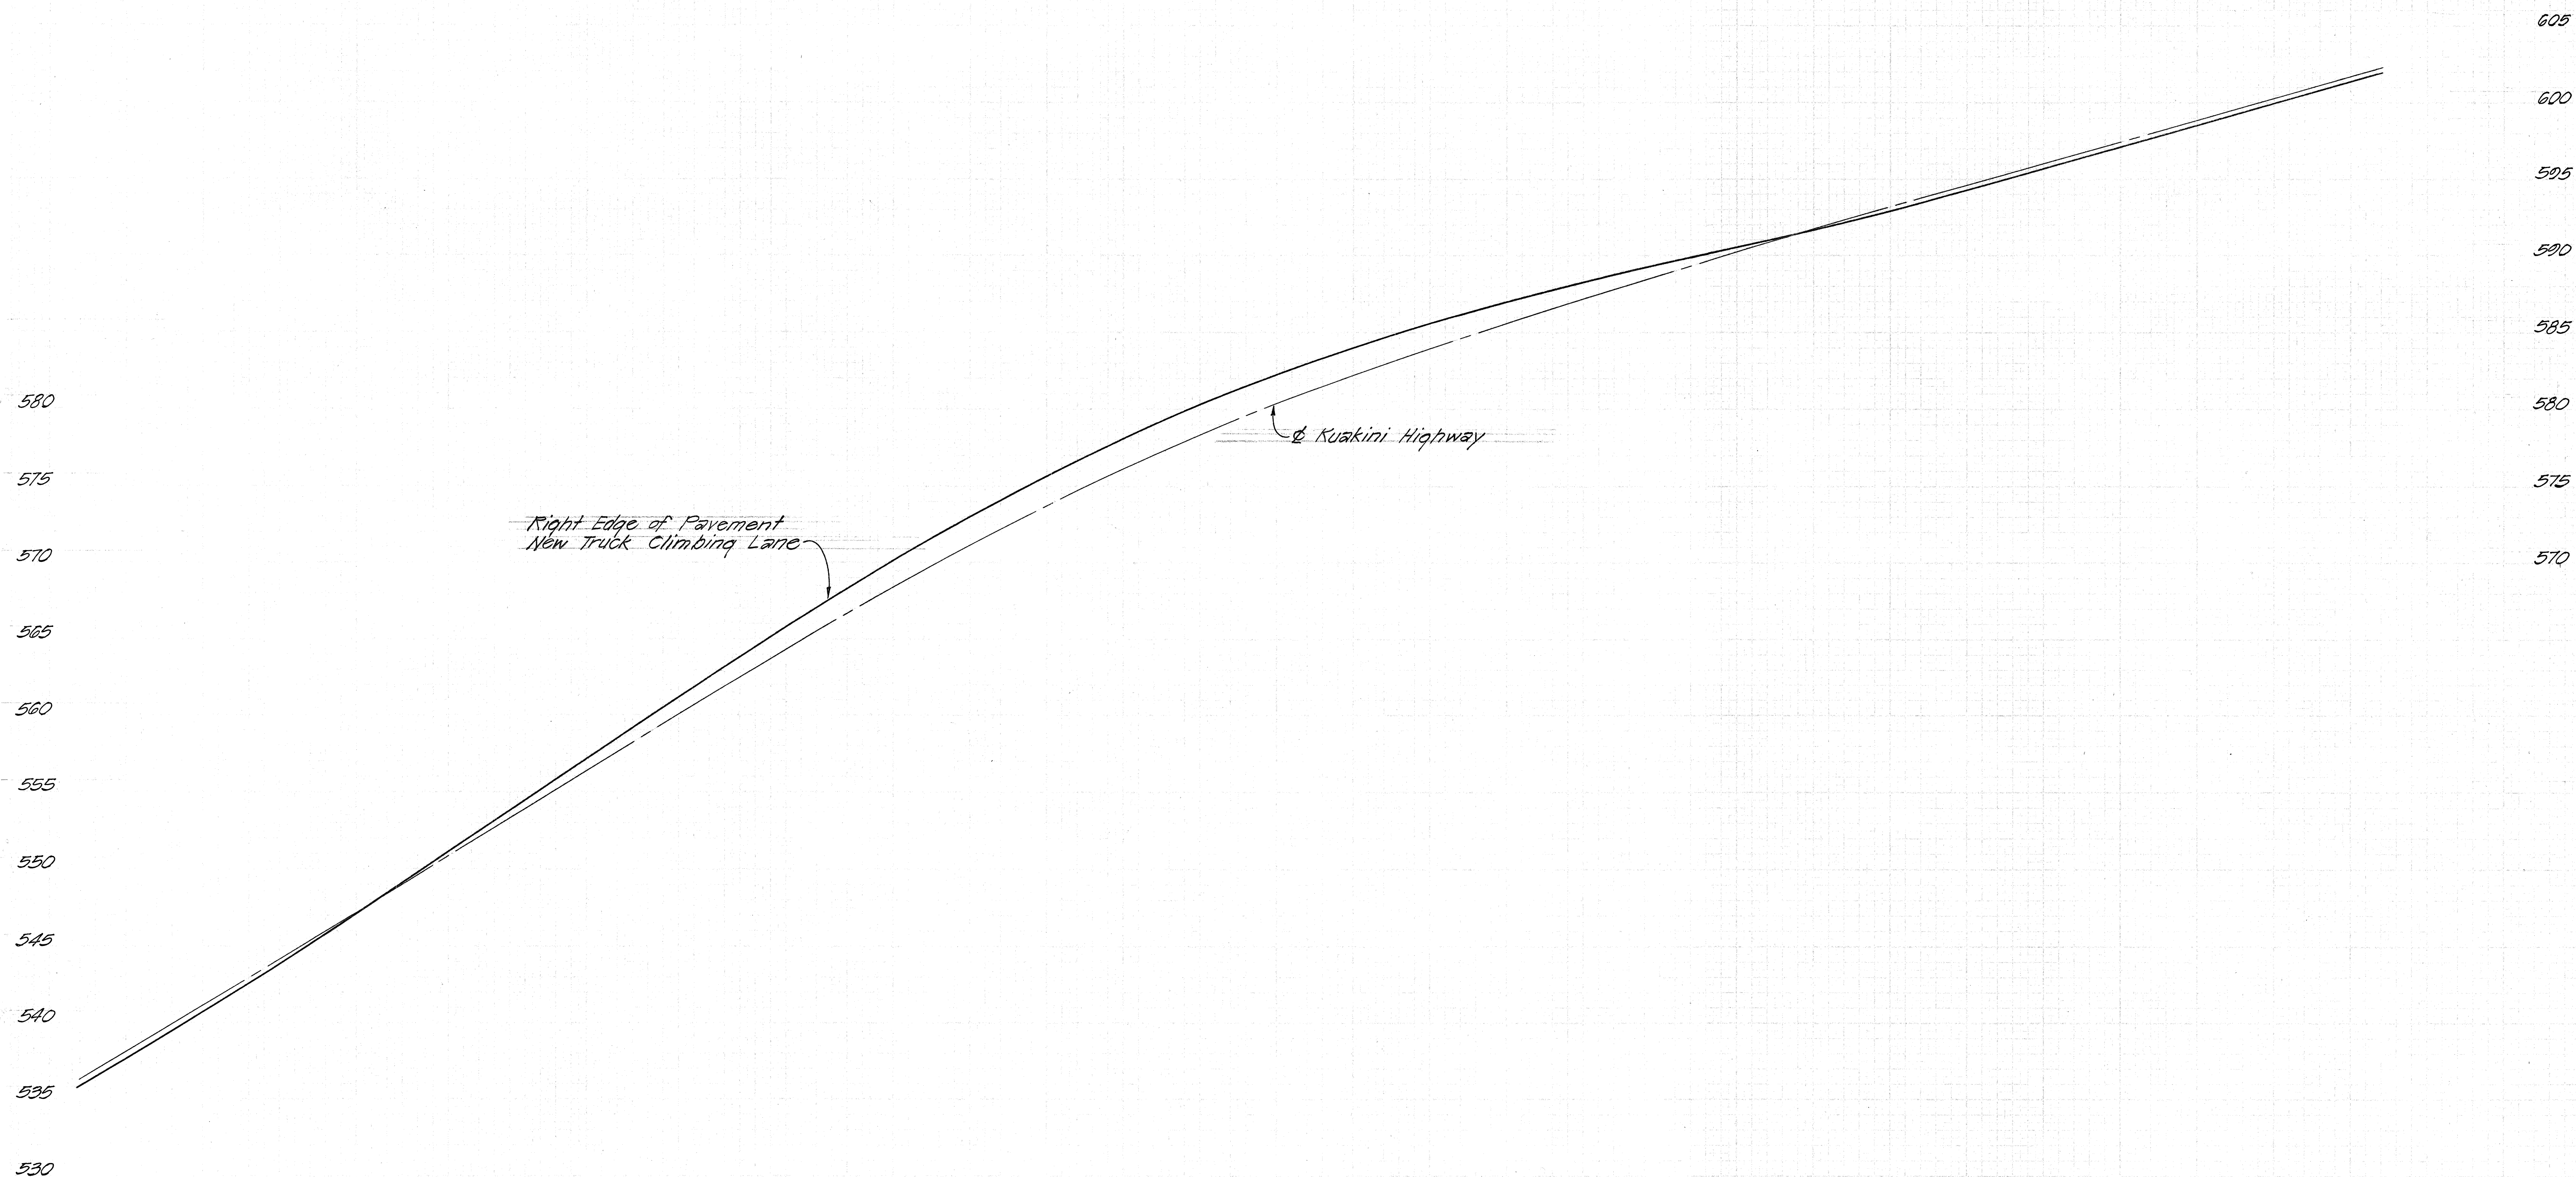
243

244

FED. ROAD DIST. NO.	STATE	PROJ. NO.	FISCAL YEAR	SHEET NO.	TOTAL SHEETS
HAWAII	HAW.	11A-01-75	1978	14	65

245+00

246

SUPERELEVATION DIAGRAM (STA. 232+00 TO STA. 246+00)Scale: Horiz. 1" = 50'
Vert. 1" = 5'

STATE OF HAWAII DEPARTMENT OF TRANSPORTATION LAND TRANSPORTATION FACILITIES DIVISION	
<u>SUPERELEVATION DIAGRAM</u> <u>(STA. 232+00 TO STA. 246+00)</u>	
<u>KUAKINI HIGHWAY</u> <u>Truck Climbing Lanes, North Kona</u> <u>Proj. No. 11A-01-75</u>	
Scale: As Shown	Date: June 1977
SHEET No. 1 OF 1 SHEETS	