


FED. ROAD DIST. NO.	STATE	PROJ. NO.	FISCAL YEAR	SHEET NO.	TOTAL SHEETS
HAWAII	HAW.	11D-01-82M	1982	2	5

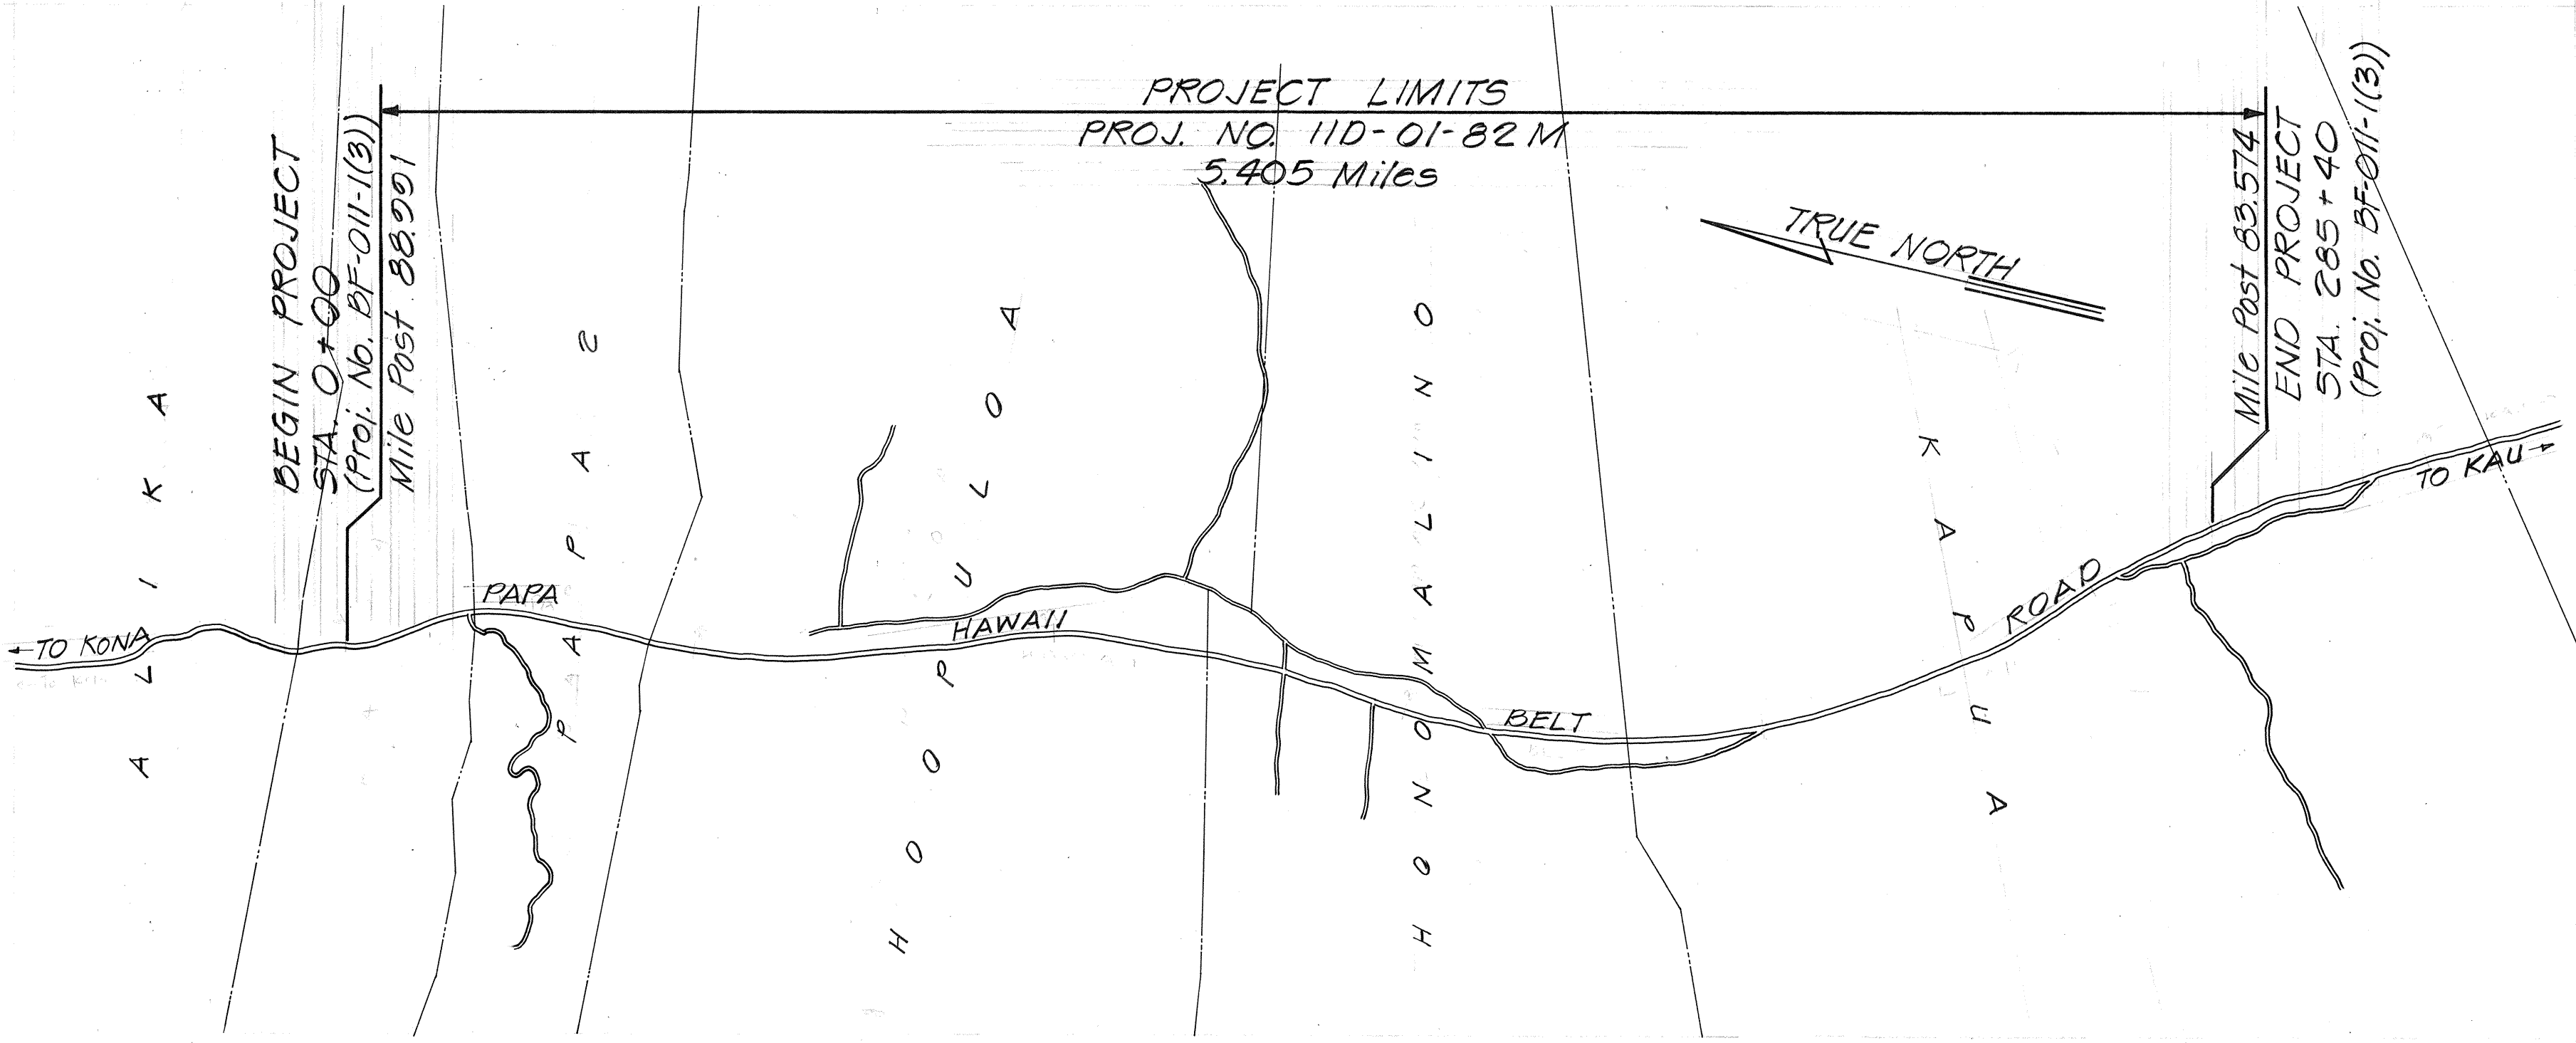

HAWAII BELT ROAD
 PROJ. NO. 11D-01-82M
 Scale: 1" = 2000'

PAVEMENT MARKER SCHEDULE					
STATION		DESCRIPTION	TYPE		
FROM	TO		D	H	J
Proj. No. BF-011-1(3)					
0+00	4+ 50 ³⁰	No Passing - Both Sides	24 ²³		
4+ 50 ³⁰	5+00	Open Milolii Interchange	4		
5+00	9+55 ⁹⁺¹⁰	No Passing - Both Sides	16 ²¹		
9+10 ⁹⁺¹⁰	18+30 ¹⁸⁺³⁰	No Passing L Passing R	23 ²³	23 ²³	168 ⁹²
18+30 ¹⁸⁺³⁰	36+00 ³⁶⁺⁰⁰	Passing Both Sides	43 ⁴²		168 ¹⁶⁴
36+00 ³⁶⁺⁰⁰	44+ 50 ⁵⁰	Passing L No Passing R	23 ²³	23 ²³	92 ⁸⁴
44+ 50 ⁵⁰	47+ 50 ⁵⁰	No Passing Both Sides	16 ¹⁷		
47+ 50 ⁵⁰	55+00 ⁵⁵⁺⁰⁰	No Passing L Passing R	21 ²³	23 ²³	92 ⁹²
55+00 ⁵⁵⁺⁰⁰	63+25 ⁶³⁺²⁵	Passing Both Sides	21 ¹⁴		84 ⁵²
63+25 ⁶³⁺²⁵	71+ 50 ⁵⁰	Passing L No Passing R	23 ²⁴	21 ²⁴	92 ⁸⁸
71+ 50 ⁵⁰	74+50 ⁷⁴⁺⁵⁰	No Passing Both Sides	16 ¹⁵		
74+50 ⁷⁴⁺⁵⁰	83+50 ⁸³⁺⁵⁰	No Passing L Passing R	23 ²³	23	92
83+50 ⁸³⁺⁵⁰	90+00 ⁹⁰⁺⁰⁰	Passing Both Sides	17 ¹⁷		68 ⁶⁸
90+00 ⁹⁰⁺⁰⁰	97+ 50 ⁵⁰	Passing L No Passing R	23 ²³	23 ²³	92 ⁷⁶
97+50 ⁹⁷⁺⁵⁰	107+50 ¹⁰⁷⁺⁵⁰	No Passing Both Sides	6 ⁶		
107+50 ¹⁰⁷⁺⁵⁰	122+15 ¹²²⁺¹⁵	No Passing L Passing R	23	23	92
122+15 ¹²²⁺¹⁵	130+50 ¹³⁰⁺⁵⁰	Passing Both Sides	42 ⁴²		168 ¹⁶⁴
130+50 ¹³⁰⁺⁵⁰	138+15 ¹³⁸⁺¹⁵	Passing L No Passing R	23 ²³	21 ²¹	92 ⁸⁴
138+15 ¹³⁸⁺¹⁵	130+ 50 ⁵⁰	No Passing Both Sides	5		
130+ 50 ⁵⁰	138+15 ¹³⁸⁺¹⁵	No Passing L Passing R	23 ²¹	23 ²³	92 ⁸⁸
138+15 ¹³⁸⁺¹⁵	285+40	Passing Both Sides	362 ³⁶²		1476 ¹⁴⁷⁶
TOTALS			768	194	8740
			771	208	2656

RECOVER & MONUMENTS

PROJ. NO. (EXIST.)	STATION
BF-011-1(3)	0 + 00
"	P.C. 3 + 45.87
"	P.T. 12 + 53.44
"	P.C. 33 + 64.02
"	P.O.C. 43 + 00
"	P.O.C. 49 + 00
"	P.T. 61 + 56.55
"	P.O.T. 73 + 00
"	P.C. 80 + 83.73
"	P.O.C. 93 + 00
"	P.O.C. 100 + 00
"	P.T. 111 + 13.62
"	P.O.T. 125 + 00
"	P.O.T. 131 + 00
"	P.C. 144 + 91.87
"	P.O.C. 158 + 00
"	P.O.C. 170 + 00
"	P.O.C. 182 + 00
"	P.O.C. 195 + 00
"	P.O.C. 210 + 00
"	P.O.C. 220 + 00
"	P.O.C. 230 + 00
"	P.T. 241 + 67.98
"	P.C. 249 + 84.41 EQ.
"	P.O.C. 261 + 00
"	P.O.C. 272 + 00
"	P.T. 282 + 83.50

TOTAL 27 EA.

STATE OF HAWAII

DEPARTMENT OF TRANSPORTATION

HIGHWAYS DIVISION

GENERAL LOCATION PLAN

HAWAII BELT RD. RESURFACING

PAPA TOWARDS KAHUKU

PROJ. NO. 11D-01-82M

Scale: As Shown

Date: July 1981

SHEET NO. 1 OF 1 SHEETS

SURVEY PLOTTED BY	DATE
DRAWN BY	
DESIGNED BY	
NOTED BY	
CHECKED BY	
NO.	