,	INDEX TO DRAWINGS
SHEET NO.	DESCRIPTION
1	TITLE SHEET
2	GENERAL LOCATION PLAN
3	TYPICAL SECTIONS AND DETAILS
4-5	STANDARD DETAILS
•	
ete entre algunia de la comunicación de la comunica	
,	
	·.·
	· ·
	,
	A contract of the contract of



STATE OF HAWAII



DEPARTMENT OF TRANSPORTATION

HIGHWAYS DIVISION

"AS-BUILT"


PLANS FOR CONSTRUCTION OF

HAWAII BELT ROAD RESURFACING

PAPA TOWARDS KAHUKU PROJECT NO. IID-01-82M

> DISTRICT OF SOUTH KONA ISLAND OF HAWAII

CONTRACTOR: YAMADA & SONS, INC. CONTRACT NO. 13355

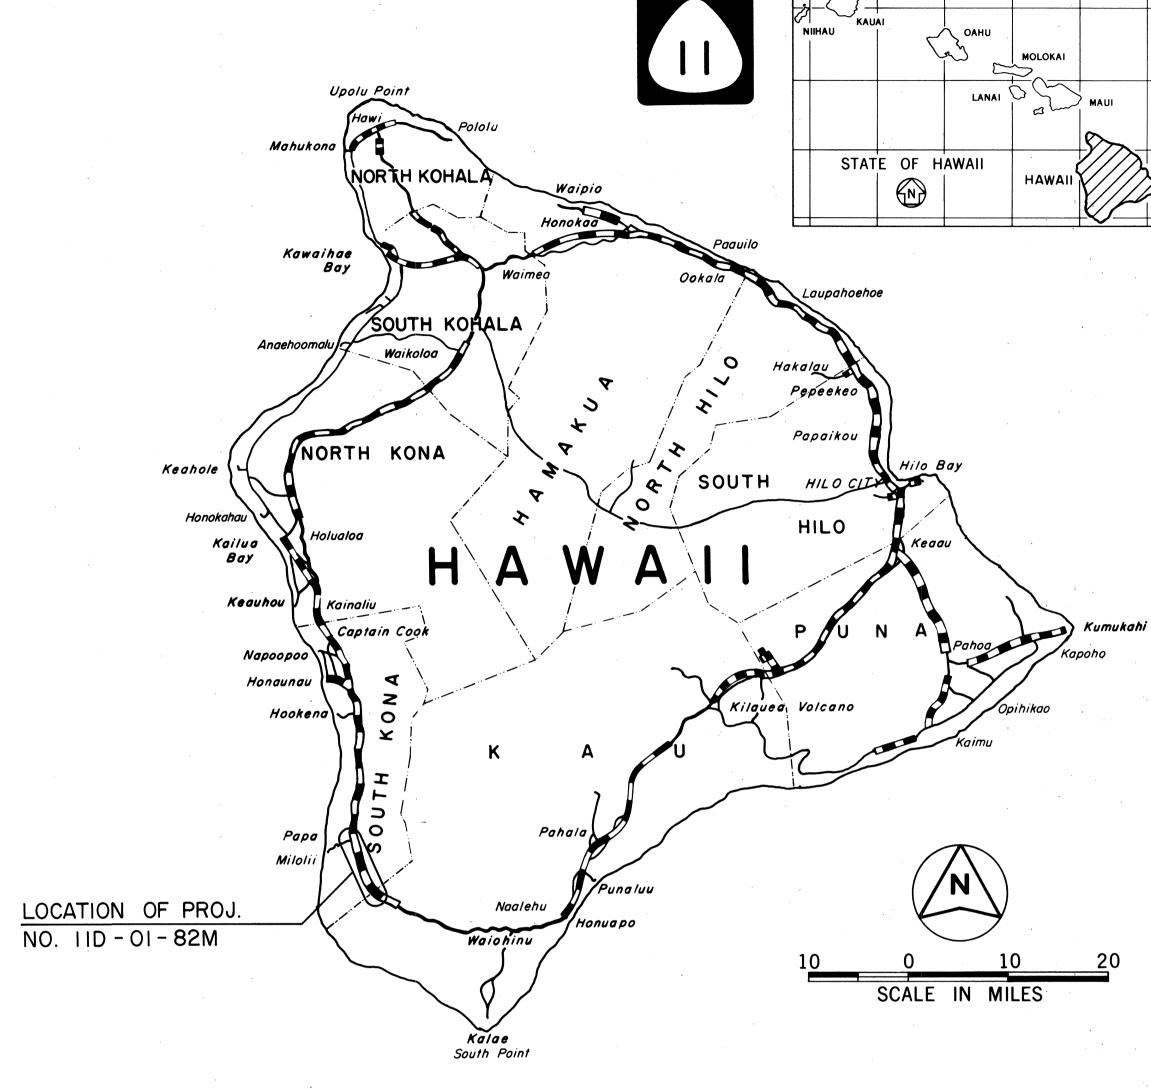

FED. ROAD DIST. NO.

FEDERAL AID PROJECTS PREVIOUSLY CONSTRUCTED OR UNDER CONSTRUCTION

ALL CHANGES MADE DURING CONSTRUCTION HAVE BEEN INCORPORATED ON THESE PLANS IN RED EXCEPT CHANGES IN THE ORIGINAL THEORETICAL QUANTITIES. FOR ACTUAL QUANTITIES, REFER TO PROJECT LEDGER AND/OR COMPUTATION BOOK.

Denge Krdani 12-27-82

DATE

FISCAL SHEET TOTAL YEAR NO. SHEETS

PROJ. NO.

11D-01-82M

DEPARTMENT OF TRANSPORTATION STATE OF HAWAII APPROVED:

ADIR. OF TRANSPORTATION