	INDEX TO DRAWINGS
SHEET NO.	DESCRIPTION
	TITLE SHEET
2	PLAN, GENERAL NOTES AND DETAILS
A construction of the cons	
	,
\$	



STATE OF HAWAII


DEPARTMENT OF TRANSPORTATION HIGHWAYS DIVISION "AS - BUILT" PLANS FOR

HAWAII BELT ROAD REPAIR OF STORM DAMAGE TO STREAM BED AT PUNALUU STREAM BRIDGE


PROJECT NO. IIG-02-82M

DISTRICT OF KAU ISLAND OF HAWAII

CONTRACTOR: YAMADA AND SONS, INC. CONTRACT NO. 15044

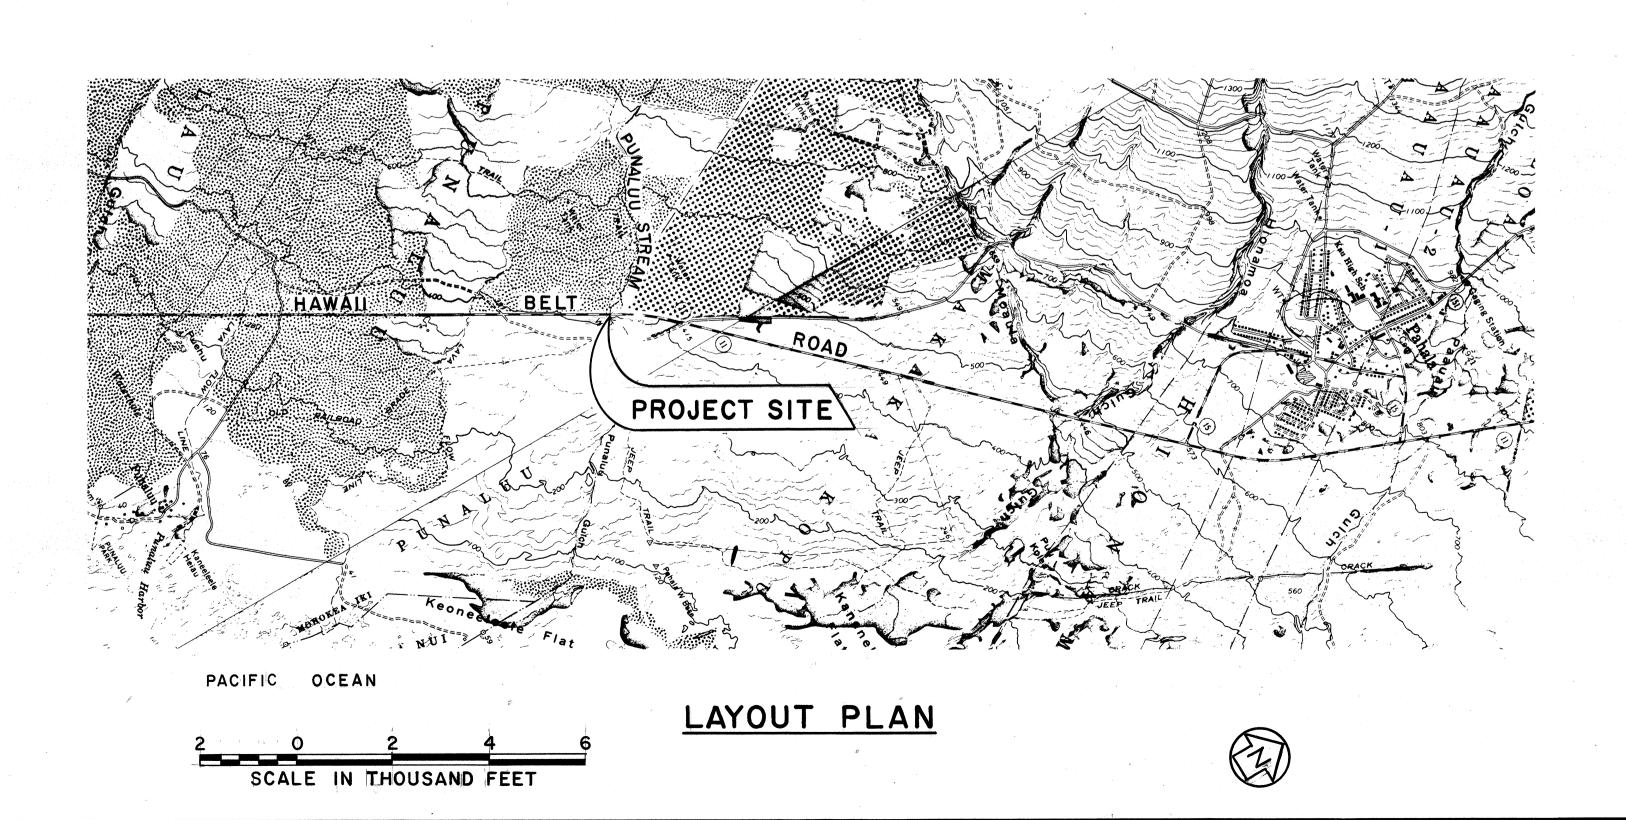

FED. ROAD DIST. NO. FISCAL SHEET TOTAL YEAR NO. SHEETS STATE IIG-02-82M

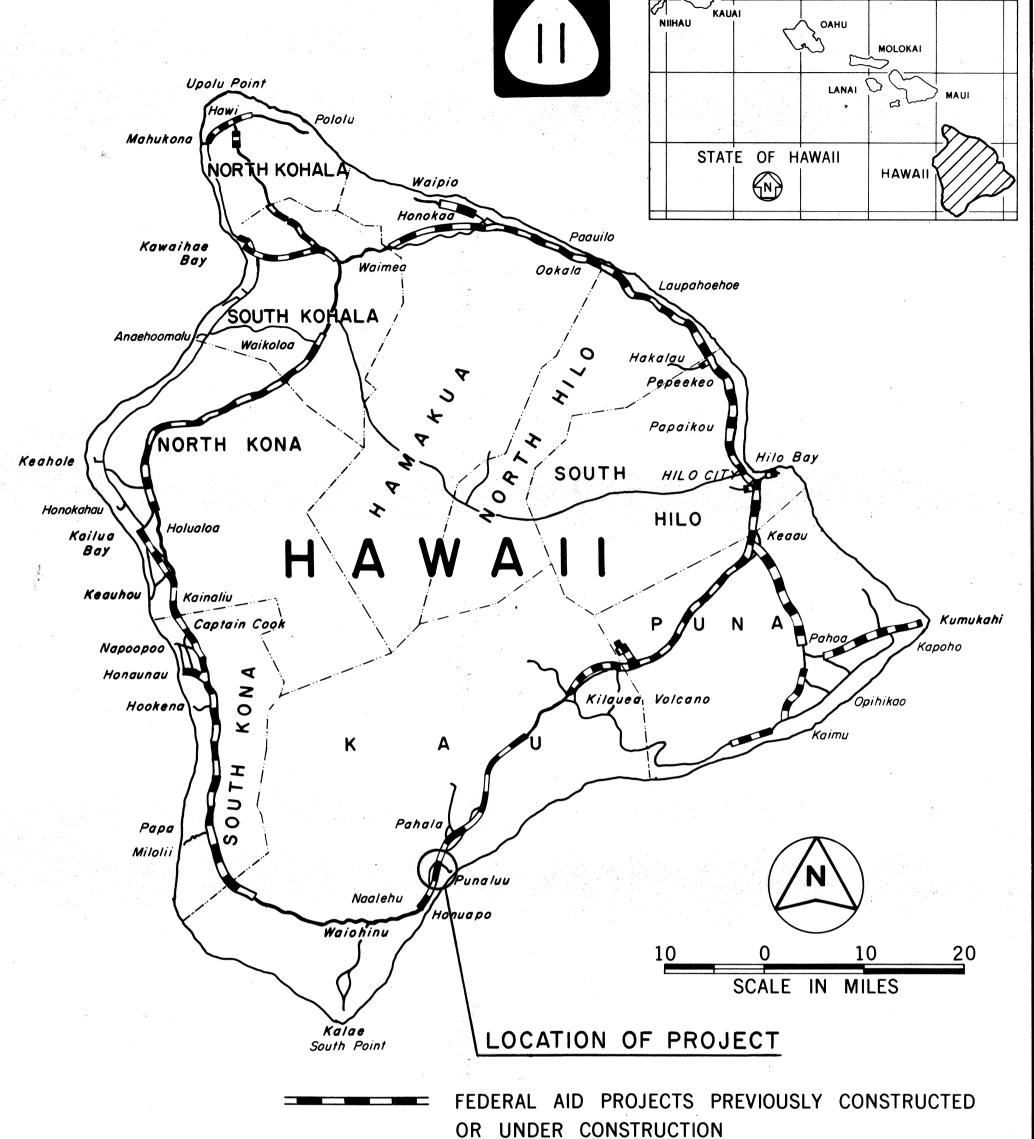

ALL CHANGES MADE DURING CONSTRUCTION HAVE BEEN INCORPORATED ON THESE PLANS IN RED EXCEPT CHANGES IN THE ORIGINAL THEORETICAL QUANTITIES. FOR ACTUAL QUANTITIES, REFER TO PROJECT LEDGER AND/OR COMPUTATION BOOK.

Denge Kodani 5-20-83 RESIDENT ENGINEER

> DEPARTMENT OF TRANSPORTATION STATE OF HAWAII ARPROVED: DIR. OF TRANSPORTATION

> > · 100-1-5-9

DATE

MAY, 1982 DATE

548-7490 PHONE

NISHIMURA P. S. & E. BY